

Refer to RFI tracker
for further design
and construction
amendments



Hamilton City Council
Development Engineering Unit

ACCEPTED ENGINEERING PLANS


Assessed for Related Resource Consent Conditions Only

Library Reference: 011.2019.00007140.025

Address: Greenhill Stage 24

Date: 7/05/2025

Subject to all notes and conditions affixed

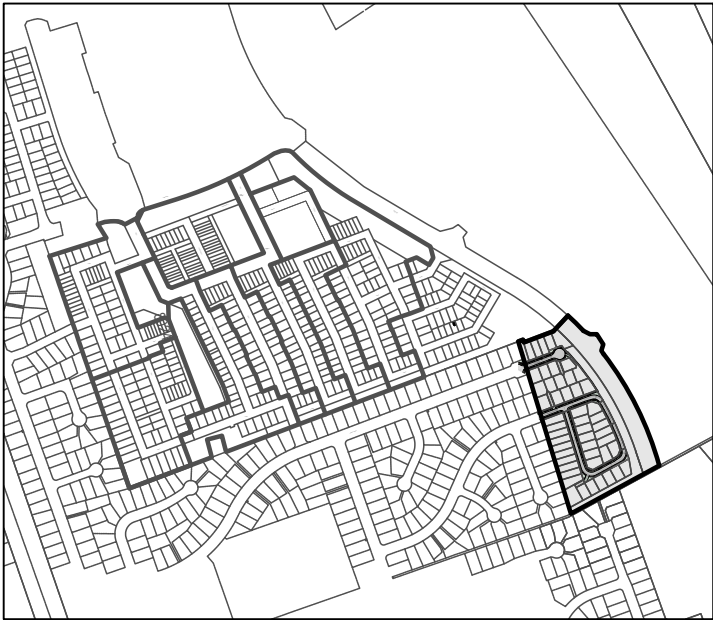

19-30410-01-LUK - CHEDWORTH - AREAS L, U & K - STAGE 24 (GREENHILL PARK) ENGINEERING DESIGN

DRAWING NUMBER	DRAWING TITLE	REV
ROADING		
24-30410-24D-R1	ROAD LAYOUT PLAN STAGE 24 OVERVIEW	4
24-30410-24D-R2	RADIATA STREET EXTENSION PLAN AND LONGSECTION	5
24-30410-24D-R3	RADIATA STREET ROW 1 & DRIVEWAY PLANS AND LONGSECTIONS	5
24-30410-24D-R4	RALEIGH AVENUE EXTENSION PLAN AND LONGSECTION	4
24-30410-24D-R5	RALEIGH AVENUE ROW 2 PLAN AND LONGSECTION	4
24-30410-24D-R6	ROAD 3 PLAN AND LONGSECTION (CH 0 - 250)	5
24-30410-24D-R7	ROAD 3 PLAN AND LONGSECTION (CH 250 - 320)	4
24-30410-24D-R8	ROAD 3 ROW 3 PLAN AND LONGSECTION	3
24-30410-24D-R9	PEDESTRIAN FOOTPATH PLAN AND LONGSECTION	5
24-30410-24D-R10	TYPICAL CROSS-SECTIONS	3
24-30410-24D-R11	RADIATA STREET EXTENSION CROSS-SECTIONS (CH 15 - 50)	2
24-30410-24D-R12	RADIATA STREET EXTENSION CROSS-SECTIONS (CH 55 - 75)	2
24-30410-24D-R13	RALEIGH AVENUE EXTENSION CROSS-SECTIONS (CH 10 - 110)	1
24-30410-24D-R14	ROAD 3 CROSS-SECTIONS (CH 0 - 180)	2
24-30410-24D-R15	ROAD 3 CROSS-SECTIONS (CH 190 - 320)	2
24-30410-24D-R16	PEDESTRIAN FOOTPATH CROSS-SECTIONS (CH 0 - 75)	4
24-30410-24D-R17	PEDESTRIAN FOOTPATH CROSS-SECTIONS (CH 80 - 100)	4

DRAWING NUMBER	DRAWING TITLE	REV
24-30410-24D-R18	SWALE - WEST PLAN AND LONG SECTIPN	6
24-30410-24D-R19	SWALE - WEST CROSS-SECTIONS (CH 0 - 190)	7
24-30410-24D-R20	SWALE - WEST CROSS-SECTIONS (CH 200 - 240)	7
24-30410-24D-R21	CUT & FILL PLAN FOR ROAD WORKS STAGE 24	2
24-30410-24D-R22	PAVEMENT DETAILS	2
24-30410-24D-R23	RADIATA STREET EXTENSION TRACKING 12.5M RIGID TRUCK	3
24-30410-24D-R24	JACQUES TERRACE EXTENSION TRACKING 12.5M RIGID TRUCK	2
STORMWATER		
30410-01-S24-SW0	STORMWATER LOCATION PLAN STAGE 24	3
30410-01-S24-SW1	STORMWATER LAYOUT PLAN STAGE 24	7
30410-01-S24-SW1A	STORMWATER LAYOUT PLAN STAGE 24 (NORTH)	3
30410-01-S24-SW2	STORMWATER LINES H & H4 LONGSECTIONS	5
30410-01-S24-SW2A	STORMWATER LINES H & H4 DETAILS	6
30410-01-S24-SW2B	STORMWATER LINES I & I3 LONGSECTIONS	4
30410-01-S24-SW2C	STORMWATER LINES I4, I6 & I7 LONGSECTIONS	4
30410-01-S24-SW3	STORMWATER LINES J & J7 LONGSECTIONS	4
30410-01-S24-SW3A	STORMWATER LINES J8 & J9 LONGSECTIONS	8
30410-01-S24-SW3B	STORMWATER LINES K & K0F LONGSECTIONS	
30410-01-S24-SW4	STANDARD DETAILS STORMWATER	1

DRAWING NUMBER	DRAWING TITLE	REV
30410-01-S24-SW5	STORMWATER STAGE 24 ~ 22 LONGSECTION	12
30410-01-S24-SW6	STORMWATER STAGE 24 ~ 22 CROSS-SECTION	12
30410-01-S24-SW7	STORMWATER STAGE 24 ~ 22 DETAILS OF CONCRETE PAD	3
30410-01-S24-SW8	CULVERT BLOCKED SCENARIO 100 YEAR STORM EVENT	7
30410-01-S24-SW8A	CULVERT BLOCKED SCENARIO 100 YEAR STORM EVENT (NORTH)	1
30410-01-S24-SW8B	SWALES CROSS-SECTIONS	3
30410-01-S24-SW9	STORMWATER EXISTING HCC LINE EXTENSION PLAN	6
30410-01-S24-SW10	STORMWATER EXISTING HCC LINE EXTENSION DETAILS	6
30410-01-S24-SW11	WEST SWALE IMDERDRAIN	3
WASTEWATER		
30410-01-S24-WW1	WASTEWATER LAYOUT PLAN STAGE 24	4
30410-01-S24-WW2	WASTEWATER LINES 3 & 3-2 LONGSECTIONS	4
30410-01-S24-WW3	WASTEWATER LINES 4 & 4-3 LONGSECTIONS	4
30410-01-S24-WW4	WASTEWATER LINES 4-5 & 4-5-3 LONGSECTIONS	4
30410-01-S24-WW5	STANDARD DETAILS WASTEWATER	1
WATER		
30410-01-S24-W1	WATER LAYOUT PLAN STAGE 24	4
30410-01-S24-W2	STANDARD DETAILS WATER	1
30410-01-S24-W3	STANDARD DETAILS WATER	1
OTHER		

DRAWING NUMBER	DRAWING TITLE	REV
30410-01-S24-D1	WASTEWATER & STORMWATER OVERVIEW STAGE 24	
30410-01-S24-S1	WASTEWATER, STORMWATER, WATER & ROADING OVERVIEW STAGE 24	1

SHRIMPTON & LIPINSKI
LAND SPECIALISTS

Ph. 07 577 6069
Email: info@sltga.co.nz
P.O. Box 231, Tauranga 3140
www.sltga.co.nz

Status
FOR APPROVAL

Date
07/05/25

Drawing No
30410-01-S24-COV1

Revision
7

R:\Project Files\30410-01-1901 Drawing Presentation Files\19-30410-01 - Stage 24 Engineering Design Plan Set.dwg - Plotted: 7/05/2025

R:\Project Files\30410-01-1901 Detail Design\G24-30410-24D_Stage 24_Road Design - West Svale Check.dwg - Plotted: 29/04/2025

Refer to RFI tracker
for further design
and construction
amendments

Hamilton City Council
Development Engineering Unit

ACCEPTED ENGINEERING PLANS

Assessed for Related Resource Consent Conditions Only

Library Reference: 011.2019.00007140.025

Address: Greenhill Stage 24

Date: 7/05/2025

Subject to all notes and conditions affixed



S & L Land Specialists
Ph. 07 577 6069
Email: info@slip.co.nz
P.O. Box 231, Tauranga 3144
www.slip.co.nz

LEGEND:
— ABUTTALS
— BOUNDARIES
■ ROAD SURFACE
■ PARKING SURFACE
■ FOOTPATH
■ GRASS

NOTE:
SUBJECT TO FINAL DESIGN.
ALL DESIGNS TO BE IN ACCORDANCE
WITH THE RITS OR SPECIFIED
DEPARTURES ON DETAIL DESIGN.

Rev	DESCRIPTION	DRN	CKD	APP	DATE
0	Preliminary	GG	BG	PH	29.07.24
1	Layout Update	GG	HB	PH	19.08.24
2	Issued for RFI	GG	HB	PH	31.10.24
3	RFI Response	NW	HB	RH	16/04/25
4	RFI Response	TM	HB		24/04/25

SURVEYED	NAME	DATE	DESIGNED	NAME	DATE
			GG		29.07.24

COORDINATE SYSTEM:
ORIGIN OF COORDINATES:
HEIGHT DATUM:
ORIGIN OF HEIGHT:
TITLE

GREENHILL PARK
STAGE 24
OVERVIEW

PREPARED FOR


ORIGINAL SCALES @ A3
1:1000
DO NOT SCALE DIMENSIONS
DRAWING NO
24-30410-24D-R1

STATUS
APPROVAL
REVISION
4

COPYRIGHT ON THIS DRAWING IS RESERVED

R:\Project Files\30410-01-1901 Detail Design\G24-30410-24D_Stage 24_Road Design.dwg - Plotted: 29/04/2025



Hamilton City Council
Development Engineering Unit

ACCEPTED ENGINEERING PLANS

Assessed for Related Resource Consent Conditions Only

Library Reference: 011.2019.00007140.025

Address: Greenhill Stage 24

Date: 7/05/2025

Subject to all notes and conditions affixed

S & L Land Specialists

Ph. 07 577 6069
Email: info@slp.co.nz
P.O. Box 231, Tauranga 3144
www.slp.co.nz

LEGEND:

- ABUTTALS
- BOUNDARIES
- ROAD SURFACE
- PARKING SURFACE
- FOOTPATH
- GRASS
- STORMWATER MANHOLE
- STORMWATER CATCH PIT
- WASTEWATER MANHOLE
- STORMWATER PIPE
- WASTEWATER PIPE

NOTE:

ALL DESIGNS TO BE IN ACCORDANCE WITH THE RITS OR SPECIFIED DEPARTURES ON DETAIL DESIGN.

Rev	DESCRIPTION	DRN	CKD	APP	DATE
0	Preliminary	GG	BG	PH	29.07.24
1	Layout Update	GG	HB	PH	19.08.24
2	Issued for RFI	GG	HB	PH	31.10.24
3	Issued for RFI (SW Update)	TM		PH	07.04.25
4	RFI Response	NW	HB	RH	16.04.25
5	RFI Response	NW	HB	RH	29.04.25

NAME	DATE	NAME	DATE
SURVEYED	DESIGNED	GG	29.07.24

COORDINATE SYSTEM:

ORIGIN OF COORDINATES:

HEIGHT DATUM:

ORIGIN OF HEIGHT:

TITLE

**RADIATA STREET
ROW 1 & DRIVEWAY
PLANS AND
LONG SECTIONS**

PREPARED FOR

ORIGINAL SCALES @ A3	STATUS
AS SHOWN	APPROVAL

DO NOT SCALE DIMENSIONS

DRAWING NO

24-30410-24D-R3

REVISION

5

COPYRIGHT ON THIS DRAWING IS RESERVED

R:\Project Files\30410-01-1901 Detail Design\G24-30410-24D_Stage 24_Road Design.dwg - Plotted: 17/04/2025



S & L Land Specialists

Ph. 07 577 6069
Email: info@slip.co.nz
P.O. Box 231, Tauranga 3144
www.slip.co.nz

LEGEND:

- ABUTTALS
- BOUNDARIES
- ROAD SURFACE
- PARKING SURFACE
- FOOTPATH
- GRASS
- STORMWATER MANHOLE
- STORMWATER CATCH PIT
- WASTEWATER MANHOLE
- STORMWATER PIPE
- WASTEWATER PIPE

NOTE:
SUBJECT TO FINAL DESIGN.
ALL DESIGNS TO BE IN ACCORDANCE
WITH THE RITS OR SPECIFIED
DEPARTURES ON DETAIL DESIGN.

Rev	DESCRIPTION	DRN	CKD	APP	DATE
0	Preliminary	GG	BG	PH	29.07.24
1	Layout Update	GG	HB	PH	19.08.24
2	Issued for RFI	GG	HB	PH	31.10.24
3	Issued for RFI (SW Update)	TM	HB	PH	07.04.25
4	RFI Response	NW	HB	RH	16.04.25

SURVEYED	NAME	DATE	DESIGNED	NAME	DATE
			GG		29.07.24

COORDINATE SYSTEM:
ORIGIN OF COORDINATES:
HEIGHT DATUM:
ORIGIN OF HEIGHT:

**RELEIGH AVENUE
EXTENTION
PLAN AND
LONG SECTION**


PREPARED FOR



ORIGINAL SCALES @ A3 STATUS
AS SHOWN APPROVAL

DRAWING NO. 24-30410-24D-R4
REVISION 4

COPYRIGHT ON THIS DRAWING IS RESERVED

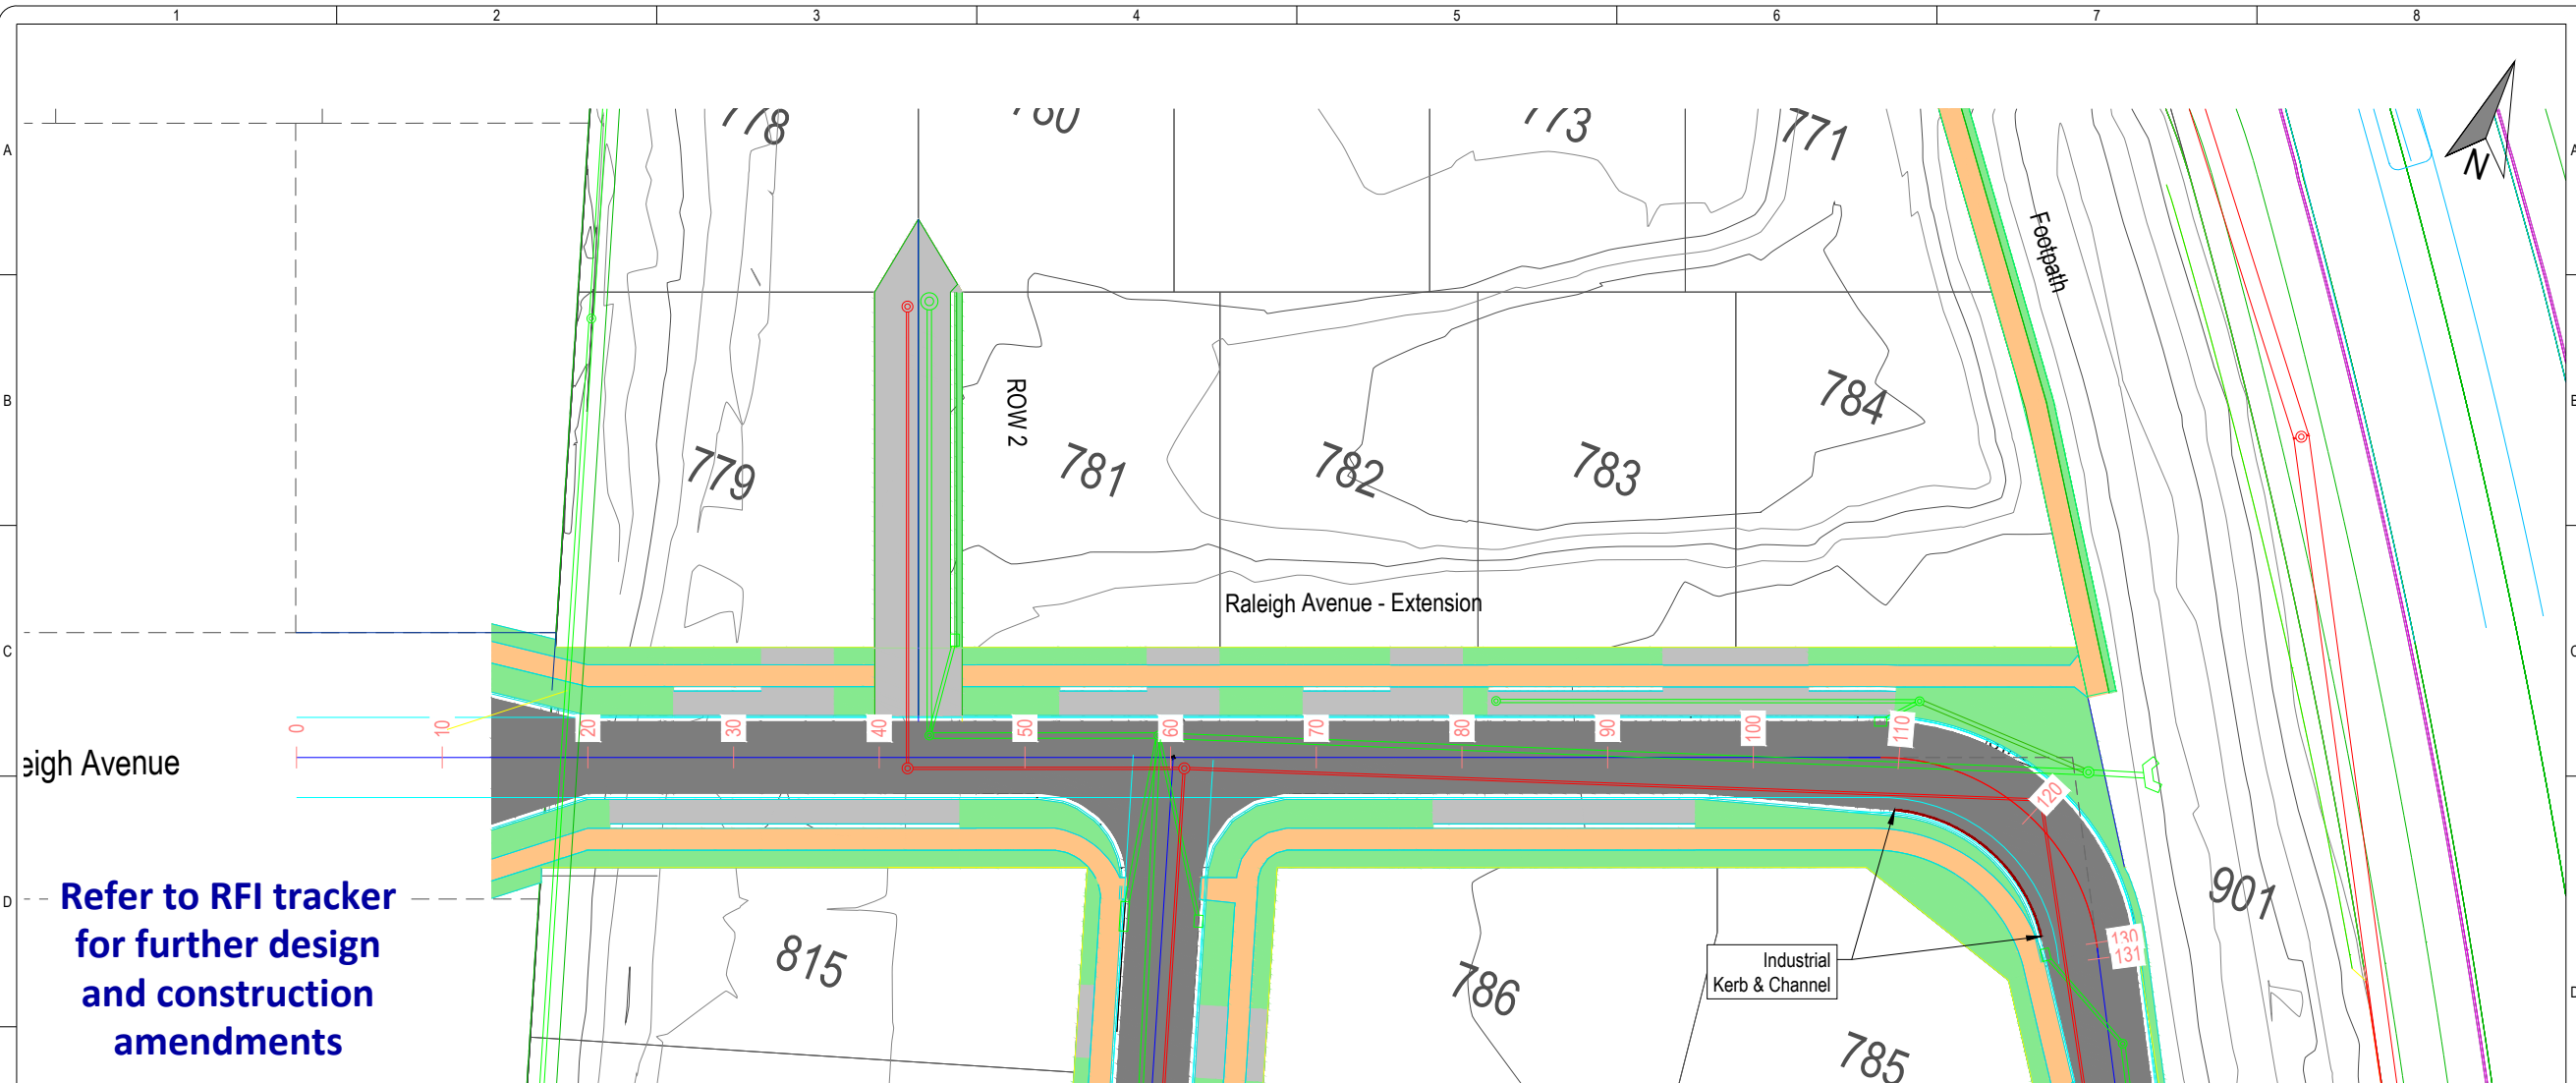


RALEIGH AVENUE (EXTENTION) - PLAN
Scale - 1:500

VERT EXAG 1:5
DATUM ELEV: 35.00

CUT / FILL
DESIGN SURFACE
EXISTING SURFACE
CHAINAGE
HORIZONTAL
VERTICAL

S24-RALEIGH EXTENTION LONG SECTION

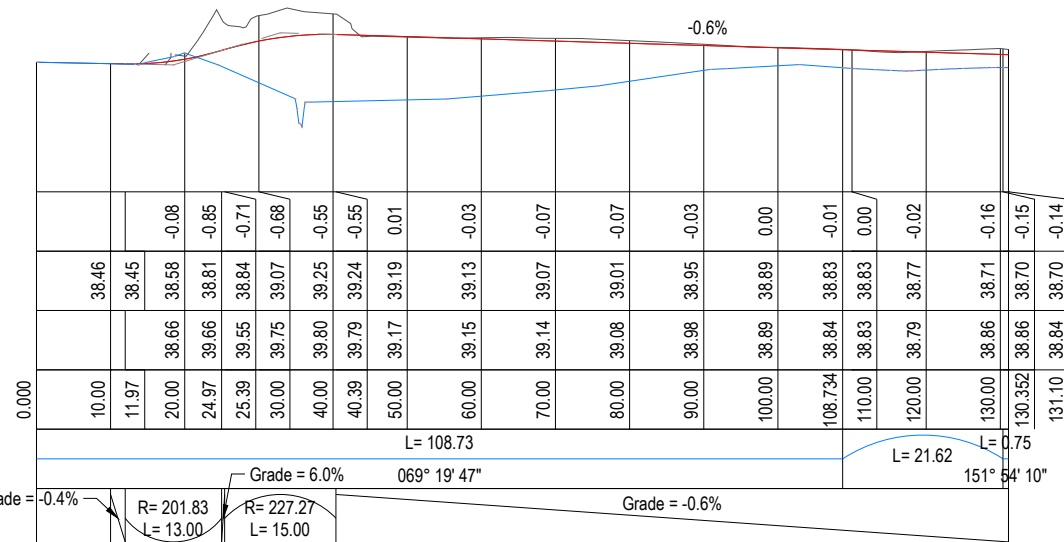

RALEIGH AVENUE (EXTENSION) - LONG SECTION
Scale - H: 1:1000 V: 1:200



- — ABUTTALS
- BOUNDARIES
-  ROAD SURFACE
-  PARKING SURFACE
-  FOOTPATH
-  GRASS
-  STORMWATER MANHOLE
-  STORMWATER CATCH PIT
-  WASTEWATER MANHOLE
-  STORMWATER PIPE
-  WASTEWATER PIPE

Rev	DESCRIPTION	DRN	CKD	APP	DATE
0	Preliminary	GG	BG	PH	29.07.24
1	Layout Update	GG	HB	PH	19.08.24
2	Issued for RFI	GG	HB	PH	31.10.24
3	Issued for RFI (SW Update)	TM		PH	07.04.25
4	RFI Response	NW	HB	RH	16.04.25

COORDINATE SYSTEM:
ORIGIN OF COORDINATES:
HEIGHT DATUM:
ORIGIN OF HEIGHT:



24-30410-24D-R5	4
-----------------	---

COPYRIGHT ON THIS DRAWING IS RESERVED

[illegible]

Hamilton City Council
Development Engineering Unit

ACCEPTED ENGINEERING PLANS

Assessed for Related Resource Consent Conditions Only

Library Reference: 011.2019.00007140.025

Address: Greenhill Stage 24

Date: 7/05/2025

Subject to all notes and conditions affixed

R:\Project Files\30410-01-19\01 Detail Design\G24-30410-24D_Stage 24_Road Design.dwg - Plotted: 17/04/2025


R:\Project Files\30410-01-1901 Detail Design\G24-30410-24D_Stage 24_Road Design.dwg - Plotted: 6/05/2025



JACQUES TERRACE - PLAN
Scale - 1:1000

Refer to RFI tracker
for further design
and construction
amendments

Hamilton City Council
Development Engineering Unit
ACCEPTED ENGINEERING PLANS
Assessed for Related Resource Consent Conditions Only
Library Reference: 011.2019.00007140.025
Address: Greenhill Stage 24
Date: 7/05/2025
Subject to all notes and conditions affixed

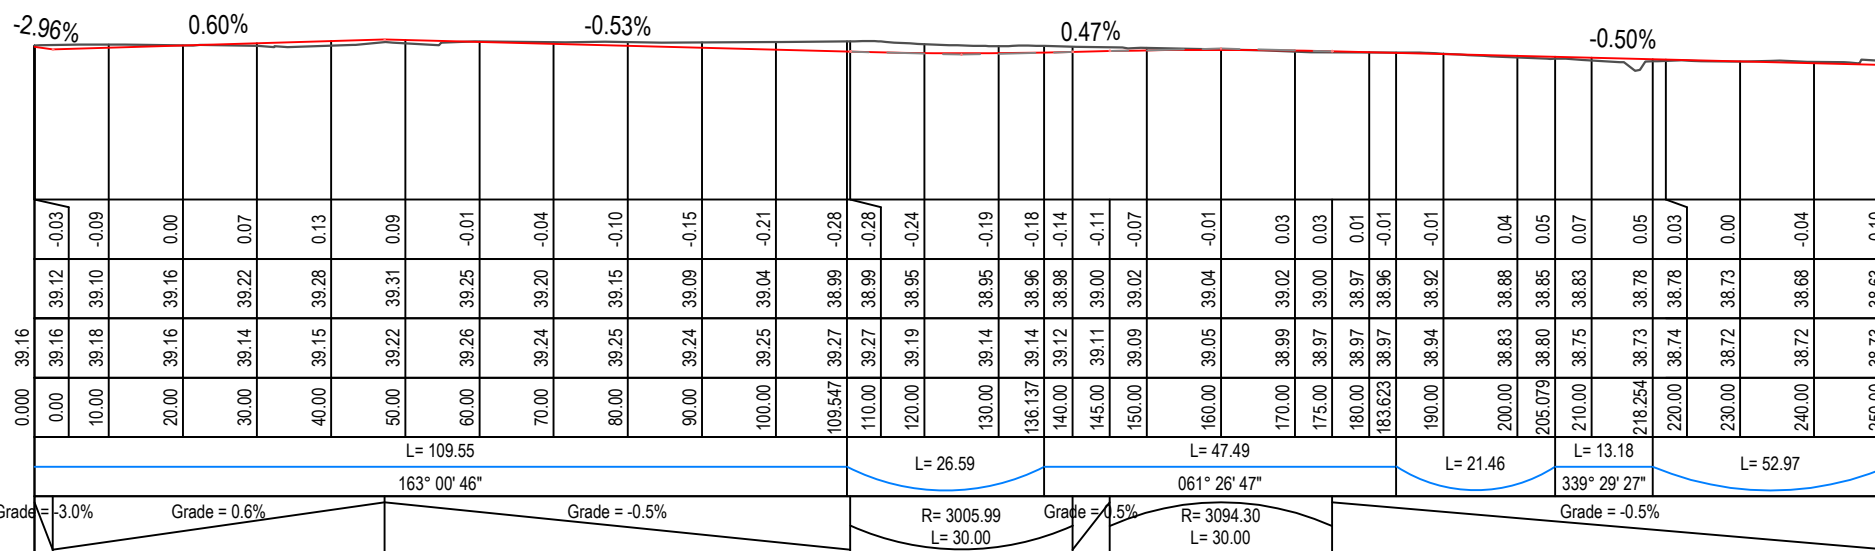

JACQUES TERRACE - LONG SECTION (From CH 0+000 to CH 0+250)
Scale - H: 1:1000 V: 1:200

VERT EXAG 1:5
DATUM ELEV: 35.00

CUT / FILL
DESIGN SURFACE
EXISTING SURFACE
CHAINAGE
HORIZONTAL
VERTICAL



S & L Land Specialists

Ph. 07 577 6069
Email: info@slp.co.nz
P.O. Box 231, Tauranga 3144
www.slp.co.nz

LEGEND:

- ABUTTALS
- BOUNDARIES
- ROAD SURFACE
- PARKING SURFACE
- FOOTPATH
- GRASS
- STORMWATER MANHOLE
- STORMWATER CATCH PIT
- WASTEWATER MANHOLE
- STORMWATER PIPE
- WASTEWATER PIPE

NOTE:
SUBJECT TO FINAL DESIGN.
ALL DESIGNS TO BE IN ACCORDANCE
WITH THE RITS OR SPECIFIED
DEPARTURES ON DETAIL DESIGN.

Rev	DESCRIPTION	DRN	CKD	APP	DATE
0	Preliminary	GG	BG	PH	29.07.24
1	Layout Update	GG	HB	PH	19.08.24
2	Issued for RFI	GG	HB	PH	31.10.24
3	Issued for RFI (SW Update)	TM		PH	07.04.25
4	RFI Response	NW	HB	RH	16.04.25
5	Low Point Ch.125 Lifted	TM	HB		06/05/25

NAME	DATE	NAME	DATE
SURVEYED		DESIGNED	GG 29.07.24

COORDINATE SYSTEM:

ORIGIN OF COORDINATES:

HEIGHT DATUM:

ORIGIN OF HEIGHT:

TITLE

JACQUES TERRACE
PLAN AND
LONG SECTION
(CH 0+000 - CH 0+250)

PREPARED FOR



ORIGINAL SCALES @ A3

AS SHOWN

DO NOT SCALE DIMENSIONS

DRAWING NO

24-30410-24D-R6


APPROVAL

REVISION


5

COPYRIGHT ON THIS DRAWING IS RESERVED

R:\Project Files\30410-01-1901 Detail Design\304-30410-24D_Stage 24_Road Design.dwg - Plotted: 17/04/2025

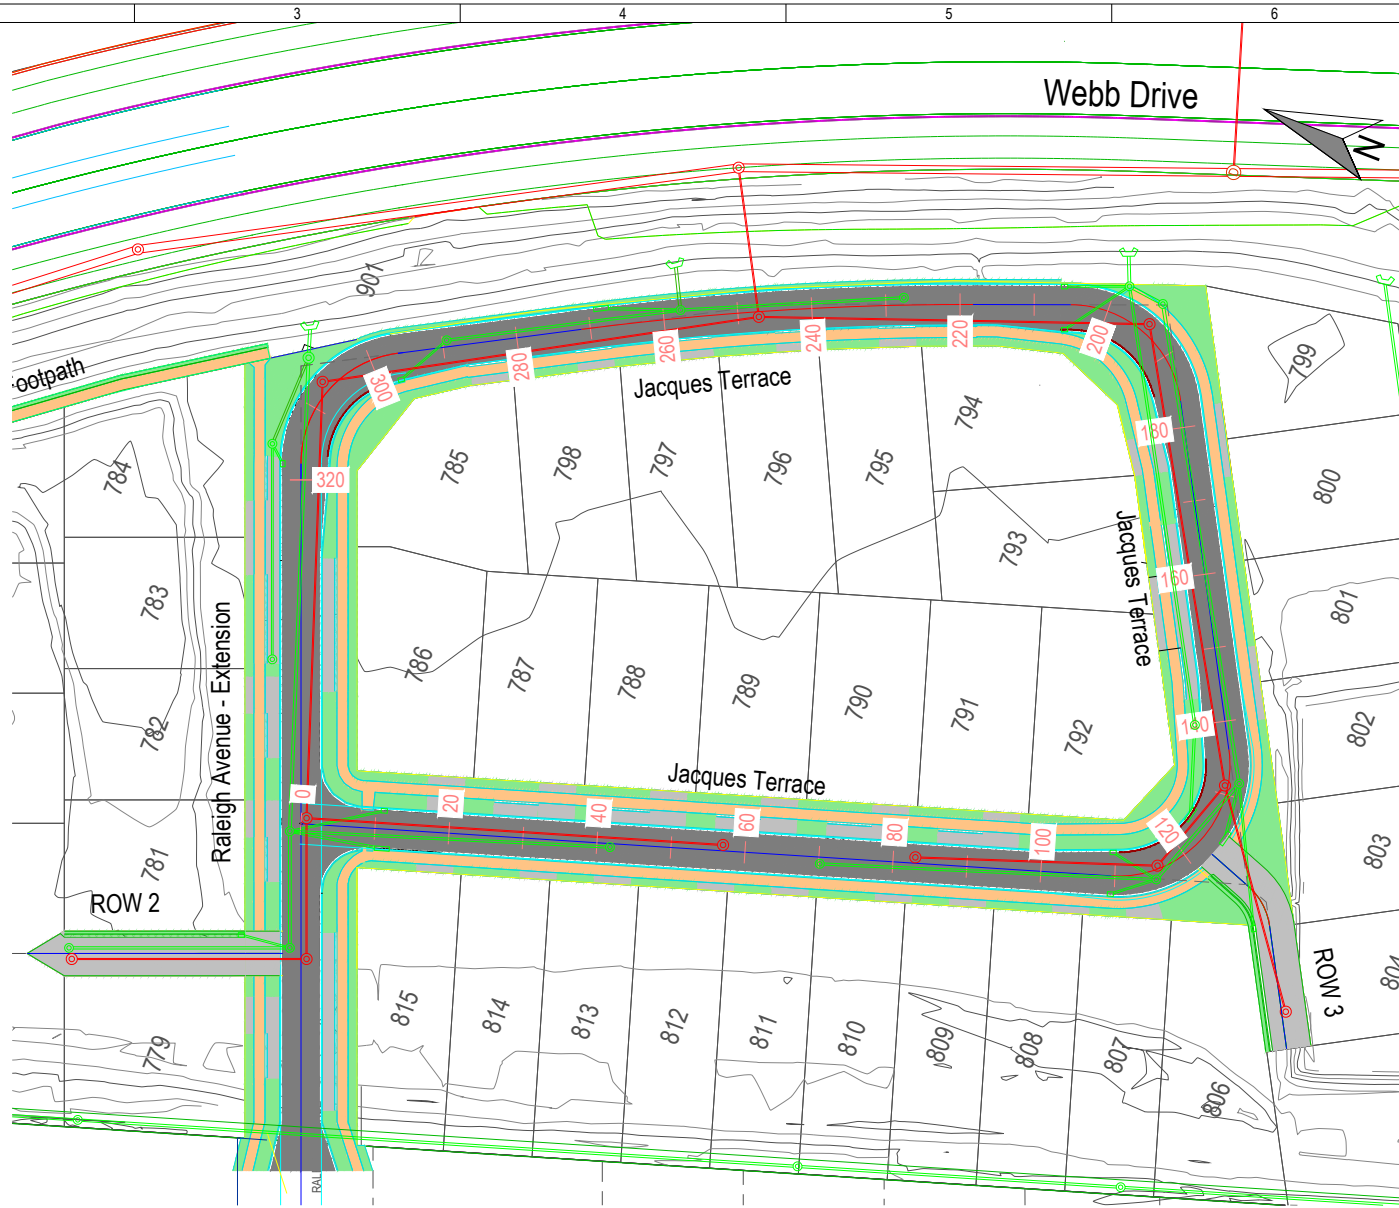

JACQUES TERRACE - PLAN
Scale - 1:1000

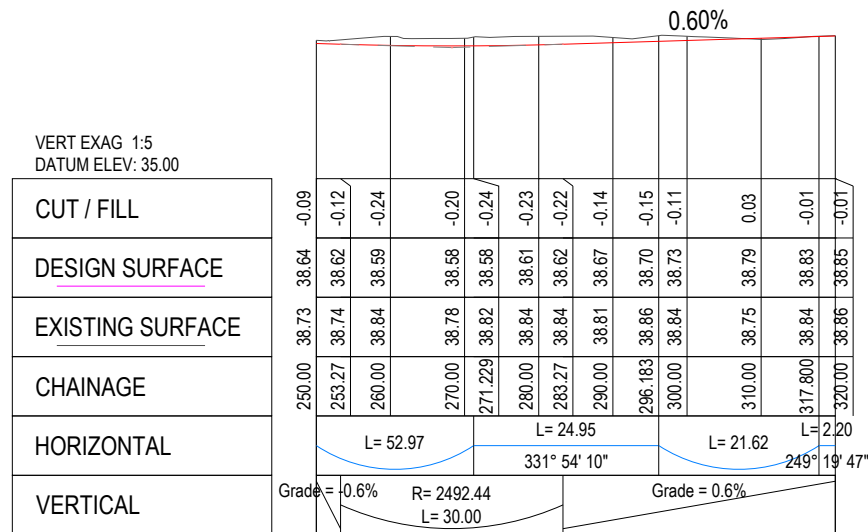

JACQUES TERRACE - LONG SECTION (From CH 0+250 to CH 0+320)
Scale - H: 1:1000 V: 1:200

Refer to RFI tracker
for further design
and construction
amendments

Hamilton City Council
Development Engineering Unit

ACCEPTED ENGINEERING PLANS

Assessed for Related Resource Consent Conditions Only

Library Reference: 011.2019.00007140.025

Address: Greenhill Stage 24

Date: 7/05/2025

Subject to all notes and conditions affixed



S & L Land Specialists

Ph. 07 577 6069
Email: info@slp.co.nz
P.O. Box 231, Tauranga 3144
www.slp.co.nz

LEGEND:

- ABUTTALS
- BOUNDARIES
- ROAD SURFACE
- PARKING SURFACE
- FOOTPATH
- GRASS
- STORMWATER MANHOLE
- STORMWATER CATCH PIT
- WASTEWATER MANHOLE
- STORMWATER PIPE
- WASTEWATER PIPE

NOTE:
SUBJECT TO FINAL DESIGN.
ALL DESIGNS TO BE IN ACCORDANCE
WITH THE RITS OR SPECIFIED
DEPARTURES ON DETAIL DESIGN.


Rev	DESCRIPTION	DRN	CKD	APP	DATE
0	Preliminary	GG	BG	PH	29.07.24
1	Layout Update	GG	HB	PH	19.08.24
2	Issued for RFI	GG	HB	PH	31.10.24
3	Issued for RFI (SW Update)	TM		PH	07.04.25
4	RFI Response	NW	HB	RH	16.04.25

NAME	DATE	NAME	DATE
SURVEYED		DESIGNED	GG 29.07.24

COORDINATE SYSTEM:
ORIGIN OF COORDINATES:
HEIGHT DATUM:
ORIGIN OF HEIGHT:

TITLE

JACQUES TERRACE
PLAN AND
LONG SECTION
(CH 0+250 - CH 0+320)

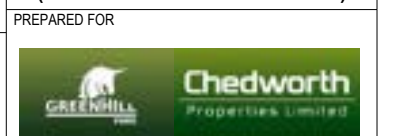

ORIGINAL SCALES @ A3	STATUS
AS SHOWN	APPROVAL
DO NOT SCALE DIMENSIONS	
DRAWING NO	REVISION
24-30410-24D-R7	4

COPYRIGHT ON THIS DRAWING IS RESERVED



Ph. 07 577 6069
Email: info@slip.co.nz
P.O. Box 231, Tauranga 3144
www.slip.co.nz

 — ABUTTALS
 — BOUNDARIES
 ROAD SURFACE
 PARKING SURFACE
 FOOTPATH
 GRASS
 STORMWATER MANHOLE
 STORMWATER CATCH PIT
 WASTEWATER MANHOLE
 STORMWATER PIPE
 WASTEWATER PIPE

NOTE:
SUBJECT TO FINAL DESIGN.
ALL DESIGNS TO BE IN ACCORDANCE
WITH THE RITS OR SPECIFIED
DEPARTURES ON DETAIL DESIGN.

Rev	DESCRIPTION	DRN	CKD	APP	DATE
0	Preliminary	GG	BG	PH	29.07.2
1	Layout Update	GG	HB	PH	19.08.2
2	Issued for RFI	GG	HB	PH	31.10.2
3	RFI Response	NW	HB	RH	16.04.2

	NAME	DATE		NAME	DATE
SURVEYED			DESIGNED	GG	29.07.24

COORDINATE SYSTEM:
ORIGIN OF COORDINATES:
HEIGHT DATUM:
ORIGIN OF HEIGHT:

TITLE

JACQUES TERRACE
ROW 3
PLAN AND
LONG SECTION


PREPARED FOR _____



ORIGINAL SCALES @ A3	STATUS
AS SHOWN	APPROVAL
DO NOT SCALE DIMENSIONS	
DRAWING NO	REVISION
24-30410-24D-R8	3

COPYRIGHT ON THIS DRAWING IS RESERVED

**Refer to RFI tracker
for further design
and construction
amendments**

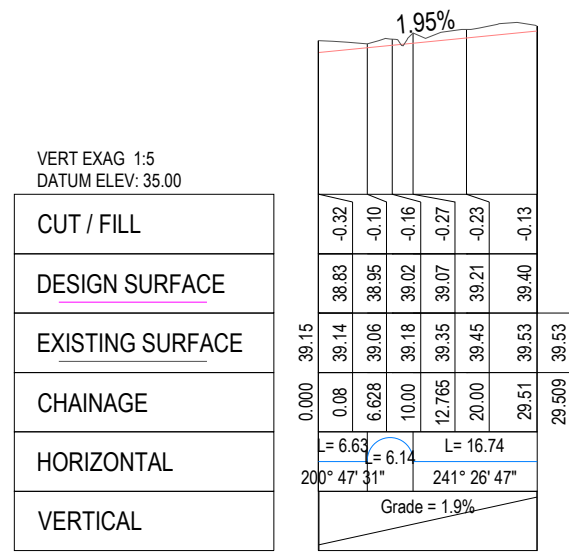

JACQUES TERRACE - ROW 3 - LONG SECTION
Scale - H: 1:1000 V: 1:200

Hamilton City Council
Development Engineering Unit

ACCEPTED ENGINEERING PLANS

Assessed for Related Resource Consent Conditions Only

Library Reference: 011.2019.00007140.025


Address: Greenhill Stage 24

Date: 7/05/2025

Subject to all notes and conditions affixed

R:\Project Files\30410-01-19\01 Detail Design\G24-30410-24D_Stage 24_Road Design.dwg - Plotted: 17/04/2025

R:\Project Files\30410-01-1901 Detail Design\304-30410-24D_Stage 24_Road Design.dwg - Plotted: 29/04/2025

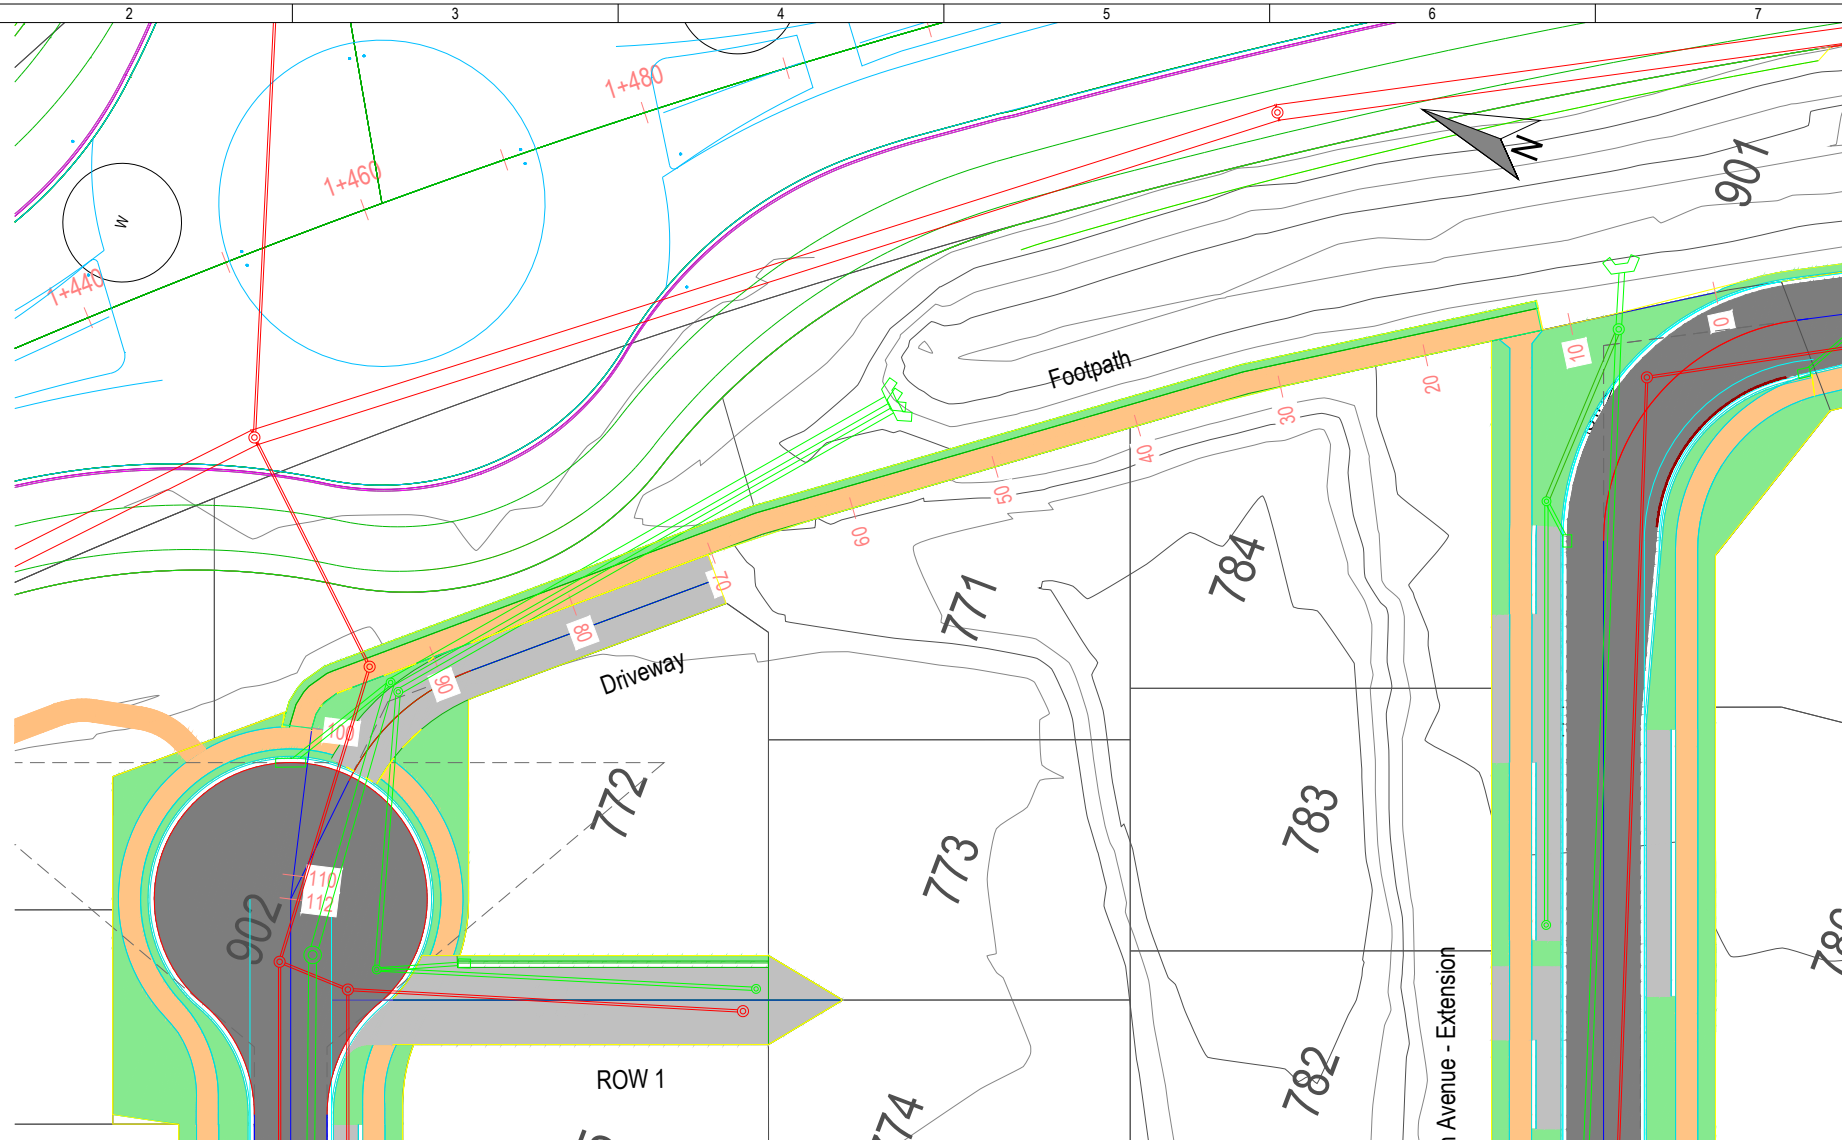


PEDESTRIAN FOOTPATH - PLAN
Scale - 1:500

Refer to RFI tracker
for further design
and construction
amendments

Hamilton City Council
Development Engineering Unit
ACCEPTED ENGINEERING PLANS
Assessed for Related Resource Consent Conditions Only
Library Reference: 011.2019.00007140.025
Address: Greenhill Stage 24
Date: 7/05/2025
Subject to all notes and conditions affixed

VERT EXAG 1:5
DATUM ELEV: 35.00

CUT / FILL
DESIGN SURFACE
EXISTING SURFACE
CHAINAGE
HORIZONTAL
VERTICAL

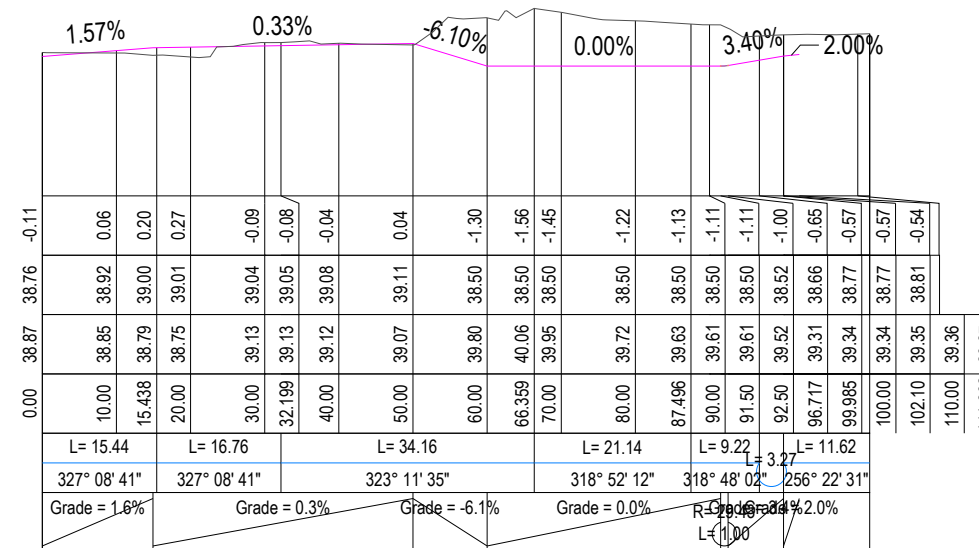

PEDESTRIAN FOOTPATH - LONG SECTION
Scale - H: 1:1000 V: 1:200



S & L Land Specialists

Ph. 07 577 6069
Email: info@slip.co.nz
P.O. Box 231, Tauranga 3144
www.slip.co.nz

LEGEND:

- ABUTTALS
- BOUNDARIES
- ROAD SURFACE
- PARKING SURFACE
- FOOTPATH
- GRASS
- STORMWATER MANHOLE
- STORMWATER CATCH PIT
- WASTEWATER MANHOLE
- STORMWATER PIPE
- WASTEWATER PIPE

NOTE:
ALL DESIGNS TO BE IN ACCORDANCE
WITH THE RITS OR SPECIFIED
DEPARTURES ON DETAIL DESIGN.

Rev	DESCRIPTION	DRN	CKD	APP	DATE
0	Preliminary	GG	BG	PH	29.07.24
1	Layout Update	GG	HB	PH	19.08.24
2	Issued for RFI	GG	HB	PH	31.10.24
3	Issued for RFI	TM		PH	07.04.25
4	RFI Response	NW	HB	RH	16.04.25
5	RFI Responses	NW	HB	RH	29.04.25

NAME	DATE	NAME	DATE
SURVEYED		DESIGNED	GG 29.07.24

COORDINATE SYSTEM:
ORIGIN OF COORDINATES:
HEIGHT DATUM:
ORIGIN OF HEIGHT:

PEDESTRIAN FOOTPATH
PLAN AND
LONG SECTION
(CH 0+250 - CH 0+320)

PREPARED FOR



ORIGINAL SCALES @ A3

AS SHOWN APPROVAL

DO NOT SCALE DIMENSIONS

DRAWING NO

24-30410-24D-R9

REVISION

5

COPYRIGHT ON THIS DRAWING IS RESERVED



S & L Land Specialists

Ph. 07 577 6069
Email: info@slp.co.nz
P.O. Box 231, Tauranga 3144
www.slp.co.nz

Refer to RFI tracker
for further design
and construction
amendments

Hamilton City Council
Development Engineering Unit
ACCEPTED ENGINEERING PLANS


Assessed for Related Resource Consent Conditions Only

Library Reference: 011.2019.00007140.025


Address: Greenhill Stage 24

Date: 7/05/2025


Subject to all notes and conditions affixed

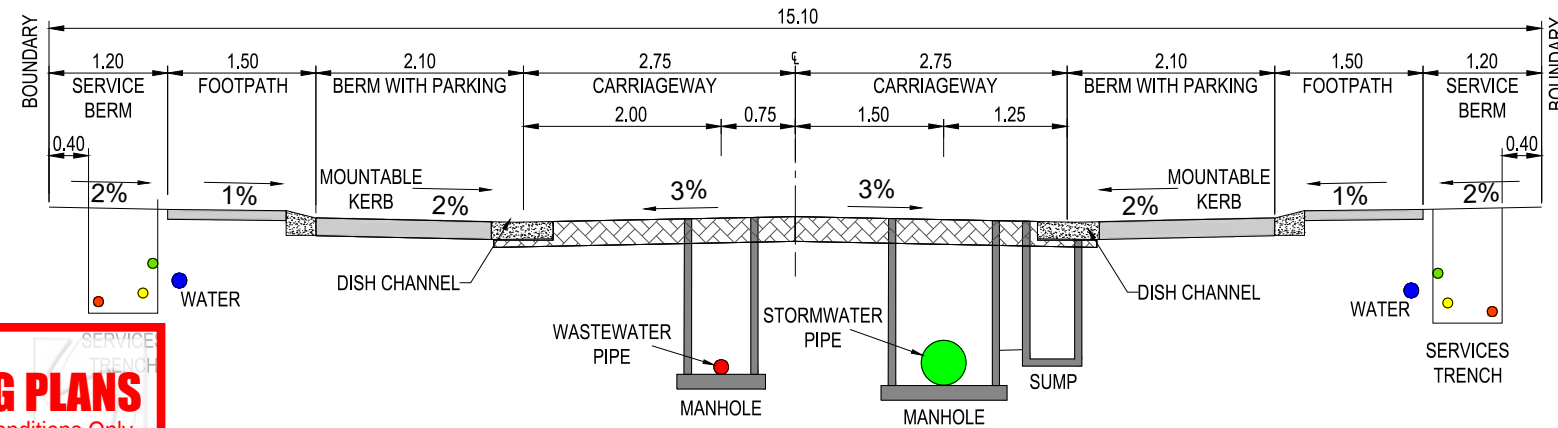


TYPICAL CROSS-SECTION 'A'
FOR THE RADIATA STREET & RALEIGH AVENUE EXTENSIONS

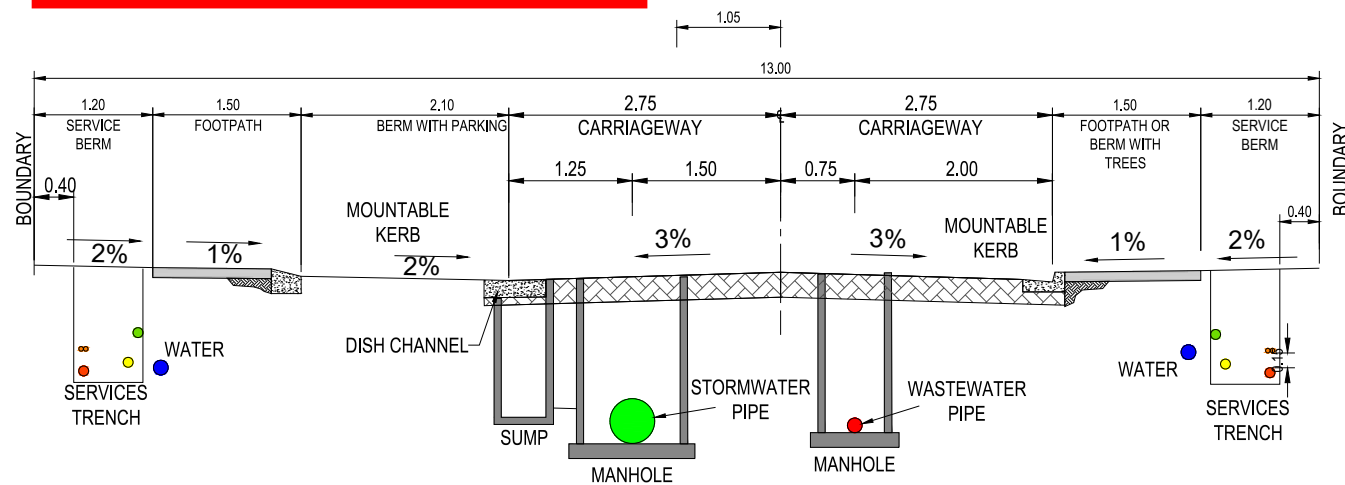


TYPICAL CROSS-SECTION 'B'
FOR THE JACQUES TERRACE FROM CH: 0+000 TO CH:0+206
SCALE 1:75

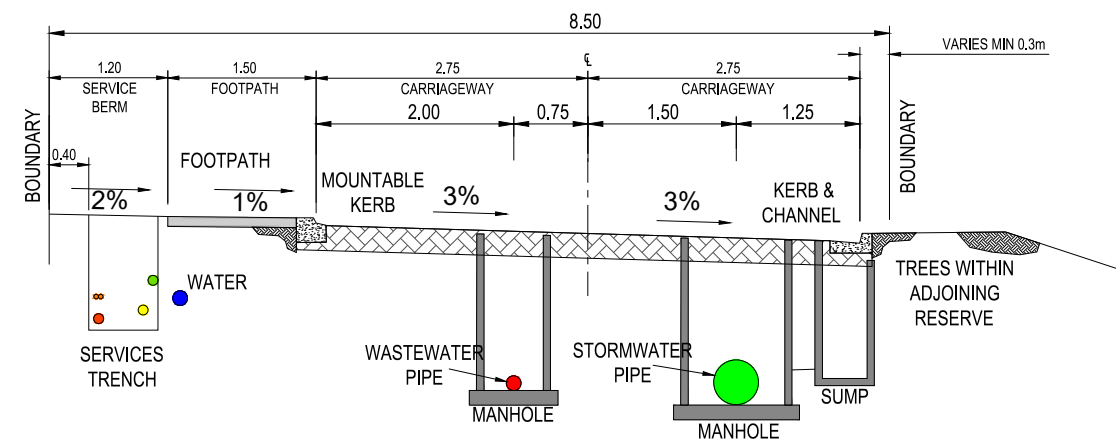


TYPICAL CROSS-SECTION 'C'
FOR THE JACQUES TERRACE FROM CH: 0+206 TO CH:0+300
SCALE 1:75

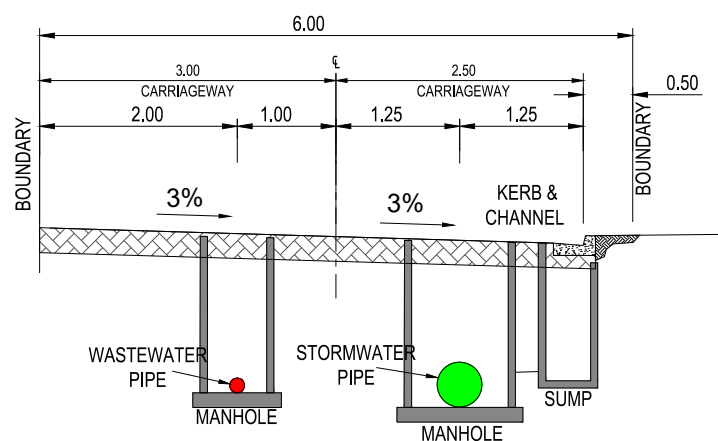

TYPICAL CROSS-SECTION 'D'
FOR THE ROW 1, 2, 3 AND DRIVEWAY
SCALE 1:75

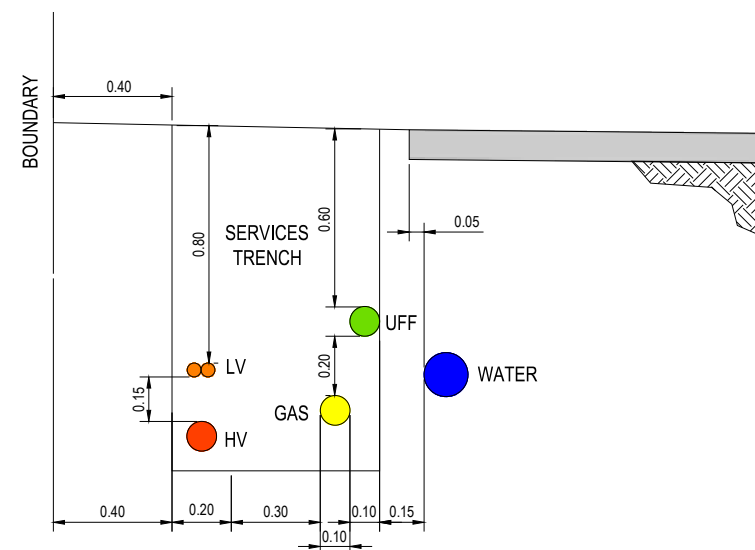

SERVICES TRENCH DETAILS
SCALE 1:40

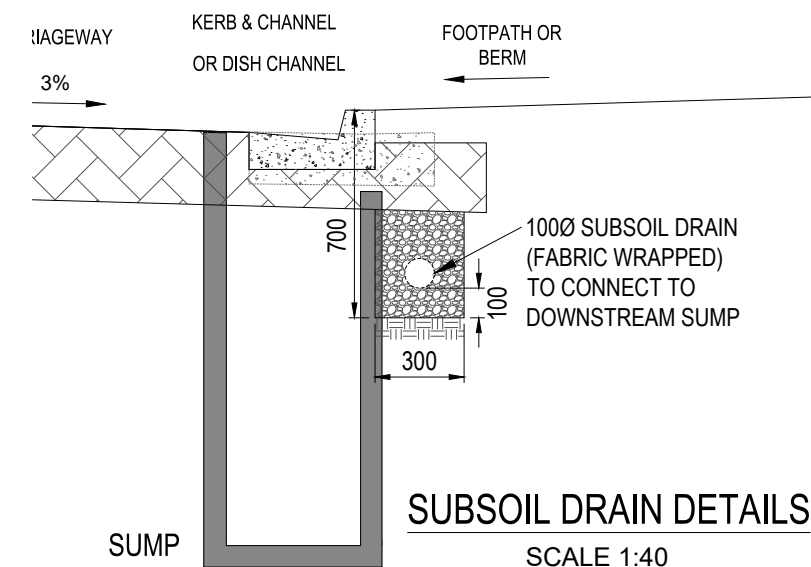

SUBSOIL DRAIN DETAILS
SCALE 1:40

NOTE:
SUBJECT TO FINAL DESIGN.
ALL DESIGNS TO BE IN ACCORDANCE
WITH THE RITS OR SPECIFIED
DEPARTURES ON DETAIL DESIGN.

Rev	DESCRIPTION	DRN	CKD	APP	DATE
0	Preliminary	GG	BG	PH	29.07.24
1	Layout Update	GG	HB	PH	19.08.24
2	Issued for RFI	GG	HB	PH	31.10.24
3	RFI Response	NW	HB	RH	16.04.25

NAME	DATE	NAME	DATE
SURVEYED	DESIGNED	GG	29.07.24

COORDINATE SYSTEM:
ORIGIN OF COORDINATES:
HEIGHT DATUM:
ORIGIN OF HEIGHT:
TITLE

**TYPICAL
CROSS-SECTIONS**

PREPARED FOR



ORIGINAL SCALES @ A3 STATUS

AS SHOWN APPROVAL

DO NOT SCALE DIMENSIONS DRAWING NO

24-30410-24D-R10

REVISION
3

COPYRIGHT ON THIS DRAWING IS RESERVED

R:\Project Files\30410-01-1901 Detail Design\G24-30410-24D_Stage 24_Road Design.dwg - Plotted: 17/04/2025

Refer to RFI tracker
for further design
and construction
amendments

Hamilton City Council
Development Engineering Unit
ACCEPTED ENGINEERING PLANS
Assessed for Related Resource Consent Conditions Only
Library Reference: 011.2019.00007140.025
Address: Greenhill Stage 24
Date: 7/05/2025

Subject to all notes and conditions affixed



S & L Land Specialists

Ph. 07 577 6069
Email: info@slip.co.nz
P.O. Box 231, Tauranga 3144
www.slip.co.nz

37.00															
OFFSET	-15.00	-14.00	-13.00	-12.00	-11.00	-10.00	-9.00	-8.00	-7.00	-6.00	-5.00	-4.00	-3.00	-2.00	-1.00
ORIGINAL LEVEL	38.88	38.87	38.85	38.85	38.86	38.88	38.86	38.84	38.84	38.85	38.86	38.88	38.88	38.90	38.92
FINISHED LEVEL															

SECTION: 30.000

37.00															
OFFSET	-15.00	-14.00	-13.00	-12.00	-11.00	-10.00	-9.00	-8.00	-7.00	-6.00	-5.00	-4.00	-3.00	-2.00	-1.00
ORIGINAL LEVEL															
FINISHED LEVEL															

SECTION: 25.000

37.00															
OFFSET	-15.00	-14.00	-13.00	-12.00	-11.00	-10.00	-9.00	-8.00	-7.00	-6.00	-5.00	-4.00	-3.00	-2.00	-1.00
ORIGINAL LEVEL															
FINISHED LEVEL															

SECTION: 20.000

37.00															
OFFSET	-15.00	-14.00	-13.00	-12.00	-11.00	-10.00	-9.00	-8.00	-7.00	-6.00	-5.00	-4.00	-3.00	-2.00	-1.00
ORIGINAL LEVEL															
FINISHED LEVEL															

SECTION: 15.000

37.00															
OFFSET	-15.00	-14.00	-13.00	-12.00	-11.00	-10.00	-9.00	-8.00	-7.00	-6.00	-5.00	-4.00	-3.00	-2.00	-1.00
ORIGINAL LEVEL	39.46	39.47	39.47	39.48	39.48	39.48	39.48	39.48	39.48	39.48	39.48	39.48	39.48	39.48	39.48
FINISHED LEVEL															

SECTION: 50.000

37.00															
OFFSET	-15.00	-14.00	-13.00	-12.00	-11.00	-10.00	-9.00	-8.00	-7.00	-6.00	-5.00	-4.00	-3.00	-2.00	-1.00
ORIGINAL LEVEL	39.52	39.54	39.53	39.54	39.53	39.52	39.51	39.51	39.51	39.52	39.52	39.53	39.53	39.54	39.55
FINISHED LEVEL															

SECTION: 45.000

37.00															
OFFSET	-15.00	-14.00	-13.00	-12.00	-11.00	-10.00	-9.00	-8.00	-7.00	-6.00	-5.00	-4.00	-3.00	-2.00	-1.00
ORIGINAL LEVEL	40.01	40.12	39.93	39.71	39.56	39.54	39.53	39.51	39.49	39.50	39.51	39.51	39.52	39.53	39.56
FINISHED LEVEL															

SECTION: 40.000

37.00															
OFFSET	-15.00	-14.00	-13.00	-12.00	-11.00	-10.00	-9.00	-8.00	-7.00	-6.00	-5.00	-4.00	-3.00	-2.00	-1.00
ORIGINAL LEVEL	39.63	39.68	39.70	39.70	39.66	39.71	39.53	39.53	39.52	39.51	39.50	39.50	39.49	39.49	39.48
FINISHED LEVEL															

SECTION: 35.000

NOTE:
SUBJECT TO FINAL DESIGN.
ALL DESIGNS TO BE IN ACCORDANCE
WITH THE RITS OR SPECIFIED
DEPARTURES ON DETAIL DESIGN.

Rev	DESCRIPTION	DRN	CKD	APP	DATE
0	Preliminary	GG	BG	PH	29.07.24
1	Layout Update	GG	HB	PH	19.08.24
2	RFI Response	NW	HB	RH	16.04.24

	NAME	DATE		NAME	DATE
SURVEYED			DESIGNED	GG	29.07.24

COORDINATE SYSTEM:
ORIGIN OF COORDINATES:
HEIGHT DATUM:
ORIGIN OF HEIGHT:

RADIATA STREET
EXTENSION
CROSS-SECTIONS

(CH 0+015 - CH 0+050)

PREPARED FOR



ORIGINAL SCALES @ A3	STATUS
1:250	APPROVAL
DO NOT SCALE DIMENSIONS	
DRAWING NO	REVISION
24-30410-24D-R11	2

COPYRIGHT ON THIS DRAWING IS RESERVED

R:\Project Files\30410-01-1901 Detail Design\G24-30410-24D_Stage 24_Road Design.dwg - Plotted: 17/04/2025

37.00									
OFFSET	-15.00								
ORIGINAL LEVEL	39.37	39.37	39.38	39.38	39.39	39.39	39.40	39.40	
FINISHED LEVEL									

SECTION: 72

37.00									
OFFSET	-15.00								
ORIGINAL LEVEL	39.40	39.40	39.39	39.38	39.39	39.39	39.39	39.40	
FINISHED LEVEL									

SECTION: 65.000

37.00									
OFFSET	-15.00								
ORIGINAL LEVEL	39.41	39.40	39.40	39.40	39.41	39.42	39.42	39.43	
FINISHED LEVEL									

SECTION: 60.000

37.00									
OFFSET	-15.00								
ORIGINAL LEVEL	39.44	39.45	39.45	39.45	39.45	39.45	39.45	39.45	
FINISHED LEVEL									

SECTION: 55.000

37.00									
OFFSET	-15.00								
ORIGINAL LEVEL	39.36	39.36	39.35	39.33	39.32	39.31	39.31	39.32	
FINISHED LEVEL									

SECTION: 75.000

Refer to RFI tracker
for further design
and construction
amendments

Hamilton City Council
Development Engineering Unit

ACCEPTED ENGINEERING PLANS

Assessed for Related Resource Consent Conditions Only

Library Reference: 011.2019.00007140.025

Address: Greenhill Stage 24

Date: 7/05/2025

Subject to all notes and conditions affixed

S & L

S & L Land Specialists

Ph. 07 577 6069
Email: info@slip.co.nz
P.O. Box 231, Tauranga 3144
www.slip.co.nz

NOTE:
SUBJECT TO FINAL DESIGN.
ALL DESIGNS TO BE IN ACCORDANCE
WITH THE RITS OR SPECIFIED
DEPARTURES ON DETAIL DESIGN.

Rev	DESCRIPTION	DRN	CKD	APP	DATE
0	Preliminary	GG	BG	PH	29.07.24
1	Layout Update	GG	HB	PH	19.08.24
2	RFI Response	NW	HB	RH	16.04.25

SURVEYED

NAME

DATE

DESIGNED

NAME

DATE

COORDINATE SYSTEM:

ORIGIN OF COORDINATES:

HEIGHT DATUM:

ORIGIN OF HEIGHT:

TITLE

RADIATA STREET
EXTENSION
CROSS-SECTIONS

(CH 0+055 - CH 0+075)

PREPARED FOR

GREENHILL
PROPERTIES

Chedworth
Properties Limited

ORIGINAL SCALES @ A3

1:250

DO NOT SCALE DIMENSIONS

DRAWING NO

24-30410-24D-R12


STATUS

APPROVAL

REVISION

2

R:\Project Files\30410-01-1901 Detail Design\G24-30410-24D_Stage 24_Road Design.dwg - Plotted: 17/04/2025

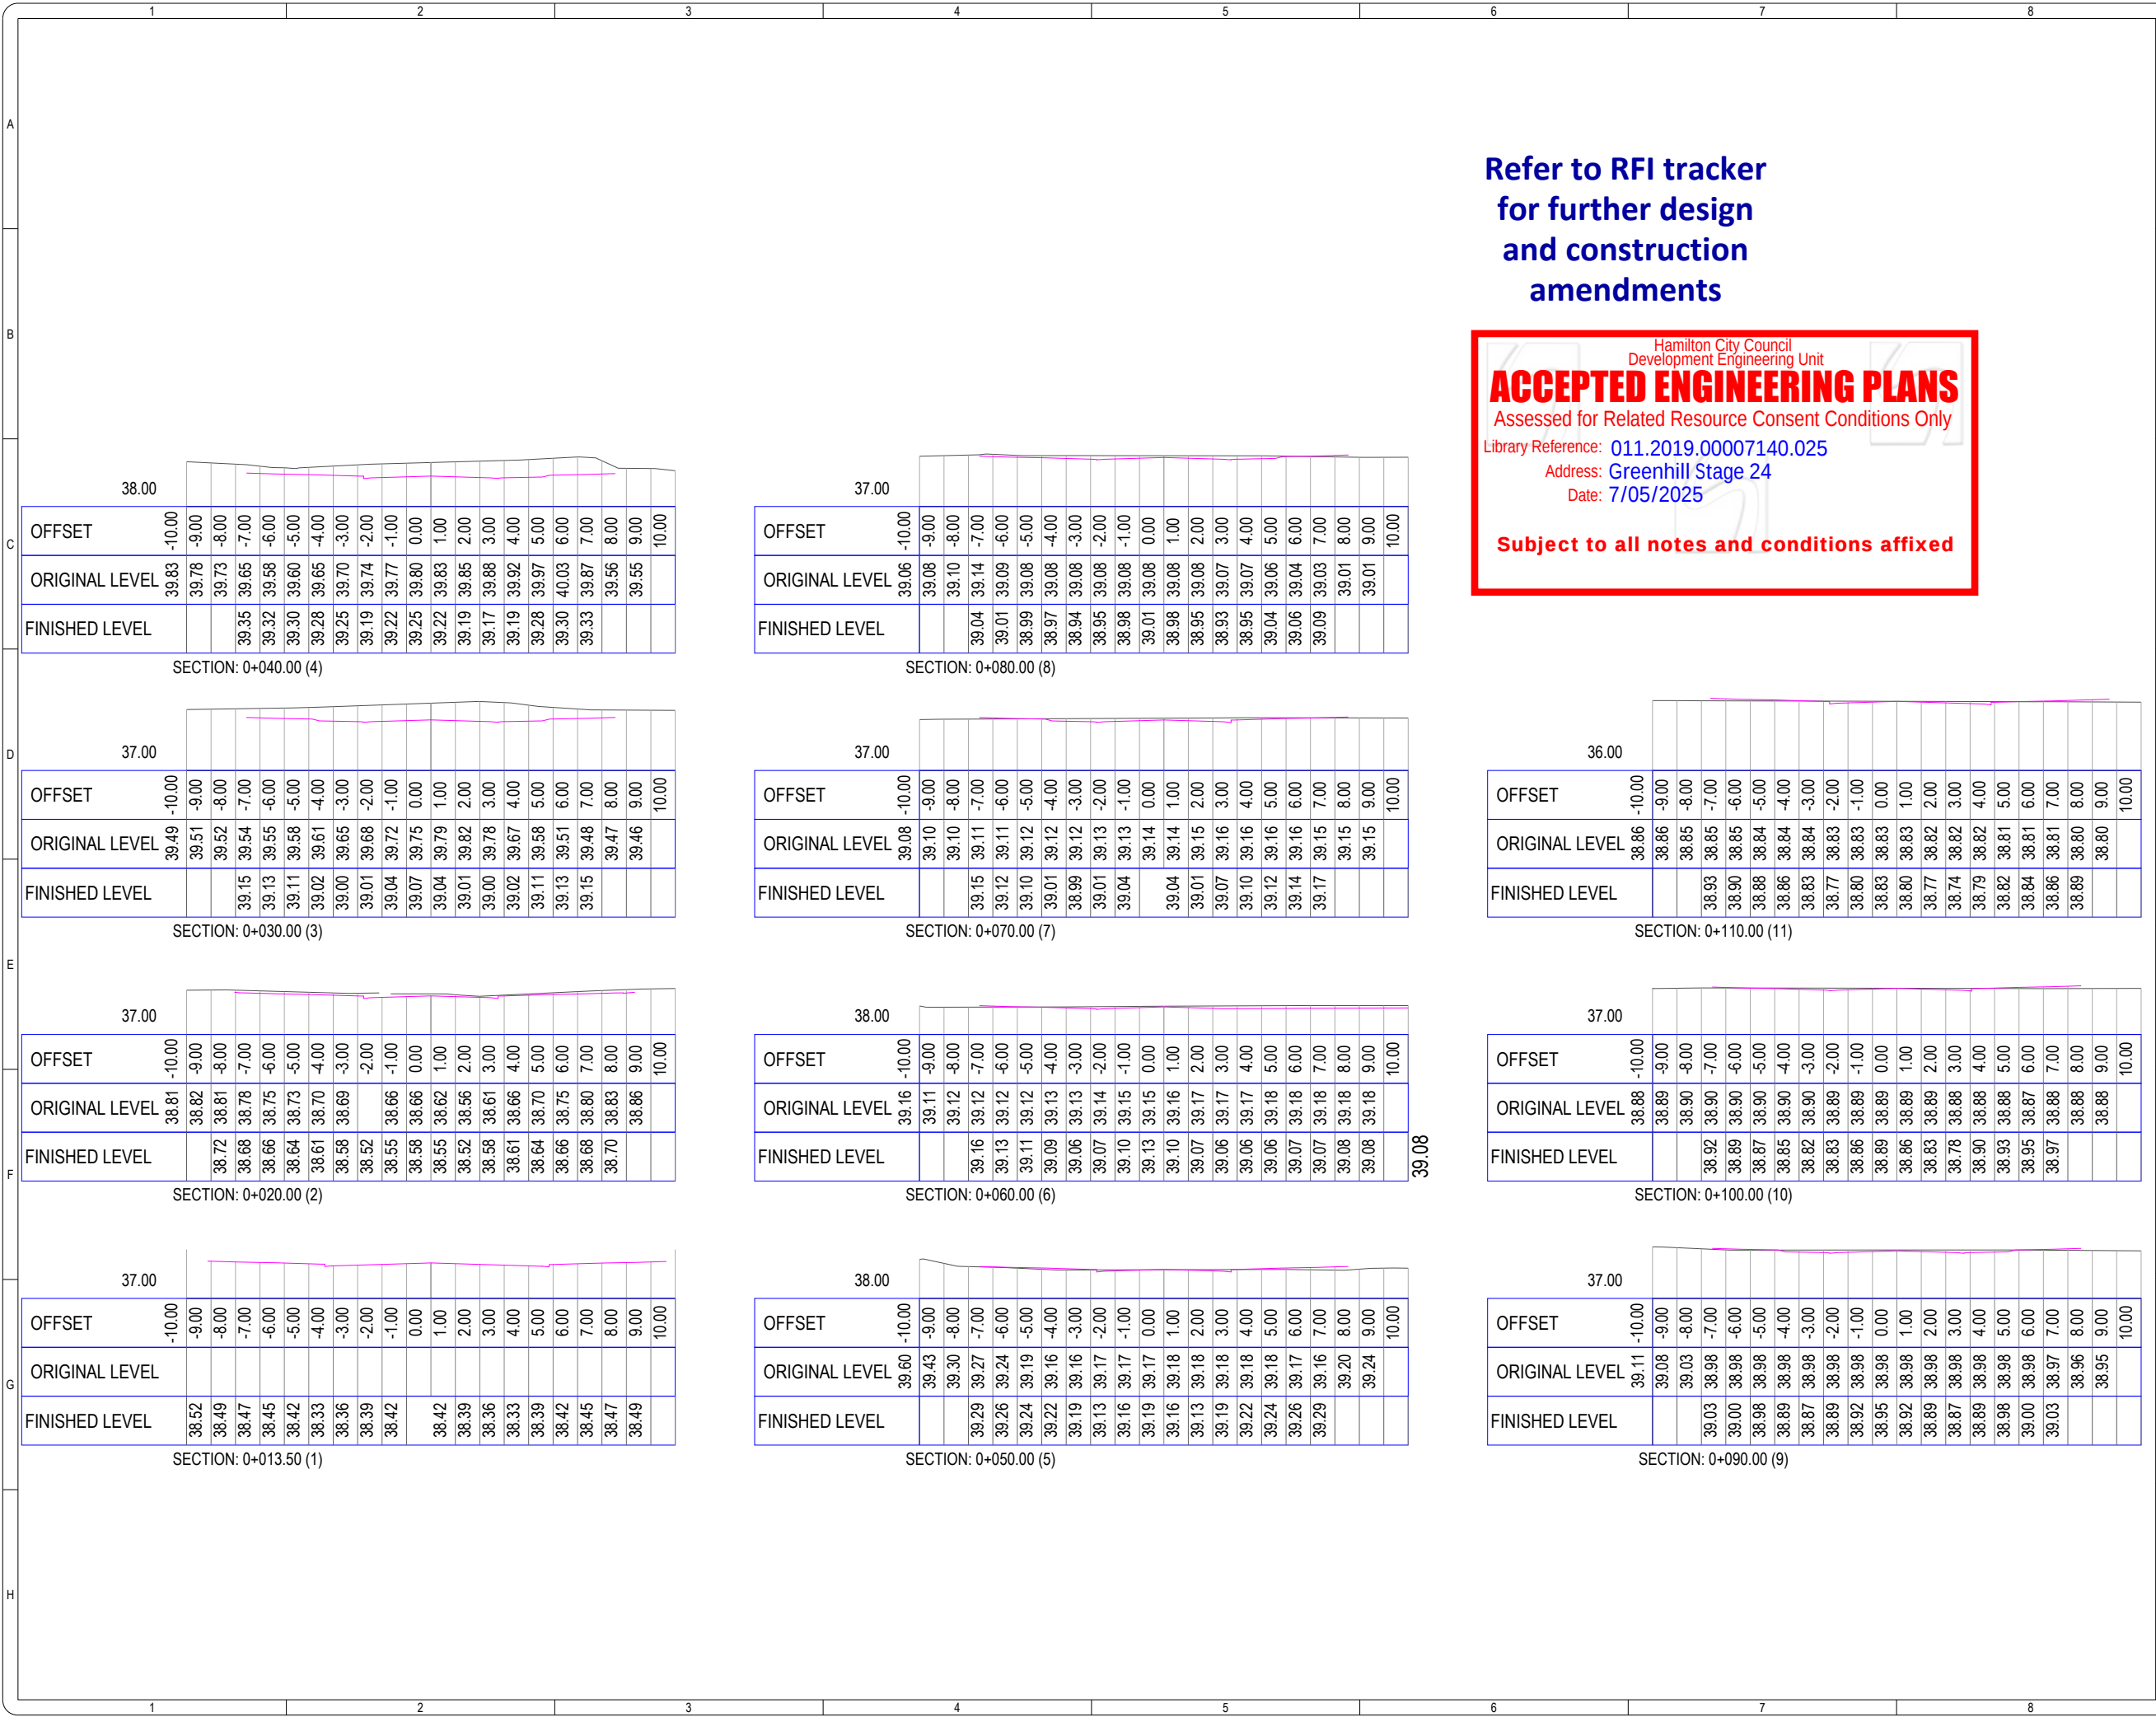



S & L Land Specialists
Ph. 07 577 6069
Email: info@slip.co.nz
P.O. Box 231, Tauranga 3144
www.slip.co.nz

NOTE:
SUBJECT TO FINAL DESIGN.
ALL DESIGNS TO BE IN ACCORDANCE
WITH THE RITS OR SPECIFIED
DEPARTURES ON DETAIL DESIGN.

Rev	DESCRIPTION	DRN	CKD	APP	DATE
0	Preliminary	GG	BG	PH	29.07.24
1	Layout Update	GG	HB	PH	19.08.24

	NAME	DATE		NAME	DATE
SURVEYED			DESIGNED	GG	29.07.24

COORDINATE SYSTEM:

ORIGIN OF COORDINATES:

HEIGHT DATUM:

ORIGIN OF HEIGHT:

TITLE

**RALEIGH AVENUE
EXTENSION
CROSS-SECTIONS**

(CH 0+010 - CH 0+110)

PREPARED FOR



ORIGINAL SCALES @ A3 STATUS

1:250 APPROVAL


DO NOT SCALE DIMENSIONS

DRAWING NO 24-30410-24D-R13 REVISION 1

COPYRIGHT ON THIS DRAWING IS RESERVED

[illegible]

R:\Project Files\30410-01-1901 Detail Design\G24-30410-24D_Stage 24_Road Design.dwg - Plotted: 17/04/2025

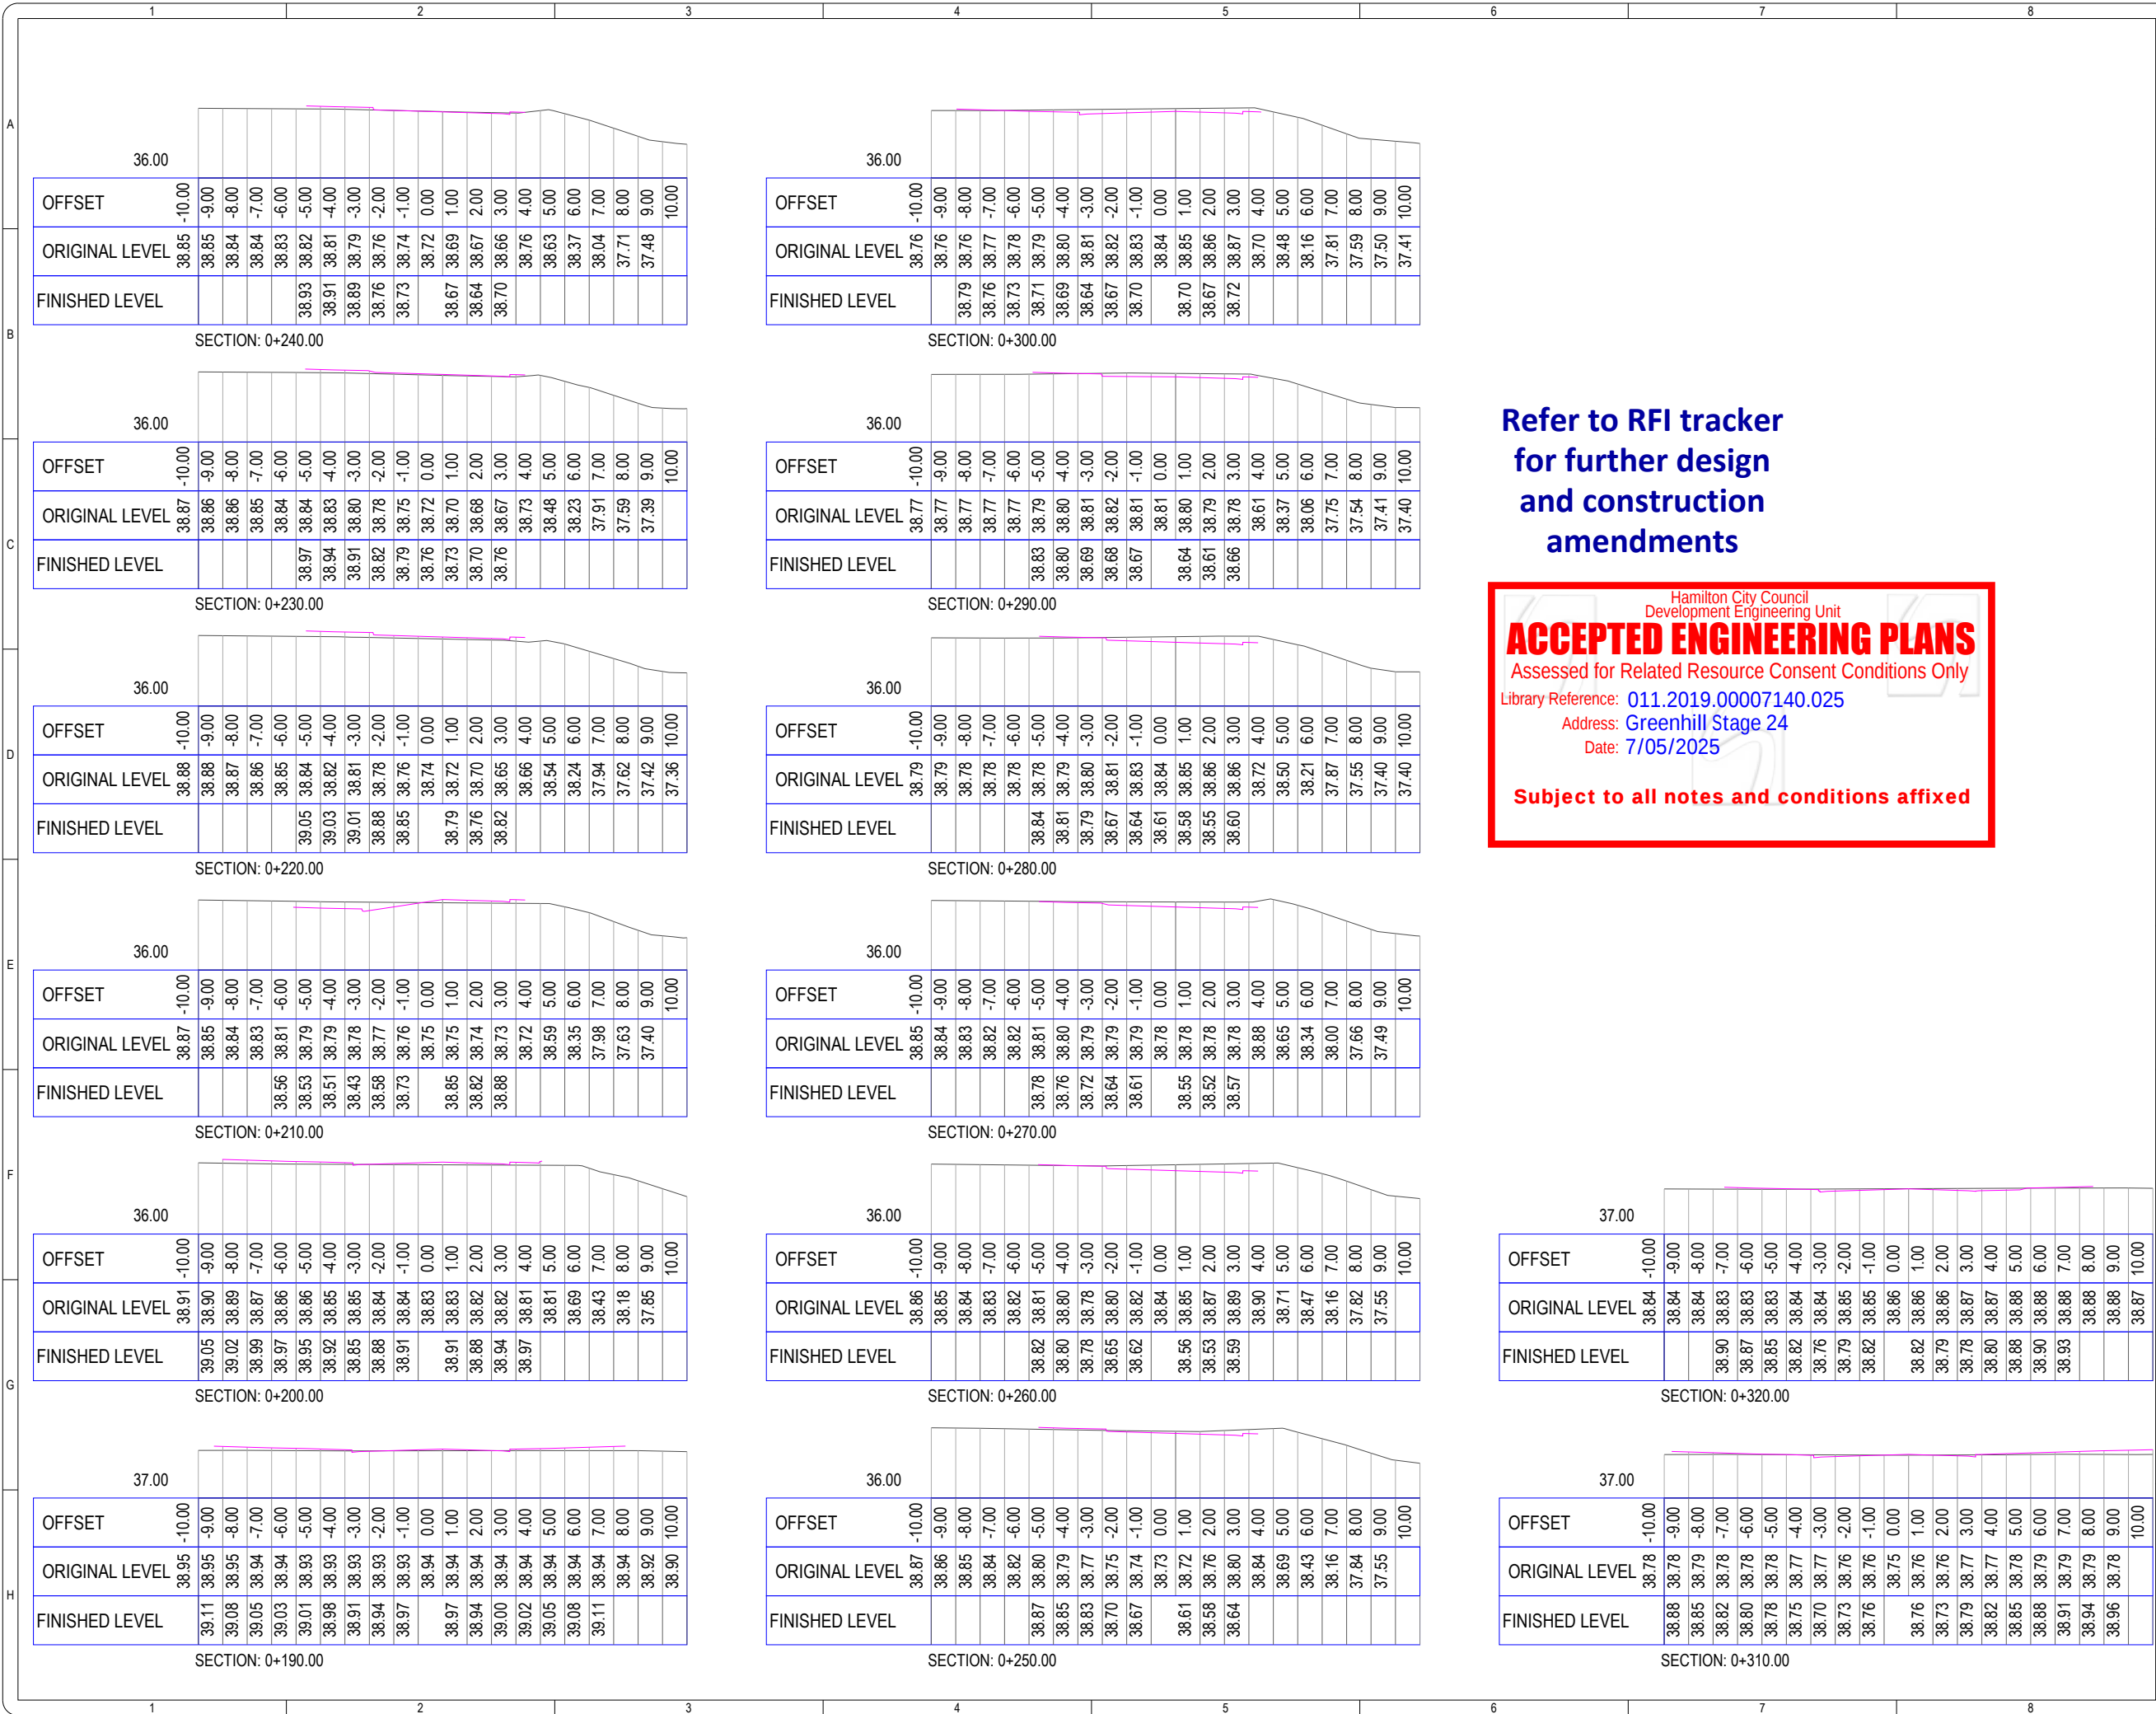

Refer to RFI tracker
for further design
and construction
amendments

Hamilton City Council
Development Engineering Unit

ACCEPTED ENGINEERING PLANS
Assessed for Related Resource Consent Conditions Only
Library Reference: 011.2019.00007140.025
Address: Greenhill Stage 24
Date: 7/05/2025

Subject to all notes and conditions affixed

**S & L Land Specialists**
Ph. 07 577 6069
Email: info@slip.co.nz
P.O. Box 231, Tauranga 3144
www.slip.co.nz

NOTE:
SUBJECT TO FINAL DESIGN.
ALL DESIGNS TO BE IN ACCORDANCE
WITH THE RITS OR SPECIFIED
DEPARTURES ON DETAIL DESIGN.

Rev	DESCRIPTION	DRN	CKD	APP	DATE
0	Preliminary	GG	BG	PH	29.07.24
1	Layout Update	GG	HB	PH	19.08.24
2	RFI Response	NW	HB	RH	16.04.25

	NAME	DATE		NAME	DATE
SURVEYED			DESIGNED	GG	29.07.24

COORDINATE SYSTEM:
ORIGIN OF COORDINATES:
HEIGHT DATUM:
ORIGIN OF HEIGHT:

TITLE

**JACQUES TERRACE
CROSS-SECTIONS**

(CH 0+190 - CH 0+320)

PREPARED FOR



ORIGINAL SCALES @ A3	STATUS
1:250 DO NOT SCALE DIMENSIONS	APPROVAL

DRAWING NO	REVISION
24-30410-24D-R15	2

COPYRIGHT ON THIS DRAWING IS RESERVED



S & L Land Specialists

Ph: 07 577 6081
Email: info@sls.co.nz
P.O. Box 231, Tauranga 31144
www.sls.co.nz

LEGEND:

SWALE DESIGN

NOTE:
ALL DESIGNS TO BE IN ACCORDANCE
WITH THE RITS OR SPECIFIED
DEPARTURES ON DETAIL DESIGN.

Rev	DESCRIPTION	OWN	CHK	APP	DATE
0	Preliminary	GG	SG	PH	29.07.24
1	Layout Update	GG	HB	PH	19.08.24
2	Design Update	TM	RH	PH	25.11.24
3	Issued for RFI	TM		PH	07.04.25
4	RFI Response	NW	HB	RH	16.04.25
5	RFI Response	TM	HB	RH	28.04.25
6	RFI Response Scale 1:2	RH	HB	RH	06.05.25

SURVEYED	DATE	DESIGNED	DATE
		GG	29.07.24
COORDINATE SYSTEM			
ORIGIN OF COORDINATES:			
HEIGHT DATUM:			
ORIGIN OF HEIGHT:			
TITLE			

SWALE - WEST
PLAN AND
LONG SECTION

PREPARED FOR:



ORIGINAL SCALES @ A3	STATUS
AS SHOWN	APPROVAL
DO NOT SCALE DIMENSIONS	
DRAWING NO	REVISION
24-30410-24D-R18	6


COPYRIGHT 1991 THIS DRAWING IS SP5000071



SWALE-WEST - PLAN

HAMILTON CITY COUNCIL
Development Engineering Unit
ACCEPTED ENGINEERING PLANS
Assessed for Related Resource Consent Conditions Only
Library Reference: 011.2019.00007140.025
Address: Greenhill Stage 24
Date: 7/05/2025
Subject to all notes and conditions affixed

Refer to RFI tracker
for further design
and construction
amendments

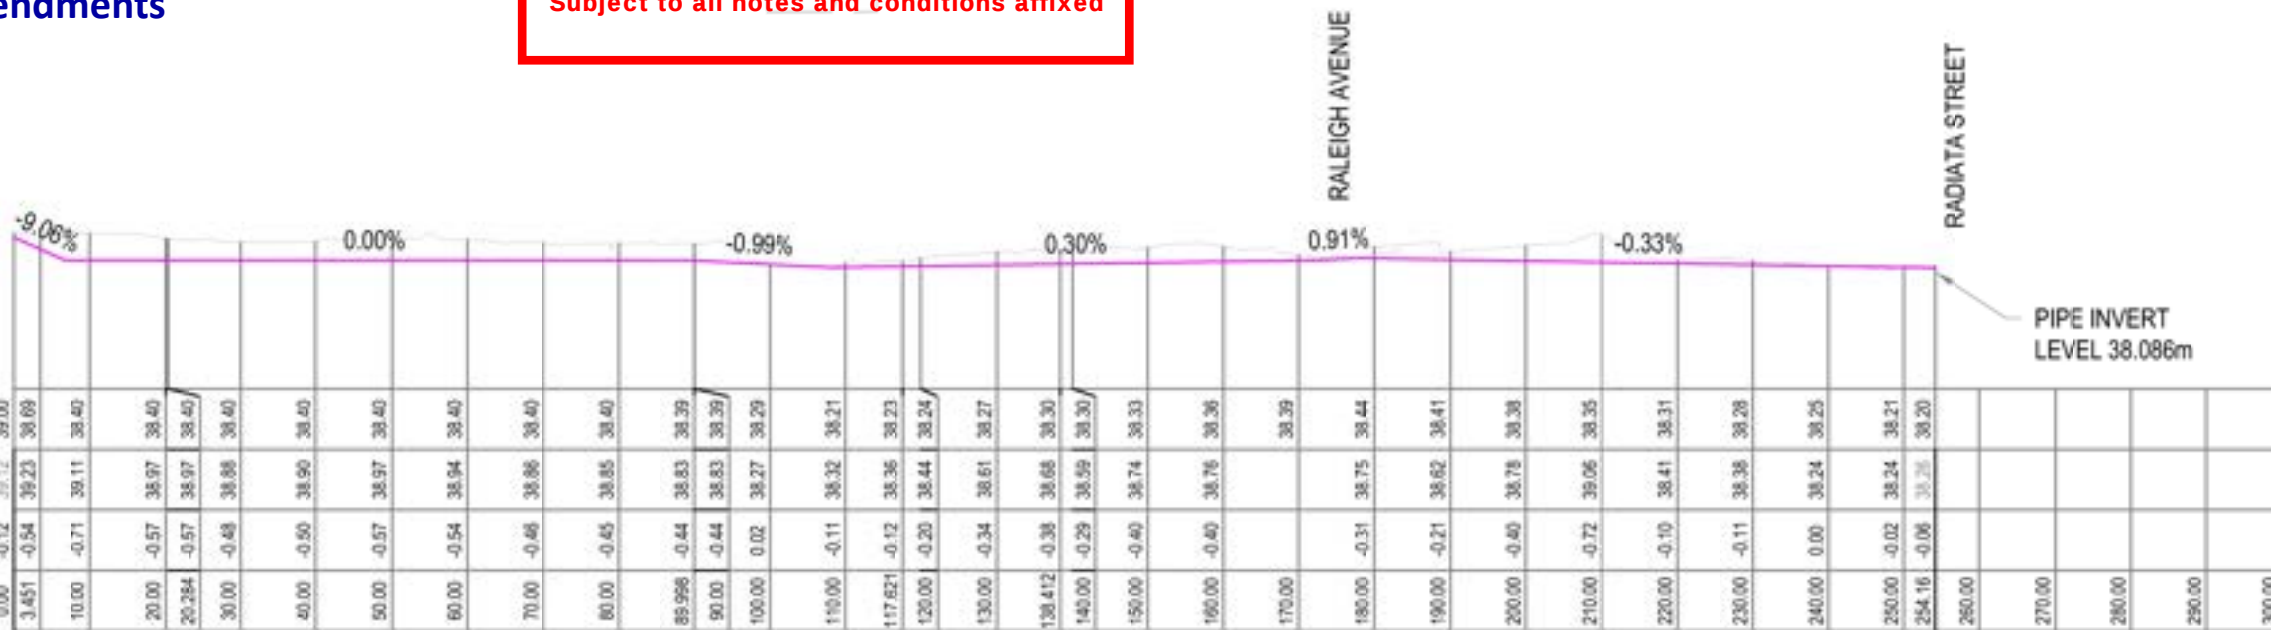

SWALE - WEST - LONG SECTION (From CH 0+000 to CH 0+170 & From CH 0+180 to CH 0+254.16)
Scale - H: 1:1000 V: 1:200

VERT EXAG 1:5
DATUM ELEV: 35.00

DESIGN LEVELS
EXISTING LEVELS
DEPTH
CHAINAGE



S & L Land Specialists

Ph: 07 577 6081
Email: info@sl.co.nz
P.O. Box 231, Tauranga 3144
www.sl.co.nz

LEGEND:

PROPOSED SURFACE

EXISTING GROUND

Refer to RFI tracker
for further design
and construction
amendments

ACCEPTED ENGINEERING PLANS
Assessed for Related Resource Consent Conditions Only

Library Reference: 011.2019.00007140.025

Address: Greenhill Stage 24

Date: 7/05/2025

Subject to all notes and conditions affixed

NOTE:
ALL DESIGNS TO BE IN ACCORDANCE
WITH THE RITS OR SPECIFIED
DEPARTURES ON DETAIL DESIGN.

Rev	DESCRIPTION	OWN	CHK	APP	DATE
3	Ext'd GL & Swale IL Added	TM	RH	PH	02.12.24
4	Issued for RFI	TM	HB	PH	07.04.25
5	RFI Responses	TM	RH	PH	16.04.25
6	RFI Responses	TM	HB	RH	28.04.25
7	RFI Responses Swale 12	RH	HB	RH	06.05.25

NAME	DATE	NAME	DATE
SURVEYED		DESIGNED	GG 29.07.24
COORDINATE SYSTEM			
ORIGIN OF COORDINATES:			
HEIGHT DATUM			
ORIGIN OF HEIGHT:			
TITLE			

**SWALE - WEST
CROSS-SECTIONS**
(From Ch 0+000 to Ch. 0+190)

PREPARED FOR:




ORIGINAL SCALES @ A3 STATUS
1:200 APPROVAL

DRAWING NO. 24-30410-24D-R19

REVISION 7

Copyright 1991-2025 S&L Land Specialists

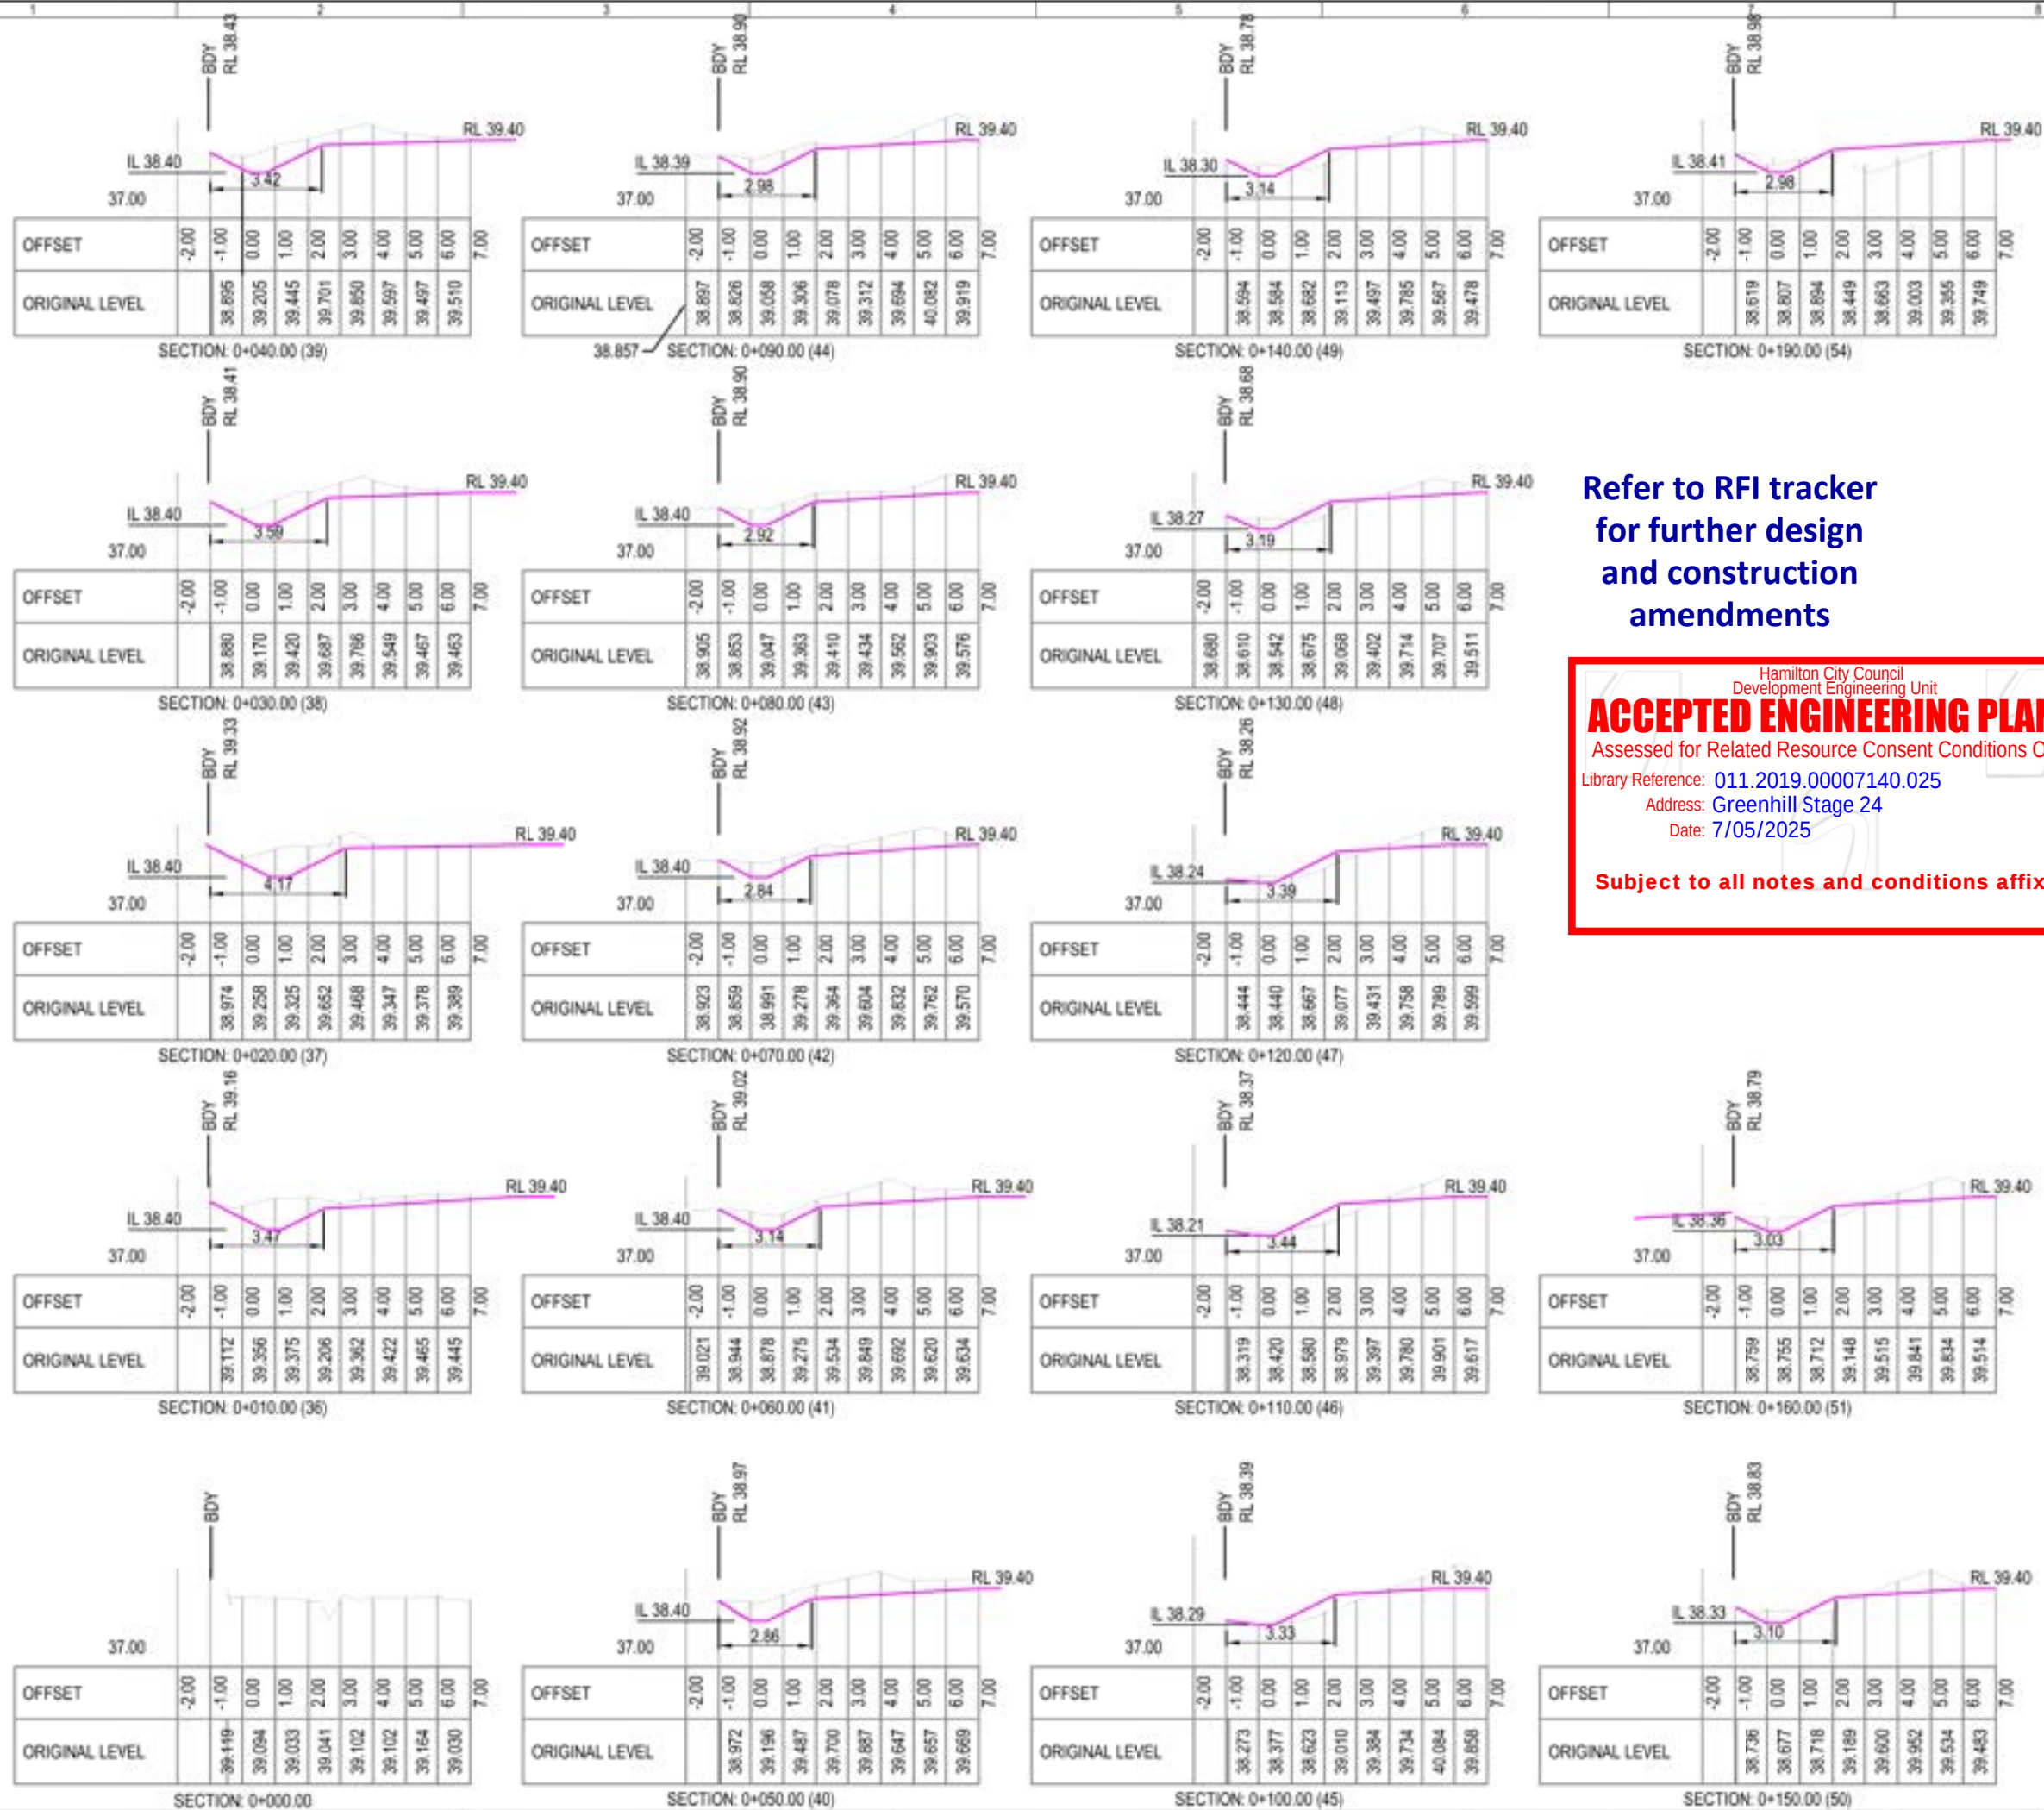



S & L Land Specialists

Ph: 07 577 4068
Email: info@slp.co.nz
P.O. Box 231, Tauranga 3144
www.slp.co.nz

LEGEND:

PROPOSED SURFACE
EXISTING GROUND

NOTE:
ALL DESIGNS TO BE IN ACCORDANCE
WITH THE RITS OR SPECIFIED
DEPARTURES ON DETAIL DESIGN.

Rev	DESCRIPTION	CHKD	CRKD	APP	DATE
3	Final GL & Swale L Added	TM	RH	PH	02.12.24
4	Issued for RFI	TM	RH	PH	07.04.25
5	RFI Response	TM	RH	PH	16.04.25
6	RFI Response	TM	HB	RH	28.04.25
7	RFI Response Swale 1.2	RH	HB	RH	06.05.25

NAME	DATE	NAME	DATE
SURVEYED		DESIGNED	OG 29.07.24

COORDINATE SYSTEM:

ORIGIN OF COORDINATES:

HEIGHT DATUM:

ORIGIN OF HEIGHT:

TITLE

SWALE - WEST
CROSS-SECTIONS
(From Ch 0+200 tp Ch. 0+240)

PREPARED FOR



ORIGINAL SCALES @ A3 STATUS

1:200

APPROVAL

DO NOT SCALE DIMENSIONS

DRAWING NO

REVISION

24-30410-24D-R20

7

COPYRIGHT ON THIS DRAWING IS RESERVED

Refer to RFI tracker
for further design
and construction
amendments

Hamilton City Council
Development Engineering Unit
ACCEPTED ENGINEERING PLANS


Assessed for Related Resource Consent Conditions Only

Library Reference: 011.2019.00007140.025

Address: Greenhill Stage 24

Date: 7/05/2025

Subject to all notes and conditions affixed

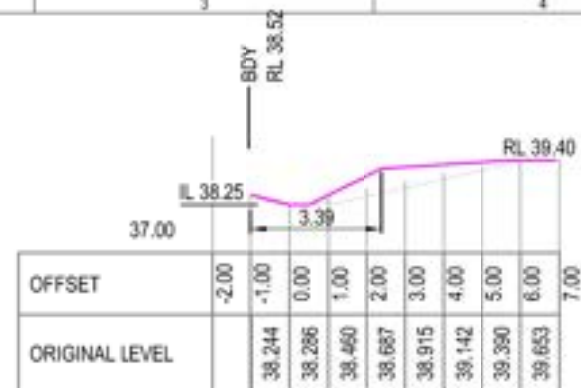


SECTION: 0+240.00 (59)



SECTION: 0+230.00 (58)



SECTION: 0+220.00 (57)

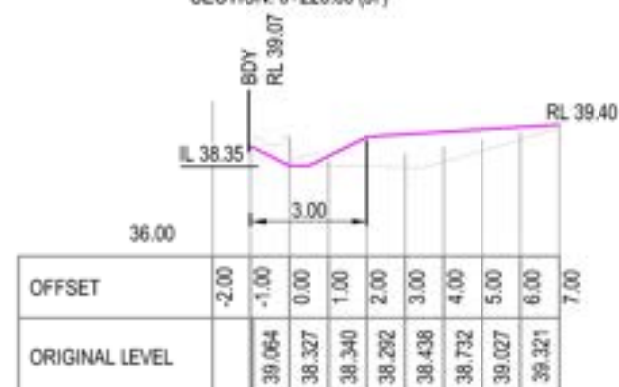

SECTION: 0+210.00 (56)



SECTION: 0+200.00 (55)

R:\Project Files\30410-01-1901 Detail Design\G24-30410-24D_Stage 24_Road Design.dwg - Plotted: 17/04/2025

Refer to RFI tracker
for further design
and construction
amendments

Hamilton City Council
Development Engineering Unit

ACCEPTED ENGINEERING PLANS
Assessed for Related Resource Consent Conditions Only
Library Reference: 011.2019.00007140.025
Address: Greenhill Stage 24
Date: 7/05/2025

Subject to all notes and conditions affixed


**S & L Land Specialists**
Ph. 07 577 6069
Email: info@slip.co.nz
P.O. Box 231, Tauranga 3144
www.slip.co.nz

LEGEND:

-2.2m ~ -0.3m

-0.3m ~ 0.3m

0.3m ~ 1.8m

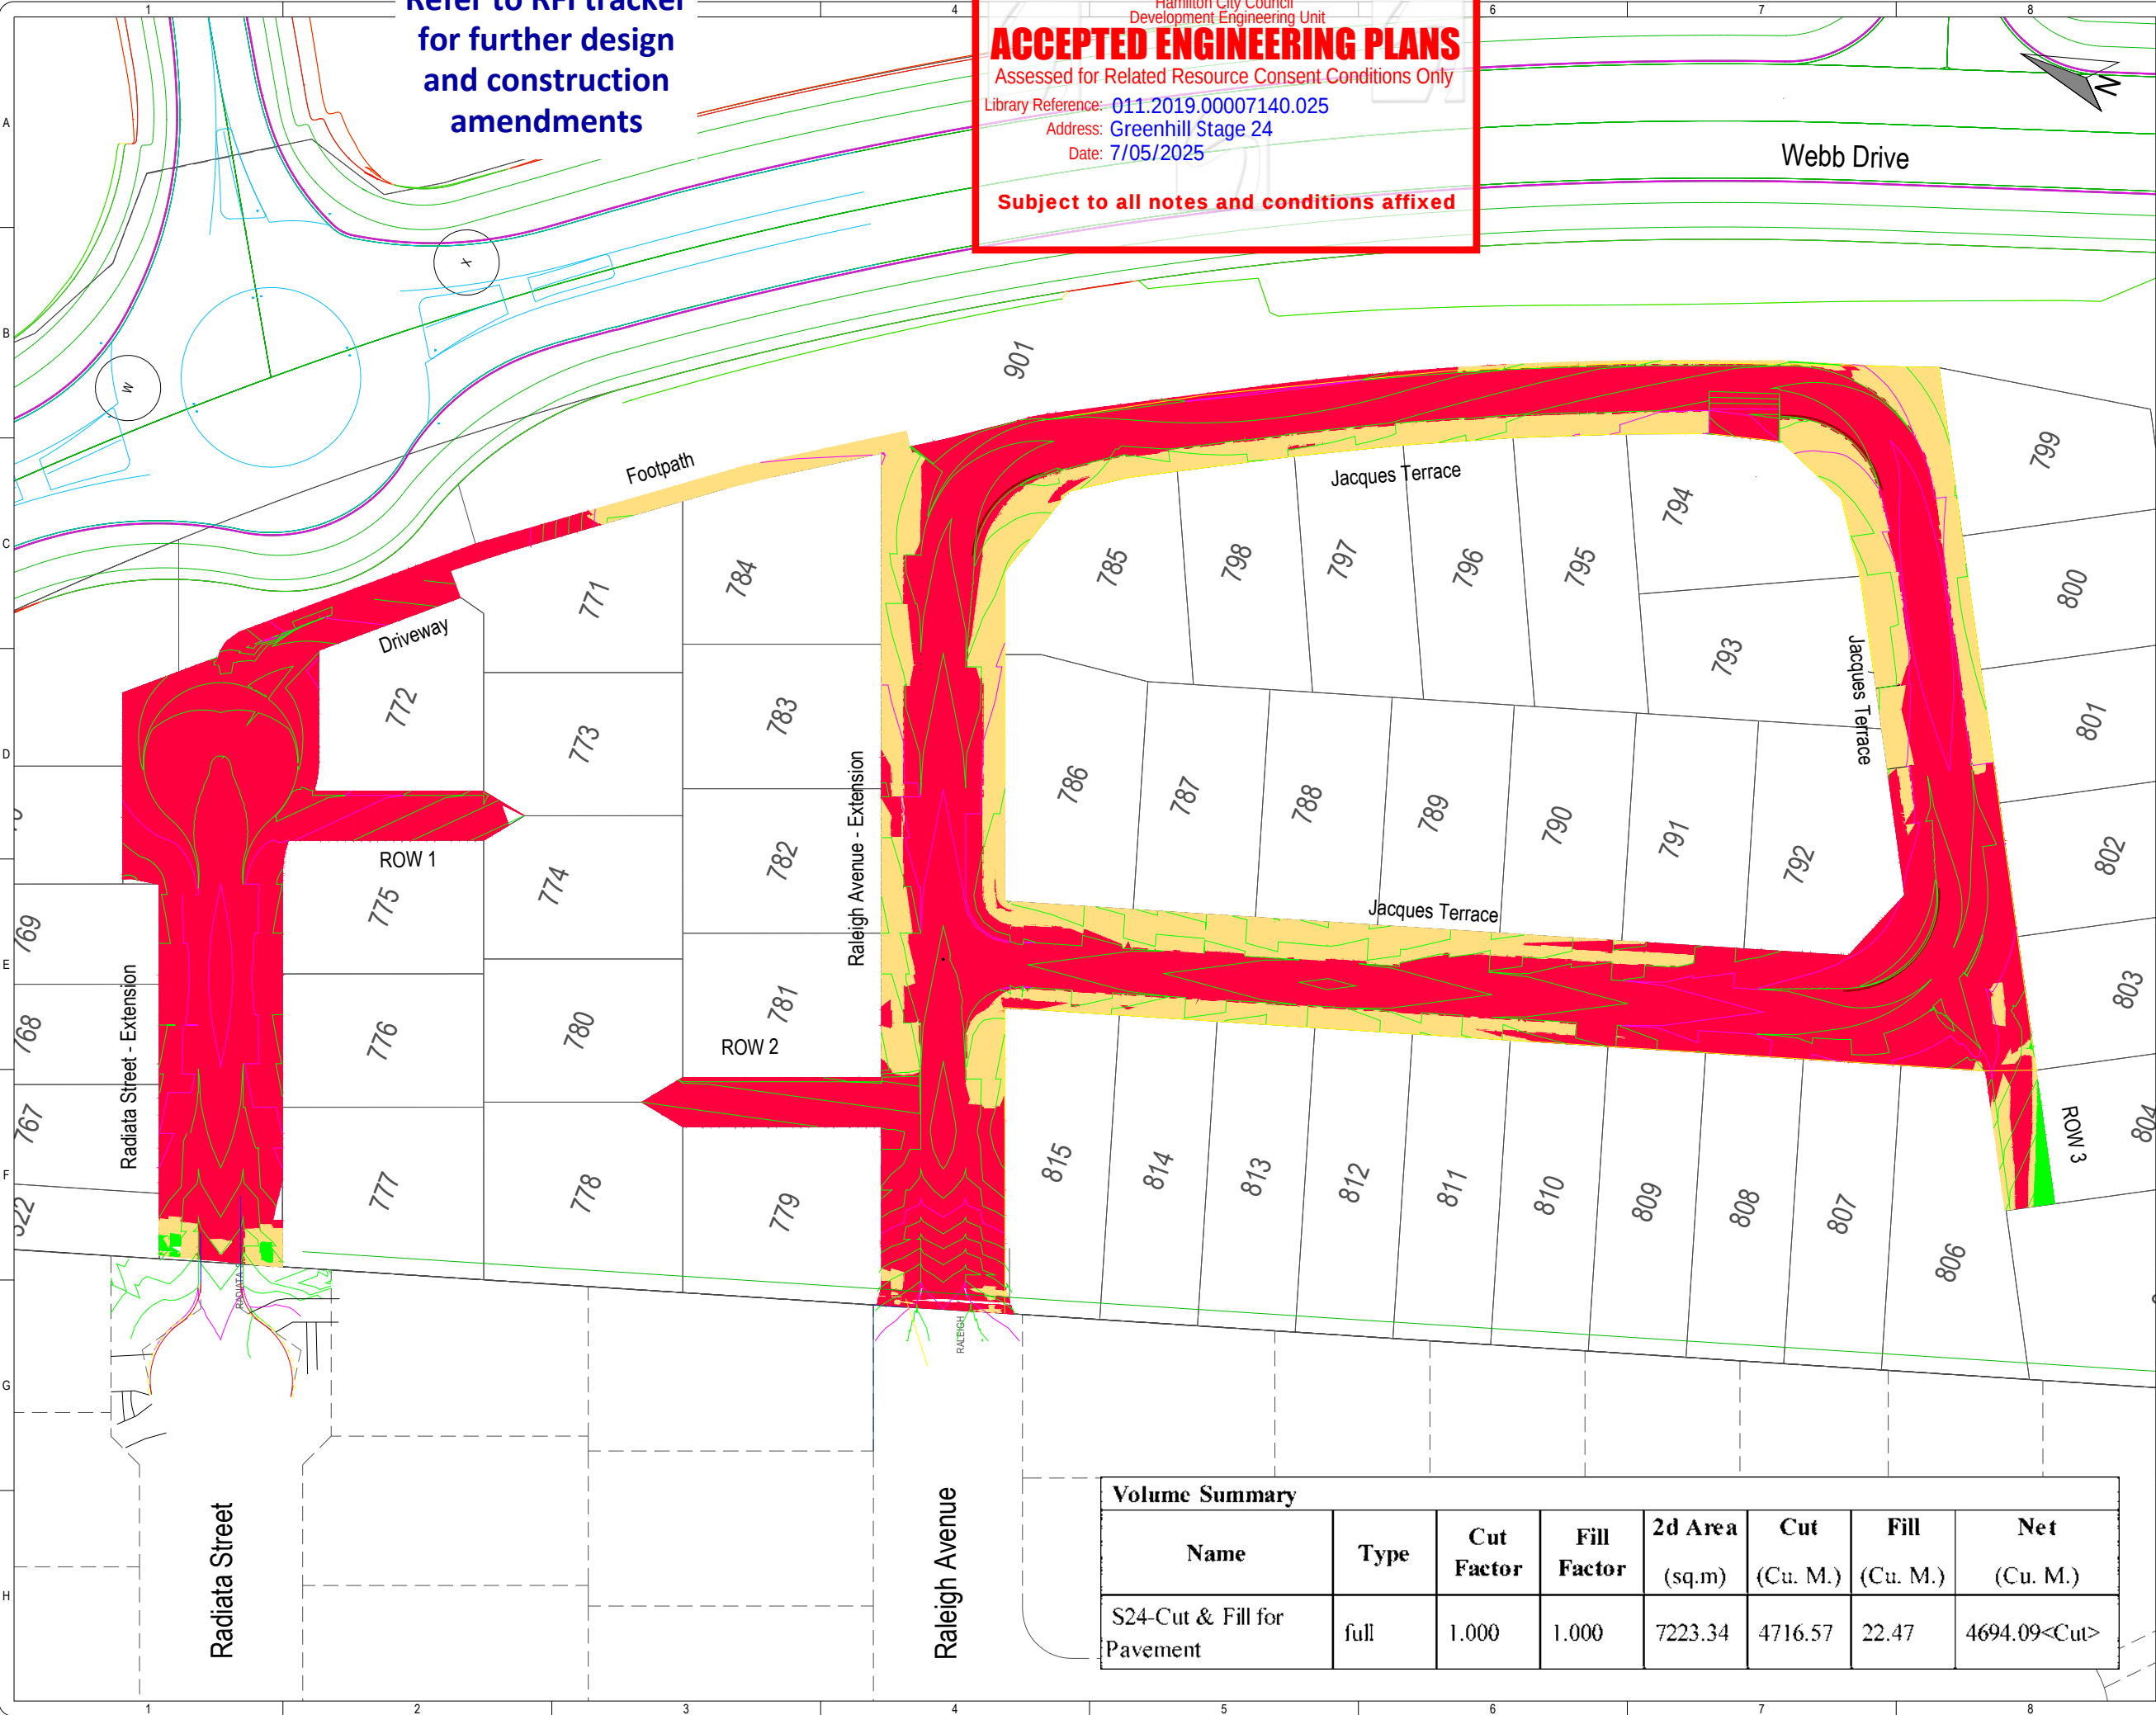

Rev	DESCRIPTION	DRN	CKD	APP	DATE
0	Preliminary	GG	HB	PH	04.10.24
1	Issued for RFI	GG	GG	PH	06.11.24
2	RFI Response	NW	HB	RH	16.04.25

SURVEYED	NAME	DATE	DESIGNED	NAME	DATE
			GG		04.10.24
COORDINATE SYSTEM:					
ORIGIN OF COORDINATES:					
HEIGHT DATUM:					
ORIGIN OF HEIGHT:					
TITLE					

CUT & FILL PLAN
FOR ROAD WORKS
STAGE 24

PREPARED FOR



ORIGINAL SCALES @ A3	STATUS
1:750	APPROVAL
DO NOT SCALE DIMENSIONS	
DRAWING NO	REVISION
24-30410-24D-R21	2

COPYRIGHT ON THIS DRAWING IS RESERVED

Volume Summary

Name	Type	Cut Factor	Fill Factor	2d Area (sq.m)	Cut (Cu. M.)	Fill (Cu. M.)	Net (Cu. M.)
S24-Cut & Fill for Pavement	full	1.000	1.000	7223.34	4716.57	22.47	4694.09<Cut>



S & L Land Specialists

Ph. 07 577 6069
Email: info@slip.co.nz
P.O. Box 231, Tauranga 3144
www.slip.co.nz

Refer to RFI tracker
for further design
and construction
amendments

Hamilton City Council
Development Engineering Unit

ACCEPTED ENGINEERING PLANS


Assessed for Related Resource Consent Conditions Only

Library Reference: 011.2019.00007140.025


Address: Greenhill Stage 24

Date: 7/05/2025


Subject to all notes and conditions affixed

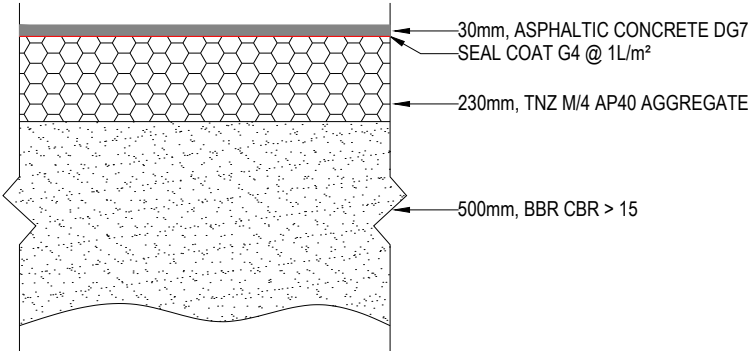

PAVEMENT DETAILS FOR LOCAL ROAD
FOR THE RADIATA STREET EXTENSION & RALEIGH AVENUE EXTENSIONS & JACQUES TERRACE
SCALE 1:20

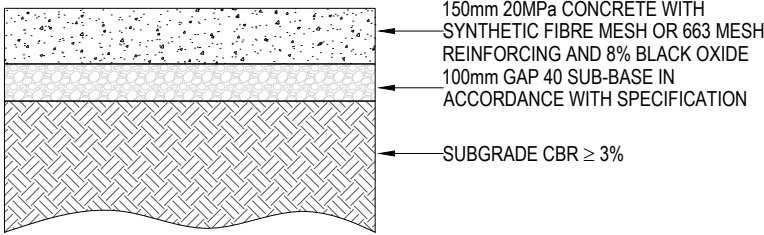

PAVEMENT TYPE I
PARKING BAY \ DRIVEWAY
COMBINED MAINTENANCE ACCESS
SCALE 1:20

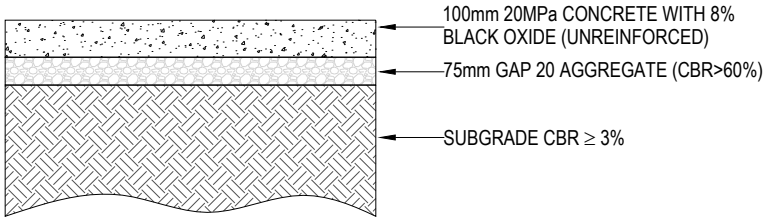

PAVEMENT TYPE H
CONCRETE FOOTPATH &
SHARED PATH
SCALE 1:20

NOTE:
SUBJECT TO FINAL DESIGN.
ALL DESIGNS TO BE IN ACCORDANCE
WITH THE RITS OR SPECIFIED
DEPARTURES ON DETAIL DESIGN.

Rev	DESCRIPTION	DRN	CKD	APP	DATE
1	Preliminary	GG	BG	PH	04.10.24
2	Issued for RFI	GG	BG	PH	06.11.24
3	RFI Response	NW	HB	RH	16.04.25

SURVEYED	NAME	DATE	DESIGNED	NAME	DATE
			GG		04.10.24

COORDINATE SYSTEM:
ORIGIN OF COORDINATES:
HEIGHT DATUM:
ORIGIN OF HEIGHT:

TITLE

PAVEMENT DETAILS

PREPARED FOR




ORIGINAL SCALES @ A3 STATUS
AS SHOWN APPROVAL

DO NOT SCALE DIMENSIONS
DRAWING NO. REVISION

24-30410-24D-R22 2

COPYRIGHT ON THIS DRAWING IS RESERVED

R:\Project Files\30410-01-1901 Detail Design\G24-30410-24D_Stage 24_Road Design.dwg - Plotted: 29/04/2025

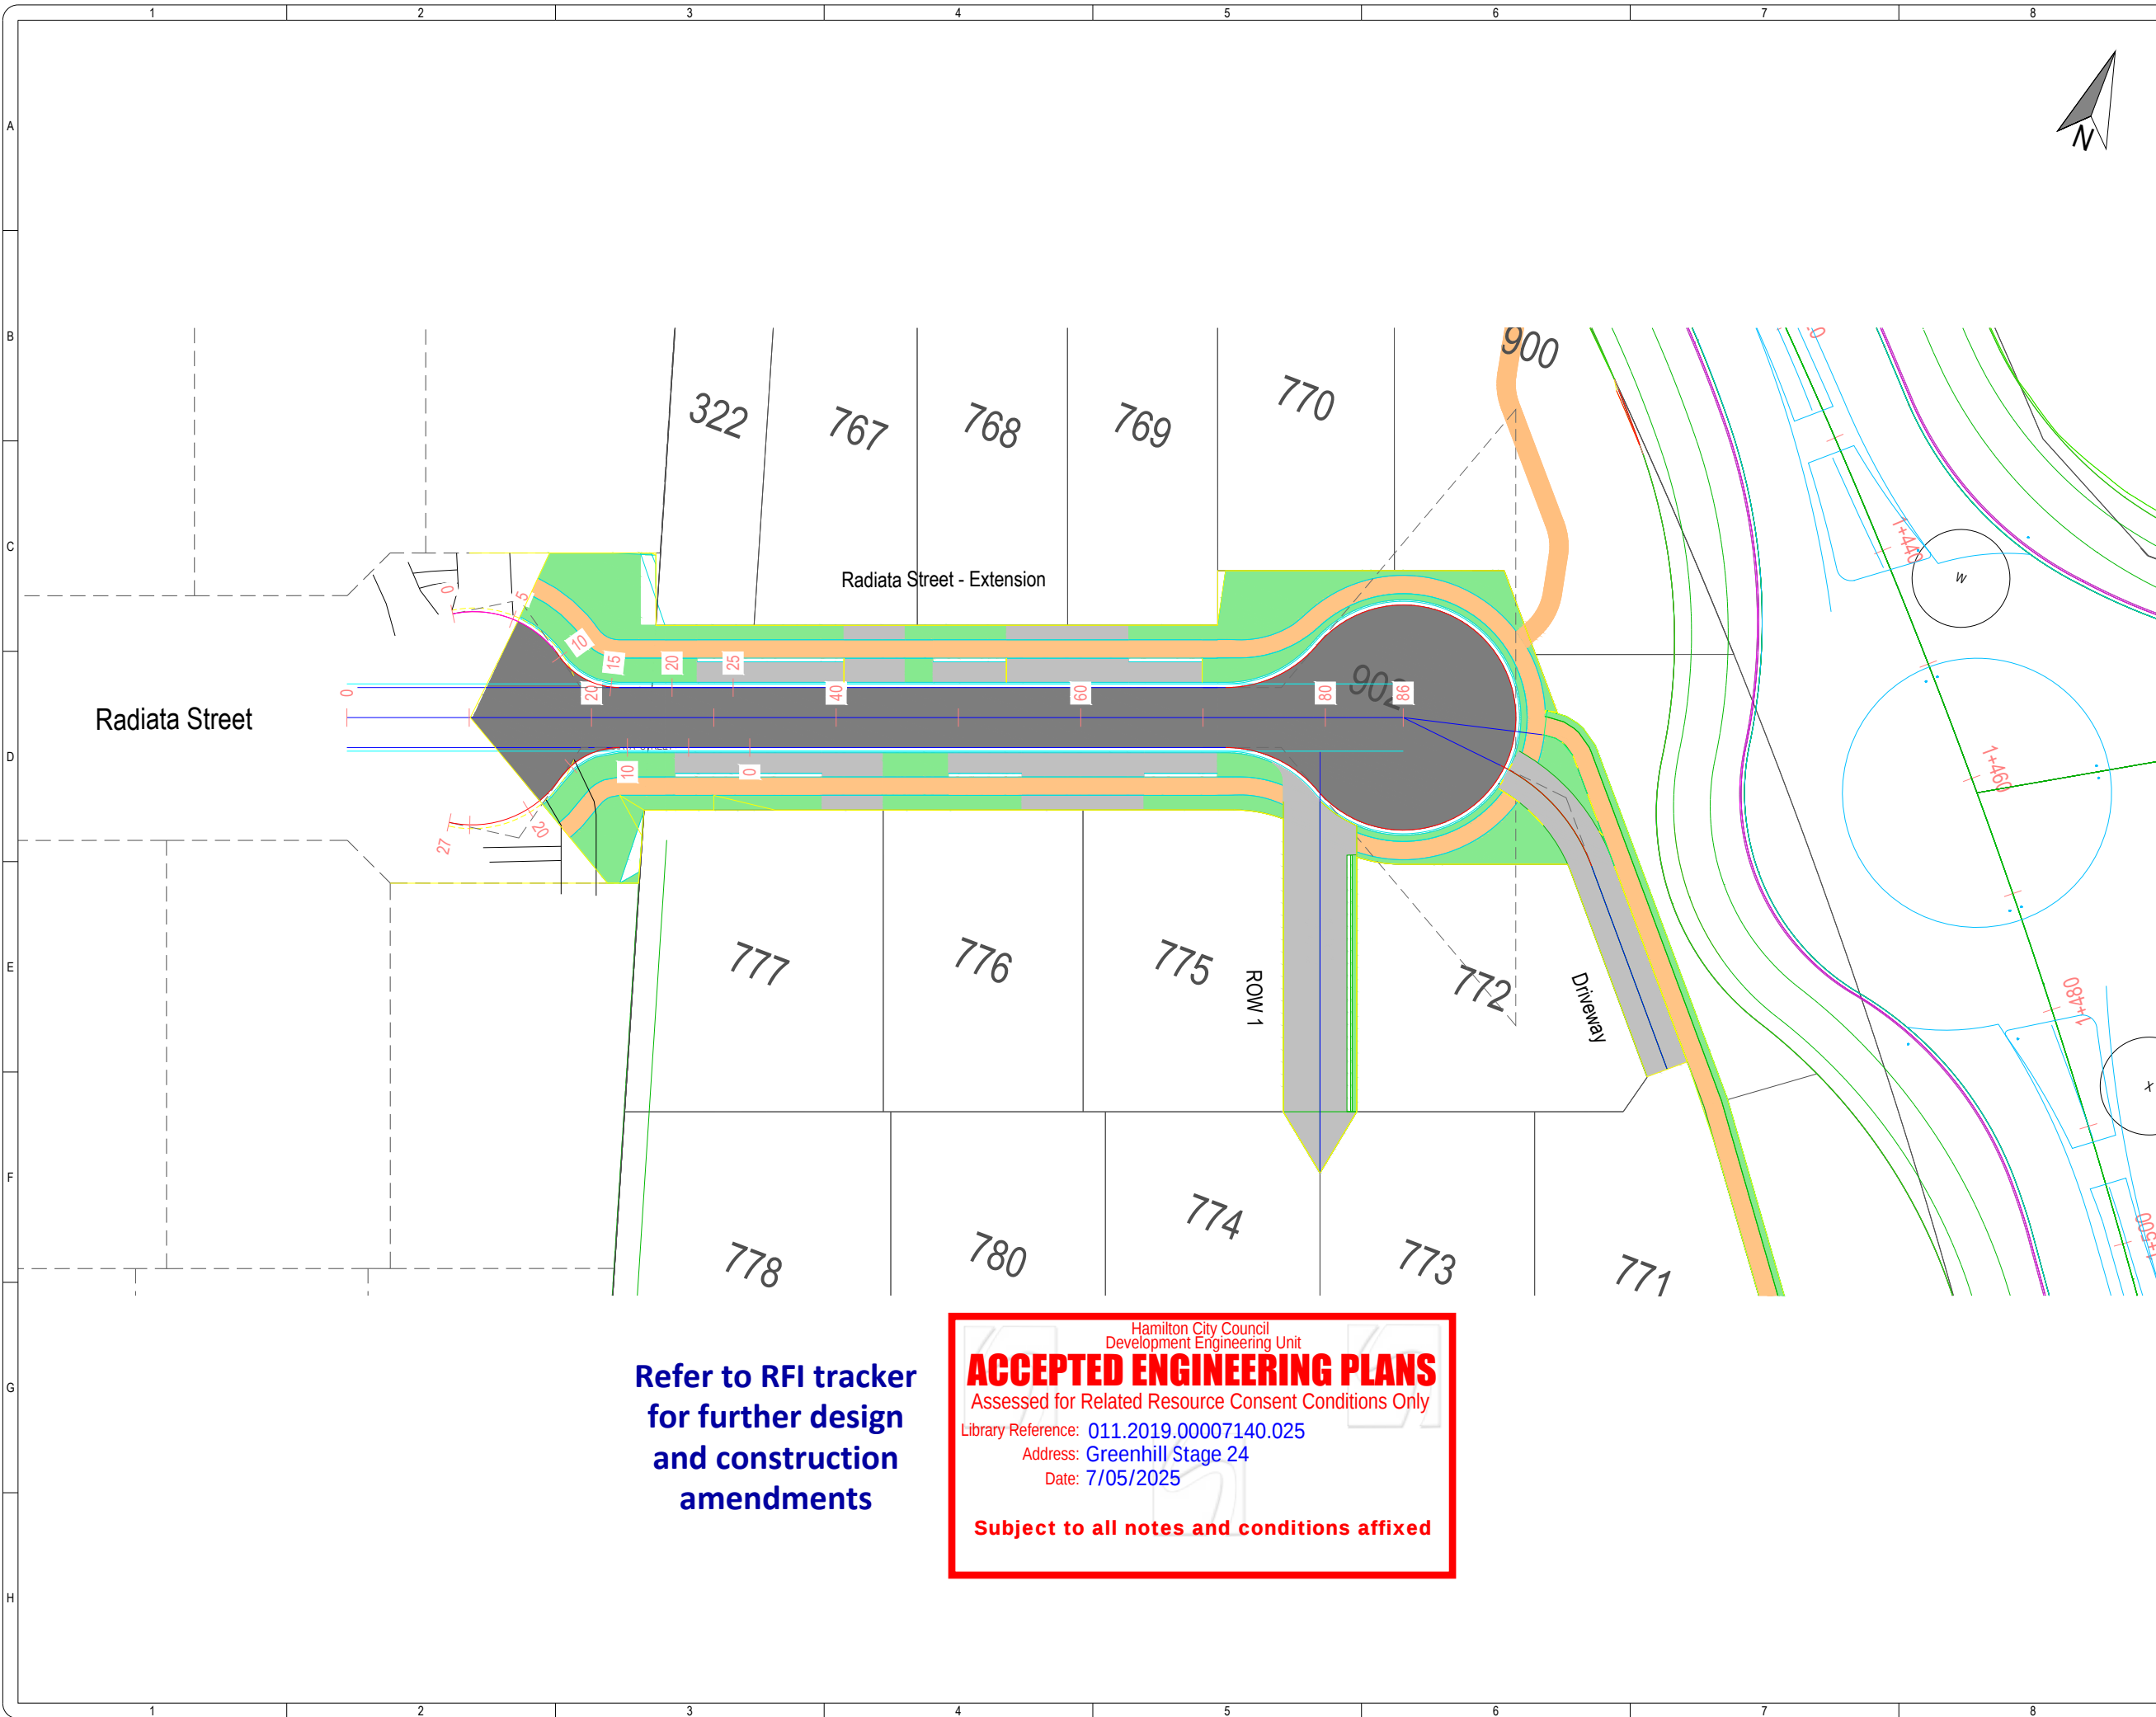

S & L Land Specialists

Ph. 07 577 6069
Email: info@slp.co.nz
P.O. Box 231, Tauranga 3144
www.slp.co.nz

LEGEND:

- — ABUTTALS
- — BOUNDARIES
- ROAD SURFACE
- PARKING SURFACE
- FOOTPATH
- GRASS

Note:

According to the Clause 3.3.2.1 under the Section 3 - Transportation of the RITS guidelines, 11.5m long Rigid truck is specified as the design vehicle for tracking on local roads.

NOTE:
ALL DESIGNS TO BE IN ACCORDANCE WITH THE RITS OR SPECIFIED DEPARTURES ON DETAIL DESIGN.

Rev	DESCRIPTION	DRN	CKD	APP	DATE
0	Preliminary	GG	BG	PH	10.07.24
1	Issued for RFI	GG	BG	PH	06.11.24
2	RFI Response	NW	HB	RH	16.04.25
3	RFI Responses	NW	HB	RH	29.04.25

SURVEYED	NAME	DATE	DESIGNED	NAME	DATE
			GG		07.10.24

COORDINATE SYSTEM:

ORIGIN OF COORDINATES:

HEIGHT DATUM:

ORIGIN OF HEIGHT:

TITLE

**RADIATA STREET
EXTENSION
VEHICLE TRACKING
12.5M RIGID TRUCK**

PREPARED FOR



ORIGINAL SCALES @ A3

1:500

DO NOT SCALE DIMENSIONS

DRAWING NO

24-30410-24D-R23

STATUS

APPROVAL


REVISION

3

COPYRIGHT ON THIS DRAWING IS RESERVED

**Refer to RFI tracker
for further design
and construction
amendments**

Hamilton City Council
Development Engineering Unit
ACCEPTED ENGINEERING PLANS
Assessed for Related Resource Consent Conditions Only
Library Reference: 011.2019.00007140.025
Address: Greenhill Stage 24
Date: 7/05/2025
Subject to all notes and conditions affixed

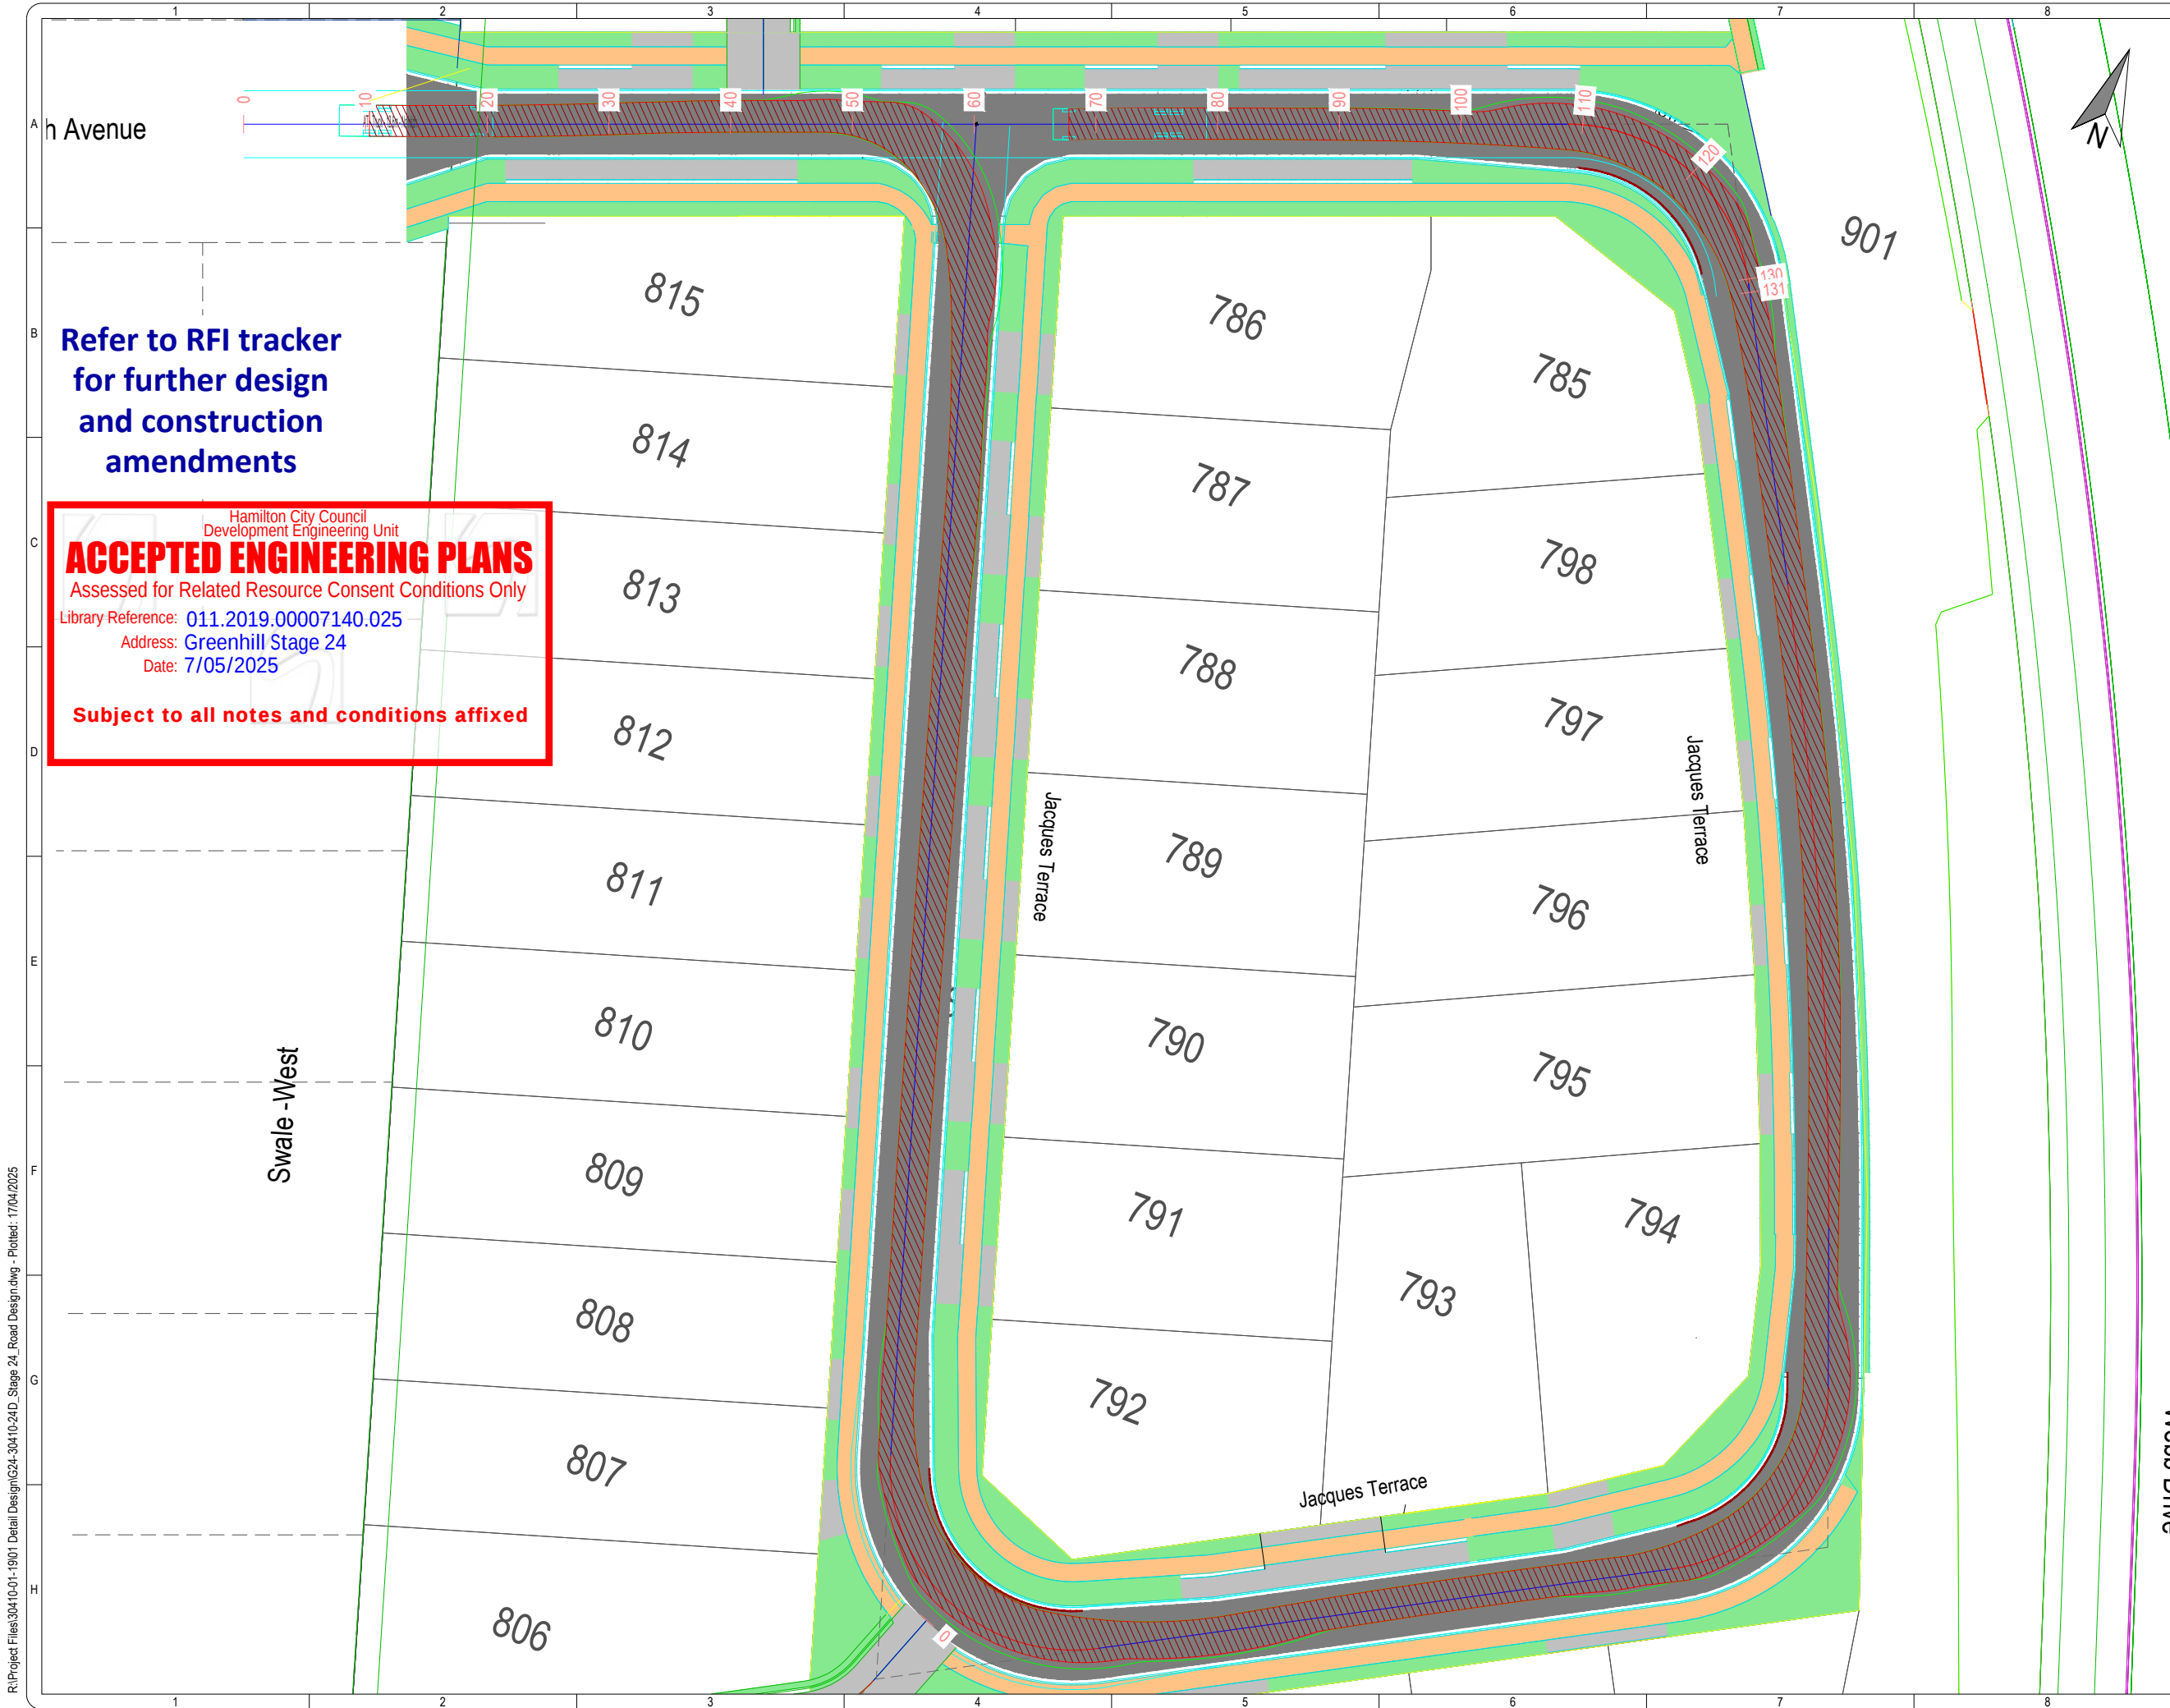

Refer to RFI tracker
for further design
and construction
amendments

Hamilton City Council
Development Engineering Unit

ACCEPTED ENGINEERING PLANS
Assessed for Related Resource Consent Conditions Only
Library Reference: 011.2019.00007140.025
Address: Greenhill Stage 24
Date: 7/05/2025

Subject to all notes and conditions affixed

**S & L Land Specialists**
Ph. 07 577 6069
Email: info@slip.co.nz
P.O. Box 231, Tauranga 3144
www.slip.co.nz

LEGEND:
— — ABUTTALS
— — BOUNDARIES
■ ROAD SURFACE
■ PARKING SURFACE
■ FOOTPATH
■ GRASS

Note:
According to the Clause 3.3.2.1 under the Section 3 - Transportation of the RITS guidelines, 11.5m long Rigid truck is specified as the design vehicle for tracking on local roads.

Rev	DESCRIPTION	DRN	CKD	APP	DATE
0	Preliminary	GG	BG	PH	07.10.24
1	Issued for RFI	GG	BG	PH	06.11.24
2	RFI Response	NW	HB	RH	16.04.25

	NAME	DATE		NAME	DATE
SURVEYED			DESIGNED	GG	07.10.24

COORDINATE SYSTEM:
ORIGIN OF COORDINATES:
HEIGHT DATUM:
ORIGIN OF HEIGHT:

TITLE
**JACQUES TERRACE
VEHICLE TRACKING
12.5M RIGID TRUCK**

PREPARED FOR


ORIGINAL SCALES @ A3
1:500
DO NOT SCALE DIMENSIONS
DRAWING NO
24-30410-24D-R24

STATUS
APPROVAL
REVISION
2

COPYRIGHT ON THIS DRAWING IS RESERVED

Refer to RFI tracker
for further design
and construction
amendments

Hamilton City Council
Development Engineering Unit

ACCEPTED ENGINEERING PLANS
Assessed for Related Resource Consent Conditions Only
Library Reference: 011.2019.00007140.025
Address: Greenhill Stage 24
Date: 7/05/2025

Subject to all notes and conditions affixed

NOTES:

1. ALL 1500Ø WATERMAINS SHALL BE PVC-O.

2. ALL RIDERMAINS SHALL BE 63MM OD HDPE.

3. TRACER WIRE OR LOCATER TAPE SHALL BE PLACED ABOVE ALL WATERMAINS / RIDERMAINS.

4. HOUSE CONNECTIONS SHALL BE 20Ø COMPLETE TO HCC REQUIREMENTS, INCLUDING GATE VALVE, WATERMETER, BACKFLOW PREVENTER AND SURFACE BOX WITH UP TO 3.0M OF HDPE PIPE TO MAIN.

5. ALL WORKS TO BE CARRIED OUT AND ALL MATERIALS TO COMPLY WITH THE HAMILTON CITY COUNCIL'S SPECIFICATIONS.

6. PRINCIPAL WATERMAINS AND RIDERMAINS IN CARRIAGEWAY SHALL HAVE A MINIMUM OF 900MM COVER. IN BERMS, THEY SHALL HAVE A MINIMUM OF 750MM COVER. SERVICE CONNECTIONS PIPES SHALL HAVE MINIMUM OF 350MM COVER.

7. REFER TO DRAWINGS 30410-01-S24-W2 & W3 FOR STANDARD DETAILS.

LEGEND:

LOT BOUNDARIES

ABUTTALS

STAGE PERIMETER


WATER PIPE

EXISTING WATER PIPE

FIRE HYDRANT

VALVE

WATER CONNECTION

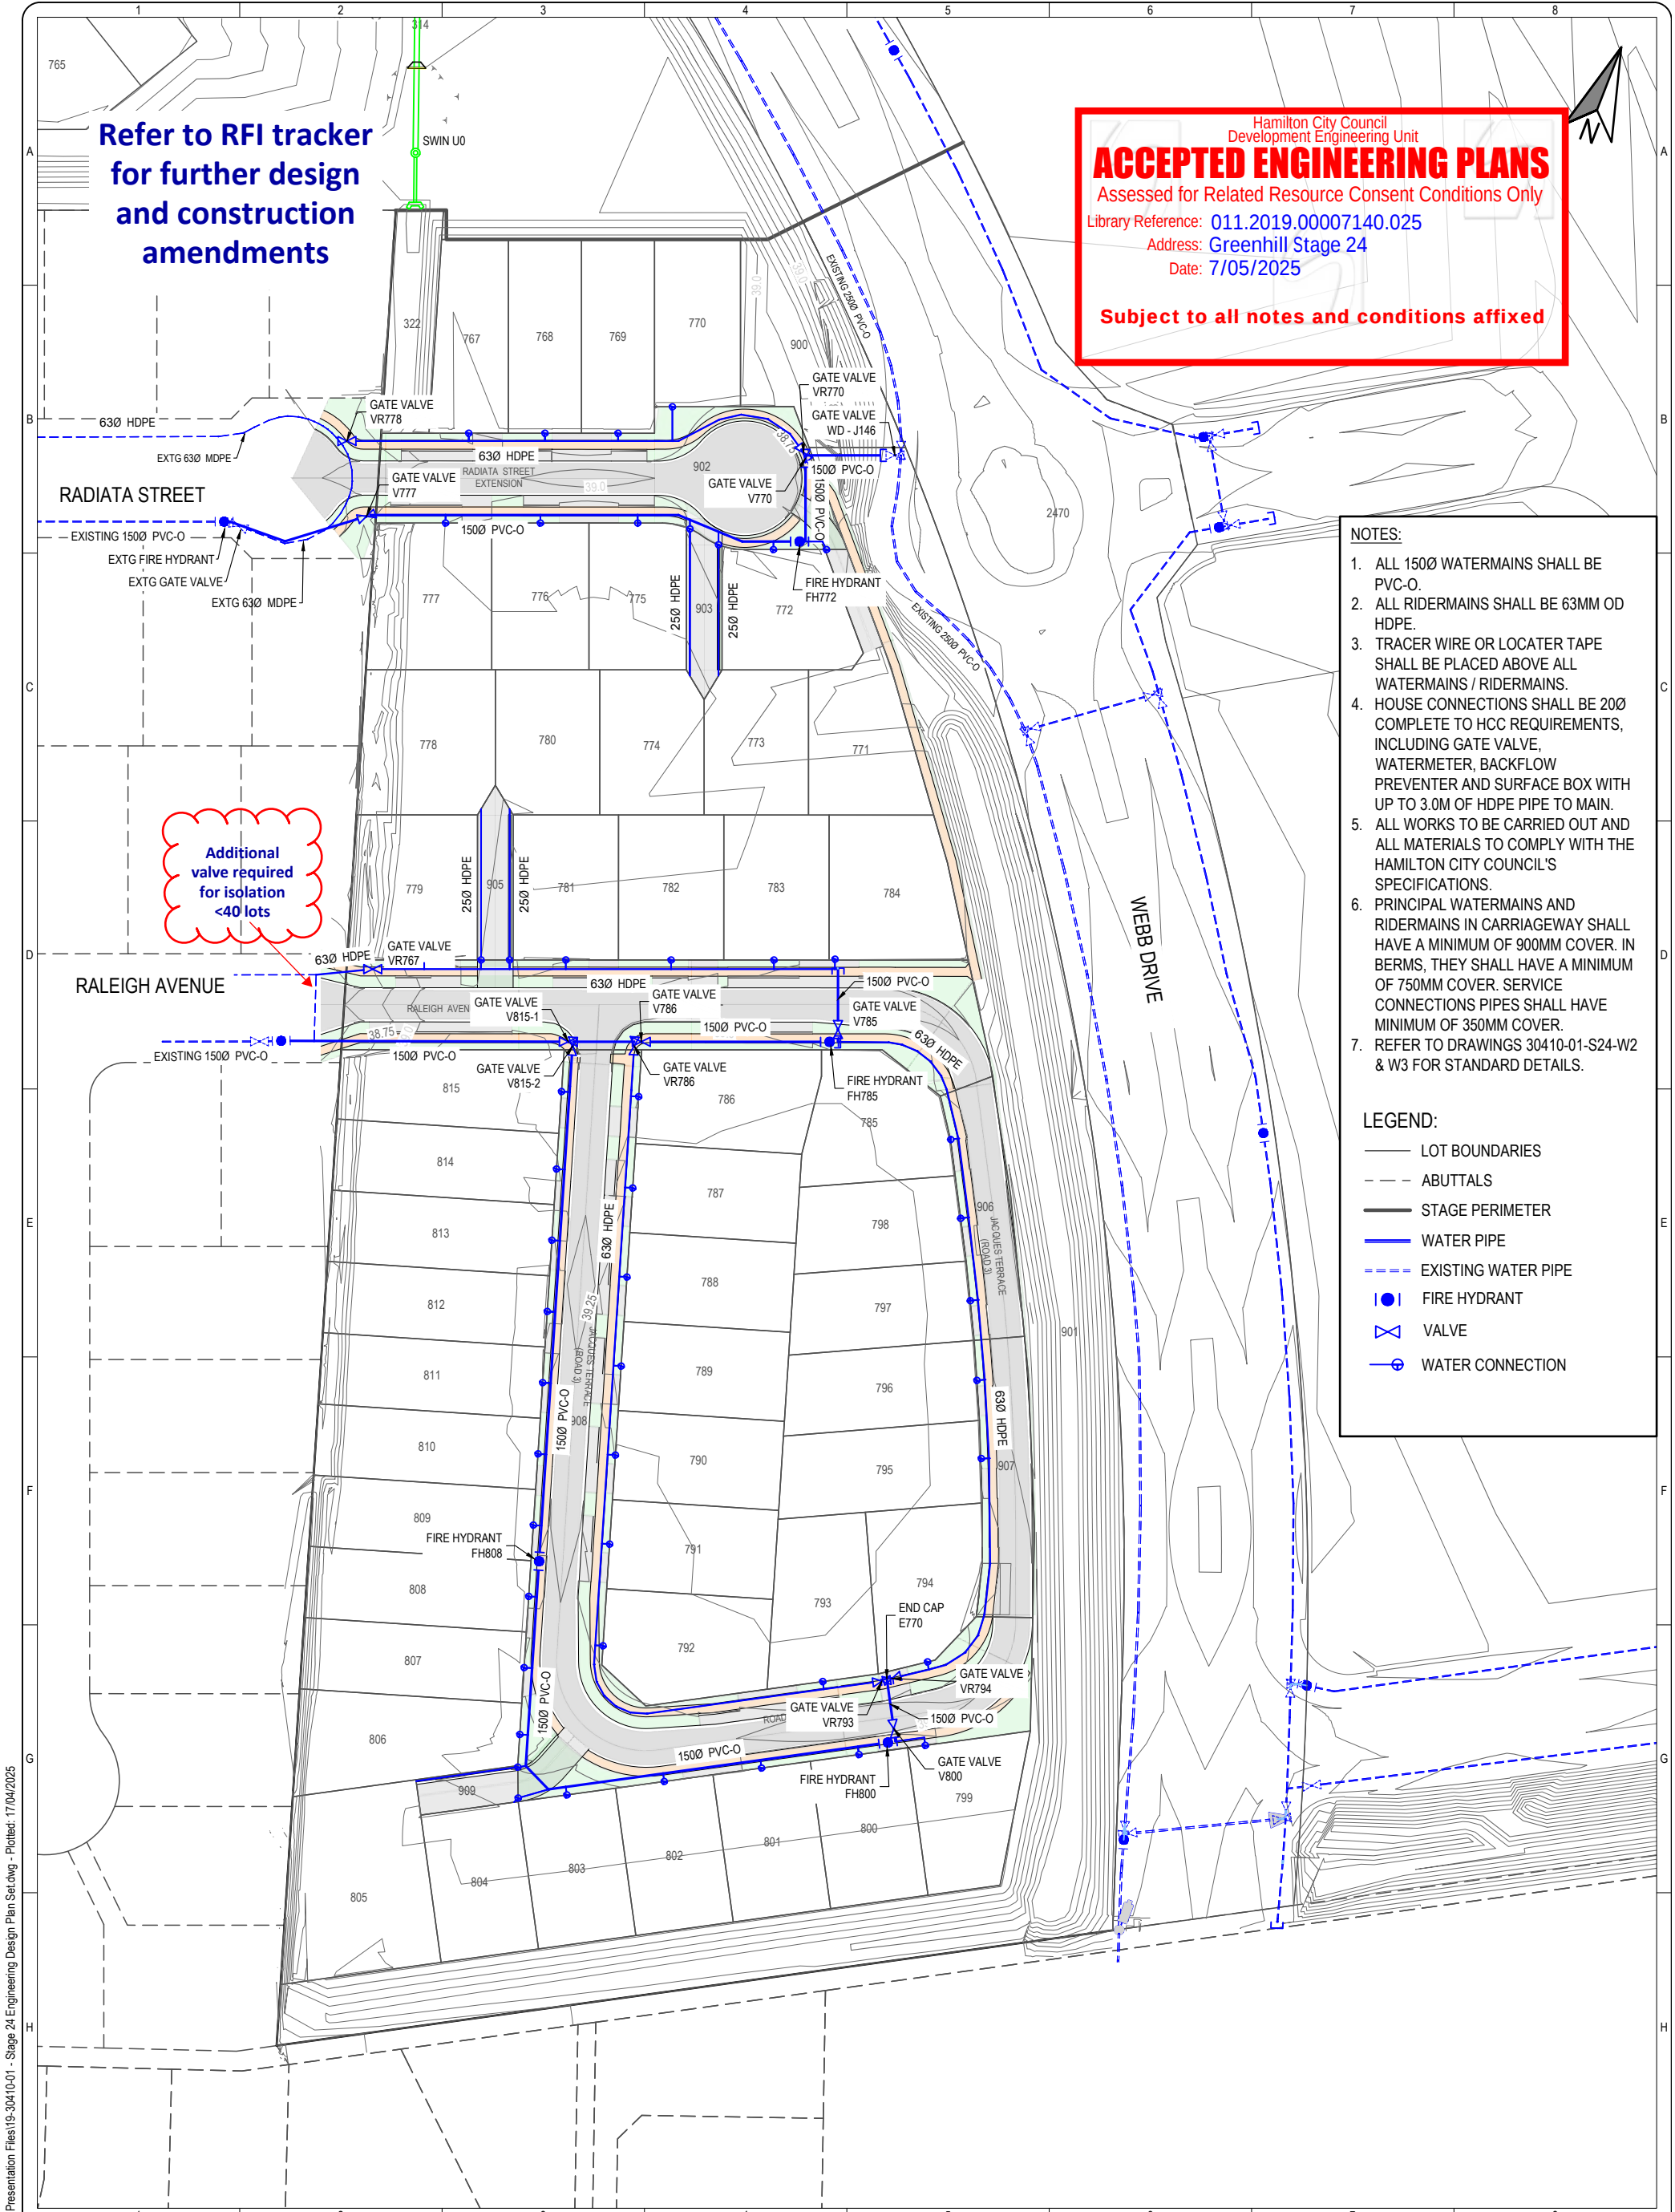

R:\Project Files\30410-01-1901 Drawing Presentation Files\19-30410-01 - Stage 24 Engineering Design Plan Set.dwg - Plotted: 17/04/2025

S&L


SHRIMPTON & LIPINSKI

LAND SPECIALISTS

Ph: 07 577 6069
Email: info@sltga.co.nz
P.O. Box 231, Tauranga 3140
www.sltga.co.nz

GREENHILL
PROPERTIES

Chedworth
Properties Limited

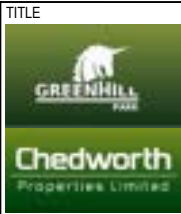


WATER LAYOUT PLAN
STAGE 24


REV	DESCRIPTION	DRN	CKD	APP	DATE	COORDINATE SYSTEM: NZGD 2000 - MT EDEN	ORIGIN OF COORDINATES: BPV DPS 17824	HEIGHT DATUM: MOTURIKI DATUM 1953	ORIGIN OF HEIGHT: SS507 SO 42451	ORIGINAL SCALES @ A3	STATUS
0	PRELIMINARY	NW	HB	PH	14/8/24					1:1000	FOR APPROVAL
1	ISSUED FOR EPA	NW	HB	PH	16/8/24						
2	ISSUED FOR RFI	TM	RH	PH	23/10/24						
3	ISSUED FOR RFI	TM		PH	07/04/25						
4	RFI RESPONSE	NW	HB		16/04/25						
						DO NOT SCALE DIMENSIONS					
						DRAWING NO	30410-01-S24-W1				REVISION
							4				
						SURVEYED	NAME	DATE	DESIGNED	NAME	DATE

COPYRIGHT ON THIS DRAWING IS RESERVED


R:\Project Files\04\10-01-1901 Drawing Presentation Files\19-304\10-01 - Stage 24 Engineering Design Plan Set.dwg - Plotted: 16/04/2025

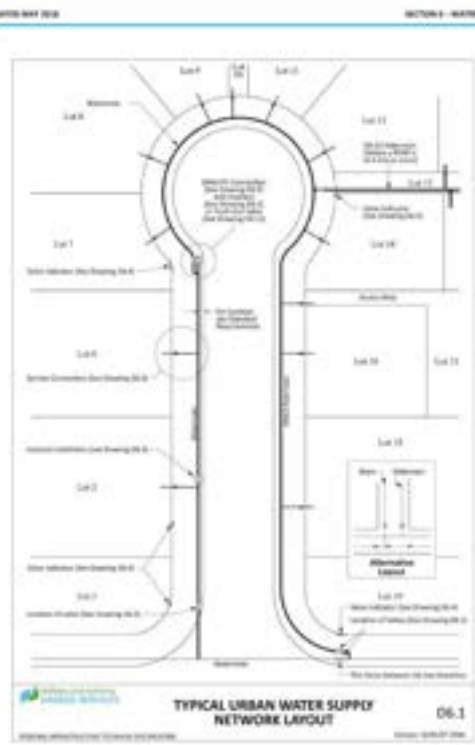


Drawing 6-1: Typical urban water supply network layout

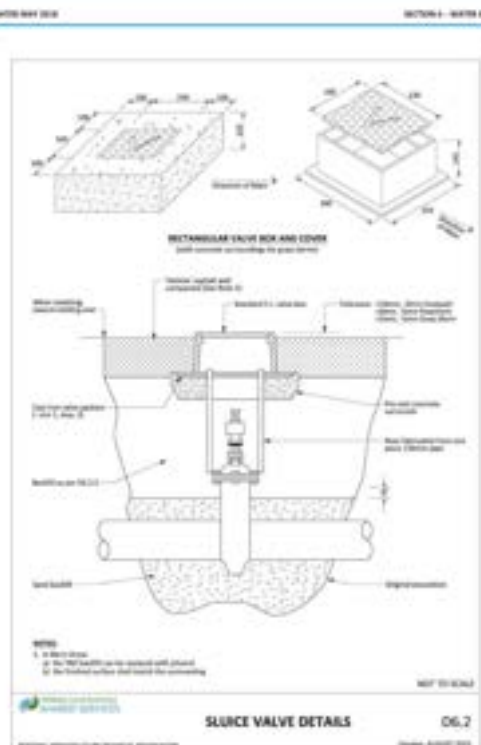

Sluice Valve Details


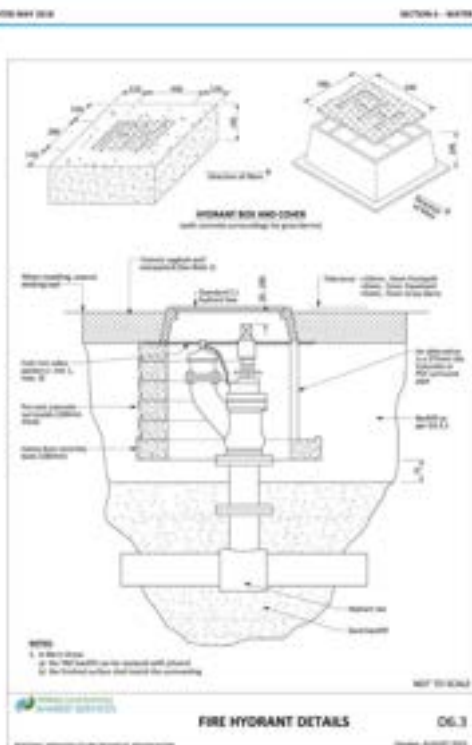


Fire Hydrant Details

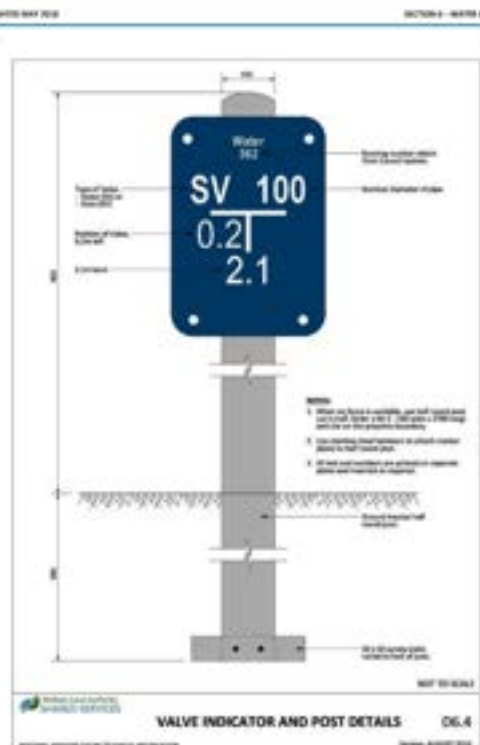


Drawing 6-4: Valve indicator and post details


Hamilton City Council
Development Engineering Unit
ACCEPTED ENGINEERING PLANS
Assessed for Related Resource Consent Conditions Only
Library Reference: 011.2019.00007140.025
Address: Greenhill Stage 24
Date: 7/05/2025
Subject to all notes and conditions affixed

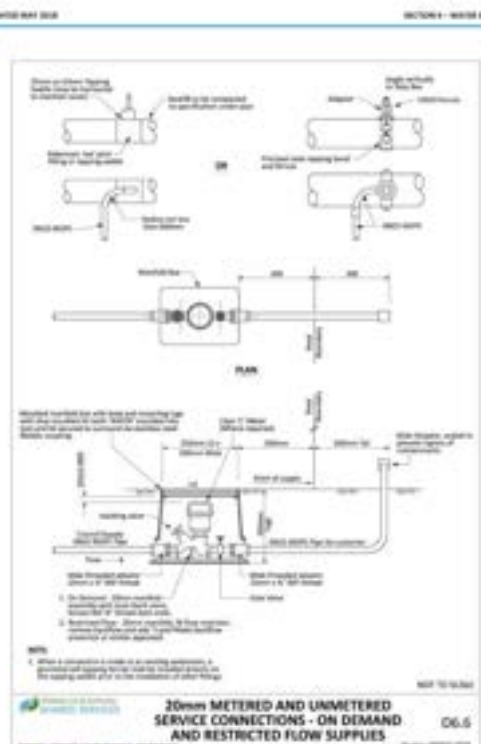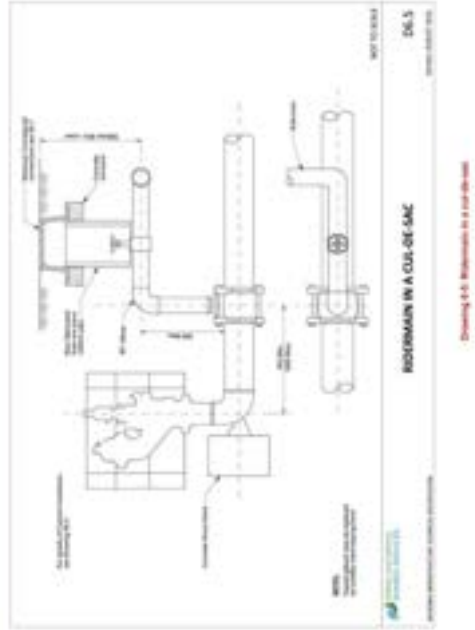

Drawing 6-6: 30mm metered and unmetered service connections - on demand and restricted flow supplies

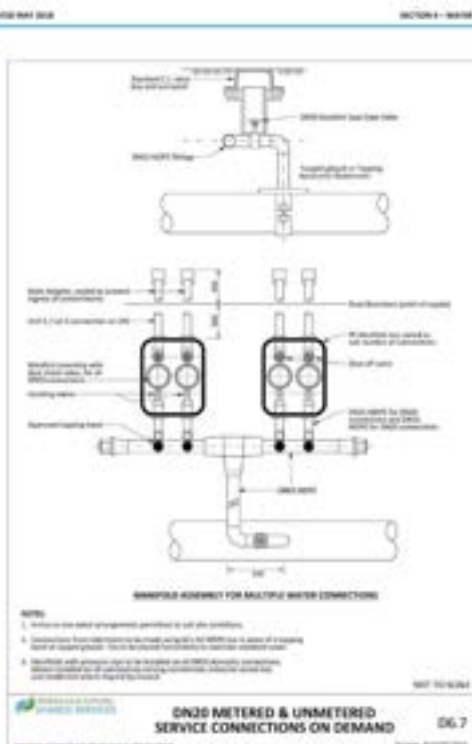

Drawing 6-7: DN32 metered and unmetered service connections on demand

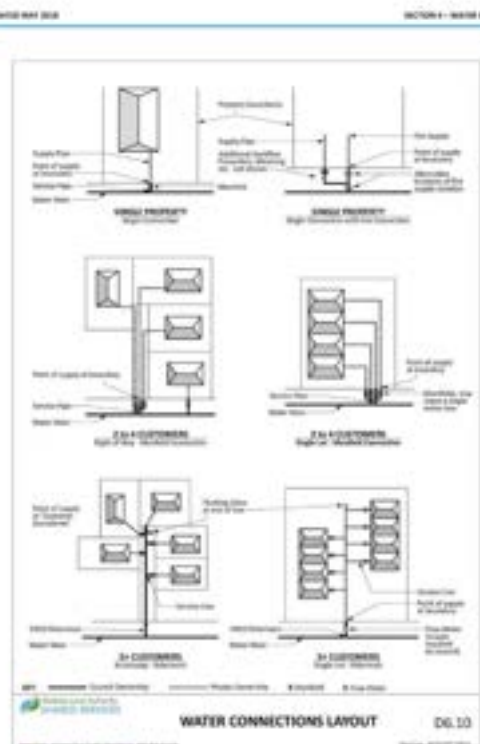

Drawing 6-10: Water connections layout



SHRIMPTON &
LIPINSKI
LAND DEVELOPMENT &
DESIGN SPECIALISTS

Ph. 07 577 6069
Email: info@sltga.co.nz
P.O. Box 231, Tauranga 3140
www.sltga.co.nz

Rev	DESCRIPTION	DRN	CKD	APP	DATE
0	PRELIMINARY	NW			14/8/24
1	ISSUED FOR EPA	NW	HB	PH	16/8/24

NAME	DATE	NAME	DATE
SURVEYED		DESIGNED	
COORDINATE SYSTEM: NZGD 2000 - MT EDEN			
ORIGIN OF COORDINATES: BPV DPS 17824			
HEIGHT DATUM: MOTURIKI DATUM 1953			
ORIGIN OF HEIGHT: SS507 SO 42451			

TITLE

STANDARD DETAILS WATER




AREAS L,U & K

ORIGINAL SCALES @ A3	STATUS
NOT TO SCALE	FOR APPROVAL
DO NOT SCALE DIMENSIONS	
DRAWING NO	REVISION
30410-01-S24-W2	1

COPYRIGHT ON THIS DRAWING IS RESERVED

R:\Project Files\04\10-01-1901 Drawing Presentation Files\19-304\10-01 - Stage 24 Engineering Design Plan Set.dwg - Plotted: 16/04/2025

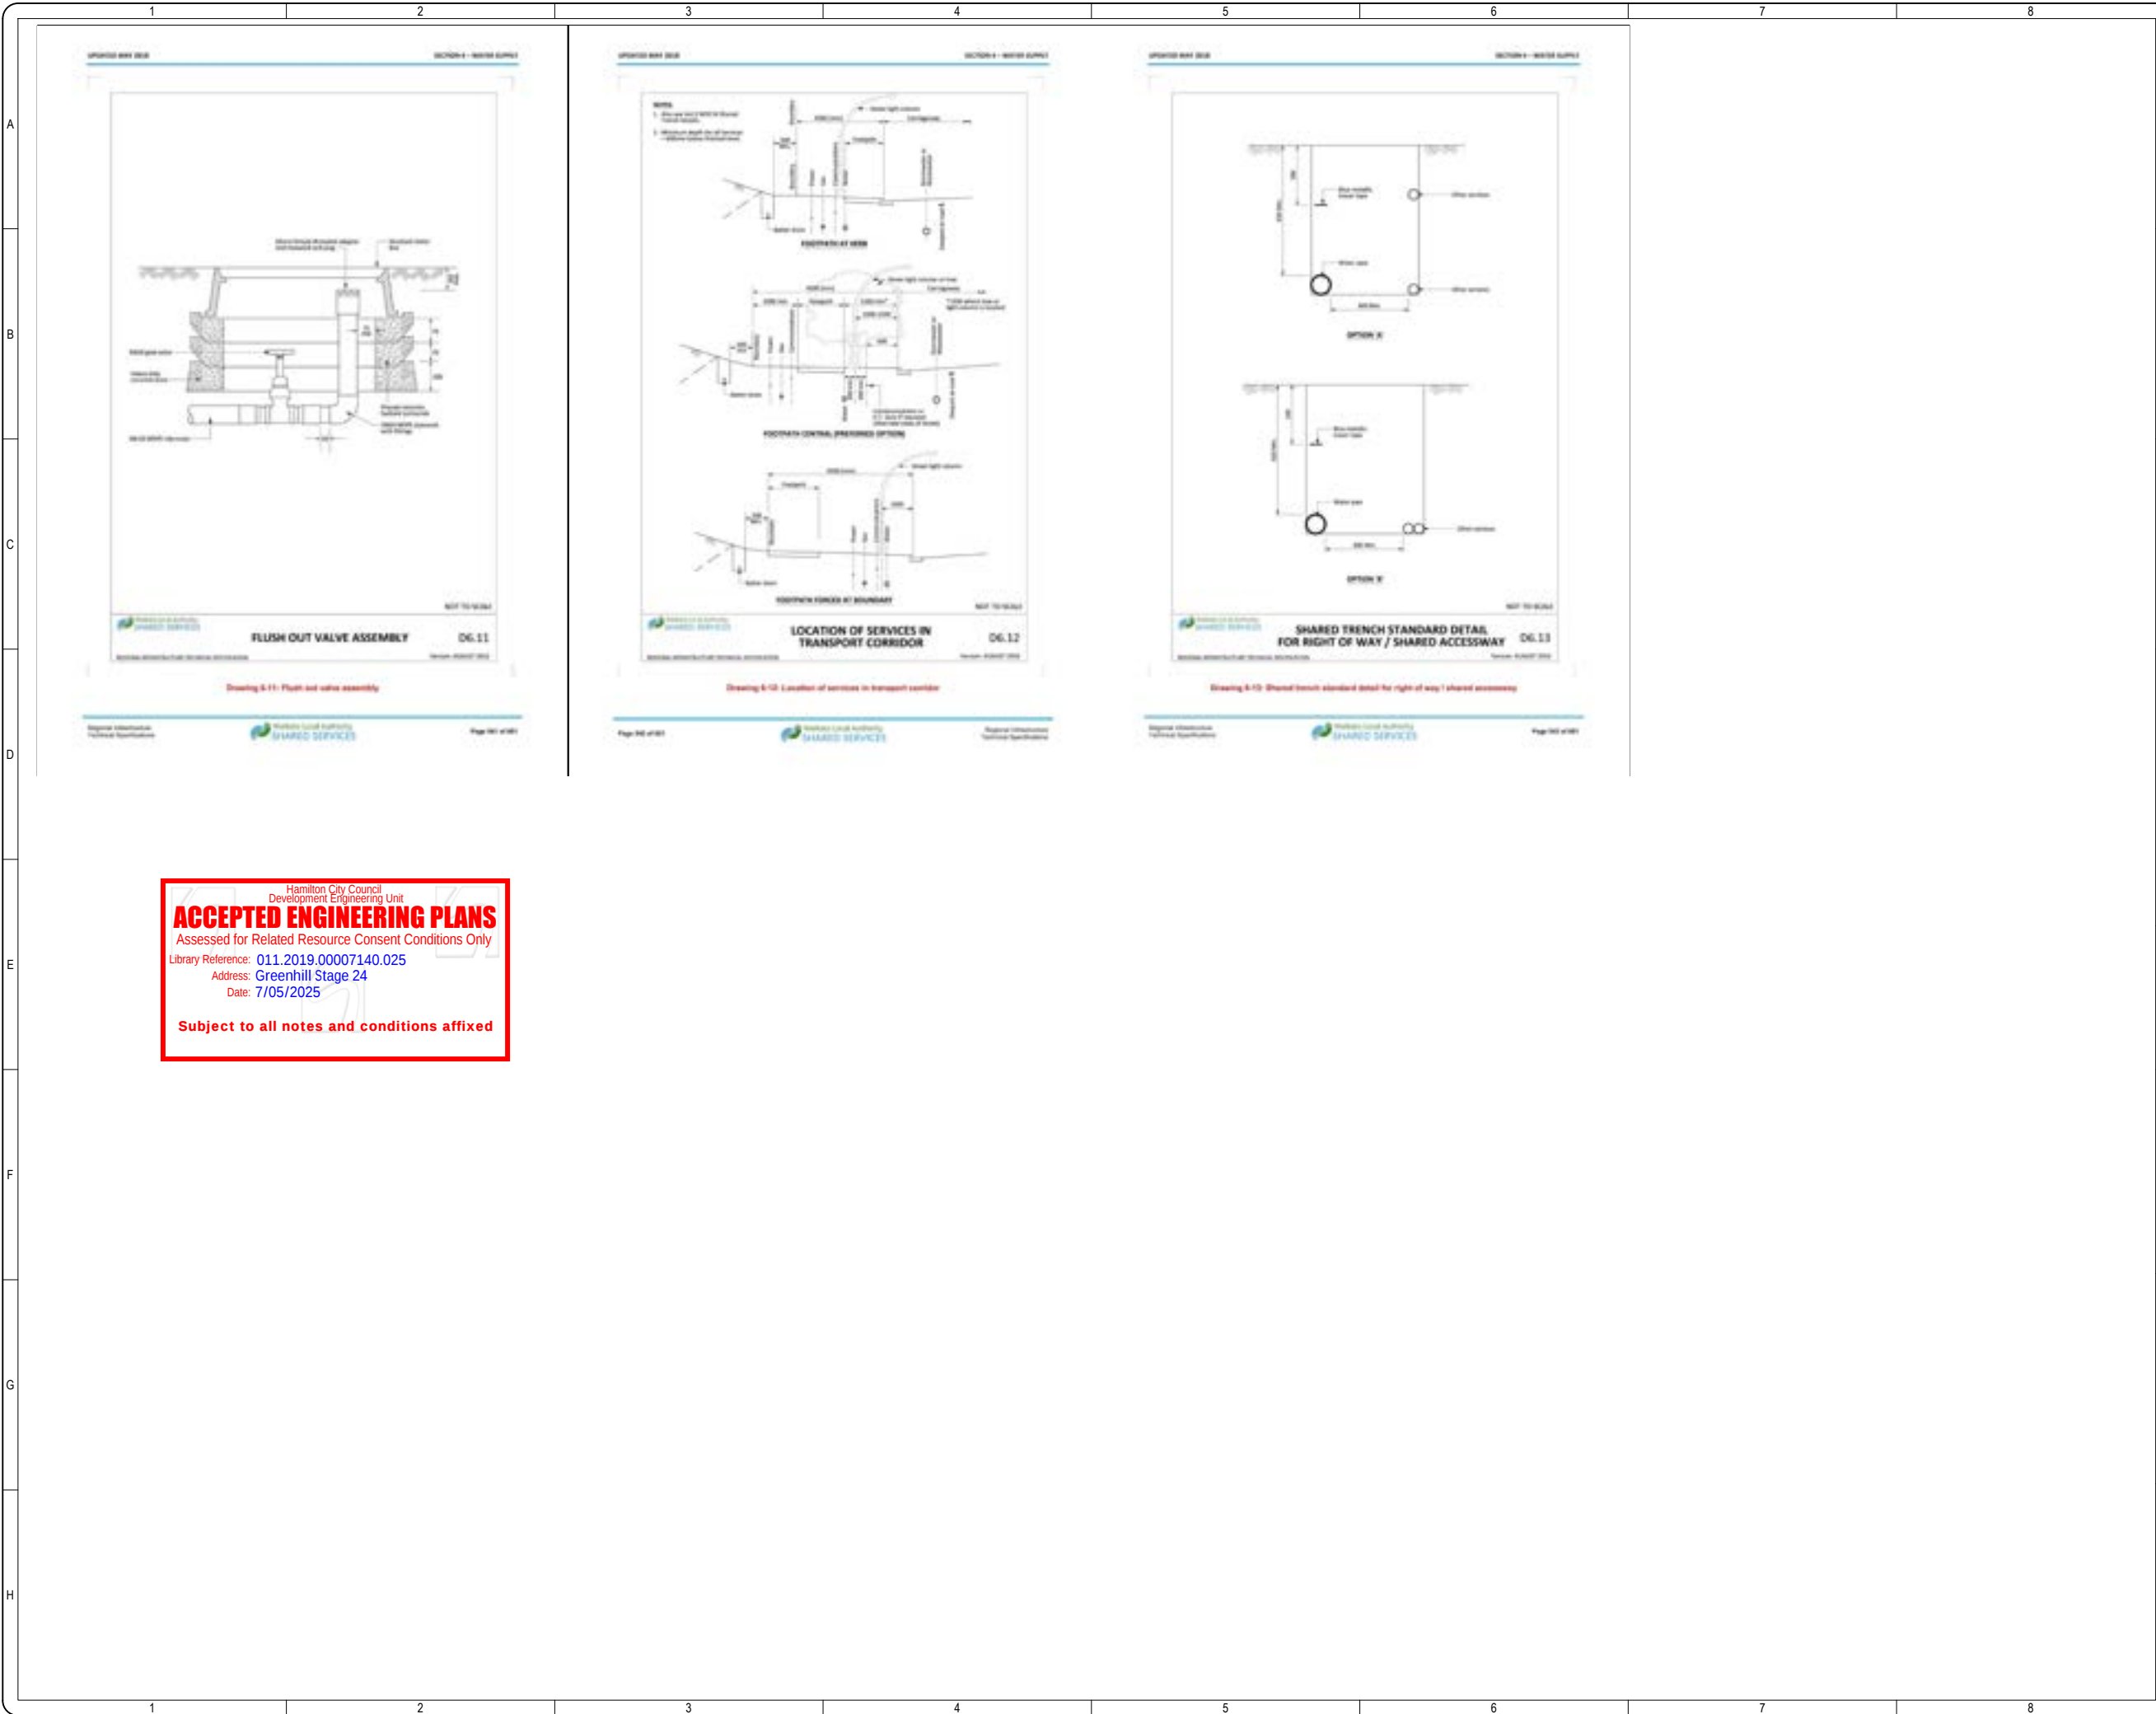

Hamilton City Council
Development Engineering Unit
ACCEPTED ENGINEERING PLANS
Assessed for Related Resource Consent Conditions Only
Library Reference: 011.2019.00007140.025
Address: Greenhill Stage 24
Date: 7/05/2025
Subject to all notes and conditions affixed

SHRIMPTON &
LIPINSKI
LAND DEVELOPMENT &
DESIGN SPECIALISTS
Ph. 07 577 6069
Email: info@sltga.co.nz
P.O. Box 231, Tauranga 3140
www.sltga.co.nz

Rev	DESCRIPTION	DRN	CKD	APP	DATE
0	PRELIMINARY	NW			14/8/24
1	ISSUED FOR EPA	NW	HB	PH	16/8/24

	NAME	DATE		NAME	DATE
SURVEYED			DESIGNED		

COORDINATE SYSTEM: NZGD 2000 - MT EDEN
ORIGIN OF COORDINATES: BPV DPS 17824
HEIGHT DATUM: MOTURIKI DATUM 1953
ORIGIN OF HEIGHT: SS507 SO 42451

TITLE

STANDARD DETAILS
WATER

PREPARED FOR

Chedworth
Properties Limited


AREAS L,U & K

ORIGINAL SCALES @ A3	STATUS
NOT TO SCALE	FOR APPROVAL
DO NOT SCALE DIMENSIONS	
DRAWING NO	REVISION

30410-01-S24-W3	1
-----------------	---

COPYRIGHT ON THIS DRAWING IS RESERVED

R:\Project Files\30410-01-1901 Drawing Presentation Files\19-30410-01 - Stage 24 Engineering Design Plan Set.dwg - Plotted: 17/04/2025

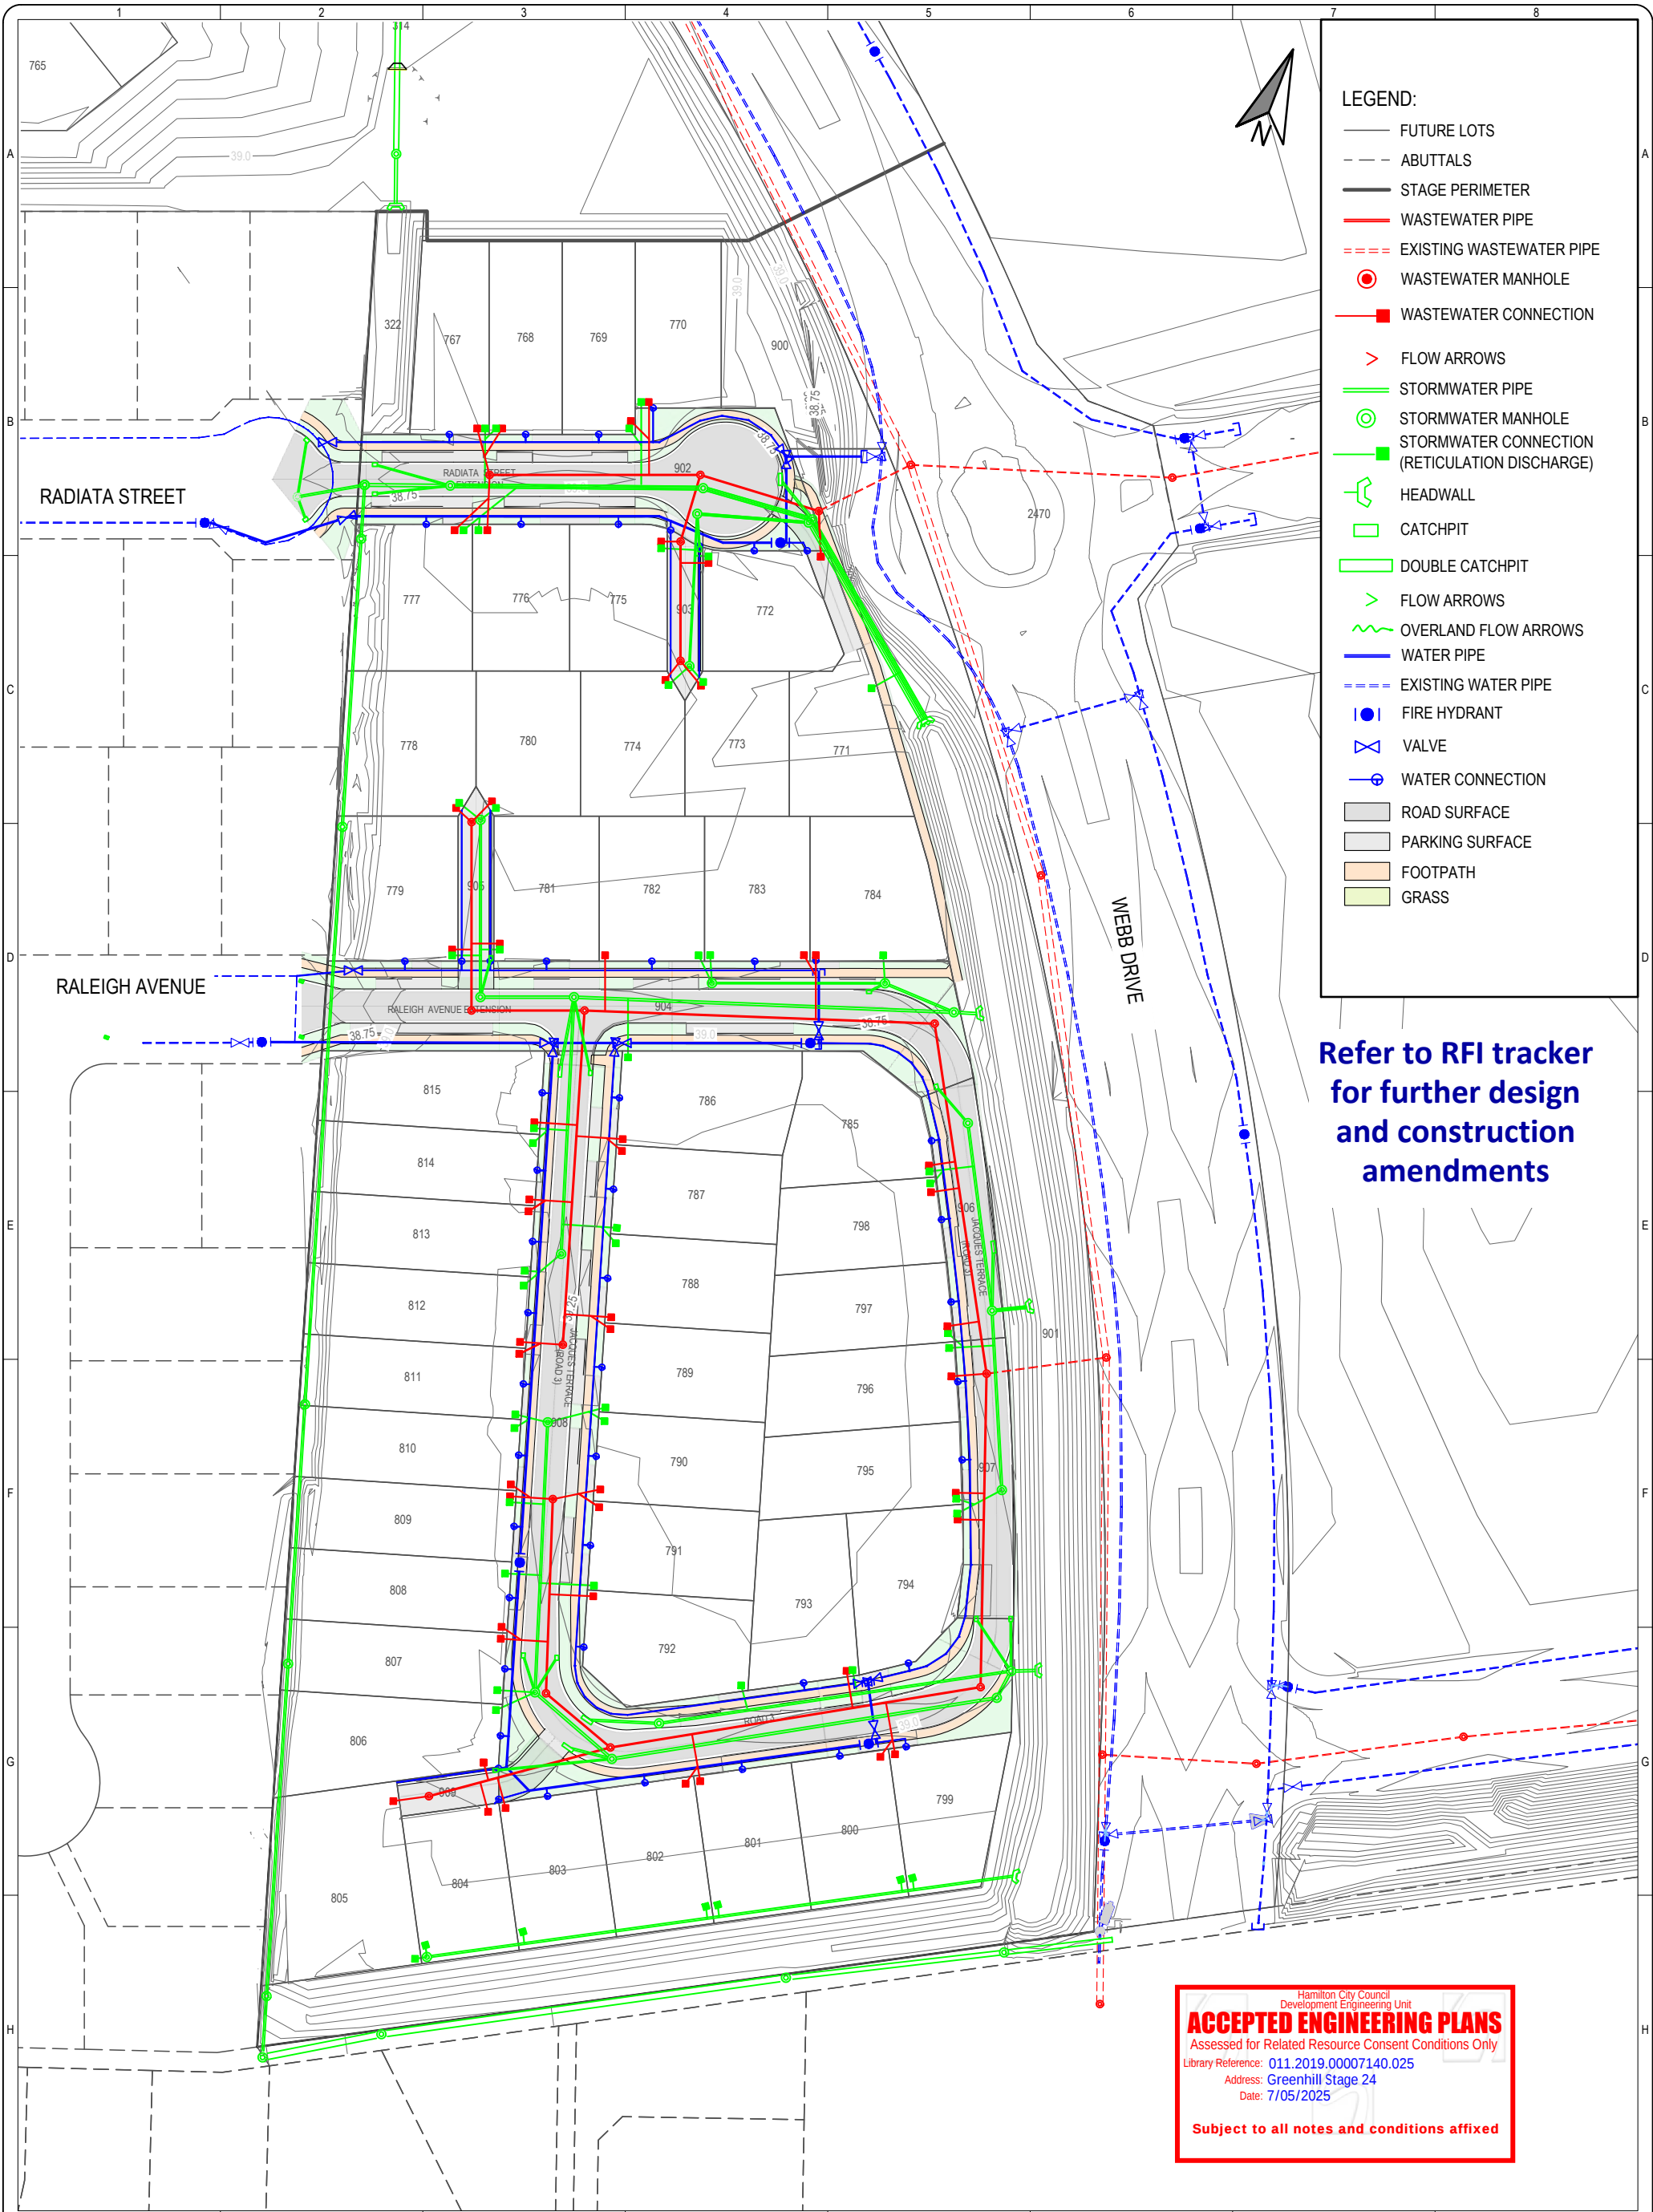

Hamilton City Council
Development Engineering Unit
ACCEPTED ENGINEERING PLANS
Assessed for Related Resource Consent Conditions Only
Library Reference: 011.2019.00007140.025
Address: Greenhill Stage 24
Date: 7/05/2025
Subject to all notes and conditions affixed


S&L
SHRIMPTON & LIPINSKI
LAND SPECIALISTS
Ph: 07 577 6069
Email: info@sltga.co.nz
P.O. Box 231, Tauranga 3140
www.sltga.co.nz



**WASTEWATER, STORMWATER,
WATER & ROADING OVERVIEW PLAN
STAGE 24**

REV	DESCRIPTION	DRN	CKD	APP	DATE	COORDINATE SYSTEM: NZGD 2000 - MT EDEN	STATUS
0	ISSUED FOR RFI	TM		PH	07/04/25	ORIGIN OF COORDINATES: BPV DPS 17824	FOR APPROVAL
1	RFI RESPONSE	NW	HB		16/04/25	HEIGHT DATUM: MOTURIKI DATUM 1953	
						ORIGIN OF HEIGHT: SS507 SO 42451	
						ORIGINAL SCALES @ A3 1:1000	
						DO NOT SCALE DIMENSIONS	
						DRAWING NO	
						30410-01-S24-S1	
							REVISION
							1

COPYRIGHT ON THIS DRAWING IS RESERVED

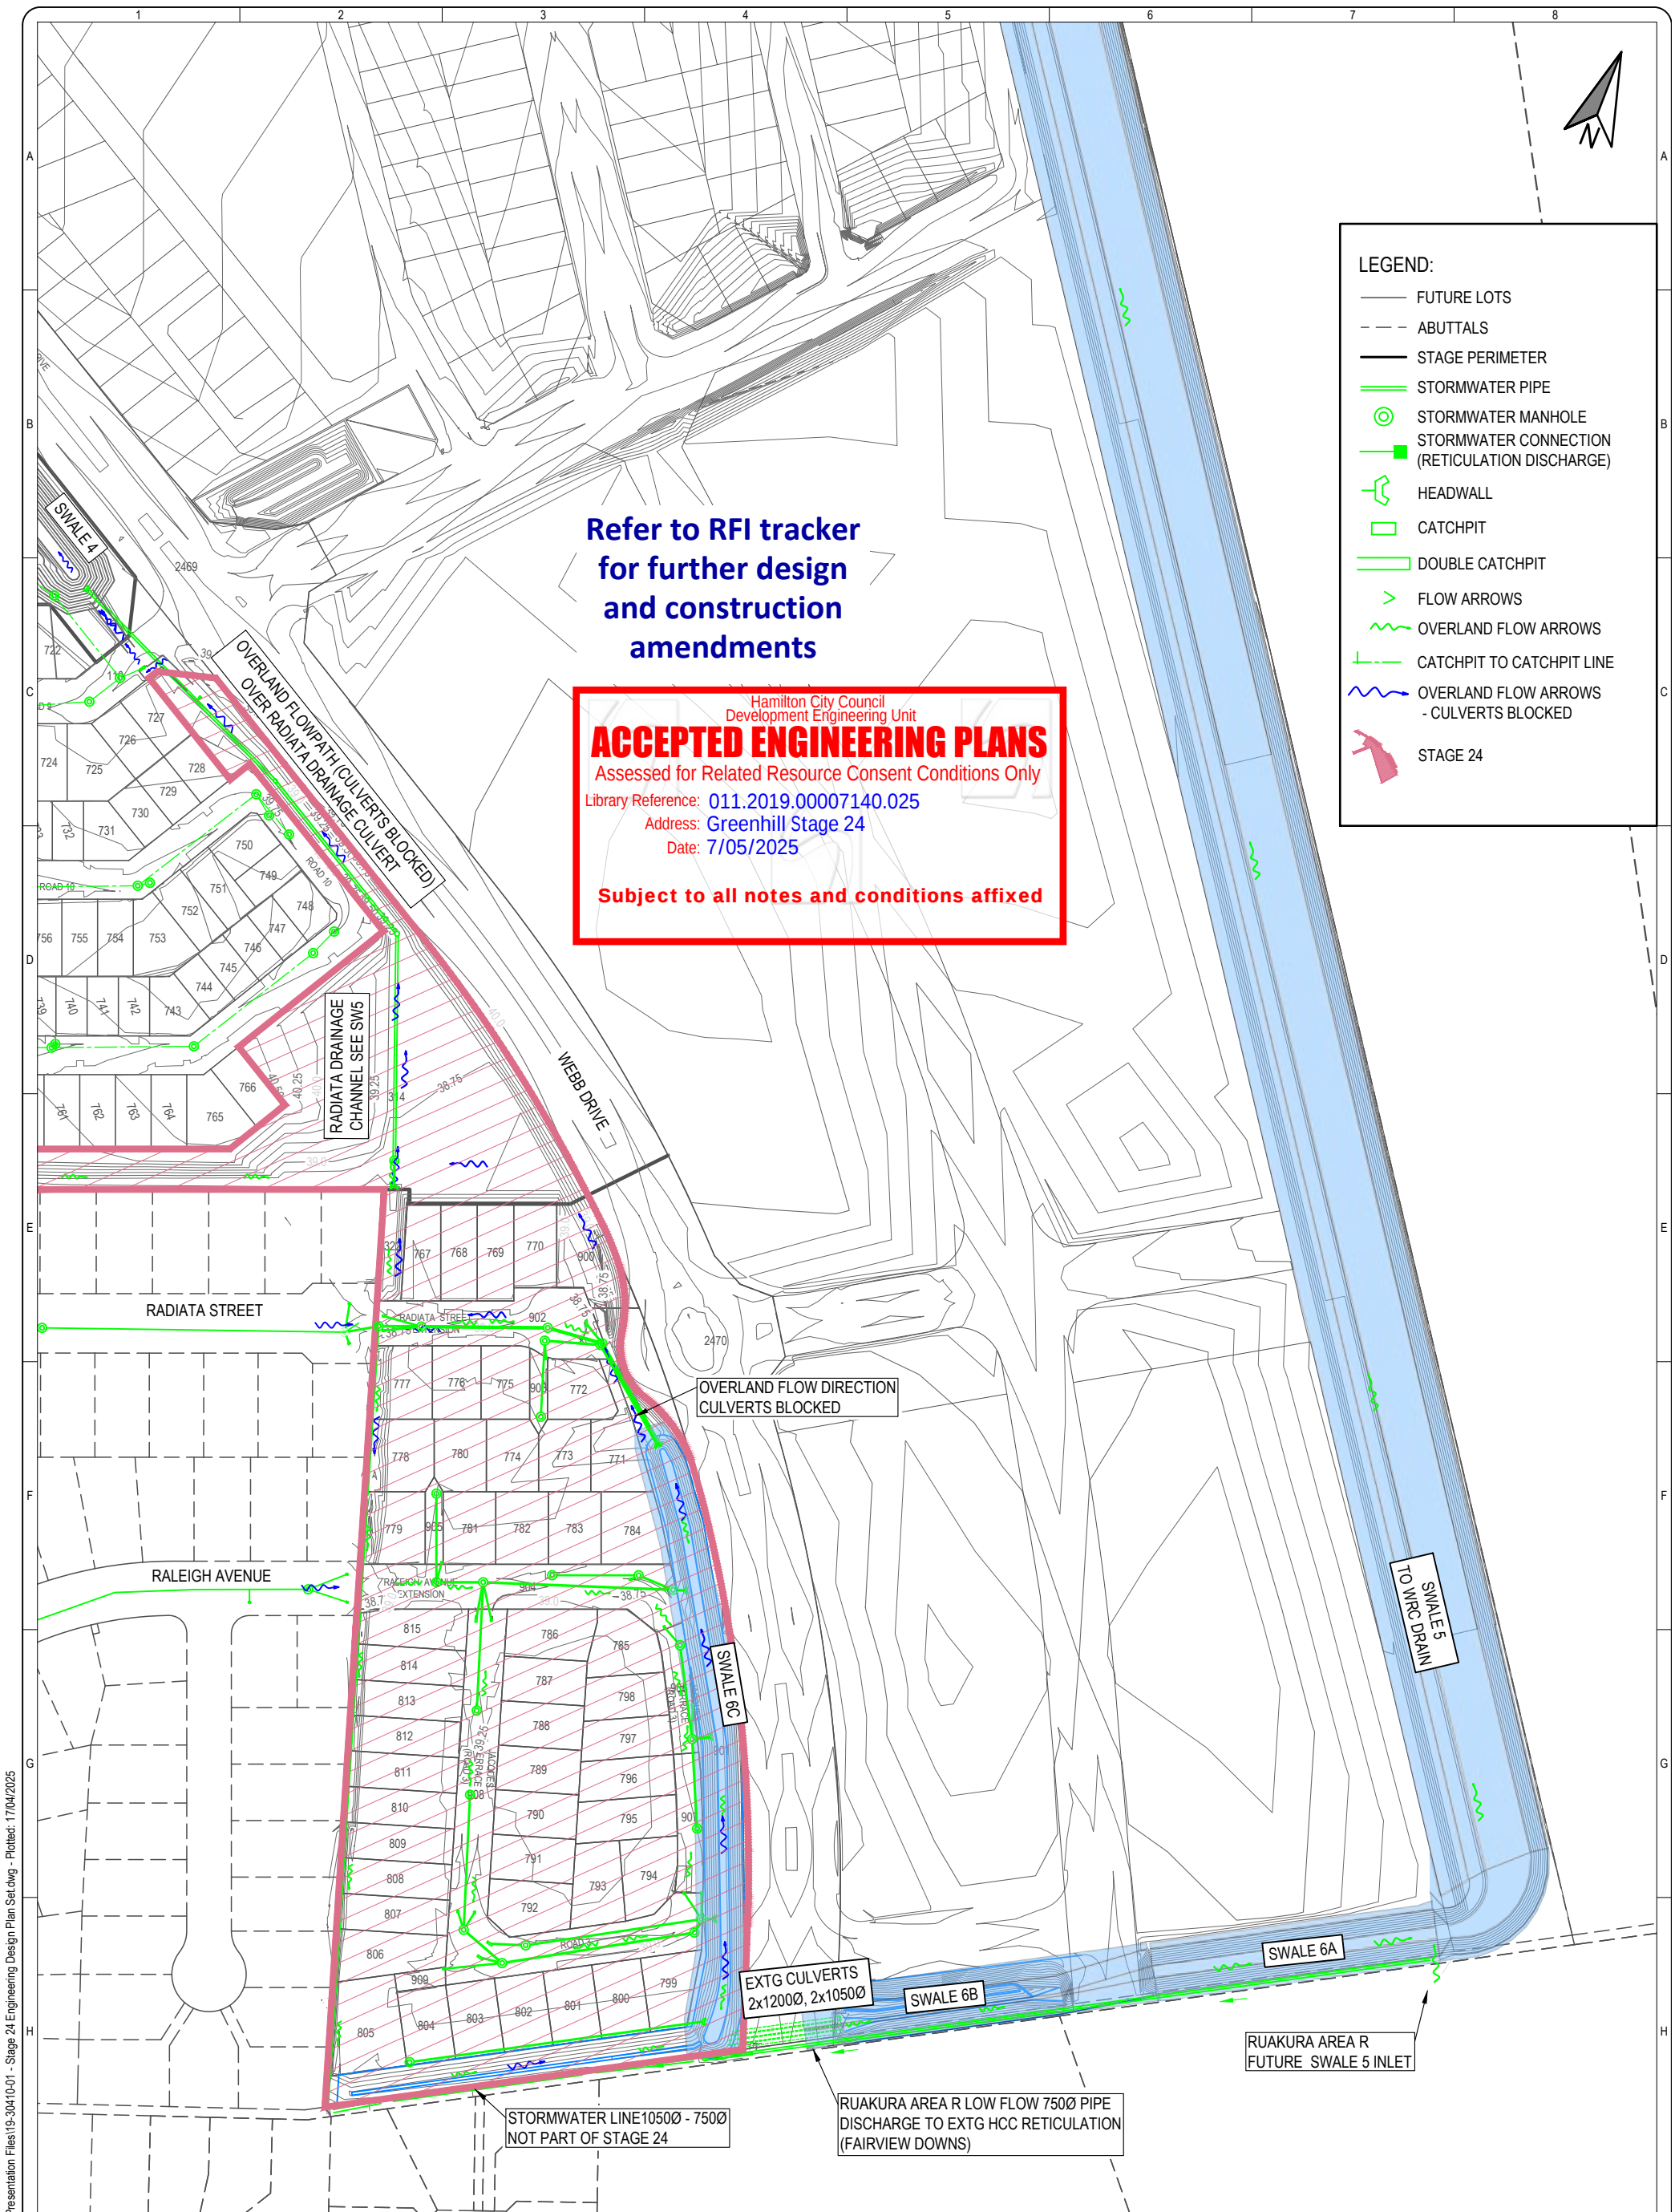

LEGEND:

- FUTURE LOTS
- - - ABUTTALS
- STAGE PERIMETER
- STORMWATER PIPE
- ⊙ STORMWATER MANHOLE
- STORMWATER CONNECTION (RETICULATION DISCHARGE)
- ⌋ HEADWALL
- CATCHPIT
- DOUBLE CATCHPIT
- > FLOW ARROWS
- ~ OVERLAND FLOW ARROWS
- CATCHPIT TO CATCHPIT LINE
- ~ OVERLAND FLOW ARROWS - CULVERTS BLOCKED
- STAGE 24

Refer to RFI tracker
for further design
and construction
amendments

Hamilton City Council
Development Engineering Unit

ACCEPTED ENGINEERING PLANS

Assessed for Related Resource Consent Conditions Only

Library Reference: 011.2019.00007140.025

Address: Greenhill Stage 24

Date: 7/05/2025

Subject to all notes and conditions affixed

R:\Project Files\30410-01-19\01 Drawing Presentation Files\19-30410-01 - Stage 24 Engineering Design Plan Set.dwg - Plotted: 17/04/2025

S&L

SHRIMPTON & LIPINSKI

LAND SPECIALISTS


Ph: 07 577 6069
Email: info@sltga.co.nz
P.O. Box 231, Tauranga 3140
www.sltga.co.nz

GREENHILL

Chedworth
Properties Limited

STORMWATER LOCATION PLAN
STAGE 24

REV	DESCRIPTION	DRN	CKD	APP	DATE	COORDINATE SYSTEM: NZGD 2000 - MT EDEN	STATUS
1	ISSUED FOR RFI	TM	RH	PH	31/10/24	ORIGIN OF COORDINATES: BPV DPS 17824	FOR APPROVAL
2	ISSUED FOR RFI	TM	RH	PH	03/04/25	HEIGHT DATUM: MOTURIKI DATUM 1953	
3	RFI RESPONSE	NW	HB		16/04/25	ORIGIN OF HEIGHT: SS507 SO 42451	
						ORIGINAL SCALES @ A3 1:2000	
						DO NOT SCALE DIMENSIONS	
						DRAWING NO	REVISION
						30410-01-S24-SW0	3
						COPYRIGHT ON THIS DRAWING IS RESERVED	

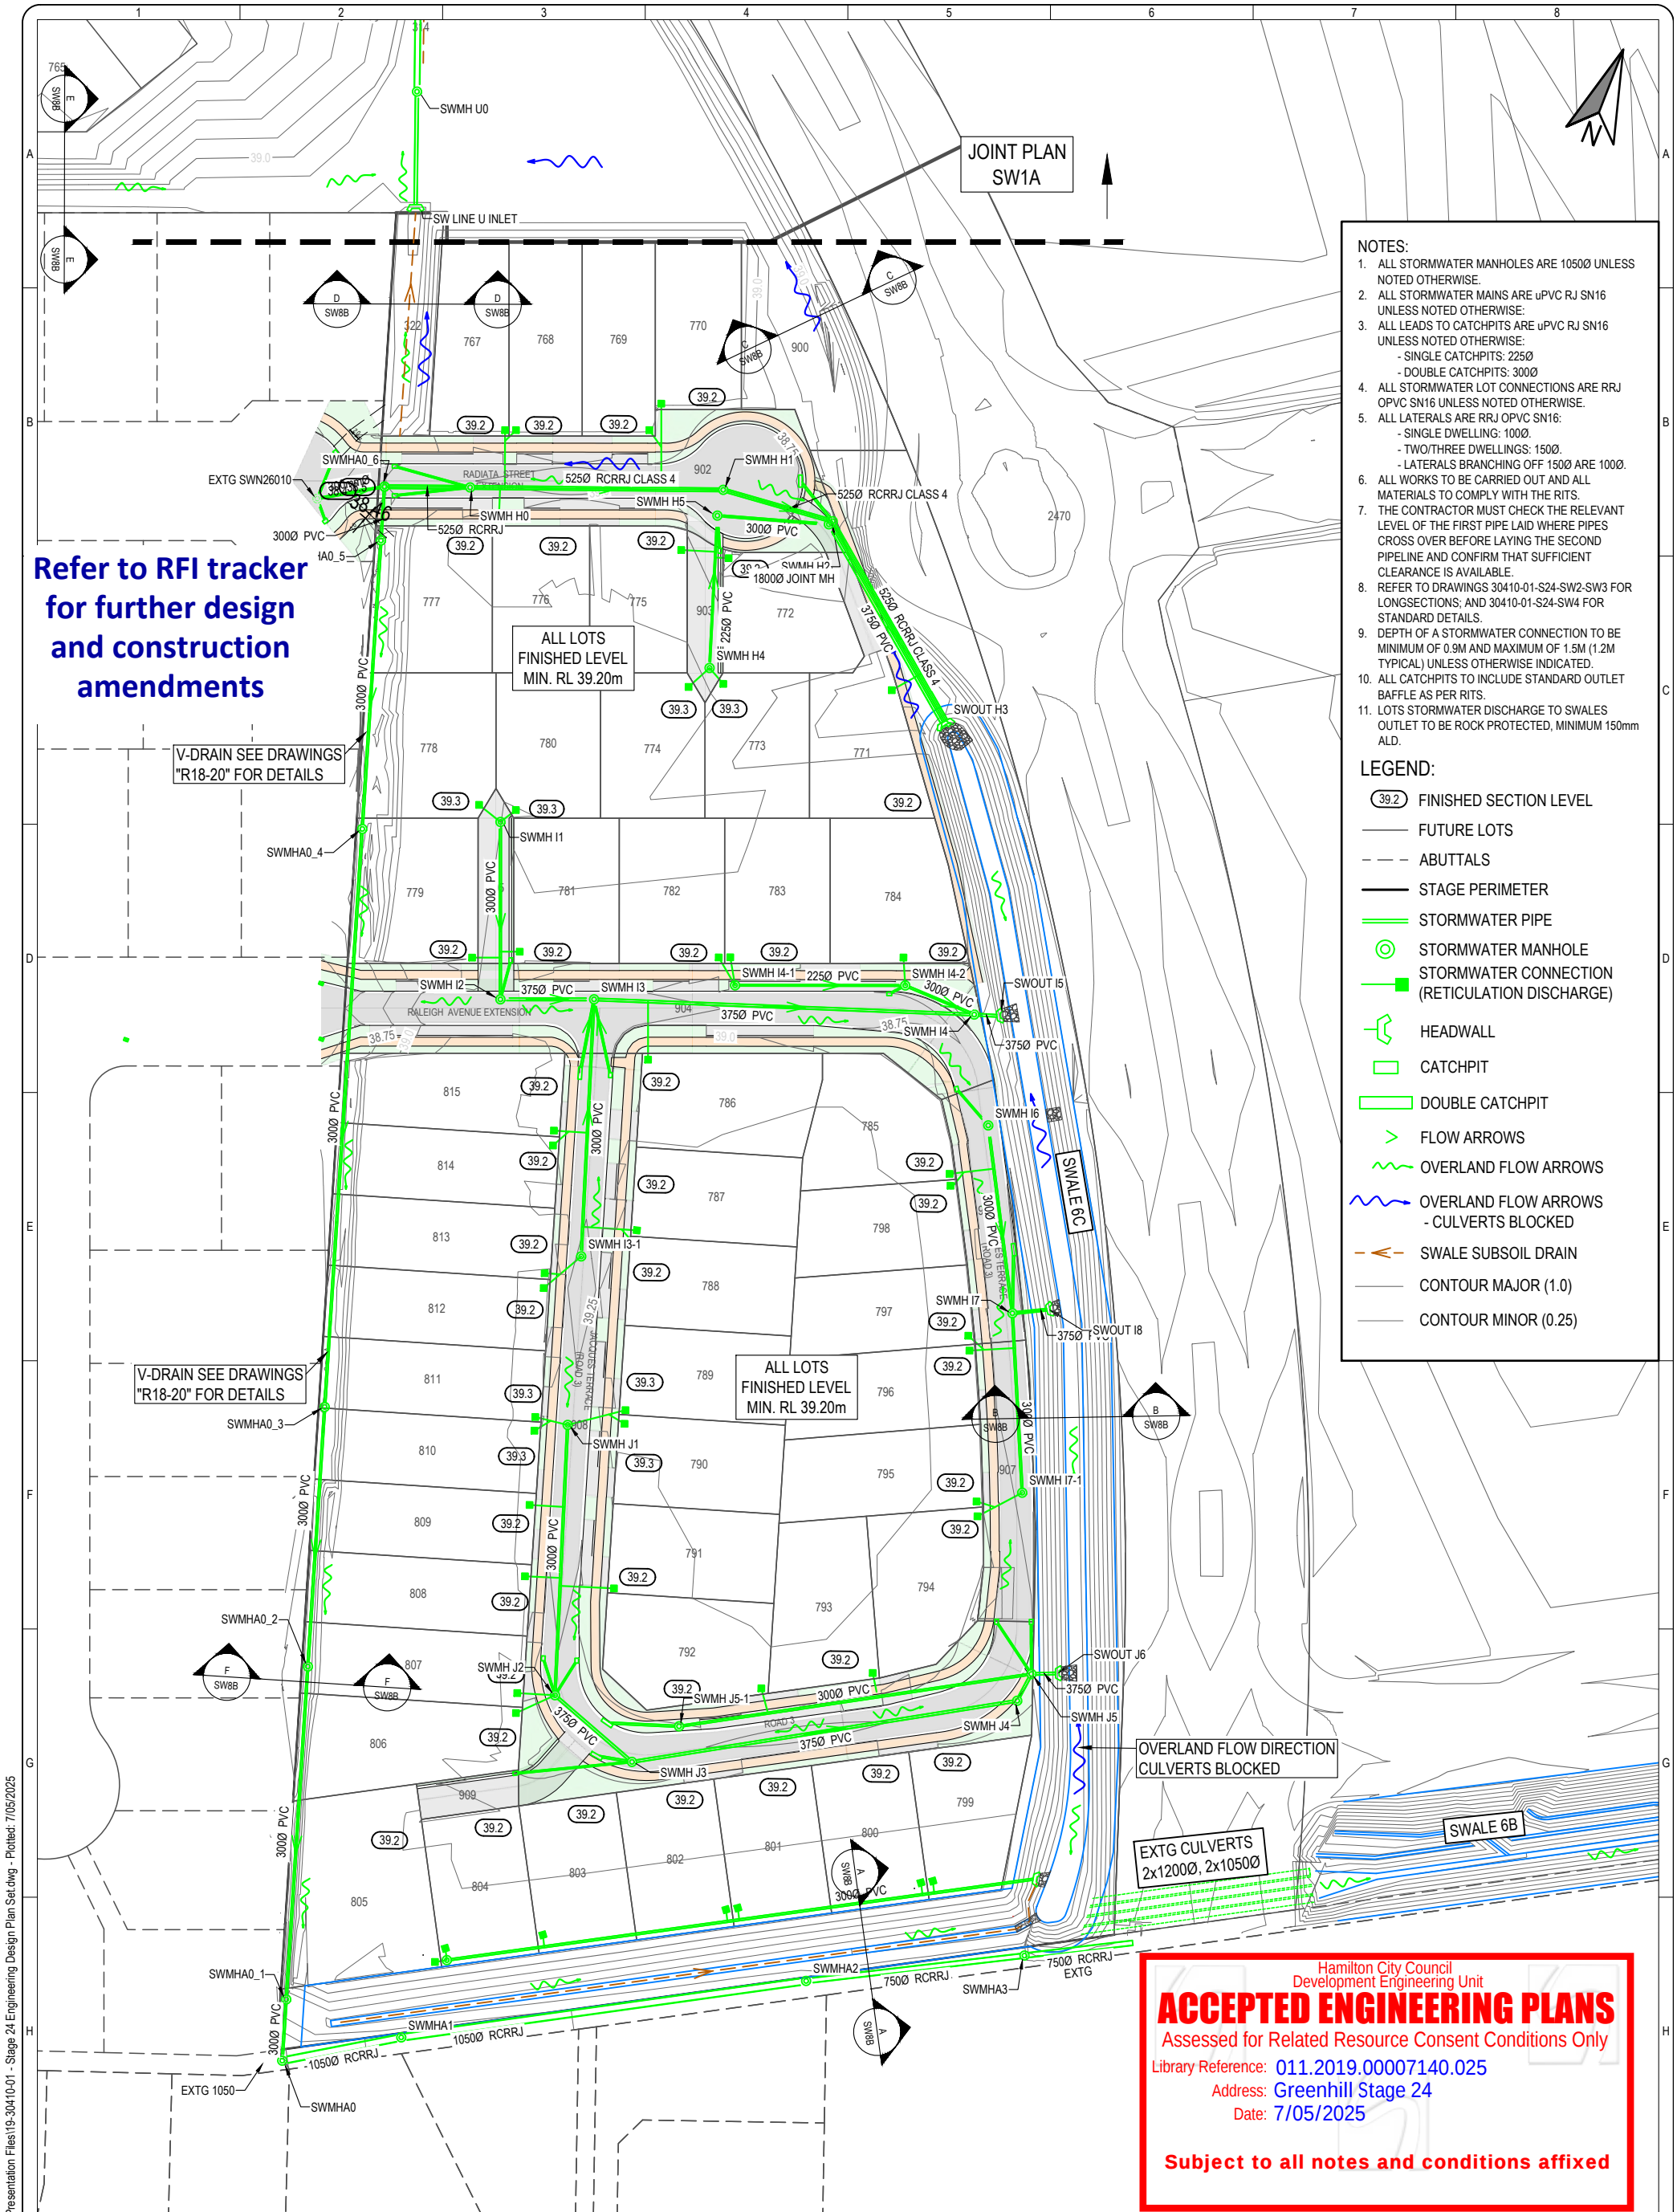

- NOTES:**
1. ALL STORMWATER MANHOLES ARE 10500 UNLESS NOTED OTHERWISE.
 2. ALL STORMWATER MAINS ARE uPVC RJ SN16 UNLESS NOTED OTHERWISE:
 3. ALL LEADS TO CATCHPITS ARE uPVC RJ SN16 UNLESS NOTED OTHERWISE:
 - SINGLE CATCHPITS: 2250
 - DOUBLE CATCHPITS: 3000
 4. ALL STORMWATER LOT CONNECTIONS ARE RRJ OPVC SN16 UNLESS NOTED OTHERWISE.
 5. ALL LATERALS ARE RRJ OPVC SN16:
 - SINGLE DWELLING: 1000
 - TWO/THREE DWELLINGS: 1500
 - LATERALS BRANCHING OFF 1500 ARE 1000.
 6. ALL WORKS TO BE CARRIED OUT AND ALL MATERIALS TO COMPLY WITH THE RITS.
 7. THE CONTRACTOR MUST CHECK THE RELEVANT LEVEL OF THE FIRST PIPE LAID WHERE PIPES CROSS OVER BEFORE LAYING THE SECOND PIPELINE AND CONFIRM THAT SUFFICIENT CLEARANCE IS AVAILABLE.
 8. REFER TO DRAWINGS 30410-01-S24-SW2-SW3 FOR LONGSECTIONS, AND 30410-01-S24-SW4 FOR STANDARD DETAILS.
 9. DEPTH OF A STORMWATER CONNECTION TO BE MINIMUM OF 0.9M AND MAXIMUM OF 1.5M (1.2M TYPICAL) UNLESS OTHERWISE INDICATED.
 10. ALL CATCHPITS TO INCLUDE STANDARD OUTLET BAFFLE AS PER RITS.
 11. LOTS STORMWATER DISCHARGE TO SWALES OUTLET TO BE ROCK PROTECTED, MINIMUM 150mm ALD.
- LEGEND:**
- (39.2) FINISHED SECTION LEVEL
 - FUTURE LOTS
 - - - ABUTTALS
 - STAGE PERIMETER
 - STORMWATER PIPE
 - STORMWATER MANHOLE
 - STORMWATER CONNECTION (RETICULATION DISCHARGE)
 - HEADWALL
 - CATCHPIT
 - DOUBLE CATCHPIT
 - > FLOW ARROWS
 - ~ OVERLAND FLOW ARROWS
 - ~ OVERLAND FLOW ARROWS - CULVERTS BLOCKED
 - SWALE SUBSOIL DRAIN
 - CONTOUR MAJOR (1.0)
 - CONTOUR MINOR (0.25)

Hamilton City Council
Development Engineering Unit

ACCEPTED ENGINEERING PLANS

Assessed for Related Resource Consent Conditions Only

Library Reference: 011.2019.00007140.025

Address: Greenhill Stage 24

Date: 7/05/2025

Subject to all notes and conditions affixed

R:\Project Files\30410-01-1901 Drawing Presentation Files\19-30410-01 - Stage 24 Engineering Design Plan Set.dwg - Plotted: 7/05/2025

SHRIMPTON & LIPINSKI
LAND SPECIALISTS

Ph: 07 577 6069
Email: info@siltga.co.nz
P.O. Box 231, Tauranga 3140
www.siltga.co.nz

Chedworth
Properties Limited

TITLE

**STORMWATER LAYOUT PLAN
STAGE 24**

REV	DESCRIPTION	DRN	CKD	APP	DATE
6	RFI RESPONSE	TM	HB		23/04/25
7	RFI RESPONSE	NW	HB	RH	07/05/25

NAME	DATE	NAME	DATE
SURVEYED		DESIGNED	

COORDINATE SYSTEM: NZGD 2000 - MT EDEN
ORIGIN OF COORDINATES: BPV DPS 17824
HEIGHT DATUM: MOTURIKI DATUM 1953
ORIGIN OF HEIGHT: SS507 SO 42451

ORIGINAL SCALES @ A3
1:1000


DO NOT SCALE DIMENSIONS

DRAWING NO
30410-01-S24-SW1

STATUS
FOR APPROVAL

REVISION
7

COPYRIGHT ON THIS DRAWING IS RESERVED

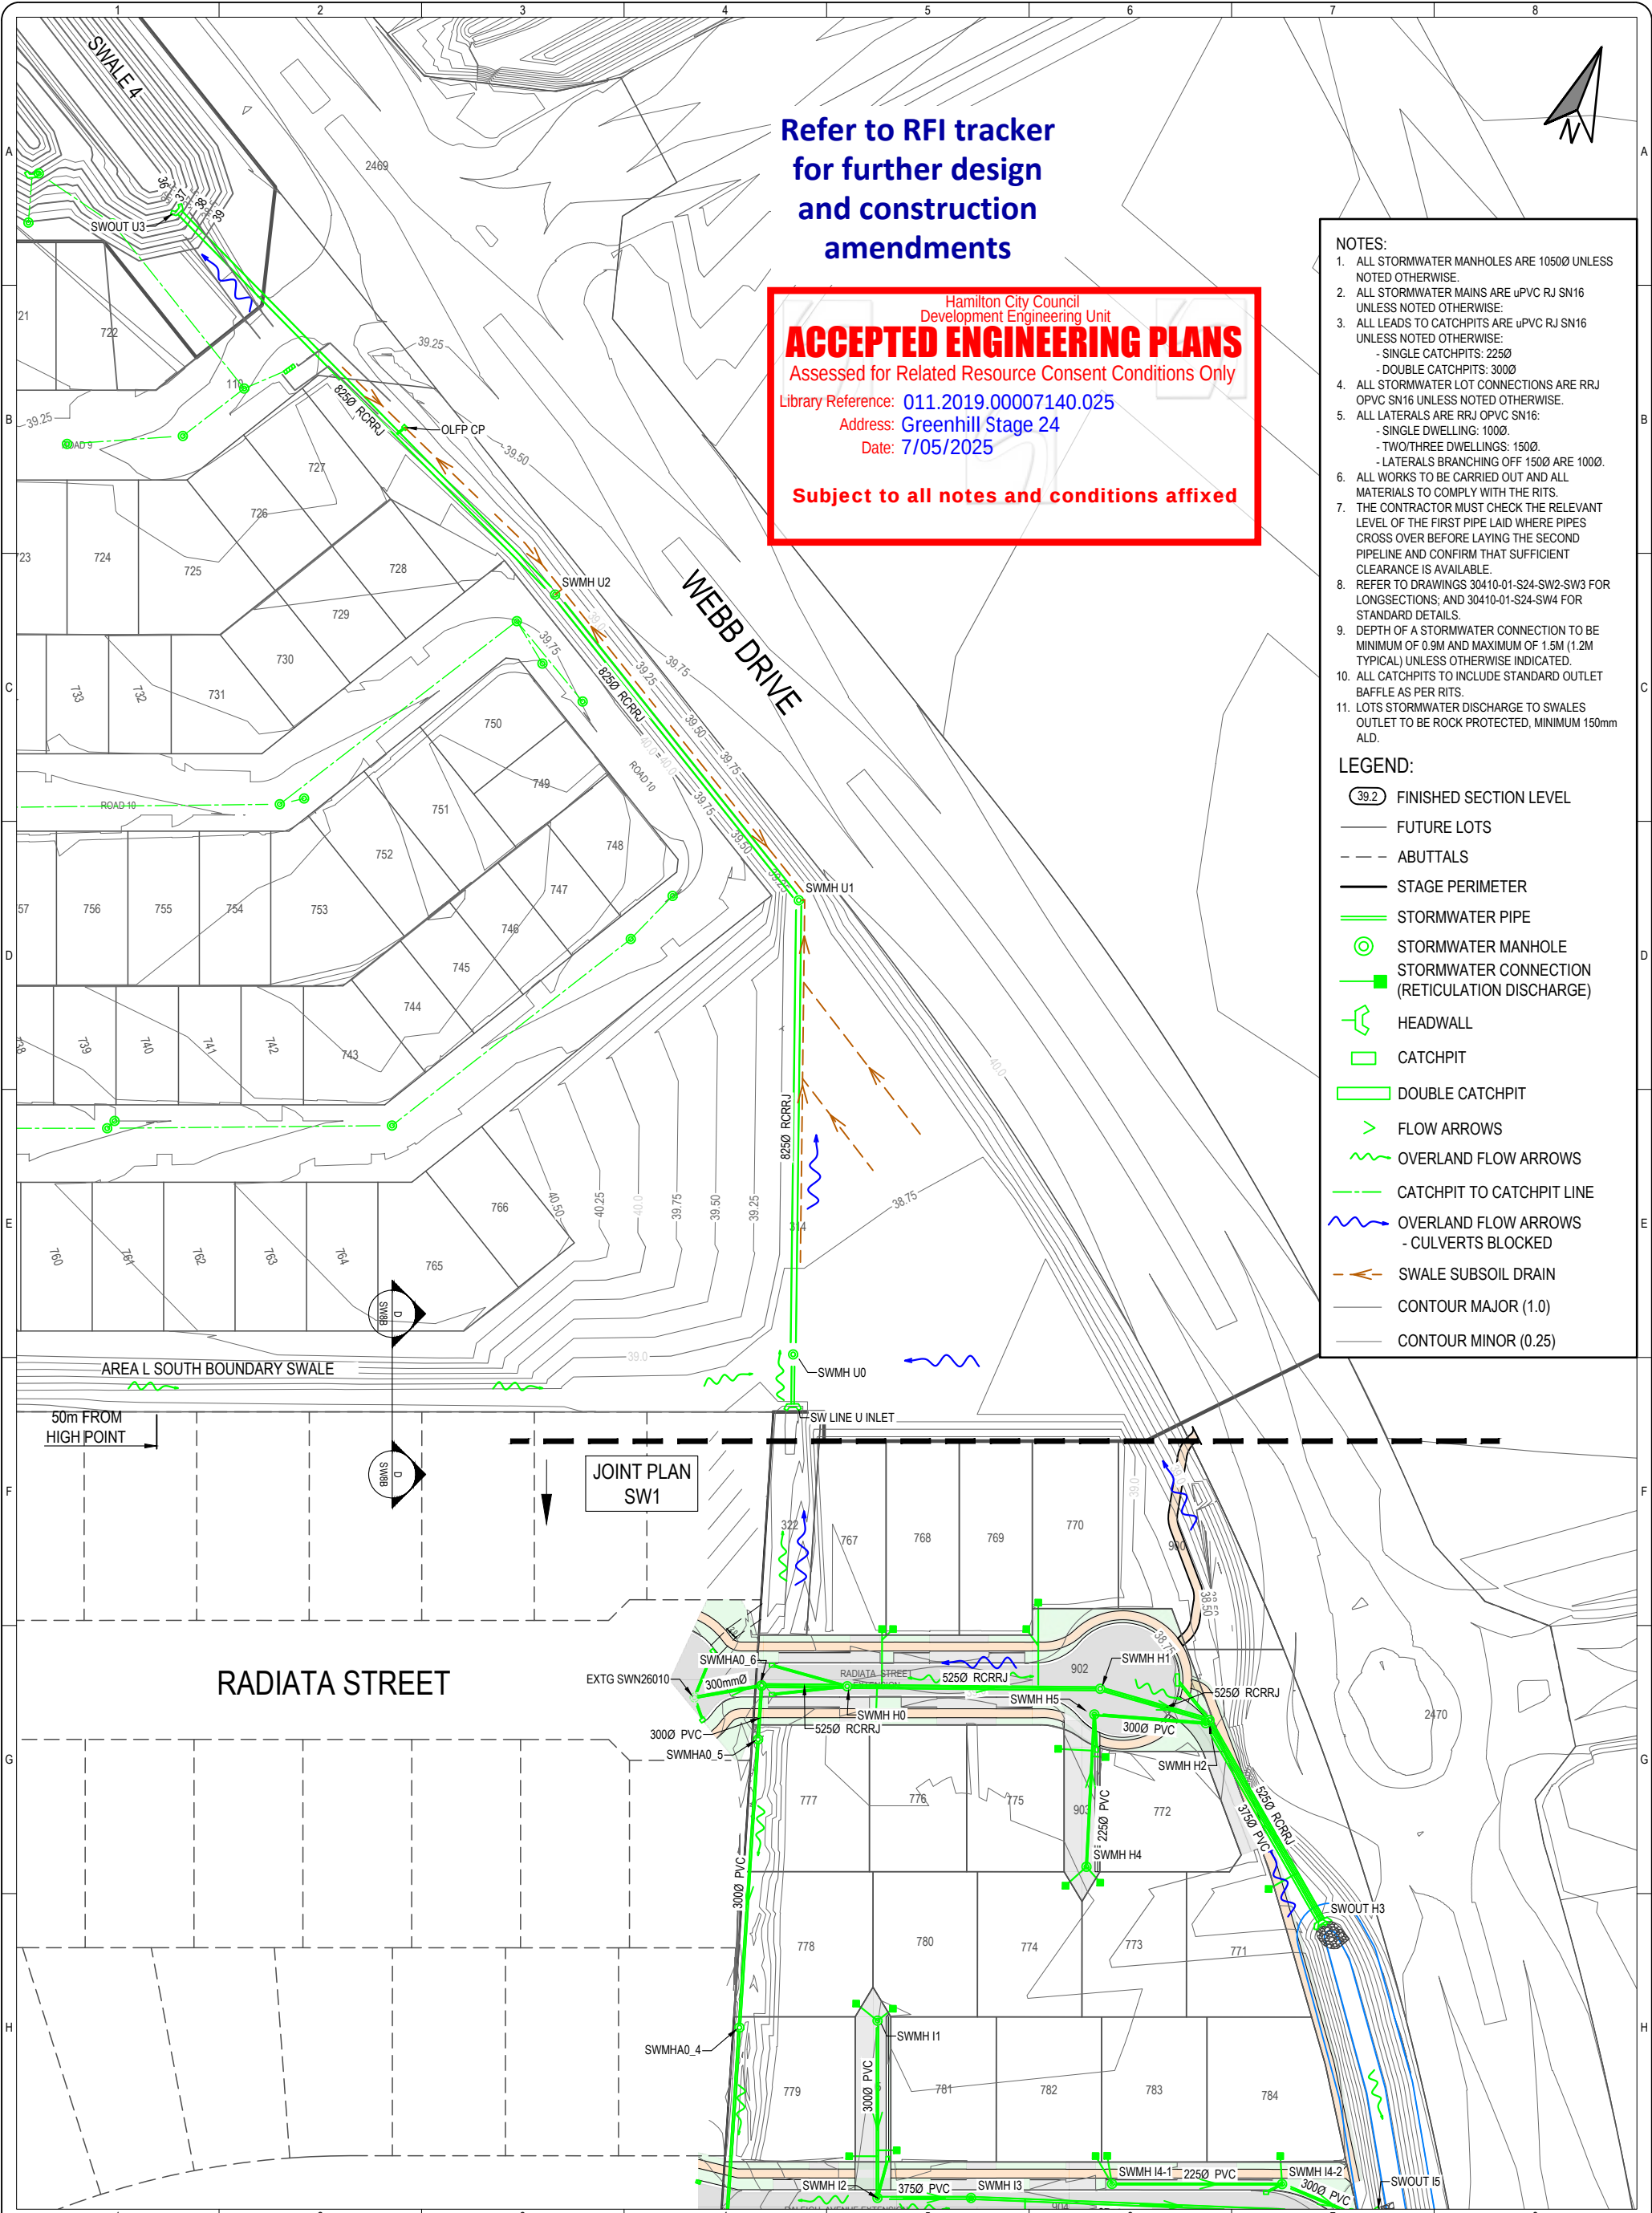

Refer to RFI tracker
for further design
and construction
amendments

Hamilton City Council
Development Engineering Unit

ACCEPTED ENGINEERING PLANS

Assessed for Related Resource Consent Conditions Only

Library Reference: 011.2019.00007140.025

Address: Greenhill Stage 24

Date: 7/05/2025

Subject to all notes and conditions affixed

- NOTES:
1. ALL STORMWATER MANHOLES ARE 1050Ø UNLESS NOTED OTHERWISE.
 2. ALL STORMWATER MAINS ARE uPVC RJ SN16 UNLESS NOTED OTHERWISE:
 3. ALL LEADS TO CATCHPITS ARE uPVC RJ SN16 UNLESS NOTED OTHERWISE:
 - SINGLE CATCHPITS: 225Ø
 - DOUBLE CATCHPITS: 300Ø
 4. ALL STORMWATER LOT CONNECTIONS ARE RRJ OPVC SN16 UNLESS NOTED OTHERWISE.
 5. ALL LATERALS ARE RRJ OPVC SN16:
 - SINGLE DWELLING: 100Ø
 - TWO/THREE DWELLINGS: 150Ø
 - LATERALS BRANCHING OFF 150Ø ARE 100Ø.
 6. ALL WORKS TO BE CARRIED OUT AND ALL MATERIALS TO COMPLY WITH THE RITS.
 7. THE CONTRACTOR MUST CHECK THE RELEVANT LEVEL OF THE FIRST PIPE LAID WHERE PIPES CROSS OVER BEFORE LAYING THE SECOND PIPELINE AND CONFIRM THAT SUFFICIENT CLEARANCE IS AVAILABLE.
 8. REFER TO DRAWINGS 30410-01-S24-SW2-SW3 FOR LONGSECTIONS, AND 30410-01-S24-SW4 FOR STANDARD DETAILS.
 9. DEPTH OF A STORMWATER CONNECTION TO BE MINIMUM OF 0.9M AND MAXIMUM OF 1.5M (1.2M TYPICAL) UNLESS OTHERWISE INDICATED.
 10. ALL CATCHPITS TO INCLUDE STANDARD OUTLET BAFFLE AS PER RITS.
 11. LOTS STORMWATER DISCHARGE TO SWALES OUTLET TO BE ROCK PROTECTED, MINIMUM 150mm ALD.

- LEGEND:
- 39.2 FINISHED SECTION LEVEL
 - FUTURE LOTS
 - ABUTTALS
 - STAGE PERIMETER
 - STORMWATER PIPE
 - STORMWATER MANHOLE
 - STORMWATER CONNECTION (RETICULATION DISCHARGE)
 - HEADWALL
 - CATCHPIT
 - DOUBLE CATCHPIT
 - FLOW ARROWS
 - OVERLAND FLOW ARROWS
 - CATCHPIT TO CATCHPIT LINE
 - OVERLAND FLOW ARROWS - CULVERTS BLOCKED
 - SWALE SUBSOIL DRAIN
 - CONTOUR MAJOR (1.0)
 - CONTOUR MINOR (0.25)

STORMWATER LAYOUT PLAN
STAGE 24 (NORTH)

REV	DESCRIPTION	DRN	CKD	APP	DATE	COORDINATE SYSTEM: NZGD 2000 - MT EDEN
0	ISSUED FOR RFI	NW		PH	26/03/25	ORIGIN OF COORDINATES: BPV DPS 17824
1	SWALES DESIGN REVISED	TM			03/04/25	HEIGHT DATUM: MOTURIKI DATUM 1953
2	RFI RESPONSE	NW	HB		16/04/25	ORIGIN OF HEIGHT: SS507 SO 42451
3	RFI RESPONSE	TM	HB		28/04/25	ORIGINAL SCALES @ A3
						1:1000
						STATUS
						FOR APPROVAL
						DO NOT SCALE DIMENSIONS
						DRAWING NO
						30410-01-S24-SW1A
						REVISION
						3

COPYRIGHT ON THIS DRAWING IS RESERVED

R:\Project Files\30410-01-1901 Drawing Presentation Files\19-30410-01 - Stage 24 Engineering Design Plan Set.dwg - Plotted: 29/04/2025





SHRIMPION &
LIPINSKI
LAND SPECIALISTS

Ph: 07 577 6069
Email: info@slga.co.nz
P.O. Box 231, Tauranga 3140
www.slga.co.nz



Chedworth
Properties Limited

R:\Project Files\30410-01-1901 Drawing Presentation Files\19-30410-01 - Stage 24 Engineering Design Plan Set.dwg - Plotted: 29/04/2025

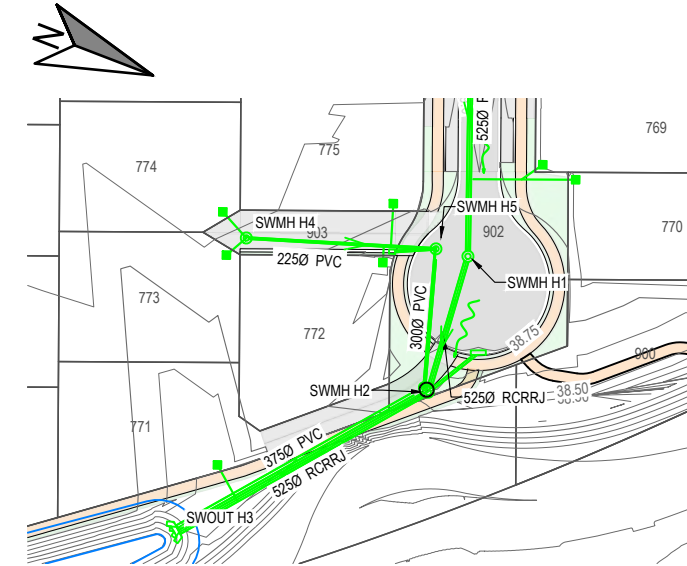
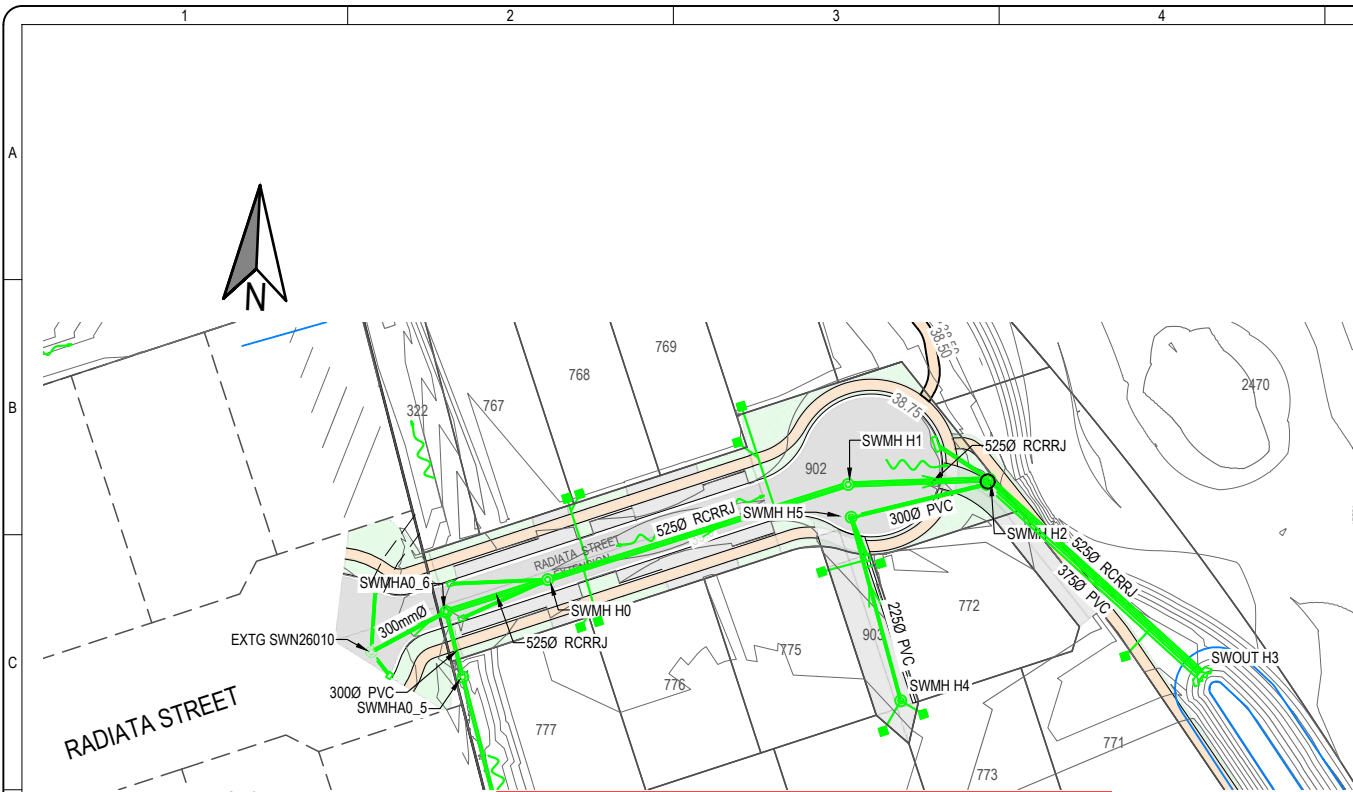


- LEGEND:**
- FUTURE LOTS
 - - - ABUTTALS
 - STAGE PERIMETER
 - STORMWATER PIPE
 - ⊙ STORMWATER MANHOLE
 - STORMWATER CONNECTION (RETICULATION DISCHARGE)
 - STORMWATER CONNECTION (SWALE DISCHARGE)
 - HEADWALL
 - CATCHPIT
 - DOUBLE CATCHPIT
 - > FLOW ARROWS
 - ~ OVERLAND FLOW ARROWS
 - CONTOUR MAJOR (1.0)
 - CONTOUR MINOR (0.25)

- NOTES:**
1. ALL STORMWATER MANHOLES ARE 1050Ø UNLESS NOTED OTHERWISE.
 2. ALL STORMWATER MAINS ARE uPVC RJ SN16 UNLESS NOTED OTHERWISE.
 3. ALL LEADS TO CATCHPITS ARE uPVC RJ SN16 UNLESS NOTED OTHERWISE:
 - SINGLE CATCHPITS: 225Ø
 - DOUBLE CATCHPITS: 300Ø
 4. ALL STORMWATER LOT CONNECTIONS ARE RRJ OPVC SN16 UNLESS NOTED OTHERWISE:
 - SINGLE DWELLING: 100Ø
 - TWO/THREE DWELLINGS: 150Ø
 - LATERALS BRANCHING OFF 150Ø ARE 100Ø.
 5. ALL LATERALS ARE RRJ OPVC SN16:
 - SINGLE DWELLING: 100Ø
 - TWO/THREE DWELLINGS: 150Ø
 - LATERALS BRANCHING OFF 150Ø ARE 100Ø.
 6. ALL WORKS TO BE CARRIED OUT AND ALL MATERIALS TO COMPLY WITH THE RITS.
 7. THE CONTRACTOR MUST CHECK THE RELEVANT LEVEL OF THE FIRST PIPE LAID WHERE PIPES CROSS OVER BEFORE LAYING THE SECOND PIPELINE AND CONFIRM THAT SUFFICIENT CLEARANCE IS AVAILABLE.
 8. REFER TO DRAWING 30410-01-S24-SW4 FOR STANDARD DETAILS.
 9. DEPTH OF A STORMWATER CONNECTION TO BE MINIMUM OF 0.9M AND MAXIMUM OF 1.5M (1.2M TYPICAL) UNLESS OTHERWISE INDICATED.
 10. ALL CATCHPITS TO INCLUDE STANDARD OUTLET BAFFLE AS PER RITS.
 11. LOTS STORMWATER DISCHARGE TO SWALES OUTLET TO BE ROCK PROTECTED, MINIMUM 150mm ALD.

Hamilton City Council
Development Engineering Unit
ACCEPTED ENGINEERING PLANS
Assessed for Related Resource Consent Conditions Only
Library Reference: 011.2019.00007140.025
Address: Greenhill Stage 24
Date: 7/05/2025
Subject to all notes and conditions affixed

Refer to RFI tracker
for further design
and construction
amendments

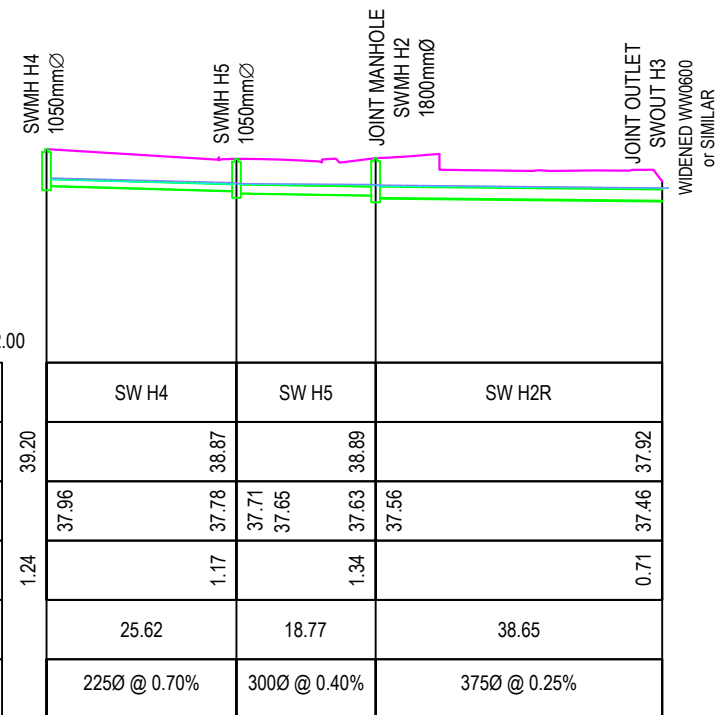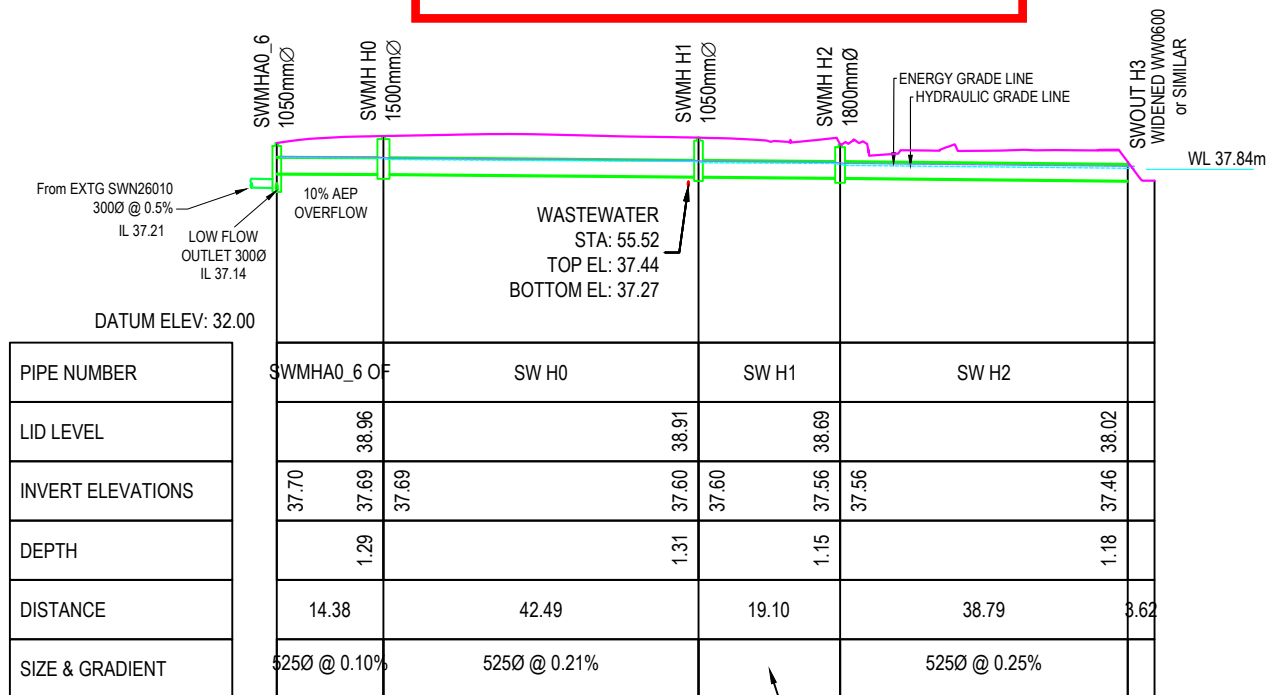

Rev	DESCRIPTION	DRN	CKD	APP	DATE
0	PRELIMINARY	NW	HB	PH	13/8/24
1	ISSUED FOR EPA	NW	HB	PH	16/8/24
2	ISSUED FOR RFI	TM	RH	PH	23/10/24
3	ISSUED FOR RFI	TM		PH	03/04/25
4	RFI RESPONSE	NW	HB		16/04/25
5	RFI RESPONSE	TM	HB		28/04/25

NAME	DATE	NAME	DATE
SURVEYED		DESIGNED	
COORDINATE SYSTEM: NZGD 2000 - MT EDEN			
ORIGIN OF COORDINATES: BPV DPS 17824			
HEIGHT DATUM: MOTURIKI DATUM 1953			
ORIGIN OF HEIGHT: SS507 SO 42451			

TITLE

**STORMWATER
LINES H & H4
LONGSECTION**



AREAS L,U & K


ORIGINAL SCALES @ A3 STATUS

H 1:1000 V 1:250 FOR APPROVAL

DO NOT SCALE DIMENSIONS

DRAWING NO 30410-01-S24-SW2

REVISION 5

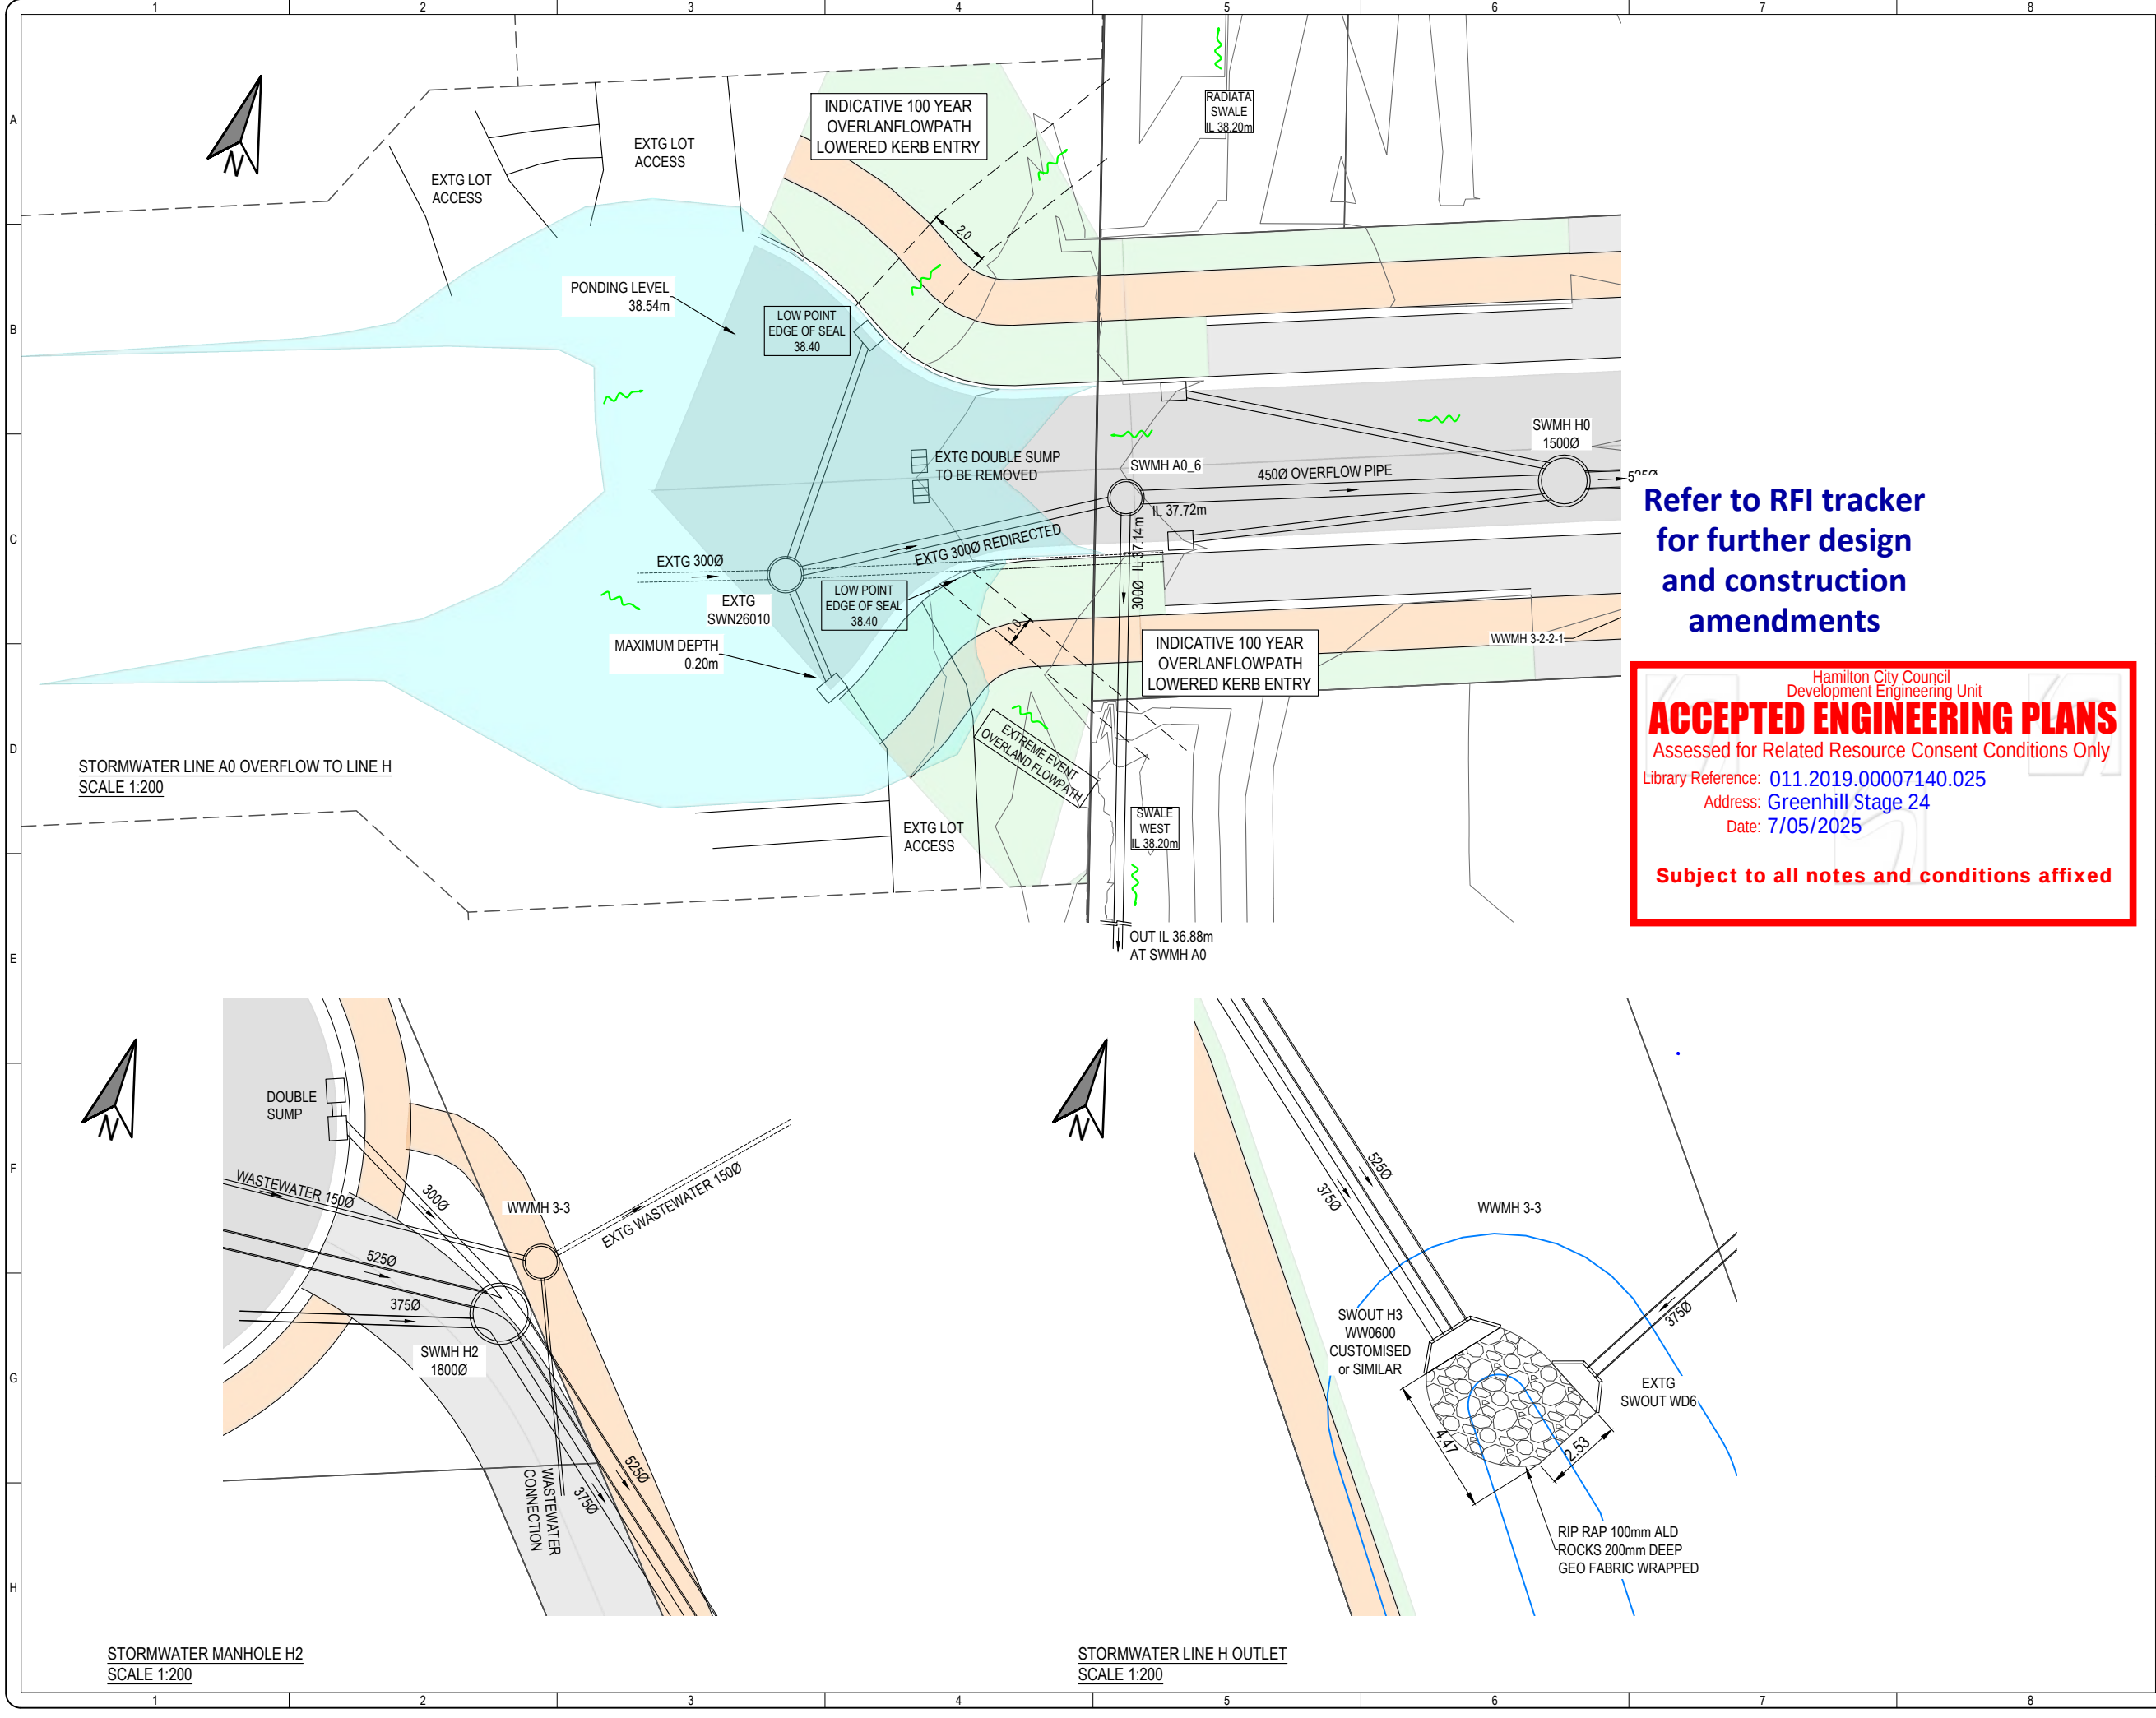

SHRIMPTON &
LIPINSKI
LAND DEVELOPMENT &
DESIGN SPECIALISTS
Ph. 07 577 6069
Email: info@sltga.co.nz
P.O. Box 231, Tauranga 3140
www.sltga.co.nz

NOTES:

1. ALL STORMWATER MANHOLES ARE 10500 UNLESS NOTED OTHERWISE.
2. ALL STORMWATER MAINS ARE uPVC RJ SN16 UNLESS NOTED OTHERWISE.
3. ALL LEADS TO CATCHPITS ARE uPVC RJ SN16 UNLESS NOTED OTHERWISE:
 - SINGLE CATCHPITS: 2250
 - DOUBLE CATCHPITS: 3000
4. ALL STORMWATER LOT CONNECTIONS ARE RRJ OPVC SN16 UNLESS NOTED OTHERWISE:
 - SINGLE DWELLING: 1000
 - TWO/THREE DWELLINGS: 1500
 - LATERALS BRANCHING OFF 1500 ARE 1000
5. ALL LATERALS ARE RRJ OPVC SN16:
 - SINGLE DWELLING: 1000
 - TWO/THREE DWELLINGS: 1500
 - LATERALS BRANCHING OFF 1500 ARE 1000
6. ALL WORKS TO BE CARRIED OUT AND ALL MATERIALS TO COMPLY WITH THE RITS.
7. THE CONTRACTOR MUST CHECK THE RELEVANT LEVEL OF THE FIRST PIPE LAID WHERE PIPES CROSS OVER BEFORE LAYING THE SECOND PIPELINE AND CONFIRM THAT SUFFICIENT CLEARANCE IS AVAILABLE.
8. REFER TO DRAWING 30410-01-S24-SW4 FOR STANDARD DETAILS.
9. DEPTH OF A STORMWATER CONNECTION TO BE MINIMUM OF 0.9M AND MAXIMUM OF 1.5M (1.2M TYPICAL) UNLESS OTHERWISE INDICATED.
10. ALL CATCHPITS TO INCLUDE STANDARD OUTLET BAFFLE AS PER RITS.
11. LOTS STORMWATER DISCHARGE TO SWALES OUTLET TO BE ROCK PROTECTED, MINIMUM 150mm ALD.

Rev	DESCRIPTION	DRN	CKD	APP	DATE
0	PRELIMINARY	NW			13/8/24
1	ISSUED FOR EPA	NW	HB	PH	16/8/24
2	ISSUED FOR RFI	TM	RH	PH	23/10/24
3	ISSUED FOR RFI	TM		PH	03/04/25
4	RFI RESPONSE	NW	HB		16/04/25
5	RFI RESPONSE	TM	HB		23/04/25
6	RFI Response	TM	HB	RH	29/04/25

NAME	DATE	NAME	DATE

SURVEYED: DESIGNED:

COORDINATE SYSTEM: NZGD 2000 - MT EDEN

ORIGIN OF COORDINATES: BPV DPS 17824

HEIGHT DATUM: MOTURIKI DATUM 1953

ORIGIN OF HEIGHT: SS507 SO 42451

TITLE

STORMWATER LINES H & H4 DETAILS

PREPARED FOR

Chedworth Properties Limited

AREAS L,U & K

ORIGINAL SCALES @ A3	STATUS
1:200	FOR APPROVAL


DO NOT SCALE DIMENSIONS

DRAWING NO 30410-01-S24-SW2A

REVISION 6

COPYRIGHT ON THIS DRAWING IS RESERVED

R:\Project Files\30410-01-1901 Drawing Presentation Files\19-30410-01 - Stage 24 Engineering Design Plan Set.dwg - Plotted: 17/04/2025

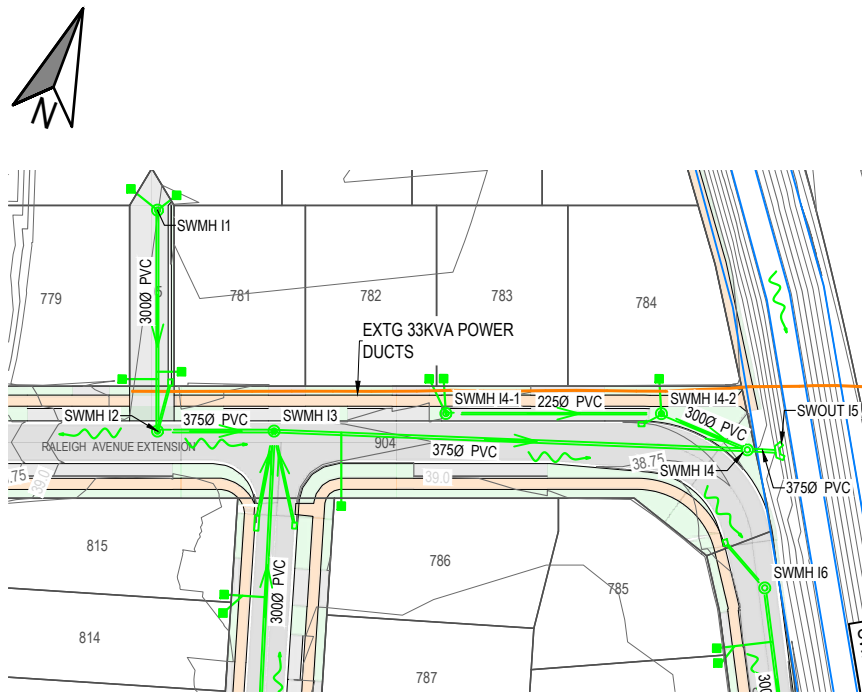


STORMWATER LINE I PLAN
SCALE 1:1000




STORMWATER LINE I3 PLAN
SCALE 1:1000

- LEGEND:
- FUTURE LOTS
 - - - ABUTTALS
 - STAGE PERIMETER
 - STORMWATER PIPE
 - ⊙ STORMWATER MANHOLE
 - STORMWATER CONNECTION (RETICULATION DISCHARGE)
 - STORMWATER CONNECTION (SWALE DISCHARGE)
 - HEADWALL
 - CATCHPIT
 - DOUBLE CATCHPIT
 - > FLOW ARROWS
 - ~ OVERLAND FLOW ARROWS
 - CONTOUR MAJOR (1.0)
 - CONTOUR MINOR (0.25)

- NOTES:
- ALL STORMWATER MANHOLES ARE 1050Ø UNLESS NOTED OTHERWISE.
 - ALL STORMWATER MAINS ARE uPVC RJ SN16 UNLESS NOTED OTHERWISE.
 - ALL LEADS TO CATCHPITS ARE uPVC RJ SN16 UNLESS NOTED OTHERWISE:
 - SINGLE CATCHPITS: 225Ø
 - DOUBLE CATCHPITS: 300Ø
 - ALL STORMWATER LOT CONNECTIONS ARE RRJ OPVC SN16 UNLESS NOTED OTHERWISE.
 - SINGLE DWELLING: 100Ø
 - TWO/THREE DWELLINGS: 150Ø
 - LATERALS BRANCHING OFF 150Ø ARE 100Ø.
 - ALL LATERALS ARE RRJ OPVC SN16:
 - SINGLE DWELLING: 100Ø
 - TWO/THREE DWELLINGS: 150Ø
 - LATERALS BRANCHING OFF 150Ø ARE 100Ø.
 - ALL WORKS TO BE CARRIED OUT AND ALL MATERIALS TO COMPLY WITH THE RITS.
 - THE CONTRACTOR MUST CHECK THE RELEVANT LEVEL OF THE FIRST PIPE LAID WHERE PIPES CROSS OVER BEFORE LAYING THE SECOND PIPELINE AND CONFIRM THAT SUFFICIENT CLEARANCE IS AVAILABLE.
 - REFER TO DRAWING 30410-01-S24-SW4 FOR STANDARD DETAILS.
 - DEPTH OF A STORMWATER CONNECTION TO BE MINIMUM OF 0.9M AND MAXIMUM OF 1.5M (1.2M TYPICAL) UNLESS OTHERWISE INDICATED.
 - ALL CATCHPITS TO INCLUDE STANDARD OUTLET BAFFLE AS PER RITS.
 - LOTS STORMWATER DISCHARGE TO SWALES OUTLET TO BE ROCK PROTECTED, MINIMUM 150mm ALD.

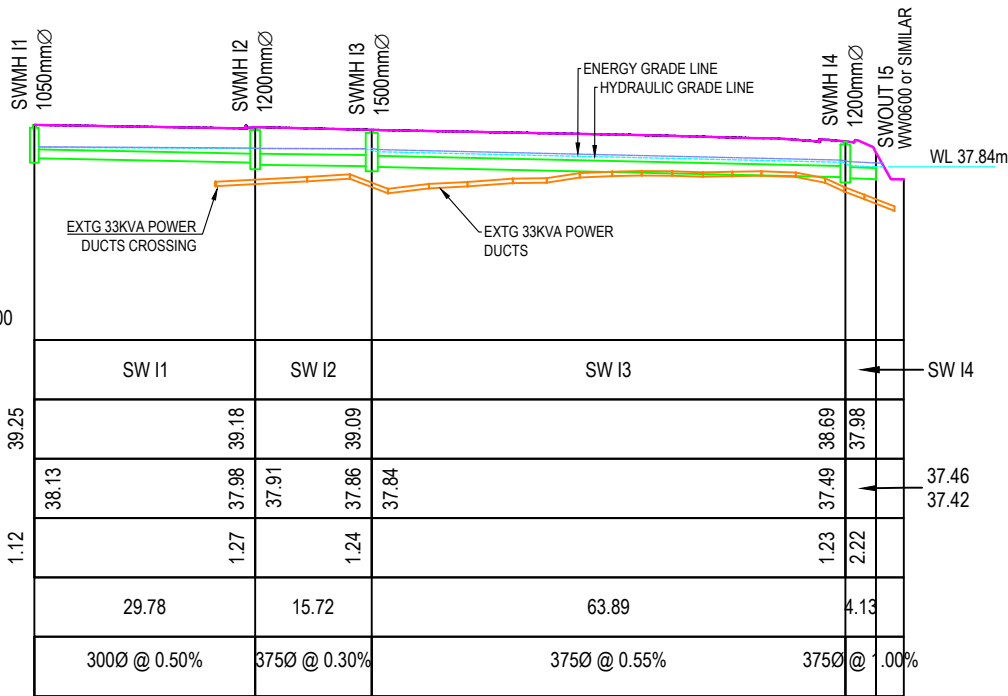

STORMWATER LINE I LONGSECTION

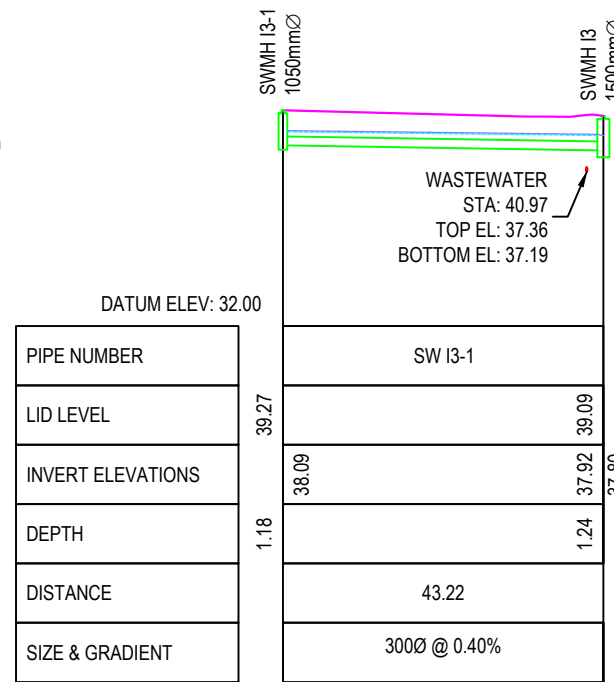

STORMWATER LINE I3 LONGSECTION

Refer to RFI tracker
for further design
and construction
amendments

Hamilton City Council
Development Engineering Unit

ACCEPTED ENGINEERING PLANS

Assessed for Related Resource Consent Conditions Only

Library Reference: 011.2019.00007140.025

Address: Greenhill Stage 24

Date: 7/05/2025

Subject to all notes and conditions affixed

Rev	DESCRIPTION	DRN	CKD	APP	DATE
0	PRELIMINARY	NW	HB	PH	13/8/24
1	ISSUED FOR EPA	NW	HB	PH	16/8/24
2	ISSUED FOR RFI	TM	RH	PH	23/10/24
3	ISSUED FOR RFI	TM	RH	PH	03/04/25
4	RFI RESPONSE	NW	HB		16/04/25

NAME	DATE	NAME	DATE
SURVEYED		DESIGNED	
COORDINATE SYSTEM: NZGD 2000 - MT EDEN			
ORIGIN OF COORDINATES: BPV DPS 17824			
HEIGHT DATUM: MOTURIKI DATUM 1953			
ORIGIN OF HEIGHT: SS507 SO 42451			

TITLE

**STORMWATER
LINES I & I3
LONGSECTION**

PREPARED FOR

**Chedworth
Properties Limited**

AREAS L,U & K


ORIGINAL SCALES @ A3 STATUS

H 1:1000 V 1:250 FOR APPROVAL


DO NOT SCALE DIMENSIONS

DRAWING NO 30410-01-S24-SW2B REVISION 4


R:\Project Files\30410-01-1901 Drawing Presentation Files\19-30410-01 - Stage 24 Engineering Design Plan Set.dwg - Plotted: 17/04/2025

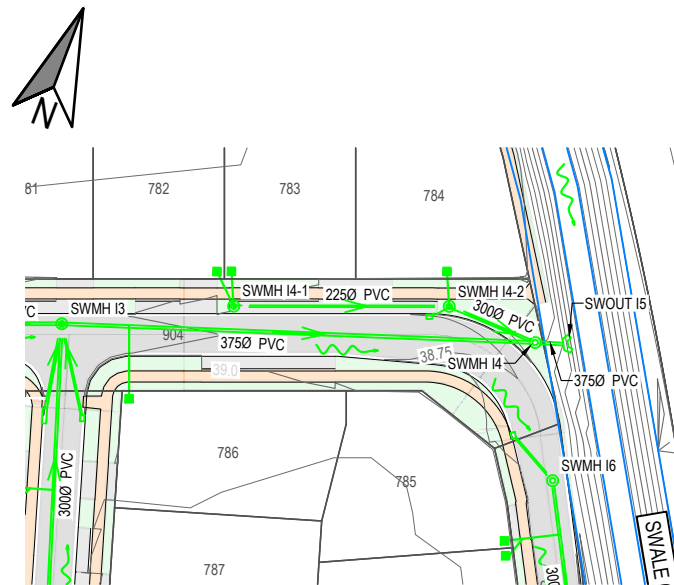

STORMWATER LINE I5 PLAN
SCALE 1:1000

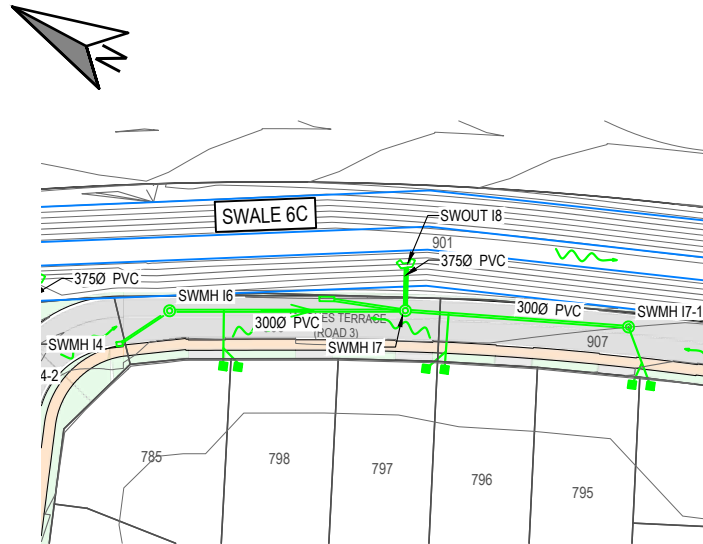

STORMWATER LINE I6 PLAN
SCALE 1:1000

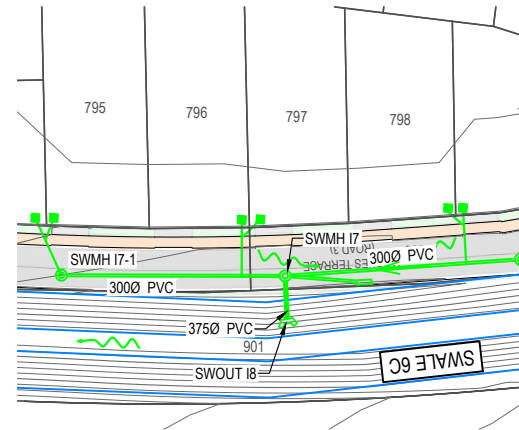

STORMWATER LINE I7 PLAN
SCALE 1:1000

- LEGEND:
- FUTURE LOTS
 - - - ABUTTALS
 - STAGE PERIMETER
 - STORMWATER PIPE
 - ⊙ STORMWATER MANHOLE
 - STORMWATER CONNECTION (RETICULATION DISCHARGE)
 - STORMWATER CONNECTION (SWALE DISCHARGE)
 - HEADWALL
 - CATCHPIT
 - DOUBLE CATCHPIT
 - > FLOW ARROWS
 - ~ OVERLAND FLOW ARROWS
 - CONTOUR MAJOR (1.0)
 - CONTOUR MINOR (0.25)

- NOTES:
- ALL STORMWATER MANHOLES ARE 1050Ø UNLESS NOTED OTHERWISE.
 - ALL STORMWATER MAINS ARE uPVC RJ SN16 UNLESS NOTED OTHERWISE.
 - ALL LEADS TO CATCHPITS ARE uPVC RJ SN16 UNLESS NOTED OTHERWISE:
 - SINGLE CATCHPITS: 225Ø
 - DOUBLE CATCHPITS: 300Ø
 - ALL STORMWATER LOT CONNECTIONS ARE RRJ OPVC SN16 UNLESS NOTED OTHERWISE:
 - SINGLE DWELLING: 100Ø
 - TWO/THREE DWELLINGS: 150Ø
 - LATERALS BRANCHING OFF 150Ø ARE 100Ø.
 - ALL LATERALS ARE RRJ OPVC SN16:
 - SINGLE DWELLING: 100Ø
 - TWO/THREE DWELLINGS: 150Ø
 - LATERALS BRANCHING OFF 150Ø ARE 100Ø.
 - ALL WORKS TO BE CARRIED OUT AND ALL MATERIALS TO COMPLY WITH THE RITS.
 - THE CONTRACTOR MUST CHECK THE RELEVANT LEVEL OF THE FIRST PIPE LAID WHERE PIPES CROSS OVER BEFORE LAYING THE SECOND PIPELINE AND CONFIRM THAT SUFFICIENT CLEARANCE IS AVAILABLE.
 - REFER TO DRAWING 30410-01-S24-SW4 FOR STANDARD DETAILS.
 - DEPTH OF A STORMWATER CONNECTION TO BE MINIMUM OF 0.9M AND MAXIMUM OF 1.5M (1.2M TYPICAL) UNLESS OTHERWISE INDICATED.
 - ALL CATCHPITS TO INCLUDE STANDARD OUTLET BAFFLE AS PER RITS.
 - LOTS STORMWATER DISCHARGE TO SWALES OUTLET TO BE ROCK PROTECTED, MINIMUM 150mm ALD.

DATUM ELEV: 32.00		SWMH I4-1 1050mmØ		SWMH I4-2 1050mmØ		SWMH I4 1200mmØ	
PIPE NUMBER		SW I4-1		SW I4-2			
LID LEVEL	38.86						
INVERT ELEVATIONS		37.88	37.68	38.86	37.60	37.54	38.69
DEPTH	0.98	1.26				1.23	
DISTANCE		29.07				12.57	
SIZE & GRADIENT		225Ø @ 0.70%		300Ø @ 0.50%			


STORMWATER LINE I4 LONGSECTION

DATUM ELEV: 32.00		SWMH I6 1050mmØ		SWMH I7 1500mmØ		SWMH I7-1 1050mmØ		SWMH I7 1500mmØ	
PIPE NUMBER		SW I6		SW I7					
LID LEVEL	38.64								
INVERT ELEVATIONS		37.63	37.50	38.57	37.96	37.43	37.40	37.50	38.57
DEPTH	1.14	1.14		1.25				1.14	
DISTANCE		31.80		6.112.96				30.18	
SIZE & GRADIENT		300Ø @ 0.40%		375Ø @ 0.35%				300Ø @ 0.4%	


STORMWATER LINE I6 LONGSECTION

DATUM ELEV: 32.00		SWMH I7-1 1050mmØ		SWMH I7 1500mmØ	
PIPE NUMBER		SW I7-1			
LID LEVEL	38.75				
INVERT ELEVATIONS		37.62	37.50	37.50	38.57
DEPTH	1.13			1.14	
DISTANCE		30.18			
SIZE & GRADE		300Ø @ 0.4%			

STORMWATER LINE I7 LONGSECTION

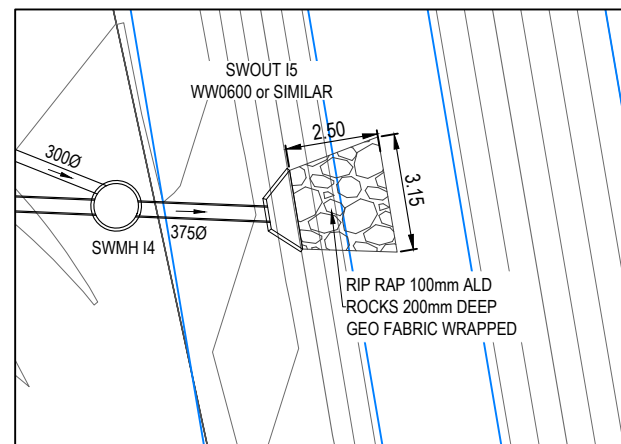

STORMWATER LINE I5 OUTLET
SCALE 1:200

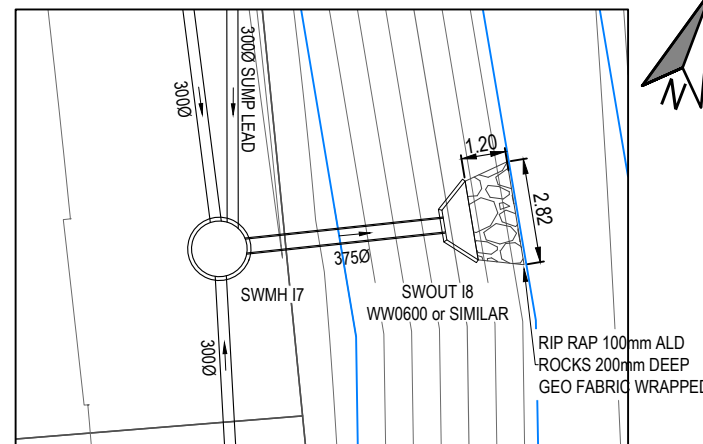

STORMWATER LINE I8 OUTLET
SCALE 1:200

Refer to RFI tracker
for further design
and construction
amendments

Hamilton City Council
Development Engineering Unit
ACCEPTED ENGINEERING PLANS
Assessed for Related Resource Consent Conditions Only
Library Reference: 011.2019.00007140.025
Address: Greenhill Stage 24
Date: 7/05/2025
Subject to all notes and conditions affixed

Rev	DESCRIPTION	DRN	CKD	APP	DATE
0	PRELIMINARY	NW	HB	PH	13/8/24
1	ISSUED FOR EPA	NW	HB	PH	16/8/24
2	ISSUED FOR RFI	TM	RH	PH	23/10/24
3	ISSUED FOR RFI	TM	RH	PH	03/04/25
4	RFI RESPONSE	NW	HB	PH	16/04/25

NAME	DATE	NAME	DATE
SURVEYED		DESIGNED	
COORDINATE SYSTEM: NZGD 2000 - MT EDEN			
ORIGIN OF COORDINATES: BPV DPS 17824			
HEIGHT DATUM: MOTURIKI DATUM 1953			
ORIGIN OF HEIGHT: SS507 SO 42451			

STORMWATER LINES I4, I6 & I7 LONGSECTION



AREAS L, U & K	
ORIGINAL SCALES @ A3 STATUS	
H 1:1000 V 1:250	FOR APPROVAL
DO NOT SCALE DIMENSIONS	
DRAWING NO	REVISION
30410-01-S24-SW2C	4

R:\Project Files\30410-01-1901 Drawing Presentation Files\19-30410-01 - Stage 24 Engineering Design Plan Set.dwg - Plotted: 7/05/2025



SHRIMPTON &
LIPINSKI
LAND DEVELOPMENT &
DESIGN SPECIALISTS

Ph. 07 577 6069
Email: info@sltga.co.nz
P.O. Box 231, Tauranga 3140
www.sltga.co.nz

NOTES:

1. ALL STORMWATER MANHOLES ARE 10500 UNLESS NOTED OTHERWISE.
2. ALL STORMWATER MAINS ARE uPVC RJ SN16 UNLESS NOTED OTHERWISE.
3. ALL LEADS TO CATCHPITS ARE uPVC RJ SN16 UNLESS NOTED OTHERWISE:
 - SINGLE CATCHPITS: 2250
 - DOUBLE CATCHPITS: 3000
4. ALL STORMWATER LOT CONNECTIONS ARE RRJ OPVC SN16 UNLESS NOTED OTHERWISE.
 - SINGLE DWELLING: 1000
 - TWO/THREE DWELLINGS: 1500
 - LATERALS BRANCHING OFF 1500 ARE 1000.
5. ALL LATERALS ARE RRJ OPVC SN16:
 - SINGLE DWELLING: 1000
 - TWO/THREE DWELLINGS: 1500
 - LATERALS BRANCHING OFF 1500 ARE 1000.
6. ALL WORKS TO BE CARRIED OUT AND ALL MATERIALS TO COMPLY WITH THE RITS.
7. THE CONTRACTOR MUST CHECK THE RELEVANT LEVEL OF THE FIRST PIPE LAID WHERE PIPES CROSS OVER BEFORE LAYING THE SECOND PIPELINE AND CONFIRM THAT SUFFICIENT CLEARANCE IS AVAILABLE.
8. REFER TO DRAWING 30410-01-S24-SW4 FOR STANDARD DETAILS.
9. DEPTH OF A STORMWATER CONNECTION TO BE MINIMUM OF 0.9M AND MAXIMUM OF 1.5M (1.2M TYPICAL) UNLESS OTHERWISE INDICATED.
10. ALL CATCHPITS TO INCLUDE STANDARD OUTLET BAFFLE AS PER RITS.
11. LOTS STORMWATER DISCHARGE TO SWALES OUTLET TO BE ROCK PROTECTED, MINIMUM 150mm ALD.

Rev	DESCRIPTION	DRN	CKD	APP	DATE
7	RFI RESPONSE	HB	RH		28/04/25
8	RFI RESPONSE	NW	HB	RH	07/05/25

NAME	DATE	NAME	DATE
------	------	------	------

SURVEYED	DESIGNED
COORDINATE SYSTEM: NZGD 2000 - MT EDEN	
ORIGIN OF COORDINATES: BPV DPS 17824	
HEIGHT DATUM: MOTURIKI DATUM 1953	
ORIGIN OF HEIGHT: SS507 SO 42451	

TITLE

STORMWATER LINES J7 LONGSECTION & DETAILS

PREPARED FOR



AREAS L,U & K

ORIGINAL SCALES @ A3 STATUS


H 1:1000 V 1:250 FOR APPROVAL

DO NOT SCALE DIMENSIONS DRAWING NO


30410-01-S24-SW3A

REVISION
8


COPYRIGHT ON THIS DRAWING IS RESERVED

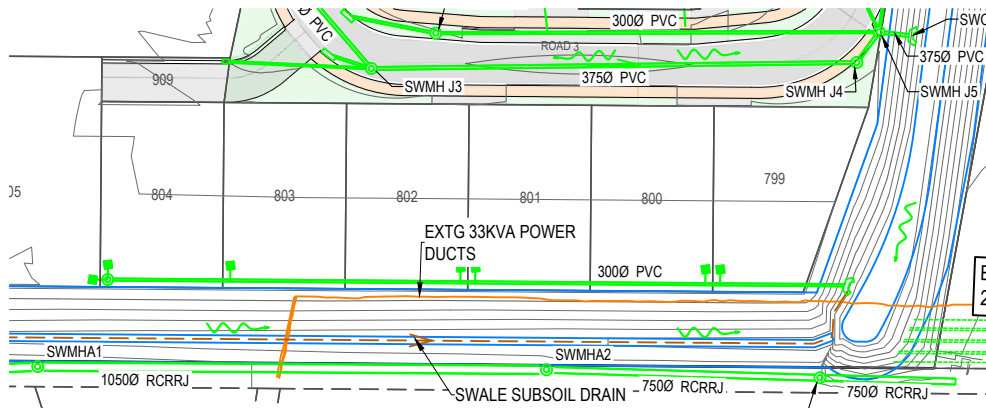


STORMWATER LINE J9 PLAN
SCALE 1:1000

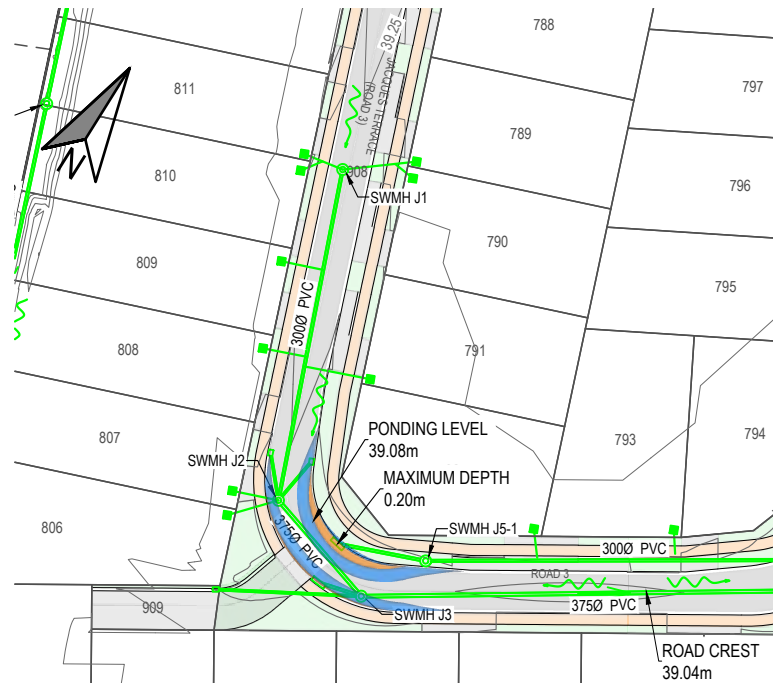


STORMWATER LINE J PONDING (100 YEAR EVENT)
SCALE 1:1000

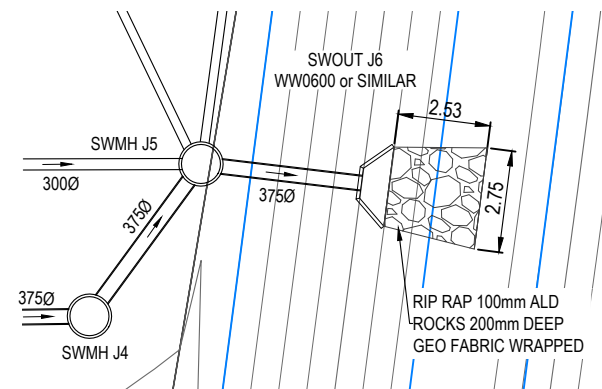

STORMWATER LINE J6 OUTLET
SCALE 1:200

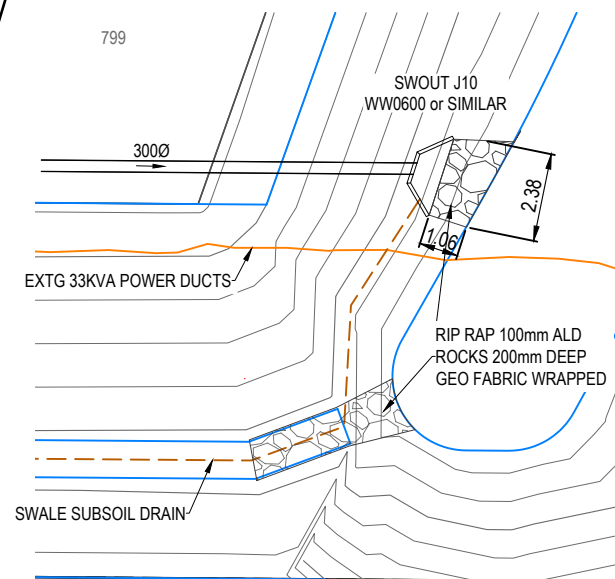

STORMWATER LINE J9 & SOUTH SWALE OUTLET
SCALE 1:200

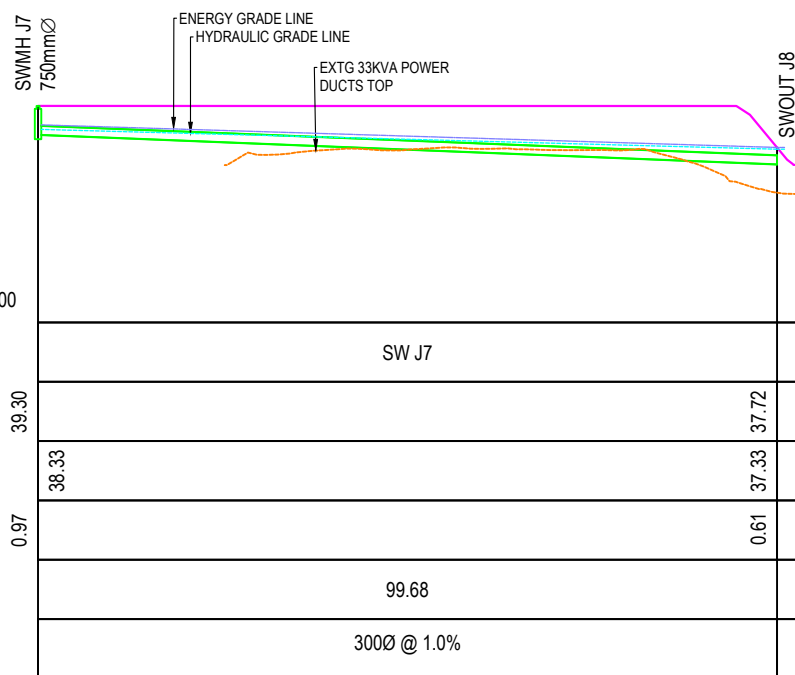

PIPE NUMBER	LID LEVEL	INVERT ELEVATIONS	DEPTH	DISTANCE	SIZE & GRADE
SW J7	39.30	38.33	0.97	99.68	3000 @ 1.0%

STORMWATER LINE J7 LONGSECTION

Refer to RFI tracker
for further design
and construction
amendments

Hamilton City Council
Development Engineering Unit
ACCEPTED ENGINEERING PLANS
Assessed for Related Resource Consent Conditions Only
Library Reference: 011.2019.00007140.025
Address: Greenhill Stage 24
Date: 7/05/2025

Subject to all notes and conditions affixed

R:\Project Files\04\10-01-1901 Drawing Presentation Files\19-304\10-01 - Stage 24 Engineering Design Plan Set.dwg - Plotted: 16/04/2025

Refer to RFI tracker
for further design
and construction
amendments

Hamilton City Council
Development Engineering Unit
ACCEPTED ENGINEERING PLANS
Assessed for Related Resource Consent Conditions Only
Library Reference: 011.2019.00007140.025
Address: Greenhill Stage 24
Date: 7/05/2025
Subject to all notes and conditions affixed



SHRIMPTON &
LIPINSKI
LAND DEVELOPMENT &
DESIGN SPECIALISTS

Ph. 07 577 6069
Email: info@sltga.co.nz
P.O. Box 231, Tauranga 3140
www.sltga.co.nz

Rev	DESCRIPTION	DRN	CKD	APP	DATE
0	PRELIMINARY	NW			13/8/24
1	ISSUED FOR EPA	NW	HB	PH	16/8/24

NAME	DATE	NAME	DATE
SURVEYED		DESIGNED	
COORDINATE SYSTEM: NZGD 2000 - MT EDEN			
ORIGIN OF COORDINATES: BPV DPS 17824			
HEIGHT DATUM: MOTURIKI DATUM 1953			
ORIGIN OF HEIGHT: SS507 SO 42451			

STANDARD DETAILS STORMWATER



PREPARED FOR



AREAS L, U & K

ORIGINAL SCALES @ A3	STATUS
NOT TO SCALE	FOR APPROVAL
DO NOT SCALE DIMENSIONS	
DRAWING NO	REVISION
30410-01-S24-SW4	1

COPYRIGHT ON THIS DRAWING IS RESERVED

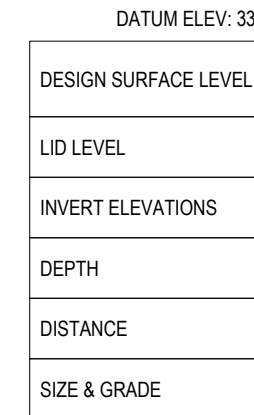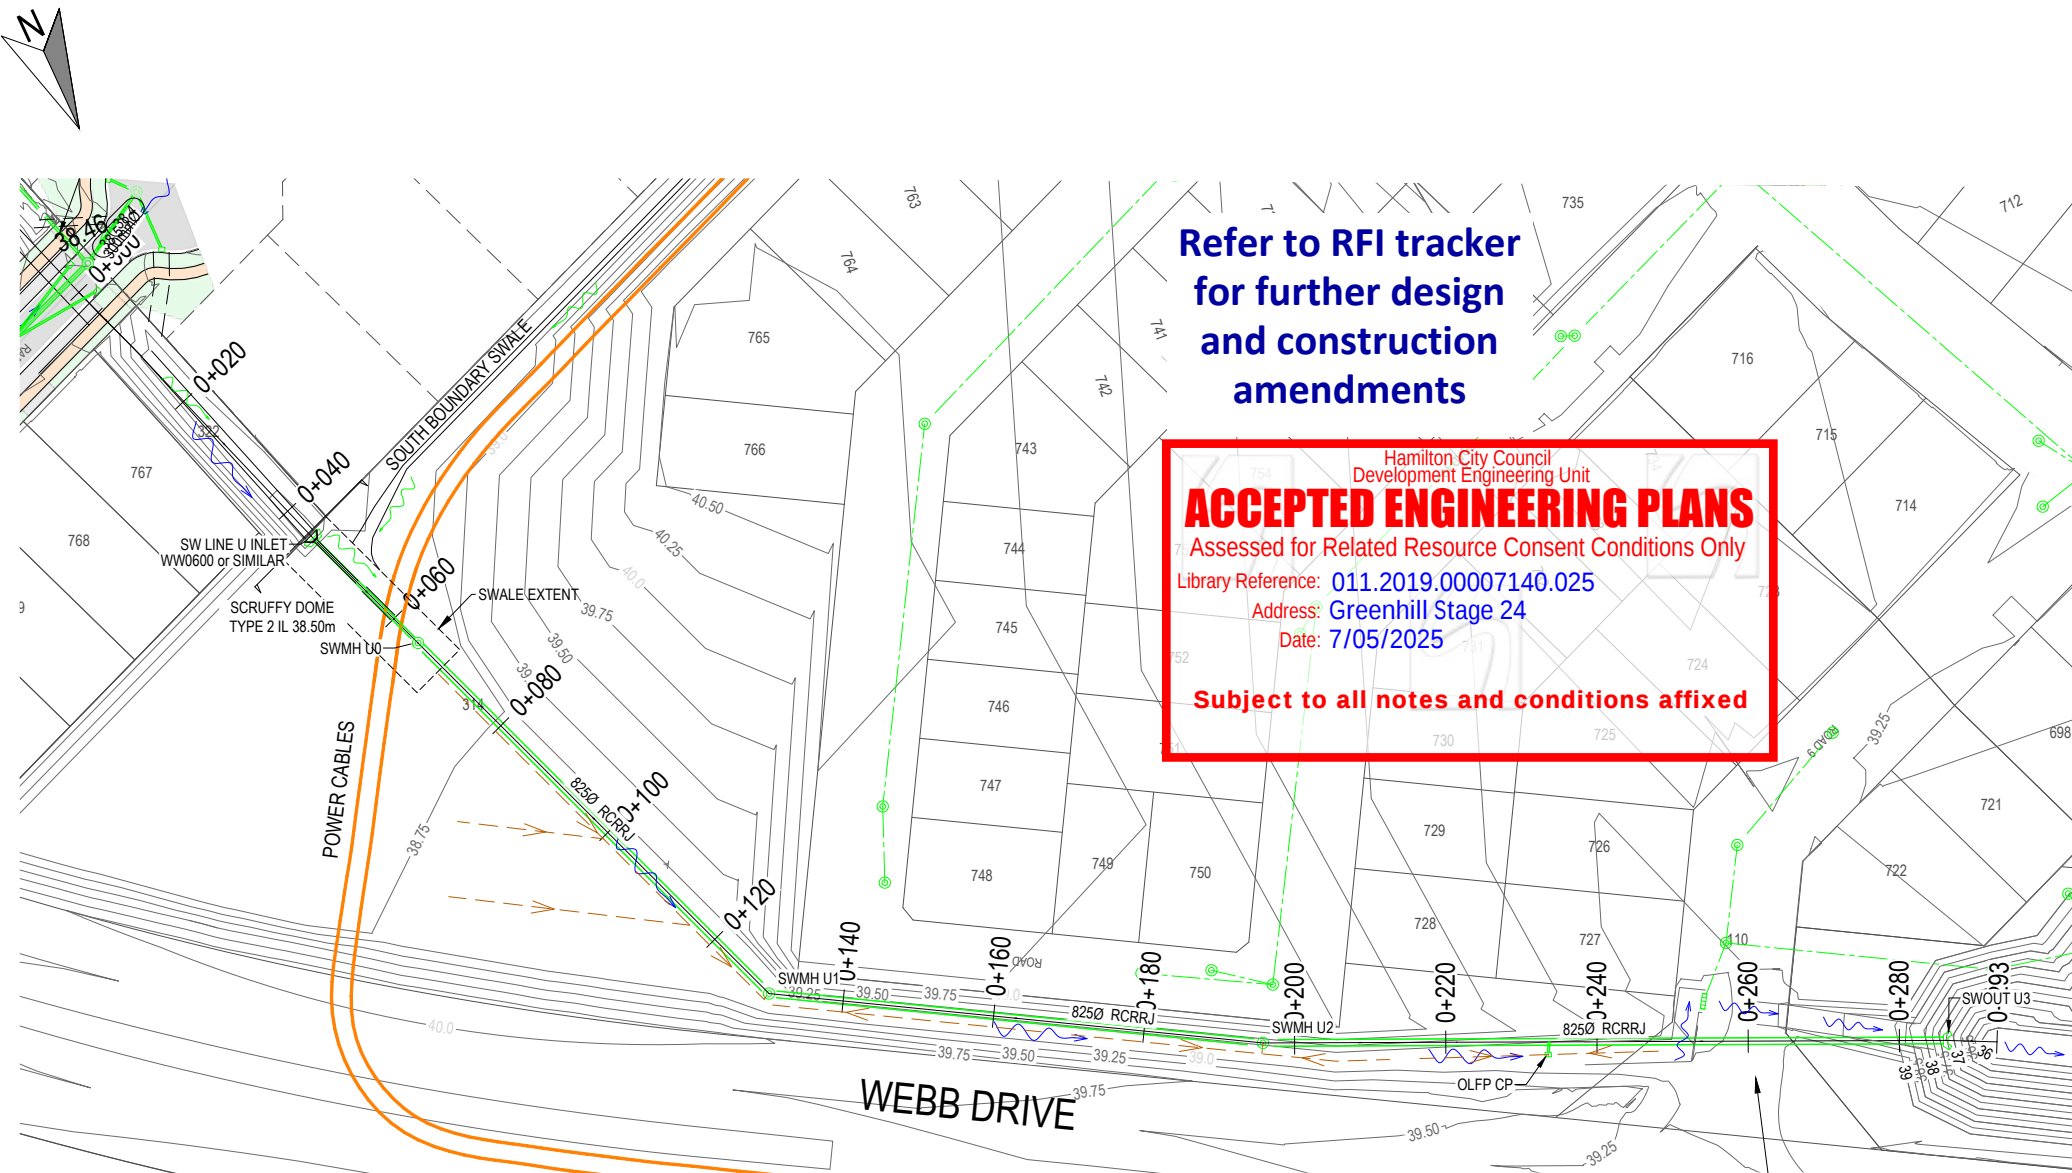


SHRIMPTON &
LIPINSKI
LAND DEVELOPMENT &
DESIGN SPECIALISTS
Ph. 07 577 6069
Email: info@sltga.co.nz
O. Box 231, Tauranga 3140
www.sltga.co.nz

NOTES:

1. ALL STORMWATER MANHOLES ARE 10500 UNLESS NOTED OTHERWISE.
2. ALL STORMWATER MAINS ARE RCRRJ UNLESS NOTED OTHERWISE:
- B. 3. ALL LEADS TO CATCHPITS ARE uPVC RJ SN16 UNLESS NOTED OTHERWISE:
 - SINGLE CATCHPITS: 2250
 - DOUBLE CATCHPITS: 3000
4. ALL STORMWATER LOT CONNECTIONS ARE RRJ OPVC SN16 UNLESS NOTED OTHERWISE.
5. ALL LATERALS ARE RRJ OPVC SN16:
 - SINGLE DWELLING: 1000.
 - TWO/THREE DWELLINGS: 1500.
 - LATERALS BRANCHING OFF 1500 ARE 1000.
6. ALL WORKS TO BE CARRIED OUT AND ALL MATERIALS TO COMPLY WITH THE RITS.
- C. 7. THE CONTRACTOR MUST CHECK THE RELEVANT LEVEL OF THE FIRST PIPE LAID WHERE PIPES CROSS OVER BEFORE LAYING THE SECOND PIPELINE AND CONFIRM THAT SUFFICIENT CLEARANCE IS AVAILABLE.
8. REFER TO DRAWING 30410-01-S24-SW4 FOR STANDARD DETAILS.
9. DEPTH OF A STORMWATER CONNECTION TO BE MINIMUM OF 0.9M AND MAXIMUM OF 1.5M (1.2M TYPICAL) UNLESS OTHERWISE INDICATED.
10. ALL CATCHPITS TO INCLUDE STANDARD OUTLET BAFFLE AS PER RITS.
11. LOTS STORMWATER DISCHARGE TO SWALES OUTLET TO BE ROCK PROTECTED, MINIMUM 150mm ALD.
12. SIDE OF SWALE TO BE MAXIMUM 3 : 1.

LEGEND:

 OVERLAND FLOW ARROWS
- CULVERTS BLOCKED

Rev	DESCRIPTION	DRN	CKD	APP	DATE
7	ISSUED FOR RFI	TM	RH	PH	02/12/22
8	ISSUED FOR RFI	TM	RH	PH	13/01/21
9	ISSUED FOR RFI	TM		PH	03/04/21
10	RFI RESPONSE	NW	HB		16/04/21
11	RFI RESPONSE	TM	HB		22/04/21
12	RFI RESPONSE	TM	HB		06/05/21

	NAME	DATE		NAME	DATE
SURVEYED			DESIGNED		


COORDINATE SYSTEM: NZGD 2000 - MT EDEN
ORIGIN OF COORDINATES: BPV DPS 17824
HEIGHT DATUM: MOTURIKI DATUM 1953
ORIGIN OF HEIGHT: SS507 SO 42451
TITLE

STORMWATER
STAGE 24 ~ 22
LONGSECTION

PREPARED FOR



H	ORIGINAL SCALES @ A3	STATUS
	H 1:1000 V 1:250 DO NOT SCALE DIMENSIONS	FOR APPROVAL
DRAWING NO		REVISION
30410-01-S24-SW5		12

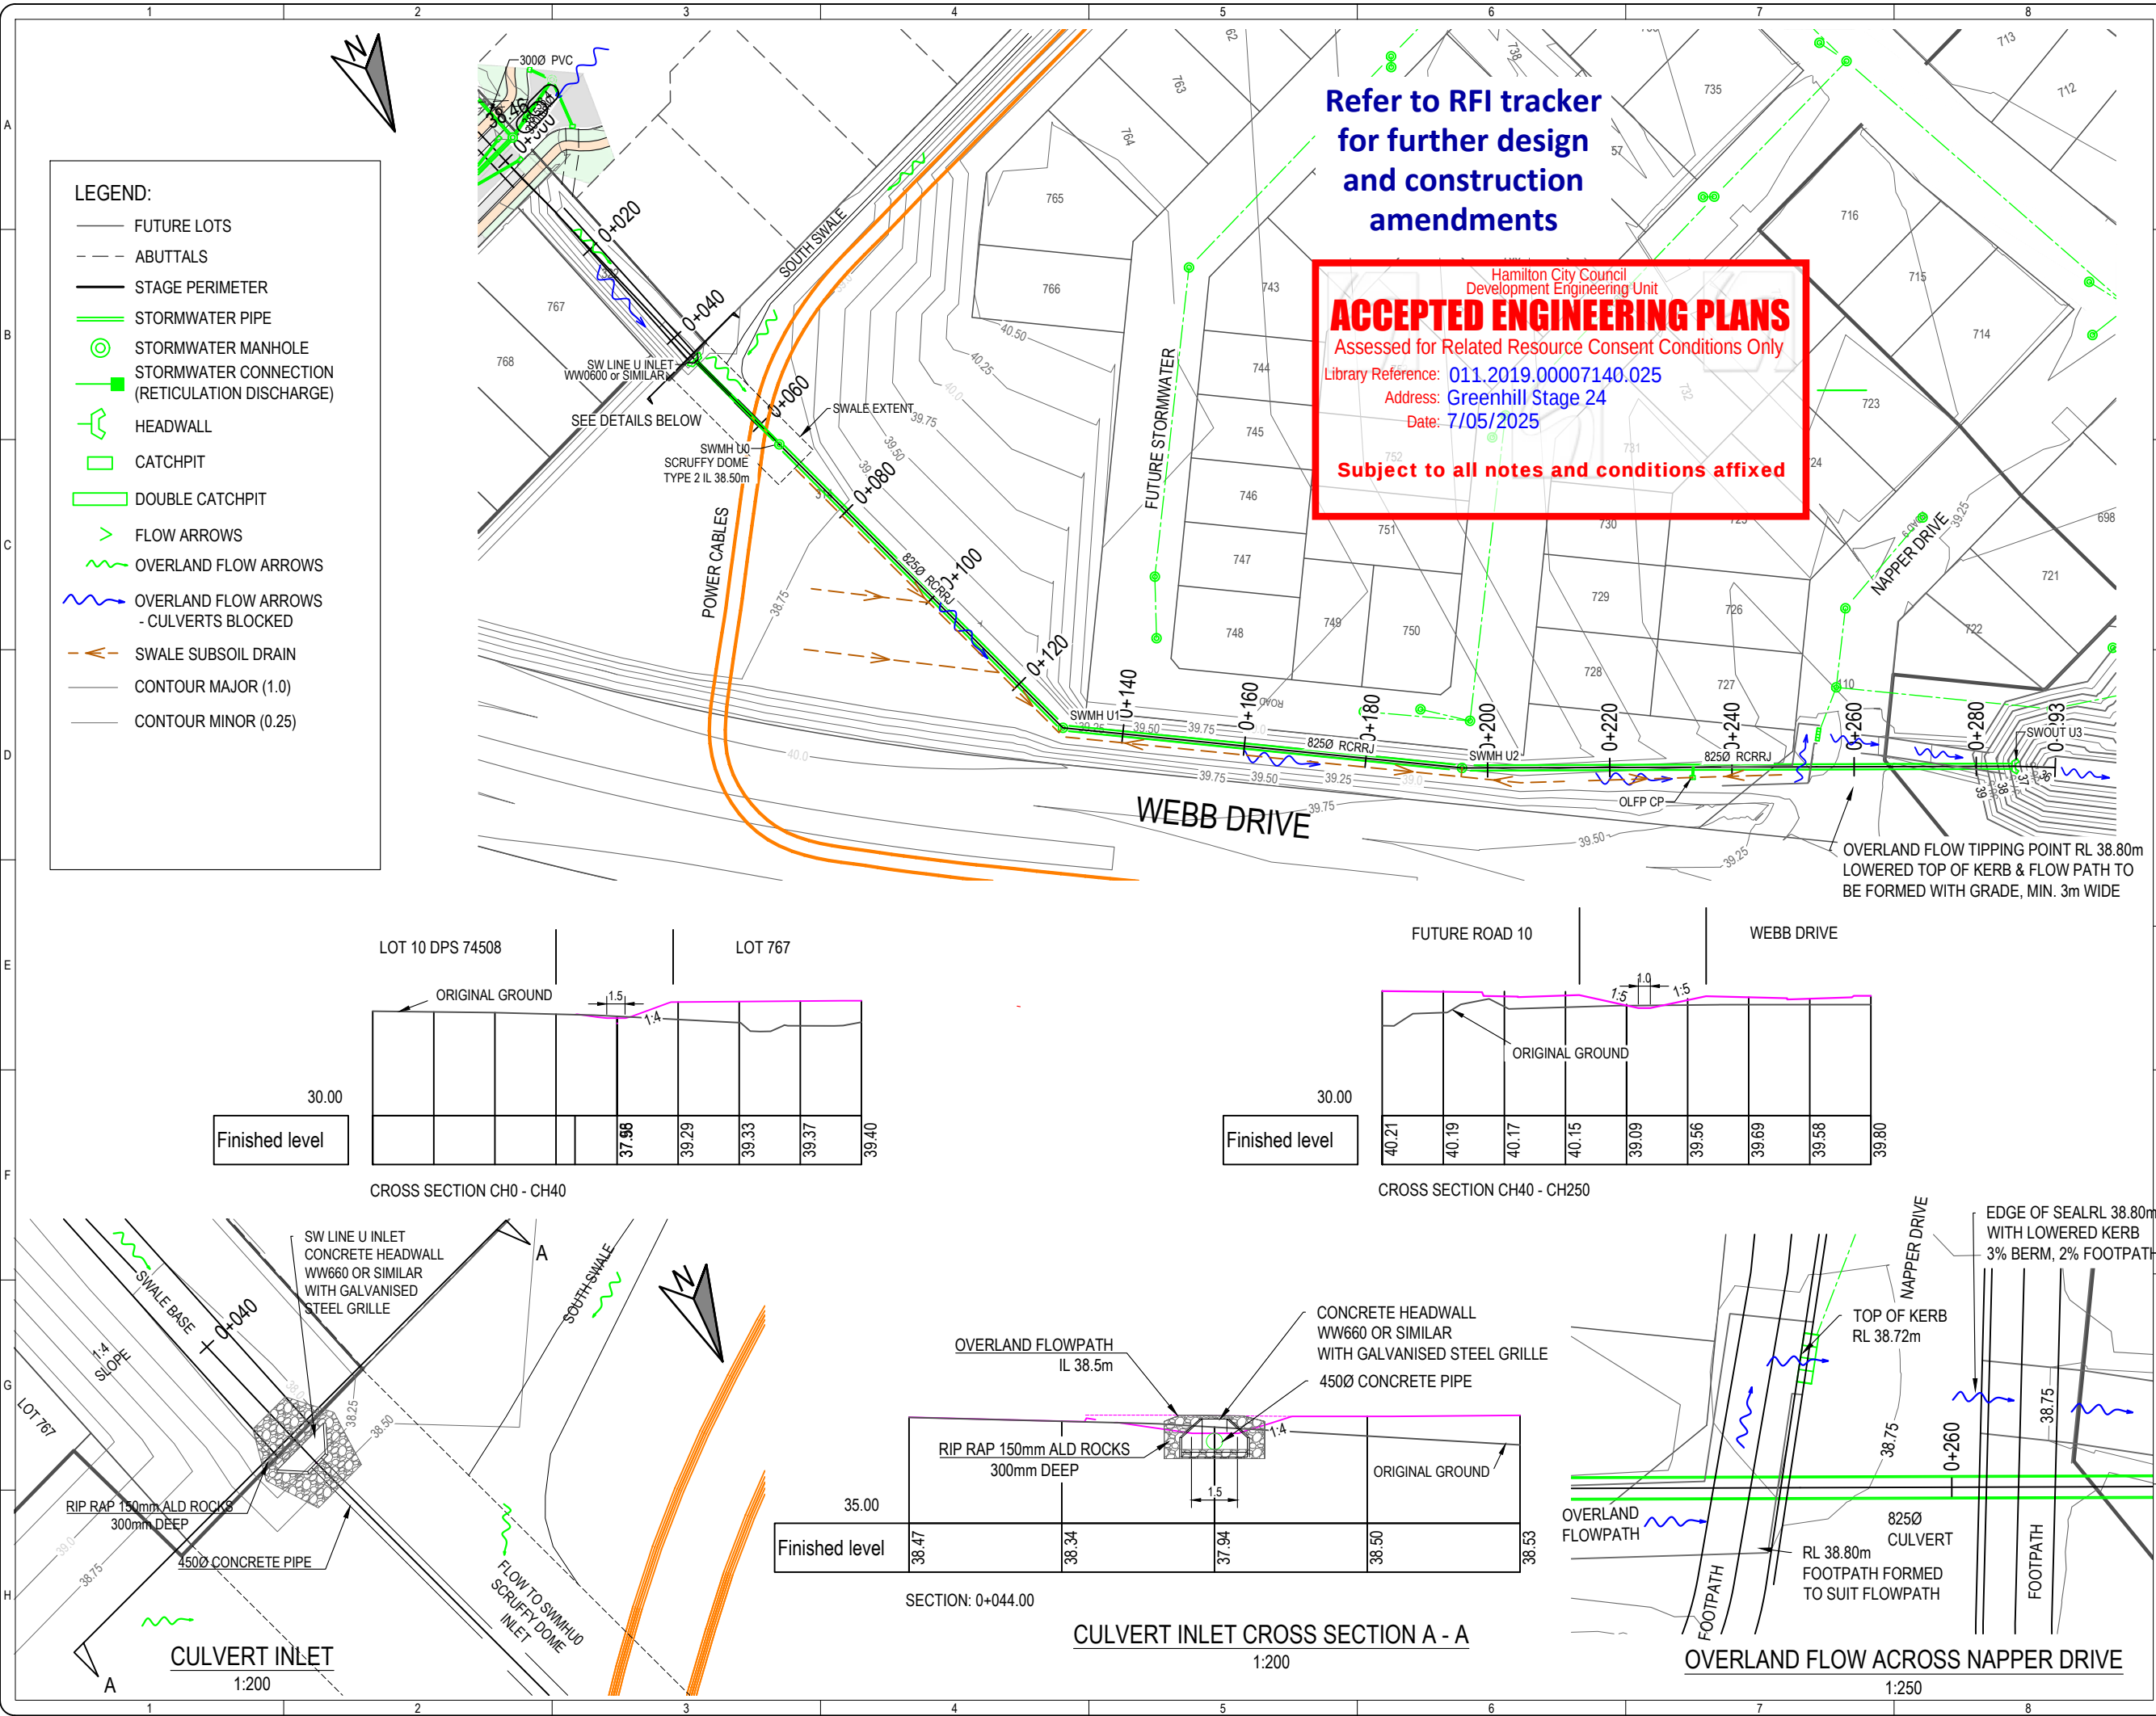



SHRIMPTON &
LIPINSKI
LAND DEVELOPMENT &
DESIGN SPECIALISTS

Ph. 07 577 6069
Email: info@sltga.co.nz
P.O. Box 231, Tauranga 3140
www.sltga.co.nz

- NOTES:
1. ALL STORMWATER MANHOLES ARE 1050Ø UNLESS NOTED OTHERWISE.
 2. ALL STORMWATER MAINS ARE RCRRJ UNLESS NOTED OTHERWISE.
 3. ALL LEADS TO CATCHPITS ARE uPVC RJ SN16 UNLESS NOTED OTHERWISE:
 - SINGLE CATCHPITS: 225Ø
 - DOUBLE CATCHPITS: 300Ø
 4. ALL STORMWATER LOT CONNECTIONS ARE RRJ OPVC SN16 UNLESS NOTED OTHERWISE.
 5. ALL LATERALS ARE RRJ OPVC SN16:
 - SINGLE DWELLING: 100Ø.
 - TWO/THREE DWELLINGS: 150Ø.
 - LATERALS BRANCHING OFF 150Ø ARE 100Ø.
 6. ALL WORKS TO BE CARRIED OFF AND ALL MATERIALS TO COMPLY WITH THE RITS.
 7. THE CONTRACTOR MUST CHECK THE RELEVANT LEVEL OF THE FIRST PIPE LAID WHERE PIPES CROSS OVER BEFORE LAYING THE SECOND PIPELINE AND CONFIRM THAT SUFFICIENT CLEARANCE IS AVAILABLE.
 8. REFER TO DRAWING 30410-01-S24-SW4 FOR STANDARD DETAILS.
 9. DEPTH OF A STORMWATER CONNECTION TO BE MINIMUM OF 0.9M AND MAXIMUM OF 1.5M (1.2M TYPICAL) UNLESS OTHERWISE INDICATED.
 10. ALL CATCHPITS TO INCLUDE STANDARD OUTLET BAFFLE AS PER RITS.
 11. LOTS STORMWATER DISCHARGE TO SWALES OUTLET TO BE ROCK PROTECTED, MINIMUM 150mm ALD.
 12. SIDE OF SWALE TO BE MAXIMUM 3 : 1.

Rev	DESCRIPTION	DRN	CKD	APP	DATE
7	ISSUED FOR RFI	TM	RH	PH	02/12/24
8	ISSUED FOR RFI	TM	RH	PH	13/01/25
9	ISSUED FOR RFI	TM		PH	03/04/25
10	RFI RESPONSE	NW	HB		16/04/25
11	RFI RESPONSE	TM	HB		23/04/25
12	RFI RESPONSE	TM	HB		06/05/25

SURVEYED	NAME	DATE	DESIGNED	NAME	DATE
COORDINATE SYSTEM: NZGD 2000 - MT EDEN					
ORIGIN OF COORDINATES: BPV DPS 17824					
HEIGHT DATUM: MOTURIKI DATUM 1953					
ORIGIN OF HEIGHT: SS507 SO 42451					
TITLE					

STORMWATER STAGE 24 ~ 22 CROSS-SECTION

PREPARED FOR



Chedworth
Properties Limited

AREAS L,U & K

ORIGINAL SCALES @ A3 STATUS

1:500 FOR APPROVAL

DO NOT SCALE DIMENSIONS


DRAWING NO

30410-01-S24-SW6

REVISION

12

COPYRIGHT ON THIS DRAWING IS RESERVED

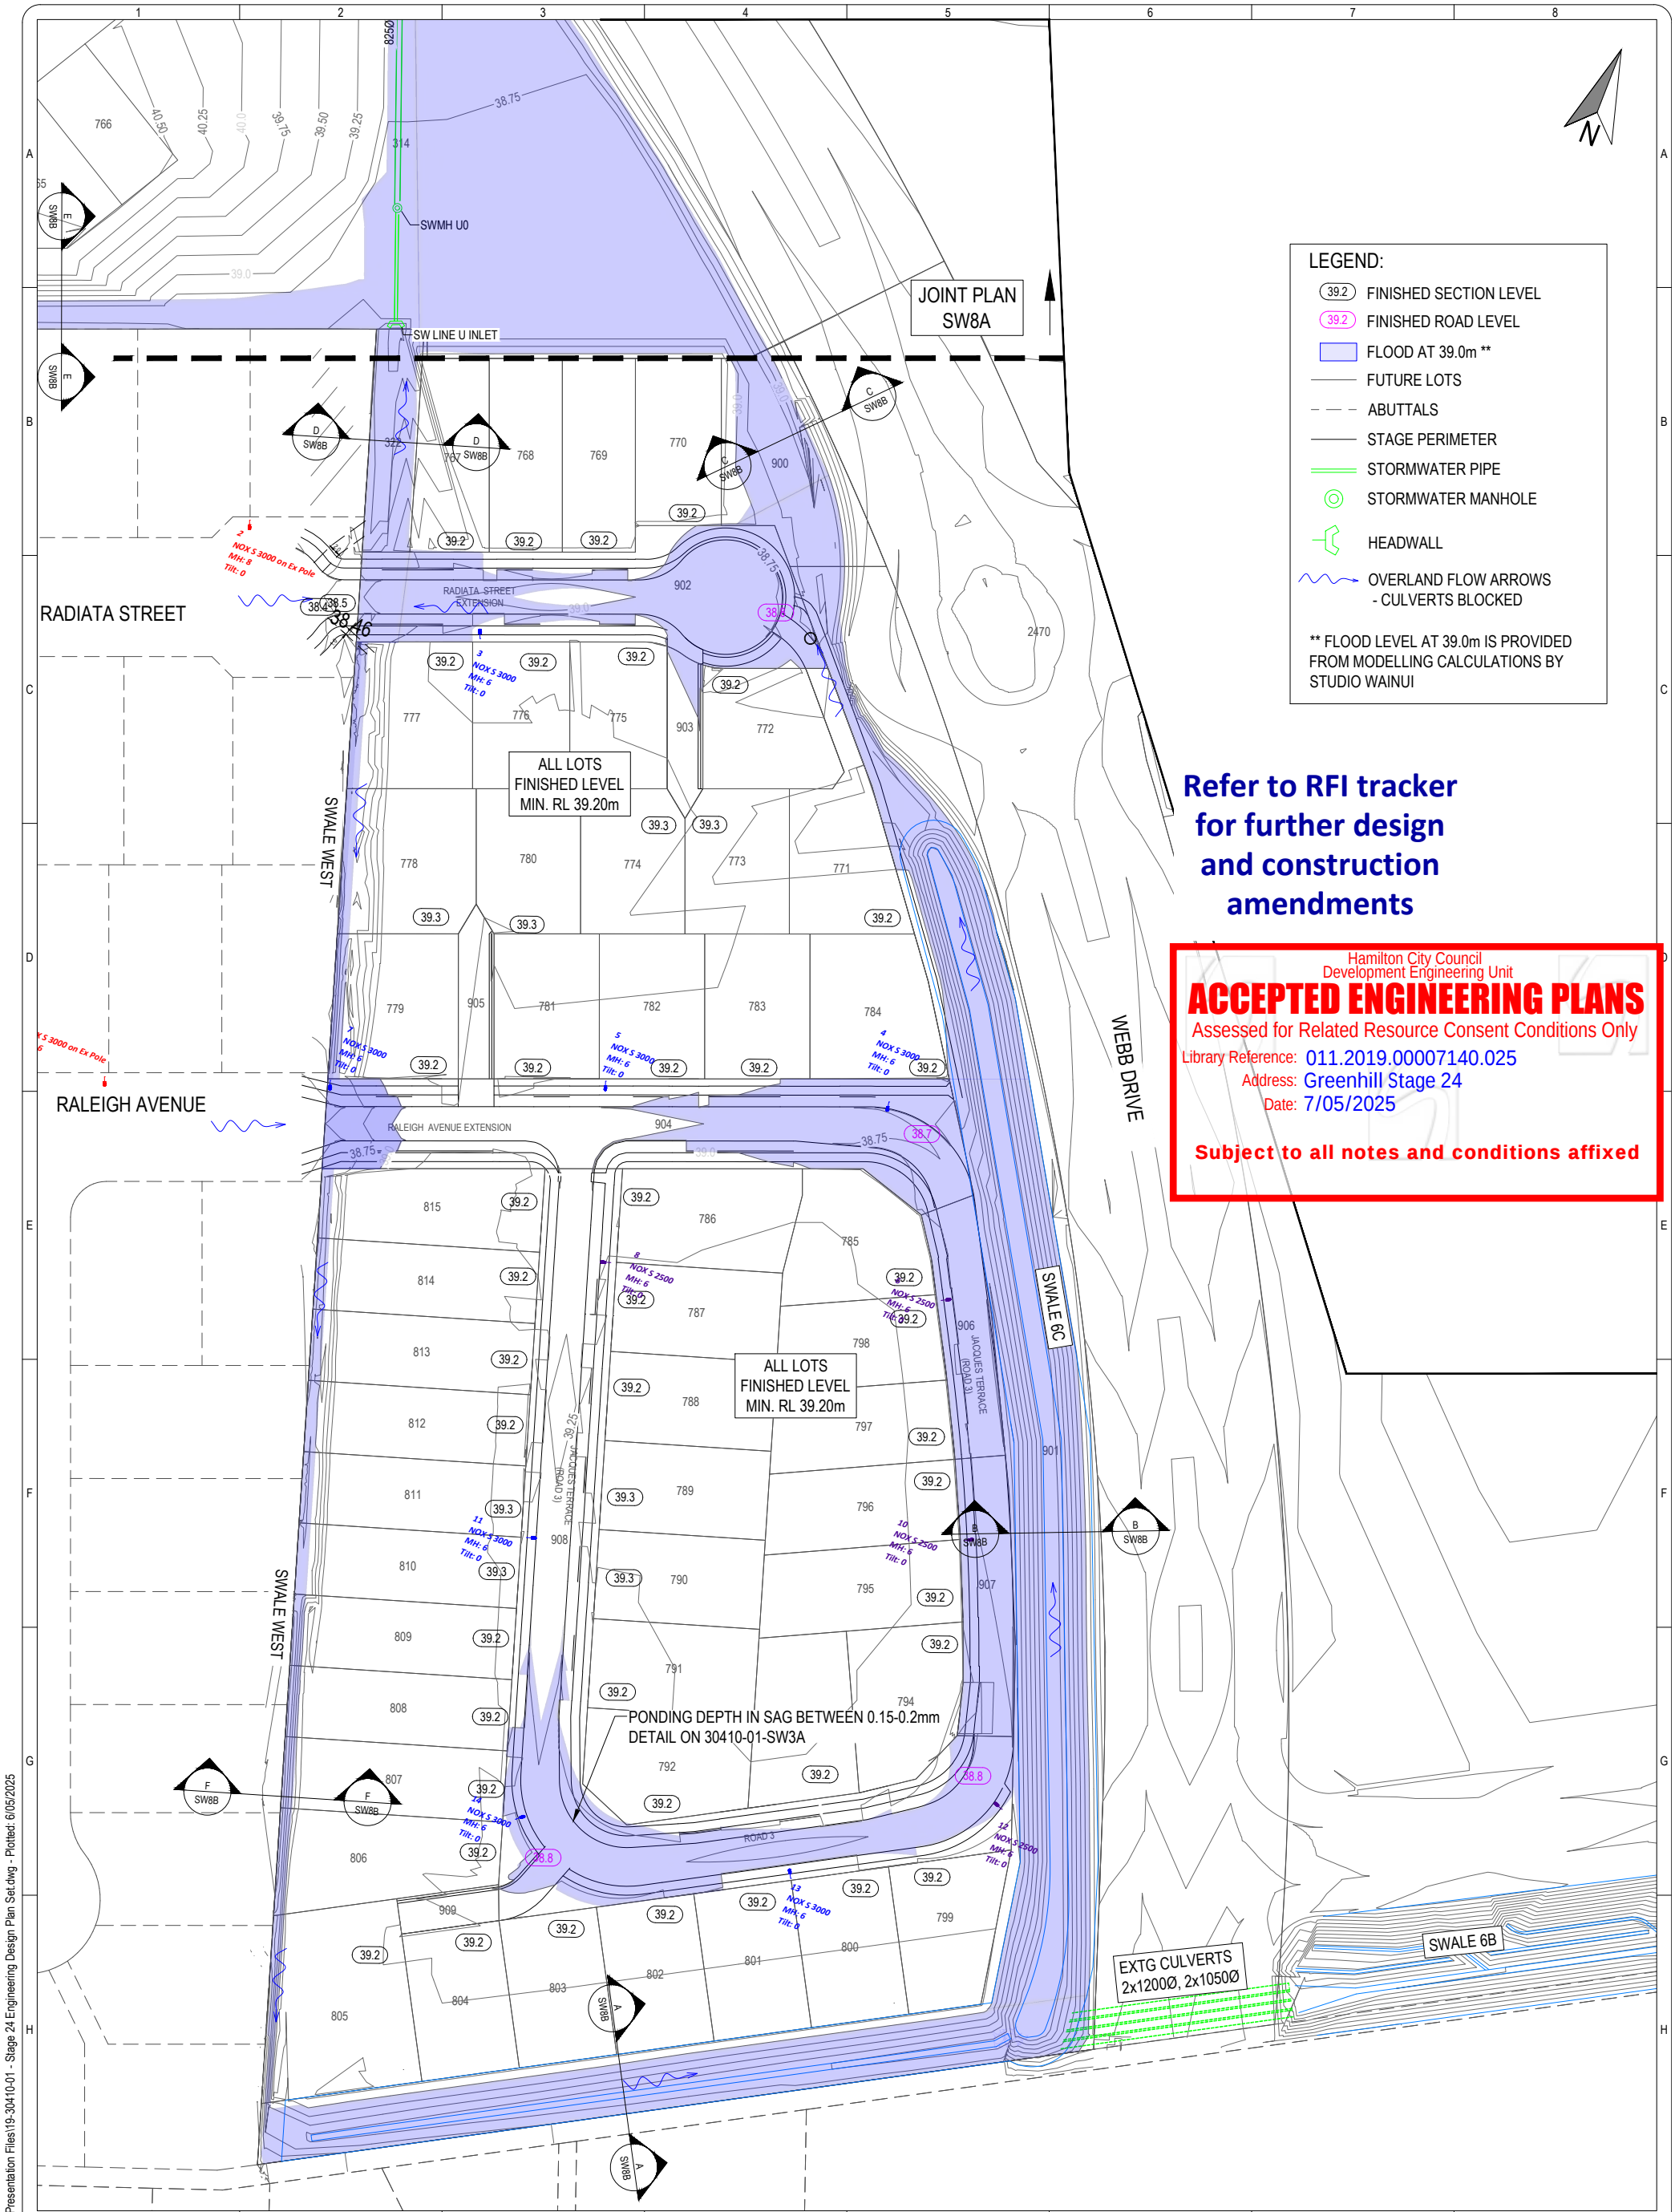

LEGEND:

- 39.2 FINISHED SECTION LEVEL
- 39.2 FINISHED ROAD LEVEL
- FLOOD AT 39.0m **
- FUTURE LOTS
- ABUTTALS
- STAGE PERIMETER
- STORMWATER PIPE
- STORMWATER MANHOLE
- HEADWALL
- OVERLAND FLOW ARROWS - CULVERTS BLOCKED

** FLOOD LEVEL AT 39.0m IS PROVIDED FROM MODELLING CALCULATIONS BY STUDIO WAINUI

Refer to RFI tracker
for further design
and construction
amendments

Hamilton City Council
Development Engineering Unit

ACCEPTED ENGINEERING PLANS

Assessed for Related Resource Consent Conditions Only

Library Reference: 011.2019.00007140.025

Address: Greenhill Stage 24

Date: 7/05/2025

Subject to all notes and conditions affixed

R:\Project Files\30410-01-19101 Drawing Presentation Files\19-30410-01 - Stage 24 Engineering Design Plan Set.dwg - Plotted: 6/05/2025

S&L
SHRIMPTON &
LIPINSKI
LAND SPECIALISTS


Ph. 07 577 6069
Email: info@sltga.co.nz
P.O. Box 231, Tauranga 3140
www.sltga.co.nz



**CULVERT BLOCKED SCENARIO
100 YEAR STORM EVENT
STAGE 24**

REV	DESCRIPTION	DRN	CKD	APP	DATE	COORDINATE SYSTEM: NZGD 2000 - MT EDEN	STATUS
5	RFI RESPONSE	NW	HB		16/04/25	ORIGIN OF COORDINATES: BPV DPS 17824	FOR APPROVAL
6	RFI RESPONSE	HB	RH		28/04/25	HEIGHT DATUM: MOTURIKI DATUM 1953	
7	RFI RESPONSE	HB	HB	RH	06/05/25	ORIGIN OF HEIGHT: SS507 SO 42451	
						ORIGINAL SCALES @ A3 1:1000	
						DO NOT SCALE DIMENSIONS	
						DRAWING NO	
						30410-01-S24-SW8	
						REVISION	
						7	

COPYRIGHT ON THIS DRAWING IS RESERVED

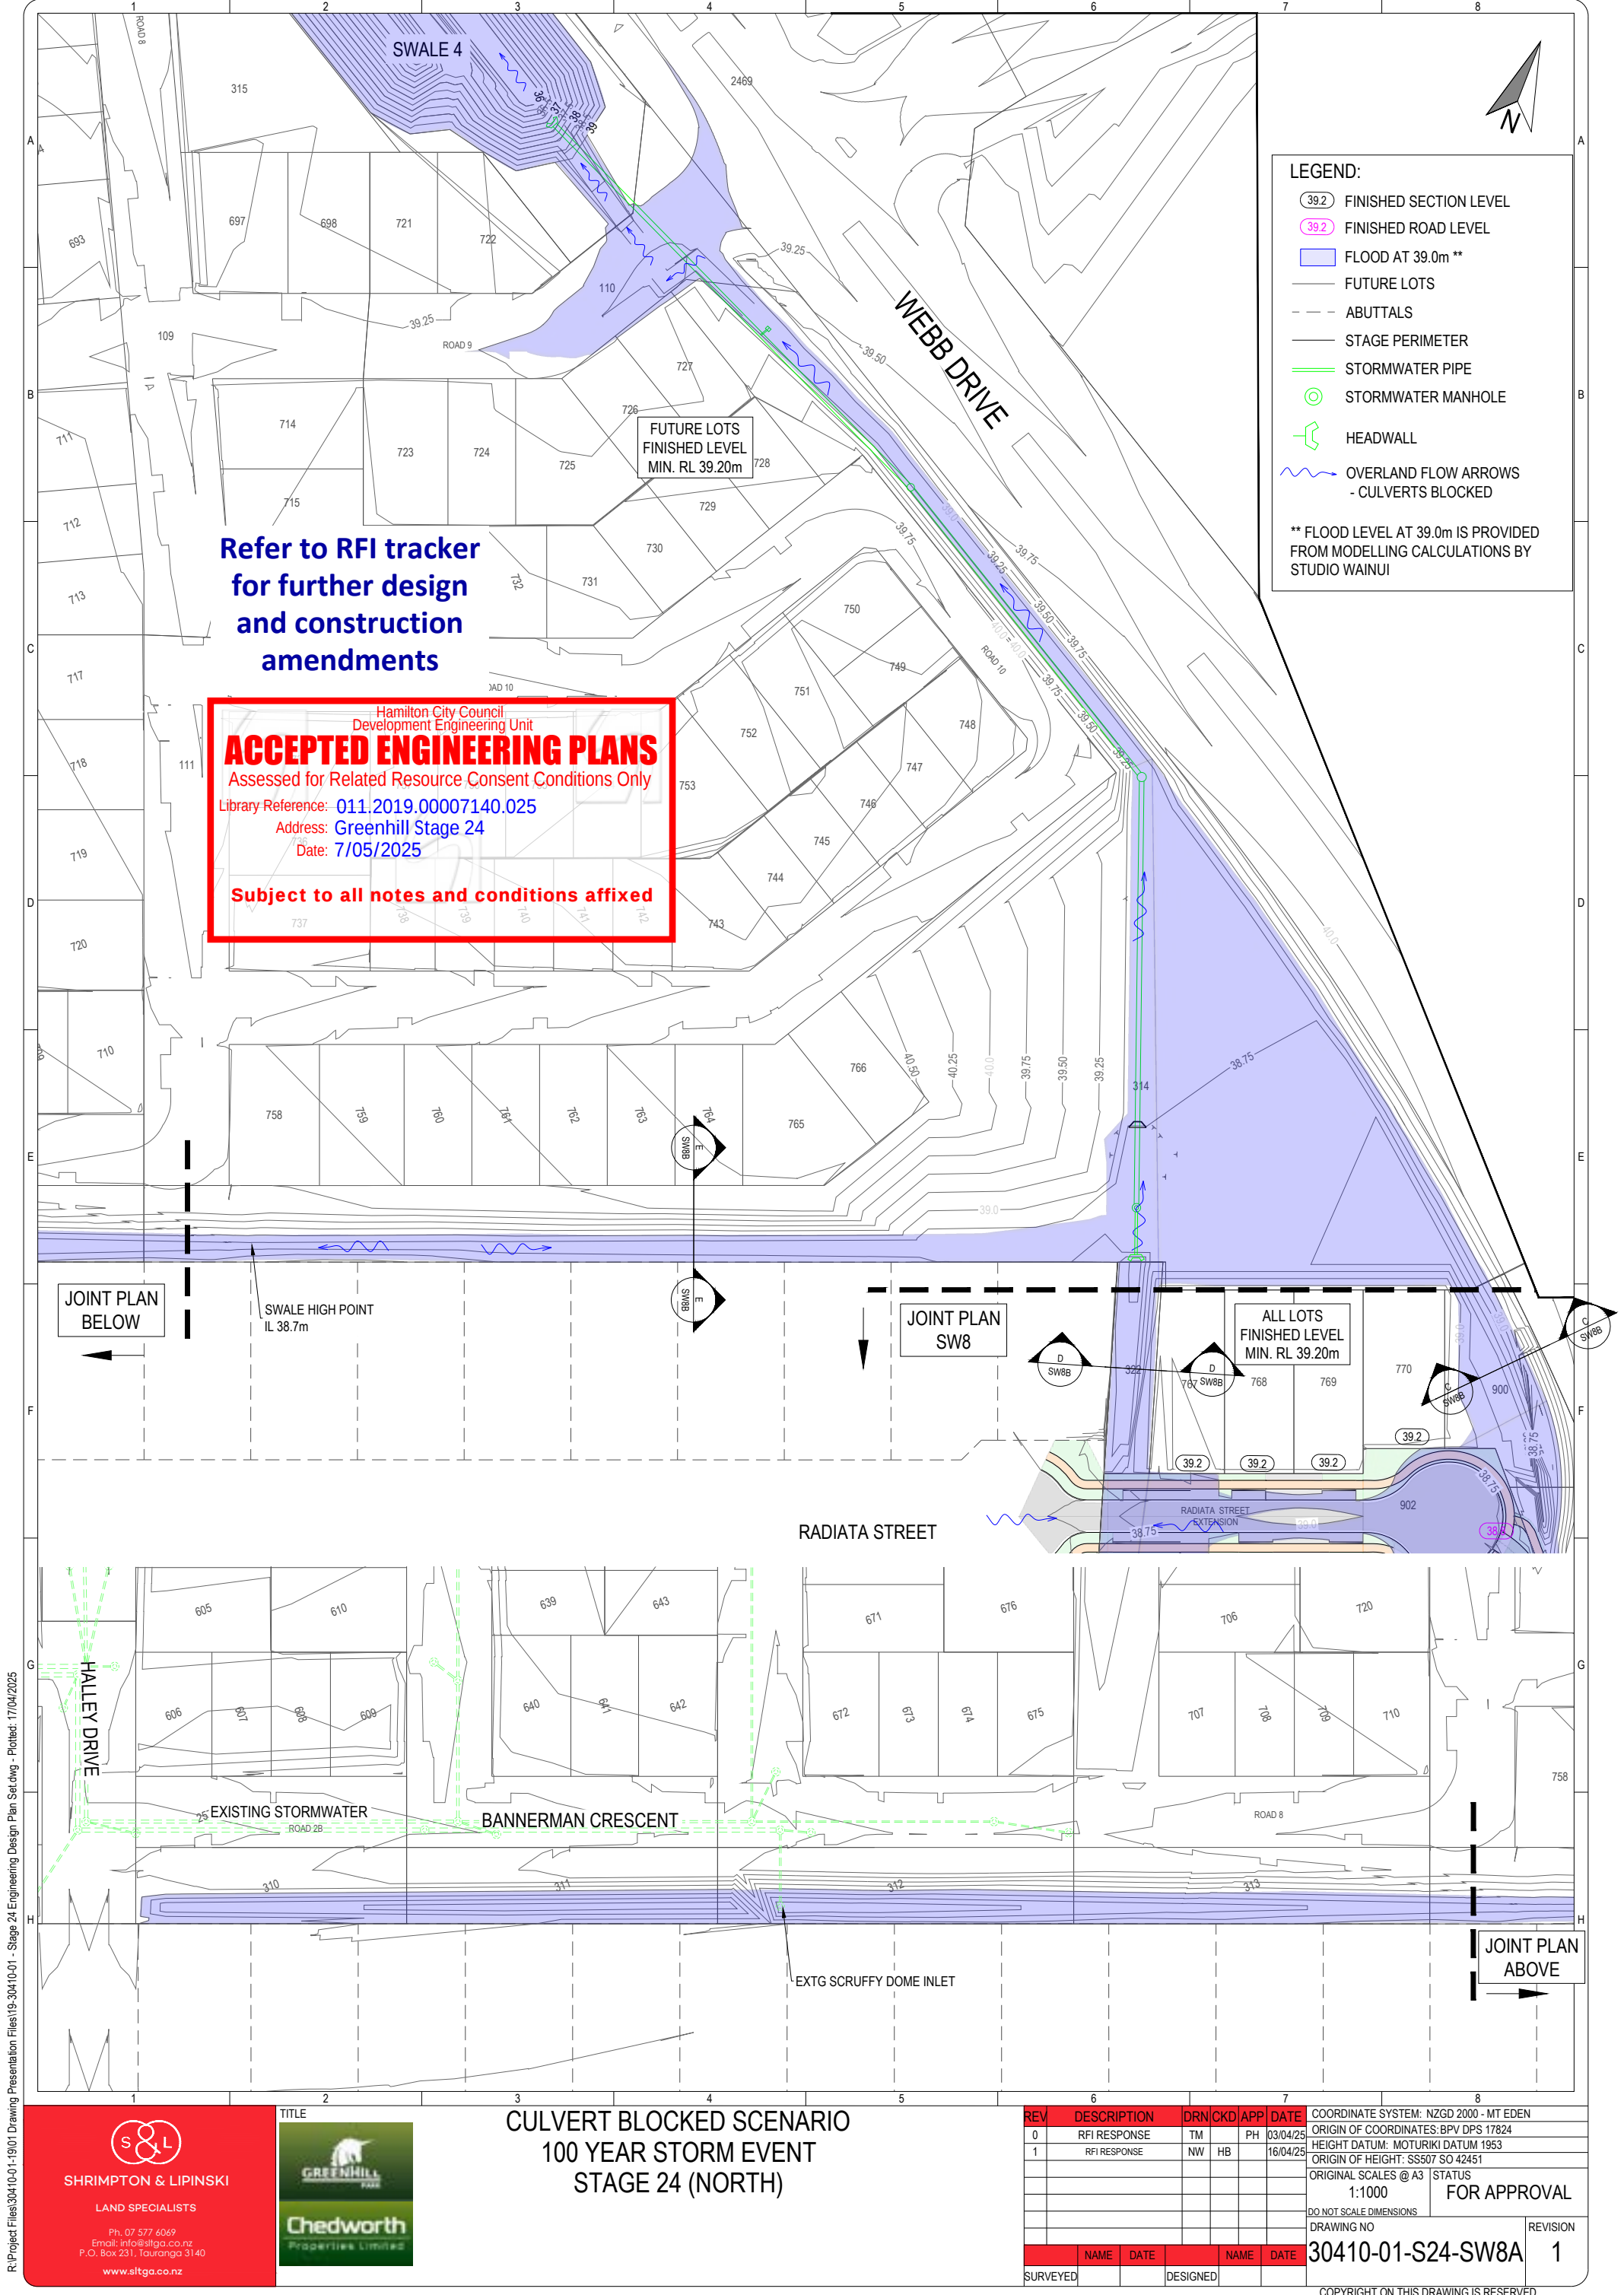

Refer to RFI tracker
for further design
and construction
amendments

Hamilton City Council
Development Engineering Unit
ACCEPTED ENGINEERING PLANS
Assessed for Related Resource Consent Conditions Only
Library Reference: 011.2019.00007140.025
Address: Greenhill Stage 24
Date: 7/05/2025
Subject to all notes and conditions affixed

LEGEND:

- 39.2 FINISHED SECTION LEVEL
- 39.2 FINISHED ROAD LEVEL
- FLOOD AT 39.0m **
- FUTURE LOTS
- ABUTTALS
- STAGE PERIMETER
- STORMWATER PIPE
- STORMWATER MANHOLE
- HEADWALL
- OVERLAND FLOW ARROWS - CULVERTS BLOCKED

** FLOOD LEVEL AT 39.0m IS PROVIDED FROM MODELLING CALCULATIONS BY STUDIO WAINUI

CULVERT BLOCKED SCENARIO
100 YEAR STORM EVENT
STAGE 24 (NORTH)


REV	DESCRIPTION	DRN/CKD	APP	DATE	COORDINATE SYSTEM: NZGD 2000 - MT EDEN
0	RFI RESPONSE	TM	PH	03/04/25	ORIGIN OF COORDINATES: BPV DPS 17824
1	RFI RESPONSE	NW	HB	16/04/25	HEIGHT DATUM: MOTURIKI DATUM 1953
					ORIGIN OF HEIGHT: SS507 SO 42451
					ORIGINAL SCALES @ A3 STATUS
					1:1000 FOR APPROVAL
					DO NOT SCALE DIMENSIONS
					DRAWING NO
					30410-01-S24-SW8A
					REVISION
					1




SHRIMPTON & LIPINSKI
LAND SPECIALISTS
Ph. 07 577 6069
Email: info@sltga.co.nz
P.O. Box 231, Tauranga 3140
www.sltga.co.nz




R:\Project Files\30410-01-19\01 Drawing Presentation Files\19-30410-01 - Stage 24 Engineering Design Plan Set.dwg - Plotted: 6/05/2025

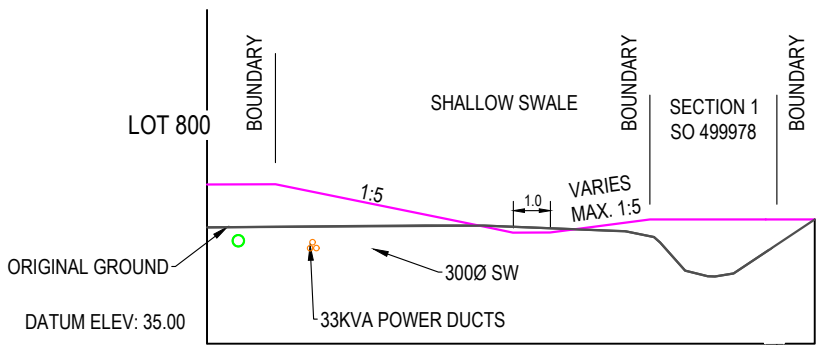


CROSS SECTION A-A
SOUTH SWALE

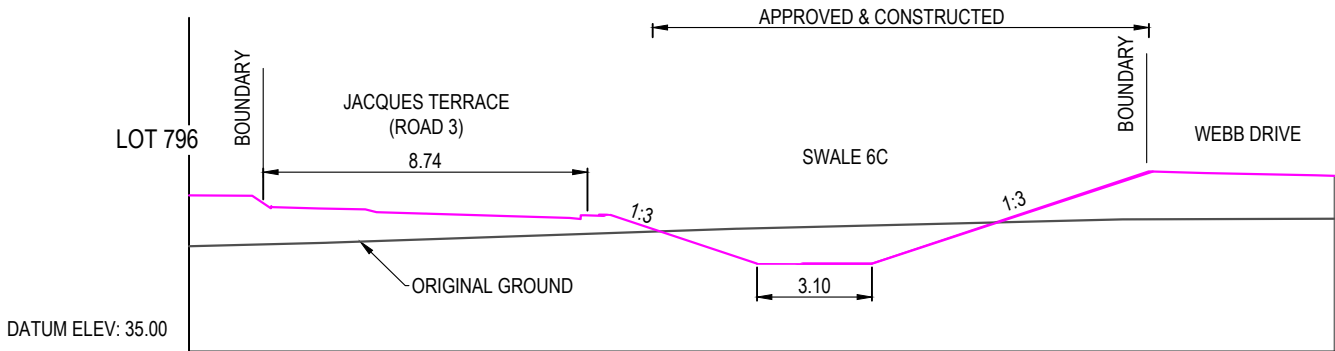


CROSS SECTION B-B
SWALE 6C

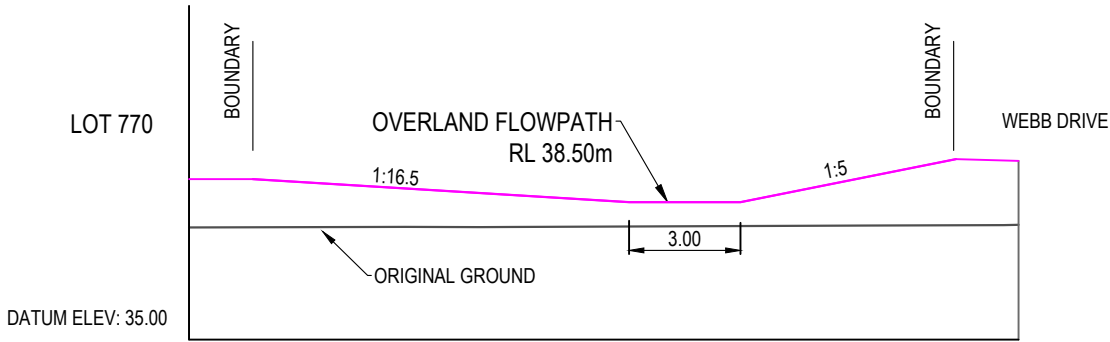


CROSS SECTION C-C
LOT 900

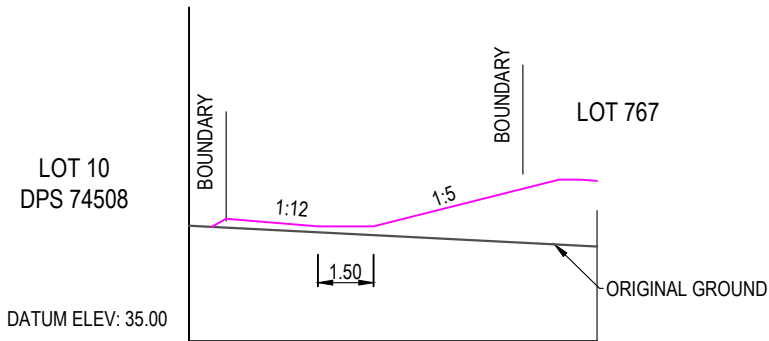

CROSS SECTION D-D
RADIATA SWALE

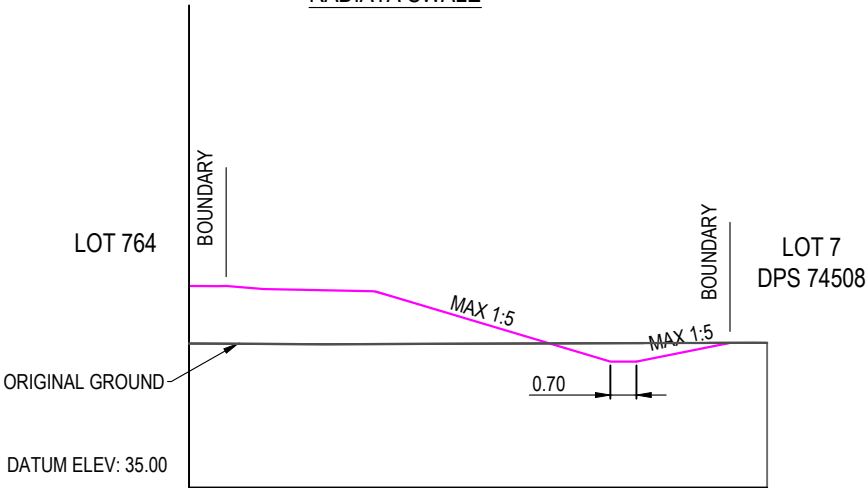

CROSS SECTION E-E
AREA L SOUTH BOUNDARY SWALE

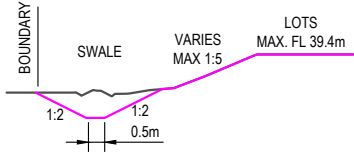

CROSS SECTION F-F
SWALE WEST
Scale 1:200

Refer to RFI tracker
for further design
and construction
amendments

Hamilton City Council
Development Engineering Unit

ACCEPTED ENGINEERING PLANS

Assessed for Related Resource Consent Conditions Only

Library Reference: 011.2019.00007140.025

Address: Greenhill Stage 24

Date: 7/05/2025

Subject to all notes and conditions affixed




SHRIMPTON &
LIPINSKI
LAND SPECIALISTS



Chedworth
Properties Limited

Ph: 07 577 6069
Email: info@siltga.co.nz
P.O. Box 231, Tauranga 3140
www.siltga.co.nz

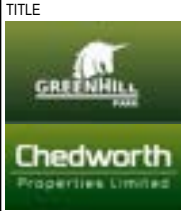

STORMWATER SWALES CROSS-SECTIONS
STAGE 24

REV	DESCRIPTION	DRN	CKD	APP	DATE	COORDINATE SYSTEM: NZGD 2000 - MT EDEN
0	ISSUED FOR RFI	NW		PH	03/04/25	ORIGIN OF COORDINATES: BPV DPS 17824
1	RFI RESPONSE	NW	HB		16/04/25	HEIGHT DATUM: MOTURIKI DATUM 1953
2	RFI RESPONSE	HB	RH		29/04/25	ORIGIN OF HEIGHT: SS07 SO 42451
3	RFI Response Swale 1:2	HB	HB	RH	06/05/25	ORIGINAL SCALES @ A3 1:200
						DO NOT SCALE DIMENSIONS
						DRAWING NO
						STATUS
						REVISION
						30410-01-S24-SW8B
						3

COPYRIGHT ON THIS DRAWING IS RESERVED

R:\Project Files\30410-01-1901 Detail Design\30410 - Stage 24 South Boundary Stormwater Pipe Line.dwg - Plotted: 16/04/2025

Refer to RFI tracker
for further design
and construction
amendments

ACCEPTED ENGINEERING PLANS

Assessed for Related Resource Consent Conditions Only

Library Reference: 011.2019.00007140.025

Address: Greenhill Stage 24

Date: 7/05/2025

Subject to all notes and conditions affixed



S & L Land Specialists

Ph. 07 577 6069
Email: info@slp.co.nz
P.O. Box 231, Tauranga 3144
www.slp.co.nz

NOTES:

1. ALL STORMWATER MANHOLES WITH TYPE 2 SCRUFFY DOME AND SIZES AS SHOWN.
2. ALL STORMWATER MAINS ARE RCRRJ CLASS 4 UNLESS NOTED OTHERWISE.
3. ALL WORKS TO BE CARRIED OUT AND ALL MATERIALS TO COMPLY WITH THE RITS.
4. THE CONTRACTOR MUST CHECK THE RELEVANT LEVEL AND ALIGNMENT OF THE FIRST 1050Ø PIPE LAID WHERE THE CONSTRUCTION STARTS APPROPRIATELY.
5. THE CONTRACTOR MUST CHECK THE RELEVANT LEVEL AND ALIGNMENT OF OTHER EXISTING PIPES SO THAT ALL THE MANHOLES ARE PLACED APPROPRIATELY.
6. THE CONTRACTOR MUST CHECK AND FORM THE FINISHED GROUND TO SUIT EXISTING GROUND SO THE MANHOLE SCRUFFY DOMES TO BE PLACED APPROPRIATELY.
7. THE MANHOLES TO HAVE SEDIMENT COLLECTION SUMP BELOW INVERT LEVEL BY REQUEST FROM THE COUNCIL.

LEGEND:

- FUTURE LOTS
- - ABUTTALS
- STORMWATER PIPE
- ⊙ STORMWATER MANHOLE
- ~ OVERLAND FLOW ARROWS
- EXISTING CONTOURS: 0.25m
- DESIGN CONTOURS: 0.25m
- EXISTING GROUND
- DESIGN SURFACE

Rev	DESCRIPTION	DRN	CKD	APP	DATE
1	ISSUED FOR EPA	TM	HB	PH	12/02/25
2	ISSUED FOR RFI	TM		PH	11/03/25
3	DESIGN REVISED	TM		PH	12/03/25
4	ALIGNMENT SHIFTED	TM		PH	13/03/25
5	ISSUED FOR RFI	TM		PH	03/04/25
6	RFI Response	TM	HB	RH	16/04/25

NAME	DATE	NAME	DATE
SURVEYED		DESIGNED	
COORDINATE SYSTEM: NZGD 2000 - MT EDEN			
ORIGIN OF COORDINATES: BPV DPS 17824			
HEIGHT DATUM: MOTURIKI DATUM 1953			
ORIGIN OF HEIGHT: SS507 SO 42451			

TITLE

STORMWATER EXISTING HCC LINE EXTENSION PLAN

PREPARED FOR



AREAS L, U & K

ORIGINAL SCALES @ A3 STATUS

H 1:500 V 1:100

DO NOT SCALE DIMENSIONS

DRAWING NO


30410-01-S24-SW9

REVISION

6

COPYRIGHT ON THIS DRAWING IS RESERVED

PRIOR TO CONSTRUCTION
ENGINEER TO CONFIRM EXISTING AND
PROPOSED ALIGNMENTS AND INVERT
LEVELS SO THAT THE MANHOLE POSITIONS
ARE SUITABLE.

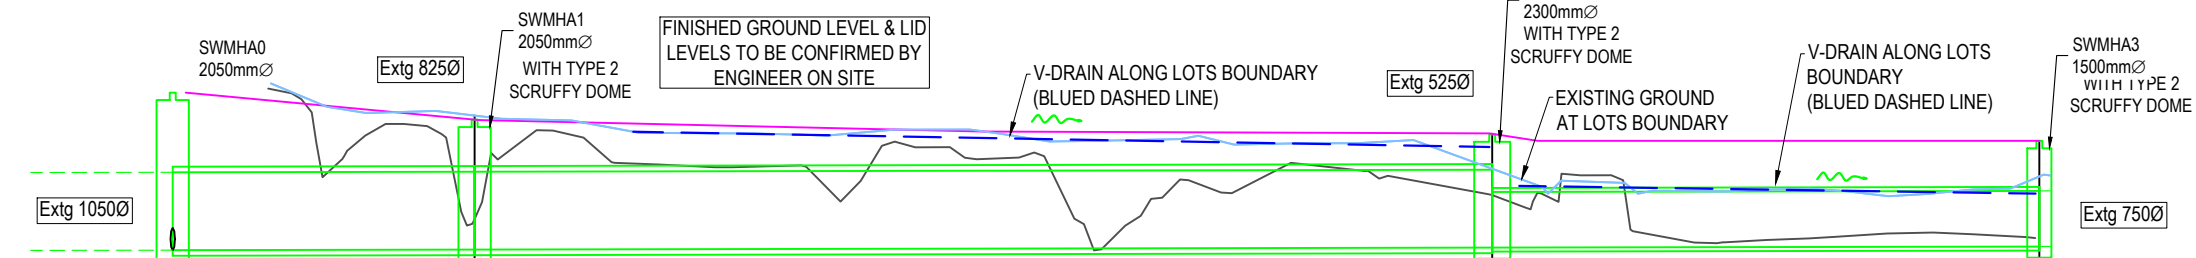

VERT EXAG 1:5
DATUM ELEV: 35.00

CUT TO INVERT
INVERT LEVEL
EXISTING SURFACE
DESIGN SURFACE
DISTANCE
SIZE & GRADE

0.53	1.75	1.75	1.53	1.53	1.42
36.88	36.88	36.88	36.91	36.91	36.93
	37.29		37.62		
	38.64		38.44		38.35
3.38	20.36	23.74	68.63	92.37	36.90
	1,050 mm Concrete Pipe @ 0.04%		1,050 mm Concrete Pipe @ 0.04%		750 mm Concrete Pipe @ 0.04%

AREA U SOUTH SW MAIN EXTENSION LONGSECTION

R:\Project Files\30410-01-1901 Detail Design\30410- Stage 24 South Boundary Stormwater Pipe Line.dwg - Plotted: 16/04/2025



S & L Land Specialists

Ph. 07 577 6069
Email: info@slip.co.nz
P.O. Box 231, Tauranga 3144
www.slip.co.nz

ORIGINAL LEVEL
FINISHED LEVEL

38.88	37.75	38.35	
39.03	37.97	38.35	

ORIGINAL LEVEL
FINISHED LEVEL

		37.63	
39.16	38.15	38.45	

ORIGINAL LEVEL
FINISHED LEVEL


		37.42	
39.15	38.29	38.64	

Refer to RFI tracker
for further design
and construction
amendments


Hamilton City Council
Development Engineering Unit
ACCEPTED ENGINEERING PLANS
Assessed for Related Resource Consent Conditions Only
Library Reference: 011.2019.00007140.025
Address: Greenhill Stage 24
Date: 7/05/2025
Subject to all notes and conditions affixed

RIPRAP PROTECTION
4.0m x 4.0m x 0.3m DEEP
150mm ALD ROCKS WRAPPED
GEO FABRIC BIDIM A44 OR SIMILAR

SHALLOW SWALE RIPRAP PROTECTION

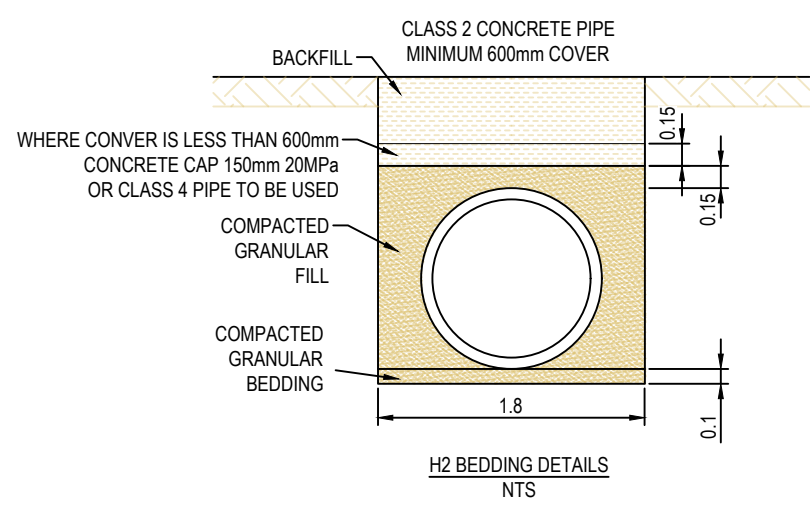


UPDATED MAY 2018

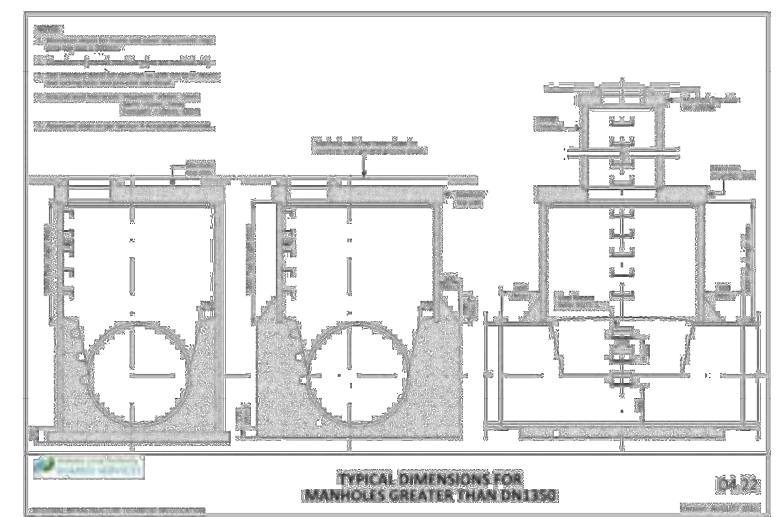

LARGE DIAMETER MANHOLE STANDARD DRAWING

WEST SW DRAIN TYPICAL CROSS SECTION 1:200

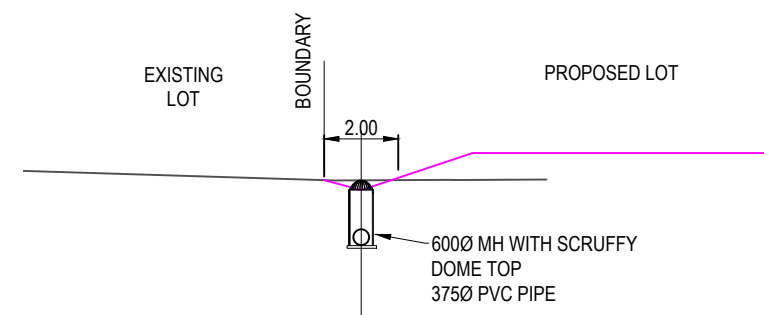

Rev	DESCRIPTION	DRN	CKD	APP	DATE
1	ISSUED FOR EPA	TM	HB	PH	12/02/25
2	ISSUED FOR RFI	TM		PH	11/03/25
3	DESIGN REVISED	TM		PH	12/03/25
4	ALIGNMENT SHIFTED	TM		PH	13/03/25
5	ISSUED FOR RFI	TM		PH	03/04/25
6	RFI Response	TM	HB	RH	16/04/25

NAME	DATE	NAME	DATE
SURVEYED		DESIGNED	
COORDINATE SYSTEM: NZGD 2000 - MT EDEN			
ORIGIN OF COORDINATES: BPV DPS 17824			
HEIGHT DATUM: MOTURIKI DATUM 1953			
ORIGIN OF HEIGHT: SS507 SO 42451			


STORMWATER EXISTING HCC LINE EXTENSION DETIALS



AREAS L,U & K	
ORIGINAL SCALES @ A3	STATUS
1 : 250	FOR APPROVAL
DO NOT SCALE DIMENSIONS	
DRAWING NO	REVISION
30410-01-S24-SW10	6

COPYRIGHT ON THIS DRAWING IS RESERVED

R:\Project Files\30410-01-1901 Detail Design\30410 - Stage 24 South Boundary Stormwater Pipe Line.dwg - Plotted: 7/05/2025

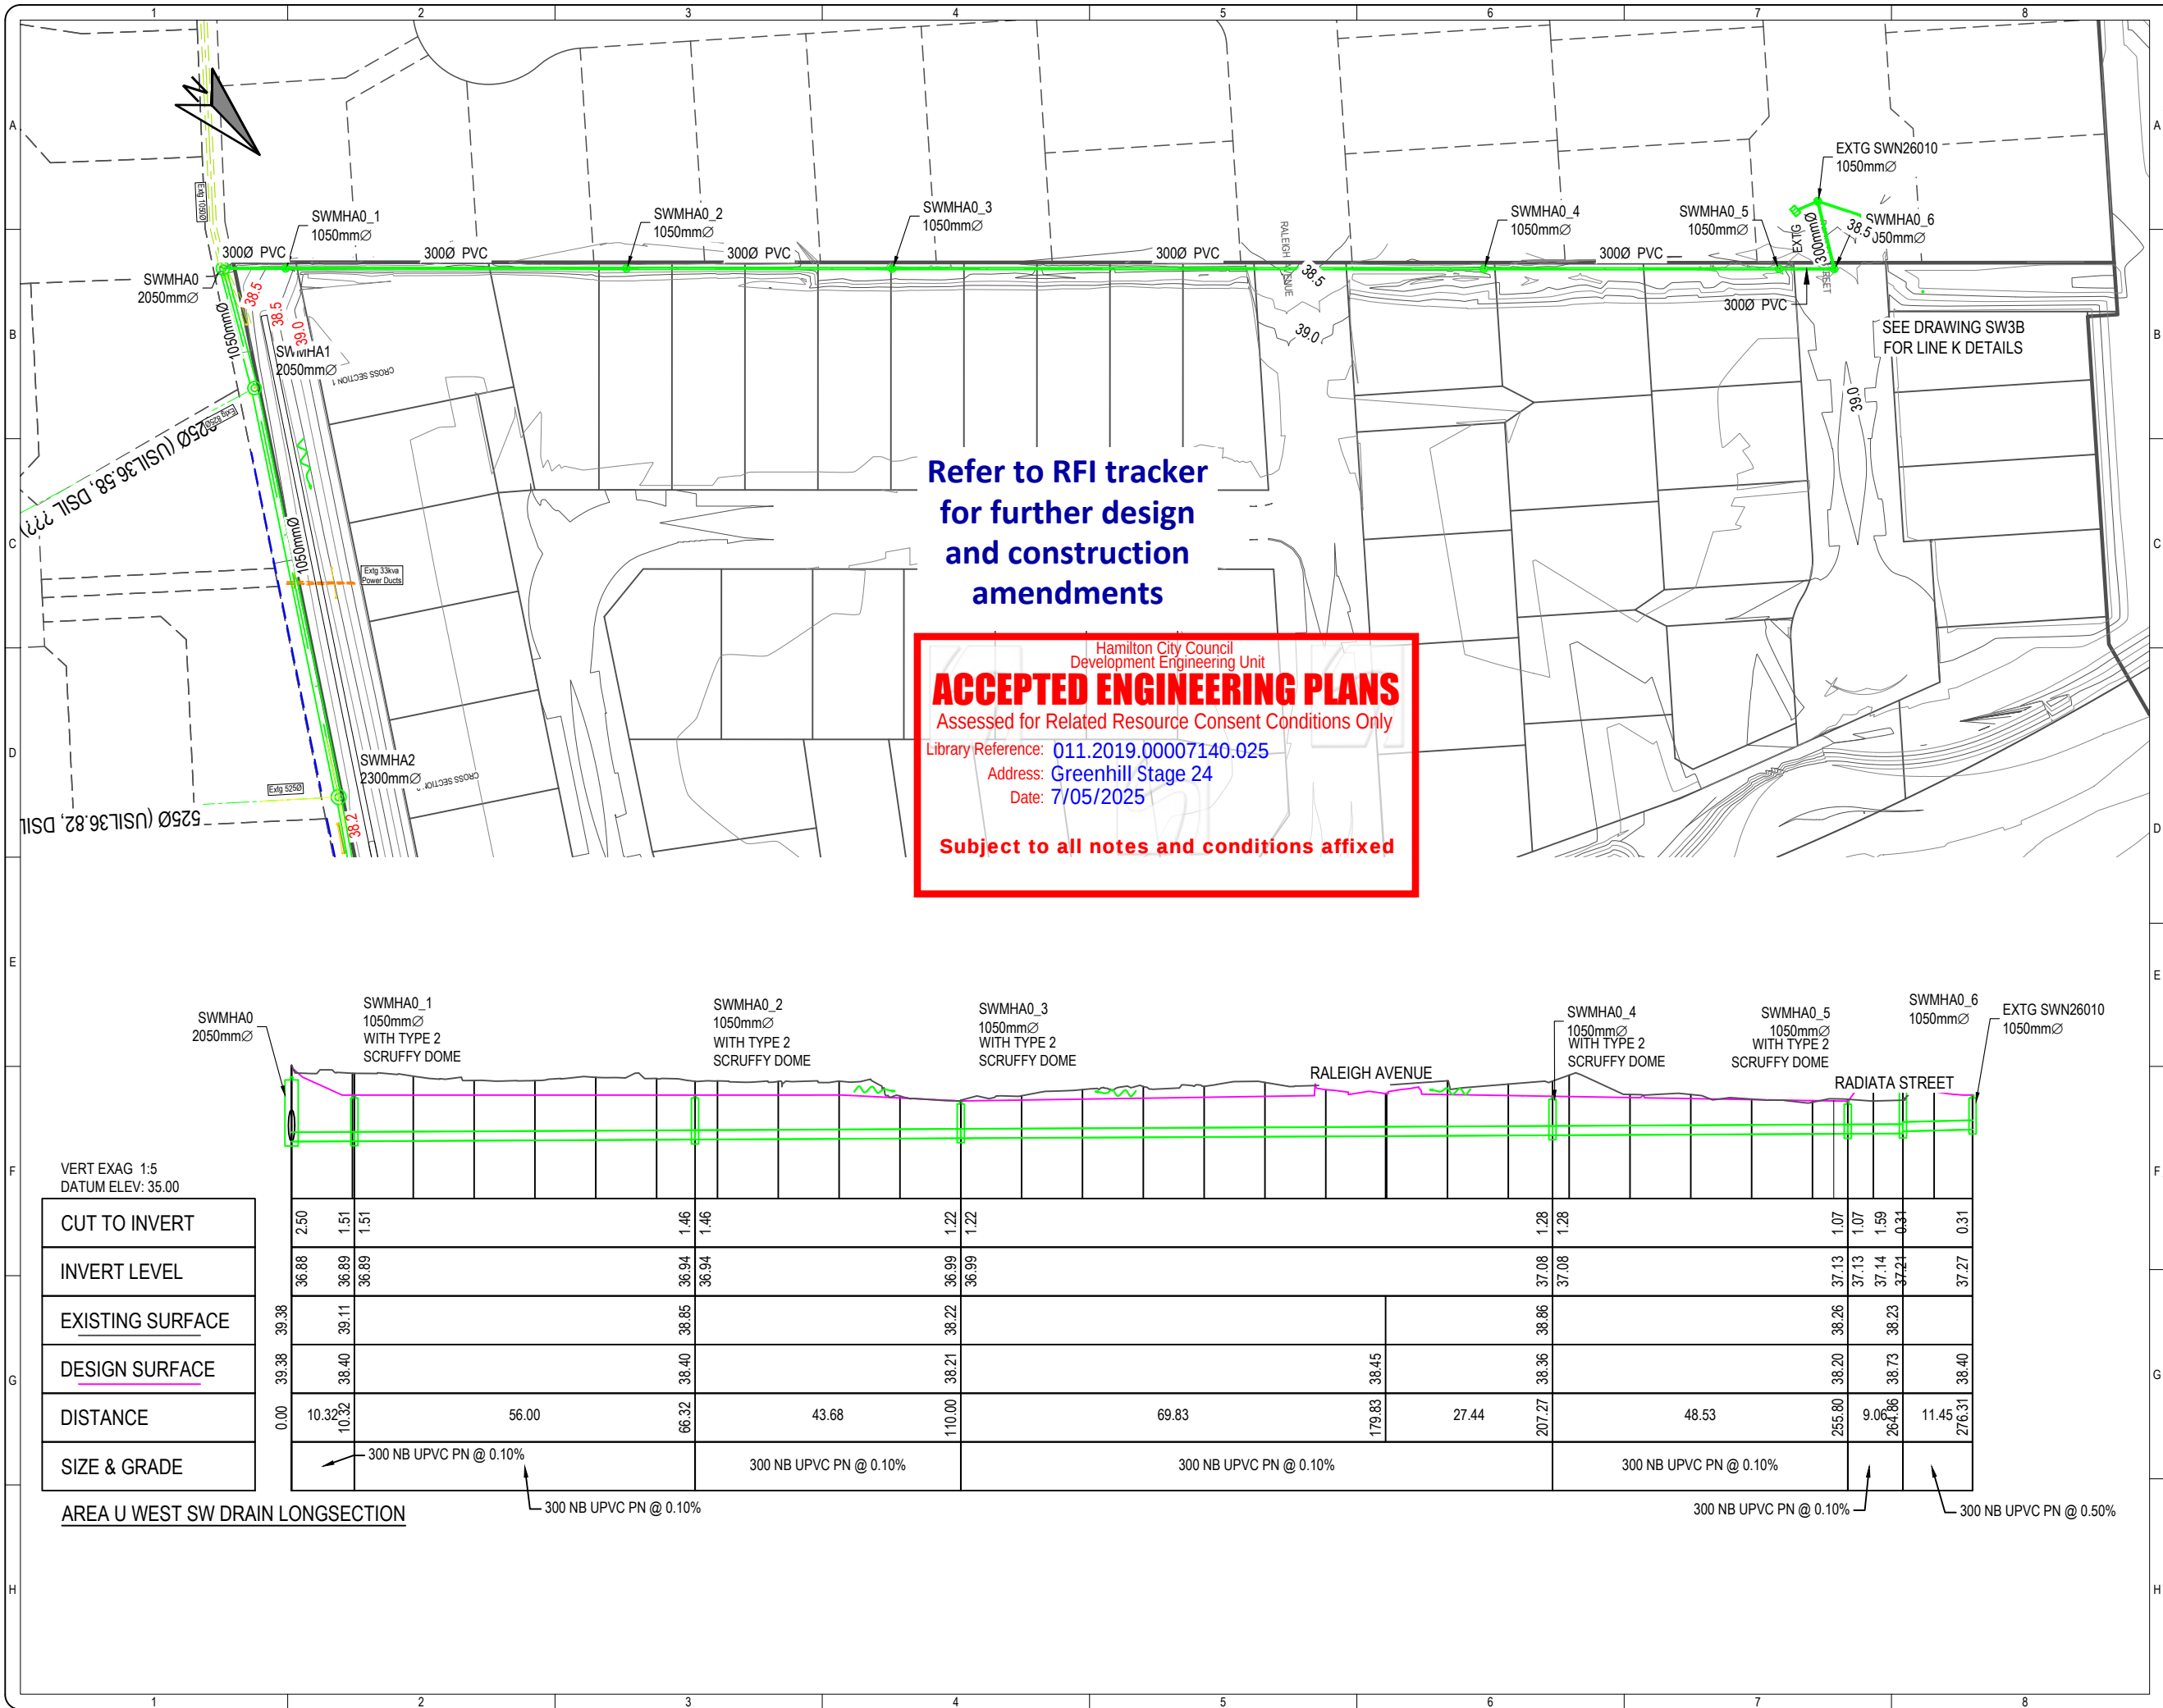

S & L Land Specialists

Ph. 07 577 6069
Email: info@slp.co.nz
P.O. Box 231, Tauranga 3144
www.slp.co.nz

NOTES:

1. ALL STORMWATER MANHOLES WITH TYPE 2 SCRUFFY DOME AND SIZES AS SHOWN.
2. ALL STORMWATER MAINS ARE RCRRJ CLASS 4 UNLESS NOTED OTHERWISE.
3. ALL WORKS TO BE CARRIED OUT AND ALL MATERIALS TO COMPLY WITH THE RITS.
4. THE CONTRACTOR MUST CHECK THE RELEVANT LEVEL AND ALIGNMENT OF THE FIRST 1050mm PIPE LAID WHERE THE CONSTRUCTION STARTS APPROPRIATELY.
5. THE CONTRACTOR MUST CHECK THE RELEVANT LEVEL AND ALIGNMENT OF OTHER EXISTING PIPES SO THAT THE ALL THE MANHOLES ARE PLACED APPROPRIATELY.
6. THE CONTRACTOR MUST CHECK AND FORM THE FINISHED GROUND TO SUIT EXISTING GROUND SO THE MANHOLE SCRUFFY DOMES TO BE PLACED APPROPRIATELY.
7. THE MANHOLES TO HAVE SEDIMENT COLLECTION SUMP BELOW INVERT LEVEL BY REQUEST FROM THE COUNCIL.

LEGEND:

- FUTURE LOTS
- - ABUTTALS
- STORMWATER PIPE
- ⊙ STORMWATER MANHOLE
- ~ OVERLAND FLOW ARROWS
- EXISTING CONTOURS: 0.25m
- DESIGN CONTOURS: 0.25m
- EXISTING GROUND
- DESIGN SURFACE

Rev	DESCRIPTION	DRN	CKD	APP	DATE
1	ISSUED FOR RFI	TM	PH		03/04/25
2	RFI Response	TM	HB	RH	16/04/25
3	RFI Response	TM	HB		24/04/25

NAME	DATE	NAME	DATE
SURVEYED		DESIGNED	
COORDINATE SYSTEM: NZGD 2000 - MT EDEN			
ORIGIN OF COORDINATES: BPV DPS 17824			
HEIGHT DATUM: MOTURIKI DATUM 1953			
ORIGIN OF HEIGHT: SS507 SO 42451			


STORMWATER STAGE 24 WEST SWALE UNDERDRAIN



AREAS L, U & K
ORIGINAL SCALES @ A3 STATUS
H 1:1000 V 1:200 FOR APPROVAL
DO NOT SCALE DIMENSIONS
DRAWING NO
REVISION

30410-01-S24-SW11 3

COPYRIGHT ON THIS DRAWING IS RESERVED

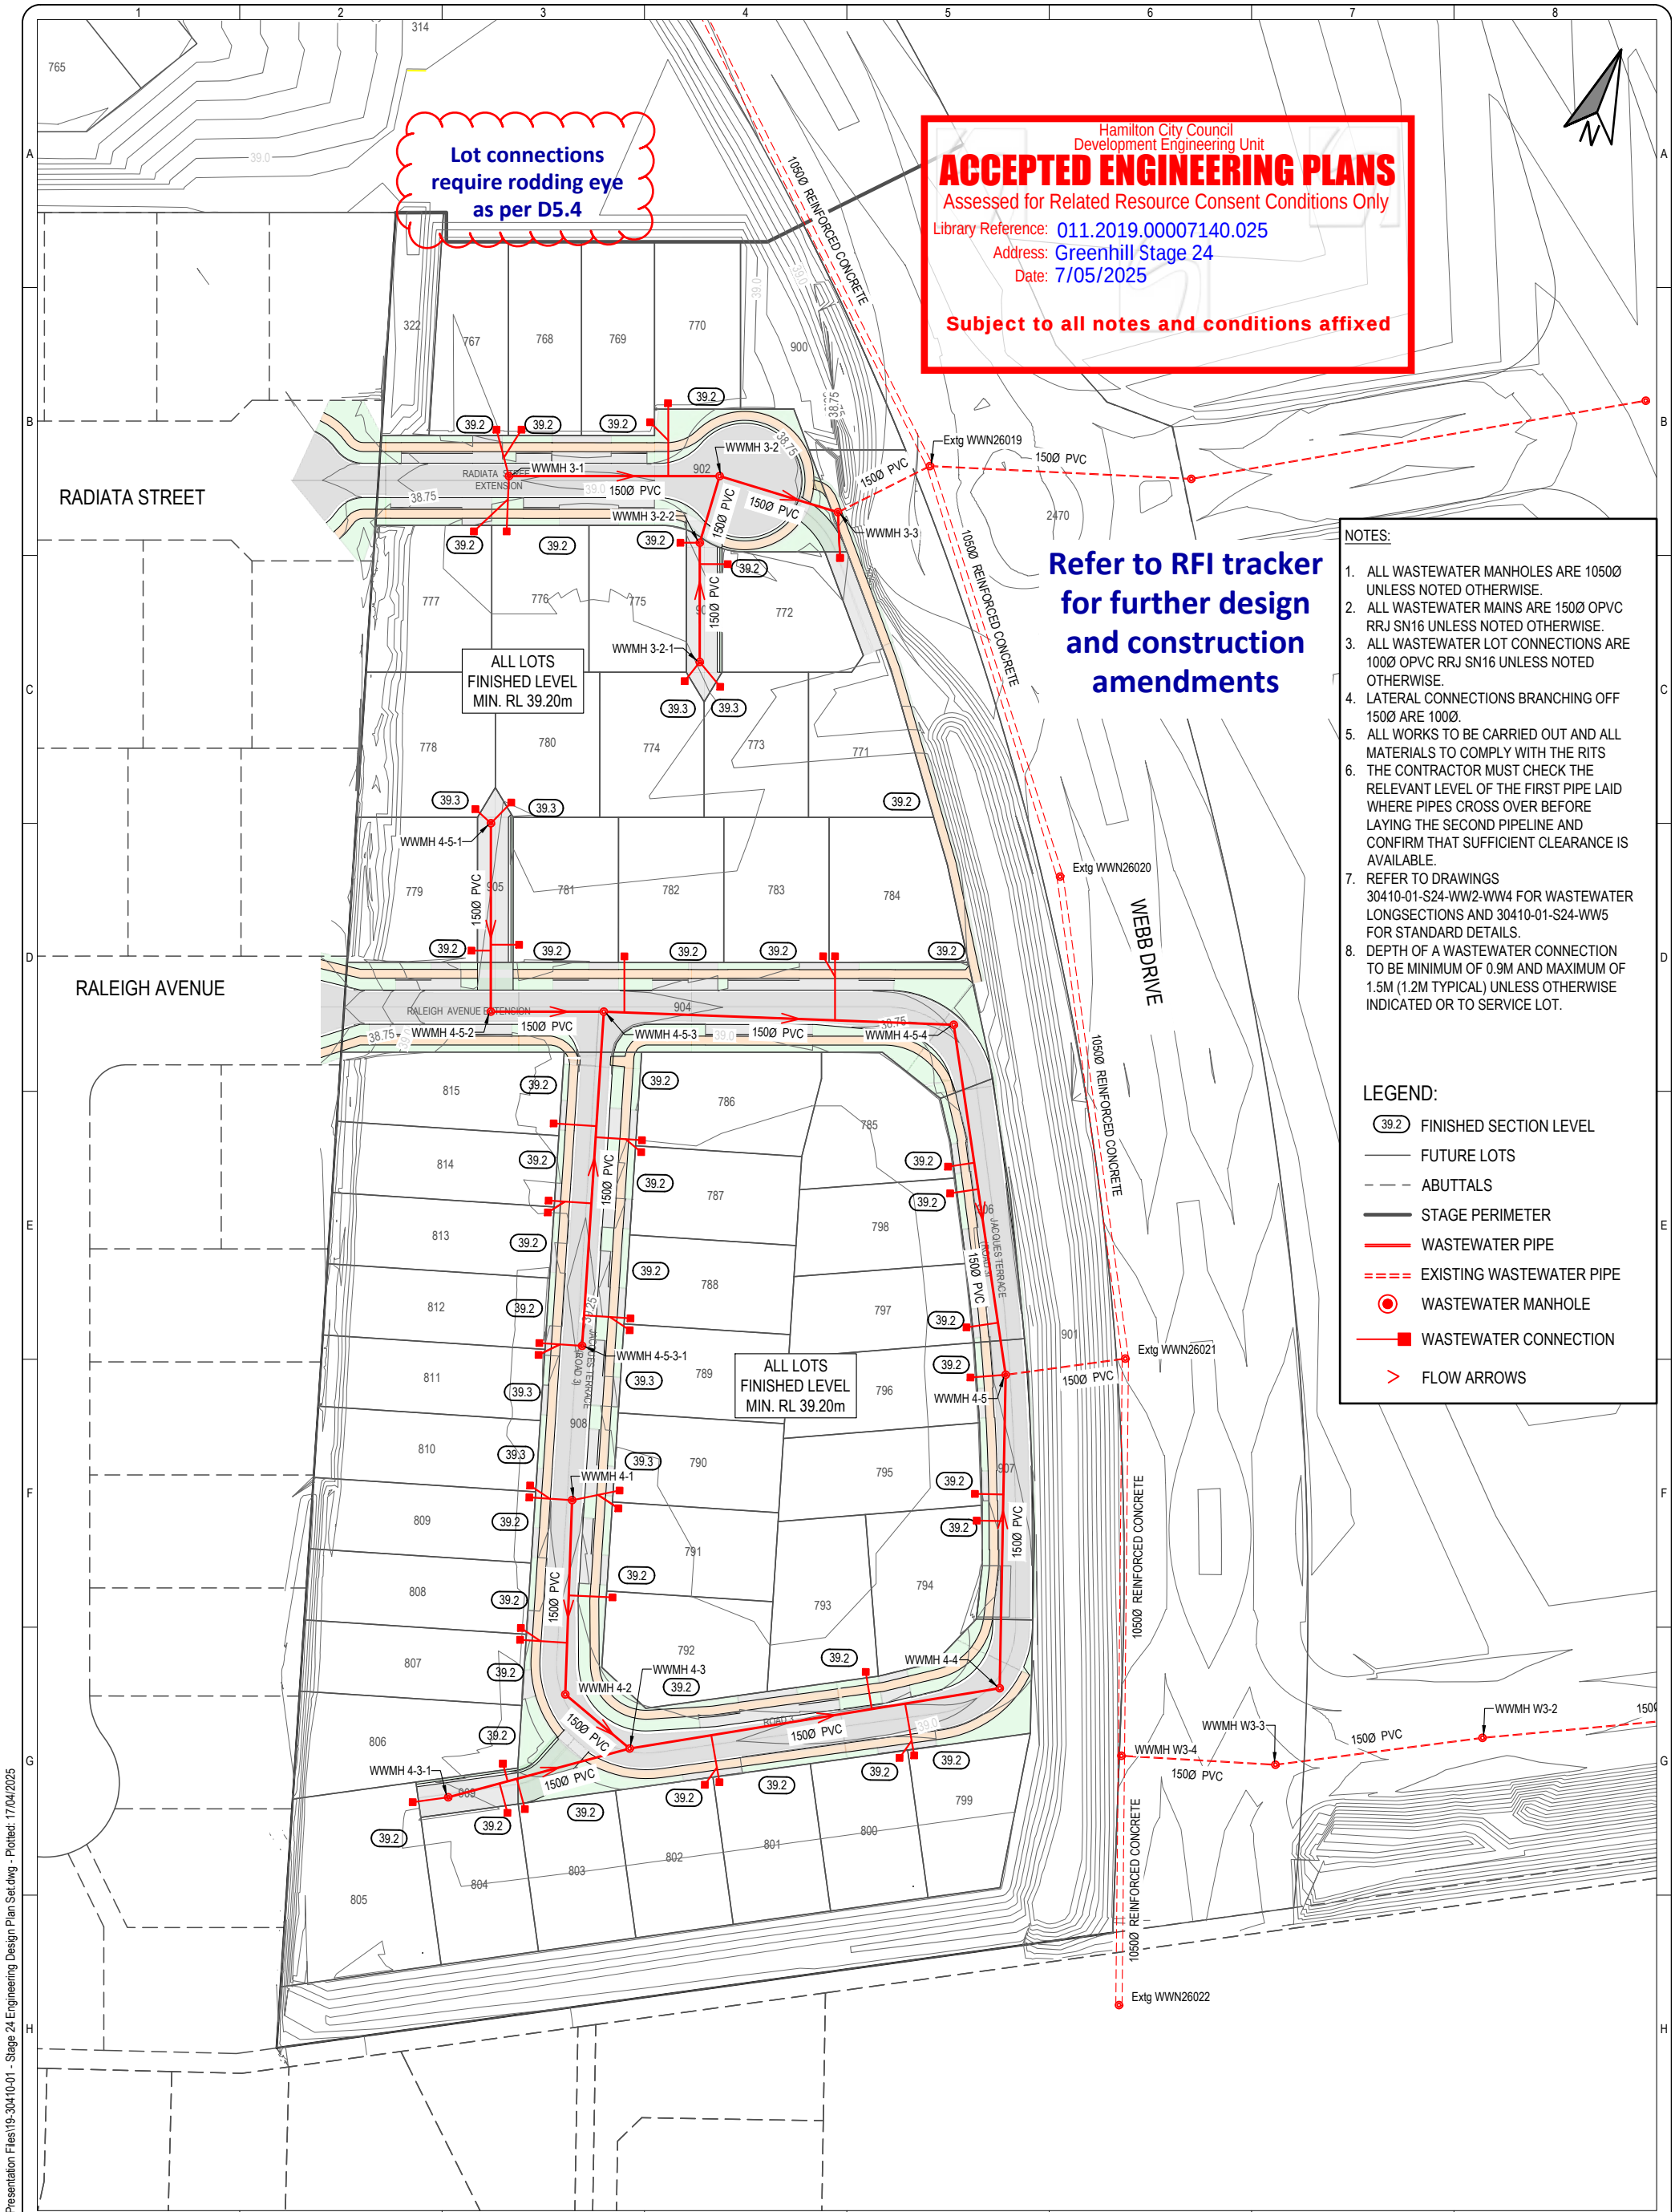

Lot connections
require rodding eye
as per D5.4

Hamilton City Council
Development Engineering Unit

ACCEPTED ENGINEERING PLANS
Assessed for Related Resource Consent Conditions Only
Library Reference: 011.2019.00007140.025
Address: Greenhill Stage 24
Date: 7/05/2025

Subject to all notes and conditions affixed

Refer to RFI tracker
for further design
and construction
amendments

NOTES:

1. ALL WASTEWATER MANHOLES ARE 1050Ø UNLESS NOTED OTHERWISE.

2. ALL WASTEWATER MAINS ARE 1500Ø OPVC RRJ SN16 UNLESS NOTED OTHERWISE.

3. ALL WASTEWATER LOT CONNECTIONS ARE 100Ø OPVC RRJ SN16 UNLESS NOTED OTHERWISE.

4. LATERAL CONNECTIONS BRANCHING OFF 1500Ø ARE 100Ø.

5. ALL WORKS TO BE CARRIED OUT AND ALL MATERIALS TO COMPLY WITH THE RITS

6. THE CONTRACTOR MUST CHECK THE RELEVANT LEVEL OF THE FIRST PIPE LAID WHERE PIPES CROSS OVER BEFORE LAYING THE SECOND PIPELINE AND CONFIRM THAT SUFFICIENT CLEARANCE IS AVAILABLE.

7. REFER TO DRAWINGS 30410-01-S24-WW2-WW4 FOR WASTEWATER LONGSECTIONS AND 30410-01-S24-WW5 FOR STANDARD DETAILS.

8. DEPTH OF A WASTEWATER CONNECTION TO BE MINIMUM OF 0.9M AND MAXIMUM OF 1.5M (1.2M TYPICAL) UNLESS OTHERWISE INDICATED OR TO SERVICE LOT.

LEGEND:

39.2

FINISHED SECTION LEVEL

FUTURE LOTS

ABUTTALS

STAGE PERIMETER

WASTEWATER PIPE

EXISTING WASTEWATER PIPE

●

WASTEWATER MANHOLE

WASTEWATER CONNECTION

>

FLOW ARROWS

R:\Project Files\30410-01-1901 Drawing Presentation Files\19-30410-01 - Stage 24 Engineering Design Plan Set.dwg - Plotted: 17/04/2025

S&L

SHRIMPTON & LIPINSKI

LAND SPECIALISTS

Ph: 07 577 6069
Email: info@sltga.co.nz
P.O. Box 231, Tauranga 3140
www.sltga.co.nz

GREENHILL

Chedworth

Properties Limited

WASTEWATER LAYOUT PLAN
STAGE 24

REV	DESCRIPTION	DRN	CKD	APP	DATE
0	PRELIMINARY	NW			13/8/24
1	ISSUED FOR EPA	NW	HB	PH	16/8/24
2	ISSUED FOR RFI	TM	RH	PH	23/10/24
3	ISSUED FOR RFI	TM		PH	07/04/25
4	RFI RESPONSE	NW	HB		16/04/25

COORDINATE SYSTEM: NZGD 2000 - MT EDEN
ORIGIN OF COORDINATES: BPV DPS 17824
HEIGHT DATUM: MOTURIKI DATUM 1953
ORIGIN OF HEIGHT: SS507 SO 42451
ORIGINAL SCALES @ A3 1:1000
DO NOT SCALE DIMENSIONS



STATUS
FOR APPROVAL

DRAWING NO
30410-01-S24-WW1

REVISION
4

COPYRIGHT ON THIS DRAWING IS RESERVED

R:\Project Files\30410-01-1901 Drawing Presentation Files\19-30410-01 - Stage 24 Engineering Design Plan Set.dwg - Plotted: 16/04/2025

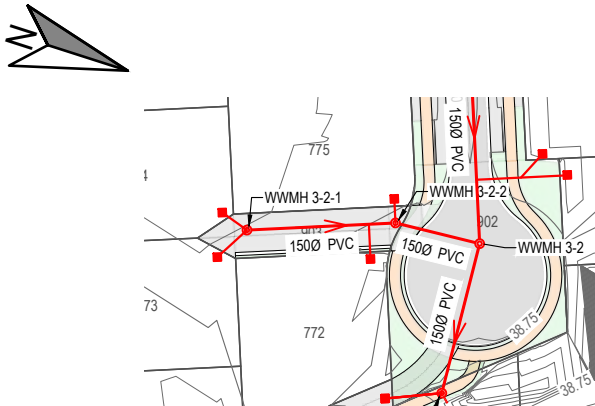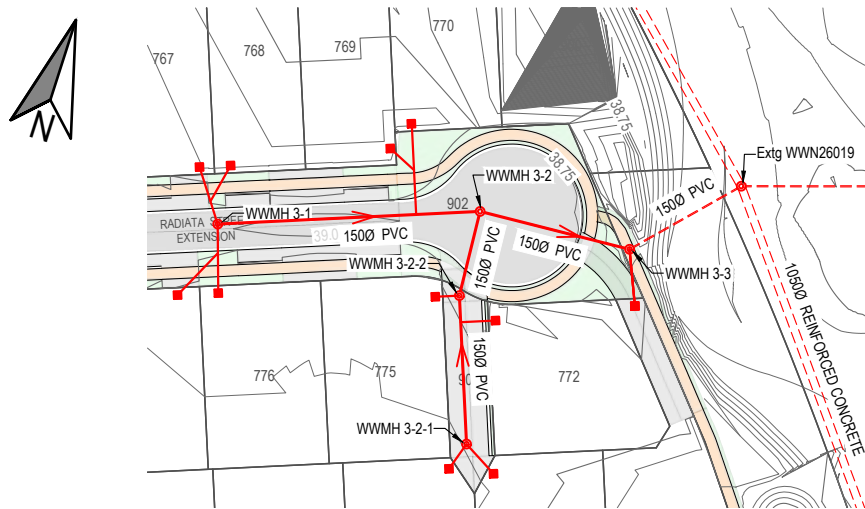

LEGEND:



- FUTURE LOTS
- - - ABUTTALS
- STAGE PERIMETER
- WASTEWATER PIPE
- EXISTING WASTEWATER
- WASTEWATER MANHOLE
- WASTEWATER CONNECTION
- > FLOW ARROWS

Hamilton City Council
Development Engineering Unit
ACCEPTED ENGINEERING PLANS
Assessed for Related Resource Consent Conditions Only

Library Reference: 011.2019.00007140.025
Address: Greenhill Stage 24
Date: 7/05/2025

Subject to all notes and conditions affixed

Refer to RFI tracker
for further design
and construction
amendments

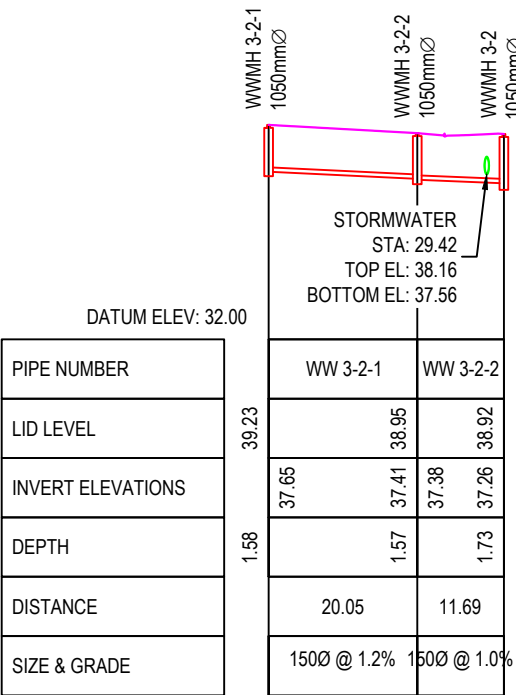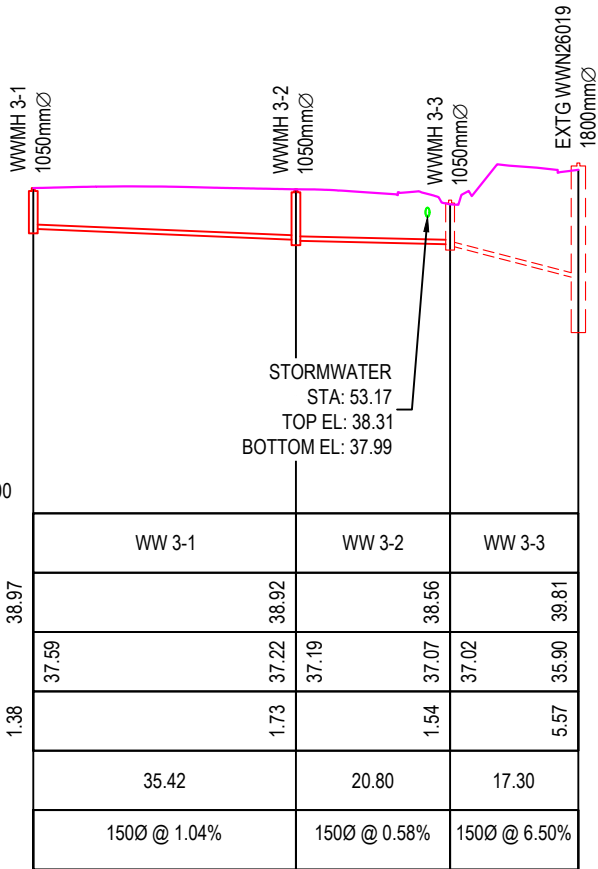

NOTES:

- ALL WASTEWATER MANHOLES ARE 1050Ø UNLESS NOTED OTHERWISE.
- ALL WASTEWATER MAINS ARE 1500Ø OPVC RRJ SN16 UNLESS NOTED OTHERWISE.
- ALL WASTEWATER LOT CONNECTIONS ARE 1000Ø OPVC RRJ SN16 UNLESS NOTED OTHERWISE.
- LATERAL CONNECTIONS BRANCHING OFF 1500Ø ARE 1000Ø.
- ALL WORKS TO BE CARRIED OUT AND ALL MATERIALS TO COMPLY WITH THE RITS
- THE CONTRACTOR MUST CHECK THE RELEVANT LEVEL OF THE FIRST PIPE LAID WHERE PIPES CROSS OVER BEFORE LAYING THE SECOND PIPELINE AND CONFIRM THAT SUFFICIENT CLEARANCE IS AVAILABLE.
- REFER TO DRAWING 30410-01-S24-WW5 FOR STANDARD DETAILS.
- DEPTH OF A WASTEWATER CONNECTION TO BE MINIMUM OF 0.9M AND MAXIMUM OF 1.5M (1.2M TYPICAL) UNLESS OTHERWISE INDICATED OR TO SERVICE LOT.

Rev	DESCRIPTION	DRN	CKD	APP	DATE
0	PRELIMINARY	NW	HB	PH	14/8/24
1	ISSUED FOR EPA	NW	HB	PH	16/8/24
2	ISSUED FOR RFI	TM	RH	PH	23/10/24
3	ISSUED FOR RFI	TM	PH	PH	07/04/25
4	RFI RESPONSE	NW	HB	PH	16/04/25

NAME	DATE	NAME	DATE
SURVEYED		DESIGNED	
COORDINATE SYSTEM: NZGD 2000 - MT EDEN			
ORIGIN OF COORDINATES: BPV DPS 17824			
HEIGHT DATUM: MOTURIKI DATUM 1953			
ORIGIN OF HEIGHT: SS507 SO 42451			

TITLE


**WASTEWATER
LINES 3 & 3-2
LONGSECTION**

PREPARED FOR



AREAS L, U & K	
ORIGINAL SCALES @ A3	STATUS
H 1:1000 V 1:250	FOR APPROVAL
DO NOT SCALE DIMENSIONS	
DRAWING NO	REVISION
30410-01-S24-WW2	4

R:\Project Files\30410-01-1901 Drawing Presentation Files\19-30410-01 - Stage 24 Engineering Design Plan Set.dwg - Plotted: 16/04/2025

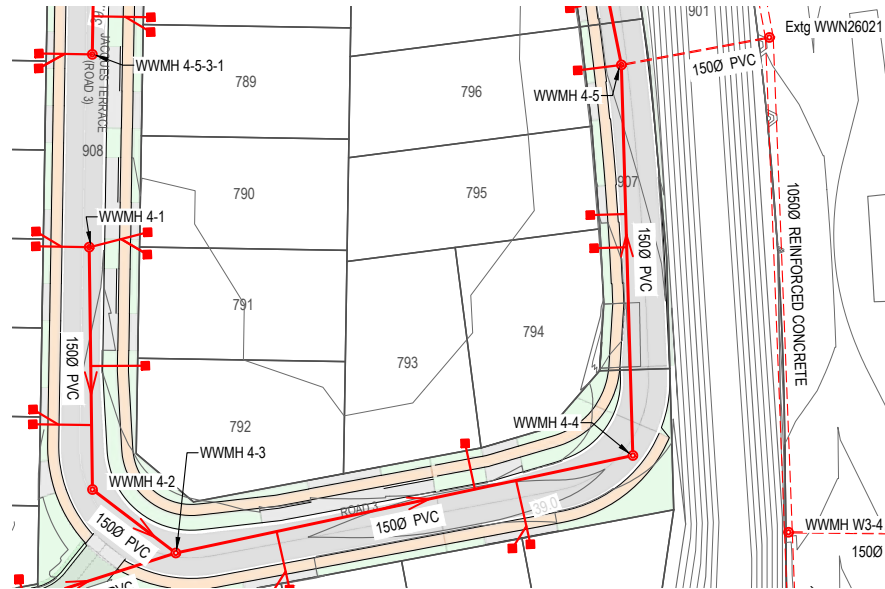

Hamilton City Council
Development Engineering Unit

ACCEPTED ENGINEERING PLANS
Assessed for Related Resource Consent Conditions Only
Library Reference: 011.2019.00007140.025
Address: Greenhill Stage 24
Date: 7/05/2025

Subject to all notes and conditions affixed

Refer to RFI tracker
for further design
and construction
amendments



LEGEND:

—

FUTURE LOTS

- - -

ABUTTALS

—

STAGE PERIMETER

—

WASTEWATER PIPE

- - -

EXISTING WASTEWATER

●


WASTEWATER MANHOLE

—■

WASTEWATER CONNECTION

>

FLOW ARROWS

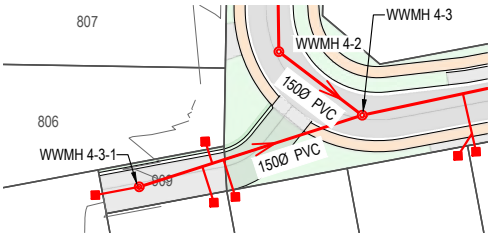

STORMWATER
STA: 30.03
TOP EL: 38.20
BOTTOM EL: 37.77

STORMWATER
STA: 19.73
TOP EL: 38.19
BOTTOM EL: 37.93

STORMWATER
STA: 27.93
TOP EL: 38.19
BOTTOM EL: 37.87

DATUM ELEV: 28.00

PIPE NUMBER
LID LEVEL
INVERT ELEVATIONS
DEPTH
DISTANCE
SIZE & GRADIENT

WWMH 4-1 1050mmØ	WWMH 4-2 1050mmØ	WWMH 4-3 1050mmØ	WWMH 4-4 1050mmØ	WWMH 4-5 1050mmØ	EXTG WWMH26021 1800mmØ
STORMWATER STA: 119.92 TOP EL: 37.75 BOTTOM EL: 37.49					
WW 4-1	WW 4-2	WW 4-3	WW 4-4	WW 4-5	
39.08	38.90	38.89	38.94	38.68	39.26
37.57	37.24	37.19	37.10	36.70	36.64
1.52	1.71	1.85	2.30	2.40	4.58
32.68	14.13	63.03	52.69	20.30	
1500 @ 1.00%	500 @ 0.64%	1500 @ 0.55%	1500 @ 0.55%	1500 @ 0.55%	

WASTEWATER NETWORK LINE- 4 LONGSECTION

DATUM ELEV: 32.00

PIPE NUMBER
LID LEVEL
INVERT ELEVATIONS
DEPTH
DISTANCE
SIZE & GRADE

WWMH 4-3-1 1050mmØ	WWMH 4-3 1050mmØ
STORMWATER STA: 27.93 TOP EL: 38.19 BOTTOM EL: 37.87	
WW 4-3-1	
39.32	38.89
38.06	37.19
1.26	1.85
31.59	
1500 @ 2.8%	

WASTEWATER NETWORK - LINE 4-3 LONGSECTION



SHRIMPTON &
LIPINSKI
LAND DEVELOPMENT &
DESIGN SPECIALISTS

Ph: 07 577 6069
Email: info@sltga.co.nz
P.O. Box 231, Tauranga 3140
www.sltga.co.nz

NOTES:

- ALL WASTEWATER MANHOLES ARE 1050Ø UNLESS NOTED OTHERWISE.
- ALL WASTEWATER MAINS ARE 1500Ø OPVC RRJ SN16 UNLESS NOTED OTHERWISE.
- ALL WASTEWATER LOT CONNECTIONS ARE 1000Ø OPVC RRJ SN16 UNLESS NOTED OTHERWISE.
- LATERAL CONNECTIONS BRANCHING OFF 1500Ø ARE 1000Ø.
- ALL WORKS TO BE CARRIED OUT AND ALL MATERIALS TO COMPLY WITH THE RITS
- THE CONTRACTOR MUST CHECK THE RELEVANT LEVEL OF THE FIRST PIPE LAID WHERE PIPES CROSS OVER BEFORE LAYING THE SECOND PIPELINE AND CONFIRM THAT SUFFICIENT CLEARANCE IS AVAILABLE.
- REFER TO DRAWING 30410-01-S24-WW5 FOR STANDARD DETAILS.
- DEPTH OF A WASTEWATER CONNECTION TO BE MINIMUM OF 0.9M AND MAXIMUM OF 1.5M (1.2M TYPICAL) UNLESS OTHERWISE INDICATED OR TO SERVICE LOT.

Rev	DESCRIPTION	DRN	CKD	APP	DATE
0	PRELIMINARY	NW	HB	PH	14/8/24
1	ISSUED FOR EPA	NW	HB	PH	16/8/24
2	ISSUED FOR RFI	TM	RH	PH	23/10/24
3	ISSUED FOR RFI	TM	PH		07/04/25
4	RFI RESPONSE	NW	HB		16/04/25

NAME	DATE	NAME	DATE
SURVEYED		DESIGNED	
COORDINATE SYSTEM: NZGD 2000 - MT EDEN			
ORIGIN OF COORDINATES: BPV DPS 17824			
HEIGHT DATUM: MOTURIKI DATUM 1953			
ORIGIN OF HEIGHT: SS507 SO 42451			

WASTEWATER
LINES 4 & 4-3
LONGSECTION

PREPARED FOR



AREAS L,U & K

ORIGINAL SCALES @ A3 STATUS

H 1:1000 V 1:250

DO NOT SCALE DIMENSIONS

DRAWING NO

30410-01-S24-WW3


FOR APPROVAL

REVISION

4

COPYRIGHT ON THIS DRAWING IS RESERVED

R:\Project Files\30410-01-1901 Drawing Presentation Files\19-30410-01 - Stage 24 Engineering Design Plan Set.dwg - Plotted: 16/04/2025

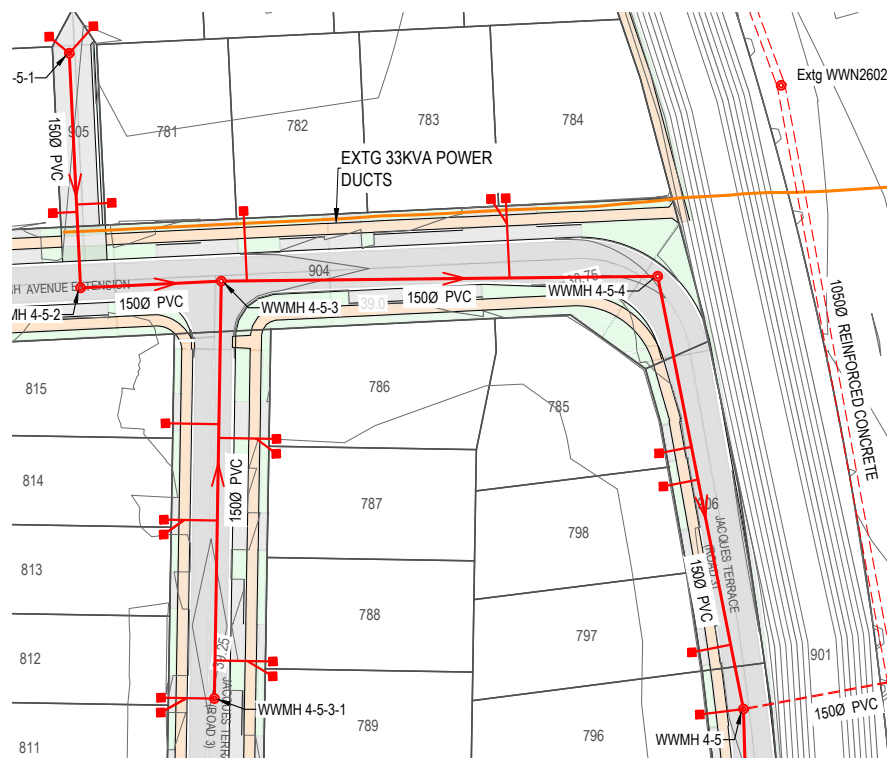

Hamilton City Council
Development Engineering Unit

ACCEPTED ENGINEERING PLANS

Assessed for Related Resource Consent Conditions Only

Library Reference: 011.2019.00007140.025

Address: Greenhill Stage 24


Date: 7/05/2025

Subject to all notes and conditions affixed

Refer to RFI tracker
for further design
and construction
amendments

LEGEND:

- FUTURE LOTS
- - - ABUTTALS
- STAGE PERIMETER
- WASTEWATER PIPE
- EXISTING WASTEWATER
- WASTEWATER MANHOLE
- WASTEWATER CONNECTION
- > FLOW ARROWS

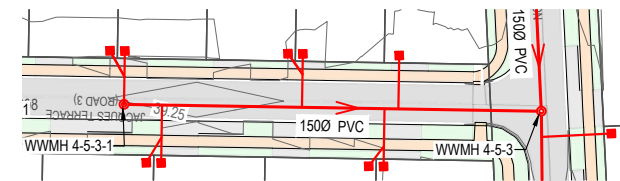

00 <

WASTEWATER NETWORK LINE- 4-5 LONGSECTION

DATUM ELEV: 32.00		WWMH 4-5-3-1 1050mmØ		WWMH 4-5-3 1050mmØ	
PIPE NUMBER		WW 4-5-3-1			
LID LEVEL	39.24	39.10			
INVERT ELEVATIONS	1.52	37.72	37.15		
DEPTH		2.02			
DISTANCE		56.29			
SIZE & GRADE		1500Ø @ 1.0%			

WASTEWATER NETWORK LINE- 4-5-3 LONGSECTION



SHRIMPTON &
LIPINSKI
LAND DEVELOPMENT &
DESIGN SPECIALISTS

Ph. 07 577 6069
Email: info@sltga.co.nz
P.O. Box 231, Tauranga 3140
www.sltga.co.nz

NOTES:

- ALL WASTEWATER MANHOLES ARE 1050Ø UNLESS NOTED OTHERWISE.
- ALL WASTEWATER MAINS ARE 1500Ø OPVC RRJ SN16 UNLESS NOTED OTHERWISE.
- ALL WASTEWATER LOT CONNECTIONS ARE 1000Ø OPVC RRJ SN16 UNLESS NOTED OTHERWISE.
- LATERAL CONNECTIONS BRANCHING OFF 1500Ø ARE 1000Ø.
- ALL WORKS TO BE CARRIED OUT AND ALL MATERIALS TO COMPLY WITH THE RITS
- THE CONTRACTOR MUST CHECK THE RELEVANT LEVEL OF THE FIRST PIPE LAID WHERE PIPES CROSS OVER BEFORE LAYING THE SECOND PIPELINE AND CONFIRM THAT SUFFICIENT CLEARANCE IS AVAILABLE.
- REFER TO DRAWING 30410-01-S24-WW5 FOR STANDARD DETAILS.
- DEPTH OF A WASTEWATER CONNECTION TO BE MINIMUM OF 0.9M AND MAXIMUM OF 1.5M (1.2M TYPICAL) UNLESS OTHERWISE INDICATED OR TO SERVICE LOT.

Rev	DESCRIPTION	DRN	CKD	APP	DATE
0	PRELIMINARY	NW	HB	PH	14/8/24
1	ISSUED FOR EPA	NW	HB	PH	16/8/24
2	ISSUED FOR RFI	TM	RH	PH	23/10/24
3	ISSUED FOR RFI	TM	RH	PH	07/04/25
4	RFI RESPONSE	NW	HB	PH	16/04/25

NAME	DATE	NAME	DATE
SURVEYED		DESIGNED	
COORDINATE SYSTEM: NZGD 2000 - MT EDEN			
ORIGIN OF COORDINATES: BPV DPS 17824			
HEIGHT DATUM: MOTURIKI DATUM 1953			
ORIGIN OF HEIGHT: SS507 SO 42451			

TITLE

WASTEWATER LINES 4-5 & 4-5-3 LONGSECTION



AREAS L,U & K

ORIGINAL SCALES @ A3 STATUS
H 1:1000 V 1:250 FOR APPROVAL
DO NOT SCALE DIMENSIONS
DRAWING NO

30410-01-S24-WW4

4





COPYRIGHT ON THIS DRAWING IS RESERVED

R:\Project Files\04\10-01-1901 Drawing Presentation Files\19-304\10-01 - Stage 24 Engineering Design Plan Set.dwg - Plotted: 16/04/2025



SHRIMPSTON &
LIPINSKI
LAND DEVELOPMENT &
DESIGN SPECIALISTS

Ph. 07 577 6069
Email: info@sltga.co.nz
P.O. Box 231, Tauranga 3140
www.sltga.co.nz

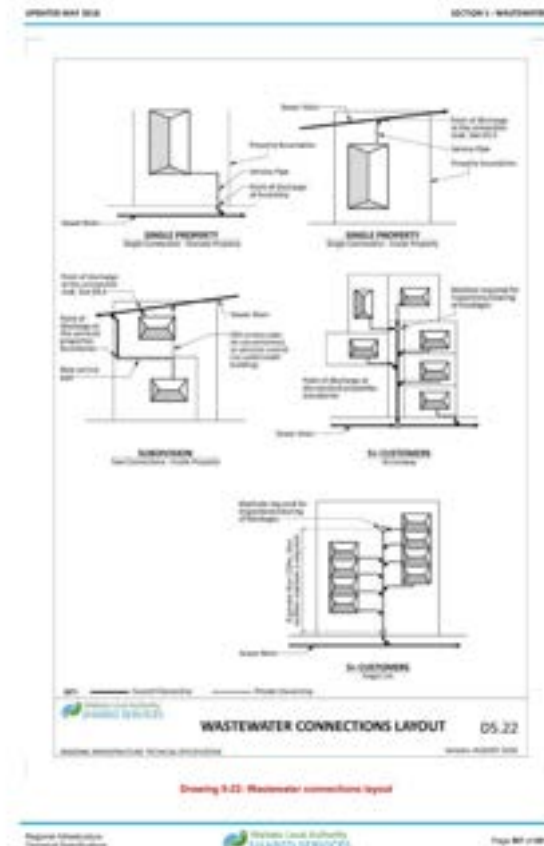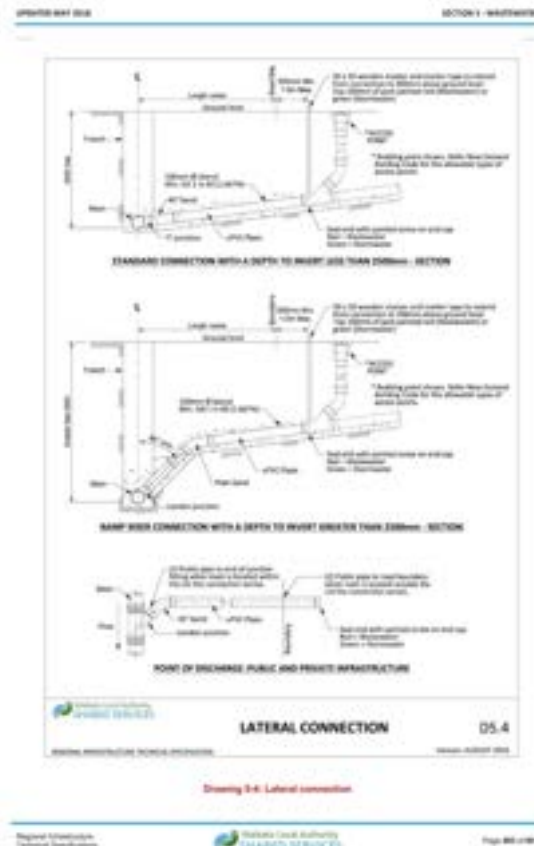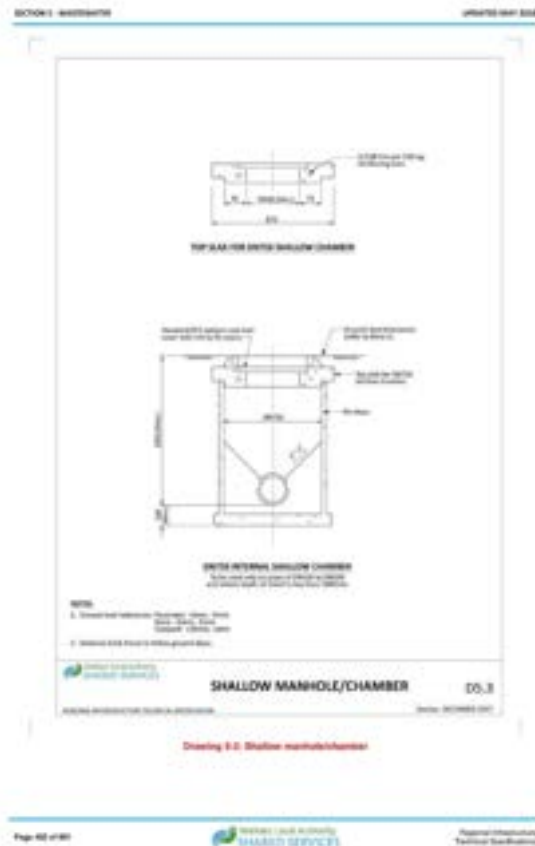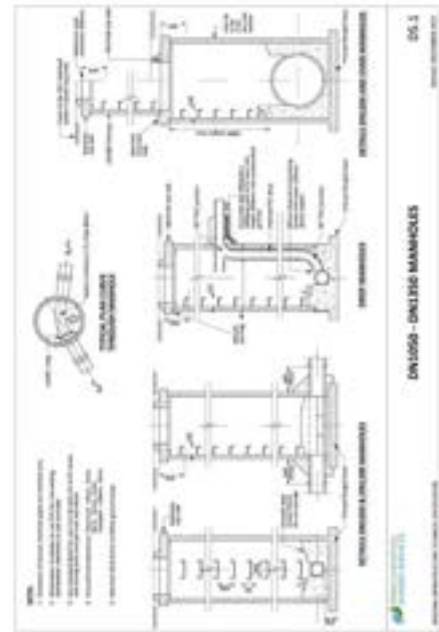

Hamilton City Council
Development Engineering Unit
ACCEPTED ENGINEERING PLANS
Assessed for Related Resource Consent Conditions Only
Library Reference: 011.2019.00007140.025
Address: Greenhill Stage 24
Date: 7/05/2025
Subject to all notes and conditions affixed

Refer to RFI tracker
for further design
and construction
amendments

Rev	DESCRIPTION	DRN	CKD	APP	DATE
0	PRELIMINARY	NW			14/8/24
1	ISSUED FOR EPA	NW	HB	PH	16/8/24

NAME	DATE	NAME	DATE
SURVEYED		DESIGNED	
COORDINATE SYSTEM: NZGD 2000 - MT EDEN			
ORIGIN OF COORDINATES: BPV DPS 17824			
HEIGHT DATUM: MOTURIKI DATUM 1953			
ORIGIN OF HEIGHT: SS507 SO 42451			

TITLE
**STANDARD DETAILS
WASTEWATER**



PREPARED FOR	
AREAS L, U & K	
ORIGINAL SCALES @ A3	STATUS
NOT TO SCALE	FOR TENDER
DO NOT SCALE DIMENSIONS	
DRAWING NO	REVISION
30410-01-S24-WW5	1

COPYRIGHT ON THIS DRAWING IS RESERVED

Number	RFI	Recommended Resolution	S&L Comment	Comment	HCC COMMENTS 11/04/2025	S&L Comment.	HCC Comments 24/04/2025	S&L comments	HCC Comments 05/05/2025	HCC Comments 07/05/20252	S&L comments 06/05/2025
Table 1 – General observation/recommendation	The overall level of detail in the documentation isn't considered to be of sufficient detail to support an EPA design.										
T1.1	Detailed calculations supporting the design are incomplete. Overall, there seems to be significant reliance on conceptual work undertaken by Beca to support the CDP. It is expected that all design calculations would need to be revised to support an EPA design.	Resolution of specific items are included in the tables below. However, it considered that the application should be supported by a more comprehensive stormwater design document – ideally a Water Impact Assessment (WIA) prepared for this stage of development.	The Beca reports utilised for this design: - Beca Infrastructure report 2016 - Beca WIA 2016 - Beca SW Design report, 2016 With reference to the WIA, the existing document creates the design philosophy of the development and extends its forecast out to 2028. As with any WIA it is an assessment of the capability for the local infrastructure to accommodate the development, this is still the case. The detailed design supersedes and improves upon the WIA.	Complete.	An overarching stormwater report or WIA is still required. The Beca report was prepared to support resource consent applications and does not provide appropriate detail for Detailed engineering design. The design for Area U (Stage 24) and surrounding stages have also been altered significantly from the Beca report requiring further assessment and analysis to ensure the stormwater management system meets the objectives of the Beca report and do not have adverse effects on the constructed stormwater system or downstream receiving environment. The report can however be prepared following the EPA approval process. HCC can provide further guidance on this item as required.	As agreed this will be actioned at a later stage	Noted				Closed
T1.2	No O&M plan appears to have been submitted with the EPA package – typically this would be expected.	Please update existing O&M plan to be submitted for review by HCC.	Will be provided. Complete.	Complete. Plan provided.	O&M Manual is very generic. HCC to liaise with M&S Safety during construction confirm requirements for specific O&M plan that meets city waters requirements	We await the requirements during construction that meet city waters requirements.	Noted				Closed for EPA We await the requirements during construction that meet city waters requirements.
T1.3	There is very limited detail on how geotechnical & hydrogeological potential issues have been identified incorporated into the design (if necessary). Generally would expect groundwater levels, slope stability, peat management etc to be addressed.	HCC to identify whether sufficient detail has been provided under other applications otherwise supporting geotechnical/hydrogeological design information to be supplied.	HCC to assess.	HCC to confirm.	S&L to provide supporting geotechnical information for Stage 24. Of particular interest is 1. Groundwater levels relative to design levels. 2. Nature of Engineered fill and effect on the on-lot retention measures. 3. Assessment of the slope stability of the various batters around the perimeter of Stage 24.	All fill has been certified by Core50	Not accepted. Please provide additional response specific to HCC query.	A detailed response, including detail from Core 50 is imminent.	Noted		Closed for EPA. A detailed response, including detail from Core 50 will be provided during construction.
Table 2 – Stages 24 – Area LUR- Stormwater Calculations Check											
T2.1	There doesn't appear to a catchment plan corresponding to the supplied calculation sheet.	SW catchment plan to be included to support calculations.	A catchment drawing will be created.	Complete. Refer drawing SWC1 & SWC2.	Closed						Closed by HCC on 11/04/2025
T2.2	It is not clear what climate scenario is being used for design rainfall inputs. It is noted that the WQ calculation sheet indicates RCP6.0 intensities for the 2031-51 planning horizon have been adopted.	All stormwater calculations should be updated to be based on RCP6.5 climate change scenario (2100 – 2120 planning horizon)	Design completed mid 2024, reference to NIWA. RCP6.0 used. It is noted that the in-depth SW modeling that has been undertaken could be assessed as a sensitivity analysis.	Complete. Updated to RCP 6.0 2100	Closed						Closed by HCC on 11/04/2025
T2.3	Calculations should cover all conveyance elements of the design – pipes, swales, oilpjs etc.	Update calculations to include all conveyance elements of the design.	Refer TS.18 - Review done with majority of calculations provided, any further updates required will be provided.	Complete. Updated calculation provided.							Closed, covered by actions below.
T2.4	Calculations don't include hydraulic grade line information.	Update SW calculations to include hydraulic grad line calculations & associated plots for each pipeline.	In progress, will be added to drawings.	Complete. HGL information provided on drawings.	The new western SW line appears to be significantly undersized (i.e. Q >288% of Qcap). We acknowledge that the higher level 300mm line provides overflow to the north however the combined system should still be designed to convey the 10yr event (without significant surcharge). Please review pipe calculation and update long sections with HGL information.	SW design updated to 300mm dia with 10 year capacity	Refer email item 5. Detailed calculations are required.	Further calculations issued to HCC	Accepted		Closed by HCC on 05/05/2025
T2.5	There doesn't appear to be consideration of potential impacts of tailwater in the stormwater calculations – all pipe runs in Stage 24 discharge to Swale 6 which has a peak level of 37.84 mRL in the 10y ARI event.	Update calculations to include consideration of correct tailwater levels.	Flood modelling has considered the worst case scenarios for flooding within the development. Worst case, no surcharge will impact any lot.	Tailwater depths have been included in design.							Closed, covered by actions below.
T2.6	No evidence of assessment of flow/ponding depths in roading corridors to demonstrate compliance with RITS.	Update SW calculations to demonstrate consistency with RITS requirements for secondary flow depths in roadways.	Drawing was created and provided to HCC separately, will be included in EPA submission.	Complete. Refer drawing SW8 & SWBA.	SW8 and SWBA show flooding extents in the culvert block event with flood levels at RL39.0m. This information is useful however does not demonstrate consistency with RITS requirements for secondary flow depths in roadways as per original RFI item. Secondary flow on roads shall be in accordance with Section 3 : Transportation (Clause 3.3.14.10). The design must not result in ponding greater than 150mm deep and a velocity greater than 1m/s. Further assessment is required to demonstrate the ponding and flow depths within the road corridor for a local 50 or 100 year storm event. Plans are required to show areas in the road where flood depths exceed the 150mm limit. Of particular interest is the sag point in Road 3 fronting Lots 802-807.	Drawing SW8 has been updated to show flood depths in the road between 0.15 and 0.2m based on a flood level of RL39.0m. We request a relaxation as 0.2m flood depths should not restrict vehicular movement.	Refer email item 7. Additional assessment required	Further detailing of flood depths and calculations provided, we are asking for a relaxation. There will be no car parking in this vicinity, this ponding situation only occurs during a 100 year event and with all catch pits are 100% blocked. See drawing SW 3A for ponding depths.	Refer email for additional queries. HCC are not convinced the design has been optimised to keep the ponding depth to a minimum.		Closed. Latest design submitted has been agreed. Deepest flooding is 0.2m at the kerb, for a localised position with a the greatest width of 0.9m. This has been accepted during a discussion with HCC.
T2.7					To help with steep batter grades, is there opportunity to lift the Lot 900 OLPF to tie in with the Radiata Street cul-de-sac levels. The roading plans also show a footpath link to the Webb Drive Footpath - how is this to be formed through the OLPF channel?	Swale has been lifted 400mm to RL 38.70 and slope batters maximum of 1:5.	Accepted				Closed by HCC on 24/04/2025
Table 3 – Stage 24 - Stormwater Treatment Design(2.0)-1.0-SW treatm											
T3.1	The supplied calculations only appear to cover a small section of the Stage 24 area – Lots 799 to 805. No calculations are supplied for areas draining to Swale 6C.	Update WQ calculations to include calculations for Swale 6C.	Review completed, assessment done previously. Will provide calculations. These have been based on average retention times.	Calculations revised.							Closed, covered by actions below.
T3.2	Supplied WQ calculations don't take into account flow contributions from the western swale – this will influence flow depths for WQ storm calculations.	Update WQ calculations for the shallow swale to account for flows from western swale. Note: Current configuration of western swale is generally not supported.	Flow from the western swale is only to allow for previous, existing developments that were permitted to discharge overland flow onto CPL property. The catchment of this swale is negligible and from grassed areas only	Complete.	RFI item no longer relevant. Southern reserve 'swale' is to be removed and replaced with a grassed overland flow path.						Closed by HCC on 11/04/2025
T3.3	Design rainfalls quoted in calculations sheets indicate RCP6.0 intensities for the 2031-51 planning horizon have been adopted.	All stormwater calculations should be updated to be based on the RCP6.5 climate change scenario (2100 – 2120 planning horizon). Refer to RITS version 2b available through the Colab website for additional guidance.	524 design started early 2024, submitted August 2024. RITS 2b not yet adopted. Suggest utilising the RCP6.0 criteria and use the flood modelling as a sensitivity analysis.	Complete. Updated to RCP 6.0 2100	Noted.						Closed by HCC on 11/04/2025
T3.4	Maximum batter slopes indicated on conceptual cross section in WQ calculation sheets are 1:2. This exceeds RITS specifications.	Update swale design of shallow swale to be consistent with RITS requirements for side slopes – i.e. 1:3 for planted and 1:5 for mowed batters.	Drawing to be updated. Side slopes extended to 1:3.5 - this is the best option considering the adjacent pipelines and flow requirements.	Complete. Batters remain at 1:3 with planting.	Further design required to confirm treatment of batter slopes. Preference is for OLPF's to be grassed with maximum batter slopes of 1V:5H. The design of Swales also needs to ensure access is provided for safe and practical maintenance - this is particularly relevant for the Lot 322 swale. Refer further comments below on channel cross sections.	Grassed swales will have maximum batter slopes of 1V:5H.	Accepted				Closed by HCC on 24/04/2025
					LANDSCAPING - Updated planting plans are required based on the revised design	Landscape plans immanent.	Noted. Landscaping plans to be provided	Landscaping design will follow, and will be in keeping of the previous Green Hill Park designs.	Noted.		Closed for EPA. Landscaping that will we submitted will be reviewed to ensure no clashes with civil work.
T3.5	Longitudinal slope is given as 0.25% - which would require suitable underdrainage as per RITS.	Update design to include suitably designed under-drainage or provide additional supporting information as to how flat grades are being appropriately managed.	Drawing to be updated.	HCC would like to see this swale planted with a pipeline along the northern edge to collect the adjacent Lots. This pipeline is to flow west and discharge at the western end of the swale. New Action: Swale to be planted with an additional SW line to intercept property connections. Complete. Flow now to Road 3 reticulation.	Underdrainage has been proposed for the southern OLPF, and the northern OLPF above the 825mm pipe. Area L south swale needs underdrainage to ensure this area does not become a bog in the winter.	Swale has been constructed as agreed on site with S&L engineers and HCC.	Further discussion required. It is essential that the Area L south swale is able to be maintained/mown throughout the winter.	Batter slopes have been revised and access is available.	Recommend this swale/OLPF is provided with underdrainage.		Closed for EPA, providing the following comment is adhered too. The southern shallow swale and radiata as agreed and indicated on the drawing with include underdrainage, also the western swale will also have underdrainage installed.
Table 4 – OLPF Report once flood model response has been provided it will be expected that the report will need updating to reflect											
T4.1	The report title refer to overland flow management, but actually covers multiple aspects of stormwater management.	It is recommended that this report is expanded to cover all reporting requirements of a WIA.	Refer T4.1 - Design work to the WIA provided by Beca. This document should be read in conjunction.	Complete. Existing WIA is suitable.	To be address as part of future reporting. HCC to confirm requirements	Noted.					Closed for EPA. To be address as part of future reporting. HCC to confirm requirements.
T4.2	The "Stormwater Overland Flow Management report" provides a number of alternative OLPF's to convey flood flows in the event the Webb Drive culvert became blocked, or capacity exceeded. The recommendations of the report have not however been incorporated into the engineering plans. Missing details include: - Point 2 – details of the OLPF running from the north end of the development to the eastern end of Swale 2 - Point 4 – details of the OLPF extending across Lot 900 - Levels of the northern reserve area to facilitate recommended attenuation.	Update the overall design to be consistent with measures outlined in the OLPF report.	The "Stormwater Overland Flow Management report" was penned in response to the flooding requirements, this can be read in conjunction - drawings will be updated. Drawing will be provided. Drawing will be provided. - As previously discussed, levels of the northern reserve can be managed to suit as per HCC's desired outcome for the land use.	Complete. Please see EPA report section 5.7. As previously discussed, levels of the northern reserve can be managed to suit as per HCC's desired outcome for the land use.	Updated designs include details of the OLPF's recommended in the S&L report. Recommend S&L report is updated to reflect amended EPA design. Further comment on the detailed design of the OLPF and conveyance channels is provided below.	Reports to be provided shortly after EPA submission.	Noted				Closed for EPA. Reports were provided on 29/04/2025
T4.3	The OLPF report identifies multiple on-lot measures that could be applied – it would be expected that	Update reporting to identify preferred on-lot measures & identify what post-construction testing will be undertaken to confirm suitability.		Complete. Please refer to Appendix D of the WIA.							Closed for EPA. We will comply with Appendix D of the WIA. Consent notice 54 from RCD 11-2019 7140.016 will be registered at the time of 223/224 against all relevant lots. This consent notice confirms that any site shall include stormwater management measures identified in the WIA report.
Table 5 - 24-30410-24 - EPA - GHP Stage 24 - Stormwater Design - 18.02.202											
T5.1	Design contour plan should be included – currently very difficult to understand if the SW network is designed correctly – for example, the stormwater line K. It is difficult to determine whether pits on this line are located in a sag or not.	Provide a design contour plan in the drawing set which can clearly be interpreted.	All catchpits correctly positioned. Drawing to be provided.	Complete. Refer drawing SW1.	There appear to be a number of errors in the design contours (i.e. stockpile across Lots 781-784? Irregular contours across Lots 806-815, and 777-779). Can key roading lines also be added to the SW plans (kerb and channel lines, footpaths etc) to provide context. As per RITS, confirm manholes are typically located 2m out from the k&c	Key roading lines added including re-aligned pedestrian crossing in OLPF in lot 900. We have created dwg S2 wich includes 3 waters and roading.	Noted. Additional comments in email.	This footpath has been moved and is accessibility compliant.	Accepted. Post construction review will be undertaken to confirm footpath link provides a sensible connection to Webb Drive. May require a second more direct link with stairs.		Closed for EPA. Post construction review will be undertaken to confirm footpath link provides a sensible connection to Webb Drive. To be constructed to accessibility standards, a second more direct link with stairs may be required.
T5.2	Lot numbers and road names differ between the roading and SW plan sets.	Update plans to be consistent.	Drawings to be updated.	Complete.	Awaiting updated roading plans?	Roading Plans included in latest submission	HCC review still pending				Closed for EPA No further comments from HCC after their comments on 24/04/2025.

	Overall layout plan should show all SW/drainage works being proposed – currently does not anything to the north of Radiata St extension.	Update layout plan to show all works being proposed, provide multiple layout plans.	Drawing to be updated.	Complete. Refer drawings SW1 & SW1A.	Accepted - refer further RFI below on Radiata Street drainage.					Closed by HCC on 24/04/2025.
TS.3										
TS.4	The SW layout plan (SW24-SW1) indicates a significant number of kerb connections. Private connections to Swale 6C that run across the reading corridor are also a concern.	The overall design of the SW reticulation network needs to be reviewed/reconsidered. It is likely some kind of detailed workshop with HCC would be useful to clarify expectations.	Substantial discussions have been held with HCC already since August last year including the previous RFI requests. This request is very general and, we believe is covered by other requests from this RFI and previous RFIs.	HCC would now like to reduce the number of kerb connections to a minimum and doesn't want a catchpit-to-catchpit connection. To achieve this HCC is happy to accept pipe gradients at less than RITS, 0.25% was discussed. This exception can be applied to a pipe length to achieve a reduction in kerb connections. New action: Design to incorporate gradients less than RITS requirement. This section of Rd3 is to have a connector line to pick up property discharges, with proposed discharge at SWOUT16. New Action: New SW line to intercept property connections Complete. Refer drawings SW1 & SW1A.	Kerb Connections removed which is supported. We understand further design work is underway by S&L to optimise the drainage layouts.	Please see the updated drainage layout on drawing 30410-01-S24-SW1	Refer email for additional comments on revised drainage layout.	Email comments responded to, in accordance with HCC requirements.	Noted. Refer additional comments in email	Closed for EPA. Radiata footpath shown on roading set and will be constructed. Post construction review will be undertaken to confirm footpath link provides a sensible connection to Webb Drive. To be constructed to accessibility standards, a second more direct link with stairs may be required.
TS.5	There are multiple outlets to each treatment swale, including at locations very close to swale outlets. Locations should be rationalised & located such that maximum retention times are achieved.		Refer T3.1 - The site is very flat so SW is limited option regarding outlet location. While others may be available we believe the provided design is applicable.	Complete. Refer drawings SW1 & SW1A.	Latest design represents an improved layout. Line JB-16 is however grading up.	Line JB-16 has been corrected	Accepted			Closed by HCC on 24/04/2025.
TS.6	It is not clear whether catch-pit spacing adheres to RITS requirements. – distance between catch-pits on Jacques Tce appears high. 100 m ish vs 90m rits max		Refer TS.1 - Catchpit locations are suitable.	Complete. Refer drawings SW1 & SW1A.	Accepted					Closed by HCC on 11/04/2025.
TS.7	OLFP arrows indicate a road sag near the boundary of Lots 787 & 788, there are no catchpits in this location.		Arrow slightly incorrect. Drawing will be corrected.	Complete. Refer drawings SW1 & SW1A.	Accepted					Closed by HCC on 11/04/2025.
TS.8	Not clear why there is a different approach to SW network layout for the two ROWs – one has a central SW line with lateral connections, the other doesn't		Design is to manage SW capacity constraints.	Complete. Refer drawings SW1 & SW1A.	Accepted					Closed by HCC on 11/04/2025.
TS.9	The SW layout plan indicates that western part of Raleigh Ave is not captured by the reticulation network & discharged to Swale 6C – i.e. is not treated.		Correct. Due to the need to increase the elevation of the lot levels, the road needed to increase in grade. This means a small area of Raleigh Street (extension) will fall to the west.	Complete.	Refer further comments below					Closed for EPA. Covered by actions below.
TS.10	In some locations there are catch-pits connected to catch-pits, rather than laterally connected to a manhole. Location of Jacques southern catchpits in vehicle crossing.		Correct. This has been previously discussed and agreed with HCC in the previous RFI processes. SW design is constrained by the achievable fall.	Complete. Refer drawings SW1 & SW1A.	Accepted			Noted, and responded to below:		Closed by HCC on 11/04/2025.
TS.11	K/C connections can only service a single lot for clearing purposes, inconsistency of lots being K/C vs mains ie lot 783 vs 782		All lots have been connected to a reticulation system where possible. All kerb connections will be made single connections.	Complete. Refer drawings SW1 & SW1A. Kerb connections removed due to lesser gradient.	Accepted					Closed by HCC on 11/04/2025.
TS.12	Doesn't appear to be any sections through Swale 6C presented – would expect both typical detail sections and detailed sections.	Add relevant details to drawing set.	Drawing will be provided.	Complete. Refer drawings SW1 & SW1A.	The WQ calculations show a base width of 3.1m, however cross section BB shows a reduced width. Calculations need to be updated to reflect the actual base width.	Drawing SWB8 has been amended.	Accepted.			Closed by HCC on 24/04/2025.
TS.13	The drawings shows a swale (v-drain) running along the western boundary of the development (swale - west). - Supplied sections indicate up to 1:1 batter slopes which are up to 2m high. - Longitudinal slope of the drain is 0.6% & 0.3%. - No easement is indicated - The long-section shows the southern end of the swale has an invert at RL37.16m. This appears to be approx. 800mm lower than the 'shallow swale' extending along the southern boundary.	The western swale needs to be redesigned to be consistent with RITS requirements.	The purpose of the western swale is solely to capture stormwater runoff from adjacent land that discharges onto CPL property. The swale has no other catchment and is therefore a very low flow swale. This is the same scenario utilised (and accepted) on the southern boundary of Stage 17, which has been successful. Easements provided - please refer to 23-30410-S24-C1. Long section will be adjusted to indicate tie in to swale. To achieve the drainage of the adjacent properties and the flood levels for Stage 24, the swale will need a minor deviation from RITS.	HCC would like more of an 'urban design' review for this section. As part of #6 above, design a SW line along the western boundary flowing to the south with scuffly dome inlets along its length. Review if the swale needs to be planted and possibly have a 'sawtooth' flow. Assess the flood depth from swale 6C and ensure it cannot flow back up into the existing properties. New Action: New western SW line. Complete. Refer drawings SW1 & SW1A.	Please provide a long section of the updated western swale, and also cross sections at regular intervals. A long section of the 375mm pipe along the western boundary is also required. 11/04/2025 Following meeting today, it is expected there will be some amendments to the pipe and drain design. The hydraulic capacity of the western OLFP needs to be checked based on the contributing catchments, and conveyance of the 100 year ARI flows. Also, HCC would prefer a concrete base, say 1m wide, to the western OLFP within private lots to ensure weeds and long grass dont restrict capacity. This will also help to delineate the flow path and enable landowners to maintain the channel easily.	Long Section and sections provided.	Refer email for additional comments on revised drainage layout.	Long section, cross sections and calculations have been provided. The swale is within the lots, and due to site constraints we are proposing a steeper gradient with no vegetation to maintain. Our methodology to achieve this is to shape the swale, cover with PVC then Coconut matting, please see the drawings R18, R19, R20 SWB8.	Requires further design and assessment. Refer comments in email.	Closed by HCC on 05/05/2025. Also see row TS.27 responses to HCC comments 05/05/2025.
TS.14	No details are provided of erosion protection at pipe outlets. Where erosion protection is shown on plans it is shown with straight edges or angled inwards – rather than flared outwards as appropriate.	Include erosion protection details and supporting calculations.	Pipe outlets are small and rip scour protection will be added to notes and can be discussed on site.	Complete. Drawings update to show scour protection.	Dimensions of rip rap pads should be added to the plans and reflect the calculations provided. There also appears to be errors in the calculations provided - length of the riprap pads are not correct with most pads needing to be longer. The riprap pad at SWOUT K2OF has not been designed or shown on the drawings.	Calculations have been corrected and dimensions and extent of riprap added to plans.	Noted. Review of riprap calculations pending			Closed by HCC. Review completed by HCC and informed it has been accepted.
TS.15	No outlet is shown at SWOUT K2 – based on the depth indicated on plan S24-SW3 it looks like this pipeline could be below ground level.	Design of outlet to be updated to interface at ground level with design surface.	SWOUT K2 is designed as a bubble up system. This emulates the existing condition, providing better management.	HCC would like to review if this outlet can be redirected via reticulation to the south and connect into the 1050 line to the south as a primary flow. This discharge was previously undesired. It was thought useful that the bubble up connection remain as a secondary flow. New Action: New western SW line. Complete. Refer drawings SW1 & SW1A. Due to a level decrease, this can now be a headwall outlet with a subsoil drain fall back to a MH.	Refer queries above regarding capacity of the 300mm line and requirement for rip rap pad details.	This outlet has now been redirected via reticulation to the south. Riprap pad details have been updated.	Refer email for additional comments on revised drainage layout.	Email comments responded to.	Noted	Closed by HCC on 05/05/2025.
TS.16	Drawing S24-SW6 shows a bund on Lot 767 (chainage +020) – no top width or side slopes indicated. It is unclear to what extent this would affect this lot.	Update design of this drain/swale section to not require bunding.	There is no bund, this is a berm into the swale.	Complete	Noted, however swale slopes of 1:2 are not appropriate.	See section D-O on drawing SWB8.	Accepted			Closed by HCC on 24/04/2025.
TS.17	OLFP above 825mm pipe shown on drawing S24-SW6 shows batter slopes of 1:3, which is steeper than RITS allows for grassed swales.	Update swale design to be consistent with RITS.	To accommodate the OLFP we have kept the invert of the swale as wide as possible. The swale is shallow, so 1:3 should be maintainable.	Complete. Leave at 3:1 due to shallow swale.	Recommend post construction inspection required to confirm ability to maintain the swale with ride on mower. Remedials may be required.	Noted				Closed for EPA. We will undertake a post construction inspection required to confirm ability to maintain the swale with ride on mower. Remedials may be required.
TS.18	The overall philosophy of the 825mm pipe is not clear – i.e. what is the rationale of this being piped versus just open channel? If the 825mm is designed as a 100 yr culvert? should the flow from radiata be completely piped without the section of open channel. Why is the 825mm sized thus, could a smaller line be put in for the section connected to Radiata, does 322 need to be a "swale"?	Update design reporting to better outline and justify overall design philosophy.	The depth of the pipeline meant a channel was prohibitive and designed to be capable of coping with future flood volumes. The first section is an open swale to reduce flooding risk to adjacent properties and allow clearance of high voltage cables. Calculations will be provided, although the pipeline has been accepted and constructed.	Complete. The 825 line is design to convey high flows from the Stage 24 area through to Swale 4.	Further justification required to resolve RFI item. What catchment and flows has the 825mm line been designed for? Provide hydrology and hydraulic calculations.	825 pipeline to extend to lot 322 and end with a bubble adjacent to lot 322.	Further information required to resolve RFI item. Please provide hydrology and hydraulic calculations for the 825mm pipe including catchment plan.	Calculations and drawings SWS and SW6 revised.	Information provided does not appear to have the design calculations of the 825mm (and extended 450mm) lines. Please provide specific calculations	Closed for EPA. Calculation issued on 08/05/2025, this swale shows a depth of 210mm, this is achievable on site and complying with our current submission.
TS.19	Stormwater Swale Cross Sections - DWG 30410-01-S24-SWB8 - Rev 0	Cross Section A-A - There appears to be a bund that would block overland flows being conveyed from the south. Also, please confirm the invert of the OLFP is below the level of the southern residential properties				Section A-A updated to demonstrate swale is below boundary level and no interrupting of overland flow path.	Accepted			Closed by HCC on 24/04/2025.
TS.20		Cross Section C-C - What is driving the invert level of the OLFP? - can this be lifted to flatten the batter down from Webb Drive to <1.5 so it can be grassed.				Drawing SWB8 has been amended.	Accepted			Closed by HCC on 24/04/2025.
TS.21		Cross Section D-D - The cross section shows the right side batter at 1:1.8 slope. The RITS recommends a maximum slope for a planted batter of 1:3. Also, what is the minimum depth of the swale cross section to convey the design flows?				Drawing SWB8 has been amended. The minimum depth of the swale 0.210m.	Noted. It is however important that the lot 322 OLFP is sufficiently deep to avoid flows spilling to the adjacent residential property to the east. Please provide calculations to confirm 100 year flows and associated flow depths within the OLFP.	Calculations provided, and detail on drawing SWB8.	Please confirm where calculations can be found?	Closed for EPA. Calculation issued on 08/05/2025, this swale shows a depth of 210mm, this is achievable on site and complying with our current submission.
TS.22		Cross Section E-E - Notes show swale slopes up to 1:3.3. Can these batters be flattened to max 1:5 so they can be grassed. If not, prepare a plan showing areas that are steeper than 1:5.				Drawing SWB8 updated to show maximum gradient of 1:5	Accepted			Closed by HCC on 24/04/2025.
TS.23		Cross Section F-F - Require a long section of Swale West and cross sections at regular intervals to understand how this swale works and interfaces with the lots and neighbouring residential land				Cross sections of West swale are on drawings R19 & R20. Long section is on R18 and can also be viewed on SW11.	There are a number of cross sections that show steep side slopes to the channel. Particularly at the southern end CH0-90. This profile will be challenging to maintain and requires further consideration. Can the channel be widened to enable side slopes to be flattened to 1:3 max? Cross section F-F does not represent the actual design profile.	The swale is within the lots, and due to site constraints we are proposing a steeper gradient with no vegetation to maintain. Our methodology to achieve this is to shape the swale, cover with PVC then Coconut matting, please see the drawings R18, R19, R20 and SWB8.	Refer additional comments in email	Closed for EPA. PVC capping and coconut matting was rejected by HCC, however a 1:2 grassed slopes with a flat base was accepted via email on 6th May 2025.
TS.24	WQ Treatment for Western ends of Radiata and Raleigh Street Extensions	The revised design with the 375mm western pipeline results in a significant area of the Stage 24 development not receiving any treatment or peak flow attenuation. This includes Lots 767, 768, 777 and 776.				Lots are now treated through swale 6C via SW line H.	Refer email for additional comments on revised drainage layout.	Email comments responded to. Calculations provided and detail shown on drawing SW2.	Refer additional comments in email	Closed for EPA. Email on 6th May accepting compliance.
TS.25		11/04/2025 - Further to discussions at meeting this morning, consideration needs to be given to conveyance of primary flows into Swale 6C. This will ensure the Beca Stormwater design is implemented and flows are not directed north to the GHP swale system. This will require reconfiguration of the drainage system on the Radiata Street extension.				Stormwater line H discharges in to swale 6c. 300mm western line throttled to encourage flows into H line.	Refer email for additional comments on revised drainage layout.	Email comments responded to. Calculations provided and detail shown on drawing SW1 and SW2.	Refer additional comments in email	Closed for EPA. Email on 6th May accepting compliance.
TS.26		If the primary drainage discharge is removed from Lot 322, this channel can be lifted and formed as a grassed OLFP. We would also recommend that the 825mm pipe is extended to the south and the drain filled through the reserve area. Overland flows could then enter the 825mm pipe via a scuffly dome inlet.				825 pipeline to extend to lot 322 and end with a bubble adjacent to lot 322.	Refer email for additional comments on revised drainage layout.	Email comments responded to. Detail provided and shown on drawings SWS and SW6.	Refer additional comments in email	Closed for EPA. With submission of the required update on 7th May, and also refer to comments under TS.29.

TS 27							Western Boundary Swale Drawing R18 shows the swale west long section. The swale has been designed longitudinally flat from CH10-CH90. This channel needs to have positive fall to avoid significant surface ponding. We acknowledge this was not picked up previously. We also recommend that the full length of the western swale is constructed with underdrainage (required under RITS Table 4-28). Closed for EPA. With construction of the swale base for chainages 10 to 90 of 0.3% falling southwards. Construction for the full length of the western swale to also include underdrainage.
TS 28							Footpath linking Radista to Webb has been removed from Drawing SW1? Closed for EPA. Radista footpath shown on roading set and will be constructed. Post construction review will be undertaken to confirm footpath link provides a sensible connection to Webb Drive. To be constructed to accessibility standards, a second more direct link with stairs may be required.
TS 29							825mm SW line Does the section of 825mm pipe between SWMH U0-U1 need to be steepened to 1.0%. Recommend this pipe is extended from SWMHU1 at 0.4% to increase the cover at the upstream end. As per comments provided yesterday, this would assist to lower the overflow level for SWMH U0 to maximise secondary overland flows into the 825mm pipe and keep flood levels to a minimum. Can the scruffy dome and incoming channel ben lowered to RL38.30m say Closed for EPA. Section U1 to U3 has been approved by HCC and constructed. The top of the 825mm pipe level is constrained by the existing HV cables and maintaining clearance of them. We will construct the scruffy intake level to 38.4m.