



S&L
Land Development
and Design Specialists

GREENHILL PARK RESIDENTIAL SUBDIVISION

STAGE 15

INFRASTRUCTURE DEVELOPMENT COMPLETION REPORT

POPHAM ROAD, GREENHILL PARK

CHEDWORTH PROPERTIES LTD

Our reference: 19-30378-01



Prepared for Chedworth Properties Limited



This report has been prepared specifically for Chedworth Properties Ltd and supplied to Hamilton City Council for works clearance for Greenhill Park Subdivision and no responsibility is accepted by S&L Consultants Ltd for the use of any part of this report in other contexts without written approval.

This disclaimer shall apply notwithstanding that the report may be made available to other persons for an application for permission or approval to fulfil a legal requirement.

REVISION	Issued for Application	DATE	14 April 2021
-----------------	------------------------	-------------	---------------

Quality Assurance Statement		
Task	Responsibility	Signature/Approval
Written by:	Barry Pearson Engineer	
Reviewed by:	Nic Fu Client Principal	

Our Ref: 19-30378-01

Prepared by: S&L

36 Kereiti Street - Mount Maunganui - Tauranga 3116

Telephone: 07 577 6069 - Fax: 07 577 6065 - E-mail info@sltga.co.nz

The information contained in this document is intended solely for the use of the client identified on the report cover for the purpose for which it has been prepared and no representation is made or is to be implied as being made to any third party. Other than for the exclusive use of our client, no part of this report may be reproduced, stored in a retrieval; system or transmitted in any form or by any means, electronic, mechanical, photocopying or otherwise without the prior written permission of S&L.

© S&L

Table of Contents

1.0	BACKGROUND	1
1.1	Introduction.....	1
1.2	Entities Involved with Development	1
1.3	Observation of Works.....	2
1.4	As-Built Data.....	2
1.5	CCTV.....	2
1.6	Design and Hamilton City Council Development Unit Design Acceptance	2
1.7	Amendments to approved plans.....	3
2.0	EARTHWORKS	3
3.0	ROADING INFRASTRUCTURE	3
3.1	Road Construction.....	3
3.2	Subgrade.....	3
3.3	Subbase	4
3.4	Basecourse.....	4
3.5	Benkelman Beam Results	5
3.6	Road Surfacing.....	6
4.0	WATER INFRASTRUCTURE	6
4.1	Installation.....	6
4.2	Testing and Disinfection	7
5.0	WASTEWATER INFRASTRUCTURE	7
6.0	STORMWATER INFRASTRUCTURE	7
6.1	Installation.....	7
6.2	Secondary flow paths	8
7.0	STREET LIGHTING, STREET MARKING AND SIGNAGE	8
8.0	LANDSCAPING	9
8.1	Hard Landscaping.....	9
8.2	Soft Landscaping.....	9
9.0	NETWORK UTILITIES	9
9.1	Power.....	9
9.2	Gas	9
9.3	Telecommunications.....	9
10.0	FINAL INSPECTION	9

Appendices

Appendix 1	DBCon Report on Subdivision Earthworks & Recommendations for Building Development
Appendix 2	Road Construction Inspection and Quality Assurance Records
2(a)	Subgrade
2(b)	Basecourse
2(c)	RAMM data
Appendix 3	Water Construction and Quality Assurance Records
Appendix 4	Waste Water Construction and Quality Assurance Records
Appendix 5	Stormwater Construction and Quality Assurance Records
Appendix 6	Landscaping Certifications
Appendix 7	Network Utilities Certifications
Appendix 8	Miscellaneous Check Lists and Producer Statements
Appendix 9	As-Built Drawings/Data
Appendix 10	Asset Spreadsheets – PDF copy



1.0 BACKGROUND

1.1 Introduction

This application relates to Greenhill Park Subdivision Stage 15 located alongside Webb Drive, south of Pardoa Boulevard.

Works included the following:

- Stage 15 subdivision roading (including Gosset Avenue and Couldsack Ave)
- Wastewater reticulation and lot connections
- Stormwater reticulation for roading and lot connections
- Watermain and lot connections
- Associated Streetlights
- Electrical reticulation for subdivision lots and street lighting
- Ultrafast Broadband reticulation
- Gas supply for subdivision development
- Concrete footpath construction
- Landscape planting

On the west side of Webb Drive, Stage 15 development works for 27 residential lots have been carried out under Hamilton City Council Subdivision Resource Consent 011.2018.6632, granted 05 September 2018.

This application is made on behalf of Chedworth Properties Ltd for Works Clearance from Hamilton City Council. Works clearance is sought in order to obtain certification pursuant to Section 224(c) of the Resource Management Act 1991 for Greenhill Park subdivision, Stage 15, LT 560839. A copy of the land transfer plan is included in Appendix 8.

This report addresses the key details associated with the Infrastructure provided.

1.2 Entities Involved with Development

The following companies have been involved with the construction of the Subdivision;

- Developer: Chedworth Properties Ltd
- Consultant Design Engineers: Beca Consultants
- Consultant Engineers and Surveyors: S&L
- Geotech Engineer: DBCon Engineers
- Landscape Design: Boffa Miskell
- Landscape Planting: Native Awa
- Head Contractor: Online Contractors 2016 Ltd (OLC)
- Subcontractors & Suppliers:
 - Civil Materials Supply: Hynds
 - Stormwater and Wastewater: West Construction Ltd (WC)
 - Drainage



Geotechnical Testing	Opus/WSP
Concrete Supply	Bowers Bros Concrete
Concrete kerbs	Waikato Construction
Carparks	Purrfect Paving
Footpaths	Purrfect Paving
Concrete Cutting	Ironman Concrete Cutting
Streetlights	Ibex Lighting
Power Reticulation	WEL Networks – (Subcontractors: Northpower and Bayonne)
Road Materials Supplier	Stevenson Resources, Gleeson Quarry – Huntly
Road Surfacing Contractor	Higgins Contractors
Road Signs	Directionz Ltd
Road Line Marking	Linemark
Gas	First Gas
Telecommunication	Ultrafast Fibre – (Subcontractor: Civtec)

1.3 Observation of Works

S&L undertook regular inspections of the works as the project progressed and reviewed the contractor’s quality assurance measures including test results. The progress of the construction was reviewed formally at weekly site meetings as well as discussions on site with the contractor.

The observation and supervision activities by S&L were undertaken to a level of CM3 (weekly site visits) as described in the IPENZ document “Guidelines on the Briefing and Engagement of Consulting Engineering Services” with additional inspections when required by the nature of the works under construction.

1.4 As-Built Data

A full set of as-built drawings and excel spreadsheets have been appended to this document in Appendix 9 and 10. These include the as built and asset value information required in accordance with the RITS. The as built data has also been included in this application in electronic format and a copy enclosed in final works clearance report for reference.

1.5 CCTV

CCTV inspections have been completed for the wastewater and stormwater lines. The footage has been provided to Hamilton City Council separately.

1.6 Design and Hamilton City Council Development Unit Design Acceptance

The following Approvals have been gained from the HCC Development Unit:

- Greenhill Park Stage 15 was designed by Beca Consultants and approved by HCC Development Unit.

1.7 Amendments to approved plans

Amendments from the approved plans have been made during construction as follows:

- Pavement type C Local Access Road/Lane, changed to one 200mm thick layer of GAP40 on 500mm of Blue Brown Rock CBR> 15. Refer to email confirmation included in completion report for Stage 12
- Kerbing changes made removing flush kerbs and footpaths. Refer to email confirmation included in completion report for Stage 12

2.0 EARTHWORKS

Earthworks have been carried out onsite under the supervision of S&L and DBCon Engineers. DBCon Engineers were engaged as the geotechnical engineer. The DBCon report of stage 15 subdivision earthworks and recommendations for building development is included in Appendix 1, detailing earthworks compliance with HCC RITS and NZ Standards.

3.0 ROADING INFRASTRUCTURE

3.1 Road Construction

Roads have been constructed in general accordance with the pavement shown on the approved engineering plans, except where the pavement has been changed as discussed in section 1.7 above.

Review of the road construction is as follows:

3.2 Subgrade

The underlying natural soils comprise sandy silts of varying strengths. Significant subgrade improvement works have been carried out as follows:

- Much of the Stage 15 subgrade consists of imported hardfill for the backfill of the stormwater and sanitary sewer underground lines beneath.
- All areas in the road carriageway that have not been backfilled with hard brown rock have been undercut to a minimum depth of 0.5m below subgrade level and replaced with a subgrade improvement layer of compacted hard blue brown rock.
- Subsoil drains have been laid beneath kerbs discharging into catchpits

Testing of the subgrade improvement layer included proof rolling with no visible weave, stringing by way of GPS survey, and Clegg hammer testing to confirm that a CIV>15 (CBR>15) had been achieved for all roads in Stage 15. Results of the Clegg hammer testing are included in Appendix 2(a).

A GPS survey was undertaken throughout Stage 15 and checked against the design surface. Results are included in Appendix 2(a), confirming that design pavements depths have generally been achieved to ITS tolerances.

All road subgrades have been tested using clegg hammers, showing that CBR values over 15 have been consistently achieved on all roads. The results from the Subgrade Clegg Hammer testing are summarised below:

Subgrade Clegg Hammer Results Summary

Road 22 CH 160 - 260	Range CIV 42 - 49 Mean CIV 49	Min Inferred CBR 123*
Road 37 CH 280 - 340	Range CIV 42 - 58 Mean CIV 49	Min Inferred CBR 123*
Road 38 CH 130 - 200	Range CIV 42 - 56 Mean CIV 50	Min Inferred CBR 123*

*Note: CBR = 0.07(CIV)² formula applied in accordance with RITS

3.3 Subbase

The subbase of roads with pavement type C have been incorporated into the basecourse layer. Construction and testing methods for these roads are covered in the basecourse section below.

3.4 Basecourse

Subdivision roading comprises of the following basecourse types:

Road 22, 37 and 38 (Couldsack Avenue and Gosset Avenue)	200mm GAP40 basecourse – Stevensons Tauhei
---	--

QA Supplied for the basecourse included in Appendix 2(b) includes the following:

- Material testing sheets
- Stringing
- Compaction testing of the basecourse with Nuclear Densometer
- Clegg Hammer tests
- Benkelman Beam testing

Stringing

Stringing of the basecourse was carried out from kerbs prior to sealing. Results are included in Appendix 2(b) confirming that design pavements depths have generally been achieved to ITS tolerances.

Clegg Hammer

Clegg hammer testing has been undertaken on the subdivision roading basecourse showing compliance with RITS.

Nuclear Densometer

Nuclear densometer testing was carried out by Opus in order to confirm density.

Nuclear Densometer testing has been undertaken in accordance with RITS Section 3.8.2.5 & 3.8.3.4, Table 3-22. Results are included in Appendix 2(b).

The Target MDD for the GAP40 pavement is 2.22t/m³ as per Opus MDD report (project number: 2-68015.00, lab reference: HA 6289/2_VHMDD).

Results are summarised below:

Basecourse NDM Results Summary

Road 22 CH 160 - 260	Min 97% of MDD (Target MDD 2.22t/m ³)	Mean 98% of MDD
Road 37 CH 280 - 340	Min 96% of MDD (Target MDD 2.22t/m ³)	Mean 98% of MDD
Road 38 CH 130 - 200	Min 97% of MDD (Target MDD 2.22t/m ³)	Mean 98% of MDD

3.5 Benkelman Beam Results

Benkelman beam tests were carried out by Opus on the basecourse surface following surfacing. Results are summarised below:

Basecourse Benkelman Beam Results Summary

	Deflection (mm)			
	Maximum (mm)	Minimum (mm)	%age over 1.8mm (A2)	Average (mm)
Road 22 CH 160 - 260	1.10	0.60	0	0.89
Road 37 CH 280 - 340	1.14	0.68	0	0.87
Road 38 CH 130 - 200	0.86	0.36	0	0.63

Results conform to the maximum and average deflection requirements of Section 3.8.3.5, Table 3-23 of the RITS for A2 (up to 10⁵ EDA) roads.

3.6 Road Surfacing

A summary of road surfacing details laid by Higgins is listed below:

Road Surfacing Summary

Road	Membrane Seal	Surface
Pavement Type C	Grade 4 single coat water proofing membrane. Residual Application Rate: 1.0L/m ²	30mm DG7

4.0 WATER INFRASTRUCTURE

4.1 Installation

The water supply reticulation completed by Online Contractors includes the following components:

- 150mm mPVC PN12RRJ principal main
- 63mm PE80 PN12.5 ridermain
- Associated fittings, valves and hydrants
- Residential connections to all lots

Quantities and installation locations are shown on as-built records appended to this document.

4.2 Testing and Disinfection

Online Contractors Ltd carried out all aspects of pressure testing of the supply lines and disinfection prior to livening, in accordance with the ITS and in the presence of HCC.

Testing included the following items:

- Water supply pressure test result
- Water Supply disinfection
- Water Supply E Coli test

The pressure test and the observation of FAC (Free Available Chlorine) was witnessed by HCC's testing officer. The E Coli test samples were collected as part of the testing and the samples have been reviewed by HCC Officer, L. Parkes and passed.

Pressure testing results, pipe laying checklists and Bacto Test results are included in Appendix 3.

5.0 WASTEWATER INFRASTRUCTURE

Supporting quality assurance documentation for Wastewater Infrastructure supplied by the contractor and reviewed by S&L is attached in Appendix 4.

The gravity sewerage system comprises installation of the following components:

- 150mm dia uPVC SN16 wastewater main
- 100mm dia uPVC SN16 sewer laterals and lot connections
- Associated manholes.

Testing and inspection includes the following:

- CCTV inspection which has been supplied separately to Council
- Inspection of Manhole Structures
- Pressure testing of Manhole Structures by West Construction observed by HCC
- Pressure testing of 150mm dia wastewater main by West Construction observed by HCC
- As-buiting by West Construction and S&L with final as-builts compiled by S&L.

6.0 STORMWATER INFRASTRUCTURE

6.1 Installation

In accordance with the approved design, stormwater from Stage 15 discharges into the Area M swales for treatment and conveyance:

- Swale 3B is located on the south side of Popham Rd and flows west.

The primary system comprises of:

- UPVC & RCRRJ stormwater mains and headwalls
- UPVC laterals and lot connections
- Road catchpits and leads
- Manholes

Observation of the works was undertaken by S&L and includes:

- CCTV inspection which has been supplied separately to Council
- Inspection of all manhole structures, catch pits, outlets and inlets
- As-builting by Online Contractors and S&L Consultants with final as-builts compiled by S&L.

QA and checklists provided by the contractor and reviewed by S&L are included in Appendix 5.

6.2 Secondary flow paths

In accordance with the approved design, the stormwater from Stage 15 discharges into swale 3B for treatment and conveyance.

A piped drainage network has been designed to collect runoff from the road and lots with standard sumps. The pipes are designed to convey (without significant surcharge) the 50% AEP flows to the network of swales downstream. Each individual lot is provided with a piped connection to the main drainage system in case on-lot soakage is not appropriate.

In events larger than a 50% AEP, secondary stormwater flows for Stage 15 will flow down the road shoulders to a low point at the road 38/39 intersection and flow north across the overland flow path (lot 507), then spill into Swale 3B that runs along the southern side of Popham Road and flows west.

See attached as-built drawings 21879-M-15-R1 and 21879-M-15-SW1 in appendix 9 showing the location and direction of stormwater overland flow.

7.0 STREET LIGHTING, STREET MARKING AND SIGNAGE

Streetlights have been designed, supplied and installed by Ibex Lighting Ltd. All quality assurance documentation for the street lights is included in Appendix 7.

Signage has been installed by OLC subcontractor Directionz Ltd in accordance with approved drawings and RITS requirements.

Carriageway paint marking has been completed by OLC subcontractor Linemark Ltd and is in accordance with approved drawings and RITS requirements.

8.0 LANDSCAPING

8.1 Hard Landscaping

There are no hard landscaping works included in stage 15.

8.2 Soft Landscaping

The landscape planting within the road reserves and the stormwater swales has been completed. An inspection by HCC Parks and Open Spaces has been completed.

9.0 NETWORK UTILITIES

Network utilities have been provided as follows.

9.1 Power

Electrical reticulation has been installed by WEL Networks for both street lighting and residential supply.

A WEL Networks works clearance statement is attached in Appendix 7.

9.2 Gas

First Gas has installed reticulation to enable future connection by individual lot owners. A completion Certificate is included in Appendix 7.

9.3 Telecommunications

Ultrafast Fibre has installed reticulation to individual lots. An acceptance letter is included in Appendix 7.

10.0 FINAL INSPECTION

A final inspection has been undertaken and was attended by Hamilton City Council's Development Engineers and associated staff from S&L and Online Contractors.

A separate inspection by Parks and Open Spaces has also been completed.

APPENDIX 1

Earthworks QA Documentation

- DBCon Engineers Report on Subdivision Earthworks & Recommendations for Building Development





GREENHILL PARK RESIDENTIAL SUBDIVISION

**STAGE 15
Area M, Greenhill Park**

HAMILTON

***REPORT ON SUBDIVISION EARTHWORKS
AND RECOMMENDATIONS FOR BUILDING
DEVELOPMENT***

Our Ref: DB 171738-AREA-M-S15-01

Prepared for: Chedworth Properties Limited

Date: 19th April 2021

Contents

1.0	Subdivision Development Earthworks	1
1.1	Introduction	1
1.2	Earthworks in the Subdivision	1
1.3	Earthworks Standards	2
1.4	Filled Ground	2
1.5	Areas of Cut	3
1.6	Test Results in Filling Placed	3
1.7	Test Results in Areas of Cut and Natural Ground	3
1.8	Land Hazards.....	3
1.8.1	Land Stability	3
1.8.2	Flooding	3
1.8.3	Liquefaction	4
1.8.4	Expansive Soils.....	4
2.0	Disposal of Stormwater	5
3.0	Retaining Walls	6
4.0	Professional Opinion	6
5.0	Applicability	7
	References	8

Appendices

Appendix I	<u>Reference Drawings</u> Subdivision plan 21879-01-M15-EW1 Site Levels Plan
Appendix II	<u>Geotechnical Completion Forms</u> Checklist 2.2 - Statement of Professional Opinion Summary of Geotechnical Data for Individual Lots
Appendix III	<u>Pre-Construction Test Results</u> BECA Area M Liquefaction Assessment Summary Plan
Appendix IV	<u>Post Construction Test Results</u> Tests by DBCE
Appendix V	<u>Stormwater Management</u> On-lot Water Efficiency Measures Lot Levels (Minimum Lot Levels)

1.0 Subdivision Development Earthworks

1.1 Introduction

Stage 15 of Greenhill Park is currently accessed from Pardoia Boulevard. Stage 15 comprises 27 residential lots (numbered 407 to 433). The locations of these lots are shown on attached *Cut/Fill Plan*, drawing 21879-01-M15-EW1 included in Appendix I.

Bulk earthworks have been completed to re- contour the previously agricultural landscape for Stage 15 of the Greenhill Park Residential Subdivision in Hamilton. Works have been carried out in accordance with Hamilton City Council's (HCC) Subdivision Resource Consent: **011.2018.6632.001** dated: 05/09/2018. Prior to commencement of earthworks, geotechnical investigations were carried out by Beca Ltd (Beca) in 2016 [1].

HCC's Infrastructure Technical Specifications (ITS) set out the minimum standards for design and construction of public infrastructure within Hamilton City. Section 2.1.5 of the *Earthworks and Geotechnical Requirements* of the ITS states that the developer shall appoint a geo-professional to carry out functions as described in NZS 4404[5] Section 2.2.4. ITS Section 2.3.3.1 states that a geotechnical completion report shall be submitted as per NZS 4404 Section 2.6 including a statement of professional opinion on the suitability of land for building construction [4]. The developer has appointed DB Consulting Engineers (DBCE) Ltd as the geo-professional.

To satisfy the requirements of HCC's Resource Consent, the ITS and NZS 4404, this report summarizes the observations and testing undertaken during the development of the stage, discusses the suitability of the ground for the support of the proposed residential buildings and contains recommendations for the disposal of stormwater runoff generated on individual sites.

Included in Appendix I of this report is the proposed subdivision plan comprising the original Lot 605 DP 516275 and the proposed new lots 407-433 for Area M Stage 15. The included earthworks plan shows the cut/fill extent of the earthworks undertaken, test positions, and road and lot locations.

1.2 Earthworks in the Subdivision

The earthworks for stage 15 of the subdivision development were undertaken between February 2020 and October 2020.

These earthworks comprised

1. The stripping of surface topsoil to expose underlying natural soils
2. The placement of filling within Lots 407 to Lots 433
3. Backfilling and raising the ground level with new fill to create uniform fill platforms.
4. The reinstatement of the surface topsoil cover and subsequent grassing.

The soils encountered during the formation of the site and road subgrades were a mixture of silts, sands and pumiceous gravels, typical of Hinuera formation deposits in this area of Hamilton. These soils were those that had been identified in pre-construction site investigations by the Beca Report. The published geology indicates that Area M soils comprise Hinuera Formation alluvium at surface with Walton Subgroup overlain by Hamilton Ash in the gently sloping hill to the south of Area M.

The filling work was undertaken using these site soils gained from areas of cut on other stages from within the larger Greenhill Subdivision. Filling was undertaken during summer 2020 when drying back of the soils was possible to close to optimum moisture contents to achieve near maximum compaction densities. The sandy alluvial soils are expected to be free draining and is suitable for re-compaction with little or no moisture conditioning needed.

Upon completion of the earthworks, approximately 200 to 300 mm of topsoil was placed across the sites and the finished surfaces were grassed in accordance with Conditions of the Resource Consent. Areas where an initial grass strike did not take place were re-grassed. While the target topsoil depths after the earthworks were to be around 300 mm, no guarantee is implied or given that the topsoil on any part of any lot is 300 mm or less and it is recommended that future owners or designers or builders check topsoil depths when preparing site development plans and cost schedules.

1.3 Earthworks Standards

The earthworks in filling were undertaken using in situ Silty clay, silts mixtures gained from areas of cut across the larger subdivision and already used for the earlier stages of the development. The standards for the placement of filling, as stated in the earthworks contract documents, were to comply with NZS 4431:1989 "Code of Practice for Earth fill for Residential Development" and the Council ITS. Filling placed to these standards may be considered as good ground in terms of NZS 3604:2011 "Timber Framed Structures."

The compaction of the filling placed was monitored and tested for compaction density using a hand-held shear vane in finer grained silts and Silty CLAY. Adequate strengths would be achieved when an undrained shear strength of 100 kPa or more had been developed in silts and clays. And scala penetrometer in granular soils.

Materials used where the same basic strata as being used for the previous Stages of works, with a high level of consistency based on previous test results.

1.4 Filled Ground

During the placement of filling on the road subgrades and on areas intended for residential development, the contractor, OLC, stripped and removed all topsoil and other surface organic soils. Post construction testing was carried out to confirm the interface between the cut and fill. Filling was placed in discrete layers with compaction applied through sheepfoot drum rollers and smooth drum rollers.

As most of the filling placed comprised the Silty SAND and Sandy SILT identified in the pre subdivision boreholes, testing of the compaction achieved was mostly undertaken with a handheld shear vane and NDM testing (Nuclear Density Meter).

The results indicate that the construction filling standards have been met. Foundations may therefore be detailed to NZS 3604:2011 where a timber framed subfloor containing shallow piles, bearers and joists is contemplated. Concrete floors designed to NZS3604 can be used on most lots where they are not immediately adjacent to a stormwater swale.

1.5 Areas of Cut

Areas developed in cut are shown on 21879-01-M15-EW1 (Appendix I). Only four lots from Lot 426 to 429 is having cut around 0.4m to 1.5m. In these areas, the ground at formation levels was observed to comprise the same silts and sands that had been used for filling elsewhere and as identified by pre subdivision tests.

1.6 Test Results in Filling Placed

A summary of the tests undertaken by DBCE is present in Appendix IV. The test positions are shown on 21879-01-M15-EW1 and the test results are in Appendix IV.

The shear vane and scala penetrometer test results show that acceptable soil strengths had been developed in all fill areas tested.

1.7 Test Results in Areas of Cut and Natural Ground

Only for Lot 426 to Lot 429 there is cut performed around 0.5m to 1.5m. The natural ground at the finished ground surface or under the filling comprised silty sands and sands as had been identified in the pre-subdivision investigation boreholes.

The results of the tests undertaken indicate that “good ground” as defined in NZS3604:2011 is present. No areas that were tested will require any future ground improvement work for buildings supported

1.8 Land Hazards

1.8.1 Land Stability

There are no landform stability issues within Stage 15 of the Greenhill Park Subdivision. The specification from the developer for the site earthworks was that the lots were to be graded as flat as possible with a desirable gradient of 0.5%.

1.8.2 Flooding

The final lot levels have been set based on infrastructure requirements and freeboard from flood levels developed as part of the stormwater design for the larger subdivision. The means of disposal of stormwater runoff from lots in this stage of the subdivision are described in the catchment and overland flow assessments by Beca (interpretive Report Lot Levels Area M). In the report for area M, a 1% AEP flood event is identified for each swale system. The three relevant swales for Stage 15 are Swale 1D, 3B and 3A (R.L. 38.46 1% Flood level). A flood level of 38.00 R.L. Stage 15, Greenhill Park, Hamilton Subdivision Completion Report Job No: DB 171738-AREA-M-

has been used in assessing the flood risk in stage 15. This equates to minimum lot levels of 38.925m to 40.020m R.L. across the stage (with low being the west end and high being the east end). A list of Lot Levels for Stage 15 is included in Appendix V.

Site grading during house construction must not lower finished levels below the minimum finished ground levels identified by Beca without further review of the impacts on flooding. Earthworks must not direct stormwater runoff to adjacent properties, or towards buildings, or create areas of localized ponding. All overland flow is to be towards the road frontage on each section, where falls will direct surface flow towards the Swale 1D and Swale 3B.

It is the responsibility of the building design professional to ensure that the requirements for mitigation for the hazard of flooding are met by the design prior to submitting to Council for consent. Confirmation of the swale construction and flood levels are excluded from the scope of this report and are to be covered separately with sign-off of infrastructure works.

1.8.3 Liquefaction

The potential for the hazard of liquefaction for Area M of the Greenhill Park Subdivision is discussed in “Greenhill Park Geotechnical Interpretation and Design - Area M” by Beca and dated 13 July 2018. Foundations within 5m of the top of the swales are classed as TC2 like foundations. The liquefaction summary plan is appended to this Completion report. Specifically, the requirements are:

- 0m – 1.5m no habitable dwellings to be built within 1.5 m of the swale crest.
- 1.5 – 5m adopt an enhanced TC2 _like foundation
- Beyond 5m of swale crest no specific requirements to mitigate liquefaction effects.

The Beca report refers to zones adjacent to the swales being in a TC2 type area as is defined in guidelines published by the Ministry of Business, Innovation and Employment (MBIE). MBIE recommends that TC2 type foundations should typically include ‘an enhanced foundation slab’ as is currently being installed for new houses in Christchurch. Alternatively, MBIE advises that houses may be supported on timber piles and a timber framed subfloor as detailed in NZS 3604 to meet a Type A construction as described in their guidelines. For stage 15 none of the lots are affected by swale so no specific requirements are needed to mitigate liquefaction.

1.8.4 Expansive Soils

The underlying soil conditions are primarily non-expansive sand strata and shallow slightly expansive silt layers. Zones of fill are encountered across the sites, with deeper fill located in all lots except Lot 428 and Lot 429 where fill is maximum of 0.4m. There is backfill of old drainage ditches in Lot 431 and Lot 432. The backfill is typically silty sand and not considered expansive. Overall, Stage 15 is underlain by non or slightly expansive soils. Any soils with a higher expansivity are expected to be limited in extent, and unlikely to result in changing the soil class.

For purpose of foundation recommendations, Lots 407-433 can be treated as M Class sites.

This is indicative of the greater depth of fill under these sites and therefore greater variability in the ground conditions. This is not to say the strata is moderately expansive, but that it may perform with comparable movement.

2.0 Disposal of Stormwater

Greenhill Park has been designed with a swale network to limit peak flows from the subdivision to 80 % of the 1 % AEP pre-development rate, and 90 % of the 10 % and 50 % AEP pre-development rates (Beca Ltd. [2016] Greenhill Park - Stormwater Design, for Chedworth Properties Ltd, 29 June 2016). Area M has been designed to include roadside swales flowing in an approximately east to west direction. Stage 15 includes swale 1D and 3B. The depth of the swales has been designed to accommodate the fall and cover depth required of the piped drainage system. The piped drainage network has been designed to convey the 50 % AEP flows from roads and lots to the swale network, with each lot to be provided with a piped service connection. The stormwater plan is presented in the S&L Drawing 'Stormwater as Built DWGs reported separately.

All lots will require on-site stormwater efficiency measures as per the District Plan requirements (Rule 25.13.4.5 Water Efficiency Measures). These include:

1. Detention of stormwater to 80% of pre-development runoff by an appropriate means. This has largely been achieved by the swale network for events greater than the 50 % AEP storm. For the 50 % AEP and smaller events, the stormwater efficiency measures are expected to provide sufficient additional mitigation to achieve this requirement.
2. Permeable surfaces protected to achieve at least 20% above the minimum standard of the zone (i.e., 40 % site permeability).
 - a. Sites within the Ruakura Medium Density Residential Zone require a minimum permeability of 20 % (Rule 4.6.5) and are limited to 50 % site coverage (Rule 4.6.6).
3. Rainwater tank for non-potable reuse system
4. Other equivalent features

Stormwater management must ensure that the rate of stormwater discharge offsite is at or below pre-development rates. Stormwater management measures shall be implemented, as appropriate, in accordance with the following drainage hierarchy:

1. Retention for reuse
2. Soakage techniques
3. Detention and gradual release to a watercourse
4. Detention and gradual release to stormwater reticulation.

Section 42 of the Subdivision Resource Consent (SRC) relating to Stages 9-15 state that "Each residential lot shall be provided with a means for disposal of stormwater, with no private stormwater pipes or soakage systems crossing from one lot to another except where covered by an easement" .

Section 43 of the SRC states that water efficiency measures for the individual residential lots are to be detailed for each subdivision stage. “Where retention for reuse tanks is proposed they shall be a minimum of 5,000L to ensure they are effective or where the lot is less than 300m² should be appropriately designed considering the specific site constraints. The required stormwater efficiency measure is to be implemented at the building consent stage and maintained on an on-going basis at the owners’ expense”.

Section 44 of the SRC requires a consent notice on each title advising of the required water efficiency measures to be implemented and maintained on an ongoing basis.

Section 55 of the SRC states the requirement for lot development to be undertaken in general accordance with the recommendations in the report: Greenhill Park Geotechnical Interpretation and Design – Area M, prepared by Beca Ltd., 13 July 2018.

In the Stage 15 development area, each site is to be tested for soakage capability by the property owners. For those sites that have a sufficient soakage capability, disposal of stormwater is to be undertaken onsite using soakage and/or bioretention systems with overflow to the lot stormwater service connection. Those sites that are not soakage viable are to retain stormwater for reuse by way of a Slimline Rain Tank or other similar type water tank. The size of the tank is to be 5000 litres and the tank is to be plumbed into the house for use as a non-potable water supply including for garden irrigation and in general accordance with the HCC guidelines for the Implementation of Water Efficiency Measures. The Slimline rain tank system is described in Appendix V. This requirement will be advised to purchasers and will be implemented through the building consent process by HCC. A consent notice is to be registered on the certificates of titles for each lot which describes these investigation and design requirements.

Details of the required stormwater measures are included in Appendix V, sourced from the Greenhill Park Design Guidelines.

3.0 Retaining Walls

There are no retaining walls that were constructed by the developer within stage 15.

4.0 Professional Opinion

It has been demonstrated in this Geotechnical Completion Report, that earthworks have been completed and building platforms have been constructed to comply with Council’s ITS specifications and the New Zealand Building Code. Recommendations have been provided within the report for the disposal of stormwater from individual lots, for the ongoing development of the lots and for the mitigation of liquefaction risk where applicable.

In accordance with ITS Section 2.3.3.1, a statement of professional opinion is enclosed in Appendix II of this document. This statement is presented in the form of Checklist 2.2 of Council’s Development Manual, Volume 4: Quality Systems for Land Development, and is accompanied by a *Summary of Geotechnical Data for Individual Lots* which summarizes the information and recommendations contained in this report.

5.0 Applicability

Recommendations contained in this document are based on data from observations of site earthworks, boreholes, and test results. Inferences about the nature and continuity of subsoils away from these locations are made but cannot be guaranteed.

In all circumstances, if variations in the subsoils occur which differ from those described or are assumed to exist, the site should be inspected by an engineer suitably qualified to make an informed judgement and provide advice on appropriate improvement measures.

This report has been prepared specifically for Stage 15 as shown for Lots: 407-433, DP543207 of Area M within the Greenhill Park Residential Subdivision. No responsibility is accepted by DB Consulting Engineers Ltd for the use of any part of this report for other development sites without their written approval.

Report Prepared By:

Date: 19th April 2021

.....

Ranjan Ghiloria
Civil Engineer

Report Reviewed By:

Date: 19th April 2021

.....

Michael Richardson
Senior Engineer

References

- [1] Ruakura Land Development - LDP Geotechnical Factual Report by Beca, 15 April 2016.
- [2] C. Hughes and K. Read, "Ruakura Development - Stage 1 Geotechnical Investigation – Liquefaction Potential Detailed Assessment," Opus International Consultants, Ltd., Hamilton, New Zealand, 2014.
- [3] M. Hughes and L. Shuler, "Report on Preliminary Geotechnical Investigation, Ruakura Development, Hamilton," S&L Consultants, Ltd., Tauranga, New Zealand, 2015.
- [4] "Section 2 Earthworks and Geotechnical Requirements," in *Infrastructure Technical Specifications*, Hamilton, New Zealand, Hamilton City Council, 2013.
- [5] "NZS 4404 Land Development and Subdivision Infrastructure," in *New Zealand Standards*, Wellington, New Zealand, Standards New Zealand, 2010.
- [6] "Greenhill Park - Geotechnical Interpretation and Design-Area 1" by Beca 28 October 2016.
- [7] "Part 5: Earthquake Actions - New Zealand," in *NZS 1170.5:2004 Structural Design Actions*, Standards New Zealand, 2004.
- [8] "Greenhill Park Design Report - Area I (Stage 5, 6, 7 & 8) by Beca 20 December 2016
- [9] "Clause B1: Structure," in *Acceptable Solutions and Verification Methods For New Zealand Building Code*, Wellington, Ministry of Business, Innovation and Employment, 2014.
- [10] "Part A: Technical Guidance," in *Repairing and rebuilding houses affected by the Canterbury earthquakes*, Wellington, Ministry of Business, Innovation and Employment, 2012.
- [11] "Clause E1: Surface Water," in *Acceptable Solutions and Verification Methods For New Zealand Building Code*, Wellington, Ministry of Business, Innovation and Employment, 2014.
- [12] "Section 4 Stormwater," in *Infrastructure Technical Specifications*, Hamilton, New Zealand, Hamilton City Council, 2015.

Appendix I *Reference Drawings* Subdivision Plan
Cut/Fill Plan 21879-01-M15-EW1
Site Levels Plan

H:\10000 - H Drive\pmp\Autocad\21879 - Greenhill Park - Stage 15 Cut Fill and Geotech Plans.dwg - Plotted: 7/04/2021



SHRIMPTON & LIPINSKI

LAND DEVELOPMENT & DESIGN SPECIALISTS

Ph. 07 577 6069
Email: info@sltga.co.nz
P.O. Box 231, Tauranga 3140

www.sltga.co.nz



GOSSET AVENUE

COULDSACK AVENUE

GOSSET AVENUE

COULDSACK AVENUE

Elevations Table

Number	Minimum Elevation	Maximum Elevation	Color
1	-1.491	-1.250	Light Blue
2	-1.250	-1.000	Blue
3	-1.000	-0.750	Light Blue
4	-0.750	-0.500	Light Blue
5	-0.500	-0.250	Light Green
6	-0.250	0.000	Light Green
7	0.000	0.250	Yellow-Green
8	0.250	0.500	Yellow-Green
9	0.500	0.750	Yellow
10	0.750	1.000	Yellow
11	1.000	1.250	Yellow
12	1.250	1.500	Yellow
13	1.500	1.750	Yellow
14	1.750	2.000	Yellow
15	2.000	2.250	Yellow
16	2.250	2.500	Yellow
17	2.500	2.750	Yellow
18	2.750	3.000	Brown
19	3.000	3.152	Brown

CUT

FILL

Rev	DESCRIPTION	DRN	CKD	APP	DATE
0	PRELIMINARY	NP	SC	SC	04/21

SURVEYED	SRC	DESIGNED	NAME	DATE
COORDINATE SYSTEM:	MT EDEN 2000 CIRCUIT			
ORIGIN OF COORDINATES:	ALP3 DP 534481			
HEIGHT DATUM:	MOTURIKI DATUM			
ORIGIN OF HEIGHT:	SS507 SO 42451 RL = 44.04			

TITLE
**CHEDWORTH PROPERTIES LTD
GREENHILL PARK
STAGE 15
CUT / FILL PLAN**



ORIGINAL SCALES @ A3	STATUS
1:500	PRELIMINARY
DO NOT SCALE DIMENSIONS	
DRAWING NO	REVISION
21879-01-M15-EW1	0

LEGEND

- DBCON GEOTECH TEST LOCATIONS
- DEPTH OF FILL
- CUT/FILL CONTOUR INTERVAL: 0.25M

COPYRIGHT ON THIS DRAWING IS RESERVED

H:\0000 - H Drive\parker\Autocad\21879 - Greenhill Park - Stage 15 Cut Fill and Geotech Plans.dwg - Plotted: 7/04/2021



SHRIMPTON & LIPINSKI

LAND DEVELOPMENT &
DESIGN SPECIALISTS

Ph. 07 577 6069
Email: info@sltga.co.nz
P.O. Box 231, Tauranga 3140
www.sltga.co.nz



LEVELS ARE TAKEN ON REPLACED TOPSOIL.
THIS PLAN IS NOT TO BE USED FOR DESIGN PURPOSES

LEGEND

← FLOW ARROW

(39.2) SPOT HEIGHT (GROUND LEVEL)

Rev	DESCRIPTION	DRN	CKD	APP	DATE
0	PRELIMINARY	NP	SC	SC	04/21

SURVEYED	NAME	DATE	DESIGNED	NAME	DATE


COORDINATE SYSTEM: MT EDEN 2000 CIRCUIT
ORIGIN OF COORDINATES: ALP3 DP 534481
HEIGHT DATUM: MOTURIKI DATUM
ORIGIN OF HEIGHT: SS507 SO 42451 RL = 44.04

TITLE

**SECTION LEVELS AND FLOW
GEOTECHNICAL REQUIREMENT
STAGE 15**

PREPARED FOR

ORIGINAL SCALES @ A3	STATUS
1:500	PRELIMINARY
DO NOT SCALE DIMENSIONS	
DRAWING NO	REVISION
21879-01-M15-G1	0

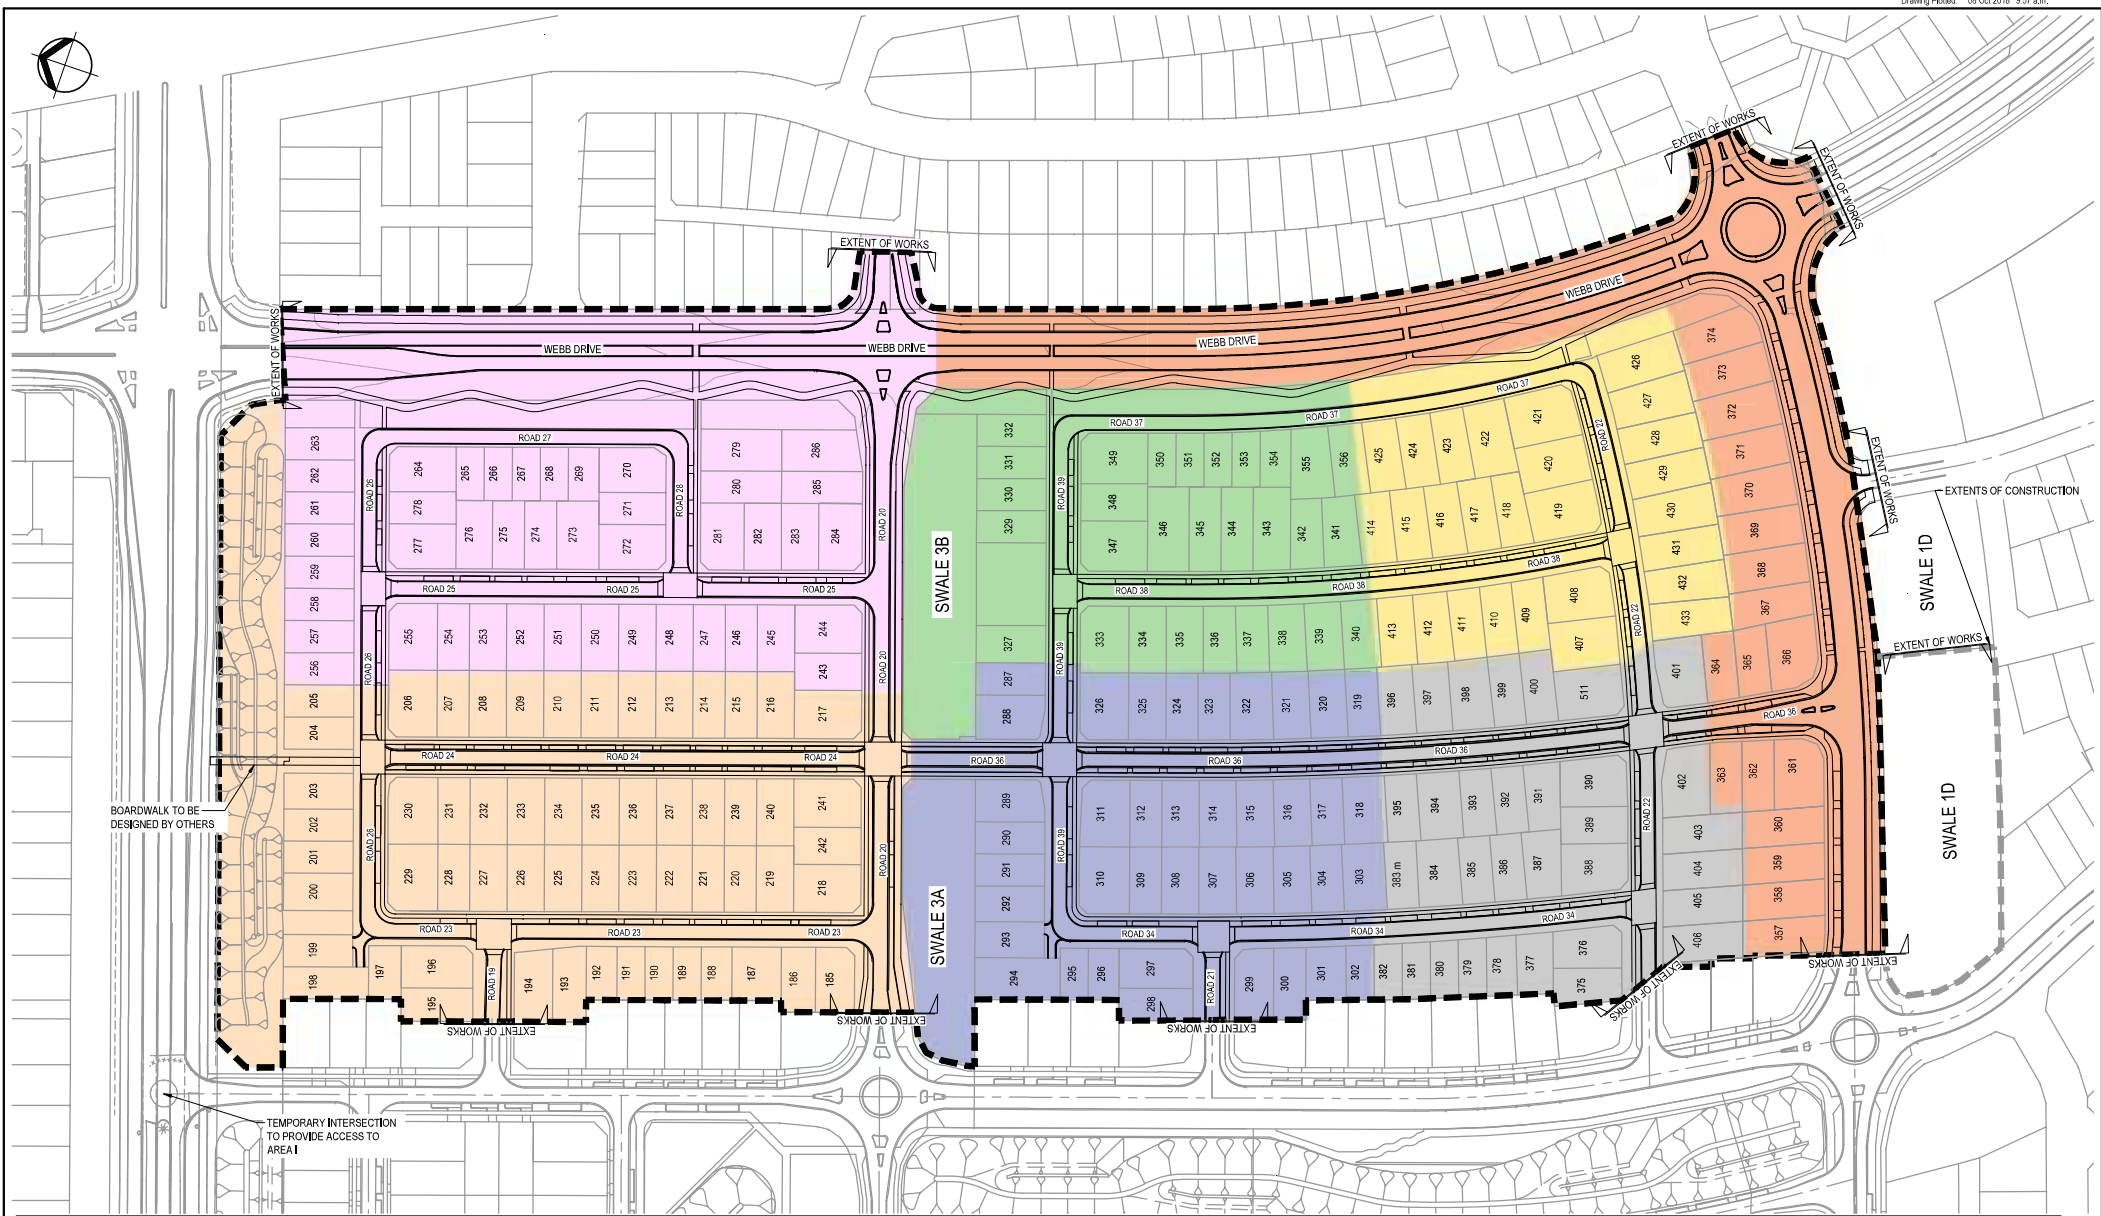

BOARDWALK TO BE DESIGNED BY OTHERS

TEMPORARY INTERSECTION TO PROVIDE ACCESS TO AREA 1

LEGEND:

	AREA M EXTENTS		AREA M - STAGE 10		AREA M - STAGE 13
	STORMWATER CULVERT		AREA M - STAGE 11		AREA M - STAGE 14
	BASIN LOW FLOW CHANNEL		AREA M - STAGE 12		AREA M - STAGE 15
	AREA M - STAGE 9				

- NOTES:**
1. EXTENT OF WORKS IS DEFINED AS THE "AREA M EXTENTS" AS SHOWN ON THE PLANS.
 2. ALL WORKS TO BE CONSTRUCTED IN ACCORDANCE WITH HAMILTON CITY COUNCIL INFRASTRUCTURE TECHNICAL SPECIFICATIONS (UNLESS OTHERWISE SPECIFIED).
 3. DETAILS OF INTERFACING WITH OTHER PROJECT STAGES TO BE CONFIRMED ON SITE PRIOR TO CONSTRUCTION

**ORIGINAL DRAWING
IN COLOUR**

FOR CONSTRUCTION

No.	Revision	SM	PP	AJ	21.09.18
1	FOR CONSTRUCTION				



Original Scale (A1)	Design	REMK	17.08.18	Approved For Construction*
1:1000	Drawn	SM	17.08.18	AJ
Reduced Scale (A3)	Design Checker	GJC	17.08.18	Date
1:2000	Design Checker	GDC	17.08.18	Date

* Refer to Revision 1 for Original Signature

Client:



Project:

Title: ROADING AND EARTHWORKS GENERAL ARRANGEMENT

Discipline: CIVIL ENGINEERING
Drawing No: 3411915-CA-2010
Rev: 1

Appendix II *Geotechnical Completion Forms*

Checklist 2.2 - Statement of Professional Opinion Summary of Geotechnical Data for Individual Lots
Summary of Geotechnical Data for individual Lots

STATEMENT OF PROFESSIONAL OPINION AS TO SUITABILITY OF LAND FOR BUILDING CONSTRUCTION

Development: Greenhill Park Stage 15 Developer: Chedworth Properties Limited

At Pardoia Boulevard, Chartwell, Hamilton

I, Michael Richardson of DB Consulting Engineers, PO Box 1123, Taupo

Hereby confirm that:

- 1.0 I am a geo-professional as defined in clause 1.2.2 of NZS 4404:2010 and was retained by the developer as the geo- professional on the above development.
- 2.0 The extent of my inspections during construction, and the results of all tests carried out are described in my geotechnical completion report for Greenhill Park Area M Stage 15 dated 19 April 2021 (reference 171738-AREA-M-S15-01)
- 3.0 In my professional opinion, not to be construed as a guarantee, I consider that:
 - a. The completed works give due regard to land slope and foundation stability considerations.
 - b. The site ground affected by engineered certified filling is suitable for the erection there on of buildings designed according to the report recommendations provided that:
 - i. Lots 407-433 are subject to the recommendations in the summary for individual lots and specific design as required to address variable ground. An M Class Waffle slab or similar is expected as an appropriate foundation type for sites requiring specific design.
 - ii. All lots are subject to an engineering inspection during foundation excavations unless of further soils testing is carried out for building consent. Previous stages have not required further soils testing, but Council requirements are for a minimum 4 soils tests per lots to be carried out for building consent. We recommend construction supervision from an engineer should be carried out to confirm the shallow ground conditions are in accordance with this report and suitable for NZS3604 foundations for bearing strength.
- 4.0 This professional opinion is furnished to Hamilton City Council and the developer for their purposes alone on the express condition that it will not be relied upon by any other person and does not remove the necessity for the normal inspection of foundation conditions at the time of erection of any dwelling.
- 5.0 This certificate shall be read in conjunction with my geotechnical completion report referred to in clause 2 above and shall not be copied or reproduced except in conjunction with the full geotechnical completion report.

Signed

Date: 21 April 2021

Michael Richardson
Chartered Professional Engineer (Geotechnical)
CPEng 1005467


Summary of Geotechnical Data for Individual Lots

DP No:	TBC	Property Address	Greenhill Park, Stage 15, Hamilton													RC No:	11/2018/6632		
Lot No:	Area (m ²)	Subsurface Data						Foundations		Building Restriction Line	S/W Specific Design	S/W Soakage	S/W Reticulated Platform	Designated Building Platform	Minimum Building Platform	Compressible Soils	On-site Effluent Disposal	Consent Notice	Comment
		Shear Strength (kPa)	Subdivision Filling		Natural Topography Unworked	Natural Topography Earthworked		Conventional Shallow Foundation to NZS 3604:2011	Specific Design										
			Y/N	Depth (m)	Y/N	Y/N	Depth (mm)	Y/N/Ribraft	Y/N/NA										
407	460	Note 1	Y	0.5-2.2 ²	N	Y	200 ²	N	Y	N	Y	Y ⁴	N	N	N	N	N	Y	
408	460	Note 1	Y	0.2-1.3 ²	N	Y	200 ²	Y	N	N	Y	Y ⁴	N	N	N	N	N	Y	
409	320	Note 1	Y	0.2-1.0 ²	N	Y	200 ²	Y - Ribraft	N	N	Y	Y ⁴	N	N	N	N	N	Y	
410	315	Note 1	Y	0.6-1.2 ²	N	Y	200 ²	Y - Ribraft	N	N	Y	Y ⁴	N	N	N	N	N	Y	
411	320	Note 1	Y	0.6-1.2 ²	N	Y	200 ²	Y - Ribraft	N	N	Y	Y ⁴	N	N	N	N	N	Y	
412	349	Note 1	Y	0.3-1.3 ²	N	Y	200 ²	Y	N	N	Y	Y ⁴	N	N	N	N	N	Y	
413	349	Note 1	Y	0.5-1.2 ²	N	Y	200 ²	Y	N	N	Y	Y ⁴	N	N	N	N	N	Y	
414	349	Note 1	Y	0.8-1.1 ²	N	Y	200 ²	Y - Ribraft	N	N	Y	Y ⁴	N	N	N	N	N	Y	
415	349	Note 1	Y	0.7-1.0 ²	N	Y	200 ²	Y	N	N	Y	Y ⁴	N	N	N	N	N	Y	
416	349	Note 1	Y	0.4-0.9 ²	N	Y	200 ²	Y	N	N	Y	Y ⁴	N	N	N	N	N	Y	
417	348	Note 1	Y	0.5-1.2 ²	N	Y	200 ²	Y	N	N	Y	Y ⁴	N	N	N	N	N	Y	
418	315	Note 1	Y	0.5-1.3 ²	N	Y	200 ²	Y	N	N	Y	Y ⁴	N	N	N	N	N	Y	
419	500	Note 1	Y	0.5-1.1 ²	N	Y	200 ²	Y	N	N	Y	Y ⁴	N	N	N	N	N	Y	
420	450	Note 1	Y	1.1-1.6 ²	N	Y	200 ²	Y	N	N	Y	Y ⁴	N	N	N	N	N	Y	
421	500	Note 1	Y	1.5-2.5 ²	N	Y	200 ²	Y	N	N	Y	Y ⁴	N	N	N	N	N	Y	
422	445	Note 1	Y	1.0-1.8 ²	N	Y	200 ²	Y	N	N	Y	Y ⁴	N	N	N	N	N	Y	
423	345	Note 1	Y	0.7-1.2 ²	N	Y	200 ²	Y	N	N	Y	Y ⁴	N	N	N	N	N	Y	
424	349	Note 1	Y	0.5-1.1 ²	N	Y	200 ²	Y	N	N	Y	Y ⁴	N	N	N	N	N	Y	
425	345	Note 1	Y	0.1-0.8 ²	N	Y	200 ²	Y	N	N	Y	Y ⁴	N	N	N	N	N	Y	
426	450	Note 1	Y	0.3-1.6 ²	N	Y	200 ²	Y - Ribraft	N	N	Y	Y ⁴	N	N	N	N	N	Y	
427	450	Note 1	Y	0.1-0.8 ²	N	Y	200 ²	Y	N	N	Y	Y ⁴	N	N	N	N	N	Y	
428	405	Note 1	Y	0.2-0.3 ²	N	Y	200 ²	Y	N	N	Y	Y ⁴	N	N	N	N	N	Y	
429	405	Note 1	Y	0.1-0.4 ²	N	Y	200 ²	Y	N	N	Y	Y ⁴	N	N	N	N	N	Y	
430	450	Note 1	Y	0.2-1.3 ²	N	Y	200 ²	Y - Ribraft	N	N	Y	Y ⁴	N	N	N	N	N	Y	
431	400	Note 1	Y	0.5-1.9 ²	N	Y	200 ²	Y - Ribraft	N	N	Y	Y ⁴	N	N	N	N	N	Y	
432	400	Note 1	Y	0.5-1.6 ²	N	Y	200 ²	N	Y	N	Y	Y ⁴	N	N	N	N	N	Y	
433	433	Note 1	Y	0.1-1.5 ²	N	Y	200 ²	Y	N	N	Y	Y ⁴	N	N	N	N	N	Y	


Summary of Geotechnical Data for Individual Lots

- NOTES:
- 1) Testing undertaken with Shera vane and Scala.
 - 2) This considers approximately 200mm of topsoil removal across all lots prior to subdivision filling.
 - 3) Setback required for properties adjacent swales. TC2 type foundation to be adopted within 1.5m-5m from top of slope, no foundations to be constructed <1.5m from top of slope, No specific engineer design required >5m from top of slope
 - 4) Soakage testing required on individual lots. Ground soakage and stormwater storage devices required

Appendix III Pre-Construction Assessment (exerts)
BECA Area M Liquefaction Assessment Summary Plan

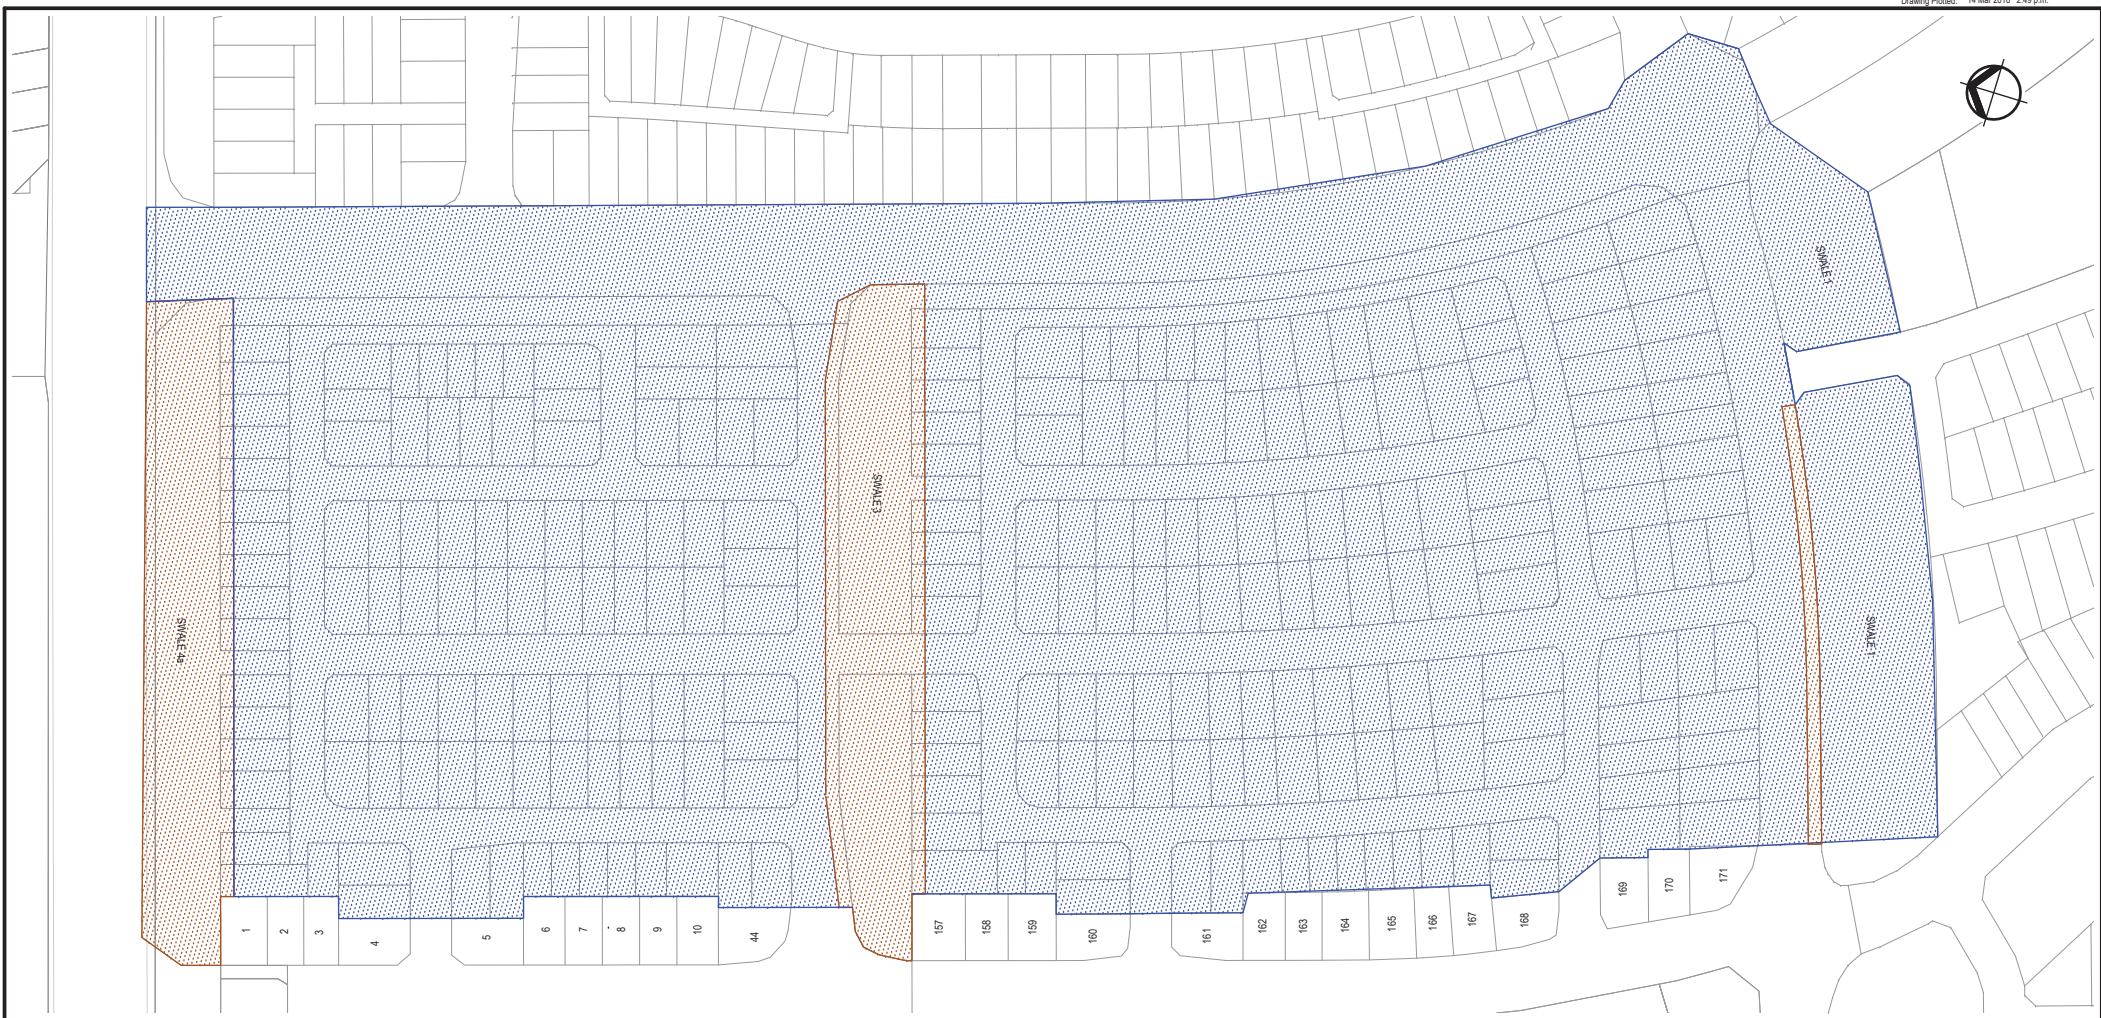

KEY

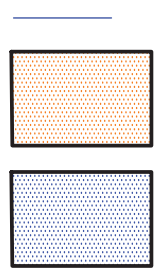

EXTENT OF AREA M


MEDIUM LIQUEFACTION VULNERABILITY

- MINOR TO MODERATE LIQUEFACTION-INDUCED GROUND DAMAGE IN 500 YEAR EARTHQUAKE TO MITIGATE LIQUEFACTION AND SEISMIC SLOPE INSTABILITY EFFECTS ADOPT LIQUEFACTION MITIGATION OPTION 1 OR 2.


LOW LIQUEFACTION VULNERABILITY

- NONE TO MINOR LIQUEFACTION-INDUCED GROUND DAMAGE IN 500 YEAR EARTHQUAKE.
- NO SPECIFIC REQUIREMENTS TO MITIGATE LIQUEFACTION EFFECTS.

LIQUEFACTION MITIGATION OPTION 1:

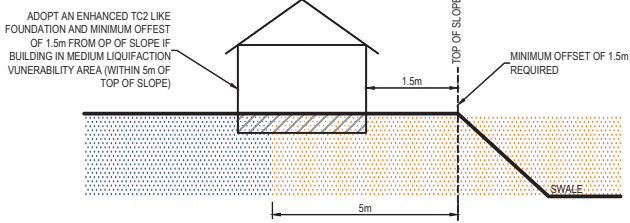

LIQUEFACTION MITIGATION OPTION 2:

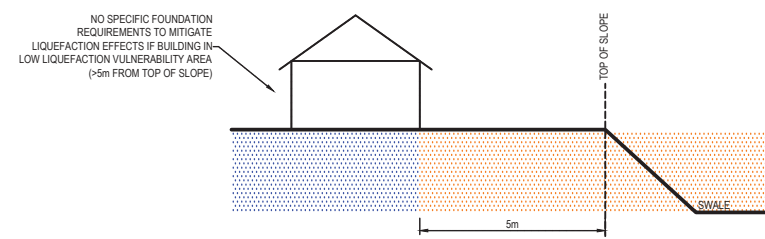

**FOR INFORMATION
NOT FOR CONSTRUCTION**

No.	Revision	By	Clk	APPR	Date
A	FOR INFORMATION	SM	MP	PR	12.03.18

Drawing Originator:	Original Scale (A1): 1:3000	Design:	MLP	27.09.16	Approved For Construction:
	Reduced Scale (A3): 1:6000	Drawn:	SM	12.03.18	
		Day Checker:	EAR	12.03.18	
		Date:			

Client:		Project:	
---------	--	----------	--

Title:	AREA M LIQUEFACTION ASSESSMENT SUMMARY PLAN	Discipline:	GEOTECHNICAL
Revision:	3411915-GC-K068	Rev:	A

Appendix IV Post-Construction Test Results

Completion Testing by DCBE Ltd



Project Name Chedworth Properties, Area M, Stage 15		Job Ref. 171738-AREA-M-S15-01	
Tested by GetGeo	Date 15/04/2021	Sheet No. 1	Test Site Lot 407

Depth (mm)	Undrained Shear (kPa)	No of blows /100mm	Scala Penetrometer (Blows/100mm)		Soil Description	Water Table
			0	2 4 6 8 10 12 14 16		
100		3		Good Ground	FILL, respread topsoil, gravels	
200		7		Result	medium-dense to dense	
300		3			Engineered FILL, silt, sand	
400		4			some angular gravels	
500		4			mixed light-brown, moist	
600		4				
700		2				
800		2				
900	140 / 23	1			900-1000mm minor topsoil	
1000		1				
1100		2			minor silt, minor gravels, orange-brown	
1200		2				
1300		2				
1400		4			Sand, silt, gravels	
1500		7			mixed browns, moist to very moist	
1600		13				
1700		11				
1800		11				
1900		12				
2000		14			SAND, some gravels, minor pumiceous materials	
2100		UTP			minor silt, grey, moist	
2200						
2300						
2400		UTP			dark grey-brown	
2500						
2600						
2700		UTP			dark grey, very moist	
2800						
2900						
3000						
3100					EOB @ 3.0m	
3200					Target Depth	
3300						
3400						
3500						

Notes:	EOB = End Of Borehole	UTP = Unable To Penetrate	UTE = Unable To Extract
1	Weather leading up to test was recent rain and cool weather. Fine during testing		
2	Ground water was not encountered during testing		
3	Shear Vane readings are converted readings, as per calibration Certificate. (Values are undrained shear strength)		
4	Shear Vane records include Re-moulded values where possible		
5	Shear Vane Serial No.: 2086	Exp. Date: 2/06/2021	Rev2.8



Project Name Chedworth Properties, Area M, Stage 15		Job Ref. 171738-AREA-M-S15-01	
Tested by GetGeo	Date 16/04/2021	Sheet No. 2	Test Site Lot 407b

Depth (mm)	Undrained Shear (kPa)	No of blows /100mm	Scala Penetrometer (Blows/100mm)		Soil Description	Water Table
			0	2 4 6 8 10 12 14 16		
100		3			FILL, topsoil, gravels	
200		6				
300		11			hard	
400		11			Engineered FILL, silt, sand, gravel, mixed browns, moist	
500		7			hand auger to 900mm	
600		6				
700		4				
800		11			mixed grey-brown and orange-brown	
900		7				
1000		7				
1100		8				
1200					Sandy SILT, light orange-brown, moist	
1300						
1400					Silty SAND, orange-brown, moist	
1500					minor fine gravels	
1600					grey orange-brown	
1700					gravelly Sand, minor silt, grey	
1800						
1900						
2000						
2100						
2200					dark grey	
2300						
2400						
2500						
2600						
2700					EOB @ 2600mm	
2800						
2900						
3000						
3100						
3200						
3300						
3400						
3500						

Notes:	EOB = End Of Borehole	UTP = Unable To Penetrate	UTE = Unable To Extract
1	Weather leading up to test was recent rain and cool weather. Fine during testing		
2	Ground water was not encountered during testing		
3	Shear Vane readings are converted readings, as per calibration Certificate. (Values are undrained shear strength)		
4	Shear Vane records include Re-moulded values where possible		
5	Shear Vane Serial No.: 2086	Exp. Date: 2/06/2021	



Project Name Chedworth Properties, Area M, Stage 15		Job Ref. 171738-AREA-M-S15-01	
Tested by GetGeo	Date 15/04/2021	Sheet No. 3	Test Site Lot 408

Depth (mm)	Undrained Shear (kPa)	No of blows /100mm	Scala Penetrometer (Blows/100mm)		Soil Description	Water Table
			0	2 4 6 8 10 12 14 16		
100		1			FILL, topsoil, gravels	
200		1				
300		3				
400		5			hard Engineered FILL, silt, minor sand dark orange-brown, moist minor topsoil Sand, silt, minor topsoil mixed grey-brown and dark brown loose minor silt some gravels	
500		4				
600	204+ / -	5				
700		6				
800		6				
900		5				
1000		1				
1100		2				
1200		2				
1300		3				
1400		5			dense SAND, some gravels, grey, moist	
1500		3				
1600		7				
1700		9				
1800		12			EOB @ 2.0m Target Depth	
1900		11				
2000		11				
2100						
2200						
Notes:	EOB = End Of Borehole	UTP = Unable To Penetrate	UTE = Unable To Extract
1	Weather leading up to test was recent rain and cool weather. Fine during testing		
2	Ground water was not encountered during testing		
3	Shear Vane readings are converted readings, as per calibration Certificate. (Values are undrained shear strength)		
4	Shear Vane records include Re-moulded values where possible		
5	Shear Vane Serial No.: 2086	Exp. Date: 2/06/2021	Rev2.8



Project Name Chedworth Properties, Area M, Stage 15		Job Ref. 171738-AREA-M-S15-01	
Tested by GetGeo	Date 15/04/2021	Sheet No. 4	Test Site Lot 409

Depth (mm)	Undrained Shear (kPa)	No of blows /100mm	Scala Penetrometer (Blows/100mm)		Soil Description	Water Table
			0	2 4 6 8 10 12 14 16		
100		1			FILL, topsoil, gravels	
200		1				
300		3			dense	
400		3			Engineered FILL, silt, minor sand	
500		9			mixed greys/browns, moist	
600		8			some gravels, sand	
700		4				
800		2			stiff	
900		2				
1000		1			SILT, light yellow-brown	
1100		1			minor orange-mottling, moist	
1200	70 / 18	0.5				
1300		0.5				
1400		1			creamy brown	
1500		1				
1600		3			dense	
1700		7				
1800		11			SAND, some silt, light-grey, moist	
1900		14			some gravels, minor silt, dark grey, very moist	
2000		14				
2100					EOB @ 2.0m	
2200					Target Depth	
2300						
2400						
Notes:	EOB = End Of Borehole	UTP = Unable To Penetrate	UTE = Unable To Extract
1	Weather leading up to test was recent rain and cool weather. Fine during testing		
2	Ground water was not encountered during testing		
3	Shear Vane readings are converted readings, as per calibration Certificate. (Values are undrained shear strength)		
4	Shear Vane records include Re-moulded values where possible		
5	Shear Vane Serial No.: 2086	Exp. Date: 2/06/2021	Rev2.8



Project Name Chedworth Properties, Area M, Stage 15		Job Ref. 171738-AREA-M-S15-01	
Tested by GetGeo	Date 15/04/2021	Sheet No. 5	Test Site Lot 410

Depth (mm)	Undrained Shear (kPa)	No of blows /100mm	Scala Penetrometer (Blows/100mm)		Soil Description	Water Table
			0	2 4 6 8 10 12 14 16		
100		1			FILL, topsoil, gravels	
200		2				
300		9			dense	
400		16				
500		12			Engineered FILL, silt, sand, some gravels mixed light-brown, moist	
600		5				
700		4				
800		7			minor topsoil, minor gravels	
900		4				
1000		2				
1100		2				
1200	128 / 26	1			very stiff	
1300		1			SILT, minor topsoil, minor sand, orange-brown, moist light-brown, minor orange-mottling	
1400		1				
1500		0.5				
1600		0.5			some orange-mottling	
1700		3			loose to dense	
1800		3			SAND, silt, creamy brown, some mottling, moist	
1900		3			minor silt	
2000		13			gravels	
2100					EOB @ 2.0m	
2200					Target Depth	
2300						
2400						
Notes:	EOB = End Of Borehole	UTP = Unable To Penetrate	UTE = Unable To Extract
1	Weather leading up to test was recent rain and cool weather. Fine during testing		
2	Ground water was not encountered during testing		
3	Shear Vane readings are converted readings, as per calibration Certificate. (Values are undrained shear strength)		
4	Shear Vane records include Re-moulded values where possible		
5	Shear Vane Serial No.: 2086	Exp. Date: 2/06/2021	Rev2.8



Project Name Chedworth Properties, Area M, Stage 15		Job Ref. 171738-AREA-M-S15-01	
Tested by GetGeo	Date 15/04/2021	Sheet No. 6	Test Site Lot 411

Depth (mm)	Undrained Shear (kPa)	No of blows /100mm	Scala Penetrometer (Blows/100mm)		Soil Description	Water Table
			0	2 4 6 8 10 12 14 16		
100		1			FILL, topsoil, gravels	
200		2				
300		3			dense	
400		2				
500		10				
600		11			Engineered FILL, silt, sand, some gravels mixed light-brown, moist	
700		9				
800		9				
900		10				
1000		2			minor topsoil	
1100		1			firm	
1200		1			SILT, light orange-brown some dark orange-mottling, moist	
1300		1				
1400	56 / 18	1			very moist	
1500		1				
1600		2				
1700		2			dense	
1800		5			SAND, some gravels, minor silt, grey to dark grey moist	
1900		7				
2000		10				
2100					EOB @ 2.0m	
2200					Target Depth	
2300						
2400						
Notes:	EOB = End Of Borehole	UTP = Unable To Penetrate	UTE = Unable To Extract
1	Weather leading up to test was recent rain and cool weather. Fine during testing		
2	Ground water was not encountered during testing		
3	Shear Vane readings are converted readings, as per calibration Certificate. (Values are undrained shear strength)		
4	Shear Vane records include Re-moulded values where possible		
5	Shear Vane Serial No.: 2086	Exp. Date: 2/06/2021	



Project Name Chedworth Properties, Area M, Stage 15		Job Ref. 171738-AREA-M-S15-01	
Tested by GetGeo	Date 15/04/2021	Sheet No. 7	Test Site Lot 412

Depth (mm)	Undrained Shear (kPa)	No of blows /100mm	Scala Penetrometer (Blows/100mm)		Soil Description	Water Table
			0	2 4 6 8 10 12 14 16		
100		1			FILL, topsoil, gravels	
200		2			very stiff Engineered FILL, silt, sand, some gravels mixed light-brown, moist	
300		4				
400		12				
500		8				
600		8				
700		7				
800		8				
900		4				
1000						
1100					very stiff	
1200	140 / 26				SILT, orange-brown, moist clayey Silt, very moist grading to creamy light-brown, some orange-mottling minor mottling	
1300						
1400						
1500	117 / 20					
1600		3				
1700		4				
1800		4				
1900		5				
2000		4				
2100		4				
2200					EOB @ 2.0m Target Depth	
2300						
2400						
Notes:	EOB = End Of Borehole	UTP = Unable To Penetrate	UTE = Unable To Extract
1	Weather leading up to test was recent rain and cool weather. Fine during testing		
2	Ground water was not encountered during testing		
3	Shear Vane readings are converted readings, as per calibration Certificate. (Values are undrained shear strength)		
4	Shear Vane records include Re-moulded values where possible		
5	Shear Vane Serial No.: 2086	Exp. Date: 2/06/2021	Rev2.8



Project Name Chedworth Properties, Area M, Stage 15		Job Ref. 171738-AREA-M-S15-01	
Tested by GetGeo	Date 15/04/2021	Sheet No. 8	Test Site Lot 413

Depth (mm)	Undrained Shear (kPa)	No of blows /100mm	Scala Penetrometer (Blows/100mm)		Soil Description	Water Table
			0	2 4 6 8 10 12 14 16		
100		2			FILL, topsoil, gravels	
200		2			hard Engineered FILL, silt, sand, some gravels mixed light-brown, moist interbedded gangular gravels, minor topsoil	
300		3				
400		4				
500		9				
600		21				
700		UTP			stiff SILT, orange-brown, orange mottling light grey-brown, minor mottling, moist	
800						
900					loose SAND, some silt, light grey-brown, moist some gravels, dark grey	
1000						
1100						
1200	140 / 50	4				
1300		3				
1400		2				
1500		2				
1600		3				
1700		2				
1800		2				
1900		3				
2000		4				
2100					EOB @ 2.0m Target Depth	
2200						
2300						
Notes:	EOB = End Of Borehole	UTP = Unable To Penetrate	UTE = Unable To Extract
1	Weather leading up to test was recent rain and cool weather. Fine during testing		
2	Ground water was not encountered during testing		
3	Shear Vane readings are converted readings, as per calibration Certificate. (Values are undrained shear strength)		
4	Shear Vane records include Re-moulded values where possible		
5	Shear Vane Serial No.: 2086	Exp. Date: 2/06/2021	Rev2.8



Project Name Chedworth Properties, Area M, Stage 15		Job Ref. 171738-AREA-M-S15-01	
Tested by GetGeo	Date 15/04/2021	Sheet No. 9	Test Site Lot 414

Depth (mm)	Undrained Shear (kPa)	No of blows /100mm	Scala Penetrometer (Blows/100mm)		Soil Description	Water Table
			0	2 4 6 8 10 12 14 16		
100		4		Good Ground	FILL, respread topsoil, gravels	
200		8		Result	medium-dense	
300		7			Engineered FILL, silt, sand some angular gravels mixed light-brown, moist	
400		5				
500		4			minor topsoil	
600		4				
700		2			stiff	
800		2				
900		2			Fine sandy SILT, light orange-brown, moist	
1000		2				
1100		2			loose	
1200	82 / 18	2				
1300					Silty SAND, light-brown, moist	
1400						
1500					minor silt	
1600		3				
1700		3			some gravels, grey-brown	
1800		3				
1900		3			EOB @ 2.0m Target Depth	
2000		5				
2100		4				
2200						
2300						
Notes:	EOB = End Of Borehole	UTP = Unable To Penetrate	UTE = Unable To Extract
1	Weather leading up to test was recent rain and cool weather. Fine during testing		
2	Ground water was not encountered during testing		
3	Shear Vane readings are converted readings, as per calibration Certificate. (Values are undrained shear strength)		
4	Shear Vane records include Re-moulded values where possible		
5	Shear Vane Serial No.: 2086	Exp. Date: 2/06/2021	Rev2.8



Project Name Chedworth Properties, Area M, Stage 15		Job Ref. 171738-AREA-M-S15-01	
Tested by GetGeo	Date 15/04/2021	Sheet No. 10	Test Site Lot 415

Depth (mm)	Undrained Shear (kPa)	No of blows /100mm	Scala Penetrometer (Blows/100mm)		Soil Description	Water Table
			0	2 4 6 8 10 12 14 16		
100		2			FILL, topsoil, gravels	
200		12				
300		14				
400		4			hard	
500		7			difficult to machine auger	
600	204+ / -	5			Engineered FILL, silt, minor sand	
700		9			some gravels, dark orange-brown, moist	
800		7				
900		5			minor topsoil	
1000		4				
1100		3			SILT, minor sand, brown, moist	
1200		2				
1300		2			medium-dense	
1400		3			Silty SAND, light-brown, moist	
1500		3			minor silt, light grey-brown	
1600		5				
1700		3				
1800		5			minor gravels, dark grey	
1900		6				
2000		7				
2100					EOB @ 2.0m	
2200					Target Depth	
2300						
2400						
Notes:	EOB = End Of Borehole	UTP = Unable To Penetrate	UTE = Unable To Extract
1	Weather leading up to test was recent rain and cool weather. Fine during testing		
2	Ground water was not encountered during testing		
3	Shear Vane readings are converted readings, as per calibration Certificate. (Values are undrained shear strength)		
4	Shear Vane records include Re-moulded values where possible		
5	Shear Vane Serial No.: 2086	Exp. Date: 2/06/2021	



Project Name Chedworth Properties, Area M, Stage 15		Job Ref. 171738-AREA-M-S15-01	
Tested by GetGeo	Date 15/04/2021	Sheet No. 11	Test Site Lot 416

Depth (mm)	Undrained Shear (kPa)	No of blows /100mm	Scala Penetrometer (Blows/100mm)		Soil Description	Water Table
			0	2 4 6 8 10 12 14 16		
100		1			FILL, topsoil, gravels	
200		1				
300		1			dense	
400		8			Engineered FILL, silt, minor sand	
500		11			mixed greys/browns, moist	
600		9			some gravels, sand	
700		5				
800		5				
900		3			SILT, orange-brown, moist	
1000		3			loose to medium-dense	
1100		2			Silty SAND, light yellow-brown	
1200					minor orange mottling, moist	
1300		4			minor silt, minor fine gravels, light grey-brown	
1400		4				
1500		5				
1600		5				
1700		6				
1800		6			some fine gravels, dark grey	
1900		7				
2000		7				
2100					EOB @ 2.0m	
2200					Target Depth	
2300						
2400						
Notes:	EOB = End Of Borehole	UTP = Unable To Penetrate	UTE = Unable To Extract
1	Weather leading up to test was recent rain and cool weather. Fine during testing		
2	Ground water was not encountered during testing		
3	Shear Vane readings are converted readings, as per calibration Certificate. (Values are undrained shear strength)		
4	Shear Vane records include Re-moulded values where possible		
5	Shear Vane Serial No.: 2086	Exp. Date: 2/06/2021	



Project Name Chedworth Properties, Area M, Stage 15		Job Ref. 171738-AREA-M-S15-01	
Tested by GetGeo	Date 15/04/2021	Sheet No. 12	Test Site Lot 417

Depth (mm)	Undrained Shear (kPa)	No of blows /100mm	Scala Penetrometer (Blows/100mm)		Soil Description	Water Table
			0	2 4 6 8 10 12 14 16		
100		3			FILL, topsoil, gravels	
200		3			dense Engineered FILL, silt, sand, some gravels mixed light-brown, moist	
300		4				
400		10				
500		16				
600		16				
700		18				
800		13				
900		5			Sandy SILT, orange-brown, moist	
1000		4			medium dense	
1100		4			Silty SAND, minor pumiceous materials	
1200		3			light yellow-brown, some orange mottling, moist	
1300		3			trace silt, light grey-brown	
1400		4				
1500		6				
1600		6				
1700		5			some fine gravels, dark brown / grey	
1800		5				
1900		7				
2000		7				
2100					EOB @ 2.0m	
2200					Target Depth	
2300						
2400						
Notes:	EOB = End Of Borehole	UTP = Unable To Penetrate	UTE = Unable To Extract
1	Weather leading up to test was recent rain and cool weather. Fine during testing		
2	Ground water was not encountered during testing		
3	Shear Vane readings are converted readings, as per calibration Certificate. (Values are undrained shear strength)		
4	Shear Vane records include Re-moulded values where possible		
5	Shear Vane Serial No.: 2086	Exp. Date: 2/06/2021	



Project Name Chedworth Properties, Area M, Stage 15		Job Ref. 171738-AREA-M-S15-01	
Tested by GetGeo	Date 15/04/2021	Sheet No. 13	Test Site Lot 418

Depth (mm)	Undrained Shear (kPa)	No of blows /100mm	Scala Penetrometer (Blows/100mm)		Soil Description	Water Table
			0	2 4 6 8 10 12 14 16		
100		3			FILL, topsoil, gravels	
200		3				
300		9			dense	
400		11			Engineered	
500		11			FILL, silt, sand, some gravels, mixed light-brown moist	
600		6				
700		4				
800		4				
900	204+ / -	4			SILT, minor sand, orange-brown, moist	
1000		4			some sand	
1100		5			medium dense	
1200		3			Silty SAND, light yellow-brown, moist	
1300		3			minor silt, light grey-brown	
1400		4				
1500		5			trace silt, grey	
1600		5				
1700		6				
1800		5				
1900		4				
2000		6				
2100					EOB @ 2.0m	
2200					Target Depth	
2300						
2400						
Notes:	EOB = End Of Borehole	UTP = Unable To Penetrate	UTE = Unable To Extract
1	Weather leading up to test was recent rain and cool weather. Fine during testing		
2	Ground water was not encountered during testing		
3	Shear Vane readings are converted readings, as per calibration Certificate. (Values are undrained shear strength)		
4	Shear Vane records include Re-moulded values where possible		
5	Shear Vane Serial No.: 2086	Exp. Date: 2/06/2021	



Project Name Chedworth Properties, Area M, Stage 15		Job Ref. 171738-AREA-M-S15-01	
Tested by GetGeo	Date 15/04/2021	Sheet No. 14	Test Site Lot 419

Depth (mm)	Undrained Shear (kPa)	No of blows /100mm	Scala Penetrometer (Blows/100mm)		Soil Description	Water Table
			0	2 4 6 8 10 12 14 16		
100		3			FILL, topsoil, gravels	
200		4			very stiff Engineered FILL, silt, sand, some gravels, minor clay mixed greys, browns, orange-brown, moist	
300		5				
400		6				
500		7				
600		10				
700		8			minor topsoil	
800		8				
900		5			very stiff	
1000		5				
1100		3			SILT, orange-brown, moist	
1200	166 / 35	1				
1300		2			clayey Silt, very moist grading to creamy light-brown, some orange-mottling	
1400		4				
1500		3			loose Silty SAND, grey-brown, minor mottling, moist	
1600		2				
1700		3			minor silt dark grey	
1800		3				
1900		3			EOB @ 2.0m Target Depth	
2000		4				
2100						
2200						
Notes:	EOB = End Of Borehole	UTP = Unable To Penetrate	UTE = Unable To Extract
1	Weather leading up to test was recent rain and cool weather. Fine during testing		
2	Ground water was not encountered during testing		
3	Shear Vane readings are converted readings, as per calibration Certificate. (Values are undrained shear strength)		
4	Shear Vane records include Re-moulded values where possible		
5	Shear Vane Serial No.: 2086	Exp. Date: 2/06/2021	Rev2.8



Project Name Chedworth Properties, Area M, Stage 15		Job Ref. 171738-AREA-M-S15-01	
Tested by GetGeo	Date 15/04/2021	Sheet No. 15	Test Site Lot 420

Depth (mm)	Undrained Shear (kPa)	No of blows /100mm	Scala Penetrometer (Blows/100mm)		Soil Description	Water Table
			0	2 4 6 8 10 12 14 16		
100		2			FILL, topsoil, gravels	
200		2				
300		3			dense to very dense	
400		10				
500		11			Engineered FILL, silt, sand, some gravels mixed light-brown, moist	
600		7				
700		12			interbedded angular gravels, minor topsoil	
800		18			difficult to machine auger	
900		16				
1000		11				
1100		13				
1200		4			stiff	
1300		7			SILT, minor sand, yellow-brown, minor mottling moist	
1400		4				
1500		4			medium dense	
1600		7			Silty SAND, yellow-brown, moist	
1700		7				
1800		6			minor silt	
1900		5			grey	
2000		6				
2100					EOB @ 2.0m	
2200					Target Depth	
2300						
2400						
Notes:	EOB = End Of Borehole	UTP = Unable To Penetrate	UTE = Unable To Extract
1	Weather leading up to test was recent rain and cool weather. Fine during testing		
2	Ground water was not encountered during testing		
3	Shear Vane readings are converted readings, as per calibration Certificate. (Values are undrained shear strength)		
4	Shear Vane records include Re-moulded values where possible		
5	Shear Vane Serial No.: 2086	Exp. Date: 2/06/2021	Rev2.8



Project Name Chedworth Properties, Area M, Stage 15		Job Ref. 171738-AREA-M-S15-01	
Tested by GetGeo	Date 16/04/2021	Sheet No. 16	Test Site Lot 421

Depth (mm)	Undrained Shear (kPa)	No of blows /100mm	Scala Penetrometer (Blows/100mm)		Soil Description	Water Table
			0	2 4 6 8 10 12 14 16		
100		1		Good Ground	FILL, respread topsoil, gravels	
200		1		Result		
300		2			medium-dense	
400		15				
500		15			Engineered FILL, silt, sand some angular gravels mixed light-brown, moist	
600		UTP				
700		Not tested				
800		Not tested			minor topsoil	
900		Not tested				
1000		2				
1100		6				
1200	82 / 18	7			varying dominance by Silt or Sand	
1300		13				
1400		7				
1500		6				
1600		5				
1700		10				
1800		10				
1900		6				
2000		7				
2100		6				
2200		7				
2300		6			medium dense	
2400		10			Silty SAND, minor fine gravels, light grey, very moist	
2500		8				
2600		3				
2700		3				
2800		3			very stiff	
2900		2			Fine sandy SILT, creamy light-brown some orange mottling, moist	
3000		3				
3100						
3200					EOB @ 3.0m	
3300					Target Depth	
3400						
3500						

Notes:	EOB = End Of Borehole	UTP = Unable To Penetrate	UTE = Unable To Extract
1	Weather leading up to test was recent rain and cool weather. Fine during testing		
2	Ground water was not encountered during testing		
3	Shear Vane readings are converted readings, as per calibration Certificate. (Values are undrained shear strength)		
4	Shear Vane records include Re-moulded values where possible		
5	Shear Vane Serial No.: 2086	Exp. Date: 2/06/2021	Rev2.8



Project Name Chedworth Properties, Area M, Stage 15		Job Ref. 171738-AREA-M-S15-01	
Tested by GetGeo	Date 16/04/2021	Sheet No. 17	Test Site Lot 421b

Depth (mm)	Undrained Shear (kPa)	No of blows /100mm	Scala Penetrometer (Blows/100mm)		Soil Description	Water Table
			0	2 4 6 8 10 12 14 16		
100		3		Result	FILL, topsoil, gravels	
200		7		Good Ground		
300		9				
400		12			Engineered FILL, silt, sand, minor angular gravels mixed brown, moist some orange-brown	
500		UTP				
600						
700		6				
800		7				
900		8				
1000		11				
1100		9				
1200		5				
1300		4				
1400		5			1700-1800mm significant angular gravels, silt and sand dark grey-brown	
1500		8				
1600		8				
1700		12				
1800		UTP			SILT, minor fine sand, creamy light-brown, some mottling moist minor clay, minor orange mottling	
1900		2				
2000		2				
2100		2				
2200						
2300					EOB @ 2400mm	
2400						
2500						
2600						
2700						
2800						
2900						
3000						
3100						
3200						
3300						
3400						
3500						

Notes:	EOB = End Of Borehole	UTP = Unable To Penetrate	UTE = Unable To Extract
1	Weather leading up to test was recent rain and cool weather. Fine during testing		
2	Ground water was not encountered during testing		
3	Shear Vane readings are converted readings, as per calibration Certificate. (Values are undrained shear strength)		
4	Shear Vane records include Re-moulded values where possible		
5	Shear Vane Serial No.: 2086	Exp. Date: 2/06/2021	Rev2.8



Project Name Chedworth Properties, Area M, Stage 15		Job Ref. 171738-AREA-M-S15-01	
Tested by GetGeo	Date 16/04/2021	Sheet No. 18	Test Site Lot 422a

Depth (mm)	Undrained Shear (kPa)	No of blows /100mm	Scala Penetrometer (Blows/100mm)		Soil Description	Water Table
			0	2 4 6 8 10 12 14 16		
100		2			FILL, topsoil, gravels	
200		2				
300		9				
400		17			hard	
500		19			difficult to machine auger	
600	204+ / -	17			Engineered FILL, silt, minor sand some gravels, dark orange-brown, moist	
700		16				
800		22				
900		17				
1000		17				
1100		17				
1200		12				
1300		10				
1400		12				
1500		13				
1600		9			medium dense	
1700		8				
1800		9			Silty SAND, light-brown, moist to very moist	
1900		7				
2000		10				
2100					EOB @ 2.0m	
2200					Target Depth	
2300						
2400						
Notes:	EOB = End Of Borehole	UTP = Unable To Penetrate	UTE = Unable To Extract
1	Weather leading up to test was recent rain and cool weather. Fine during testing		
2	Ground water was not encountered during testing		
3	Shear Vane readings are converted readings, as per calibration Certificate. (Values are undrained shear strength)		
4	Shear Vane records include Re-moulded values where possible		
5	Shear Vane Serial No.: 2086	Exp. Date: 2/06/2021	



Project Name Chedworth Properties, Area M, Stage 15		Job Ref. 171738-AREA-M-S15-01	
Tested by GetGeo	Date 16/04/2021	Sheet No. 19	Test Site Lot 422b

Depth (mm)	Undrained Shear (kPa)	No of blows /100mm	Scala Penetrometer (Blows/100mm)		Soil Description	Water Table
			0	2 4 6 8 10 12 14 16		
100		3			FILL, topsoil, gravels	
200		6				
300		13				
400		14				
500		10				
600		21			Engineered FILL, silt, sand, angular gravels mixed brown, moist	
700		UTP			difficult to machine auger	
800					significant gravels	
900		11				
1000		14			grey-brown	
1100		UTP				
1200						
1300		12				
1400		16				
1500		13				
1600		9				
1700		4				
1800		3				
1900		4				
2000		6			SILT, minor fine sand, creamy light-brown, moist	
2100		8				
2200						
2300						
2400					Silty SAND, creamy light-brown, moist	
2500						
2600					EOB @ 2500mm	
2700						
2800						
2900						
3000						
3100						
3200						
3300						
3400						
3500						

Notes:	EOB = End Of Borehole	UTP = Unable To Penetrate	UTE = Unable To Extract
1	Weather leading up to test was recent rain and cool weather. Fine during testing		
2	Ground water was not encountered during testing		
3	Shear Vane readings are converted readings, as per calibration Certificate. (Values are undrained shear strength)		
4	Shear Vane records include Re-moulded values where possible		
5	Shear Vane Serial No.: 2086	Exp. Date: 2/06/2021	



Project Name Chedworth Properties, Area M, Stage 15		Job Ref. 171738-AREA-M-S15-01	
Tested by GetGeo	Date 16/04/2021	Sheet No. 20	Test Site Lot 423

Depth (mm)	Undrained Shear (kPa)	No of blows /100mm	Scala Penetrometer (Blows/100mm)		Soil Description	Water Table
			0	2 4 6 8 10 12 14 16		
100		6			FILL, topsoil, gravels	
200		6				
300		12			dense	
400		12			Engineered FILL, silt, minor sand mixed greys/browns, moist	
500		13			some gravels, sand	
600		16				
700		17				
800		18			difficult to machine auger	
900		20			difficult to extract	
1000		UTP				
1100						
1200						
1300		5				
1400		10				
1500		9				
1600		7				
1700		7			very stiff	
1800		7			SILT, some fine sand, light grey, very moist	
1900		6				
2000		5				
2100					EOB @ 2.0m	
2200					Target Depth	
2300						
2400						
Notes:	EOB = End Of Borehole	UTP = Unable To Penetrate	UTE = Unable To Extract
1	Weather leading up to test was recent rain and cool weather. Fine during testing		
2	Ground water was not encountered during testing		
3	Shear Vane readings are converted readings, as per calibration Certificate. (Values are undrained shear strength)		
4	Shear Vane records include Re-moulded values where possible		
5	Shear Vane Serial No.: 2086	Exp. Date: 2/06/2021	Rev2.8



Project Name Chedworth Properties, Area M, Stage 15		Job Ref. 171738-AREA-M-S15-01	
Tested by GetGeo	Date 16/04/2021	Sheet No. 21	Test Site Lot 424

Depth (mm)	Undrained Shear (kPa)	No of blows /100mm	Scala Penetrometer (Blows/100mm)		Soil Description	Water Table
			0	2 4 6 8 10 12 14 16		
100		5			FILL, topsoil, gravels	
200		5			dense	
300		7				
400		7			Engineered FILL, silt, sand, some gravels mixed light-brown, moist	
500		16				
600		20			some gravels, sand	
700		18				
800		12			difficult to machine auger difficult to extract	
900		12				
1000		12			very stiff	
1100		7				
1200		11			SILT, some fine sand, light grey, very moist	
1300		12				
1400		13			EOB @ 2.0m Target Depth	
1500		7				
1600		4				
1700		3				
1800		3				
1900		3				
2000	187 / 41	6				
2100						
2200						
Notes:	EOB = End Of Borehole	UTP = Unable To Penetrate	UTE = Unable To Extract
1	Weather leading up to test was recent rain and cool weather. Fine during testing		
2	Ground water was not encountered during testing		
3	Shear Vane readings are converted readings, as per calibration Certificate. (Values are undrained shear strength)		
4	Shear Vane records include Re-moulded values where possible		
5	Shear Vane Serial No.: 2086	Exp. Date: 2/06/2021	Rev2.8



Project Name Chedworth Properties, Area M, Stage 15		Job Ref. 171738-AREA-M-S15-01	
Tested by GetGeo	Date 16/04/2021	Sheet No. 22	Test Site Lot 425

Depth (mm)	Undrained Shear (kPa)	No of blows /100mm	Scala Penetrometer (Blows/100mm)		Soil Description	Water Table
			0	2 4 6 8 10 12 14 16		
100		7			FILL, topsoil, gravels	
200		8				
300		15			dense	
400		16				
500		20			Engineered FILL, silt, sand, some gravels	
600		UTP			mixed light-brown, moist	
700					some gravels, sand	
800						
900		UTP			difficult to machine auger	
1000					difficult to extract	
1100						
1200		5			medium dense to dense	
1300		5				
1400		3			Silty SAND, orange-brown, moist	
1500		4			minor silt	
1600		6			some fine gravels	
1700		11				
1800		10				
1900		8				
2000		8				
2100					EOB @ 2.0m	
2200					Target Depth	
2300						
2400						
Notes:	EOB = End Of Borehole	UTP = Unable To Penetrate	UTE = Unable To Extract
1	Weather leading up to test was recent rain and cool weather. Fine during testing		
2	Ground water was not encountered during testing		
3	Shear Vane readings are converted readings, as per calibration Certificate. (Values are undrained shear strength)		
4	Shear Vane records include Re-moulded values where possible		
5	Shear Vane Serial No.: 2086	Exp. Date: 2/06/2021	



Project Name Chedworth Properties, Area M, Stage 15		Job Ref. 171738-AREA-M-S15-01	
Tested by GetGeo	Date 16/04/2021	Sheet No. 23	Test Site Lot 426

Depth (mm)	Undrained Shear (kPa)	No of blows /100mm	Scala Penetrometer (Blows/100mm)		Soil Description	Water Table
			0	2 4 6 8 10 12 14 16		
100		2			FILL, topsoil, gravels	
200		3			very stiff Engineered FILL, silt, minor clay, yellow-brown, moist	
300	204+ / -	3				
400		4				
500		4				
600	204+ / -	5				
700		4				
800		4				
900	204+ / -	4				
1000		6				
1100		6				
1200	204+ / -				hard	
1300					SILT, minor clay, dark orange-brown, moist becoming yellow-brown creamy pinkish brown	
1400						
1500	146 / 41					
1600						
1700						
1800						
1900						
2000	70 / 35					
2100						
2200						
2300					EOB @ 2.0m Target Depth	
2400						
2500						
2600						
2700						
2800						
2900						
3000						
3100						
3200						
3300						
3400						
3500						

Notes:	EOB = End Of Borehole	UTP = Unable To Penetrate	UTE = Unable To Extract
1	Weather leading up to test was recent rain and cool weather. Fine during testing		
2	Ground water was not encountered during testing		
3	Shear Vane readings are converted readings, as per calibration Certificate. (Values are undrained shear strength)		
4	Shear Vane records include Re-moulded values where possible		
5	Shear Vane Serial No.: 2086	Exp. Date: 2/06/2021	Rev2.8



Project Name Chedworth Properties, Area M, Stage 15		Job Ref. 171738-AREA-M-S15-01	
Tested by GetGeo	Date 16/04/2021	Sheet No. 24	Test Site Lot 427

Depth (mm)	Undrained Shear (kPa)	No of blows /100mm	Scala Penetrometer (Blows/100mm)		Soil Description	Water Table
			0	2 4 6 8 10 12 14 16		
100		2			FILL, topsoil, gravels	
200		2				
300	204+ / -	3			dense to very dense	
400		7			hand auger to 900mm	
500		4			Engineered FILL, silt, minor clay	
600	UTP	5			orange-brown, moist	
700		4				
800		5				
900	204+ / -	4				
1000		4			hard	
1100		4				
1200	204+ / -				SILT, minor clay, light grey-brown, moist	
1300					minor orange mottling	
1400						
1500	204+ / -					
1600						
1700					pinkish creamy-brown	
1800						
1900						
2000	181 / 70					
2100					EOB @ 2.0m	
2200					Target Depth	
2300						
2400						
Notes:	EOB = End Of Borehole	UTP = Unable To Penetrate	UTE = Unable To Extract
1	Weather leading up to test was recent rain and cool weather. Fine during testing		
2	Ground water was not encountered during testing		
3	Shear Vane readings are converted readings, as per calibration Certificate. (Values are undrained shear strength)		
4	Shear Vane records include Re-moulded values where possible		
5	Shear Vane Serial No.: 2086	Exp. Date: 2/06/2021	Rev2.8



Project Name Chedworth Properties, Area M, Stage 15		Job Ref. 171738-AREA-M-S15-01	
Tested by GetGeo	Date 16/04/2021	Sheet No. 25	Test Site Lot 428

Depth (mm)	Undrained Shear (kPa)	No of blows /100mm	Scala Penetrometer (Blows/100mm)		Soil Description	Water Table
			0	2 4 6 8 10 12 14 16		
100					FILL, respread topsoil, gravels	
200						
300	204+ / -				hard	
400					Engineered FILL, clay, orange-brown, moist	
500					hand auger to 900mm	
600	204+ / -					
700					hard	
800					SILT, minor fine sand, yellow-brown, moist	
900	204+ / -					
1000						
1100						
1200	204+ / -					
1300					light yellow-brown, some orange-mottling	
1400						
1500	204+ / -				creamy grey-brown	
1600						
1700					1700-1800mm manganese mottling, yellow-brow, sandy texture	
1800						
1900					dark orange-brown, very moist	
2000	163 / 32					
2100					EOB @ 2.0m	
2200					Target Depth	
2300						
2400						
Notes:	EOB = End Of Borehole	UTP = Unable To Penetrate	UTE = Unable To Extract
1	Weather leading up to test was recent rain and cool weather. Fine during testing		
2	Ground water was not encountered during testing		
3	Shear Vane readings are converted readings, as per calibration Certificate. (Values are undrained shear strength)		
4	Shear Vane records include Re-moulded values where possible		
5	Shear Vane Serial No.: 2086	Exp. Date: 2/06/2021	Rev2.8



Project Name Chedworth Properties, Area M, Stage 15		Job Ref. 171738-AREA-M-S15-01	
Tested by GetGeo	Date 16/04/2021	Sheet No. 26	Test Site Lot 429

Depth (mm)	Undrained Shear (kPa)	No of blows /100mm	Scala Penetrometer (Blows/100mm)		Soil Description	Water Table
			0	2 4 6 8 10 12 14 16		
100		2			FILL, topsoil, gravels	
200		2				
300	UTP	3			SILT, orange-brown, moist	
400		3			hard	
500		3			very stiff	
600	UTP	5				
700		5			SILT, minor sand, yellow-brown, moist	
800		4				
900	204+ / -	5				
1000		6			clayey Silt, orange-brown, moist	
1100		5				
1200	204+ / -					
1300						
1400					1400-1700mm grey-brown	
1500	160 / 44					
1600					creamy-brown, heavy orange-mottling	
1700						
1800					minor mottling, very moist	
1900						
2000	204+ / -					
2100					EOB @ 2.0m	
2200					Target Depth	
2300						
2400						
Notes:	EOB = End Of Borehole	UTP = Unable To Penetrate	UTE = Unable To Extract
1	Weather leading up to test was recent rain and cool weather. Fine during testing		
2	Ground water was not encountered during testing		
3	Shear Vane readings are converted readings, as per calibration Certificate. (Values are undrained shear strength)		
4	Shear Vane records include Re-moulded values where possible		
5	Shear Vane Serial No.: 2086	Exp. Date: 2/06/2021	Rev2.8



Project Name Chedworth Properties, Area M, Stage 15		Job Ref. 171738-AREA-M-S15-01	
Tested by GetGeo	Date 16/04/2021	Sheet No. 27	Test Site Lot 430

Depth (mm)	Undrained Shear (kPa)	No of blows /100mm	Scala Penetrometer (Blows/100mm)		Soil Description	Water Table
			0	2 4 6 8 10 12 14 16		
100		1			FILL, topsoil, gravels	
200		2				
300	UTP	2			hard	
400		3			Engineered FILL, silt, mixed browns, moist	
500		2			hand auger to 900mm	
600	163 / 53	3				
700		4				
800		3			hard	
900	204+ / -	2			SILT, minor clay, dark brown, moist	
1000		3				
1100		4				
1200	152 / 50					
1300					some clay, brown	
1400						
1500	204+ / -					
1600						
1700						
1800					light-brown	
1900						
2000	181 / 64					
2100					EOB @ 2.0m	
2200					Target Depth	
2300						
2400						
Notes:	EOB = End Of Borehole	UTP = Unable To Penetrate	UTE = Unable To Extract
1	Weather leading up to test was recent rain and cool weather. Fine during testing		
2	Ground water was not encountered during testing		
3	Shear Vane readings are converted readings, as per calibration Certificate. (Values are undrained shear strength)		
4	Shear Vane records include Re-moulded values where possible		
5	Shear Vane Serial No.: 2086	Exp. Date: 2/06/2021	Rev2.8



Project Name Chedworth Properties, Area M, Stage 15		Job Ref. 171738-AREA-M-S15-01	
Tested by GetGeo	Date 16/04/2021	Sheet No. 28	Test Site Lot 431a

Depth (mm)	Undrained Shear (kPa)	No of blows /100mm	Scala Penetrometer (Blows/100mm)		Soil Description	Water Table
			0	2 4 6 8 10 12 14 16		
100		1			FILL, topsoil, gravels	
200		2				
300	204+ / -	6			dense	
400		3				
500		4			Engineered FILL, silt, some sand, mixed creamy- light-brown	
600	204+ / -	3			moist	
700		4				
800		2			700-900mm minor topsoil	
900	204+ / -	3				
1000		2			minor fine sand	
1100		2			very stiff	
1200	204+ / -				SILT, minor fine sand, creamy light-brown, moist	
1300						
1400						
1500	UTP					
1600						
1700						
1800						
1900					Silty SAND, creamy orange-brown, moist	
2000					grey-brown, very moist	
2100					EOB @ 2.0m	
2200					Target Depth	
2300						
2400						
Notes:	EOB = End Of Borehole	UTP = Unable To Penetrate	UTE = Unable To Extract
1	Weather leading up to test was recent rain and cool weather. Fine during testing		
2	Ground water was not encountered during testing		
3	Shear Vane readings are converted readings, as per calibration Certificate. (Values are undrained shear strength)		
4	Shear Vane records include Re-moulded values where possible		
5	Shear Vane Serial No.: 2086	Exp. Date: 2/06/2021	Rev2.8



Project Name Chedworth Properties, Area M, Stage 15		Job Ref. 171738-AREA-M-S15-01	
Tested by GetGeo	Date 16/04/2021	Sheet No. 29	Test Site Lot 431b

Depth (mm)	Undrained Shear (kPa)	No of blows /100mm	Scala Penetrometer (Blows/100mm)		Soil Description	Water Table
			0	2 4 6 8 10 12 14 16		
100		2			FILL, topsoil, gravels	
200		2				
300	166 / 76	3			very stiff	
400		3				
500		4			Engineered FILL, silt, minor clay, dark orange-brown moist	
600	204+ / -	3			minor angular gravels	
700		3			minor topsoil	
800		4				
900	128 / 35	3				
1000		3				
1100		2				
1200	204+ / -					
1300						
1400						
1500	UTP				hard	
1600					Engineered FILL, silt, sand, some angular gravels mixed dark-grey and grey-brown, moist	
1700						
1800						
1900						
2000	UTP					
2100						
2200						
2300					SAND, minor silt, dark grey, very moist	
2400						
2500					EOB @ 2400mm	
2600						
2700						
2800						
2900						
3000						
3100						
3200						
3300						
3400						
3500						

Notes:	EOB = End Of Borehole	UTP = Unable To Penetrate	UTE = Unable To Extract
1	Weather leading up to test was recent rain and cool weather. Fine during testing		
2	Ground water was not encountered during testing		
3	Shear Vane readings are converted readings, as per calibration Certificate. (Values are undrained shear strength)		
4	Shear Vane records include Re-moulded values where possible		
5	Shear Vane Serial No.: 2086	Exp. Date: 2/06/2021	



Project Name Chedworth Properties, Area M, Stage 15		Job Ref. 171738-AREA-M-S15-01	
Tested by GetGeo	Date 16/04/2021	Sheet No. 30	Test Site Lot 432a

Depth (mm)	Undrained Shear (kPa)	No of blows /100mm	Scala Penetrometer (Blows/100mm)		Soil Description	Water Table
			0	2 4 6 8 10 12 14 16		
100		1			FILL, topsoil, gravels	
200		1				
300		1				
400		1				
500		1				
600	UTP	2			layer of gravels	medium dense to loose
700		6				
800		4			Engineered FILL, silt, sand, mixed light greys, moist	
900	204+ / -	2				
1000		3				
1100		3				
1200	204+ / -					
1300						
1400						
1500						
1600		UTP			Engineered FILL, sand, gravels, silt, some topsoil dark brown, moist	
1700						
1800						
1900		UTP				
2000					EOB @ 2.0m Target Depth	
2100						
2200						
Notes:	EOB = End Of Borehole	UTP = Unable To Penetrate	UTE = Unable To Extract
1	Weather leading up to test was recent rain and cool weather. Fine during testing		
2	Ground water was not encountered during testing		
3	Shear Vane readings are converted readings, as per calibration Certificate. (Values are undrained shear strength)		
4	Shear Vane records include Re-moulded values where possible		
5	Shear Vane Serial No.: 2086	Exp. Date: 2/06/2021	



Project Name Chedworth Properties, Area M, Stage 15		Job Ref. 171738-AREA-M-S15-01	
Tested by GetGeo	Date 16/04/2021	Sheet No. 31	Test Site Lot 432b

Depth (mm)	Undrained Shear (kPa)	No of blows /100mm	Scala Penetrometer (Blows/100mm)		Soil Description	Water Table
			0	2 4 6 8 10 12 14 16		
100		2			FILL, topsoil, gravels	
200		3			very stiff	
300	143 / 55	5				
400		6			Engineered FILL, silt, minor clay dark brown dark orange-brown, moist	
500		4				
600	178 / 53	4				
700		3				
800		2				
900	131 / 32	2				
1000		2				
1100		2				
1200	204+ / -					
1300						
1400					1700-1800mm some topsoil	
1500	UTP					
1600						
1700						
1800						
1900						
2000	70 / 26					
2100						
2200						
2300						
2400					Gravelly SAND, dark grey, very moist	
2500					EOB @ 2700mm	
2600						
2700						
2800						
2900						
3000						
3100						
3200						
3300						
3400						
3500						

Notes:	EOB = End Of Borehole	UTP = Unable To Penetrate	UTE = Unable To Extract
1	Weather leading up to test was recent rain and cool weather. Fine during testing		
2	Ground water was not encountered during testing		
3	Shear Vane readings are converted readings, as per calibration Certificate. (Values are undrained shear strength)		
4	Shear Vane records include Re-moulded values where possible		
5	Shear Vane Serial No.: 2086	Exp. Date: 2/06/2021	



Project Name Chedworth Properties, Area M, Stage 15		Job Ref. 171738-AREA-M-S15-01	
Tested by GetGeo	Date 16/04/2021	Sheet No. 32	Test Site Lot 433a

Depth (mm)	Undrained Shear (kPa)	No of blows /100mm	Scala Penetrometer (Blows/100mm)		Soil Description	Water Table
			0	2 4 6 8 10 12 14 16		
100		1			FILL, respread topsoil, gravels	
200		2			hard (engineer controlled) FILL, silt, sand, gravels mixed brown, moist	
300		2				
400		4				
500		5				
600		12				
700		UTP				
800						
900						
1000						
1100						
1200	163 / 44					
1300					very stiff	
1400					Sandy SILT, creamy light-brown, moist	
1500						
1600		11				
1700		14			Silty SAND. Light-brown, moist	
1800		UTP			gravelly Sand, minor silt, dark grey, very moist	
1900						
2000						
2100					EOB @ 2.0m	
2200					Target Depth	
2300						
2400						
Notes:	EOB = End Of Borehole	UTP = Unable To Penetrate	UTE = Unable To Extract
1	Weather leading up to test was recent rain and cool weather. Fine during testing		
2	Ground water was not encountered during testing		
3	Shear Vane readings are converted readings, as per calibration Certificate. (Values are undrained shear strength)		
4	Shear Vane records include Re-moulded values where possible		
5	Shear Vane Serial No.: 2086	Exp. Date: 2/06/2021	



Project Name Chedworth Properties, Area M, Stage 15		Job Ref. 171738-AREA-M-S15-01	
Tested by GetGeo	Date 16/04/2021	Sheet No. 33	Test Site Lot 433b

Depth (mm)	Undrained Shear (kPa)	No of blows /100mm	Scala Penetrometer (Blows/100mm)		Soil Description	Water Table
			0	2 4 6 8 10 12 14 16		
100		1			FILL, topsoil, gravels	
200		5				
300		7				
400		11				
500		14			Engineered FILL, silt, sand, gravels	
600		8				
700		15			mixed brown and orange-brown, moist	
800		21			minor topsoil	
900		UTP				
1000						
1100						
1200						
1300						
1400		UTP				
1500		14				
1600		18			Engineered FILL, sand, gravels, minor silt	
1700		11			dark reddish brown, moist	
1800		8				
1900		17				
2000						
2100					EOB @ 2.0m	
2200					Target Depth	
2300						
2400						
Notes:	EOB = End Of Borehole	UTP = Unable To Penetrate	UTE = Unable To Extract
1	Weather leading up to test was recent rain and cool weather. Fine during testing		
2	Ground water was not encountered during testing		
3	Shear Vane readings are converted readings, as per calibration Certificate. (Values are undrained shear strength)		
4	Shear Vane records include Re-moulded values where possible		
5	Shear Vane Serial No.: 2086	Exp. Date: 2/06/2021	

Appendix V Stormwater Management
On-lot Water Efficiency Measures
Lot Levels (Minimum Lot Levels)

ON-LOT WATER EFFICIENCY MEASURES

WATER SUPPLY AND WASTEWATER DISPOSAL

The efficiency of taps, showers and toilets contribute to how much water we use. A reduction in the use of potable water by each house directly relates to the amount of wastewater generated (i.e. reduced water use results in reduced wastewater generation). To reduce potable water demand and the amount of wastewater generated, as a minimum, each house is required to install low demand fittings for kitchen, bathroom and laundry facilities.


All household fittings are required to have a minimum 3 Star Rating.

STORMWATER DISPOSAL

Each lot is required to adopt an on-lot stormwater efficiency measure to ensure that surface water runoff is appropriately managed.

First, the suitability of the site for soakage needs to be assessed. Soakage is the process of helping stormwater soak into the ground using specially designed soakage devices. Soakage allows for the infiltration of stormwater into the soil which recharges the groundwater table below.

A site infiltration test is mandatory for all lots to confirm the in-situ soils are capable of achieving the minimum percolation rates. Refer to Hamilton City Council 'Three Waters Practice Note HCC 03: Soakage' for guidance on soil testing.

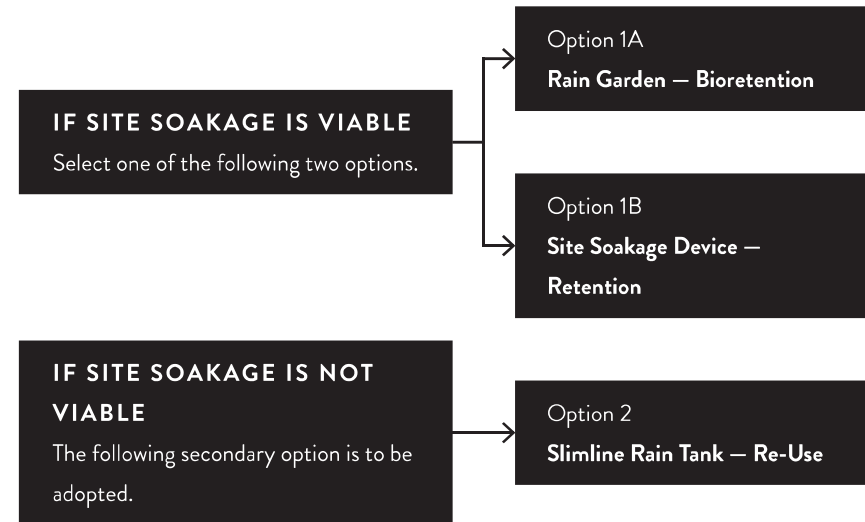

* Other alternative stormwater efficiency options will also be considered subject to approval by Greenhill Park and Hamilton City Council.

The selected option is to be designed by a suitably qualified Engineer and approved by the Hamilton City Council Building Control Unit. Refer to page 33 to 36 of these guidelines for further information of the design requirements for Options 1A, 1B & 2.

Hamilton City Council also encourages the installation of multiple stormwater efficiency options within a property, where practical.

Option 1A

RAIN GARDEN – BIORETENTION

Design to provide minimum 'live storage' retention for runoff from a 10mm rainfall event for trafficked hardstand areas.

The following table outlines indicative storage volumes and estimated rain garden areas for a range of lot sizes.

Lot Area (m ²)	Live Storage Volume (m ³)	Rain Garden Area (m ²)
300	0.8	4.1
350	0.9	4.7
400	1.1	5.4
450	1.2	6.1
500	1.4	6.8
550	1.5	7.4

Based on hardstand coverage equal to 30% of total lot area

KEY REQUIREMENTS

- Rain garden to be located to capture runoff from main hardstand areas within the lot (as much as practical).
- Maximum live storage depth to be 300mm (safety requirements to be considered when device is at maximum storage capacity).
- A channel and grate to be installed across vehicle entrance to capture hardstand run off and direct it to rain garden.

- Rain garden to be integrated with garden design (refer to page 34 for details).
- Overflow to be connected to stormwater connection provided.

FOR MORE INFORMATION

Refer to Hamilton City Council 'Three Waters Practice Note – HCC04 – Bio-retention (Rain Gardens)' for information on typical design requirements.

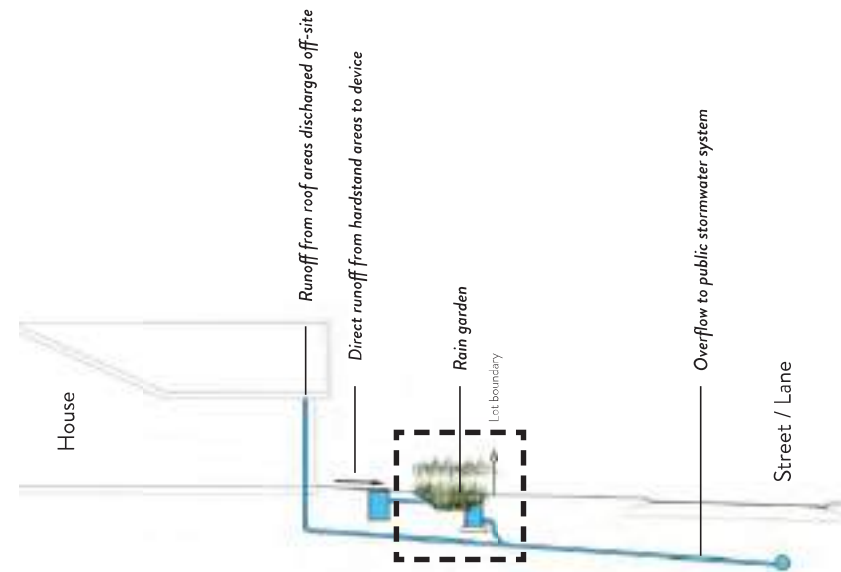


DIAGRAM – 7
Rain Garden – Bioretention

GREENHILL PARK RAIN GARDEN PLANT LIST

Native plants are encouraged, but other exotic plant species which complement your front yard planting design could be used. Deciduous plants should not be used as their leaf-fall can block the outflow.

The plants selected need to —

- Be able to tolerate short periods of inundation and longer dry periods
- Be perennial rather than annual
- Have deep fibrous root systems and a spreading growth form
- Form a dense, weed-suppressing cover



Botanical Name	Common Name
Apodasmia similis	oioi
Blechnum penna-marina	alpine hard fern
Libertia ixioides	mikoikoi
Carex dipsacea	teasel sedge
Carex secta	purei
Carex virgata	pukio
Dianella nigra	turutu
Libertia grandiflora	mikoikoi
Lobelia angulata	panakenake
Pimelea prostrata	pinatoro

All rain garden plants to be a minimum grade of Pb 8 at the time of planting. * Other plant species can be approved at the discretion of the Design Review Panel.

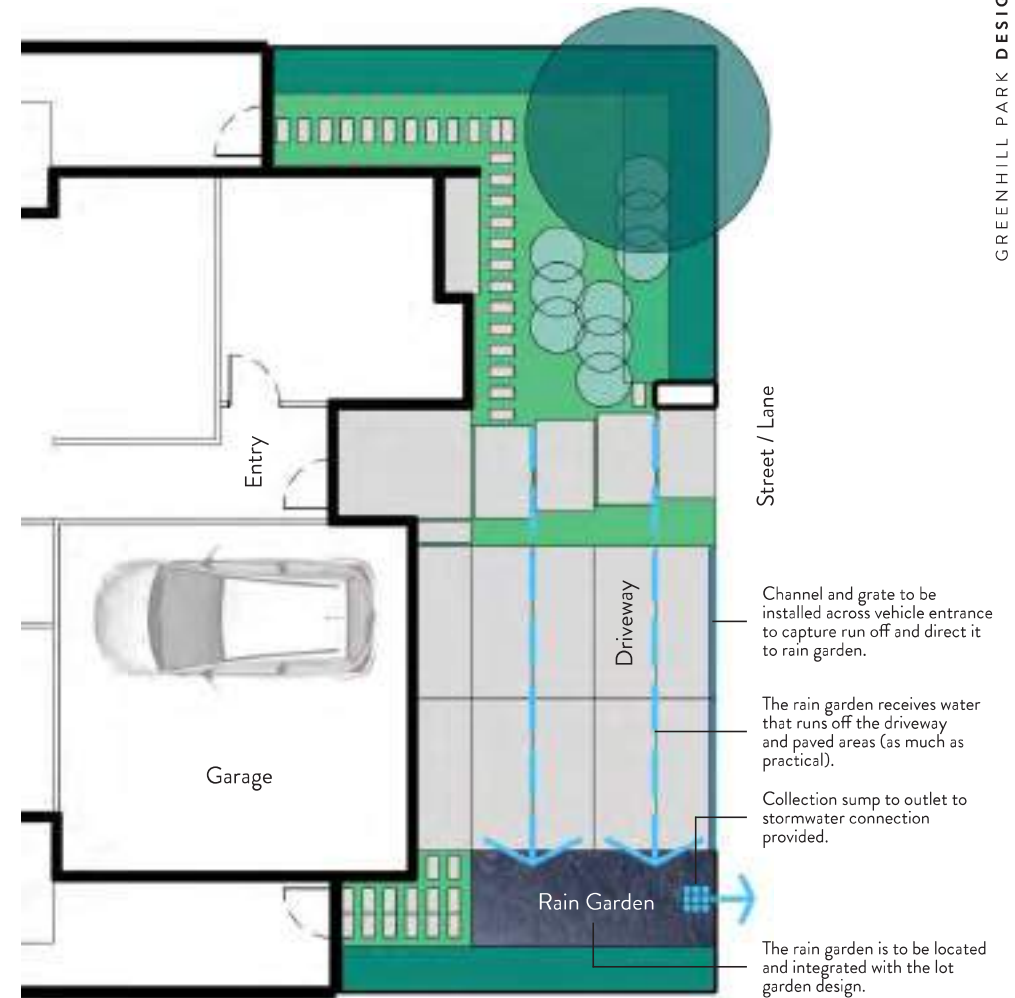


DIAGRAM — 8
Rain Garden Typical Location

Option 1B

SITE SOAKAGE DEVICE – RETENTION

Design to provide minimum 'live storage' retention for runoff from a 10mm rainfall event for roof and trafficked hardstand areas.

The following table outlines indicative storage volumes for a range of lot sizes.

Lot Area (m ²)	Live Storage Volume (m ³)
300	2.2
350	2.6
400	3.0
450	3.4
500	3.7
550	4.1

Based on 80% site coverage (roof and hardstand areas)

KEY REQUIREMENTS

- Soakage device(s) to be located to capture runoff from roof downpipes and hardstand areas (as much as practical).
- A channel and grate to be installed across vehicle entrance to capture hardstand run off and direct it to soakage device.
- Soakage device to be integrated with garden design.
- Overflow to be connected to stormwater connection provided.

FOR MORE INFORMATION

Refer to Hamilton City Council 'Three Waters Practice Note HCC 03: Soakage' for information on typical design requirements.

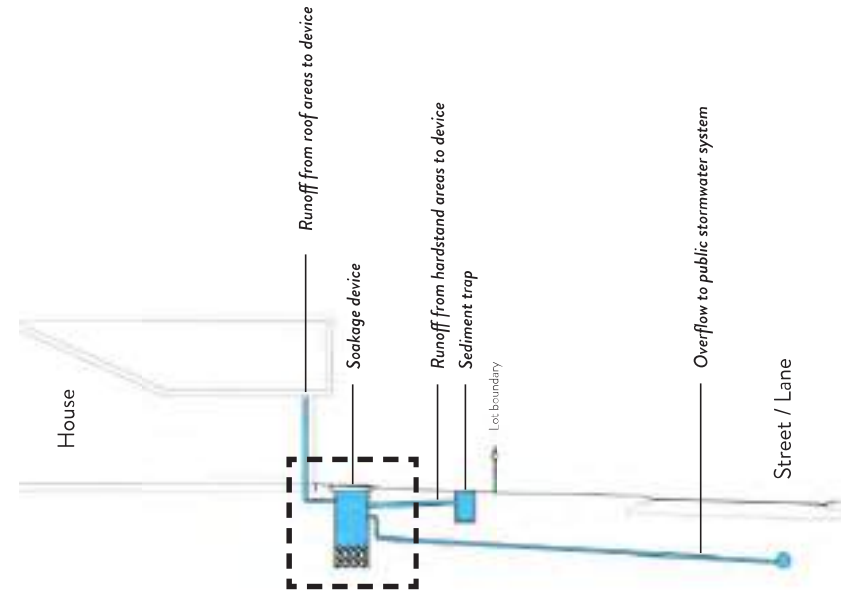


DIAGRAM — 9
Site Soakage Device – Retention

Option 2

SLIMLINE RAIN TANK – RE-USE

The slimline rain tank is to be connected to a separate grey-water household re-use system with a minimum capacity of 5,000L.

KEY REQUIREMENTS

- Rain tank to be connected into a fully integrated grey-water re-use system within the main dwelling with connections to toilets, laundry and irrigation systems.
- All roof run-off is to be captured by rain tanks and available for re-use. Run-off from hardstand areas (driveways and paving) can be discharged directly into stormwater connection provided.
- A maximum of two (2) tanks may be used to achieve the required storage and align with downpipe locations.
- Overflow to be connected to stormwater connection provided.

LOCATION AND INSTALLATION

Slimline rain tanks should be placed in the rear or side yard of the lot as unobtrusively as possible. Care should be taken, where tanks are placed next to the house, to ensure they are placed adjacent to a blank wall and not in front of a window.

COLOUR

The colour of all rain tanks should match the colour of the homes exterior wall cladding adjacent to the tank.

* Colours that do not match but are complementary to the design and materials of the house can be approved at the discretion of the Design Review Panel.

FOR MORE INFORMATION

Refer to Hamilton City Council 'Three Waters Practice Note – HCC02 – Rainwater Re-use Systems (Rain Tanks)' for information on design requirements.

APPROVED RAIN TANK PRODUCTS

Tanksalot® Slimline Tank www.tanksalot.co.nz

ThinTanks™ NZ Slimline Rainwater Poly Tank www.thintanks.co.nz

* Other rain tank products will also be considered subject to approval by Greenhill Park.

Note below ground tanks (sealed tanks only) are also considered an appropriate design option and are pre-approved for use on this subdivision.

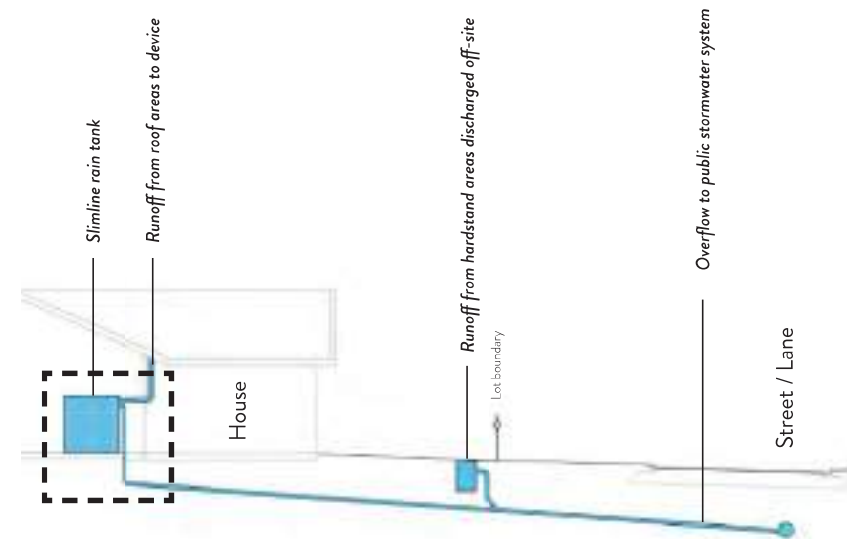


DIAGRAM – 10
Slimline Rain Tank – Re-use

Lot	Stage	Minimum Lot Level (mRL)	1% AEP Flood Level (mRL)	Flood Level Reference	Calculated Freeboard (to Lot Level)
388	14	39.428	38.00	Swale 1D	1.428
389	14	39.316	38.00	Swale 1D	1.316
390	14	39.191	38.00	Swale 1D	1.191
391	14	39.419	38.00	Swale 1D	1.419
392	14	39.409	38.00	Swale 1D	1.409
393	14	39.325	36.40	Swale 3A	2.925
394	14	39.214	36.40	Swale 3A	2.814
395	14	39.130	36.40	Swale 3A	2.730
396	15	39.127	36.40	Swale 3A	2.727
397	15	39.222	36.40	Swale 3A	2.822
398	15	39.318	36.40	Swale 3A	2.918
399	15	39.429	38.00	Swale 1D	1.429
400	15	39.414	38.00	Swale 1D	1.414
401	15	38.923	38.00	Swale 1D	0.923
402	15	39.946	38.00	Swale 1D	1.946
403	15	39.233	38.00	Swale 1D	1.233
404	15	39.309	38.00	Swale 1D	1.309
405	15	39.278	38.00	Swale 1D	1.278
406	15	38.925	38.00	Swale 1D	0.925
407	15	39.339	38.00	Swale 1D	1.339
408	15	39.607	38.00	Swale 1D	1.607
409	15	39.358	36.46	Swale 3B	2.898
410	15	39.288	36.46	Swale 3B	2.828
411	15	39.215	36.46	Swale 3B	2.755
412	15	39.138	36.46	Swale 3B	2.678
413	15	39.057	36.46	Swale 3B	2.597
414	15	39.151	36.46	Swale 3B	2.691
415	15	39.231	36.46	Swale 3B	2.771
416	15	39.311	36.46	Swale 3B	2.851
417	15	39.391	36.46	Swale 3B	2.931
418	15	39.471	36.46	Swale 3B	3.011
419	15	39.544	38.00	Swale 1D	1.544
420	15	39.811	38.00	Swale 1D	1.811
421	15	39.930	35.46	Swale 3B	4.470
422	15	39.825	36.46	Swale 3B	3.365
423	15	39.741	36.46	Swale 3B	3.281
424	15	39.657	37.46	Swale 3B	2.197
425	15	39.571	38.46	Swale 3B	1.111
426	15	40.020	38.00	Swale 1D	2.020
427	15	39.908	38.00	Swale 1D	1.908
428	15	39.748	38.00	Swale 1D	1.748

Lot	Stage	Minimum Lot Level (mRL)	1% AEP Flood Level (mRL)	Flood Level Reference	Calculated Freeboard (to Lot Level)
429	15	39.696	38.00	Swale 1D	1.696
430	15	39.589	38.00	Swale 1D	1.589
431	15	39.472	38.00	Swale 1D	1.472
432	15	39.320	38.00	Swale 1D	1.320
433	15	39.144	38.00	Swale 1D	1.144

APPENDIX 2

Roading QA Documentation

Road Subgrade – 2(a)

- Drawing 21879-M-12-BR1 (in lieu of strings)
- Clegg Hammer Tests

Road Basecourse 2(b)

- Nuclear Densometer Results
- Benkelman Beam Test Results
- Basecourse Strings
- GAP40 Material Tests

Surfacing & RAMM Data 2(c)

- HCC pavement RAMM data
- Surfacing RAMM data



APPENDIX 2(a)

Roading QA Documentation

Road Subgrade

- Drawing 21879-M-15-BR1 (in lieu of strings)
- Clegg Hammer Tests




NOTES:


DEPTHS CALCULATED FROM
ONLINE CONSTRUCTORS
MEASUREMENTS V DESIGN
SURFACE.

TARGET DEPTHS
GOSSET AVENUE 0.23m
COULDSACK AVENUE 0.23m

MEASUREMENTS TAKEN
TO BROWNROCK SUBGRADE
IMPROVEMENT LAYER

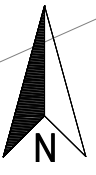

STAGE 12

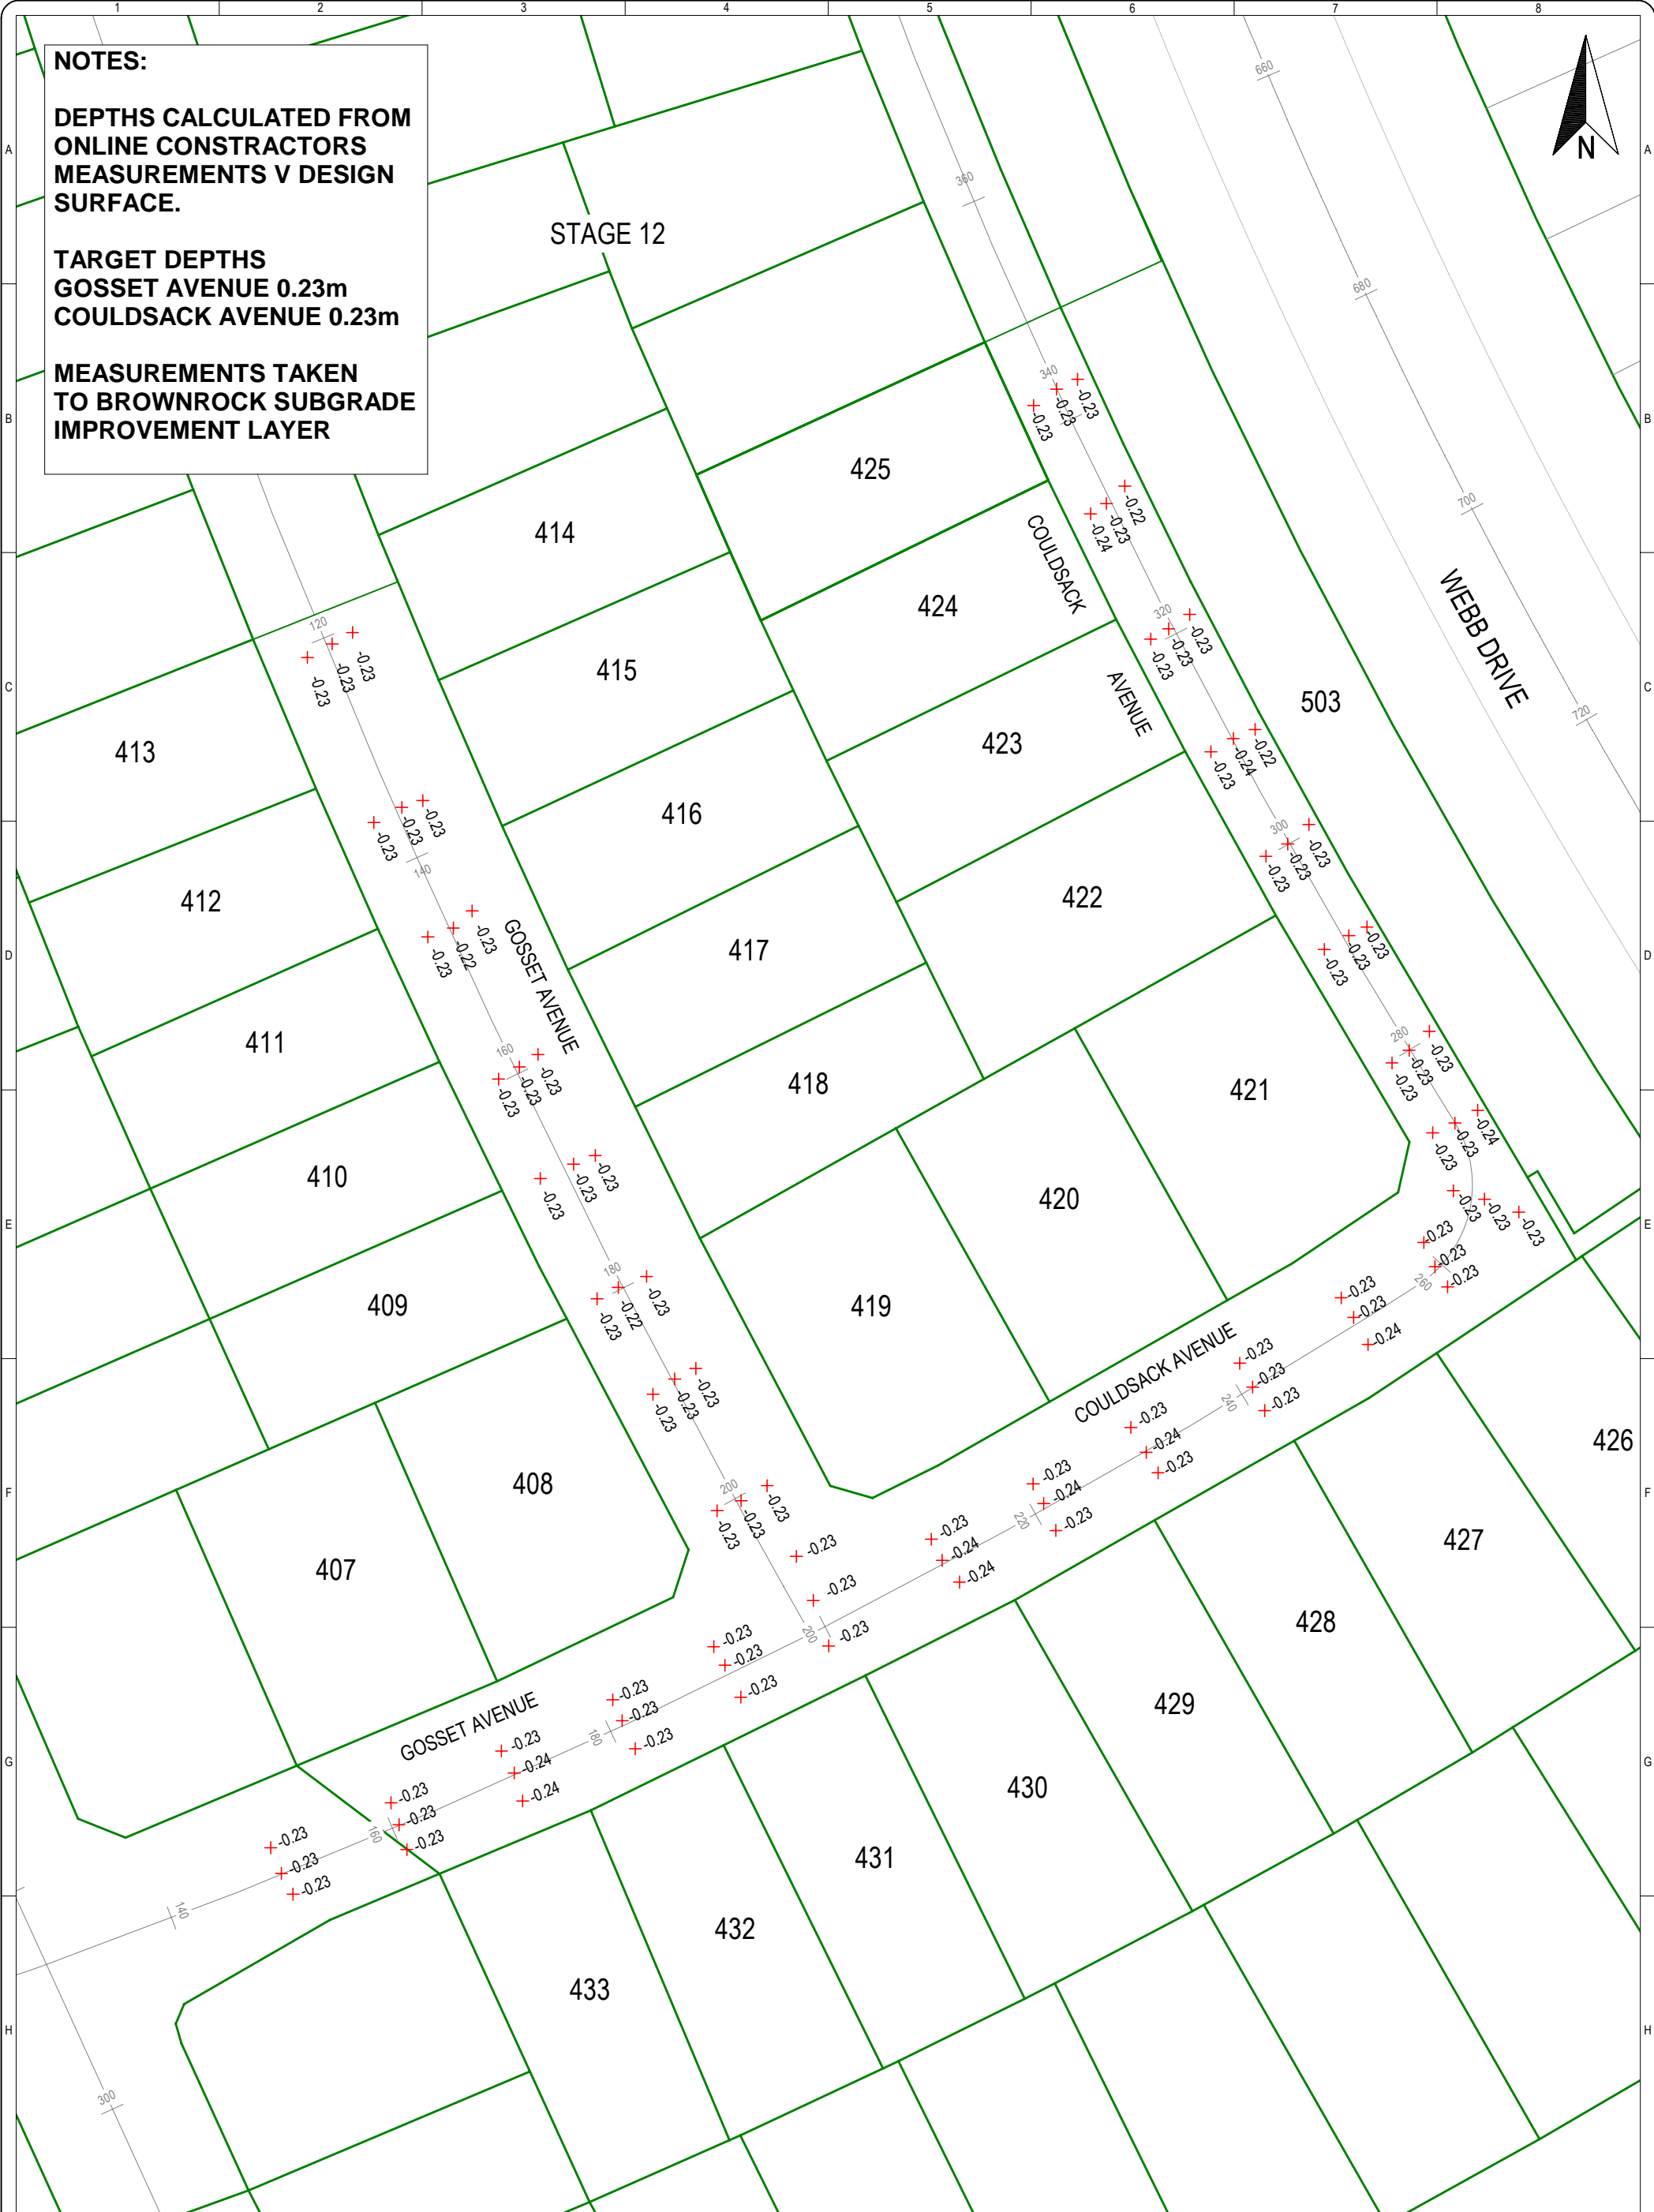

S&L
Land Development
and Design Specialists
Ph. 07 577 6069
Email: info@stlga.co.nz
36 Kereiti Street, Mt Maunganui, Tauranga 3116
P.O. Box 231, Tauranga 3140
www.stlga.co.nz

Title

QUALITY ASSURANCE
COMPARISON OF BROWNROCK V DESIGN
ROADING LAYOUT
STAGE 15 AREA M

Rev	Description	Drn	Ckd	App	Date
AB	ISSUE TO HCC	SRC	BE	NF	03/21
0	INTERNAL REVIEW	SRC	BE	NF	03/21
	Name	Date	Name	Date	
Surveyed	Online	03/2021	Designed		

Coordinate System: Mt Eden 2000 Circuit	
Origin of Coordinates: ALP 3 DP 534481	
Height Datum: Moturiki Vertical Datum 1953	
Origin of Height: SS 507 SO 42451 RL = 44.04m	
Original Scales @ A3	Status
1:500	AS-BUILT
Do Not Scale Dimensions	
Drawing No	Revision
21879-M-15-BR1	AB

Copyright on this drawing is reserved



P O Box 21187, Rototuna
 Hamilton, 3256
 Email: Todd@onlinecontractors.co.nz
 Ph: 07 853 9422

COMPACTION - CLEGG TESTS

Contract	GHP	Job No.	
Site/Chainage	Road 37 Stage 15	Date	22/01/021
Material	Brown Rock SIL	Recorded by	Bikal Baniya

Chn	1m from kerb - Left	Centre Line	1m from kerb - Right	Notes
270	30			
280			25	
290	22			
300			29	
310	27			
320			39	
330	23			
340			36	

Source of conversion: $Inferred\ CBR\% = 0.07(Impact\ Value)^2 / 100$

Remarks _____



P O Box 21187, Rototuna
 Hamilton, 3256
 Email: Todd@onlinecontractors.co.nz
 Ph: 07 853 9422

COMPACTION - CLEGG TESTS

Contract	<u>GHP</u>	Job No.	
Site/Chainage	<u>Road 38 Stage 15</u>	Date	<u>22/01/021</u>
Material	<u>Brown Rock SIL</u>	Recorded by	<u>Bikal Baniya</u>

Chn	1m from kerb -	Centre Line	1m from kerb - Right	Notes
130	27			
140			24	
150	21			
160			31	
170	27			
180			26	
190	20			
200			33	

Source of conversion: $Inferred\ CBR\% = 0.07(Impact\ Value)^2 / 100$

Remarks _____

APPENDIX 2(b)

Roading QA Documentation

Road Basecourse

- Nuclear Densometer Results
- Benkelman Beam Test Results
- Basecourse Strings
- GAP40 Material Tests
- S&L/HCC Correspondence regarding kerb and pavement changes



COMPACTION - CLEGG TESTS

Contract	GHP	Job No.	
Site/Chainage	Road 22 Stage 15	Date	12/03/21
Material	AP 40	Recorded by	Bikal Baniya

Chn	1m from kerb - Left	Centre Line	1m from kerb - Right	Notes
160	51			
170		59		
180			43	
210	48			
220		49		
230			53	
240	56			
250		47		
260			42	

Source of conversion: $Inferred\ CBR\% = 0.07 (Impact\ Value)^2 / 100$

Remarks _____

BASECOURSE COMPACTION CONTROL
TNZ - B2 TEST RESULTS



Project : Greenhill Park
Location : Road 22
Client : Online Contractors Ltd
Contractor : Online Contractors Ltd
Tested by : G Tait
Date tested : 15/03/21

Sample description : GAP40 ex Stevensons Tauhei
Nuclear densometer no : 33576
Solid density (tested) : 2.73 t/m³
Max dry density (tested) : 2.22 t/m³
Opt. water content (tested) : 7.5 %

Project No : 2-68015.00
Lab Ref No : HA7050_1
Client Ref No : Road 22.

Nuclear Densometer Test Results												
Test Number	1	2	3	4	5	6	7	8	9	10	11	12
Test Position	150	160	170	180	188	210	220	230	240	250	260	270
Offset	LHS	RHS	LHS	RHS	LHS	RHS	LHS	RHS	LHS	RHS	LHS	RHS
Probe Depth (mm)	B/S	B/S	B/S	B/S	B/S	B/S	B/S	B/S	B/S	B/S	B/S	B/S
Wet Density (t/m ³)	2.28	2.29	2.28	2.26	2.26	2.32	2.31	2.26	2.28	2.27	2.27	2.26
Dry Density (t/m ³)	2.19	2.18	2.17	2.16	2.17	2.20	2.19	2.15	2.17	2.16	2.18	2.15
Water Content (%)	4.0	5.3	4.9	4.7	4.5	5.3	5.4	4.9	5.3	4.7	4.4	5.1
% of MDD	99	98	98	97	98	99	99	97	98	97	98	97
% Saturation	44	57	52	49	47	61	60	50	55	49	47	52

Concrete Intersection

Oven Corrected Test Results												
Dry Density (t/m ³)												
Water Content (%)												
% of MDD												
% Saturation												

Test Methods	Notes
In situ Density : NZS 4407 : 2015, Test 4.3 for Backscatter Mode	Max dry density from 1 HA6289/2 Sept 2020 (WSP Lab)

This report may only be reproduced in full

IANZ Approved Signatory
Designation : Laboratory Manager
Date : 16/03/21



All tests reported herein have been performed in accordance with the laboratory's scope of accreditation

BASECOURSE COMPACTION CONTROL
TNZ - B2 TEST RESULTS



Project: Greenhill Park
 Location: Road 37
 Client: Online Contractors Ltd
 Contractor: Online Contractors Ltd
 Tested by: G Tait
 Date tested: 15/03/21

Sample description: GAP40 ex Stevensons Tauhei
 Nuclear densometer no: 33576
 Solid density (tested): 2.73 t/m³
 Max dry density (tested): 2.22 t/m³
 Opt. water content (tested): 7.5 %

Project No: 2-68015.00
 Lab Ref No: HA7050_2
 Client Ref No: Road 37

Nuclear Densometer Test Results							
Test Number	1	2	3	4	5	6	7
Test Position	280	270	260	250	240	230	220
Offset	RHS	LHS	RHS	LHS	RHS	LHS	RHS
Probe Depth (mm)	B/S	B/S	B/S	B/S	B/S	B/S	B/S
Wet Density (t/m ³)	2.27	2.24	2.29	2.22	2.34	2.26	2.31
Dry Density (t/m ³)	2.18	2.16	2.18	2.13	2.23	2.17	2.20
Water Content (%)	4.2	4.1	5.2	4.4	5.0	4.2	5.1
% of MDD	98	97	98	96	100	98	99
% Saturation	45	42	56	42	61	45	58

Oven Corrected Test Results							
Dry Density (t/m ³)							
Water Content (%)							
% of MDD							
% Saturation							

Test Methods	Notes
Insitu Density : NZS 4407 : 2015, Test 4.3 for Backscatter Mode	Max dry density from : HA6289/2 Sept 2020 (WSP Lab)

This report may only be reproduced in full

IANZ Approved Signatory

Designation: Laboratory Manager
 Date: 16/03/21

Date reported: 16/03/21



All tests reported herein have been performed in accordance with the laboratory's scope of accreditation

BASECOURSE COMPACTION CONTROL
TNZ - B2 TEST RESULTS



Project : Greenhill Park
 Location : Road 38
 Client : Online Contractors Ltd
 Contractor : Online Contractors Ltd
 Tested by : G Tait
 Date tested : 15/03/21

Sample description : GAP40 ex Stevensons Tauhei
 Nuclear densometer no : 33576
 Solid density (tested) : 2.73 t/m³
 Max dry density (tested) : 2.22 t/m³
 Opt. water content (tested) : 7.5 %

Project No : 2-68015.00
 Lab Ref No : HA7050_3
 Client Ref No : Road 38

Nuclear Densometer Test Results									
Test Number	1	2	3	4	5	6	7	8	9
Test Position	200	190	180	170	160	150	140	130	120
Offset	RHS	RHS*	LHS	RHS	LHS	RHS	LHS	RHS	LHS
Probe Depth (mm)	B/S	B/S	B/S	B/S	B/S	B/S	B/S	B/S	B/S
Wet Density (t/m ³)	2.30	2.23	2.31	2.33	2.24	2.31	2.27	2.31	2.30
Dry Density (t/m ³)	2.18	2.16	2.19	2.21	2.16	2.19	2.16	2.20	2.18
Water Content (%)	5.8	3.6	5.2	5.5	3.9	5.2	5.0	4.6	5.3
% of MDD	98	97	99	100	97	99	97	99	98
% Saturation	62	37	58	64	40	58	52	53	57

Oven Corrected Test Results									
Dry Density (t/m ³)									
Water Content (%)									
% of MDD									
% Saturation									

Test Methods	Notes
In situ Density : NZS 4407 : 2015, Test 4.3 for Backscatter Mode	Max dry density from : HA6289/2 Sept 2020 (WSP Lab)

This report may only be reproduced in full

* Grader on LHS

IANZ Approved Signatory

Designation : Laboratory Manager
 Date : 16/03/21

Date reported : 16/03/21



All tests reported herein have been performed in accordance with the laboratory's scope of accreditation

**BENKELMAN BEAM
TEST REPORT**



Project : Greenhill - Stage 15
 Location : Road 22
 Client : Online Contractors (2016) Limited
 Contractor : Online Contractors (2016) Limited
 Test method : TNZ T/1 1977
 Pavement type : CAP40
 Pavement temp °C : -
 Weight on rear axle : 8.3 tonnes
 Tested by : J. Waru-Savage, C. Brown

Project No : 2-68015.00
 Lab Ref No : HA7058a
 Client Ref :

Test Results				
Location Metres	Deflections (mm)			Comments
	Left WT	Right WT		
160	0.80			
170		0.80		Concrete Pad
180	0.94			
190		0.90		
200				
210		0.60		
220	0.80			
230		1.06		
240	1.06			
250		0.92		
260	1.10			
270		0.80		
	1.06			90 Percentile calculated for all data in columns 1 to 2.

Deflection Statistical Analysis (for all deflections)

Maximum (mm): 1.10 Minimum (mm): 0.60 Average (mm): 0.89

Note: Results in *italics* have a difference between Intermediate and Final readings that are greater than 3 (refer TNZ T/1 1977).

This report may only be reproduced in full

Date tested : 17/03/2021
 Date reported : 17/03/2021

IANZ Approved Signatory

Designation : Senior Civil Engineering Technician
 Date : 17/03/2021



All tests reported herein have been performed in accordance with the laboratory's scope of accreditation

**BENKELMAN BEAM
TEST REPORT**



Project : Greenhill - Stage 15
 Location : Road 37
 Client : Online Contractors (2016) Limited
 Contractor : Online Contractors (2016) Limited
 Test method : TNZ T/1 1977
 Pavement type : GAP40
 Pavement temp °C : -
 Weight on rear axle : 8.3 tonnes
 Tested by : J. Waru-Savage, C. Brown

Project No : 2-68015.00
 Lab Ref No : HA7058b
 Client Ref :

Test Results				
Location Metres	Deflections (mm)			Comments
	Left WT	Right WT		
280	0.70			
290		0.96		
300	0.68			
310		1.14		
320	0.90			
330		0.90		
340	0.84			
	1.03			90 Percentile calculated for all data in columns 1 to 2.

Deflection Statistical Analysis (for all deflections)

Maximum (mm): 1.14	Minimum (mm): 0.68	Average (mm): 0.87
--------------------	--------------------	--------------------

Note: Results in italics have a difference between Intermediate and Final readings that are greater than 3 (refer TNZ T/1 1977)

This report may only be reproduced in full

Date tested : 17/03/2021
 Date reported : 17/03/2021

IANZ Approved Signatory

Designation : Senior Civil Engineering Technician
 Date : 17/03/2021



All tests reported herein have been performed in accordance with the laboratory's scope of accreditation

BENKELMAN BEAM
TEST REPORT



Project : Greenhill - Stage 15
 Location : Road 38
 Client : Online Contractors (2016) Limited
 Contractor : Online Contractors (2016) Limited
 Test method : TNZ T/1 1977
 Pavement type : GAP40
 Pavement temp °C : -
 Weight on rear axle: 8.3 tonnes
 Tested by : J. Waru-Savage, C. Brown

Project No : 2-68015.00
 Lab Ref No : HA7058c
 Client Ref :

Test Results				
Location Metres	Deflections (mm)			Comments
	Left WT	Right WT		
120	0.86			
130		0.70		
140	0.36			
150		0.56		
160	0.56			
170		0.50		
180	0.64			
190		0.80		
200	0.70			
		0.81	90 Percentile calculated for all data in columns 1 to 2.	

Deflection Statistical Analysis (for all deflections)

Maximum (mm): 0.86	Minimum (mm): 0.36	Average (mm): 0.63
--------------------	--------------------	--------------------

Note: Results in italics have a difference between intermediate and Final readings that are greater than 3 (refer TNZ T/1 1977).

This report may only be reproduced in full

Date tested : 17/03/2021
 Date reported : 17/03/2021

IANZ Approved Signatory

Designation : Senior Civil Engineering Technician
 Date : 17/03/2021



All tests reported herein have been performed in accordance with the laboratory's scope of accreditation.

APPENDIX 2(c)

Roading QA Documentation

Surfacing & RAMM Data

- HCC pavement RAMM data
- Surfacing RAMM data



F3.8 RAMM CHIPSEAL DATA

(to be completed for each seal layer on each road section)

Subdivision	<u>GREENHILL PARK - STAGE 15</u>
Road No / Name	<u>ROAD 37 + 38 + 22</u>
Start m	<u>CH 380 (RD 37)</u> Start Description <u>EOS STAGE 12</u>
End m	<u>CH 170 (RD 22)</u> End Description <u>EOS STAGE 14</u>
Width	<u>5.5</u>
Contractor	<u>online Contractors 2016 Ltd.</u>
Date of Work	<u>01/04/21</u>
Seal Type (circle one)	<u>1 Coat</u> / Racked in Chipseal / 2 Coat / Other:
Seal Reason	<u>Waterproofing First Coat / Second Coat / Asphalt Membrane</u>
Area Sealed (m ²)	<u>1360 m²</u>
Chip Grading (e.g. 3/5)	<u>Grade 4</u>
Binder Type (e.g. B180/200)	<u>CRS-2 - Emulsion.</u>
Chip Source Company	<u>J. Swap.</u>
Chip Source Quarry	<u>Qataroona.</u>
Total Volume of Binder Used (Hot) (Litres)	<u>1904 litres.</u>
Temperature of Binder (°C)	<u>80°C</u>
Residual Binder Rate (L/m ²)	<u>1.0 L/m²</u>
Cutter (e.g. 3 pph Kero)	<u>-</u>
Other Additives with concentrations (e.g. Polymer modification RS1, 3%)	<u>-</u>
Sealing Notes (e.g. Weather, Temp)	<u>-</u>

Surfacing Chip PSV testing form attached

F3.7 RAMM ASPHALT DATA

(to be completed for each seal layer on each road section)

Subdivision online - greenhill - stage 15

Road No / Name ROAD 37 + 28 + 22

Start m CH 320 (2019) Start Description EGS SMA2E 12

End m CH 170 (2022) End Description EGS SMA2E 14

Width 5.5

Contractor online Contractors

Date of Work 01/04/21

Asphalt Type (circle one) AC / OGPA / SMA / Other

Grading (e.g. M/10 DG10) D0-7

Area Surfaced (m²) 1360 m²

Average thickness (mm) 36 mm

Laying Temperature (°C) 149°C

Tack Coat Residual Application Rate (L/m²) 1.0 L/m²

Additional Notes (e.g. Weather, Temp, Polymer Modification) Dry.

F3.9 RAMM PAVEMENT DATA

(to be completed for each road section)

Subdivision GREENHILL PARK STAGE 15
 Road No / Name ROAD 22 (GOSSET AVE)
 Start m 160 Start Description LOT 407
 End m 260 End Description ROAD 37 (COULDSACK AVE)
 Width 5.5m

Basecourse

Date Completed 12-3-2021
 Thickness 200 mm
 Grading GAP 40
 Quarry STEVENSONS TAUHEI

Sub-Base

Date Completed NIL
 Thickness _____
 Grading _____
 Quarry _____

Undercut / Imported Subgrade (If Required)

Whole Site Yes / No
 Length 100
 Width 6 m
 Depth 500mm
 Backfill Material BLUE BROWN ROCK

Subgrade

CBR Without 15
 Stabilisation _____
 Material _____
 Stabilised? No / Cement / Lime
 % Stabilising Agent _____
 Stabilised Depth _____
 Stabilised CBR _____

F3.9 RAMM PAVEMENT DATA

(to be completed for each road section)

Subdivision GREENHILL PARK STAGE 15
 Road No / Name ROAD 37 (COULDSACK AVE)
 Start m 280 Start Description ROAD 22 (GOSSET AVE)
 End m 340 End Description LOT 425
 Width 5.5m.

Basecourse

Date Completed 12-3-2021
 Thickness 200mm
 Grading GAP 40
 Quarry STEVENSONS TAUHEI

Sub-Base

Date Completed NIL
 Thickness _____
 Grading _____
 Quarry _____

Undercut / Imported Subgrade (If Required)

Whole Site Yes / No
 Length 60m
 Width 6m
 Depth 500mm
 Backfill Material BLUE BROWN ROCK

Subgrade

CBR Without 15
 Stabilisation _____
 Material _____
 Stabilised? No / Cement / Lime
 % Stabilising Agent _____
 Stabilised Depth _____
 Stabilised CBR _____

F3.9 RAMM PAVEMENT DATA

(to be completed for each road section)

Subdivision GREENHILL PARK STAGE 15
 Road No / Name ROAD 38 (GOSSET AVE)
 Start m 130 Start Description LOT 414
 End m 200 End Description ROAD 22 (GOSSET AVE)
 Width _____

Basecourse

Date Completed 12-3-2021
 Thickness 200mm
 Grading GAP 40
 Quarry STEVENSONS TAUHEI

Sub-Base

Date Completed NIL
 Thickness _____
 Grading _____
 Quarry _____

Undercut / Imported Subgrade (If Required)

Whole Site Yes / No
 Length 70m
 Width 6m
 Depth 500mm
 Backfill Material BLUE BROWN ROCK

Subgrade

CBR Without 15
 Stabilisation _____
 Material _____
 Stabilised? No / Cement / Lime
 % Stabilising Agent _____
 Stabilised Depth _____
 Stabilised CBR _____

APPENDIX 3

Water Construction QA Documentation

- Pipe Laying Checklists F6.2
- Final Inspection Checklist F6.3
- Laboratory Water Test Results
- Pressure Test Results





WATER SUPPLY PIPE LAYING CHECKLIST

SITE ADDRESS: GREENHILL PARK - STAGE 15.

NAME OF DEVELOPER: CHEDWORTH PROPERTIES LTD.

NAME OF QUALIFIED
WATER SERVICE PERSON: TE RUI SHEEHAN

Location: Pipe length (Intersection to Intersection and side)	FROM	RD 37 512	RD 22	RD 22	RD 36 512	RD 36 512
	TO	RD 22	RD 37	RD 37	RD 22	RD 22
		Tick if satisfactory	Tick if satisfactory	Tick if satisfactory	Tick if satisfactory	Tick if satisfactory
Pipe size, pressure rating, material, acceptable products checked (attach photo of manufacturer's stamp on pipe)		150 PN12.5	150 PN12.5	63 PN12.5	150 PN12.5	63 PN12.5
Foundation support attached		X	X	X	X	X
Dynamic cone penetrometer (DCP) results available		X	X	X	X	X
If under-cutting required, note metreage and DCP:		X	X	X	X	X
Bedding type and backfill material (DCP results for road crossings and driveways attached?) YES <input type="checkbox"/> NO <input checked="" type="checkbox"/>		SAND	SAND	SAND	SAND	SAND
Valves and hydrants not in carriageway		✓	✓	✓	✓	✓
Alignment and cover		✓	✓	✓	✓	✓
All service connections in place (Table of water meter and backflow preventor numbers with corresponding lot numbers attached?) YES <input checked="" type="checkbox"/> NO <input type="checkbox"/>		✓	✓	✓	✓	✓
Connections and Toby Box correctly located horizontally and vertically (as per standard drawings)		✓	✓	✓	✓	✓
Hydrants and valves positioned correctly (as per standard drawings)		✓	✓	✓	✓	✓
Thrust blocks installed		✓	✓	✓	✓	✓
Pipelines flushed		✓	✓	✓	✓	✓
As-built measurements taken prior to backfill		✓	✓	✓	✓	✓
Pressure test witnessed and passed by Council representative		✓	✓	✓	✓	✓

	Tick if satisfactory	Tick if satisfactory	Tick if satisfactory	Tick if satisfactory	Tick if satisfactory
Bacto sample taken and passed by Council representative PRIOR to connection to the live Council main	✓	✓	✓	✓	✓
Connection to live main by Council (unless specifically approved)	✓	✓	✓	✓	✓

Main left charged at FAC level of _____ ppm

ONLINE CONTRACTORS

Developer/Contractor's name
(please print)

P. Hopper P. HOPPER
Developer/Contractor's signature

7-4-21
Date signed

Council Representative's name
(please print)

Council Representative's signature

Date signed

WATER SUPPLY FINAL INSPECTION CHECKLIST

DEVELOPER/CONTRACTOR ONLINE CONTRACTORS LTD

SITE/LOCATION GREENHILL PARK - STAGE 15

SUB /

CONTRACT NO

Developer to verify checklist prior to meeting	Developer Check	Council Rep Check
1. All lines flushed out	/	
2. All backfilling complete and reinstated	/	
3. Water Supply Design Confirmation form completed		
4. Water Supply Pipe Laying Checklist completed	/	
5. Final as-built plans attached for site inspection		
6. Connected to existing supply by Council (<i>refer Water Supply Pipe Laying Checklist</i>)	/	
Site Meeting:		
1. Valves and hydrants correctly marked <i>(Refer standard drawings for indicator posts)</i>	/	
2. FH pavement markers in place	/	
3. Fire hydrant lids painted	/	
4. Valve and FH boxes installed correctly (<i>Refer standard drawings</i>)	/	
5. All valves checked on/off	/	
6. Remedial work required? <i>Yes (please list)</i>	NO	

ONLINE CONTRACTORS

Developer/Contractor's name
(please print)



Developer/Contractor's signature

8-4-21

Date signed

Council Representative's name
(please print)

Council Representative's signature

Date signed

Test Certificate

Date	4 Feb 2021
Project Name	Greenhill
Plan No.	Stage 15, 14 & 13
Contractor	Online
Contractors Rep	Tyler Maiki
HCC Officer	M. Gibbs

Water Reticulation


Pressure Test – Water

171-PSI



or

1200kPa

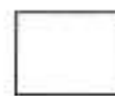

for 15mins

Test Name	PN Rating	Pipe Size	Start	Finish	Length	Result
PT	16	150mm 63mm	10.45	11.00	600m	Pass

Signature HCC Test Official	
Signature Contractor Representative	

Sample ID	Sample Type	Site	Date Sampled	Date Received	Parameter Name	Result	Units	Lab	Status
2021000845	Hamilton Reticulation Maintenance	150 Greenhill west	16/02/2021	16/02/2021	Heterotrophic Plate Count 35°C	<1	cfu/mL	HCC Laboratory	e
2021000845	Hamilton Reticulation Maintenance	150 Greenhill west	16/02/2021	16/02/2021	Temperature On Arrival	17.1	°C	HCC Laboratory	e
2021000845	Hamilton Reticulation Maintenance	150 Greenhill west	16/02/2021	16/02/2021	E.coli Enumerated	<1	MPN/100mL	HCC Laboratory	e
2021000845	Hamilton Reticulation Maintenance	150 Greenhill west	16/02/2021	16/02/2021	Total Coliforms Enumerated	<1	MPN/100mL	HCC Laboratory	e
2021000845	Hamilton Reticulation Maintenance	150 Greenhill west	16/02/2021	16/02/2021	Time Sampled (client)	06:30		Client	e
2021000845	Hamilton Reticulation Maintenance	150 Greenhill west	16/02/2021	16/02/2021	Sampler (client)	Lance Parkes		Client	e
2021000846	Hamilton Reticulation Maintenance	150 Greenhill North	16/02/2021	16/02/2021	Heterotrophic Plate Count 35°C	5	cfu/mL	HCC Laboratory	e
2021000846	Hamilton Reticulation Maintenance	150 Greenhill North	16/02/2021	16/02/2021	Temperature On Arrival	16.8	°C	HCC Laboratory	e
2021000846	Hamilton Reticulation Maintenance	150 Greenhill North	16/02/2021	16/02/2021	E.coli Enumerated	<1	MPN/100mL	HCC Laboratory	e
2021000846	Hamilton Reticulation Maintenance	150 Greenhill North	16/02/2021	16/02/2021	Total Coliforms Enumerated	<1	MPN/100mL	HCC Laboratory	e
2021000846	Hamilton Reticulation Maintenance	150 Greenhill North	16/02/2021	16/02/2021	Time Sampled (client)	06:35		Client	e
2021000846	Hamilton Reticulation Maintenance	150 Greenhill North	16/02/2021	16/02/2021	Sampler (client)	Lance Parkes		Client	e
2021000847	Hamilton Reticulation Maintenance	150 Greenhill East	16/02/2021	16/02/2021	Heterotrophic Plate Count 35°C	<1	cfu/mL	HCC Laboratory	e
2021000847	Hamilton Reticulation Maintenance	150 Greenhill East	16/02/2021	16/02/2021	Temperature On Arrival	17.7	°C	HCC Laboratory	e
2021000847	Hamilton Reticulation Maintenance	150 Greenhill East	16/02/2021	16/02/2021	E.coli Enumerated	<1	MPN/100mL	HCC Laboratory	e
2021000847	Hamilton Reticulation Maintenance	150 Greenhill East	16/02/2021	16/02/2021	Total Coliforms Enumerated	<1	MPN/100mL	HCC Laboratory	e
2021000847	Hamilton Reticulation Maintenance	150 Greenhill East	16/02/2021	16/02/2021	Time Sampled (client)	06:45		Client	e
2021000847	Hamilton Reticulation Maintenance	150 Greenhill East	16/02/2021	16/02/2021	Sampler (client)	Lance Parkes		Client	e

APPENDIX 4

Wastewater Construction and QA Records

- Wastewater Pipe Laying Checklist F5.2
- Wastewater Manhole Checklist F5.3
- Wastewater trench Backfill Summary Checklist F5.4
- Wastewater Final Inspection Checklist F5.6
- Pressure Test Results
- CCTV submission email



F5.2 WASTEWATER PIPE LAYING CHECKLIST

Engineering plan number(s): <u>21879-M-13-S01</u>					
Name of certified drainlayer: <u>Zane Millar</u>					
Location: Pipe length (MH To MH)	<u>FEI</u> to <u>18.5</u>	<u>18.5</u> to <u>18.4</u>	<u>18.4</u> to <u>16.3</u>	<u>16.3</u> to <u>18.1</u>	<u>18.1</u> to <u>18.2</u>

Pipe Laying Checks

Trench Safety	<input checked="" type="checkbox"/>	<input checked="" type="checkbox"/>	<input checked="" type="checkbox"/>	<input checked="" type="checkbox"/>	<input checked="" type="checkbox"/>
(d) Shield	<input checked="" type="checkbox"/>	<input checked="" type="checkbox"/>	<input checked="" type="checkbox"/>	<input checked="" type="checkbox"/>	<input checked="" type="checkbox"/>
(e) Batter	<input type="checkbox"/>	<input type="checkbox"/>	<input type="checkbox"/>	<input type="checkbox"/>	<input type="checkbox"/>
(f) Other	<input type="checkbox"/>	<input type="checkbox"/>	<input type="checkbox"/>	<input type="checkbox"/>	<input type="checkbox"/>
Pipe size, quality, manufacturer, on acceptable products list	<input checked="" type="checkbox"/>	<input checked="" type="checkbox"/>	<input checked="" type="checkbox"/>	<input checked="" type="checkbox"/>	<input checked="" type="checkbox"/>
CCTV pipe inspection data and comments supplied	<input checked="" type="checkbox"/>	<input checked="" type="checkbox"/>	<input checked="" type="checkbox"/>	<input checked="" type="checkbox"/>	<input checked="" type="checkbox"/>

West Construction

16/12/20

Developer/Contractor

Date

F5.2 WASTEWATER PIPE LAYING CHECKLIST

Engineering plan number(s):	21879-M-13-501				
Name of certified drainlayer:	Zane Miller				
Location: Pipe length (MH To MH)	18.2 to 18.1	18.2 to 19.2	19.2 to 19.1	19.2 to 19.1	19.2 to 20.2

Pipe Laying Checks

Trench Safety	<input checked="" type="checkbox"/>	<input checked="" type="checkbox"/>	<input checked="" type="checkbox"/>	<input checked="" type="checkbox"/>	<input checked="" type="checkbox"/>
(d) Shield	<input checked="" type="checkbox"/>	<input checked="" type="checkbox"/>	<input checked="" type="checkbox"/>	<input checked="" type="checkbox"/>	<input checked="" type="checkbox"/>
(e) Batter	<input type="checkbox"/>	<input type="checkbox"/>	<input type="checkbox"/>	<input type="checkbox"/>	<input type="checkbox"/>
(f) Other	<input type="checkbox"/>	<input type="checkbox"/>	<input type="checkbox"/>	<input type="checkbox"/>	<input type="checkbox"/>
Pipe size, quality, manufacturer, on acceptable products list	<input checked="" type="checkbox"/>	<input checked="" type="checkbox"/>	<input checked="" type="checkbox"/>	<input checked="" type="checkbox"/>	<input checked="" type="checkbox"/>
Set out	<input checked="" type="checkbox"/>	<input checked="" type="checkbox"/>	<input checked="" type="checkbox"/>	<input checked="" type="checkbox"/>	<input checked="" type="checkbox"/>
- Surveyors name <u>Online</u>	<input checked="" type="checkbox"/>	<input checked="" type="checkbox"/>	<input checked="" type="checkbox"/>	<input checked="" type="checkbox"/>	<input checked="" type="checkbox"/>
Service connections

All service connections in place, taped, and staked	<input checked="" type="checkbox"/>	<input checked="" type="checkbox"/>	<input checked="" type="checkbox"/>	<input checked="" type="checkbox"/>	<input checked="" type="checkbox"/>
As-built measurements taken, GPS located	<input checked="" type="checkbox"/>	<input checked="" type="checkbox"/>	<input checked="" type="checkbox"/>	<input checked="" type="checkbox"/>	<input checked="" type="checkbox"/>
CCTV pipe inspection data and comments supplied	<input checked="" type="checkbox"/>	<input checked="" type="checkbox"/>	<input checked="" type="checkbox"/>	<input checked="" type="checkbox"/>	<input checked="" type="checkbox"/>

West Construction

16/12/20

Developer/Contractor

Date

F5.2 WASTEWATER PIPE LAYING CHECKLIST

Engineering plan number(s):	21879-M-13-501												
Name of certified drainlayer:	Zane Miller												
Location: Pipe length (MH To MH)	20.2	to	20.1	20.2	to	21.3	21.2	to	21.2	21.1	22.2	to	22.1

Pipe Laying Checks

Trench Safety	<input checked="" type="checkbox"/>	<input checked="" type="checkbox"/>	<input checked="" type="checkbox"/>	<input checked="" type="checkbox"/>	<input checked="" type="checkbox"/>
(d) Shield	<input checked="" type="checkbox"/>	<input checked="" type="checkbox"/>	<input checked="" type="checkbox"/>	<input checked="" type="checkbox"/>	<input checked="" type="checkbox"/>
(e) Batter	<input type="checkbox"/>	<input type="checkbox"/>	<input type="checkbox"/>	<input type="checkbox"/>	<input type="checkbox"/>
(f) Other	<input type="checkbox"/>	<input type="checkbox"/>	<input type="checkbox"/>	<input type="checkbox"/>	<input type="checkbox"/>
Pipe size, quality, manufacturer, on acceptable products list	<input checked="" type="checkbox"/>	<input checked="" type="checkbox"/>	<input checked="" type="checkbox"/>	<input checked="" type="checkbox"/>	<input checked="" type="checkbox"/>
Set out	<input checked="" type="checkbox"/>	<input checked="" type="checkbox"/>	<input checked="" type="checkbox"/>	<input checked="" type="checkbox"/>	<input checked="" type="checkbox"/>
- Surveyors name <u>Online</u>	<input checked="" type="checkbox"/>	<input checked="" type="checkbox"/>	<input checked="" type="checkbox"/>	<input checked="" type="checkbox"/>	<input checked="" type="checkbox"/>
- Set out checked	<input checked="" type="checkbox"/>	<input checked="" type="checkbox"/>	<input checked="" type="checkbox"/>	<input checked="" type="checkbox"/>	<input checked="" type="checkbox"/>
Bulk backfill compaction (DCP results from pipe to ground level attached)	<input checked="" type="checkbox"/>	<input checked="" type="checkbox"/>	<input checked="" type="checkbox"/>	<input checked="" type="checkbox"/>	<input checked="" type="checkbox"/>
Alignment - control points identified	<input checked="" type="checkbox"/>	<input checked="" type="checkbox"/>	<input checked="" type="checkbox"/>	<input checked="" type="checkbox"/>	<input checked="" type="checkbox"/>
Pressure test witnessed and passed by Council representative.	<input checked="" type="checkbox"/>	<input checked="" type="checkbox"/>	<input checked="" type="checkbox"/>	<input checked="" type="checkbox"/>	<input checked="" type="checkbox"/>

Service connections

All service connections in place, taped, and staked	<input checked="" type="checkbox"/>	<input checked="" type="checkbox"/>	<input checked="" type="checkbox"/>	<input checked="" type="checkbox"/>	<input checked="" type="checkbox"/>
As-built measurements taken, GPS located	<input checked="" type="checkbox"/>	<input checked="" type="checkbox"/>	<input checked="" type="checkbox"/>	<input checked="" type="checkbox"/>	<input checked="" type="checkbox"/>
CCTV pipe inspection data and comments supplied	<input checked="" type="checkbox"/>	<input checked="" type="checkbox"/>	<input checked="" type="checkbox"/>	<input checked="" type="checkbox"/>	<input checked="" type="checkbox"/>

West Construction

16/12/20

Developer/Contractor

Date

F5.3 WASTEWATER MANHOLE CHECKLIST

Engineering Plan Number(s) <i>21879-M-13-502</i>					
Name of certified drainlayer: <i>Zane Miller</i>					
Location: Pipe length (MH To MH)	<i>18.5</i>	<i>18.4</i>	<i>18.3</i>	<i>18A1</i>	<i>18.2</i>
Manhole Construction Checklist	MH number				
Manhole size, quality, manufacturer on acceptable materials list	<input checked="" type="checkbox"/>	<input checked="" type="checkbox"/>	<input checked="" type="checkbox"/>	<input checked="" type="checkbox"/>	<input checked="" type="checkbox"/>
Set out /orientation	<input checked="" type="checkbox"/>	<input checked="" type="checkbox"/>	<input checked="" type="checkbox"/>	<input checked="" type="checkbox"/>	<input checked="" type="checkbox"/>
Sealing strip between risers	<input checked="" type="checkbox"/>	<input checked="" type="checkbox"/>	<input checked="" type="checkbox"/>	<input checked="" type="checkbox"/>	<input checked="" type="checkbox"/>
Benching					
• Height	<input checked="" type="checkbox"/>	<input checked="" type="checkbox"/>	<input checked="" type="checkbox"/>	<input checked="" type="checkbox"/>	<input checked="" type="checkbox"/>
Access details per drawings (e.g. manhole cover sited over steps).	<input checked="" type="checkbox"/>	<input checked="" type="checkbox"/>	<input checked="" type="checkbox"/>	<input checked="" type="checkbox"/>	<input type="checkbox"/>
Step irons including epoxy to outside recesses	<input checked="" type="checkbox"/>	<input checked="" type="checkbox"/>	<input checked="" type="checkbox"/>	<input checked="" type="checkbox"/>	<input checked="" type="checkbox"/>
Bedding type and surround	<input checked="" type="checkbox"/>	<input checked="" type="checkbox"/>	<input checked="" type="checkbox"/>	<input checked="" type="checkbox"/>	<input checked="" type="checkbox"/>
Bulk backfill compaction - Dynamic Cone Penetrometer (DCP) results attached	<input checked="" type="checkbox"/>	<input checked="" type="checkbox"/>	<input checked="" type="checkbox"/>	<input checked="" type="checkbox"/>	<input checked="" type="checkbox"/>
No debris in pipelines	<input checked="" type="checkbox"/>	<input checked="" type="checkbox"/>	<input checked="" type="checkbox"/>	<input checked="" type="checkbox"/>	<input checked="" type="checkbox"/>
Pipe invert fall through manhole	<input checked="" type="checkbox"/>	<input checked="" type="checkbox"/>	<input checked="" type="checkbox"/>	<input checked="" type="checkbox"/>	<input checked="" type="checkbox"/>
Pressure test witnessed and passed by Council representative.	<input checked="" type="checkbox"/>	<input checked="" type="checkbox"/>	<input checked="" type="checkbox"/>	<input checked="" type="checkbox"/>	<input checked="" type="checkbox"/>

West Construction

16/12/20

Developer/Contractor

Date

F5.3 WASTEWATER MANHOLE CHECKLIST

Engineering Plan Number(s) <u>21879-M-13-S01</u>					
Name of certified drainlayer: <u>Zane Milken</u>					
Location: Pipe length (MH To MH)	<u>18.1</u>	<u>19.2</u>	<u>19.1</u>	<u>19.1</u>	<u>20.2</u>
Manhole Construction Checklist	MH number				
Manhole size, quality, manufacturer on acceptable materials list	<input checked="" type="checkbox"/>	<input type="checkbox"/>	<input checked="" type="checkbox"/>	<input checked="" type="checkbox"/>	<input checked="" type="checkbox"/>
Set out /orientation	<input checked="" type="checkbox"/>	<input checked="" type="checkbox"/>	<input checked="" type="checkbox"/>	<input checked="" type="checkbox"/>	<input checked="" type="checkbox"/>
Sealing strip between risers	<input checked="" type="checkbox"/>	<input checked="" type="checkbox"/>	<input checked="" type="checkbox"/>	<input checked="" type="checkbox"/>	<input checked="" type="checkbox"/>
Benching					
• Height	<input checked="" type="checkbox"/>	<input checked="" type="checkbox"/>	<input checked="" type="checkbox"/>	<input checked="" type="checkbox"/>	<input checked="" type="checkbox"/>
• Alignment and cross section	<input checked="" type="checkbox"/>	<input checked="" type="checkbox"/>	<input checked="" type="checkbox"/>	<input checked="" type="checkbox"/>	<input checked="" type="checkbox"/>
• Half pipe lining (wastewater only)	<input checked="" type="checkbox"/>	<input checked="" type="checkbox"/>	<input checked="" type="checkbox"/>	<input checked="" type="checkbox"/>	<input checked="" type="checkbox"/>
• Step recesses (if applicable)	<input type="checkbox"/>	<input type="checkbox"/>	<input type="checkbox"/>	<input type="checkbox"/>	<input type="checkbox"/>
Flexible joints	<input checked="" type="checkbox"/>	<input checked="" type="checkbox"/>	<input checked="" type="checkbox"/>	<input checked="" type="checkbox"/>	<input checked="" type="checkbox"/>
WAST Construction

Developer/Contractor

16/12/20

Date

F5.3 WASTEWATER MANHOLE CHECKLIST

Engineering Plan Number(s) <i>21879-M-13-501</i>						
Name of certified drainlayer: <i>Zane Milder</i>						
Location: Pipe length (MH To MH)	<i>20.1</i>	<i>21.3</i>	<i>21.2</i>	<i>21.1</i>	<i>22.2</i>	<i>22.1</i>
Manhole Construction Checklist	MH number					
Manhole size, quality, manufacturer on acceptable materials list	<input checked="" type="checkbox"/>	<input checked="" type="checkbox"/>	<input checked="" type="checkbox"/>	<input checked="" type="checkbox"/>	<input checked="" type="checkbox"/>	<input checked="" type="checkbox"/>
Set out /orientation	<input checked="" type="checkbox"/>	<input checked="" type="checkbox"/>	<input checked="" type="checkbox"/>	<input checked="" type="checkbox"/>	<input checked="" type="checkbox"/>	<input checked="" type="checkbox"/>
Sealing strip between risers	<input checked="" type="checkbox"/>	<input checked="" type="checkbox"/>	<input checked="" type="checkbox"/>	<input checked="" type="checkbox"/>	<input checked="" type="checkbox"/>	<input checked="" type="checkbox"/>
Benching						
• Height	<input checked="" type="checkbox"/>	<input checked="" type="checkbox"/>	<input checked="" type="checkbox"/>	<input checked="" type="checkbox"/>	<input checked="" type="checkbox"/>	<input checked="" type="checkbox"/>
• Alignment and cross section	<input checked="" type="checkbox"/>	<input checked="" type="checkbox"/>	<input checked="" type="checkbox"/>	<input checked="" type="checkbox"/>	<input checked="" type="checkbox"/>	<input checked="" type="checkbox"/>
• Half pipe lining (wastewater only)	<input checked="" type="checkbox"/>	<input checked="" type="checkbox"/>	<input checked="" type="checkbox"/>	<input checked="" type="checkbox"/>	<input checked="" type="checkbox"/>	<input checked="" type="checkbox"/>
Date

F5.4 WASTEWATER TRENCH BACKFILL COMPACTION TEST SUMMARY (ATTACH INDIVIDUAL TEST REPORTS)

Technician Carrying out Tests:	West Construction
Location:	Greenhill Park 13, 14, 15
Plan No(s):	21872-M-13-502
From MH	22.2 - 22.1
Acceptance Criteria:	
Tests by:	West Construction

(attached)

Analysis of Results

Trench backfill completed satisfactorily

or

Trench backfill requires remedial work as follows:

West Construction

Developer/Contractor

16/12/20

Date

F5.4 WASTEWATER TRENCH BACKFILL COMPACTION TEST SUMMARY (ATTACH INDIVIDUAL TEST REPORTS)

Technician Carrying out Tests:	West Construction
Location:	Greenhill Park 13/14/15
Plan No(s):	21879-M-13-501
From MH	19.2-20.2-21.3-21.2-21.1-20.1
Acceptance Criteria:	CBR > 16
Tests by:	West Construction

(attached)

Analysis of Results

Trench backfill completed satisfactorily

or

Trench backfill requires remedial work as follows:

•

West Construction

Developer/Contractor

16/12/20

Date

F5.4 WASTEWATER TRENCH BACKFILL COMPACTION TEST SUMMARY (ATTACH INDIVIDUAL TEST REPORTS)

Technician Carrying out Tests:	West Construction
Location:	Greenhill Park 13, 14, 15
Plan No(s):	21879-M-13-SOA
From MH	FET, 18.5, 18.4, 18.3, 18.2, 18.1, 18A1
Acceptance Criteria:	CBR > 16
Tests by:	West Construction

(attached)

Analysis of Results

Trench backfill completed satisfactorily

or

Trench backfill requires remedial work as follows:

-

West Construction

Developer/Contractor

16/12/20

Date

F5.4 WASTEWATER TRENCH BACKFILL COMPACTION TEST SUMMARY (ATTACH INDIVIDUAL TEST REPORTS)

Technician Carrying out Tests:	West Construction
Location:	Greenhill 13,14,15
Plan No(s):	21879-M-13-502
From MH	18.2-19.2,17A1-19.1
Acceptance Criteria:	CBR > 16
Tests by:	West Construction

(attached)

Analysis of Results

Trench backfill completed satisfactorily

or

Trench backfill requires remedial work as follows:

•

West Construction

Developer/Contractor

16/12/20

Date

F4.6 STORMWATER PIPE NETWORK - FINAL INSPECTION CHECKLIST

Site/Location: *Greenhill Park Stages 13,14,15*

Developer/Contractor: *West Construction*

SUB ____ / ____ Contract No: _____

PRE-MEETING TASKS

Developer to verify checklist prior to meeting:

	Developer Check	Council Rep Check
1. All relevant stormwater checklists completed	<input checked="" type="checkbox"/>	<input type="checkbox"/>
2. All lines flushed out	<input checked="" type="checkbox"/>	<input type="checkbox"/>
3. All required CCTV inspections carried out, reviewed and any re-work completed.	<input checked="" type="checkbox"/>	<input type="checkbox"/>
4. All manholes checked (eg infiltration, plastering)	<input checked="" type="checkbox"/>	<input type="checkbox"/>
5. All backfilling complete and tidied up	<input checked="" type="checkbox"/>	<input type="checkbox"/>
6. Final as-built and operational plans attached for site inspection	<input type="checkbox"/>	<input type="checkbox"/>

SITE MEETING

1. Inspect all lines	<input type="checkbox"/>	<input type="checkbox"/>
2. Inspect all manholes and catchpits	<input type="checkbox"/>	<input type="checkbox"/>
3. Works on third party land completed to satisfaction of owner	<input type="checkbox"/>	<input type="checkbox"/>
4. Overland flow to and from adjoining properties not affected	<input type="checkbox"/>	<input type="checkbox"/>
5. Remedial work required? <input type="checkbox"/> Yes (please list) <input type="checkbox"/> No		

Developer *West Construction*

Council

Date *9/3/21*

Date

F5.6 WASTEWATER PIPE NETWORK - FINAL INSPECTION CHECKLIST

Site/Location: *Greenhill Park Stages 13,14,15*

Developer/Contractor: *West Construction*

SUB _____ / _____ Contract No: _____

Developer to verify checklist prior to meeting:	Developer Check	Council Rep Check
6. All checklists completed (add form numbers)	<input checked="" type="checkbox"/>	<input type="checkbox"/>
7. All lines flushed out	<input checked="" type="checkbox"/>	<input type="checkbox"/>
8. All required CCTV inspections carried out, reviewed and any re-work completed.	<input checked="" type="checkbox"/>	<input type="checkbox"/>
9. All manholes checked (eg. Infiltration, plastering)	<input checked="" type="checkbox"/>	<input type="checkbox"/>
10. All backfilling complete and tidied up	<input checked="" type="checkbox"/>	<input type="checkbox"/>
11. Pressure test completed and witnessed	<input checked="" type="checkbox"/>	<input type="checkbox"/>
12. Final as-built and operational plans attached for site inspection	<input type="checkbox"/>	<input type="checkbox"/>

Site Meeting

13. Inspect all lines	<input type="checkbox"/>	<input type="checkbox"/>
14. Inspect all manholes and catchpits	<input type="checkbox"/>	<input type="checkbox"/>
15. Inspect SW inlet and outlet structures	<input type="checkbox"/>	<input type="checkbox"/>
16. Secondary flowpaths and detention ponds	<input type="checkbox"/>	<input type="checkbox"/>
17. Works on third party land completed to satisfaction of owner	<input type="checkbox"/>	<input type="checkbox"/>
18. Wastewater pumping station data complete and test results (Form F5.7) attached	<input type="checkbox"/>	<input type="checkbox"/>
19. Overland flow to and from adjoining properties not affected	<input type="checkbox"/>	<input type="checkbox"/>
20. Remedial work required?	<input type="checkbox"/> Yes (please list)	<input type="checkbox"/> No

Council _____

Developer _____

West Construction 9/3/21

HCC WW testing Report

HCC WW testing Report

Complete

Score	0%	Failed items	0	Actions	0
Location	Greenhill area M Stages 13, 14, 15, Chartwell, Hamilton 3281, New Zealand (-37.7490854, 175.2960279)				
Conducted on	16th Nov, 2020 11:22 AM NZDT				
Test type	Wastewater pressure test MH pressure test -				
Pipe type	100mm - SN16 - uPVC 150mm - SN16 - uPVC				
MH # tested	WWMH's 19.1, 19a.1, 19.2, 18a.1, 18.1, 18.2, 18.3, 18.4, 18.5, 20.1, 20.2, 21.1, 21.2, 21.3.				
MH # to MH #	WWMH's 19a.1 to 19.2 to 19.1, 19.2 to 18.2 to 18.1, 18.2 to 18.3 to 18a.1, 18.2 to 20.2 to 20.1, 20.2 to 21.3 to 21.2 to 21.1, 18.3 to 18.4 to 18.5 to interceptor.				
Tested by	Matt from Wests Construction 16th Nov, 2020 11:52 AM NZDT				
Inspector/Auditor	Lance Parkes				
Comments	WWMH's tested - WWMH's 19.1, 19a.1, 19.2, 18a.1, 18.1, 18.2, 18.3, 18.4, 18.5, 20.1, 20.2, 21.1, 21.2, 21.3. WW main tested - WWMH's 19a.1 to 19.2 to 19.1, 19.2 to 18.2 to 18.1, 18.2 to 18.3 to 18a.1, 18.2 to 20.2 to 20.1, 20.2 to 21.3 to 21.2 to 21.1, 18.3 to 18.4 to 18.5 to interceptor.				
Photos					
Pass/Fail	Pass				



BACKFILL RESULT SHEET

TESTED BY: West Construction

PROJECT NAME : Greenhill Park Stages 13,14,15

Sewer Chainage	C/L Trench(CIV VALUES)		Remarks
	1ST LIFT	SECOND LIFT	
FEI WWMH1.9			
10	24	21	BROWN ROCK 1M TESTS
20	26	19	BROWN ROCK 1M TESTS
SSMH18.5			
10	21	17	BROWN ROCK 1M TESTS
20	23	22	BROWN ROCK 1M TESTS
30	27	29	BROWN ROCK 1M TESTS
40	29	24	BROWN ROCK 1M TESTS
50	22	21	BROWN ROCK 1M TESTS
60	24	27	BROWN ROCK 1M TESTS
70	28	20	BROWN ROCK 1M TESTS
80	26	23	BROWN ROCK 1M TESTS
SSMH18.4			
10	27	24	BROWN ROCK 1M TESTS
20	21	25	BROWN ROCK 1M TESTS
30	24	20	BROWN ROCK 1M TESTS
40	21	18	BROWN ROCK 1M TESTS
50	27	24	BROWN ROCK 1M TESTS
60	20	22	BROWN ROCK 1M TESTS
SSMH18.3			
10	22	18	BROWN ROCK 1M TESTS
20	21	22	BROWN ROCK 1M TESTS
30	27	20	BROWN ROCK 1M TESTS
40	25	27	BROWN ROCK 1M TESTS
50	29	23	BROWN ROCK 1M TESTS
60	19	22	BROWN ROCK 1M TESTS
70	21	26	BROWN ROCK 1M TESTS
SSMH18.2			
10	20	24	BROWN ROCK 1M TESTS
20	22	19	BROWN ROCK 1M TESTS
30	24	29	BROWN ROCK 1M TESTS
40	21	26	BROWN ROCK 1M TESTS
50	21		BROWN ROCK 1M TESTS
60	23		BROWN ROCK 1M TESTS
70	25		BROWN ROCK 1M TESTS
80	21		BROWN ROCK 1M TESTS
SSMH18.1			
SSMH18.3			
10	23	21	BROWN ROCK 1M TESTS
20	27	26	BROWN ROCK 1M TESTS
30	21	25	BROWN ROCK 1M TESTS
40	24		BROWN ROCK 1M TESTS
50	29		BROWN ROCK 1M TESTS
60	24		BROWN ROCK 1M TESTS
SSMH18.A1			
SSMH18.2			
10	22	19	BROWN ROCK 1M TESTS
20	24	22	BROWN ROCK 1M TESTS

TESTED BY:	West Construction		
PROJECT NAME :	Greenhill Park Stages 13,14,15		
30	21	24	BROWN ROCK 1M TESTS
40	29	26	BROWN ROCK 1M TESTS
50	24	25	BROWN ROCK 1M TESTS
60	27	30	BROWN ROCK 1M TESTS
SSMH19.2			
10	29	22	BROWN ROCK 1M TESTS
20	24	26	BROWN ROCK 1M TESTS
30	25	23	BROWN ROCK 1M TESTS
40	26	24	BROWN ROCK 1M TESTS
50	24		BROWN ROCK 1M TESTS
60	21		BROWN ROCK 1M TESTS
70	26		BROWN ROCK 1M TESTS
80	28		BROWN ROCK 1M TESTS
90	24		BROWN ROCK 1M TESTS
SSMH19.1			
SSMH19.2			
10	22		BROWN ROCK 1M TESTS
SSMH19.A1			
SSMH18.2			
10	21	26	BROWN ROCK 1M TESTS
20	23	22	BROWN ROCK 1M TESTS
30	24	24	BROWN ROCK 1M TESTS
40	27	36	BROWN ROCK 1M TESTS
50	19	25	BROWN ROCK 1M TESTS
60	21	24	BROWN ROCK 1M TESTS
SSMH20.2			
10	19	23	BROWN ROCK 1M TESTS
20	20	24	BROWN ROCK 1M TESTS
30	24	21	BROWN ROCK 1M TESTS
40	26	22	BROWN ROCK 1M TESTS
50	22		BROWN ROCK 1M TESTS
60	23		BROWN ROCK 1M TESTS
70	20		BROWN ROCK 1M TESTS
80	21		BROWN ROCK 1M TESTS
SSMH20.1			
SSMH20.2			
10	25	19	BROWN ROCK 1M TESTS
20	24	18	BROWN ROCK 1M TESTS
30	23	26	BROWN ROCK 1M TESTS
40	26	21	BROWN ROCK 1M TESTS
SSMH21.3			
10	20	25	BROWN ROCK 1M TESTS
20	24	23	BROWN ROCK 1M TESTS
SSMH21.2			
10	24	21	BROWN ROCK 1M TESTS
20	25	23	BROWN ROCK 1M TESTS
30	28	25	BROWN ROCK 1M TESTS
40	23	22	BROWN ROCK 1M TESTS
50	29		BROWN ROCK 1M TESTS
60	21		BROWN ROCK 1M TESTS

TESTED BY:	West Construction		
PROJECT NAME :	Greenhill Park Stages 13,14,15		
70	25		BROWN ROCK 1M TESTS
SSMH21.1			

Barry Pearson

From: Barry Pearson (Shrimpton and Lipinski Limited Partnership (HQ - Tauranga))
<bpearson@sltga.co.nz>
Sent: Tuesday, 13 April 2021 3:24 PM
To: Martyn Smith (Hamilton City Council (Hamilton))
Subject: Document Issue No. 9 - Stage 15 GHP - CCTV SW and WW
Attachments: 19-30378-03 - Greenhill Park - Area M Stage 13, 14 and 15 - Issue 9.pdf

19-30378-03 - Greenhill Park - Area M Stage 13, 14 and 15 Issue 9

Issued by: Barry Pearson (Shrimpton and Lipinski Limited Partnership)
On: 13 Apr 2021

Stage 15 GHP - CCTV SW and WW for Review

Note that we intend to submit our Greenhill Park engineering works completion report to HCC approx. 14th April 2021 for review and approval.

Thanks

[Access the documents for this issue](#)

Recipients:

Martyn Smith (Hamilton City Council (Hamilton))
Lance Parkes (Hamilton City Council (Hamilton))
Murray Giles (Hamilton City Council (Hamilton))
Barry Pearson (Shrimpton and Lipinski Limited Partnership (HQ - Tauranga))
Mark Derksen (Shrimpton and Lipinski Limited Partnership (HQ - Tauranga))

BARRY PEARSON



S&L
Land Development
and Design Specialists

36 Kereiti Street, Tauranga 3110
PO Box 231, Tauranga 3140
07 577 6069 bpearson@sltga.co.nz
www.sltga.co.nz

APPENDIX 5

Stormwater Construction and QA Records

- Stormwater Pipe Laying Checklist F4.11 F5.2
- Stormwater Manhole Checklist F4.12 F5.3
- Trench Backfill Compaction Test Summary F4.13
- Stormwater Backfill Compaction Test Results
- Stormwater Catchpit Checklist F4.14
- Stormwater Final Inspection Checklist F4.6
- CCTV submission email



F4.2 STORMWATER PIPE LAYING CHECKLIST

Engineering plan number(s):											
Name of certified drainlayer:											
Location: Pipe length (MH To MH)											
	Swart 15	to 19.5	19.5	to 19.4	19.4	to 19.1	19.1	to 20.1	20.1	to 21.2	21.2

Pipe Laying Checks

Trench Safety					
(a) Shield	<input checked="" type="checkbox"/>	<input checked="" type="checkbox"/>	<input checked="" type="checkbox"/>	<input checked="" type="checkbox"/>	<input checked="" type="checkbox"/>
(b) Batter	<input checked="" type="checkbox"/>	<input checked="" type="checkbox"/>	<input checked="" type="checkbox"/>	<input checked="" type="checkbox"/>	<input checked="" type="checkbox"/>
(c) Other	<input type="checkbox"/>	<input type="checkbox"/>	<input type="checkbox"/>	<input type="checkbox"/>	<input type="checkbox"/>
Pipe size, quality, manufacturer, on acceptable products list	<input checked="" type="checkbox"/>	<input checked="" type="checkbox"/>	<input checked="" type="checkbox"/>	<input checked="" type="checkbox"/>	<input checked="" type="checkbox"/>
Set out					
- Surveyors name <u>Online</u>	<input checked="" type="checkbox"/>	<input checked="" type="checkbox"/>	<input checked="" type="checkbox"/>	<input checked="" type="checkbox"/>	<input checked="" type="checkbox"/>
- Set out checked	<input checked="" type="checkbox"/>	<input checked="" type="checkbox"/>	<input checked="" type="checkbox"/>	<input checked="" type="checkbox"/>	<input checked="" type="checkbox"/>
Foundation support attached					
- Dynamic cone penetrometer (DCP) results	<input checked="" type="checkbox"/>	<input checked="" type="checkbox"/>	<input checked="" type="checkbox"/>	<input checked="" type="checkbox"/>	<input checked="" type="checkbox"/>
- if under cutting required, note metreage and DCP results.	<input checked="" type="checkbox"/>	<input checked="" type="checkbox"/>	<input checked="" type="checkbox"/>	<input checked="" type="checkbox"/>	<input checked="" type="checkbox"/>
Record daily level check and confirm on grade	<input checked="" type="checkbox"/>	<input checked="" type="checkbox"/>	<input checked="" type="checkbox"/>	<input checked="" type="checkbox"/>	<input checked="" type="checkbox"/>
Bedding type and surround material:					
<u>40/20 - Sand</u>	<input checked="" type="checkbox"/>	<input checked="" type="checkbox"/>	<input checked="" type="checkbox"/>	<input checked="" type="checkbox"/>	<input checked="" type="checkbox"/>
Bulk Backfill material:					
<u>Brown Rock</u>	<input type="checkbox"/>	<input type="checkbox"/>	<input type="checkbox"/>	<input type="checkbox"/>	<input type="checkbox"/>
Bulk backfill compaction (DCP results from pipe to ground level attached)	<input checked="" type="checkbox"/>	<input checked="" type="checkbox"/>	<input checked="" type="checkbox"/>	<input checked="" type="checkbox"/>	<input checked="" type="checkbox"/>
Alignment – control points identified	<input checked="" type="checkbox"/>	<input checked="" type="checkbox"/>	<input checked="" type="checkbox"/>	<input checked="" type="checkbox"/>	<input checked="" type="checkbox"/>
Pressure test witnessed and passed by Council representative.	<input type="checkbox"/>	<input type="checkbox"/>	<input type="checkbox"/>	<input type="checkbox"/>	<input type="checkbox"/>

Service connections

All service connections in place, taped, and staked	<input checked="" type="checkbox"/>	<input checked="" type="checkbox"/>	<input checked="" type="checkbox"/>	<input checked="" type="checkbox"/>	<input checked="" type="checkbox"/>
As-built measurements taken, GPS located	<input checked="" type="checkbox"/>	<input checked="" type="checkbox"/>	<input checked="" type="checkbox"/>	<input checked="" type="checkbox"/>	<input checked="" type="checkbox"/>
CCTV pipe inspection data and comments supplied	<input checked="" type="checkbox"/>	<input checked="" type="checkbox"/>	<input checked="" type="checkbox"/>	<input checked="" type="checkbox"/>	<input checked="" type="checkbox"/>

West Construction

Developer/Contractor

14/12/20

Date

F4.2 STORMWATER PIPE LAYING CHECKLIST

Engineering plan number(s):									
Name of certified drainlayer:									
Location: Pipe length (MH To MH)	21.2	to 21.1	15.2	to 15.1	19.4	to 22.2	22.2	to 22.1	to

Pipe Laying Checks

Trench Safety					
(a) Shield	<input checked="" type="checkbox"/>	<input checked="" type="checkbox"/>	<input checked="" type="checkbox"/>	<input checked="" type="checkbox"/>	<input type="checkbox"/>
(b) Batter	<input checked="" type="checkbox"/>	<input checked="" type="checkbox"/>	<input checked="" type="checkbox"/>	<input checked="" type="checkbox"/>	<input type="checkbox"/>
(c) Other	<input type="checkbox"/>	<input type="checkbox"/>	<input type="checkbox"/>	<input type="checkbox"/>	<input type="checkbox"/>
Pipe size, quality, manufacturer, on acceptable products list	<input checked="" type="checkbox"/>	<input checked="" type="checkbox"/>	<input checked="" type="checkbox"/>	<input checked="" type="checkbox"/>	<input type="checkbox"/>
Set out					
- Surveyors name <u>online</u>	<input checked="" type="checkbox"/>	<input checked="" type="checkbox"/>	<input checked="" type="checkbox"/>	<input checked="" type="checkbox"/>	<input type="checkbox"/>
- Set out checked	<input checked="" type="checkbox"/>	<input checked="" type="checkbox"/>	<input checked="" type="checkbox"/>	<input checked="" type="checkbox"/>	<input type="checkbox"/>
Foundation support attached					
- Dynamic cone penetrometer (DCP) results	<input checked="" type="checkbox"/>	<input checked="" type="checkbox"/>	<input checked="" type="checkbox"/>	<input checked="" type="checkbox"/>	<input type="checkbox"/>
- if under cutting required, note metreage and DCP results.	<input checked="" type="checkbox"/>	<input checked="" type="checkbox"/>	<input checked="" type="checkbox"/>	<input checked="" type="checkbox"/>	<input type="checkbox"/>
Record daily level check and confirm on grade	<input checked="" type="checkbox"/>	<input checked="" type="checkbox"/>	<input checked="" type="checkbox"/>	<input checked="" type="checkbox"/>	<input type="checkbox"/>
Bedding type and surround material:					
<u>40/20 - Sand</u>	<input checked="" type="checkbox"/>	<input checked="" type="checkbox"/>	<input checked="" type="checkbox"/>	<input checked="" type="checkbox"/>	<input type="checkbox"/>
Bulk Backfill material:					
<u>Broken Rock</u>	<input checked="" type="checkbox"/>	<input checked="" type="checkbox"/>	<input checked="" type="checkbox"/>	<input checked="" type="checkbox"/>	<input type="checkbox"/>
Bulk backfill compaction (DCP results from pipe to ground level attached)	<input checked="" type="checkbox"/>	<input checked="" type="checkbox"/>	<input checked="" type="checkbox"/>	<input checked="" type="checkbox"/>	<input type="checkbox"/>
Alignment - control points identified	<input checked="" type="checkbox"/>	<input checked="" type="checkbox"/>	<input checked="" type="checkbox"/>	<input checked="" type="checkbox"/>	<input type="checkbox"/>
Pressure test witnessed and passed by Council representative.	<input type="checkbox"/>	<input type="checkbox"/>	<input type="checkbox"/>	<input type="checkbox"/>	<input type="checkbox"/>

Service connections

All service connections in place, taped, and staked	<input checked="" type="checkbox"/>	<input checked="" type="checkbox"/>	<input checked="" type="checkbox"/>	<input checked="" type="checkbox"/>	<input type="checkbox"/>
As-built measurements taken, GPS located	<input checked="" type="checkbox"/>	<input checked="" type="checkbox"/>	<input checked="" type="checkbox"/>	<input checked="" type="checkbox"/>	<input type="checkbox"/>
CCTV pipe inspection data and comments supplied	<input checked="" type="checkbox"/>	<input checked="" type="checkbox"/>	<input checked="" type="checkbox"/>	<input checked="" type="checkbox"/>	<input type="checkbox"/>

Was Construction

Developer/Contractor

14/12/20

Date

F4.3 STORMWATER MANHOLE CHECKLIST

Engineering Plan Number(s)						
Name of certified drainlayer:						
Location:	Pipe length (MH To MH)	Outlet 15	19.5	19.4	19.1	20.1

MH number

Manhole Construction Checklist

Manhole size, quality, manufacturer on acceptable materials list	<input checked="" type="checkbox"/>	<input checked="" type="checkbox"/>	<input checked="" type="checkbox"/>	<input checked="" type="checkbox"/>	<input checked="" type="checkbox"/>
Set out /orientation	<input checked="" type="checkbox"/>	<input checked="" type="checkbox"/>	<input checked="" type="checkbox"/>	<input checked="" type="checkbox"/>	<input checked="" type="checkbox"/>
Sealing strip between risers	<input checked="" type="checkbox"/>	<input checked="" type="checkbox"/>	<input checked="" type="checkbox"/>	<input checked="" type="checkbox"/>	<input checked="" type="checkbox"/>
Benching - Height - alignment and cross section - half pipe lining (wastewater only) - Step recesses (if applicable)	<input checked="" type="checkbox"/> <input checked="" type="checkbox"/> <input checked="" type="checkbox"/> <input checked="" type="checkbox"/>	<input checked="" type="checkbox"/> <input checked="" type="checkbox"/> <input checked="" type="checkbox"/> <input checked="" type="checkbox"/>	<input checked="" type="checkbox"/> <input checked="" type="checkbox"/> <input checked="" type="checkbox"/> <input checked="" type="checkbox"/>	<input checked="" type="checkbox"/> <input checked="" type="checkbox"/> <input checked="" type="checkbox"/> <input checked="" type="checkbox"/>	<input checked="" type="checkbox"/> <input checked="" type="checkbox"/> <input checked="" type="checkbox"/> <input checked="" type="checkbox"/>
Flexible joints	<input checked="" type="checkbox"/>	<input checked="" type="checkbox"/>	<input checked="" type="checkbox"/>	<input checked="" type="checkbox"/>	<input checked="" type="checkbox"/>
Bulk backfill compaction - Dynamic Cone Penetrometer (DCP) results attached	<input checked="" type="checkbox"/>	<input checked="" type="checkbox"/>	<input checked="" type="checkbox"/>	<input checked="" type="checkbox"/>	<input checked="" type="checkbox"/>
No debris in pipelines	<input checked="" type="checkbox"/>	<input checked="" type="checkbox"/>	<input checked="" type="checkbox"/>	<input checked="" type="checkbox"/>	<input checked="" type="checkbox"/>
Pipe invert fall through manhole	<input checked="" type="checkbox"/>	<input checked="" type="checkbox"/>	<input checked="" type="checkbox"/>	<input checked="" type="checkbox"/>	<input checked="" type="checkbox"/>

West Construction

14/12/20

Developer/Contractor

Date

F4.3 STORMWATER MANHOLE CHECKLIST

Engineering Plan Number(s)					
Name of certified drainlayer:					
Location: Pipe length (MH To MH)	15.1	21.2	21.1	22.2	22.1

MH number

Manhole Construction Checklist

Manhole size, quality, manufacturer on acceptable materials list	<input checked="" type="checkbox"/>	<input checked="" type="checkbox"/>	<input checked="" type="checkbox"/>	<input checked="" type="checkbox"/>	<input checked="" type="checkbox"/>
Set out /orientation	<input checked="" type="checkbox"/>	<input checked="" type="checkbox"/>	<input checked="" type="checkbox"/>	<input checked="" type="checkbox"/>	<input checked="" type="checkbox"/>
Sealing strip between risers	<input checked="" type="checkbox"/>	<input checked="" type="checkbox"/>	<input checked="" type="checkbox"/>	<input checked="" type="checkbox"/>	<input checked="" type="checkbox"/>
Benching - Height - alignment and cross section - half pipe lining (wastewater only) - Step recesses (if applicable)	<input checked="" type="checkbox"/>	<input checked="" type="checkbox"/>	<input checked="" type="checkbox"/>	<input checked="" type="checkbox"/>	<input checked="" type="checkbox"/>
Flexible joints	<input checked="" type="checkbox"/>	<input checked="" type="checkbox"/>	<input checked="" type="checkbox"/>	<input checked="" type="checkbox"/>	<input checked="" type="checkbox"/>
Cutting and plastering of connections	<input checked="" type="checkbox"/>	<input checked="" type="checkbox"/>	<input checked="" type="checkbox"/>	<input checked="" type="checkbox"/>	<input checked="" type="checkbox"/>
Access details per drawings (e.g. manhole cover sited over steps).	<input checked="" type="checkbox"/>	<input checked="" type="checkbox"/>	<input checked="" type="checkbox"/>	<input checked="" type="checkbox"/>	<input checked="" type="checkbox"/>
Pipe invert fall through manhole	<input checked="" type="checkbox"/>	<input checked="" type="checkbox"/>	<input checked="" type="checkbox"/>	<input checked="" type="checkbox"/>	<input checked="" type="checkbox"/>

West Construction

14/12/20

Developer/Contractor

Date

F4.4 STORMWATER TRENCH BACKFILL COMPACTION TEST SUMMARY

(attach individual test reports)

Technician West Construction Carrying out Tests

Location: Greenhill Park Stage 13, 14, 15

Plan No(s): 21879-M-13-S02

From MH 19.4-22.2-22.1 to MH

Acceptance Criteria: CBR > 16

Tests by: West Construction (attached)

Analysis of Results

Trench backfill completed satisfactorily as follows: or Trench backfill requires remedial work

West Construction

Developer/Contractor

Date

14/12/20

F4.4 STORMWATER TRENCH BACKFILL COMPACTION TEST SUMMARY

(attach individual test reports)

Technician West Construction Carrying out Tests

Location: Greenhill Park Stage B-14-15

Plan No(s): 21879-M-13-S01

From MH 15.2-15.1 to MH

Acceptance Criteria: CBR > 15

Tests by: West Construction (attached)

Analysis of Results

Trench backfill completed satisfactorily as follows: or Trench backfill requires remedial work

West Construction

Developer/Contractor

Date

14/12/20

F4.4 STORMWATER TRENCH BACKFILL COMPACTION TEST SUMMARY

(attach individual test reports)

Technician West Construction 2011 Carrying out Tests

Location: Greenhill Park Stage 13, 14, 15

Plan No(s): 21877-M-13-S01

From MH 19.4-19.1-20.1 to MH

Acceptance Criteria: CBR > 16

Tests by: West Construction (attached)

Analysis of Results

Trench backfill completed satisfactorily as follows: or Trench backfill requires remedial work

West Construction

Developer/Contractor

Date 14/12/20

F4.5 STORMWATER CATCHPIT CHECKLIST

Location:	117	118	119	114	115
Catchpit Number					

Catchpit Construction Checklist

Catchpit , type, size, quality, accepted material checked	<input checked="" type="checkbox"/>	<input checked="" type="checkbox"/>	<input checked="" type="checkbox"/>	<input checked="" type="checkbox"/>	<input type="checkbox"/>
Set out /orientation	<input checked="" type="checkbox"/>	<input checked="" type="checkbox"/>	<input checked="" type="checkbox"/>	<input checked="" type="checkbox"/>	<input checked="" type="checkbox"/>
Location checked	<input checked="" type="checkbox"/>	<input checked="" type="checkbox"/>	<input checked="" type="checkbox"/>	<input checked="" type="checkbox"/>	<input checked="" type="checkbox"/>
Depth of sump below outlet correct	<input checked="" type="checkbox"/>	<input checked="" type="checkbox"/>	<input checked="" type="checkbox"/>	<input checked="" type="checkbox"/>	<input checked="" type="checkbox"/>
Cutting and plastering of outlet connection	<input checked="" type="checkbox"/>	<input checked="" type="checkbox"/>	<input checked="" type="checkbox"/>	<input checked="" type="checkbox"/>	<input checked="" type="checkbox"/>
Floating debris baffle installed correctly	<input checked="" type="checkbox"/>	<input checked="" type="checkbox"/>	<input checked="" type="checkbox"/>	<input checked="" type="checkbox"/>	<input checked="" type="checkbox"/>
Backfill compaction around pit checked	<input checked="" type="checkbox"/>	<input checked="" type="checkbox"/>	<input checked="" type="checkbox"/>	<input checked="" type="checkbox"/>	<input checked="" type="checkbox"/>
Seating and plastering of surround and grate to sump barrel	<input checked="" type="checkbox"/>	<input checked="" type="checkbox"/>	<input checked="" type="checkbox"/>	<input checked="" type="checkbox"/>	<input checked="" type="checkbox"/>
All silt and debris removed from sump	<input checked="" type="checkbox"/>	<input checked="" type="checkbox"/>	<input checked="" type="checkbox"/>	<input checked="" type="checkbox"/>	<input checked="" type="checkbox"/>

West Construction

Developer/Contractor

14/12/20

Date

F4.5 STORMWATER CATCHPIT CHECKLIST

Location:	107	108	087	101	109
	Catchpit Number				

Catchpit Construction Checklist

Catchpit , type, size, quality, accepted material checked	<input checked="" type="checkbox"/>	<input checked="" type="checkbox"/>	<input checked="" type="checkbox"/>	<input checked="" type="checkbox"/>	<input checked="" type="checkbox"/>
Set out /orientation	<input checked="" type="checkbox"/>	<input checked="" type="checkbox"/>	<input checked="" type="checkbox"/>	<input checked="" type="checkbox"/>	<input checked="" type="checkbox"/>
Location checked	<input checked="" type="checkbox"/>	<input checked="" type="checkbox"/>	<input checked="" type="checkbox"/>	<input checked="" type="checkbox"/>	<input checked="" type="checkbox"/>
Depth of sump below outlet correct	<input checked="" type="checkbox"/>	<input checked="" type="checkbox"/>	<input checked="" type="checkbox"/>	<input checked="" type="checkbox"/>	<input checked="" type="checkbox"/>
Cutting and plastering of outlet connection	<input checked="" type="checkbox"/>	<input checked="" type="checkbox"/>	<input checked="" type="checkbox"/>	<input checked="" type="checkbox"/>	<input checked="" type="checkbox"/>
West Construction
Developer/Contractor

14/12/20
Date

F4.5 STORMWATER CATCHPIT CHECKLIST

Location:	116	112	113	111	110
	Catchpit Number				

Catchpit Construction Checklist

Catchpit , type, size, quality, accepted material checked	<input checked="" type="checkbox"/>	<input checked="" type="checkbox"/>	<input checked="" type="checkbox"/>	<input checked="" type="checkbox"/>	<input checked="" type="checkbox"/>
Set out /orientation	<input checked="" type="checkbox"/>	<input checked="" type="checkbox"/>	<input checked="" type="checkbox"/>	<input checked="" type="checkbox"/>	<input checked="" type="checkbox"/>
Location checked	<input checked="" type="checkbox"/>	<input checked="" type="checkbox"/>	<input checked="" type="checkbox"/>	<input checked="" type="checkbox"/>	<input checked="" type="checkbox"/>
Depth of sump below outlet correct	<input checked="" type="checkbox"/>	<input checked="" type="checkbox"/>	<input checked="" type="checkbox"/>	<input checked="" type="checkbox"/>	<input checked="" type="checkbox"/>
Cutting and plastering of outlet connection	<input checked="" type="checkbox"/>	<input checked="" type="checkbox"/>	<input checked="" type="checkbox"/>	<input checked="" type="checkbox"/>	<input checked="" type="checkbox"/>
Floating debris baffle installed correctly	<input checked="" type="checkbox"/>	<input checked="" type="checkbox"/>	<input checked="" type="checkbox"/>	<input checked="" type="checkbox"/>	<input checked="" type="checkbox"/>
Backfill compaction around pit checked	<input checked="" type="checkbox"/>	<input checked="" type="checkbox"/>	<input checked="" type="checkbox"/>	<input checked="" type="checkbox"/>	<input checked="" type="checkbox"/>
Seating and plastering of surround and grate to sump barrel	<input checked="" type="checkbox"/>	<input checked="" type="checkbox"/>	<input checked="" type="checkbox"/>	<input checked="" type="checkbox"/>	<input checked="" type="checkbox"/>
All silt and debris removed from sump	<input checked="" type="checkbox"/>	<input checked="" type="checkbox"/>	<input checked="" type="checkbox"/>	<input checked="" type="checkbox"/>	<input checked="" type="checkbox"/>

West Construction

Developer/Contractor

14/12/20

Date

F4.6 STORMWATER PIPE NETWORK - FINAL INSPECTION CHECKLIST

Site/Location: *Greenhill Park Stages 13,14,15*

Developer/Contractor: *West Construction*

SUB ____ / ____ Contract No: _____

PRE-MEETING TASKS

Developer to verify checklist prior to meeting:

	Developer Check	Council Rep Check
1. All relevant stormwater checklists completed	<input checked="" type="checkbox"/>	<input type="checkbox"/>
2. All lines flushed out	<input checked="" type="checkbox"/>	<input type="checkbox"/>
3. All required CCTV inspections carried out, reviewed and any re-work completed.	<input checked="" type="checkbox"/>	<input type="checkbox"/>
4. All manholes checked (eg infiltration, plastering)	<input checked="" type="checkbox"/>	<input type="checkbox"/>
5. All backfilling complete and tidied up	<input checked="" type="checkbox"/>	<input type="checkbox"/>
6. Final as-built and operational plans attached for site inspection	<input type="checkbox"/>	<input type="checkbox"/>

SITE MEETING

1. Inspect all lines	<input type="checkbox"/>	<input type="checkbox"/>
2. Inspect all manholes and catchpits	<input type="checkbox"/>	<input type="checkbox"/>
3. Works on third party land completed to satisfaction of owner	<input type="checkbox"/>	<input type="checkbox"/>
4. Overland flow to and from adjoining properties not affected	<input type="checkbox"/>	<input type="checkbox"/>
5. Remedial work required? <input type="checkbox"/> Yes (please list) <input type="checkbox"/> No		

Developer *West Construction*

Council

Date *9/3/21*

Date

F5.6 WASTEWATER PIPE NETWORK - FINAL INSPECTION CHECKLIST

Site/Location: *Greenhill Park Stages 13,14,15*

Developer/Contractor: *West Construction*

SUB _____ / _____ Contract No: _____

Developer to verify checklist prior to meeting:	Developer Check	Council Rep Check
6. All checklists completed (add form numbers)	<input checked="" type="checkbox"/>	<input type="checkbox"/>
7. All lines flushed out	<input checked="" type="checkbox"/>	<input type="checkbox"/>
8. All required CCTV inspections carried out, reviewed and any re-work completed.	<input checked="" type="checkbox"/>	<input type="checkbox"/>
9. All manholes checked (eg. Infiltration, plastering)	<input checked="" type="checkbox"/>	<input type="checkbox"/>
10. All backfilling complete and tidied up	<input checked="" type="checkbox"/>	<input type="checkbox"/>
11. Pressure test completed and witnessed	<input checked="" type="checkbox"/>	<input type="checkbox"/>
12. Final as-built and operational plans attached for site inspection	<input type="checkbox"/>	<input type="checkbox"/>

Site Meeting

13. Inspect all lines	<input type="checkbox"/>	<input type="checkbox"/>
14. Inspect all manholes and catchpits	<input type="checkbox"/>	<input type="checkbox"/>
15. Inspect SW inlet and outlet structures	<input type="checkbox"/>	<input type="checkbox"/>
16. Secondary flowpaths and detention ponds	<input type="checkbox"/>	<input type="checkbox"/>
17. Works on third party land completed to satisfaction of owner	<input type="checkbox"/>	<input type="checkbox"/>
18. Wastewater pumping station data complete and test results (Form F5.7) attached	<input type="checkbox"/>	<input type="checkbox"/>
19. Overland flow to and from adjoining properties not affected	<input type="checkbox"/>	<input type="checkbox"/>
20. Remedial work required?	<input type="checkbox"/> Yes (please list)	<input type="checkbox"/> No

Council _____

Developer _____

West Construction 9/3/21



BACKFILL RESULT SHEET

TESTED BY:	West Construction	
PROJECT NAME :	Greenhill Park Stages 13,14,15	
Chainage	C/L Trench(CIV VALUES)	Remarks
SWMH 19.5	1ST LIFT	
10	NA	BERM
20	NA	BERM
30	21	BROWN ROCK 1M TESTS
40	23	BROWN ROCK 1M TESTS
SWMH 19.4		
10	19	BROWN ROCK 1M TESTS
20	23	BROWN ROCK 1M TESTS
30	21	BROWN ROCK 1M TESTS
40	25	BROWN ROCK 1M TESTS
50	26	BROWN ROCK 1M TESTS
60	24	BROWN ROCK 1M TESTS
70	21	BROWN ROCK 1M TESTS
SWMH 22.2		
10	25	BROWN ROCK 1M TESTS
20	26	BROWN ROCK 1M TESTS
30	24	BROWN ROCK 1M TESTS
40	17	BROWN ROCK 1M TESTS
50	24	BROWN ROCK 1M TESTS
SWMH 22.1		
SWMH 19.4		
10	19	BROWN ROCK 1M TESTS
20	20	BROWN ROCK 1M TESTS
30	23	BROWN ROCK 1M TESTS
40	24	BROWN ROCK 1M TESTS
50	29	BROWN ROCK 1M TESTS
60	27	BROWN ROCK 1M TESTS
70	23	BROWN ROCK 1M TESTS
SWMH 19.1		
10	24	BROWN ROCK 1M TESTS
20	29	BROWN ROCK 1M TESTS
30	27	BROWN ROCK 1M TESTS
40	23	BROWN ROCK 1M TESTS
50	24	BROWN ROCK 1M TESTS
60	28	BROWN ROCK 1M TESTS
70	21	BROWN ROCK 1M TESTS
SWMH 21.2		
10	30	BROWN ROCK 1M TESTS
20	25	BROWN ROCK 1M TESTS
30	26	BROWN ROCK 1M TESTS
40	22	BROWN ROCK 1M TESTS
SWMH 21.1		
SWMH 19.1		
10	27	BROWN ROCK 1M TESTS
20	29	BROWN ROCK 1M TESTS
30	19	BROWN ROCK 1M TESTS
40	24	BROWN ROCK 1M TESTS
50	23	BROWN ROCK 1M TESTS
60	24	BROWN ROCK 1M TESTS
70	22	BROWN ROCK 1M TESTS
80	24	BROWN ROCK 1M TESTS
SWMH20.1		
SWMH15.2EX		
20	21	BROWN ROCK 1M TESTS
30	23	BROWN ROCK 1M TESTS
40	24	BROWN ROCK 1M TESTS
50	21	BROWN ROCK 1M TESTS
SWMH15.1		

Barry Pearson

From: Barry Pearson (Shrimpton and Lipinski Limited Partnership (HQ - Tauranga))
<bpearson@sltga.co.nz>
Sent: Tuesday, 13 April 2021 3:24 PM
To: Martyn Smith (Hamilton City Council (Hamilton))
Subject: Document Issue No. 9 - Stage 15 GHP - CCTV SW and WW
Attachments: 19-30378-03 - Greenhill Park - Area M Stage 13, 14 and 15 - Issue 9.pdf

19-30378-03 - Greenhill Park - Area M Stage 13, 14 and 15 Issue 9

Issued by: Barry Pearson (Shrimpton and Lipinski Limited Partnership)
On: 13 Apr 2021

Stage 15 GHP - CCTV SW and WW for Review

Note that we intend to submit our Greenhill Park engineering works completion report to HCC approx. 14th April 2021 for review and approval.

Thanks

[Access the documents for this issue](#)

Recipients:

Martyn Smith (Hamilton City Council (Hamilton))
Lance Parkes (Hamilton City Council (Hamilton))
Murray Giles (Hamilton City Council (Hamilton))
Barry Pearson (Shrimpton and Lipinski Limited Partnership (HQ - Tauranga))
Mark Derksen (Shrimpton and Lipinski Limited Partnership (HQ - Tauranga))

BARRY PEARSON



S&L
Land Development
and Design Specialists

36 Kereiti Street, Tauranga 3110
PO Box 231, Tauranga 3140
07 577 6069 bpearson@sltga.co.nz
www.sltga.co.nz

APPENDIX 6

Landscaping Certifications

- Landscaping final inspection form requested from HCC



APPENDIX 7

Network Utilities Certifications

- Ultrafast Fibre Completion Letter
- First Gas Completion Letter
- Street Light Product Warranty
- WEL Completion Letter
- Street light Suppliers Declaration of Conformity
- Streetlight Producer Statement
- Streetlight COC & ROI Certificates
- HCC Form Street Light RAMM Data



Ref: S&L Consultants, Surveyors & Engineers – 20413-S15
ID: HN-086-18



27th of March 2021

0800 342 735
info@ultrafast.co.nz

ultrafastfibre.co.nz

ACCEPTANCE BY ULTRAFIBRE LIMITED AS TELECOMMUNICATIONS OPERATOR

Subdivision: Greenhill Park Ruakura Residential Stage 15 (27 Lots), Lot 702, DP 534481, Chartwell, Hamilton.

1. Ultrafast Fibre Limited (UFF) confirms that UFF will be the telecommunications operator of the telecommunications reticulation in the proposed public roads for the Ruakura Residential Stage 15 [Greenhill Park] Hamilton, Subdivision by Chedworth Properties Ltd. (the “**Subdivision**”) Lot 702, DP 534481, to provide network connections to Lot 407 through to Lot 433, in the Subdivision (the “**Reticulation**”).
2. The Reticulation is now installed in accordance with:
 - (a) the requirements and standards set by the Hamilton City Council and advised to UFF via the Council’s website; and
 - (b) the requirements of the Telecommunications Act 2001 and all other applicable laws, regulations and codes (as amended).
3. The Reticulation has been installed by Broadspectrum Limited to UFF’s satisfaction, for the specific subdivision lots detailed on the “final” Scheme Plan as attached, with UFF remaining the owner, operator and maintainer of the Reticulation.
4. The attached “final” Scheme Plan must match your submission to the Hamilton City Council and must have the UFF stamp of ‘Approval’ accompanied by sign-off. Any additional lots created after initial deployment of multi-duct/fibre infrastructure will be chargeable.
5. One or more retail service providers will be available to supply telecommunications services over the completed Reticulation when service is available, provided that UFF shall not be responsible if the retail service provider’s offer to supply such telecommunications services or the number of such providers varies from time to time.


SIGNED for and on behalf of
ULTRAFIBRE LIMITED by:

Signature:

A handwritten signature in black ink, appearing to read "R. Gibson", written over a white background.

Name: Russell Gibson

Date: 27th of March 2021

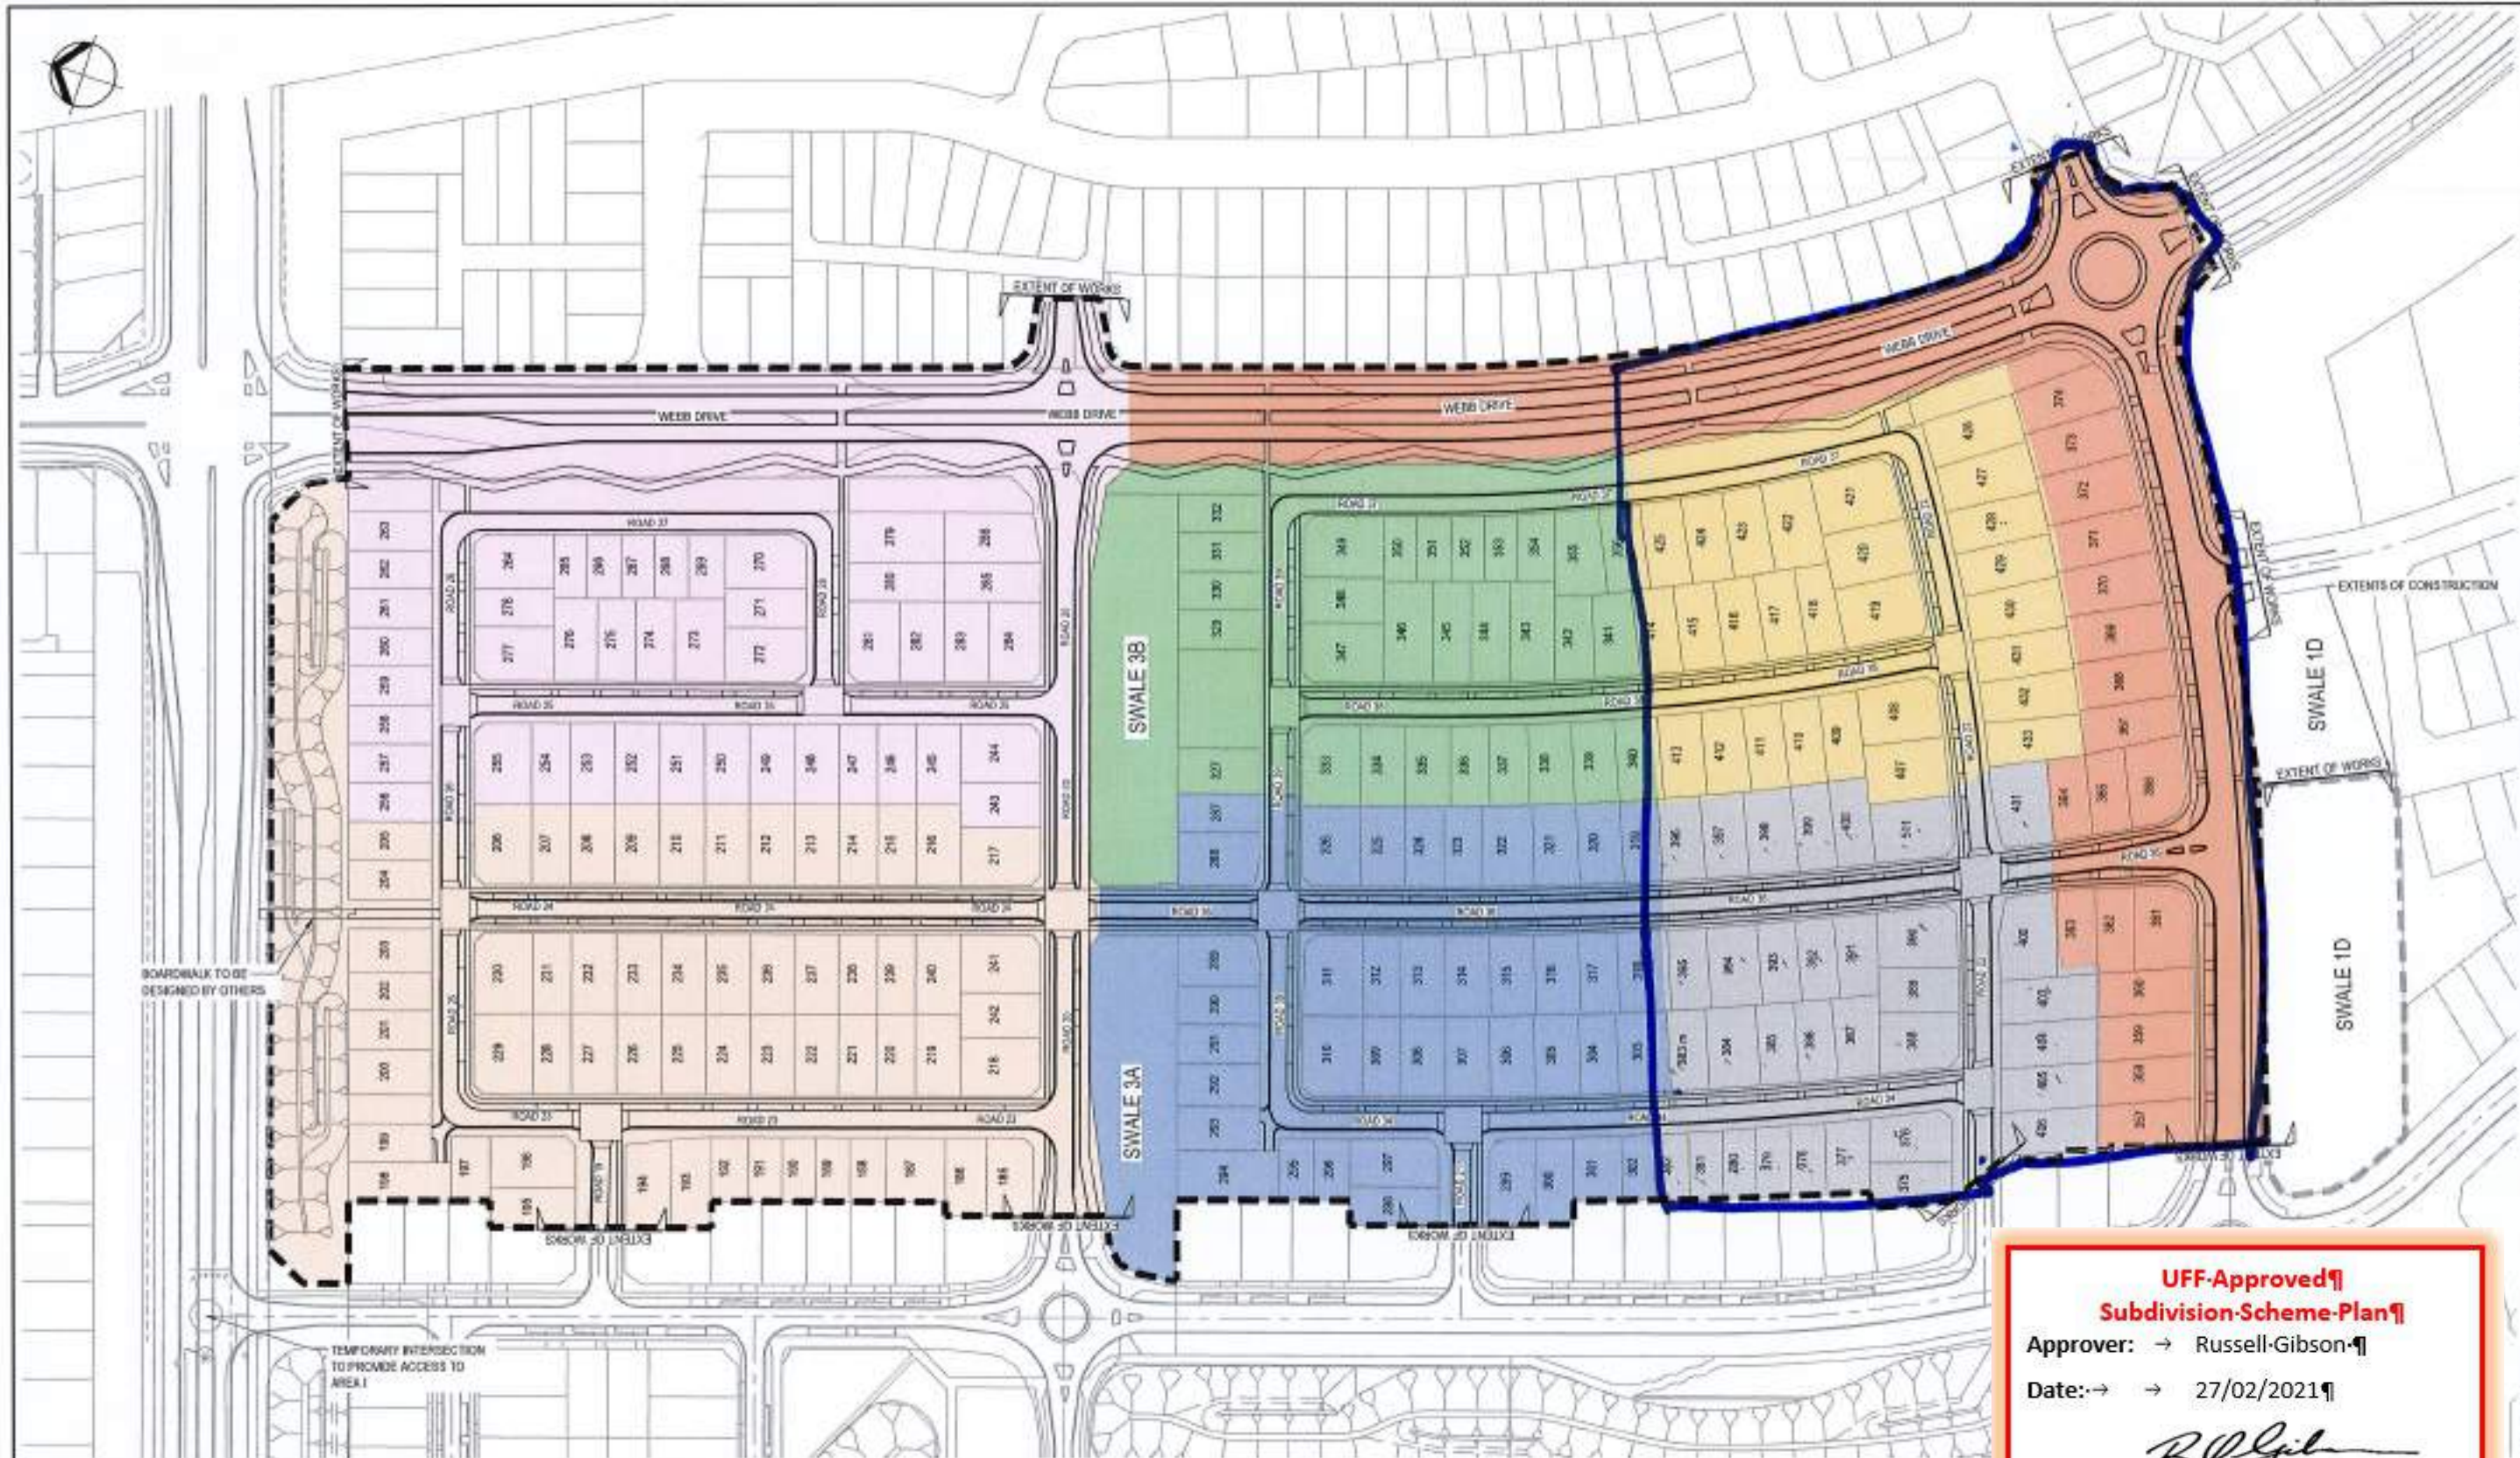

UFF-Approved
Subdivision-Scheme-Plan
 Approver: → Russell-Gibson
 Date: → → 27/02/2021
 Signature: *R. Gibson*

LEGEND:

AREA M-EXTENTS	AREA M - STAGE 10	AREA M - STAGE 13
STORMWATER CULVERT	AREA M - STAGE 11	AREA M - STAGE 14
BASIN LOW FLOW CHANNEL	AREA M - STAGE 12	AREA M - STAGE 15
AREA N - STAGE 9		

18 lots
33 lots
27 lots

- NOTES:**
1. EXTENT OF WORKS IS DEFINED AS THE "AREA M EXTENTS" AS SHOWN ON THE PLANS.
 2. ALL WORKS TO BE CONSTRUCTED IN ACCORDANCE WITH HAMILTON CITY COUNCIL INFRASTRUCTURE TECHNICAL SPECIFICATIONS (UNLESS OTHERWISE SPECIFIED).
 3. DETAILS OF INTERFACING WITH OTHER PROJECT STAGES TO BE CONFIRMED ON SITE PRIOR TO CONSTRUCTION.


**ORIGINAL DRAWING
IN COLOUR**

FOR CONSTRUCTION

Completion Certificate

To: Chedworth Properties Limited
From: Paul Bird
Cc: Barry Pearson
Date: 7 April 2021

**SUBJECT: Greenhill Park Subdivision – Stage 15
(First Gas Distribution Network)**

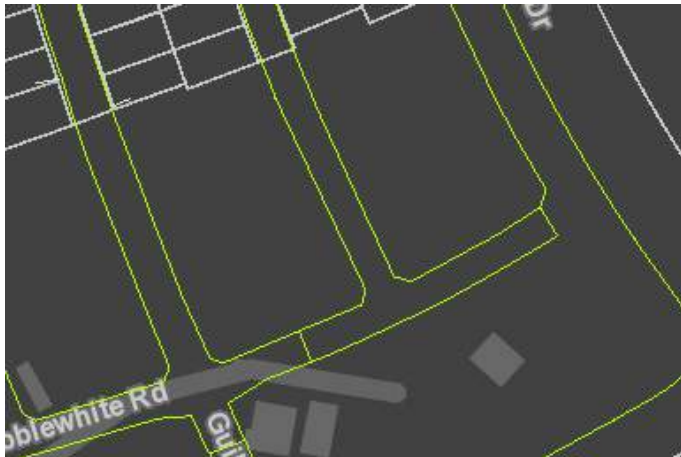

MESSAGE:

This Completion Certificate confirms that the First Gas Distribution Network installed at the above-mentioned development, has been laid, tested and commissioned in accordance with First Gas Technical Standards and relevant Gas Regulations.

Regards

A handwritten signature in blue ink, appearing to read 'Paul Bird'. The signature is stylized and somewhat cursive.

Paul Bird

Distribution Accounts Manager - New Developments

Firstgas

First Gas | Level 6, Resimac House | 45 Johnston St | Wellington | 6011

DDI 04 979 5367 | M 027 531 0060 | firstgas.co.nz

DESIGN CERTIFICATE

INFRASTRUCTURE/ LAND DEVELOPMENT

ISSUED BY: Merritt C Strickett.

TO: Chedworth Properties Ltd

TO BE SUPPLIED TO: Hamilton City Council

IN RESPECT OF: Greenhill Park Stage 15, Hamilton

AT: Carrs Road, Hamilton

Merritt C Strickett has been engaged by Chedworth Properties Ltd

To provide Street Lighting Design to AS/NZS1158 Standard and to Hamilton City Councils Code of Practice and RITS code of practice.

in respect of the infrastructure/land development described above.

Drawing references - REF 7141

I **Merritt C Strickett** have the qualifications and experience relevant to this project as set out herein and have designed the subject works and confirm that the design is to current good engineering practice, and that it satisfies all relevant Resource Consent conditions, relevant TA requirements, and applicable codes and standards. My company holds professional indemnity insurance in the sum of **\$5,000,000.00**

Qualifications and experience

NZIHT Workshop, 32 years' experience in Street lighting design.

Efficient Road Lighting Resource Workshop.

ae

Date: 10 November 2020

10 November 2020

Ref: 7141

PRODUCER STATEMENT FOR STREET LIGHTING

Project: Greenhill Park Area M Stage 15

Location: Carrs Road Hamilton

The lighting for this Project has been designed to comply with the New Zealand standard AS/NZS1158.3.1.2020 for PR4 and PR5 using Perfectlite and AGI32 lighting design software and in conjunction with the Hamilton City Council and RITS Code of Practice requirements

Product The P Category luminaires are Mini Stork 4 LED Optic P, 3000K, and the lighting columns and outreach arms are manufactured from steel which is hot dipped galvanised after fabrication and then coated with a 10 year warranty paint finish

Lifetime The luminaire have an economic life of 15-20 years where normal maintenance is carried out. The pole and outreach have an economic life of 40 years.

Yours Faithfully

IBEX INTERNATIONAL LIMITED



MERRITT STRICKETT

Account Manager - Roadway

M +64 21 220 1291 **T** +64 9 915 1083

merritts@ibexlighting.com

IBEXLIGHTING.COM

IBEX 10 Year Limited Warranty – Project Warranty

Date: 04-03-2021

Project: Greenhill Park, Stage 15

Ref: 7141-00

Issued To: Chedworth Properties Limited

Transfer Provision: Hamilton City Council

a) This limited warranty is provided by Ibex International limited (“Ibex”) in relation to the following products;

Luminaire – Vizulo Mini Stork Lens21 (5 year warranty)

Column – 6m Tapered column with ‘Milford’ Outreach (10yr Warranty Black paint Finish)

b) Ibex warrants to the purchaser that it will deliver the product in new condition in the product’s factory packaging. Further, the product will be free of defects in materials and/or workmanship for the warranty period stated.

c) Ibex has sole discretion as to whether any warranty claim shall be valid considering all factors including (without limitation) the operating conditions the product has endured and the overall performance of the product. this warranty is only valid when proof of purchase can be provided and if the product has been operating within New Zealand

d) The warranty period commences from the date of Ibex’s invoice or the product’s delivery date whichever is the earlier.

e) If Ibex determines that a warranty claim is valid, Ibex will at its sole discretion either refund the purchase price of the product, refund the current market cost of an alternative product, repair the product or replace the product. In case of the repair or replacement the replacement product may not necessary be an identical product but an improved version due to ongoing technological developments and/or supply of original components currently available.

f) Ibex reserve the right to recondition/refurbish any article that is subject to a warranty claim or replace parts with new or used parts in satisfaction of this warranty.

2 - Warranty Exclusions

a) This warranty excludes any costs incurred by the purchaser including (without limitation) equipment hire, labour charges, accommodation charges, transport charges and travel charges.

b) This warranty does not apply to loss or damages to the product caused by one or more of the following:

- Negligence and/or incorrect handling of the product by the buyer, installer, service agent or any other party acting on behalf or for the buyer;
- Improper installation;
- Improper handling;
- the product not being installed or maintained as set out in the installation instruction guide for the product;
- Acts of nature , fire , vandalism;
- Civil disturbances;
- Damages caused by fall or collision
- Installation or operation under environmental conditions beyond the manufacturer’s recommendations;
- Power surges;
- Electrical supply fluctuations or faults;
- Mechanical failures as a result of actions not considered by Ibex to be within the normal operating conditions of the product;

Improper service and/or maintenance work carried out by someone not considered by the Ibex as an approved service agent/facilitator; and/or

• any other situation and/or event or circumstance deemed by Ibex as sufficient to render this warranty void.

c) Notwithstanding any other provision of this warranty or any statute or rule of law, to the greatest extent possible Ibex shall have no liability for any costs, damages or other losses directly or indirectly attributable to failure of the product. Further, Ibex shall have no liability for any costs incurred by any party for any maintenance or remedial work.

3 - Product performance

a) Ibex retains the sole discretion to determine whether a product is defective.

b) This warranty shall apply only to the malfunction of products due to defects in material and or workmanship exceeding nominal failure rates. Unless otherwise stipulated in the product and application specifications provided by Ibex, the nominal failure rate for electronic operating devices and components such as LED's shall be set at 0.2% per 1000 operating hours.

Furthermore a decrease in luminous flux of up to 0.6% per 1,000 operating hours and colour shift as per the LED Module /chip suppliers technical data information shall be considered normal and is not covered by this warranty.

c) In the event that LED modules/Chips are replaced, lighting properties may vary from the original product.

4 - Warranty Transfers

this warranty may not be transferred to any entity without either the express written consent of Ibex or this being explicitly stated in the cover notes of this document. Ibex may withhold such consent at its sole and absolute discretion.

5 - Warranty Terms and Conditions

a) In the event where a warranty is claimed on a product which is not faulty, Ibex reserves the right to seek compensation from the entity claiming on the warranty for all costs that have been incurred by Ibex including (without limitation) travel, accommodation, costs of access equipment, and third party service agents' costs.

b) The warranty terms are those specified in wiring in this warranty document only.

c) Ibex's warranty is a back-to-base warranty. Ibex shall bear no responsibility of any charges incurred by any entity for transport of the product to Ibex and/or from Ibex to the warranty claimant.

d) Labour and Service charge incurred by Ibex in repairing / refurbishing any product are not covered in this warranty.

e) The warranty shall be void if the product has been tampered with or parts replaced by personnel that have not be previously authorised by Ibex in writing.

Ibex reserves the right to modify this warranty at any time without prior notification and the new warranty terms shall be valid for all orders placed with the Ibex on or after the new issue date, from the date that the new warranty terms are posted on Ibex's website.



ELECTRICAL CERTIFICATE OF COMPLIANCE & ELECTRICAL SAFETY CERTIFICATE

REFERENCE/CERTIFICATE ID No.:

This form has been designed to be used by licensed electrical workers to certify that installations or Part installations under Part 1 or Part 2 of AS/NZS 3000 are safe to be connected to the specified system of electrical supply.

Location Details:

Contact Details:
(Name and address)

Name of Electrical worker:

Registration/Practising licence number:

Phone & email:

Name and registration number of person(s) supervised:

Certificate of Compliance

Type of work:

Addition

Alteration

New work

The prescribed electrical work is:

Low risk

General

High-risk (Specify):

Means of compliance:

Part 1 of AS/NZS 3000

Part 2 of AS/NZS 3000

Additional Standards or electrical code of practice were required:

No Yes (specify):

Date or range of dates that prescribed electrical work undertaken:

Contains fittings that are safe to connect to a power supply?

Yes

No

Specify type of supply system:

The installation has an earthing system that is correctly rated (where applicable)

Yes

No

Parts of the installation to which this certificate relates that are safe to connect to a power supply?

All Parts (specify)

The work relies on manufacturers instructions:

Yes

No

If yes - identify the instruction manual including name, date and version. Also attach a copy of manufacturer's instructions to this certificate.

(Or provide reference to readily accessible electronic format, eg Internet link.)

Identify: Manufacturer's instructions attached: VIOLU Stark Little Brother LED street luminaire, 2005/2019

Link:

The work has been done in accordance with a certified design:

Yes

No

If yes - identify the certified design including name, date and version. Also attach a copy of the certified design to this certificate.

(Or provide reference to readily accessible electronic format, eg Internet link.)

Identify: Certified design attached: Roadway Lighting Plan drawing

Link:

The work relies on a Supplier Declaration of Conformity (SDoC):

Yes

No

If yes - identify the SDoC including name, date and version OR EESS registration. Also attach a copy of the SDoC to this certificate.

(Or provide reference to readily accessible electronic format, eg Internet link.)

Identify: SDoC attached

Link:

The installation has been satisfactorily tested in accordance with the Electricity (Safety) Regulations 2010

No Yes

Description of Work:

Install New Street Column with LED Head
Install MEN Board, Main Earth and Earth Stake, Cad Welded Connection - Light Risk
Mains Cable, Mains Installation by others.
Livened by others.

Test Results (provide values)

Polarity (Independent earth):	
Insulation resistance:	200+ M Ohms
Earth Continuity:	0.1 Ohms
Bonding:	0.1 Ohms
Fault Loop impedance:	Ohms
Other (specify):	

By signing this document I certify that the completed prescribed electrical work to which this Certificate of Compliance applies has been done lawfully and safely, and the information in the certificate is correct.

Certifier's signature:

Date:

Electrical Safety Certificate

By signing this document I certify that the installation, or part of the installation, to which this Electrical Safety Certificate applies is connected to a power supply and is safe to use.

Certifier's name:

Registration/Practising licence number:

Certifier's signature:

Certificate Issue Date:

Connection Date:

CUSTOMER COPY - THIS IS AN IMPORTANT DOCUMENT AND SHOULD BE RETAINED FOR A MINIMUM OF 7 YEARS



ELECTRICAL CERTIFICATE OF COMPLIANCE & ELECTRICAL SAFETY CERTIFICATE

REFERENCE/CERTIFICATE ID NO.: NWELCOC15792

This form has been designed to be used by licensed electrical workers to certify that installations or Part installations under Part 1 or Part 2 of AS/NZS 3000 are safe to be connected to the specified system of electrical supply.

Location Details:

Subdivision Area M - Stage 9 to 15 Greenhill Park Hamilton #109

Contact Details:
(Name and address)

Name of Electrical worker:

Yeti Martyn

Registration/Practising licence number:

E257490

Phone & email:

yetimartyn@hotmail.com

Name and registration number of person(s) supervised:

Certificate of Compliance

Type of work:

Addition

Alteration

New work

The prescribed electrical work is:

Low risk

General

High-risk (Specify):

Means of compliance:

Part 1 of AS/NZS 3000

Part 2 of AS/NZS 3000

Additional Standards or electrical code of practice were required: No Yes (specify):

Date or range of dates that prescribed electrical work undertaken: 20/02/2021

Contains fittings that are safe to connect to a power supply?

Yes

No

Specify type of supply system: 230V Mains MEN

The installation has an earthing system that is correctly rated (where applicable)

Yes

No

Parts of the installation to which this certificate relates that are safe to connect to a power supply?

All Parts (specify)

The work relies on manufacturers instructions:

Yes

No

If yes - identify the instruction manual including name, date and version. Also attach a copy of manufacturer's instructions to this certificate.

(Or provide reference to readily accessible electronic format, eg Internet link.)

Identify: Manufacturer's instructions attached. VOLU Stok Little Brother LED street luminaire. 20/05/2019

Link:

The work has been done in accordance with a certified design:

Yes

No

If yes - identify the certified design including name, date and version. Also attach a copy of the certified design to this certificate.

(Or provide reference to readily accessible electronic format, eg Internet link.)

Identify: Certified design attached. Roadway Lighting Plan drawing

Link:

The work relies on a Supplier Declaration of Conformity (SDoC):

Yes

No

If yes - identify the SDoC including name, date and version OR EESS registration. Also attach a copy of the SDoC to this certificate.

(Or provide reference to readily accessible electronic format, eg Internet link.)

Identify: SDoC attached

Link:

The installation has been satisfactorily tested in accordance with the Electricity (Safety) Regulations 2010

No

Yes

Description of Work:

Install New Street Column with LED Head
Install MEN Board, Main Earth and Earth Stake, Cad Welded Connection - Light Risk
Mains Cable, Mains Installation by others.
Livened by others.

Test Results (provide values)

Polarity (Independent earth):	
Insulation resistance:	200+ M Ohms
Earth Continuity:	0.1 Ohms
Bonding:	0.1 Ohms
Fault Loop impedance	Ohms
Other (specify):	

By signing this document I certify that the completed prescribed electrical work to which this Certificate of Compliance applies has been done lawfully and safely, and the information in the certificate is correct.

Certifier's signature:

Date:

20/02/2021

Electrical Safety Certificate

By signing this document I certify that the installation, or part of the installation, to which this Electrical Safety Certificate applies is connected to a power supply and is safe to use.

Certifier's name:

Registration/Practising licence number:

Certifier's signature:

Certificate Issue Date:

Connection Date:

CUSTOMER COPY - THIS IS AN IMPORTANT DOCUMENT AND SHOULD BE RETAINED FOR A MINIMUM OF 7 YEARS



ELECTRICAL CERTIFICATE OF COMPLIANCE & ELECTRICAL SAFETY CERTIFICATE

REFERENCE/CERTIFICATE ID No.:

This form has been designed to be used by licensed electrical workers to certify that installations or Part installations under Part 1 or Part 2 of AS/NZS 3000 are safe to be connected to the specified system of electrical supply.

Location Details:

Contact Details:
(Name and address)

Name of Electrical worker:

Registration/Practising licence number:

Phone & email:

Name and registration number of person(s) supervised:

Certificate of Compliance

Type of work:

Addition Alteration New work

The prescribed electrical work is:

Low risk General High-risk (Specify):

Means of compliance:

Part 1 of AS/NZS 3000 Part 2 of AS/NZS 3000

Additional Standards or electrical code of practice were required: No Yes (specify):

Date or range of dates that prescribed electrical work undertaken:

Contains fittings that are safe to connect to a power supply? Yes No

Specify type of supply system:

The installation has an earthing system that is correctly rated (where applicable) Yes No

Parts of the installation to which this certificate relates that are safe to connect to a power supply?

All Parts (specify)

The work relies on manufacturers instructions: Yes No

If yes - identify the instruction manual including name, date and version. Also attach a copy of manufacturer's instructions to this certificate. (Or provide reference to readily accessible electronic format, eg Internet link.)

Identify: Manufacturer's instructions attached. VOLU Stok Little Brother LED street luminaire. 20050019
Link:

The work has been done in accordance with a certified design: Yes No

If yes - identify the certified design including name, date and version. Also attach a copy of the certified design to this certificate. (Or provide reference to readily accessible electronic format, eg Internet link.)

Identify: Certified design attached. Roadway Lighting Plan drawing
Link:

The work relies on a Supplier Declaration of Conformity (SDoC): Yes No

If yes - identify the SDoC including name, date and version OR EESS registration. Also attach a copy of the SDoC to this certificate. (Or provide reference to readily accessible electronic format, eg Internet link.)

Identify: SDoC attached
Link:

The installation has been satisfactorily tested in accordance with the Electricity (Safety) Regulations 2010 No Yes

Description of Work:

Install New Street Column with LED Head
Install MEN Board, Main Earth and Earth Stake, Cad Welded Connection - Light Risk
Mains Cable, Mains Installation by others.
Livened by others.

Test Results (provide values)

Polarity (Independent earth):	
Insulation resistance:	200+ M Ohms
Earth Continuity:	0.1 Ohms
Bonding:	0.1 Ohms
Fault Loop Impedance:	Ohms
Other (specify):	

By signing this document I certify that the completed prescribed electrical work to which this Certificate of Compliance applies has been done lawfully and safely, and the information in the certificate is correct.

Certifier's signature:

Date:

Electrical Safety Certificate

By signing this document I certify that the installation, or part of the installation, to which this Electrical Safety Certificate applies is connected to a power supply and is safe to use.

Certifier's name:

Registration/Practising licence number:

Certifier's signature:

Certificate Issue Date:

Connection Date:

CUSTOMER COPY - THIS IS AN IMPORTANT DOCUMENT AND SHOULD BE RETAINED FOR A MINIMUM OF 7 YEARS



ELECTRICAL CERTIFICATE OF COMPLIANCE & ELECTRICAL SAFETY CERTIFICATE

REFERENCE/CERTIFICATE ID No.: NWELCOC1579 4

This form has been designed to be used by licensed electrical workers to certify that installations or Part installations under Part 1 or Part 2 of AS/NZS 3000 are safe to be connected to the specified system of electrical supply.

Location Details: Subdivision Area M - Stage 9 to 15 Greenhill Park Hamilton # 111

Contact Details:
(Name and address)

Name of Electrical worker: Yeti Martyn **Registration/Practising licence number:** E257490

Phone & email: yeti1martyn@hotmail.com

Name and registration number of person(s) supervised:

Certificate of Compliance

Type of work: Addition Alteration New work

The prescribed electrical work is: Low risk General High-risk (Specify):

Means of compliance: Part 1 of AS/NZS 3000 Part 2 of AS/NZS 3000

Additional Standards or electrical code of practice were required: No Yes (specify):

Date or range of dates that prescribed electrical work undertaken: 20/02/2021

Contains fittings that are safe to connect to a power supply? Yes No

Specify type of supply system: 230V Mains MEN

The installation has an earthing system that is correctly rated (where applicable) Yes No

Parts of the installation to which this certificate relates that are safe to connect to a power supply?

All Parts (specify)

The work relies on manufacturers instructions: Yes No

If yes - Identify the instruction manual including name, date and version. Also attach a copy of manufacturer's instructions to this certificate.
(Or provide reference to readily accessible electronic format, eg Internet link.)

Identify: Manufacturer's instructions attached. VIGLU 500k Luxe Brother LED street luminare, 200550019
Link:

The work has been done in accordance with a certified design: Yes No

If yes - Identify the certified design including name, date and version. Also attach a copy of the certified design to this certificate.
(Or provide reference to readily accessible electronic format, eg Internet link.)

Identify: Certified design attached. Roadway Lighting Plan drawing
Link:

The work relies on a Supplier Declaration of Conformity (SDoC): Yes No

If yes - Identify the SDoC including name, date and version OR EESS registration. Also attach a copy of the SDoC to this certificate.
(Or provide reference to readily accessible electronic format, eg Internet link.)

Identify: SDoC attached
Link:

The installation has been satisfactorily tested in accordance with the Electricity (Safety) Regulations 2010 No Yes

Description of Work:

Install New Street Column with LED Head
Install MEN Board, Main Earth and Earth Stake, Cad Welded Connection - Light Risk
Mains Cable, Mains Installation by others.
Livened by others.

Test Results (provide values)	
Polarity (Independent earth):	
Insulation resistance:	<u>200+ M Ohms</u>
Earth Continuity:	<u>0.1 Ohms</u>
Bonding:	<u>0.1 Ohms</u>
Fault Loop impedance	<u>Ohms</u>
Other (specify):	

By signing this document I certify that the completed prescribed electrical work to which this Certificate of Compliance applies has been done lawfully and safely, and the information in the certificate is correct.

Certifier's signature: [Signature] **Date:** 20/02/2021

Electrical Safety Certificate

By signing this document I certify that the installation, or part of the installation, to which this Electrical Safety Certificate applies is connected to a power supply and is safe to use.

Certifier's name: **Registration/Practising licence number:**

Certifier's signature: **Certificate Issue Date:** **Connection Date:**

CUSTOMER COPY - THIS IS AN IMPORTANT DOCUMENT AND SHOULD BE RETAINED FOR A MINIMUM OF 7 YEARS

This Electrical Safety Certificate also confirms that the electrical work complies with the building code for the purposes of Section 19(1)(a) of the Building Act 2004.



ELECTRICAL CERTIFICATE OF COMPLIANCE & ELECTRICAL SAFETY CERTIFICATE

REFERENCE/CERTIFICATE ID No.:

This form has been designed to be used by licensed electrical workers to certify that installations or Part installations under Part 1 or Part 2 of AS/NZS 3000 are safe to be connected to the specified system of electrical supply.

Location Details:

Contact Details: (Name and address)

Name of Electrical worker: Registration/Practising licence number:

Phone & email:

Name and registration number of person(s) supervised:

Certificate of Compliance

Type of work: Addition Alteration New work
The prescribed electrical work is: Low risk General High-risk (Specify):

Means of compliance: Part 1 of AS/NZS 3000 Part 2 of AS/NZS 3000

Additional Standards or electrical code of practice were required: No Yes (specify):

Date or range of dates that prescribed electrical work undertaken:

Contains fittings that are safe to connect to a power supply? Yes No

Specify type of supply system:

The installation has an earthing system that is correctly rated (where applicable) Yes No

Parts of the installation to which this certificate relates that are safe to connect to a power supply?

All Parts (specify)

The work relies on manufacturers instructions: Yes No

If yes - identify the instruction manual including name, date and version. Also attach a copy of manufacturer's instructions to this certificate. (Or provide reference to readily accessible electronic format, eg internet link.)

Identify: Manufacturer's instructions attached. WOLU Stark Little Brother LED street luminaire, 20/05/2019
Link:

The work has been done in accordance with a certified design: Yes No

If yes - identify the certified design including name, date and version. Also attach a copy of the certified design to this certificate. (Or provide reference to readily accessible electronic format, eg internet link.)

Identify: Certified design attached. Roadway Lighting Plan drawing.
Link:

The work relies on a Supplier Declaration of Conformity (SDoC): Yes No

If yes - identify the SDoC including name, date and version OR EESS registration. Also attach a copy of the SDoC to this certificate. (Or provide reference to readily accessible electronic format, eg internet link.)

Identify: SDoC attached
Link:

The installation has been satisfactorily tested in accordance with the Electricity (Safety) Regulations 2010 No Yes

Description of Work:
Install New Street Column with LED Head
Install MEN Board, Main Earth and Earth Stake, Cad Welded Connection - Light Risk
Mains Cable, Mains Installation by others.
Livened by others.

Test Results (provide values)	
Polarity (Independent earth):	
Insulation resistance:	200+ M Ohms
Earth Continuity:	0.1 Ohms
Bonding:	0.1 Ohms
Fault Loop impedance:	Ohms
Other (specify):	

By signing this document I certify that the completed prescribed electrical work to which this Certificate of Compliance applies has been done lawfully and safely, and the information in the certificate is correct.

Certifier's signature: Date:

Electrical Safety Certificate

By signing this document I certify that the installation, or part of the installation, to which this Electrical Safety Certificate applies is connected to a power supply and is safe to use.

Certifier's name: Registration/Practising licence number:

Certifier's signature: Certificate Issue Date: Connection Date:

CUSTOMER COPY - THIS IS AN IMPORTANT DOCUMENT AND SHOULD BE RETAINED FOR A MINIMUM OF 7 YEARS

This Electrical Safety Certificate also confirms that the electrical work complies with the building code for the purposes of Section 19(1)(e) of the Building Act 2004.



ELECTRICAL CERTIFICATE OF COMPLIANCE & ELECTRICAL SAFETY CERTIFICATE

REFERENCE/CERTIFICATE ID No.:

This form has been designed to be used by licensed electrical workers to certify that installations or Part installations under Part 1 or Part 2 of AS/NZS 3000 are safe to be connected to the specified system of electrical supply.

Location Details:

Contact Details:
(Name and address)

Name of Electrical worker:

Registration/Practising licence number:

Phone & email:

Name and registration number of person(s) supervised:

Certificate of Compliance

Type of work:

- Addition Alteration New work
 Low risk General High-risk (Specify):

The prescribed electrical work is:

Means of compliance:

- Part 1 of AS/NZS 3000 Part 2 of AS/NZS 3000

Additional Standards or electrical code of practice were required: No Yes (specify):

Date or range of dates that prescribed electrical work undertaken:

Contains fittings that are safe to connect to a power supply? Yes No

Specify type of supply system:

The installation has an earthing system that is correctly rated (where applicable) Yes No

Parts of the installation to which this certificate relates that are safe to connect to a power supply?

All Parts (specify)

The work relies on manufacturers instructions: Yes No

If yes - identify the instruction manual including name, date and version. Also attach a copy of manufacturer's instructions to this certificate. (Or provide reference to readily accessible electronic format, eg Internet link.)

Identify: Manufacturer's instructions attached. VCLU Stark Little Brother LED street luminaire. 20/05/2019
Link:

The work has been done in accordance with a certified design: Yes No

If yes - identify the certified design including name, date and version. Also attach a copy of the certified design to this certificate. (Or provide reference to readily accessible electronic format, eg Internet link.)

Identify: Certified design attached. Roadway Lighting Plan drawing
Link:

The work relies on a Supplier Declaration of Conformity (SDoC): Yes No

If yes - identify the SDoC including name, date and version OR EESS registration. Also attach a copy of the SDoC to this certificate. (Or provide reference to readily accessible electronic format, eg Internet link.)

Identify: SDoC attached
Link:

The installation has been satisfactorily tested in accordance with the Electricity (Safety) Regulations 2010 No Yes

Description of Work:

Install New Street Column with LED Head
Install MEN Board, Main Earth and Earth Stake, Cad Welded Connection - Light Risk
Mains Cable, Mains Installation by others.
Livened by others.

Test Results (provide values)

Polarity (Independent earth):	
Insulation resistance:	200+ M Ohms
Earth Continuity:	0.1 Ohms
Bonding:	0.1 Ohms
Fault Loop Impedance:	Ohms
Other (specify):	

By signing this document I certify that the completed prescribed electrical work to which this Certificate of Compliance applies has been done lawfully and safely, and the information in the certificate is correct.

Certifier's signature:

Date:

Electrical Safety Certificate

By signing this document I certify that the installation, or part of the installation, to which this Electrical Safety Certificate applies is connected to a power supply and is safe to use.

Certifier's name:

Registration/Practising licence number:

Certifier's signature:

Certificate Issue Date:

Connection Date:

CUSTOMER COPY - THIS IS AN IMPORTANT DOCUMENT AND SHOULD BE RETAINED FOR A MINIMUM OF 7 YEARS



ELECTRICAL CERTIFICATE OF COMPLIANCE & ELECTRICAL SAFETY CERTIFICATE

REFERENCE/CERTIFICATE ID No.: NWELCOC1579714

This form has been designed to be used by licensed electrical workers to certify that installations or Part installations under Part 1 or Part 2 of AS/NZS 3000 are safe to be connected to the specified system of electrical supply.

Location Details:

Subdivision Area M - Stage 9 to 15 Greenhill Park Hamilton #114

Contact Details:
(Name and address)

Name of Electrical worker:

Yeti Martyn

Registration/Practising licence number:

E257490

Phone & email:

yetimartyn@hotmail.com

Name and registration number of person(s) supervised:

Certificate of Compliance

Type of work:

Addition Alteration New work
 Low risk General High-risk (Specify):

The prescribed electrical work is:

Means of compliance:

Part 1 of AS/NZS 3000 Part 2 of AS/NZS 3000

Additional Standards or electrical code of practice were required: No Yes (specify):

Date or range of dates that prescribed electrical work undertaken: 20/02/2021

Contains fittings that are safe to connect to a power supply? Yes No

Specify type of supply system: 230V Mains MEN

The installation has an earthing system that is correctly rated (where applicable) Yes No

Parts of the installation to which this certificate relates that are safe to connect to a power supply?

All Parts (specify)

The work relies on manufacturers instructions: Yes No

If yes - identify the instruction manual including name, date and version. Also attach a copy of manufacturer's instructions to this certificate. (Or provide reference to readily accessible electronic format, eg Internet link.)

Identify: Manufacturer's instructions attached: VICKLI Stark Little Brother LED street luminaires, 2005/0019

Link:

The work has been done in accordance with a certified design: Yes No

If yes - identify the certified design including name, date and version. Also attach a copy of the certified design to this certificate. (Or provide reference to readily accessible electronic format, eg Internet link.)

Identify: Certified design attached: Roadway Lighting Plan drawing

Link:

The work relies on a Supplier Declaration of Conformity (SDoC): Yes No

If yes - identify the SDoC including name, date and version OR EESS registration. Also attach a copy of the SDoC to this certificate. (Or provide reference to readily accessible electronic format, eg Internet link.)

Identify: SDoC attached

Link:

The installation has been satisfactorily tested in accordance with the Electricity (Safety) Regulations 2010 No Yes

Description of Work:

Install New Street Column with LED Head
Install MEN Board, Main Earth and Earth Stake, Cad Welded Connection - Light Risk
Mains Cable, Mains Installation by others.
Livened by others.

Test Results (provide values)

Polarity (Independent earth):	
Insulation resistance:	200+ M Ohms
Earth Continuity:	0.1 Ohms
Bonding:	0.1 Ohms
Fault Loop impedance	Ohms
Other (specify):	

By signing this document I certify that the completed prescribed electrical work to which this Certificate of Compliance applies has been done lawfully and safely, and the information in the certificate is correct.

Certifier's signature:

[Signature]

Date: 20/02/2021

Electrical Safety Certificate

By signing this document I certify that the installation, or part of the installation, to which this Electrical Safety Certificate applies is connected to a power supply and is safe to use.

Certifier's name:

Registration/Practising licence number:

Certifier's signature:

Certificate Issue Date:

Connection Date:

CUSTOMER COPY - THIS IS AN IMPORTANT DOCUMENT AND SHOULD BE RETAINED FOR A MINIMUM OF 7 YEARS



ELECTRICAL CERTIFICATE OF COMPLIANCE & ELECTRICAL SAFETY CERTIFICATE

REFERENCE/CERTIFICATE ID No.:

This form has been designed to be used by licensed electrical workers to certify that installations or Part installations under Part 1 or Part 2 of AS/NZS 3000 are safe to be connected to the specified system of electrical supply.

Location Details:

Contact Details:
(Name and address)

Name of Electrical worker:

Registration/Practising licence number:

Phone & email:

Name and registration number of person(s) supervised:

Certificate of Compliance

Type of work:

- Addition Alteration New work
 The prescribed electrical work is: Low risk General High-risk (Specify):

Means of compliance:

- Part 1 of AS/NZS 3000 Part 2 of AS/NZS 3000

Additional Standards or electrical code of practice were required: No Yes (specify):

Date or range of dates that prescribed electrical work undertaken:

Contains fittings that are safe to connect to a power supply? Yes No

Specify type of supply system:

The installation has an earthing system that is correctly rated (where applicable) Yes No

Parts of the installation to which this certificate relates that are safe to connect to a power supply?

All Parts (specify)

The work relies on manufacturers instructions: Yes No

If yes - identify the instruction manual including name, date and version. Also attach a copy of manufacturer's instructions to this certificate. (Or provide reference to readily accessible electronic format, eg Internet link.)

Identify: Manufacturer's instructions attached. VOLU Slek Little Brother LED street luminaire, 2005/2018
Link:

The work has been done in accordance with a certified design: Yes No

If yes - identify the certified design including name, date and version. Also attach a copy of the certified design to this certificate. (Or provide reference to readily accessible electronic format, eg Internet link.)

Identify: Certified design attached. Roadway Lighting Plan drawing.
Link:

The work relies on a Supplier Declaration of Conformity (SDoC): Yes No

If yes - identify the SDoC including name, date and version OR EESS registration. Also attach a copy of the SDoC to this certificate. (Or provide reference to readily accessible electronic format, eg Internet link.)

Identify: SDoC attached
Link:

The installation has been satisfactorily tested in accordance with the Electricity (Safety) Regulations 2010 No Yes

Description of Work:

Install New Street Column with LED Head
Install MEN Board, Main Earth and Earth Stake, Cad Welded Connection - Light Risk
Mains Cable, Mains Installation by others.
Livened by others.

Test Results (provide values)

Polarity (Independent earth):	
Insulation resistance:	200+ M Ohms
Earth Continuity:	0.1 Ohms
Bonding:	0.1 Ohms
Fault Loop Impedance:	Ohms
Other (specify):	

By signing this document I certify that the completed prescribed electrical work to which this Certificate of Compliance applies has been done lawfully and safely, and the information in the certificate is correct.

Certifier's signature:

Date:

Electrical Safety Certificate

By signing this document I certify that the installation, or part of the installation, to which this Electrical Safety Certificate applies is connected to a power supply and is safe to use.

Certifier's name:

Registration/Practising licence number:

Certifier's signature:

Certificate Issue Date:

Connection Date:

CUSTOMER COPY - THIS IS AN IMPORTANT DOCUMENT AND SHOULD BE RETAINED FOR A MINIMUM OF 7 YEARS



ELECTRICAL CERTIFICATE OF COMPLIANCE & ELECTRICAL SAFETY CERTIFICATE

REFERENCE/CERTIFICATE ID NO.: NWELCOC1579 9

This form has been designed to be used by licensed electrical workers to certify that installations or Part installations under Part 1 or Part 2 of AS/NZS 3000 are safe to be connected to the specified system of electrical supply.

Location Details:

Subdivision Area M - Stage 9 to 15 Greenhill Park Hamilton # 116

Contact Details:
(Name and address)

Name of Electrical worker:

Yeti Martyn

Registration/Practising licence number:

E257490

Phone & email:

yetimartyn@hotmail.com

Name and registration number of person(s) supervised:

Certificate of Compliance

Type of work:

Addition Alteration New work

The prescribed electrical work is:

Low risk General High-risk (Specify):

Means of compliance:

Part 1 of AS/NZS 3000 Part 2 of AS/NZS 3000

Additional Standards or electrical code of practice were required:

No Yes (specify):

Date or range of dates that prescribed electrical work undertaken:

20/02/2021

Contains fittings that are safe to connect to a power supply?

Yes No

Specify type of supply system:

230V Mains MEN

The installation has an earthing system that is correctly rated (where applicable)

Yes No

Parts of the installation to which this certificate relates that are safe to connect to a power supply?

All Parts (specify)

The work relies on manufacturers instructions:

Yes No

If yes - identify the instruction manual including name, date and version. Also attach a copy of manufacturer's instructions to this certificate.

(Or provide reference to readily accessible electronic format, eg Internet link.)

Identify: Manufacturer's instructions attached: VIOU Stok Lille Brother LED street luminaires, 2005/2019

Link:

The work has been done in accordance with a certified design:

Yes No

If yes - identify the certified design including name, date and version. Also attach a copy of the certified design to this certificate.

(Or provide reference to readily accessible electronic format, eg Internet link.)

Identify: Certified design attached: Roadway Lighting Plan drawing

Link:

The work relies on a Supplier Declaration of Conformity (SDoC):

Yes No

If yes - identify the SDoC including name, date and version OR EESS registration. Also attach a copy of the SDoC to this certificate.

(Or provide reference to readily accessible electronic format, eg Internet link.)

Identify: SDoC attached

Link:

The installation has been satisfactorily tested in accordance with the Electricity (Safety) Regulations 2010

No Yes

Description of Work:

Install New Street Column with LED Head
Install MEN Board, Main Earth and Earth Stake, Cad Welded
Connection - Light Risk
Mains Cable, Mains Installation by others.
Livened by others.

Test Results (provide values)

Polarity (Independent earth):	
Insulation resistance:	<u>200+ M Ohms</u>
Earth Continuity:	<u>0.1 Ohms</u>
Bonding:	<u>0.1 Ohms</u>
Fault Loop impedance:	<u>Ohms</u>
Other (specify):	

By signing this document I certify that the completed prescribed electrical work to which this Certificate of Compliance applies has been done lawfully and safely, and the information in the certificate is correct.

Certifier's signature:

Date: 20/02/2021

Electrical Safety Certificate

By signing this document I certify that the installation, or part of the installation, to which this Electrical Safety Certificate applies is connected to a power supply and is safe to use.

Certifier's name:

Yeti Martyn

Registration/Practising licence number:

E257490

Certifier's signature:

Certificate Issue Date:

20/02/2021

Connection Date:

20/02/2021

CUSTOMER COPY - THIS IS AN IMPORTANT DOCUMENT AND SHOULD BE RETAINED FOR A MINIMUM OF 7 YEARS



ELECTRICAL CERTIFICATE OF COMPLIANCE & ELECTRICAL SAFETY CERTIFICATE

REFERENCE/CERTIFICATE ID NO.:

This form has been designed to be used by licensed electrical workers to certify that installations or Part installations under Part 1 or Part 2 of AS/NZS 3000 are safe to be connected to the specified system of electrical supply.

Location Details:

Contact Details:
(Name and address)

Name of Electrical worker:

Registration/Practising licence number:

Phone & email:

Name and registration number of person(s) supervised:

Certificate of Compliance

Type of work:

Addition

Alteration

New work

The prescribed electrical work is:

Low risk

General

High-risk (Specify):

Means of compliance:

Part 1 of AS/NZS 3000

Part 2 of AS/NZS 3000

Additional Standards or electrical code of practice were required:

No Yes (specify):

Date or range of dates that prescribed electrical work undertaken:

Contains fittings that are safe to connect to a power supply?

Yes

No

Specify type of supply system:

The installation has an earthing system that is correctly rated (where applicable)

Yes

No

Parts of the installation to which this certificate relates that are safe to connect to a power supply?

All

Parts (specify)

The work relies on manufacturers instructions:

Yes

No

If yes - identify the instruction manual including name, date and version. Also attach a copy of manufacturer's instructions to this certificate.

(Or provide reference to readily accessible electronic format, eg internet link.)

Identify: Manufacturer's instructions attached, VOLU Stark Little Brother LED street luminaires, 20/05/2019

Link:

The work has been done in accordance with a certified design:

Yes

No

If yes - identify the certified design including name, date and version. Also attach a copy of the certified design to this certificate.

(Or provide reference to readily accessible electronic format, eg internet link.)

Identify: Certified design attached, Roadway Lighting Plan drawing

Link:

The work relies on a Supplier Declaration of Conformity (SDoC):

Yes

No

If yes - identify the SDoC including name, date and version OR EESS registration. Also attach a copy of the SDoC to this certificate.

(Or provide reference to readily accessible electronic format, eg internet link.)

Identify: SDoC attached

Link:

The installation has been satisfactorily tested in accordance with the Electricity (Safety) Regulations 2010

No

Yes

Description of Work:

Install New Street Column with LED Head

Install MEN Board, Main Earth and Earth Stake, Cad Welded

Connection - Light Risk

Mains Cable, Mains Installation by others.

Livened by others.

Test Results (provide values)

Polarity (Independent earth):	
Insulation resistance:	200+ M Ohms
Earth Continuity:	0.1 Ohms
Bonding:	0.1 Ohms
Fault Loop impedance:	Ohms
Other (specify):	

By signing this document I certify that the completed prescribed electrical work to which this Certificate of Compliance applies has been done lawfully and safely, and the information in the certificate is correct.

Certifier's signature:

Date:

Electrical Safety Certificate

By signing this document I certify that the installation, or part of the installation, to which this Electrical Safety Certificate applies is connected to a power supply and is safe to use.

Certifier's name:

Registration/Practising licence number:

Certifier's signature:

Certificate Issue Date:

Connection Date:

CUSTOMER COPY - THIS IS AN IMPORTANT DOCUMENT AND SHOULD BE RETAINED FOR A MINIMUM OF 7 YEARS



ELECTRICAL CERTIFICATE OF COMPLIANCE & ELECTRICAL SAFETY CERTIFICATE

REFERENCE/CERTIFICATE ID No.:

This form has been designed to be used by licensed electrical workers to certify that installations or Part installations under Part 1 or Part 2 of AS/NZS 3000 are safe to be connected to the specified system of electrical supply.

Location Details:

Contact Details: (Name and address)

Name of Electrical worker: Registration/Practising licence number:

Phone & email:

Name and registration number of person(s) supervised:

Certificate of Compliance

Type of work: Addition Alteration New work

The prescribed electrical work is: Low risk General High-risk (Specify):

Means of compliance: Part 1 of AS/NZS 3000 Part 2 of AS/NZS 3000

Additional Standards or electrical code of practice were required: No Yes (specify):

Date or range of dates that prescribed electrical work undertaken:

Contains fittings that are safe to connect to a power supply? Yes No

Specify type of supply system:

The installation has an earthing system that is correctly rated (where applicable) Yes No

Parts of the installation to which this certificate relates that are safe to connect to a power supply?
 All Parts (specify)

The work relies on manufacturers instructions: Yes No

If yes - identify the instruction manual including name, date and version. Also attach a copy of manufacturer's instructions to this certificate.
 (Or provide reference to readily accessible electronic format, eg Internet link.)

Identify: Manufacturer's instructions attached: WOLU Blok LED Brother LED street luminaires, 20/05/2019
 Link:

The work has been done in accordance with a certified design: Yes No

If yes - identify the certified design including name, date and version. Also attach a copy of the certified design to this certificate.
 (Or provide reference to readily accessible electronic format, eg Internet link.)

Identify: Certified design attached: Roadway Lighting Plan drawing
 Link:

The work relies on a Supplier Declaration of Conformity (SDoC): Yes No

If yes - identify the SDoC including name, date and version OR EESS registration. Also attach a copy of the SDoC to this certificate.
 (Or provide reference to readily accessible electronic format, eg Internet link.)

Identify: SDoC attached
 Link:

The installation has been satisfactorily tested in accordance with the Electricity (Safety) Regulations 2010 No Yes

Description of Work:

Install New Street Column with LED Head
 Install MEN Board, Main Earth and Earth Stake, Cad Welded Connection - Light Risk
 Mains Cable, Mains Installation by others.
 Livened by others.

Test Results (provide values)	
Polarity (Independent earth):	
Insulation resistance:	200+ M Ohms
Earth Continuity:	0.1 Ohms
Bonding:	0.1 Ohms
Fault Loop Impedance	Ohms
Other (specify):	

By signing this document I certify that the completed prescribed electrical work to which this Certificate of Compliance applies has been done lawfully and safely, and the information in the certificate is correct.

Certifier's signature: Date:

Electrical Safety Certificate

By signing this document I certify that the installation, or part of the installation, to which this Electrical Safety Certificate applies is connected to a power supply and is safe to use.

Certifier's name: Registration/Practising licence number:

Certifier's signature: Certificate Issue Date: Connection Date:

CUSTOMER COPY - THIS IS AN IMPORTANT DOCUMENT AND SHOULD BE RETAINED FOR A MINIMUM OF 7 YEARS

This Electrical Safety Certificate also confirms that the electrical work complies with the building code for the purposes of Section 19(1)(c) of the Building Act 2004.



ELECTRICAL CERTIFICATE OF COMPLIANCE & ELECTRICAL SAFETY CERTIFICATE

REFERENCE/CERTIFICATE ID No.:

This form has been designed to be used by licensed electrical workers to certify that installations or Part installations under Part 1 or Part 2 of AS/NZS 3000 are safe to be connected to the specified system of electrical supply.

Location Details:

Contact Details:
(Name and address)

Name of Electrical worker:

Registration/Practising licence number:

Phone & email:

Name and registration number of person(s) supervised:

Certificate of Compliance

Type of work:

Addition Alteration New work

The prescribed electrical work is:

Low risk General High-risk (Specify):

Means of compliance:

Part 1 of AS/NZS 3000 Part 2 of AS/NZS 3000

Additional Standards or electrical code of practice were required: No Yes (specify):

Date or range of dates that prescribed electrical work undertaken:

Contains fittings that are safe to connect to a power supply? Yes No

Specify type of supply system:

The installation has an earthing system that is correctly rated (where applicable) Yes No

Parts of the installation to which this certificate relates that are safe to connect to a power supply?

All Parts (specify)

The work relies on manufacturers instructions: Yes No

If yes - identify the instruction manual including name, date and version. Also attach a copy of manufacturer's instructions to this certificate. (Or provide reference to readily accessible electronic format, eg Internet link.)

Identify: Manufacturer's instructions attached: WOLU Slack Little Brother LED street luminaire, 20/05/2019
Link:

The work has been done in accordance with a certified design: Yes No

If yes - identify the certified design including name, date and version. Also attach a copy of the certified design to this certificate. (Or provide reference to readily accessible electronic format, eg Internet link.)

Identify: Certified design attached: Roadway Lighting Plan drawing
Link:

The work relies on a Supplier Declaration of Conformity (SDoC): Yes No

If yes - identify the SDoC including name, date and version OR EESS registration. Also attach a copy of the SDoC to this certificate. (Or provide reference to readily accessible electronic format, eg Internet link.)

Identify: SDoC attached
Link:

The installation has been satisfactorily tested in accordance with the Electricity (Safety) Regulations 2010 No Yes

Description of Work:

Install New Street Column with LED Head
Install MEN Board, Main Earth and Earth Stake, Cad Welded Connection - Light Risk
Mains Cable, Mains Installation by others.
Livened by others.

Test Results (provide values)

Polarity (Independent earth):	
Insulation resistance:	200+ M Ohms
Earth Continuity:	0.1 Ohms
Bonding:	0.1 Ohms
Fault Loop Impedance:	Ohms
Other (specify):	

By signing this document I certify that the completed prescribed electrical work to which this Certificate of Compliance applies has been done lawfully and safely, and the information in the certificate is correct.

Certifier's signature:

Date:

Electrical Safety Certificate

By signing this document I certify that the installation, or part of the installation, to which this Electrical Safety Certificate applies is connected to a power supply and is safe to use.

Certifier's name:

Registration/Practising licence number:

Certifier's signature:

Certificate Issue Date:

Connection Date:

CUSTOMER COPY - THIS IS AN IMPORTANT DOCUMENT AND SHOULD BE RETAINED FOR A MINIMUM OF 7 YEARS



ELECTRICAL CERTIFICATE OF COMPLIANCE & ELECTRICAL SAFETY CERTIFICATE

REFERENCE/CERTIFICATE ID NO.: **NWELCOC1579 13**

This form has been designed to be used by licensed electrical workers to certify that installations or Part installations under Part 1 or Part 2 of AS/NZS 3000 are safe to be connected to the specified system of electrical supply.

Location Details:

Subdivision Area M - Stage 9 to 15 Greenhill Park Hamilton #121

Contact Details:
(Name and address)

Name of Electrical worker:

Yeti Martyn

Registration/Practising licence number:

E257490

Phone & email:

yetimartyn@hotmail.com

Name and registration number of person(s) supervised:

Certificate of Compliance

Type of work:

- Addition Alteration New work
 Low risk General High-risk (Specify):

The prescribed electrical work is:

Means of compliance:

- Part 1 of AS/NZS 3000 Part 2 of AS/NZS 3000

Additional Standards or electrical code of practice were required: No Yes (specify):

Date or range of dates that prescribed electrical work undertaken: 20/02/2021

Contains fittings that are safe to connect to a power supply? Yes No

Specify type of supply system: 230V Mains MEN

The installation has an earthing system that is correctly rated (where applicable) Yes No

Parts of the installation to which this certificate relates that are safe to connect to a power supply?

All Parts (specify)

The work relies on manufacturers instructions: Yes No

If yes - identify the instruction manual including name, date and version. Also attach a copy of manufacturer's instructions to this certificate. (Or provide reference to readily accessible electronic format, eg Internet link.)

Identify: Manufacturer's instructions attached. VOLLI Stock Little Brother LED street luminaire, 20/05/2019

Link:

The work has been done in accordance with a certified design: Yes No

If yes - identify the certified design including name, date and version. Also attach a copy of the certified design to this certificate. (Or provide reference to readily accessible electronic format, eg Internet link.)

Identify: Certified design attached. Roadway Lighting Plan drawing

Link:

The work relies on a Supplier Declaration of Conformity (SDoC): Yes No

If yes - identify the SDoC including name, date and version OR EESS registration. Also attach a copy of the SDoC to this certificate. (Or provide reference to readily accessible electronic format, eg Internet link.)

Identify: SDoC attached

Link:

The installation has been satisfactorily tested in accordance with the Electricity (Safety) Regulations 2010 No Yes

Description of Work:

Install New Street Column with LED Head
 Install MEN Board, Main Earth and Earth Stake, Cad Welded Connection - Light Risk
 Mains Cable, Mains Installation by others.
 Livened by others.

Test Results (provide values)

Polarity (independent earth):	
Insulation resistance:	200+ M Ohms
Earth Continuity:	0.1 Ohms
Bonding:	0.1 Ohms
Fault Loop impedance:	Ohms
Other (specify):	

By signing this document I certify that the completed prescribed electrical work to which this Certificate of Compliance applies has been done lawfully and safely, and the information in the certificate is correct.

Certifier's signature:

[Signature]

Date: 20/02/2021

Electrical Safety Certificate

By signing this document I certify that the installation, or part of the installation, to which this Electrical Safety Certificate applies is connected to a power supply and is safe to use.

Certifier's name:

Registration/Practising licence number:

Certifier's signature:

Certificate Issue Date:

Connection Date:

CUSTOMER COPY - THIS IS AN IMPORTANT DOCUMENT AND SHOULD BE RETAINED FOR A MINIMUM OF 7 YEARS



ELECTRICAL CERTIFICATE OF COMPLIANCE & ELECTRICAL SAFETY CERTIFICATE

REFERENCE/CERTIFICATE ID No.:

This form has been designed to be used by licensed electrical workers to certify that installations or Part installations under Part 1 or Part 2 of AS/NZS 3000 are safe to be connected to the specified system of electrical supply.

Location Details:

Contact Details:
(Name and address)

Name of Electrical worker:

Registration/Practising licence number:

Phone & email:

Name and registration number of person(s) supervised:

Certificate of Compliance

Type of work:

Addition Alteration New work

The prescribed electrical work is:

Low risk General High-risk (Specify):

Means of compliance:

Part 1 of AS/NZS 3000 Part 2 of AS/NZS 3000

Additional Standards or electrical code of practice were required: No Yes (specify):

Date or range of dates that prescribed electrical work undertaken:

Contains fittings that are safe to connect to a power supply? Yes No

Specify type of supply system:

The installation has an earthing system that is correctly rated (where applicable) Yes No

Parts of the installation to which this certificate relates that are safe to connect to a power supply?

All Parts (specify)

The work relies on manufacturers instructions:

Yes No

If yes - identify the instruction manual including name, date and version. Also attach a copy of manufacturer's instructions to this certificate. (Or provide reference to readily accessible electronic format, eg Internet link.)

Identify: Manufacturer's instructions attached: VOLU Stok Little Brother LED street luminaires, 20/05/2019

Link:

The work has been done in accordance with a certified design: Yes No

If yes - identify the certified design including name, date and version. Also attach a copy of the certified design to this certificate. (Or provide reference to readily accessible electronic format, eg Internet link.)

Identify: Certified design attached: Roadway Lighting Plan drawing

Link:

The work relies on a Supplier Declaration of Conformity (SDoC): Yes No

If yes - identify the SDoC including name, date and version OR EESS registration. Also attach a copy of the SDoC to this certificate. (Or provide reference to readily accessible electronic format, eg Internet link.)

Identify: SDoC attached

Link:

The installation has been satisfactorily tested in accordance with the Electricity (Safety) Regulations 2010 No Yes

Description of Work:

Install New Street Column with LED Head
Install MEN Board, Main Earth and Earth Stake, Cad Welded Connection - Light Risk
Mains Cable, Mains Installation by others.
Livened by others.

Test Results (provide values)

Polarity (Independent earth):	
Insulation resistance:	200+ M Ohms
Earth Continuity:	0.1 Ohms
Bonding:	0.1 Ohms
Fault Loop impedance:	Ohms
Other (specify):	

By signing this document I certify that the completed prescribed electrical work to which this Certificate of Compliance applies has been done lawfully and safely, and the information in the certificate is correct.

Certifier's signature:

Date:

Electrical Safety Certificate

By signing this document I certify that the installation, or part of the installation, to which this Electrical Safety Certificate applies is connected to a power supply and is safe to use.

Certifier's name:

Registration/Practising licence number:

Certifier's signature:

Certificate Issue Date:

Connection Date:

CUSTOMER COPY - THIS IS AN IMPORTANT DOCUMENT AND SHOULD BE RETAINED FOR A MINIMUM OF 7 YEARS



ELECTRICAL CERTIFICATE OF COMPLIANCE & ELECTRICAL SAFETY CERTIFICATE

Reference/Certificate ID No.: NWELCOC 583 JS

This form is to be completed and signed by a registered electrical worker, or duly qualified person, in accordance with Part 1 of Part 2 of AS/NZS 3000 (New Zealand Electrical Code) in the specified electrical installation.

Location Details: Subdivision Area M Stage 9 to 15 Greenhill Park Hamilton # 7/3

Contact Details: (Name and address)

Name of Electrical worker: Yeti Martyn Registration/Practising licence number: E257490

Phone & email: (optional) (provide details)

Name and registration number of person(s) supervised:

Certificate of Compliance

Type of work: Addition Alteration New work
The prescribed electrical work is: Low Risk General High Risk (see 4.1)

Means of compliance: Part 1 of AS/NZS 3000 Part 2 of AS/NZS 3000

Additional Standards or electrical code of practice were required: No Yes (specify):

Date or range of dates that prescribed electrical work undertaken: 12/03/2021

Contains fittings that are safe to connect to a power supply? Yes No

Specify type of supply system: 240V Mains M/FH

The installation has an earthing system that is correctly rated (where applicable) Yes No

Parts of the installation to which this certificate relates that are safe to connect to a power supply? All Parts (specify):

The work relies on manufacturers instructions: Yes No

Specify (identify the installation and including name, date and version). Also attach a copy of manufacturer's instructions to this certificate. Do provide reference to readily accessible electronic format (if internet link).

Identify the relevant business (where relevant) (AS/NZS 3000:2018 Clause 3.1.10)

The work has been done in accordance with a certified design: Yes No

If yes - identify the certified design including name, date and version. Also attach a copy of the certified design to this certificate. Do provide reference to readily accessible electronic format (if internet link).

Identify the relevant business (where relevant) (AS/NZS 3000:2018 Clause 3.1.10)

The work relies on a Supplier Declaration of Conformity (SDoC): Yes No

If yes - identify a SDoC including name, date and version or CE/UKCA registration. Also attach a copy of the SDoC to this certificate. Do provide reference to readily accessible electronic format (if internet link).

Identify the relevant business (where relevant) (AS/NZS 3000:2018 Clause 3.1.10)

The installer has been satisfactorily tested in accordance with the Electricity (Safety) Regulations 2010 No Yes

Description of Work:	Test Results (provide values)	
	Value	Units
Install New Street Column with LED Head Install MEN Board, Main Earth and Earth Stake, Cad Welded Connection - Light Risk Mains Cable, Mains installation by others Livered by others.	Insulation resistance (minimum acceptable)	200M - 1M Ohms
	Earth Continuity	0 Ohms
	Bonding	0 Ohms
	Earth Loop Impedance (allow 200V)	Ohms

By signing this document I certify that the completed prescribed electrical work to which this Certificate of Compliance applies has been done lawfully and safely, and the information in the certificate is correct.

Certifier's signature: [Signature] Date: 09/03/2021

Electrical Safety Certificate

By signing this document I certify that the installation, or part of the installation, to which this Electrical Safety Certificate applies is connected to a power supply and is safe to use.

Certifier's name: _____ Registration/Practising licence number: _____

Certifier's signature: _____ Certificate Issue Date: _____ Connection Date: _____

PLEASE KEEP COPY - THIS IS AN IMPORTANT DOCUMENT AND SHOULD BE RETAINED FOR A MINIMUM OF 2 YEARS.

Form ELEC 1001 (01/2018) - Electrical Safety Certificate



ELECTRICAL CERTIFICATE OF COMPLIANCE & ELECTRICAL SAFETY CERTIFICATE

Registration/Certificate ID No

EWEL0001683-7

This certificate is an integral part of the prescribed electrical work to which it relates and is, in part, void if it is not used in full, under Part 2 of Part 2 of AS/NZS 3000 and subject to the conditions specified in the accompanying documents.

Location Details:

Subdivision Area M - Stage 8 to 15 Greenhill Park Hamilton # 120

Contact Details:
(Name & address)

Name of Electrical worker:

Yeti Martyn

Registration/Practising licence number:

E257490

Phone & email:

yetimartyn@shining.com

Name and registration number of person(s) supervised:

Certificate of Compliance

Type of work:

Addition

Alteration

New work

Is prescribed electrical work in:

Low risk

General

High Risk (see 1)

Means of compliance:

Part 1 of AS/NZS 3000

Part 2 of AS/NZS 3000

Additional standards or electrical code of practice were required:

No

Yes (specify)

Date or range of dates that prescribed electrical work undertaken:

Contains fittings that are safe to connect to a power supply?

Yes

No

Specify type of supply system: 200V Mains MEN

The installation has an earthing system that is correctly rated (where applicable)

Yes

No

Parts of the installation to which this certificate relates that are safe to connect to a power supply?

All

Parts (specify)

The work relies on manufacturers instructions:

Yes

No

If yes - identify the instructions (manufacturer name, date and version). Also attach a copy of manufacturer's instructions to this certificate.

(Or provide reference to readily accessible electronic format, eg internet link)

Identify manufacturer's name, date and version: None

The work has been done in accordance with a certified design:

Yes

No

If yes - identify the certified design (drawing name, date and version). Also attach a copy of the certification to this certificate.

(Or provide reference to readily accessible electronic format, eg internet link)

Identify manufacturer's name, date and version: None

The work relies on a Supplier Declaration of Conformity (SDoC):

Yes

No

If yes - identify the SDoC (relating name, date and version) of IESS signatory. Also attach a copy of the SDoC to this certificate.

(Or provide reference to readily accessible electronic format, eg internet link)

Identify signatory: None

The installation has been satisfactorily tested in accordance with the Electricity (Safety) Regulations 2010

No

Yes

Description of Work:

Install New Street Column with LED Head

Install MEN Board, Main Earth and Earth Stake, Cad Welded Connection - Light Risk

Mains Cable, Mains installation by others.

Livened by others.

Test Results (provide values)

Insulation resistance	200 M Ohms
Earth Continuity	0.1 Ohms
Resistance	0.1 Ohms
Fault loop impedance	Ohms
Other (specify)	

By signing this document I certify that the completed prescribed electrical work to which this Certificate of Compliance applies has been done lawfully and safely, and the information in the certificate is correct.

Certifier's signature:

Date: 10/03/2021

Electrical Safety Certificate

By signing this document I certify that the installation, or part of the installation, to which this Electrical Safety Certificate applies is connected to a power supply and is safe to use.

Certifier's name:

Registration/Practising licence number:

Certifier's signature:

Certificate Issue Date:

Connection Date:

Customer copy - THIS IS AN IMPORTANT DOCUMENT AND SHOULD BE RETAINED FOR A MINIMUM OF 7 YEARS



ELECTRICAL CERTIFICATE OF COMPLIANCE & ELECTRICAL SAFETY CERTIFICATE

Reference/Certificate ID No. NWEL00018870
This Certificate is valid up to the expiry date of the licence or until the holder is notified of a change in status. It is valid in accordance with Part 1 or Part 2 of AS/NZS 3000, unless it is specifically subject to the specified date and type of work.

Location Details: Subdivision Area M - Stage 9 to 15 Greenhill Park Hamilton #1DS

Contact Details:
(Name and address)

Name of Electrical worker: Yeti Martyn Registration/Practising licence number: E257490

Phone & email: 0274781818

Name and registration number of person(s) supervised:

Certificate of Compliance

Type of work: Addition Alteration New work
The prescribed electrical work is: Low risk General High risk category

Means of compliance: Part 1 of AS/NZS 3000 Part 2 of AS/NZS 3000

Additional Standards or electrical code of practice were required: No Yes (specify):

Date or range of dates that prescribed electrical work undertaken:

Contains fittings that are safe to connect to a power supply? Yes No

Specify type of supply system: 230V Mains MEN

The installation has an earthing system that is correctly rated (where applicable) Yes No

Parts of the installation to which this certificate relates that are safe to connect to a power supply?
 All Parts (specify):

The work relies on manufacturers instructions: Yes No

If yes - identify the instructions (including name, date and version) and attach a copy of manufacturer's instructions to this certificate.

If none refer to the readily accessible information (e.g. printed label).

Identify the document(s) used to inform the workers (see AS/NZS 3000 for more details):

The work has been done in accordance with a certified design: Yes No

If yes - identify the certified design (including name, date and version) and attach a copy of the certified design to this certificate.

(Or provide a link to a readily accessible electronic format, register link)

Identify the design (see AS/NZS 3000 for more details):

The work relies on a Supplier Declaration of Conformity (SDoC): Yes No

If yes - identify the SDoC (including name, date and version) if it is registration also attach a copy of the SDoC to this certificate.

(Or provide a link to a readily accessible electronic format, register link)

Identify the SDoC:

The installation has been satisfactorily tested in accordance with the Electricity (Safety) Regulations 2010 No Yes

Description of Work:

Install New Street Column with LED Head

Install MEN Board, Main Earth and Earth Stake, Gas Welded

Connection - Light Risk

Mains Cable, Mains Installation by others.

Livened by others

Test Results (provide values)

Insulation Resistance	200 M Ohms
Earth Continuity	0.1 Ohms
Resistance	0.1 Ohms
Earth Loop Impedance	Ohms
Continuity	

By signing this document I certify that the completed prescribed electrical work to which this Certificate of Compliance applies has been done lawfully and safely, and the information in the certificate is correct.

Certifier's signature: [Signature] Date: 03/03/2021

Electrical Safety Certificate

By signing this document I certify that the installation, or part of the installation, to which this Electrical Safety Certificate applies is connected to a power supply and is safe to use.

Certifier's name: _____ Registration/Practising licence number: _____

Certifier's signature: _____ Certificate Issue Date: _____ Connection Date: _____

Customer Copy - This is a non-polluting document and should be retained for a minimum of 7 years.

© 2019 Electrical Safety Council of New Zealand. All rights reserved. This document is the property of the Electrical Safety Council of New Zealand.



Electrical Workers Registration Board

www.electricalworkers.co.nz

Record of Inspection (ROI) of High-Risk Prescribed Electrical Work

(Pursuant to the Electricity (Safety) Regulations 2010)



Reference/Record Number:

Nat onwired greenhill

Issuer (Inspector) details:

Name of inspector: Gavin Bodey

Registration #: 1250728

Email Address: gavin@bodeyspark.co.nz

Telephone: 021 426 820

Location of Installation:

Location details: Greenhill park subdivision, Area M, Street light 133, stage 9-15

Location Type: Domestic Non-Domestic Accommodation Industrial Commercial
 Educational Healthcare Miscellaneous (other)

Certifying Electrical Work and Certificate of Compliance (CoC) details:

Name of Electrical worker(s): Yari Martyn

Registration #: L257490

FW121000

CoC details: Nationwired 15931

CoC(s) attached

Certifying Electrical Work and CoC details:

What was inspected:

New Installation. New Streetlight with M.E.N. board, New Main Neutral bar and circuit protection. New Main Earthing System. Bonding of Pole and cabinet door.

Specify the regulation(s) and companion standard(s), or identify the certified design, followed when carrying out the inspection:
AS/NZS3000 part 2

What are the results of the inspection:

Earthing and bonding visually ok,

so only

M.E.C. mp < 5 Ohm

M.E.N. int.,

HRPA #005830023M

High Risk Category:

- Not to AS/NZS 3000 Part 2 – 6A(2)(a)(i) Photovoltaic system – 6A(2)(a)(iv) Electrical medical area – 6A(2)(b)(i)
- High voltage installation – 6A(2)(a)(ii) Hazardous area – 6A(2)(a)(v) Mains work – 6A(2)(b)
- Mains parallel generation – 6A(2)(a)(iii) Animal stunning or heat conditioning – 6A(2)(c)
- Other – please describe: _____

Declaration

I hereby confirm that the work described above has been done in accordance with the regulations, and the ~~responsibility~~ ^{responsibility} on which the work has been done is, and will be ~~correct~~ ^{correct}, when delivered, electrically safe.

(Note: Strike out or delete the applicable words highlighted in red above.)

Signature: _____

Date: 10/03/21



Electrical Workers Registration Board

www.electricalworkers.co.nz

Record of Inspection (ROI) of High-Risk Prescribed Electrical Work

(Pursuant to the Electricity (Safety) Regulations 2010)



Reference/Record Number:

Nationwired greenh ll

Issuer (Inspector) details:

Name of Inspector: Gavin Bodey

Registration #: E250728

Email Address: gavin@bodeyspark.co.nz

Telephone: 021 428 820

Location of Installation:

Location details: Greenhill park subdivision, Area M, Streetlight 134 stage 3-15

Location Type: Domestic Non-Domestic Accommodation Industrial Commercial
 Educational Healthcare Miscellaneous (other)

Certifying Electrical Work and Certificate of Compliance (CoC) details:

Name of Electrical worker(s): Yeti Martyn

Registration #: E257400

EW# 21000

CoC details: Nationwired 15832

CoC(s) attached

Certifying Electrical Work and CoC details:

What was Inspected:

New installation, New Streetlight with M.E.N. board, New Main Neutral bar and circuit protection, New Main Earthing System, Bonding of Pole and cabinet door.

Specify the regulation(s) and comparison standard(s), or identify the certified design, followed when carrying out the inspection:
AS/NZS 3000 part 2

What are the results of the inspection

Earthing and bonding visual ok

polarity

M.E.C. imp < 5 Ohm

M.E.N. links: HIRPA #0058304115G

High Risk Category:

- Not to AS/NZS 3000 Part 2 - SA(2)(a)(i)
 High voltage installation - SA(2)(a)(ii)
 Main parallel generation - SA(2)(a)(iii)
 Other - please describe: _____
- Protection system - SA(2)(a)(iv)
 Hazardous area - SA(2)(a)(v)
 Aerial working or line conditioning - SA(2)(i)
- Electrical medical area - SA(2)(a)(vi)
 Main work - SA(2)(b)

Declaration

I hereby confirm that the work described above has been done in accordance with the regulations, and the installation part installation on which the work has been done is, and will be, when finished, electrically safe.

(Please strike out or delete the inapplicable categories highlighted in red above.)

Signature:

Date: 10/03/21



Electrical Workers Registration Board

100-100, Victoria Street, Auckland

Record of Inspection (ROI) of High-Risk Prescribed Electrical Work

(Pursuant to the Electricity (Safety) Regulations 2000)



Reference/Record Number:

Nationwired greenhill

Issuer (Inspector) details:

Name of Inspector: Gavin Boddy

Registration #: 1250728

Email Address: gavin@pococyspark.co.nz

Telephone: 021 428 820

Location of Installation:

Location details: Greenhill park subdivision, Area M, Streetlight 135, stage 9-15

Location Type: Domestic Non-Domestic Accommodation Industrial Commercial
 Educational Healthcare Miscellaneous (other)

Certifying Electrical Work and Certificate of Compliance (CoC) details:

Name of Electrical worker(s): Yeti Martyn

Registration #: E257490

EW171000

CoC details: Nationwired 15B33

CoC(s) attached

Certifying Electrical Work and CoC details:

What was inspected:

New Installation, New Streetlight with M.E.N. board, New Main Neutral bar and circuit protection, New Main Earthing System, Bonding of Pole and cabinet, door

Specify the regulation(s) and companion standard(s), or identify the certified design, followed when carrying out the inspection:
AS/NZS 3000 part 2

What are the results of the inspection:

Earthing and bonding visual ok,

polarity

M.E.C. imp < 5 Ohm

M.E.N. link

IRPA #00583062CV

High Risk Category:

- Not to AS/NZS 3000 Part 2 - 6A(2)(a)(i) Photovoltaic system - 6A(2)(a)(iv) Electrical remedial area - 6A(2)(a)(v)
- High voltage installation - 6A(2)(a)(ii) Hazardous area - 6A(2)(a)(vi) Main work - 6A(2)(b)
- Main parallel generation - 6A(2)(a)(iii) Animal stunning or meat conditioning - 6A(2)(c)
- Other - please describe

Declaration

I hereby confirm that the work described above has been done in compliance with the regulations; and the workmanship / part installation on which the work has been done is, and will be safe when re-energised, electrically safe

(Note: Strike out or delete the inappropriate work highlighted in red above.)

Signature

Date 10/03/21



Electrical Workers Registration Board

Electrical Workers Registration Board (EWRB)

Record of Inspection (ROI) of High-Risk Prescribed Electrical Work

(Pursuant to the Electricity (Safety) Regulations 2010)



Reference/Record Number:

Nationwired greenhll

Issuer (Inspector) details:

Name of Inspector: Gav'n Bodey

Registration #: I250728

Email Address: gavin@bodeyspark.co.nz

Telephone: 021 428 820

Location of Installation:

Location details: Greenhill park subdivision, Area M, Streetlight 130, stage 9-15

Location Type: Domestic Non-Domestic Accommodation Industrial Commercial
 Educational Healthcare Miscellaneous (other)

Certifying Electrical Work and Certificate of Compliance (CoC) details:

Name of Electrical worker(s): Yell Martyn

Registration #: E257490

CoC details: Nationwired 15834

EW121000

CoC(s) attached

Certifying Electrical Work and CoC details:

What was inspected:

New Installation. New Streetlight with M.E.N. board. New Main Neutral bar and circuit protection. New Main Earthing System Bonding of Pole and cabinet door.

Specify the regulation(s) and comparison standard(s), or identify the certified design, followed when carrying out the inspection.
AS/NZS 3000 part 2

What are the results of the inspection

Earthing and bonding visual ok

potenti

M.E.C. link < 5 Ohm

M.E.N. link..

HRPA #0358357K6D

High Risk Category:

- Not to AS/NZS 3000 Part 2 - 6A(2)(i) Photovoltaic system - 6A(2)(ii) Electrical medium area - 5A(2)(iv)
 High voltage installation - 6A(2)(iii) Hazardous area - 6A(2)(v) Mains work - 6A(2)(b)
 Mains parallel generation - 5A(2)(ii) Animal stunning or meat conditioning - 6A(2)(c)
 Other - please describe.

Declaration

I hereby confirm that the work described above, has been done in accordance with the regulations; and the installation/part installation on which the work has been done is, and will be, when enforced, electrically safe

(Note: Strike out or underline inappropriate words highlighted in red above)

Signature:

Date: 10/03/21



Electrical Workers Registration Board

100 Victoria Street, Auckland 1010

Record of Inspection (ROI) of High-Risk Prescribed Electrical Work

(Pursuant to the Electricity (Safety) Regulations 2002)



Reference/Record Number:

Nationwired greenhill II

Issuer (Inspector) details:

Name of Inspector: Gavin Boeey

Registration #: 1250/28

Email Address: gavin@boeeyspark.co.nz

Telephone: 021 426 620

Location of Installation:

Location details: Greenhill park subdivision, Area M, Streetlight 137, stage 9-15

Location Type: Domestic Non-Domestic Accommodation Industrial Commercial
 Educational Healthcare Miscellaneous (other)

Certifying Electrical Work and Certificate of Compliance (CoC) details:

Name of Electrical worker(s): Yes Martyn

Registration #: E26/490

EW121000

CoC details: Nationwired 15335

CoC(s) attached

Certifying Electrical Work and CoC details:

What was inspected:

New Installation, New Streetlight with M.E.N. board New Main Neutral bar and circuit protection, New Main Earthing System, Bonding of Pole and cabinet door

Specify the regulation(s) and companion standard(s), or identify the certified design, followed when carrying out the inspection:
AS/NZS 3000 part 2

What are the results of the inspection:

Earthing and bonding visual ok.

polarity

M.E.N. imp < 5 Ohm

M.E.N. link..

IRPA #0059311v28

High Risk Category:

- Not to AS/NZS 3000 Part 2 - 6A(7)(b)(i) Photovoltaic system - 6A(2)(a)(iv) Electrical medical area - 6A(2)(a)(vi)
 High voltage installation - 6A(2)(a)(ii) Hazardous area - 6A(2)(a)(v) Mains work - 6A(2)(b)
 Mains parallel generation - 6A(2)(a)(iii) Animal stunning or meat conditioning - 6A(2)(c)
 Other - please describe: _____

Declaration

I hereby confirm that the work described above has been done in accordance with the regulations and the ~~relevant~~ part installation on which the work has been done is, and will be ~~fit for use~~, when delivered, electrically safe.

(Note: Strike out or delete the inappropriate words highlighted in red above.)

Signature:

Date: 10/03/21



Electrical Workers Registration Board

Electrical Workers Registration Board
PO Box 100, Auckland, New Zealand

Record of Inspection (RO) of High-Risk Prescribed Electrical Work

(Pursuant to the Electricity (Safety) Regulations 2010)



Reference/Record Number:

Nationwired greenhill

Issuer (Inspector) details:

Name of Inspector: Gavin Bodey

Registration #: J250728

Email Address: gavin@bodeyspark.co.nz

Telephone: 021 423 870

Location of Installation:

Location details: Greenhill park subdivision, Area M, Streetlight 138, stage 9-16

Location Type: Domestic Non-Domestic/Accommodation Industrial Commercial
 Educational Healthcare Miscellaneous (Other)

Certifying Electrical Work and Certificate of Compliance (CoC) details:

Name of Electrical worker(s): Yeli Martyn

Registration #: E257490

EW: 21000

CoC details: Nationwired 15835

CoC(s) attached

Certifying Electrical Work and CoC details:

What was inspected:

New installation: New Streetlight with M.E.N. board, New Main Neutral bar and circuit protection, New Main Earthing System, Banding of Pole and cabinet door.

Specify the regulation(s) and companion standard(s), or identify the certified design, followed when carrying out the inspection AS/NZS 3000 part 2

What are the results of the inspection:

banding and bonding visual ok

polarity

M.E.C. imp < 5 Ohm

M.E.N. link

HRPA #0358393M20

High Risk Category:

- Not to AS/NZS 3000 Part 2 – 6A(2)(a)(i) Fluorinated system – 6A(2)(a)(iv) Electrical medical area – 6A(2)(a)(v)
- High voltage installation – 6A(2)(a)(ii) Hazardous area – 6A(2)(a)(vi) Marine work – 6A(2)(b)
- Mains parallel generation – 6A(2)(a)(iii) Animal stunning or meat conditioning – 6A(2)(c)
- Other – please describe:

Declaration

I hereby confirm that the work described above has been done in accordance with the regulations, and the installation/part installation on which the work has been done is, and will be, when delivered, electrically safe.

(Note: Strike out or delete the inappropriate words highlighted in red above.)

Signature

Date: 10/03/21



Electrical Workers Registration Board

Electrical Workers Registration Board
PO Box 100, Wellington, New Zealand

Record of Inspection (ROI) of High-Risk Prescribed Electrical Work

(Pursuant to the Electricity (Safety) Regulations 2010)



Reference/Record Number:

Nationwired greenhill

Issuer (Inspector) details

Name of Inspector: Gavin Bodoy

Registration #: 1250728

Email Address: gav'n@bodoyspark.co.nz

Telephone: 021 428 820

Location of Installation:

Location details: Greenhill park subdivision, Area M, Streetlight 139, stage 3-15

Location Type: Domestic Non-Domestic Accommodation Industrial Commercial
 Educational Healthcare Miscellaneous (other)

Certifying Electrical Work and Certificate of Compliance (CoC) details:

Name of Electrical worker(s): Yeti Martyn

Registration #: E257490

EW121000

CoC details: Nationwired # 5837

CoC(s) attached

Certifying Electrical Work and CoC details:

What was inspected:

New installation New Streetlight with M.E.N. board, New Main Neutral bar and circuit protection, New Main Earthing System Bonding of Poles and cabinet door

Specify the regulation(s) and comparison standard(s), or identify the certified design, followed when carrying out the inspection:
AS/NZS 3000 part 2

What are the results of the inspection:

Earthing and bonding visual ok,

polarity

M.E.C. imp < 5 Ohm

M.E.N. link: -RPA #0038315F7X

High Risk Category:

- Not to AS/NZS 3000 Part 7 - 6A(2)(a)(v)
 High voltage installation - 6A(2)(b)(ii)
 Mains parallel generation - 6A(2)(c)(ii)
 Other - please describe
- Photovoltaic system - 6A(2)(a)(v)
 Hazardous area - 6A(2)(b)(v)
 Animal stunning or meat conditioning - 6A(2)(c)
- Vertical medical area - 6A(2)(b)(vi)
 Mains work - 6A(2)(a)

Declaration

I hereby confirm that the work described above has been done in accordance with the regulations; and the installation/part installation to which the work has been done is, and will be, when delivered, electrically safe

(Note: Strike out or delete the inappropriate work highlighted in red above.)

Signature

Date: 10/03/21



ELECTRICAL CERTIFICATE OF COMPLIANCE & ELECTRICAL SAFETY CERTIFICATE

REFERENCE/CERTIFICATE ID No.:

NWELCOC1583

This form has been designed to be used by licensed electrical workers to certify that installations or Part installations under Part 1 or Part 2 of AS/NZS 3000 are safe to be connected to the specified system of electrical supply.

Location Details:

Subdivision Area M - Stage 9 to 15 Greenhill Park Hamilton # 133

Contact Details:
(Name and address)

Name of Electrical worker:

Yeti Martyn

Registration/Practising licence number:

E257490

Phone & email:

yetimartyn@hotmail.com

Name and registration number of person(s) supervised:

Certificate of Compliance

Type of work:

Addition Alteration New work

The prescribed electrical work is: Low risk General High-risk (Specify):

Means of compliance:

Part 1 of AS/NZS 3000 Part 2 of AS/NZS 3000

Additional Standards or electrical code of practice were required: No Yes (specify):

Date or range of dates that prescribed electrical work undertaken: 09/03/2021

Contains fittings that are safe to connect to a power supply? Yes No

Specify type of supply system: 230V Mains MEN

The installation has an earthing system that is correctly rated (where applicable) Yes No

Parts of the installation to which this certificate relates that are safe to connect to a power supply?

All Parts (specify)

The work relies on manufacturers instructions:

Yes No

If yes - identify the instruction manual including name, date and version. Also attach a copy of manufacturer's instructions to this certificate.

(Or provide reference to readily accessible electronic format, eg Internet link.)

Identify: Manufacturer's instructions attached. WOLU Stark Lela Brother LED street luminaires, 2005/2018

Link:

The work has been done in accordance with a certified design: Yes No

If yes - identify the certified design including name, date and version. Also attach a copy of the certified design to this certificate.

(Or provide reference to readily accessible electronic format, eg Internet link.)

Identify: Certified design attached. Roadway Lighting Plan drawing

Link:

The work relies on a Supplier Declaration of Conformity (SDoC): Yes No

If yes - identify the SDoC including name, date and version OR EESS registration. Also attach a copy of the SDoC to this certificate.

(Or provide reference to readily accessible electronic format, eg Internet link.)

Identify: SDoC attached

Link:

The installation has been satisfactorily tested in accordance with the Electricity (Safety) Regulations 2010 No Yes

Description of Work:

Install New Street Column with LED Head
Install MEN Board, Main Earth and Earth Stake, Cad Welded Connection - Light Risk
Mains Cable, Mains Installation by others.
Livened by others.

Test Results (provide values)

Polarity (independent earth):	
Insulation resistance:	200+ M Ohms
Earth Continuity:	0.1 Ohms
Bonding:	0.1 Ohms
Fault Loop Impedance:	Ohms
Other (specify):	

By signing this document I certify that the completed prescribed electrical work to which this Certificate of Compliance applies has been done lawfully and safely, and the information in the certificate is correct.

Certifier's signature:

Date: 09/03/2021

Electrical Safety Certificate

By signing this document I certify that the installation, or part of the installation, to which this Electrical Safety Certificate applies is connected to a power supply and is safe to use.

Certifier's name:

Registration/Practising licence number:

Certifier's signature:

Certificate Issue Date:

Connection Date:

CUSTOMER COPY - THIS IS AN IMPORTANT DOCUMENT AND SHOULD BE RETAINED FOR A MINIMUM OF 7 YEARS



ELECTRICAL CERTIFICATE OF COMPLIANCE & ELECTRICAL SAFETY CERTIFICATE

REFERENCE/CERTIFICATE ID No.:

NWELCOC1583 2

This form has been designed to be used by licensed electrical workers to certify that installations or Part installations under Part 1 or Part 2 of AS/NZS 3000 are safe to be connected to the specified system of electrical supply.

Location Details:

Subdivision Area M - Stage 9 to 15 Greenhill Park Hamilton # 134

Contact Details:
(Name and address)

Name of Electrical worker:

Yeti Martyn

Registration/Practising licence number:

E257490

Phone & email:

yetimartyn@hotmail.com

Name and registration number of person(s) supervised:

Certificate of Compliance

Type of work:

The prescribed electrical work is:

Addition

Alteration

New work

Low risk

General

High-risk (Specify):

Means of compliance:

Part 1 of AS/NZS 3000

Part 2 of AS/NZS 3000

Additional Standards or electrical code of practice were required:

No

Yes (specify):

Date or range of dates that prescribed electrical work undertaken: 09/03/2021

Contains fittings that are safe to connect to a power supply?

Yes

No

Specify type of supply system:

230V Mains MEN

The installation has an earthing system that is correctly rated (where applicable)

Yes

No

Parts of the installation to which this certificate relates that are safe to connect to a power supply?

All

Parts (specify)

The work relies on manufacturers instructions:

Yes

No

If yes - identify the instruction manual including name, date and version. Also attach a copy of manufacturer's instructions to this certificate.

(Or provide reference to readily accessible electronic format, eg Internet link.)

Identify: Manufacturer's instructions attached. VIDLU Stark Little Doctor LED street luminaire, 20/05/2019

Link:

The work has been done in accordance with a certified design:

Yes

No

If yes - identify the certified design including name, date and version. Also attach a copy of the certified design to this certificate.

(Or provide reference to readily accessible electronic format, eg Internet link.)

Identify: Certified design attached. Roadway Lighting Plan drawing

Link:

The work relies on a Supplier Declaration of Conformity (SDoC):

Yes

No

If yes - identify the SDoC including name, date and version OR EESS registration. Also attach a copy of the SDoC to this certificate.

(Or provide reference to readily accessible electronic format, eg Internet link.)

Identify: SDoC attached

Link:

The installation has been satisfactorily tested in accordance with the Electricity (Safety) Regulations 2010

No

Yes

Description of Work:

Install New Street Column with LED Head
Install MEN Board, Main Earth and Earth Stake, Cad Welded Connection - Light Risk
Mains Cable, Mains Installation by others.
Livened by others.

Test Results (provide values)

Polarity (independent earth):	
Insulation resistance:	200+ M Ohms
Earth Continuity:	0.1 Ohms
Bonding:	0.1 Ohms
Fault Loop Impedance:	Ohms
Other (specify):	

By signing this document I certify that the completed prescribed electrical work to which this Certificate of Compliance applies has been done lawfully and safely, and the information in the certificate is correct.

Certifier's signature:

Date:

09/03/2021

Electrical Safety Certificate

By signing this document I certify that the installation, or part of the installation, to which this Electrical Safety Certificate applies is connected to a power supply and is safe to use.

Certifier's name:

Registration/Practising licence number:

Certifier's signature:

Certificate Issue Date:

Connection Date:

CUSTOMER COPY - THIS IS AN IMPORTANT DOCUMENT AND SHOULD BE RETAINED FOR A MINIMUM OF 7 YEARS

This Electrical Safety Certificate also confirms that the electrical work complies with the building code for the purposes of Section 19(1)(e) of the Building Act 2004.



ELECTRICAL CERTIFICATE OF COMPLIANCE & ELECTRICAL SAFETY CERTIFICATE

REFERENCE/CERTIFICATE ID No.:

NWELCOC15833

This form has been designed to be used by licensed electrical workers to certify that installations or Part installations under Part 1 or Part 2 of AS/NZS 3000 are safe to be connected to the specified system of electrical supply.

Location Details:

Subdivision Area M - Stage 9 to 15 Greenhill Park Hamilton #135

Contact Details:
(Name and address)

Name of Electrical worker:

Yeti Martyn

Registration/Practising licence number:

E257490

Phone & email:

yeti.martyn@hotmail.com

Name and registration number of person(s) supervised:

Certificate of Compliance

Type of work:

 Addition Alteration New work

The prescribed electrical work is:

 Low risk General High-risk (Specify):

Means of compliance:

 Part 1 of AS/NZS 3000 Part 2 of AS/NZS 3000

Additional Standards or electrical code of practice were required:

 No Yes (specify):

Date or range of dates that prescribed electrical work undertaken:

09/03/2021

Contains fittings that are safe to connect to a power supply?

 Yes No

Specify type of supply system:

230V Mains MEN

The installation has an earthing system that is correctly rated (where applicable)

 Yes No

Parts of the installation to which this certificate relates that are safe to connect to a power supply?

 All Parts (specify)

The work relies on manufacturers instructions:

 Yes No

If yes - identify the instruction manual including name, date and version. Also attach a copy of manufacturer's instructions to this certificate.

(Or provide reference to readily accessible electronic format, eg Internet link.)

Identify: Manufacturer's instructions attached. WOLU Stark Lila Brother LED street luminaires, 20052018

Link:

The work has been done in accordance with a certified design:

 Yes No

If yes - identify the certified design including name, date and version. Also attach a copy of the certified design to this certificate.

(Or provide reference to readily accessible electronic format, eg Internet link.)

Identify: Certified design attached. Roadway Lighting Plan drawing

Link:

The work relies on a Supplier Declaration of Conformity (SDoC):

 Yes No

If yes - identify the SDoC including name, date and version OR EESS registration. Also attach a copy of the SDoC to this certificate.

(Or provide reference to readily accessible electronic format, eg Internet link.)

Identify: SDoC attached

Link:

The installation has been satisfactorily tested in accordance with the Electricity (Safety) Regulations 2010

 No Yes

Description of Work:

Install New Street Column with LED Head
 Install MEN Board, Main Earth and Earth Stake, Cad Welded Connection - Light Risk
 Mains Cable, Mains Installation by others.
 Lived in by others.

Test Results (provide values)

Polarity (independent earth):	
Insulation resistance:	200+ M Ohms
Earth Continuity:	0.1 Ohms
Bonding:	0.1 Ohms
Fault Loop Impedance:	Ohms
Other (specify):	

By signing this document I certify that the completed prescribed electrical work to which this Certificate of Compliance applies has been done lawfully and safely, and the information in the certificate is correct.

Certifier's signature:

Date: 09/03/2021

Electrical Safety Certificate

By signing this document I certify that the installation, or part of the installation, to which this Electrical Safety Certificate applies is connected to a power supply and is safe to use.

Certifier's name:

Registration/Practising licence number:

Certifier's signature:

Certificate Issue Date:

Connection Date:

CUSTOMER COPY - THIS IS AN IMPORTANT DOCUMENT AND SHOULD BE RETAINED FOR A MINIMUM OF 7 YEARS

This Electrical Safety Certificate also confirms that the electrical work complies with the building code for the purposes of Section 13(1)(a) of the Building Act 2004.



ELECTRICAL CERTIFICATE OF COMPLIANCE & ELECTRICAL SAFETY CERTIFICATE

REFERENCE/CERTIFICATE ID No.:

NWELCOC15834

This form has been designed to be used by licensed electrical workers to certify that installations or Part installations under Part 2 or Part 2 of AS/NZS 3000 are safe to be connected to the specified system of electrical supply.

Location Details:

Subdivision Area M - Stage 9 to 15 Greenhill Park Hamilton #136

Contact Details:
(Name and address)

Name of Electrical worker:

Yeti Martyn

Registration/Practising licence number:

E257490

Phone & email:

yetimartyn@hotmail.com

Name and registration number of person(s) supervised:

Certificate of Compliance

Type of work:

- Addition Alteration New work
 Low risk General High-risk (Specify):

Means of compliance:

- Part 1 of AS/NZS 3000 Part 2 of AS/NZS 3000

Additional Standards or electrical code of practice were required: No Yes (specify):

Date or range of dates that prescribed electrical work undertaken: 09/03/2021

Contains fittings that are safe to connect to a power supply? Yes No

Specify type of supply system: 230V Mains MEN

The installation has an earthing system that is correctly rated (where applicable) Yes No

Parts of the installation to which this certificate relates that are safe to connect to a power supply?
 All Parts (specify):

The work relies on manufacturers instructions: Yes No

If yes - identify the instruction manual including name, date and version. Also attach a copy of manufacturer's instructions to this certificate. (Or provide reference to readily accessible electronic format, eg Internet link.)

Identify: Manufacturer's instructions attached: VIGLIU Stock Little Brother LED street luminaires, 26/05/2019
Link:

The work has been done in accordance with a certified design: Yes No

If yes - identify the certified design including name, date and version. Also attach a copy of the certified design to this certificate. (Or provide reference to readily accessible electronic format, eg Internet link.)

Identify: Certified design attached: Fixing Lighting Plan drawing
Link:

The work relies on a Supplier Declaration of Conformity (SDoC): Yes No

If yes - identify the SDoC including name, date and version OR EESS registration. Also attach a copy of the SDoC to this certificate. (Or provide reference to readily accessible electronic format, eg Internet link.)

Identify: SDoC attached
Link:

The installation has been satisfactorily tested in accordance with the Electricity (Safety) Regulations 2010 No Yes

Description of Work:

Install New Street Column with LED Head
Install MEN Board, Main Earth and Earth Stake, Cad Welded Connection - Light Risk
Mains Cable, Mains Installation by others.
Lived in by others.

Test Results (provide values)

Polarity (independent earth):	
Insulation resistance:	200+ M Ohms
Earth Continuity:	0.1 Ohms
Bonding:	0.1 Ohms
Fault Loop Impedance:	Ohms
Other (specify):	

By signing this document I certify that the completed prescribed electrical work to which this Certificate of Compliance applies has been done lawfully and safely, and the information in the certificate is correct.

Certifier's signature:

Date: 09/03/2021

Electrical Safety Certificate

By signing this document I certify that the installation, or part of the installation, to which this Electrical Safety Certificate applies is connected to a power supply and is safe to use.

Certifier's name:

Registration/Practising licence number:

Certifier's signature:

Certificate Issue Date:

Connection Date:

CUSTOMER COPY - THIS IS AN IMPORTANT DOCUMENT AND SHOULD BE RETAINED FOR A MINIMUM OF 7 YEARS



ELECTRICAL CERTIFICATE OF COMPLIANCE & ELECTRICAL SAFETY CERTIFICATE

REFERENCE/CERTIFICATE ID No.:

NWELCOC1583 5

This form has been designed to be used by licensed electrical workers to certify that installations or Part installations under Part 1 or Part 2 of AS/NZS 3000 are safe to be connected to the specified system of electrical supply.

Location Details:

Subdivision Area M - Stage 9 to 15 Greenhill Park Hamilton #137

Contact Details:
(Name and address)

Name of Electrical worker:

Yeti Martyn

Registration/Practising licence number:

E257490

Phone & email:

yelmartyn@hotmail.com

Name and registration number of person(s) supervised:

Certificate of Compliance

Type of work:

The prescribed electrical work is:

 Addition Alteration New work Low risk General High-risk (Specify):

Means of compliance:

 Part 1 of AS/NZS 3000 Part 2 of AS/NZS 3000

Additional Standards or electrical code of practice were required:

 No Yes (specify):

Date or range of dates that prescribed electrical work undertaken:

09/03/2021

Contains fittings that are safe to connect to a power supply?

 Yes No

Specify type of supply system:

230V Mains MEN

The installation has an earthing system that is correctly rated (where applicable)

 Yes No

Parts of the installation to which this certificate relates that are safe to connect to a power supply?

 All Parts (specify)

The work relies on manufacturers instructions:

 Yes No

If yes - identify the instruction manual including name, date and version. Also attach a copy of manufacturer's instructions to this certificate.

(Or provide reference to readily accessible electronic format, eg Internet link.)

Identify: Manufacturer's instructions attached. VOLU Stark Like Brother LED street luminaires, 20052018

Link:

The work has been done in accordance with a certified design:

 Yes No

If yes - identify the certified design including name, date and version. Also attach a copy of the certified design to this certificate.

(Or provide reference to readily accessible electronic format, eg Internet link.)

Identify: Certified design attached. Roadway Lighting Plan drawing

Link:

The work relies on a Supplier Declaration of Conformity (SDoC):

 Yes No

If yes - identify the SDoC including name, date and version OR EESS registration. Also attach a copy of the SDoC to this certificate.

(Or provide reference to readily accessible electronic format, eg Internet link.)

Identify: SDoC attached

Link:

The installation has been satisfactorily tested in accordance with the Electricity (Safety) Regulations 2010

 No Yes

Description of Work:

Install New Street Column with LED Head
 Install MEN Board, Main Earth and Earth Stake, Cad Welded Connection - Light Risk
 Mains Cable, Mains Installation by others.
 Livened by others.

Test Results (provide values)

Polarity (independent earth):	
Insulation resistance:	200+ M Ohms
Earth Continuity:	0.1 Ohms
Bonding:	0.1 Ohms
Fault Loop Impedance:	Ohms
Other (specify):	

By signing this document I certify that the completed prescribed electrical work to which this Certificate of Compliance applies has been done lawfully and safely, and the information in the certificate is correct.

Certifier's signature:

Date: 09/03/2021

Electrical Safety Certificate

By signing this document I certify that the installation, or part of the installation, to which this Electrical Safety Certificate applies is connected to a power supply and is safe to use.

Certifier's name:

Registration/Practising licence number:

Certifier's signature:

Certificate Issue Date:

Connection Date:

CUSTOMER COPY - THIS IS AN IMPORTANT DOCUMENT AND SHOULD BE RETAINED FOR A MINIMUM OF 7 YEARS

This Electrical Safety Certificate also confirms that the electrical work complies with the building code for the purposes of Section 19(1)(a) of the Building Act 2004.



ELECTRICAL CERTIFICATE OF COMPLIANCE & ELECTRICAL SAFETY CERTIFICATE

REFERENCE/CERTIFICATE ID No.:

NWELCOC15836

This form has been designed to be used by licensed electrical workers to certify that installations or Part installations under Part 1 or Part 2 of AS/NZS 3000 are safe to be connected to the specified system of electrical supply.

Location Details:

Subdivision Area M - Stage 9 to 15 Greenhill Park Hamilton # 138

Contact Details:
(Name and address)

Name of Electrical worker:

Yeti Martyn

Registration/Practising licence number:

E257490

Phone & email:

yetimartyn@hotmail.com

Name and registration number of person(s) supervised:

Certificate of Compliance

Type of work:

- Addition Alteration New work
 Low risk General High-risk (Specify):

Means of compliance:

- Part 1 of AS/NZS 3000 Part 2 of AS/NZS 3000

Additional Standards or electrical code of practice were required: No Yes (specify):

Date or range of dates that prescribed electrical work undertaken: 09/03/2021

Contains fittings that are safe to connect to a power supply? Yes No

Specify type of supply system: 230V Mains MEN

The installation has an earthing system that is correctly rated (where applicable) Yes No

Parts of the installation to which this certificate relates that are safe to connect to a power supply?

All Parts (specify)

The work relies on manufacturers instructions: Yes No

If yes - identify the instruction manual including name, date and version. Also attach a copy of manufacturer's instructions to this certificate. (Or provide reference to readily accessible electronic format, eg Internet link.)

Identify: Manufacturer's instructions attached: VIGLI (Stark) LED Bulb Holder LED about Luminaire, 20/05/2019

Link:

The work has been done in accordance with a certified design: Yes No

If yes - identify the certified design including name, date and version. Also attach a copy of the certified design to this certificate. (Or provide reference to readily accessible electronic format, eg Internet link.)

Identify: Certified design attached: Powerway Lighting Plan drawing

Link:

The work relies on a Supplier Declaration of Conformity (SDoC): Yes No

If yes - identify the SDoC including name, date and version OR EESS registration. Also attach a copy of the SDoC to this certificate. (Or provide reference to readily accessible electronic format, eg Internet link.)

Identify: SDoC attached

Link:

The installation has been satisfactorily tested in accordance with the Electricity (Safety) Regulations 2010 No Yes

Description of Work:
 Install New Street Column with LED Head
 Install MEN Board, Main Earth and Earth Stake, Cad Welded Connection - Light Risk
 Mains Cable, Mains Installation by others.
 Lived in by others.

Test Results (provide values)	
Polarity (independent earth):	
Insulation resistance:	200+ M Ohms
Earth Continuity:	0.1 Ohms
Bonding:	0.1 Ohms
Fault Loop Impedance:	Ohms
Other (specify):	

By signing this document I certify that the completed prescribed electrical work to which this Certificate of Compliance applies has been done lawfully and safely, and the information in the certificate is correct.

Certifier's signature:

Date: 09/03/2021

Electrical Safety Certificate

By signing this document I certify that the installation, or part of the installation, to which this Electrical Safety Certificate applies is connected to a power supply and is safe to use.

Certifier's name:

Registration/Practising licence number:

Certifier's signature:

Certificate Issue Date:

Connection Date:

CUSTOMER COPY - THIS IS AN IMPORTANT DOCUMENT AND SHOULD BE RETAINED FOR A MINIMUM OF 7 YEARS

This Electrical Safety Certificate also confirms that the electrical work complies with the building code for the purposes of Section 13(1)(a) of the Building Act 2004.



ELECTRICAL CERTIFICATE OF COMPLIANCE & ELECTRICAL SAFETY CERTIFICATE

REFERENCE/CERTIFICATE ID No.:

NWELCOC-1583 7

This form has been designed to be used by licensed electrical workers to certify that installations or Part installations under Part 1 or Part 2 of AS/NZS 3000 are safe to be connected to the specified system of electrical supply.

Location Details:

Subdivision Area M - Stage 9 to 15 Greenhill Park Hamilton # 139Contact Details:
(Name and address)

Name of Electrical worker:

Yeti Martyn

Registration/Practising licence number:

E257490

Phone & email:

yeti.martyn@hotmail.com

Name and registration number of person(s) supervised:

Certificate of Compliance

Type of work:

The prescribed electrical work is:

 Addition Alteration New work Low risk General High-risk (Specify):

Means of compliance:

 Part 1 of AS/NZS 3000 Part 2 of AS/NZS 3000

Additional Standards or electrical code of practice were required:

 No Yes (specify):

Date or range of dates that prescribed electrical work undertaken:

09/03/2021

Contains fittings that are safe to connect to a power supply?

 Yes No

Specify type of supply system:

230V Mains MEN

The installation has an earthing system that is correctly rated (where applicable)

 Yes No

Parts of the installation to which this certificate relates that are safe to connect to a power supply?

 All Parts (specify)

The work relies on manufacturers instructions:

 Yes No

If yes - identify the instruction manual including name, date and version. Also attach a copy of manufacturer's instructions to this certificate. (Or provide reference to readily accessible electronic format, eg Internet link.)

Identify: Manufacturer's instructions attached. VIGLU Stark Little Brother LED street luminaire, 20/05/2019

Link:

The work has been done in accordance with a certified design:

 Yes No

If yes - identify the certified design including name, date and version. Also attach a copy of the certified design to this certificate. (Or provide reference to readily accessible electronic format, eg internet link.)

Identify: Certified design attached. Roadway Lighting Plan drawing

Link:

The work relies on a Supplier Declaration of Conformity (SDoC):

 Yes No

If yes - identify the SDoC including name, date and version OR EESS registration. Also attach a copy of the SDoC to this certificate. (Or provide reference to readily accessible electronic format, eg Internet link.)

Identify: SDoC attached

Link:

The installation has been satisfactorily tested in accordance with the Electricity (Safety) Regulations 2010

 No Yes

Description of Work:

Install New Street Column with LED Head
 Install MEN Board, Main Earth and Earth Stake, Cad Welded Connection - Light Risk
 Mains Cable, Mains Installation by others.
 Livened by others.

Test Results (provide values)

Polarity (independent earth):	
Insulation resistance:	200+ M Ohms
Earth Continuity:	0.1 Ohms
Bonding:	0.1 Ohms
Fault Loop Impedance:	Ohms
Other (specify):	

By signing this document I certify that the completed prescribed electrical work to which this Certificate of Compliance applies has been done lawfully and safely, and the information in the certificate is correct.

Certifier's signature:

Date: 09/03/2021

Electrical Safety Certificate

By signing this document I certify that the installation, or part of the installation, to which this Electrical Safety Certificate applies is connected to a power supply and is safe to use.

Certifier's name:

Registration/Practising licence number:

Certifier's signature:

Certificate Issue Date:

Connection Date:

CUSTOMER COPY - THIS IS AN IMPORTANT DOCUMENT AND SHOULD BE RETAINED FOR A MINIMUM OF 7 YEARS

This Electrical Safety Certificate also confirms that the electrical work complies with the building code for the purposes of Section 18(1)(c) of the Building Act 2004.



Electrical Workers Registration Board

100 Victoria Park Road, Auckland

Record of Inspection (ROI) of High-Risk Prescribed Electrical Work

(Pursuant to the Electricity (Safety) Regulations 2010)



Reference/Record Number:

Nationwired greenhill

Issuer (Inspector) details:

Name of Inspector: Gavin Bodey

Registration #: I250728

Email Address: gavin@bodeyspark.co.nz

Telephone: 021 428 820

Location of Installation:

Location details: Greenhill park subdivision, Area M, Streetlight 109 stage 9-10

Location Type: Domestic Non-Domestic Accommodation Industrial Commercial
 Educational Healthcare Miscellaneous (other)

Certifying Electrical Work and Certificate of Compliance (CoC) details:

Name of Electrical worker(s): Yeti Marilyn

Registration #: E257490

EW121000

CoC details: Nationwired 15792 Streetlight: 109

CoC(s) attached

Certifying Electrical Work and CoC details:

What was inspected:

New Installation, New Streetlight with M.E.N. board, New Main Neutral bar and circuit protection, New Main Earthing System, Bonding of Pole and cabinet door.

Specify the regulation(s) and comparison standard(s), or identify the certified design, followed when carrying out the inspection AS/NZS3000 part 2

What are the results of the inspection:

Earthing and bonding system ok.

only

M.E.C. Imp < 5 Ohm

M.E.N. Imp. -RPA #005836744L

High Risk Category:

- Not to AS/NZS 3000 Part 2 - 6A(2)(a)(i) Photovoltaic system - 6A(2)(b)(iv) Electrical medical area - 6A(2)(a)(ii)
- High voltage installation - 6A(2)(b)(i) Hazardous area - 6A(2)(a)(iv) Mains work - 6A(2)(b)
- Mains parallel generator - 6A(2)(b)(iii) Animal stunning or meat conditioning - 6A(2)(c)
- Other - please describe:

Declaration

I hereby confirm that the work described above has been done in full accordance with the regulations, and the installation/part installation on which the work has been done is, and will be, safe, when put into, or electrically safe.

(Note: Strike out or delete the inapplicable words highlighted in red above.)

Signature:

Date: 10/03/21



Electrical Workers Registration Board

100 Waterloo Street, Auckland, New Zealand

Record of Inspection (ROI) of High-Risk Prescribed Electrical Work

(Pursuant to the Electricity (Safety) Regulations 2010)



Reference/Record Number:

Nationwired greenhill

Issuer (Inspector) details

Name of Inspector: Gavin Rooy

Registration #: 1250728

Email Address: gavin@todayspark.co.nz

Telephone: 021 428 820

Location of Installation:

Location details: Greenhill park subdivision, Area M, Streetlight 110slage 9-15

Location Type: Domestic Non-Domestic Accommodation Industrial Commercial
 Educational Healthcare Miscellaneous (other)

Certifying Electrical Work and Certificate of Compliance (CoC) details:

Name of Electrical worker(s): Yeri Martyn

Registration #: E257480

EW121000

CoC details: Nationwired 157923 Streetlight 110

CoC(s) attached

Certifying Electrical Work and CoC details:

What was inspected:

New installation, New Streetlight with M.E.N board, New Main Neutral bar and circuit protection, New Main Earthing System Bonding of Pole and cabinet door

Specify the regulation(s) and companion standard(s), or identify the certified design, followed when carrying out the inspection:
AS/NZS 3000 part 2

What are the results of the inspection:

Earthing and bonding visual ok,

isolate

M.E.C. imp < 5 Ohm

M.E.N. link

HRPA 00058367K4L

High Risk Category:

- Not to AS/NZS 3000 Part 2 - 6A(2)(a)(i) Photovoltaic system - 6A(2)(a)(iv) Electrical medical area - 6A(2)(a)(ii)
 High voltage installation - 6A(2)(a)(v) Hazardous area - 6A(2)(a)(vi) Mains work - 6A(2)(b)
 Mains parallel generation - 6A(2)(a)(ii) Artificial stunning or meat conditioning - 6A(2)(c)
 Other - please describe:

Declaration

I hereby confirm that the work described above has been done in / ~~is~~ accordance with the regulations; and the ~~installation / part~~ installation on which the work has been done is, and will be / ~~not be~~, when delivered, electrically safe.

(Note: Strike out or delete the italicized words highlighted in red above.)

Signature

Date: 10/03/21



Electrical Workers Registration Board

100 Eymore Street, Northcote, VIC 3070

Record of Inspection (ROI) of High-Risk Prescribed Electrical Work

(Pursuant to the Electricity (Safety) Regulations 2010)



Reference/Record Number:

Nationwired greenhill

Issuer (Inspector) details:

Name of Inspector: Gavin Bockey

Registration #: I250728

Email Address: gavin@pooeyspark.com.au

Telephone: 021 428 820

Location of Installation:

Location details: Greenhill park subdivision, Area M, Streetlight 112 stage 9-15

Location type: Domestic Non-Domestic Accommodation Industrial Commercial
 Educational Healthcare Miscellaneous (other)

Certifying Electrical Work and Certificate of Compliance (CoC) details:

Name of Electrical worker(s): Yeti Martyn

Registration #: L25749C

FW121000

CoC details: Nationwired, 15796 Streetlight 112

CoC(s) attached

Certifying Electrical Work and CoC details:

What was inspected:

New Installation, New Streetlight with M.F.N. board, New Main Neutral bar and circuit protection, New Main Earthing System Bonding of Pole and cabinet door.

Specify the regulation(s) and companion standard(s), or identify the certified design, followed when carrying out the inspection:
AS/NZS 3000 part 2

What are the results of the inspection

Earthing and bonding visually OK,

continuity

M.F.C. imp < 5 Ohm

M.E.N. link.

FRPA #00583/3010

High Risk Category:

- Not to AS/NZS 3000 Part 2 - 6A(2)(a)(i) Protonotic system - 6A(2)(a)(iv) Electrical medical area - 6A(2)(a)(vi)
 High voltage installation - 6A(2)(a)(v) Hazardous area - 6A(2)(a)(vii) Mains work - 6A(2)(a)(viii)
 Mains parallel generation - 6A(2)(a)(iii) Animal stockling or meat conditioning - 6A(2)(a)(ix)
 Other (please describe)

Declaration

I hereby confirm that the work described above has been done in accordance with the regulations, and the installation/part installation on which the work has been done is, and will be, when energised, electrically safe.

(Note: Strike out or delete for inapplicable words highlighted in red above.)

Signature:

Date: 10/03/21



Electrical Workers Registration Board

1211 L St, Christchurch, New Zealand

Record of Inspection (ROI) of High-Risk Prescribed Electrical Work

(Extract to the Electricity (Safety) Regulations 2010)



Reference/Record Number:

Nationwired greenhill

Issuer (Inspector) details:

Name of Inspector: Gavin Boday

Registration #: 1250728

Email Address: gavin@bodayspark.co.nz

Telephone: 021 428 820

Location of Installation:

Location details: Greenhill park subdivision, Area M, Streetlight 13 stage 9-15

Location type: Domestic Non Domestic Accommodation Industrial Commercial
 Educational Healthcare Miscellaneous (other)

Certifying Electrical Work and Certificate of Compliance (CoC) details:

Name of Electrical worker(s): Yell Marilyn

Registration #: E257490

EW121000

CoC details: Nationwired 15795 Streetlight 13

CoC (s) attached

Certifying Electrical Work and CoC details:

What was inspected?

New installation, New Streetlight with M.E.N. board, New Main Neutral bar and circuit protection, New Main Earthing System Bonding of Pole and cabinet door

Specify the regulation(s) and comparison standard(s), or identify the certified design, followed when carrying out the inspection AS/NZS 3000 part 2

What are the results of the inspection

Earthing and bonding visual ok

polarity

M.F.C. imp = 5 Ohm

M.E.N. link: HIRPA #10683774V6S

High Risk Category:

- Not to AS/NZS 3000 Part 2 - GA(2)(a)(i) Photovoltaic system - EA(2)(a)(iv) Electrical medical area - GA(2)(a)(vi)
- High voltage installation - GA(2)(b)(ii) Hazardous area - GA(2)(b)(v) Mains work - GA(2)(c)
- Motor parallel generation - GA(2)(c)(ii) Animal stunning or meat conditioning - GA(2)(c)
- Other - please describe:

Declaration

I hereby confirm that the work described above has been done in accordance with the regulations and the installation on which the work has been done is, and will be, when completed, electrically safe.

(Note: Strike out or delete the words in bold which are highlighted in red above.)

Signature:

Date: 10/03/21



Electrical Workers Registration Board

100 Victoria Park, Auckland

Record of Inspection (ROI) of High-Risk Prescribed Electrical Work

(Pursuant to the Electricity (Safety) Regulations 2000)



Reference/Record Number:

Nat onwired greenhill

Issuer (Inspector) details:

Name of Inspector: Gavin Bodey

Registration #: 250720

Email Address: gavin@bodeyspark.co.nz

Telephone: 021 426 820

Location of Installation:

Location details: Greenhill park subdivision, Area M, Streetlight 114 stage 9-15

Location type: Domestic Non-Domestic Accommodation Industrial Commercial
 Educational Healthcare Miscellaneous (Other)

Certifying Electrical Work and Certificate of Compliance (CoC) details:

Name of Electrical worker(s): Yeli Marilyn

Registration #: E25/490

EW121000

CoC details: Nat onwired 16797 Streetlight 114

CoC(s) attached

Certifying Electrical Work and CoC details:

What was inspected:

New Installation, New Street light with M.E.N. tower, New Main Neutral bar and circuit protection, New Main Earthing System, Bonding of Pole and cabinet door.

Specify the regulation(s) and companion standard(s), or identify the certified design, followed when carrying out the inspection AS/NZS3000 part 2

What are the results of the inspection:

Earthing and bonding visual ok,

polarity

M.F.C. Imp < .5 Ohm

M.E.N. ok.

HRPA #0059375845

High Risk Category:

- Not to AS/NZS 3000 Part 2 - 6A(2)(a)(i) Photovoltaic system - 6A(2)(a)(v) Electrical medical area - 6A(2)(a)(vi)
 High voltage installation - 6A(2)(a)(ii) Hazardous area - 6A(2)(a)(vii) Mains work - 6A(2)(b)
 Mains parallel generation - 6A(2)(a)(iii) Artificial stunning or meat tenderizing - 6A(2)(c)
 Other - please describe:

Declaration

I hereby confirm that the work described above has been done in accordance with the regulations, and the installation/part installation or which the work has been done is, and will be found to be when performed, electrically safe.

(Note: Strike out or delete the inapplicable items highlighted in red above.)

Signature:

Date: 10/03/21



Electrical Workers Registration Board

Electricity (Safety) Regulations 2010

Record of Inspection (ROI) of High-Risk Prescribed Electrical Work

(Pursuant to the Electricity (Safety) Regulations 2010)



Reference/Record Number:

Nationwired greenhill II

Issuer (Inspector) details

Name of Inspector: Gavin Hecoy

Registration #: 1250728

Email Address: gavin@bodeyspark.co.nz

Telephone: 021 428 820

Location of Installation:

Location details: Greenhill park subdivision, Area M, Streetlight 107stage 9-15

Location Type: Domestic Non-Domestic Accommodation Industrial Commercial
 Situational Healthcare Miscellaneous (other)

Certifying Electrical Work and Certificate of Compliance (CoC) details:

Name of Electrical worker(s): Yen Martyn

Registration #: E257490

EW121000

CoC details: Nationwired 15791 Streetlight 107

CoC(s) attached

Certifying Electrical Work and CoC details:

What was inspected:

New installation, New Streetlight with M.E.N. board. New Main Neutral bar and ground protection. New Main Earthing System. Banding of Pole and cabinet door

Specify the regulation(s) and comparison standard(s), or identify the certified design, followed when carrying out the inspection:
AS/NZS 3000 part 2

What are the results of the inspection:

Earthing and bonding visual ok.

polarity

M.E.C. imp < 5 Ohm

M.E.N. link IIRPA #0056853B7H

High Risk Category:

- Not to AS/NZS 3000 Part 2 - 6A(2)(a)(i) Photovoltaic system - 6A(2)(a)(iv) Hermetic electrical amp - 6A(2)(a)(v)
 High voltage installation - 6A(2)(a)(ii) Hazardous area - 6A(2)(a)(v) Maintenance work - 6A(2)(b)
 Mains parallel generation - 6A(2)(a)(iii) Animal stunning or meat conditioning - 6A(2)(c)
 Other - please describe

Declaration

I hereby confirm that the work described above has been done in / ~~will be~~ accordance with the regulations; and the ~~installation~~ / part installation on which the work has been done is and will be / ~~not be~~, when activated, electrically safe

(Note: Strike out or delete the inappropriate words highlighted in red above.)

Signature:

Date: 10/03/21



Electrical Workers Registration Board

10000-10000-10000-10000

Record of Inspection (ROI) of High-Risk Prescribed Electrical Work

(Pursuant to the Electricity (Safety) Regulations 2010)



Reference/Record Number:

Nationwired greenhill

Issuer (Inspector) details:

Name of Inspector: Gavin Bodey

Registration #: 1250728

Email Address: gavin@bodeyspark.co.nz

Telephone: 021 428 820

Location of Installation:

Location data is: Greenhill park subdivision, Area M, Streetlight 43 stage 2-15

Location type: Domestic Non-Domestic Accommodation Industrial Commercial
 Educational Healthcare Miscellaneous (other)

Certifying Electrical Work and Certificate of Compliance (CoC) details:

Name of Electrical worker(s): Yali Martyn

Registration #: F257450

EW121000

CoC details: Nationwired 15838

CoC(s) attached

Certifying Electrical Work and CoC details:

What was inspected:

New Installation: New Streetlight with M.E.N. board, New Main Neutral bar and circuit protection, New Van Earthing System Banding of Pole and cabinet door

Specify the regulation(s) and comparison standard(s), or identify the certified design, followed when carrying out the inspection:
AS/NZS 3000 part 2

What are the results of the inspection:

Earthing and bonding visual ok,

potenti

M.E.C. imp < 5 Ohm

M.E.N. link

HRPA #005334343

High Risk Category:

- Not to AS/NZS 3000 Part 2 – SA(2)(a)(i) Photovoltaic system – SA(2)(a)(iv) Electrical medical area – SA(2)(a)(vi)
- High voltage installation – SA(2)(a)(a) Hazardous area – SA(2)(a)(c) Mains work – SA(2)(b)
- Mains parallel generation – SA(2)(a)(ii) Animal stunning or meat conditioning – SA(2)(g)
- Other – please describe

Declaration

I hereby confirm that the work described above has been done in accordance with the regulations; and the installation / part installation on which the work has been done is, and will be, when energised, electrically safe.

(Note: Strike out or delete the inappropriate words highlighted in red above.)

Signature:

Date: 10/03/21



Electrical Workers Registration Board

100-100, Victoria Street, Auckland

Record of Inspection (ROI) of High-Risk Prescribed Electrical Work

(Pursuant to the Electricity (Safety) Regulations 2010)



Reference/Record Number:

Nationwired greenhill

Issuer (Inspector) details:

Name of Inspector: Gavin Rodley

Registration # 12510/28

Email Address: gavin@bodcyspark.co.nz

Telephone: 021 428 820

Location of Installation:

Location details: Greenhill park subdivision, Area M, Street light 120 stage 9-15

Location Type: Domestic Non-Domestic Accommodation Industrial Commercial
 Educational Healthcare Miscellaneous (other)

Certifying Electrical Work and Certificate of Compliance (CoC) details:

Name of Electrical worker(s): Yeti Martyn

Registration # E257490

EW121030

CoC details: Nat owned 15839

CoC(s) attained

Certifying Electrical Work and CoC details:

What was inspected:

New Installation, New Streetlight with M.E.N. board, New Main Neutral ear and circuit protection, New Main Earthing System, Bonding of Pole and cabinet door.

Specify the regulation(s) and companion standard(s), or identify the certified design, followed when carrying out the inspection
AS/NZS3000 part 2

What are the results of the inspection:

Earthing and bonding visual ok.

polarity

M.E.C. imp < 5 Ohm

M.E.N. link.

HRPA #0058356F1Z

High Risk Category:

- Not to AS/NZS 3000 Part 2 – SA(2)(a)(i) Photovoltaic system – SA(2)(a)(iv) Electrical medical area – SA(2)(a)(vii)
 High voltage installation – SA(2)(a)(ii) Hazardous area – SA(2)(a)(i) Mains work – SA(2)(b)
 Mains parallel connection – SA(2)(a)(iii) Animal stunning or meat conditioning – SA(2)(c)
 Other – please describe:

Declaration

I hereby confirm that the work described above has been done in accordance with the regulations; and the installation/part installation on which the work has been done is, and will be, when energised, electrically safe.

(Note: Strike out or delete the inapplicable words highlighted in red above.)

Signature:

Date: 07/03/21



Electrical Workers Registration Board

100-100, The Esplanade, Manly, NSW 1585

Record of Inspection (ROi) of High-Risk Prescribed Electrical Work

(Pursuant to the Electricity (Safety) Regulations 2010)



Reference/Record Number:

Nationwired greenhill

Issuer (Inspector) details:

Name of Inspector: Gavin Boddy

Registration # E250728

Email Address: gavin@boddeyspark.co.nz

Telephone: 021 428 820

Location of Installation:

Location details: Greenhill park subdivision, Area M, Streetlight108 stage 9-15

Location Type: Domestic Non-Domestic Accommodation Industrial Commercial
 Educational Healthcare Miscellaneous (other)

Certifying Electrical Work and Certificate of Compliance (CoC) details:

Name of Electrical worker(s): Yehi Martyn

Registration # E257480

EW121000

CoC details: Nationwired: 158510

CoC(s) attached

Certifying Electrical Work and CoC details:

What was inspected:

New Installation, New Streetlight with M.E.N. board New Main Neutral bar and circuit protection, New Main Earthing System Bonding of Pole and cabinet door

Specify the regulation(s) and companion standard(s), or identify the certified design, followed when carrying out the inspection
AS/NZS 3000 part 2

What are the results of the inspection:

Earthing and bonding visual ok.

polarity

M.F.C. imp < 5 Ohm

M.E.N. ins.: URPA 4005805607T

High Risk Category:

- Not to AS/NZS 3000 Part 2 - 6A(2)(a)(i) Proscenium system - 6A(2)(a)(ii) Electrical medical area - 6A(2)(a)(iv)
 High voltage installation - 6A(2)(a)(i) Hazardous area - 6A(2)(a)(iv) Handwork - 6A(2)(i)
 Mains parallel generation - 6A(2)(a)(iii) Animal stunning or meat conditioning - 6A(2)(e)
 Other - please describe

Declaration

I hereby confirm that the work described above has been done in accordance with the regulations, and the installation on which the work has been done is, and will be, when delivered, electrically safe

(Note: Strike out or delete the inappropriate words highlighted in red above)

Signature:

Date: 10/03/21



Electrical Workers Registration Board

100-1000, 100-1000, 100-1000

Record of Inspection (ROI) of High-Risk Prescribed Electrical Work

(Pursuant to the Electricity (Safety) Regulations 2010)



Reference/Record Number:

Natonwired greenhill

Issuer (Inspector) details:

Name of Inspector: Gavin Bodey

Registration #: 1250728

Email Address: gavin@bcdeyapark.co.nz

Telephone: 021 429 820

Location of Installation:

Location details: Greenhill park subdivision, Area M, Streetlight 122 stage 3-5

Location type: Domestic Non-Domestic Accommodation Industrial Commercial
 Educational Healthcare Miscellaneous (other)

Certifying Electrical Work and Certificate of Compliance (CoC) details:

Name of Electrical worker(s): Yell Marilyn

Registration #: E257490

EW121000

CoC details: Nat onwired 157314 Streetlight 122

CoC(s) attached

Certifying Electrical Work and CoC details:

What was inspected:

New Installation, New Streetlight with M.E.N. board. New Main Neutral bar and circuit protection, New Main Earthing System. Bonding of Pole and cabinet door.

Specify the regulation(s) and companion standard(s), or identify the certified design, followed when carrying out the inspection:
AS/NZS3000 part 2

What are the results of the inspection:

Earthing and bonding visual ok.

polarity

M.E.C. Imp < 5 Ohm

M.E.N. link..

HRPA #0068393290

High Risk Category:

- Not to AS/NZS 3000 Part 2 - 6A(2)(a)(i) Photovoltaic system - 6A(7)(a)(iv) Electrical overhead area - 6A(2)(a)(vi)
 High voltage installation - 6A(2)(a)(ii) Hazardous area - 6A(2)(a)(v) Fault work - 4A(2)(1)
 Main parallel generation - 6A(2)(a)(iii) Animal stunning or meat conditioning - 6A(2)(i)
 Other - please describe.

Declaration

I hereby confirm that the work described above has been done in ~~full~~ accordance with the regulations, and the installation/part installation on which this work has been done is, and will be ~~safe~~, when completed, electrically safe.

(Note: Strike out or delete the inappropriate words highlighted in red above.)

Signature: [Signature]

Date: 30/03/21



Electrical Workers Registration Board

www.electricalworkers.co.nz

Record of Inspection (ROI) of High-Risk Prescribed Electrical Work

IPU/50001 to the Electricity (Safety) Regulations 2011



Reference/Record Number:

Nationwired greenhill

Issuer (Inspector) details:

Name of Inspector: Gavin Bodey

Registration #: 1250728

Email Address: gavin@bodeyspark.co.nz

Telephone: 021 428 820

Location of installation:

Location details: Greenhill park subdivision, Area M, Streetlight 115 stage 8-15

Location Type: Domestic Non-Domestic Accommodation Industrial Commercial
 Educational Healthcare Miscellaneous (other)

Certifying Electrical Work and Certificate of Compliance (CoC) details:

Name of Electrical worker(s): Yola Marilyn

Registration #: E257490

EW0121000

CoC details: Nat or wired 15790 Streetlight 115

CoC(s) attached

Certifying Electrical Work and CoC details:

What was inspected:

New Installation. New Streetlight with M.E.N. board, New Main Neutral bar and ground protection, New Main Earthing System, Banding of Pole and cabinet door

Specify the regulation(s) and companion standard(s), or identify the certified design, followed when carrying out the inspection:
AS/NZS3000 part 2

What are the results of the inspection?

Earthing and bonding visual ok,
polarly
M.E.C. imp < 5 Ohm
M.E.N. link IIRPA #006837024X

High Risk Category:

- Not to AS/NZS 3000 Part 2 – CA(2)(a)(i) Photovoltaic system – SA(2)(g)(vi) Federal medical area – CA(2)(b)(vi)
 High voltage installation – EA(2)(b)(ii) Hazardous area – SA(2)(a)(c) Poles work – CA(2)(h)
 Main's parallel generation – SA(2)(b)(iii) Animal stunning or meat conditioning – SA(2)(c)
 Other - please describe

Declaration

I hereby confirm that the work described above has been done in ~~full~~ accordance with the regulations, and the ~~installation~~ part installation on which the work has been done is, and will be, when energised, electrically safe.

(Note: Strike out or delete the inappropriate words highlighted in red above.)

Signature:

Date: 10/03/21



Electrical Workers Registration Board

100-100, Victoria Road, Auckland

Record of Inspection (ROI) of High-Risk Prescribed Electrical Work

(Pursuant to the Electricity (Safety) Regulations 2010)



Reference/Record Number:

Nationwired Greenhill II

Issuer (Inspector) details

Name of Inspector: Garvin Bodey

Registration #: 1250728

Email Address: gavin@bodeyspark.co.nz

Telephone: 021 428 820

Location of Installation:

Location details: Greenhill park subdivision, Area M, Streetlight 116 stage 9-15

Location Type: Domestic Non-Domestic Accommodation Industrial Commercial
 Educational Healthcare Miscellaneous (other)

Certifying Electrical Work and Certificate of Compliance (CoC) details:

Name of Electrical worker(s): Yesi Martyn

Registration #: E:257480

FW121000

CoC details: Nationwired 15759 Greenlight 116

CoC(s) attached

Certifying Electrical Work and CoC details:

What was inspected:

New Installation, New Streetlight with M.E.N. board. New Main Neutral bar and circuit protection. New Main Earthing System. Bonding of Pole and cabinet door

Specify the regulation(s) and companion standard(s), or identify the certified design, followed when carrying out the inspection:
AS/NZS 3000 part 2

What are the results of the inspection:

Earthing and bonding visual ok,

polarity

M.E.C. imp < 5 Ohm

M.E.N. link

HRPA #005957726K

High Risk Category:

Not to AS/NZS 3000 Part 2 – SA(2)(b)(i)

Photovoltaic system – SA(2)(a)(iv)

Partial medical area – SA(2)(b)(A)

High voltage installation – SA(2)(a)(ii)

Hazardous area – SA(2)(a)(v)

Mans work – SA(2)(a)

Mains parallel general on – SA(2)(b)(ii)

Animal stunning or meat conditioning – SA(2)(c)

Other – please describe:

Declaration

I hereby confirm that the work described above has been done in accordance with the regulations; and the ~~work/area~~ installation on which the work has been done is, and will be safe, when delivered, electrically safe.

(Note: Strike out or delete the inapplicable words highlighted in red above.)

Signature: [Signature]

Date: 10/03/21



Electrical Workers Registration Board

Electrical Workers Registration Board

Record of Inspection (ROI) of High-Risk Prescribed Electrical Work

(Pursuant to the Electricity (Safety) Regulations 2001)



Reference/Record Number:

Nationwired greenhill

Issuer (Inspector) details:

Name of Inspector: Gavin Bodey

Registration #: F250728

Email Address: gavin@bodeyspark.co.nz

Telephone: 021 428 820

Location of Installation:

Location details: Greenhill park subdivision, Area M, Streetlight 117 stage 9-15

Location Type: Domestic Non-Domestic Accommodation Industrial Commercial
 Educational Healthcare Miscellaneous (other)

Certifying Electrical Work and Certificate of Compliance (CoC) details:

Name of Electrical worker(s): Yoni Martyn

Registration #: F257493

EW121000

CoC details: Nationwired 15799 Streetlight 117

CoC(s) attached

Certifying Electrical Work and CoC details:

What was inspected:

New Installation, New Streetlight with M.E.N. board, New Main Neutral bar and circuit protection, New M.E.N. Earthing System Bonding of Pole and cabinet door.

Specify the regulation(s) and comparison standard(s), or identify the certified design, followed when carrying out the inspection:
AS/NZS3000 part 2

What are the results of the inspection:

Earthing and bonding visual ok,

polarity

M.E.C. Imp < 0.1m

M.E.N. link

HRPA #005837GH8C

High Risk Category:

- Not to AS/NZS 3000 Part 2 - 6A(2)(a)(i) Photovoltaic system - 6A(2)(a)(iv) Electrical medical area - 6A(2)(a)(v)
 High voltage installation - 6A(2)(a)(i) Hazardous area - 6A(2)(a)(ii) Mains work - 6A(2)(b)
 Mains parallel generation - 6A(2)(a)(iii) Ancillary stuffing or media conditioning - 6A(2)(c)
 Other - please describe:

Declaration

I hereby confirm that the work described above has been done in / ~~has~~ accordance with the regulations; and the ~~installation / part~~ installation on which the work has been done is, and will be / ~~is~~, when energised, electrically safe.

(Note: Strike out or delete the name of cable work highlighted in red above.)

Signature:

Date: 10/03/21



Electrical Workers Registration Board

100 Victoria Street, Auckland

Record of Inspection (ROI) of High-Risk Prescribed Electrical Work

(Pursuant to the Electricity (Safety) Regulations 2010)



Reference/Record Number:

Nationwired greenhill

Issuer (Inspector) details

Name of Inspector: Gavin Bodey

Registration # 1250728

Email Address gavin@bodeyspark.co.nz

Telephone: 021 428 820

Location of Installation:

Location details Greenhill park subdivision, Area M, Streetlight 113 stage 0-15

Location Type: Domestic Non-Domestic Accommodation Industrial Commercial
 Educational Healthcare Miscellaneous (other)

Certifying Electrical Work and Certificate of Compliance (CoC) details:

Name of Electrical worker(s) Yogi Martyn

Registration # E257480

EW121000

CoC details: Nationwired 157915 Streetlight 116

CoC(s) attached

Certifying Electrical Work and CoC details:

What was inspected

New Installation: New Streetlight with M.E.N. board, New Main Neutral bar and circuit protection, New Main Earthing System Bonding of Pole and cabinet door

Specify the regulation(s) and companion standard(s), or identify the certified design, followed when carrying out the inspection:

AS/NZS3000 part 2

What are the results of the inspection:

Earthing and bonding visual ok,

polarity

M.E.C. Imp < 5 Ohm

M.E.N. link

IRPA 40050382F4F

High Risk Category:

- Not to AS/NZS 3000 Part 2 - 6A(2)(a)(i) Photovoltaic system - 6A(2)(a)(iv) Electrical medical area - 6A(2)(a)(v)
 High voltage installation - 6A(2)(a)(ii) Hazardous area - 6A(2)(a)(iii) Mains work - 6A(2)(b)
 Main parallel generation - 6A(2)(a)(ii) Arma. stunning or meat conditioning - 6A(2)(c)
 Other - please describe: _____

Declaration

I hereby confirm that the work described above has been done in accordance with the regulations, and the ~~regulation~~ part installation on which the work has been done is, and will be ~~correct~~, when anticipated, electrically safe

(Note: Strike out or delete the inapplicable words highlighted in red above.)

Signature:

Date: 10/03/21



Electrical Workers Registration Board

100-1000, The Arcade, Auckland

Record of Inspection (ROI) of High-Risk Prescribed Electrical Work

(Pursuant to the Electricity (Safety) Regulations 2010)



Reference/Record Number:

Nationwired greenhill

Issuer (Inspector) details:

Name of Inspector: Gavin Bodey

Registration #: 1250726

Email Address: gavin@bodeyspark.co.nz

Telephone: 021 428 820

Location of Installation:

Location details: Greenhill park subdivision, Area M, Streetlight 119 stage 9-15

Location Type: Domestic Non-Domestic Accommodation Industrial Commercial
 Institutional Healthcare Miscellaneous (other)

Certifying Electrical Work and Certificate of Compliance (CoC) details:

Name of Electrical worker(s): Yeli Martyn

Registration #: E257450

CoC details: Nationwired 157912 Streetlight 119

EW121000

CoC(s) attached

Certifying Electrical Work and CoC details:

What was inspected:

New Installation, New Streetlight with M.E.N. board, New Main Neutral bar and circuit protection, New Main Earthing System, Bonding of Pole and cabinet door.

Specify the regulation(s) and companion standard(s), or identify the certified design, followed when carrying out the inspection:
AS/NZS3000 part 2

What are the results of the inspection:

Earthing and bonding visual ok,

polarity

M.E.C. imp < 5 Ohm

M.E.N. link: FRIPA #0350335XCN

High Risk Category:

- Not to AS/NZS 3000 Part 2 - 6A(2)(a)(i) Photo-optic systems - 6A(2)(a)(iv) Electrical medical area - 6A(2)(a)(v)
- High voltage installation - 6A(2)(a)(ii) Hazardous area - 6A(2)(a)(v) Mains work - 6A(2)(b)
- Mains parallel generation - 6A(2)(a)(iii) Animal stunning or meat conditioning - 6A(2)(c)
- Other please describe: _____

Declaration

I hereby confirm that the work described above has been done in full and in accordance with the regulations, and the installation/part installation on which the work has been done is, and will be, safe, when re-energised electrically safe.

(Note: Strike out or delete the words in this form which are highlighted in red above.)

Signature: _____

Date: 10/03/21

Supplier's Declaration of Conformity (in accordance with ISO/IEC 17050-1)

Number: 2692777034128
Issuer's Name: Ibex International Ltd.
Issuer's Address: PO BOX 9077 Greerton
Tauranga
3142

Object of the Declaration: We declare that the items described are Electrically Safe as required in the Electricity (Safety) Regulations 2010 Regulation 80.

MINI STORK 2500LM LENS21 22W S-CAP 3000K BLACK

The Object of the Declaration described above is in conformity with the requirements of the following documents:

Document Number:	Title	Edition / Date of Issue
AS/NZS 3820	Essential Safety Requirements For Electrical Equipment	2009/AMD 1

Additional information

Signed for and on behalf of: Ibex International Ltd.
Tauranga

Date: 4/03/2021



Kingsley Holt Supply Chain & Innovation Manager

F3.10 RAMM STREETLIGHT DATA

(to be completed for each change in streetlight type)

Subdivision and stage/Contract: GREENHILL PARK AREA M STAGE 15

Number of street lights of this type: 4

General

Date Installed: 10/3/21

Control Type: Network Streetlight Feed / Photocell / Other:

Origin of Power Supply: Streetlight Circuit / Metered Power Supply

Light

Manufacturer: VIZULO

Model: MINI STORK

Total Power Consumption (W): 22.3W

Light Height (m): 6m

Tilt Angle (° Degrees): 0°

Outreach

Outreach Type: Curved / Mitre / Other Decorative: MILFORD

Outreach Distance (m): 1m

Pole

Manufacturer: IBEX LIGHTING

Type: Octagonal / Circular / Power / Other Decorative: Tapered

Pole Height (m): 6m

Material: Galvanised Steel / Steel / Other:

Coating: N/A / Painted / Powder Coated

Colour (if coated): BLACK

Mounting: Frangible ground plant / Shear Base

- Manufacturer's Warranty documents for Poles, Lights and Coatings attached.
- Shown on as-built drawings.

F3.10 RAMM STREETLIGHT DATA

(to be completed for each change in streetlight type)

Subdivision and stage/Contract GREENHILL PARK AREA M STAGE 15

Number of street lights of this type 3

General

Date Installed 10/3/21

Control Type Network Streetlight Feed / Photocell / Other:

Origin of Power Supply Streetlight Circuit / Metered Power Supply

Light

Manufacturer VIZULO

Model MINI STORK

Total Power Consumption (W) 13.5W

Light Height (m) 6m

Tilt Angle (° Degrees) 0°

Outreach

Outreach Type Curved / Mitre / Other Decorative MILFORD

Outreach Distance (m) 1m

Pole

Manufacturer IBEX LIGHTING

Type Octagonal / Circular / Power / Other Decorative: Tapered

Pole Height (m) 6m

Material Galvanised Steel / Steel / Other:

Coating N/A / Painted / Powder Coated

Colour (if coated) BLACK

Mounting Frangible ground plant / Shear Base:

- Manufacturer's Warranty documents for Poles, Lights and Coatings attached.
- Shown on as-built drawings.

APPENDIX 8

Miscellaneous Check Lists and Producer Statements

- Subdivision Works Clearance Application Form
- Subdivision Certification Application Form
- Contractor Producer Statement Form
- Land Transfer Plan LT 548658
- Schedule of Engineering Value
- Developers Tax Invoice
- Consultant Certification Statement Form
- Asbuilt Statement Form



Subdivision Works Clearance Application Form

Agent details (where an agent is applying on behalf of the consent holder)

Agent name:	<input type="text"/>
Agent company:	<input type="text"/>
Postal address:	<input type="text"/>
Telephone:	<input type="text"/>
Email:	<input type="text"/>

Subject Site

Site address:	<input type="text"/>		
Legal description:	<input type="text"/>		
Resource consent number:	<input type="text"/>	Date consent issued:	<input type="text"/>
Stage (if applicable):	<input type="text"/>	No. of lots (excluding roads/reserves):	<input type="text"/>

Clearances required

Certification required: Engineering Landscaping Other (please specify)

Fees and payment

You will be charged for the time spent by staff in preparing for and undertaking engineering works clearance site visits. Refer to Fees and Charges, as set out on our website at www.hamilton.govt.nz for costs.

Payment of fees is due upon invoice which will be issued at s224c subdivision certification stage.

Agent declaration

As a registered professional surveyor/planner, I confirm that:

- I am satisfied that the engineering and landscaping physical works have been completed in accordance with the Resource Consent
- I accept that my application may be returned if there are outstanding agreements relating to development contribution remissions or valuation of land, or if all information required for works clearance is not submitted

Subdivision Certification Application Form

Agent details (where an agent is applying on behalf of the consent holder)

Agent name:

Agent company:

Postal address:

Telephone:

Email:

Preferred means of contact: Mail Email Phone

Consent holder name

Consent holder name:

Postal address:

Telephone:

Email:

Debtor details (for invoicing)

Debtor is: Agent Owner Other (please specify)

Debtor's Name:

Postal address:

Subject Site

Site address:

Legal description:

Resource consent number: Stage Number:

Certification required

Certification required: s223 s224(c) s224(f) s32(2)(a)

Other (please specify)

Condition(s) of consent requirements

As a registered professional surveyor/planner, I confirm that:

1. For larger/complex consents, I have attended a pre-application meeting with Hamilton City Council staff to review my draft s224c application.
2. I hereby attach all information required to satisfy Hamilton City Council that all conditions specified in the subdivision consent referenced above (in terms of certification required) have been met.
3. I accept that where it is found that not all information required under clause 2 above is provided, this application shall be returned to the address for re-lodgement.
4. Where an engineering or similar professionally prepared plan and supporting information (such as landscaping or ecological plan) has to be approved by council, I have attached written evidence of such approval.
5. Where evidence of completion and approval of all physical works is required (e.g. construction of services, landscape planting). I have attached written evidence of such approval.
6. The required Landonline electronic certification documentation have been prepared and submitted to Hamilton City Council for approval.

Acceptance

I confirm that all of the above have been satisfied.

Name:

Date:

Send

Send applications to subdivision@hcc.govt.nz, drop off via the duty planner at the Municipal Building Garden Place, between 8am – 4.45pm, Monday to Friday or post to **Planning Guidance Subdivisions, Hamilton City Council, Private Bag 3010, Hamilton 3240.**

Remember to attach:

- Conditions of subdivision consent documentation
- Works clearance certificate

Send

Send applications to subdivision@hcc.govt.nz, drop off via the duty planner at the Municipal Building Garden Place, between 8am – 4.45pm, Monday to Friday or post to Planning Guidance Subdivisions, Hamilton City Council, Private Bag 3010, Hamilton 3240.

Documentation to provide:

- The attached checklist
- All required information listed in the checklist

OFFICE USE ONLY

Documentation saved to TRIM

Authority updated

Acknowledgement sent

Works Clearance Checklist

PART A - QA DOCUMENTATION:

a. General

	Received	Date
Easements required		
Consent notices required		
Power, telecommunication, gas connections certification		
Contractor Certificate		
Producer Statement		

b. Parks

Landscaping Plans Accepted Date:

	Approved by	Date
Final Inspection Checklist		

c. Roading

Engineering Plans Accepted Date:

	Approved by	Date
Subgrade Compaction/Relative Height		
Subbase Compaction/Relative Height		
Basecourse Compaction/Relative Height		
Penetrometer Results		
Clegg Hammer Results		
Benkelman Beam Results		

d. Stormwater

Engineering Plans Accepted Date:

	Approved By	Date
Wetlands and Ponds Management Checklist		
Wetlands and Ponds Inspection Checklist		
Pipe Laying Checklist		
Manhole Checklist		
Trench Backfill Compaction Test		
Catchpit Checklist		
Final Inspection Checklist		
Stormwater device Operations and Maintenance Manual supplied		

e. Wastewater

Engineering Plans Accepted

Date:

	Approved By	Date
Pipe Laying Checklist		
Manhole Checklist		
Trench Backfill Compaction Test		
Final Inspection Pipe Network		
Pumping Station Check Forms		
Pressure Test Results		

f. Water

Engineering Plans Accepted

Date:

Form/Process	Approved By	Date
Pipe Laying Checklist		
Final Inspection Checklist		
Pressure Test Results		
Bacteriological Test Results		

PART B - ASBUILT DATA:

a. Roading

Data	Received	Checked
RAMM data		
Streetlight Data		
Asbuilt Plans		
DXF Files		

b. Stormwater

Data	Received	Checked
Datasheets		
Asbuilt Plans		
DXF Files		

c. Wastewater

Data	Received	Checked
Datasheets		
Asbuilt Plans		
DXF Files		

d. Water

Data	Received	Checked
Datasheets		
Asbuilt Plans		
DXF Files		

e. Parks

Data	Received	Checked
Datasheets		
Asbuilt Plans		
DXF Files		

f. Finance

Data	Received	Checked
GST Values		
Land Values		
Asset Quantities		

PART C – CONDITIONS/BONDS:

Documentation	Received	Checked
Engineering conditions attached and completed		
Bond requested and quote attached		

SCHEDULE OF LAND AND ASSETS TO VEST IN COUNCIL

Hamilton City Council will use these values to record the assets once ownership has transferred following approval of s224c certification.

GENERAL DETAILS

Subdivision name: _____

Site address: _____

HCC application number: _____

DPS number(s): _____

Developer name: _____

Postal address: _____

Suburb: _____

City: _____ Postal code: _____

This information is certified as being true and correct

Completed by: Land owner Agent Other (please specify) _____

Name: _____

Signature: Barry Pearson Date signed: _____

SEND

Email this to subdivision@hcc.govt.nz. Alternatively, if you are attending a works clearance pre-application meeting, please bring this completed form with you.

SUMMARY OF LAND AND ASSETS TO VEST IN COUNCIL (excluding GST)

ASSET TYPE	COST/VALUE	REMOVE COUNCIL'S CONTRIBUTION	TOTAL VESTED
Land (A)			
Water supply (B)			
Wastewater (C)			
Stormwater (D)			
Roading (E)			
Parks (F)			
Other (G)			
TOTAL (excluding GST)			

PLANNING GUIDANCE

For general planning guidance enquiries, contact the duty planner weekdays 8am - 4.45pm.

Email: planning.guidance@hcc.govt.nz Phone: 07 838 6699

SCHEDULE OF LAND AND ASSETS TO VEST IN COUNCIL

LAND, WATER SUPPLY, WASTEWATER AND STORMWATER (All values are to be exclusive of GST)

LAND (A)	DPS	MEASURE (AREA M2)	COST/VALUE	COUNCIL'S CONTRIBUTION
Roading				
Recreation reserve				
Local purpose reserve				
Other - please specify				
TOTAL				
TOTAL VESTED				

WATER SUPPLY (B)	MEASURE	COST/VALUE	COUNCIL'S CONTRIBUTION
Mains	Metres		
Ridermains	Metres		
Services	No.		
Hydrants	No.		
Sluice and peat valves	No.		
Other - please specify			
TOTAL			
TOTAL VESTED			

WASTEWATER (C)	MEASURE	COST/VALUE	COUNCIL'S CONTRIBUTION
Mains	Metres		
Manholes	No.		
Connections	No.		
Other - please specify			
TOTAL			
TOTAL VESTED			

STORMWATER (D)	MEASURE	COST/VALUE	COUNCIL'S CONTRIBUTION
Mains	Metres		
Manholes	No.		
Connections	No.		
Outfalls (inlet/outlet structures)	No.		
Wetland/rain garden planting	Area (m ²)		
Other - please specify			
TOTAL			
TOTAL VESTED			

PLANNING GUIDANCE

For general planning guidance enquiries, contact the duty planner weekdays 8am - 4.45pm.

Email: planning.guidance@hcc.govt.nz **Phone:** 07 838 6699

SCHEDULE OF LAND AND ASSETS TO VEST IN COUNCIL

ROADING, PARKS AND OTHER (All values are to be exclusive of GST)

ROADING (E)	MEASURE	COST/VALUE	COUNCIL'S CONTRIBUTION
Pavement	Area (m ²)		
Surfacing	Area (m ²)		
Kerb and channel (full height)	Metres		
Berms	Area (m ²)		
Footpaths (inc. walkways & cycleways)	Area (m ²)		
Vehicle crossings (excl. residential)	Area (m ²)		
Road drainage (catchpits & leads)	No.		
Street lighting	No.		
Signage	No.		
Subsoil drains	Metres		
Tactile pavers	No.		
Parking and bus bays	Area (m ²)		
Sundries (bridges/culverts/walls/etc)	No.		
Other - please specify			
TOTAL			
TOTAL VESTED			

PARKS (F)	MEASURE	COST/VALUE	COUNCIL'S CONTRIBUTION
Bollards	No.		
Landscaping (trees, shrubs)	Area (m ²)		
Paths	Area (m ²)		
Fencing	Metres		
Play equipment	No.		
Seats/benches/tables	No.		
Other - please specify			
TOTAL			
TOTAL VESTED			

OTHER (G)	MEASURE	COST/VALUE	COUNCIL'S CONTRIBUTION
Buildings	No.		
Other - please specify			
TOTAL			
TOTAL VESTED			

PLANNING GUIDANCE

For general planning guidance enquiries, contact the duty planner weekdays 8am - 4.45pm.

Email: planning.guidance@hcc.govt.nz **Phone:** 07 838 6699



Title Plan - LT 560839

Survey Number LT 560839
Surveyor Reference 218/99 - Greenhill Park - Stage 15
Surveyor Scott Rodney Carley
Survey Firm Shrimpton and Lipinski Limited Partnership
Surveyor Declaration

Survey Details

Dataset Description Lots 407 - 433, 605 and 707 Being a Subdivision Lot 700 DP 558430
Status Initiated
Land District South Auckland
Submitted Date
Survey Class Class A
Survey Approval Date
Deposit Date

Territorial Authorities

Hamilton City

Comprised In

RT 980803

Created Parcels

Parcels	Parcel Intent	Area	RT Reference
Lot 107 Deposited Plan 560839	Fee Simple Title	0.0461 Ha	990750
Lot 408 Deposited Plan 560839	Fee Simple Title	0.0410 Ha	990751
Lot 109 Deposited Plan 560839	Fee Simple Title	0.0423 Ha	990752
Lot 410 Deposited Plan 560839	Fee Simple Title	0.0219 Ha	990753
Lot 411 Deposited Plan 560839	Fee Simple Title	0.0322 Ha	990754
Lot 412 Deposited Plan 560839	Fee Simple Title	0.0449 Ha	990755
Lot 413 Deposited Plan 560839	Fee Simple Title	0.0319 Ha	990756
Lot 111 Deposited Plan 560839	Fee Simple Title	0.0449 Ha	990757
Lot 415 Deposited Plan 560839	Fee Simple Title	0.0319 Ha	990758
Lot 116 Deposited Plan 560839	Fee Simple Title	0.0449 Ha	990759
Lot 417 Deposited Plan 560839	Fee Simple Title	0.0348 Ha	990760
Lot 418 Deposited Plan 560839	Fee Simple Title	0.0315 Ha	990761
Lot 419 Deposited Plan 560839	Fee Simple Title	0.0500 Ha	990762
Lot 420 Deposited Plan 560839	Fee Simple Title	0.0150 Ha	990763
Lot 121 Deposited Plan 560839	Fee Simple Title	0.0500 Ha	990764
Lot 422 Deposited Plan 560839	Fee Simple Title	0.0116 Ha	990765
Lot 123 Deposited Plan 560839	Fee Simple Title	0.0448 Ha	990766
Lot 424 Deposited Plan 560839	Fee Simple Title	0.0349 Ha	990767
Lot 125 Deposited Plan 560839	Fee Simple Title	0.0446 Ha	990768
Lot 426 Deposited Plan 560839	Fee Simple Title	0.0450 Ha	990769
Lot 427 Deposited Plan 560839	Fee Simple Title	0.0150 Ha	990770
Lot 428 Deposited Plan 560839	Fee Simple Title	0.0406 Ha	990771
Lot 429 Deposited Plan 560839	Fee Simple Title	0.0106 Ha	990772
Lot 130 Deposited Plan 560839	Fee Simple Title	0.0450 Ha	990773




Title Plan - LT 560839

Created Parcels

Parcels	Parcel Intent	Area	KT Reference
Lot 1M Deposited Plan 560839	Fee Simple Title	0.0488 Ha	990774
Lot 4Q Deposited Plan 560839	Fee Simple Title	0.0488 Ha	990775
Lot 1M Deposited Plan 560839	Fee Simple Title	0.0488 Ha	990776
Lot 605 Deposited Plan 560839	Vesting on Deposit in Road	0.2154 Ha	
Lot 707 Deposited Plan 560839	Fee Simple Title	1.5972 Ha	990777
Total Area		<u>2.9730 Ha</u>	



Diag. A

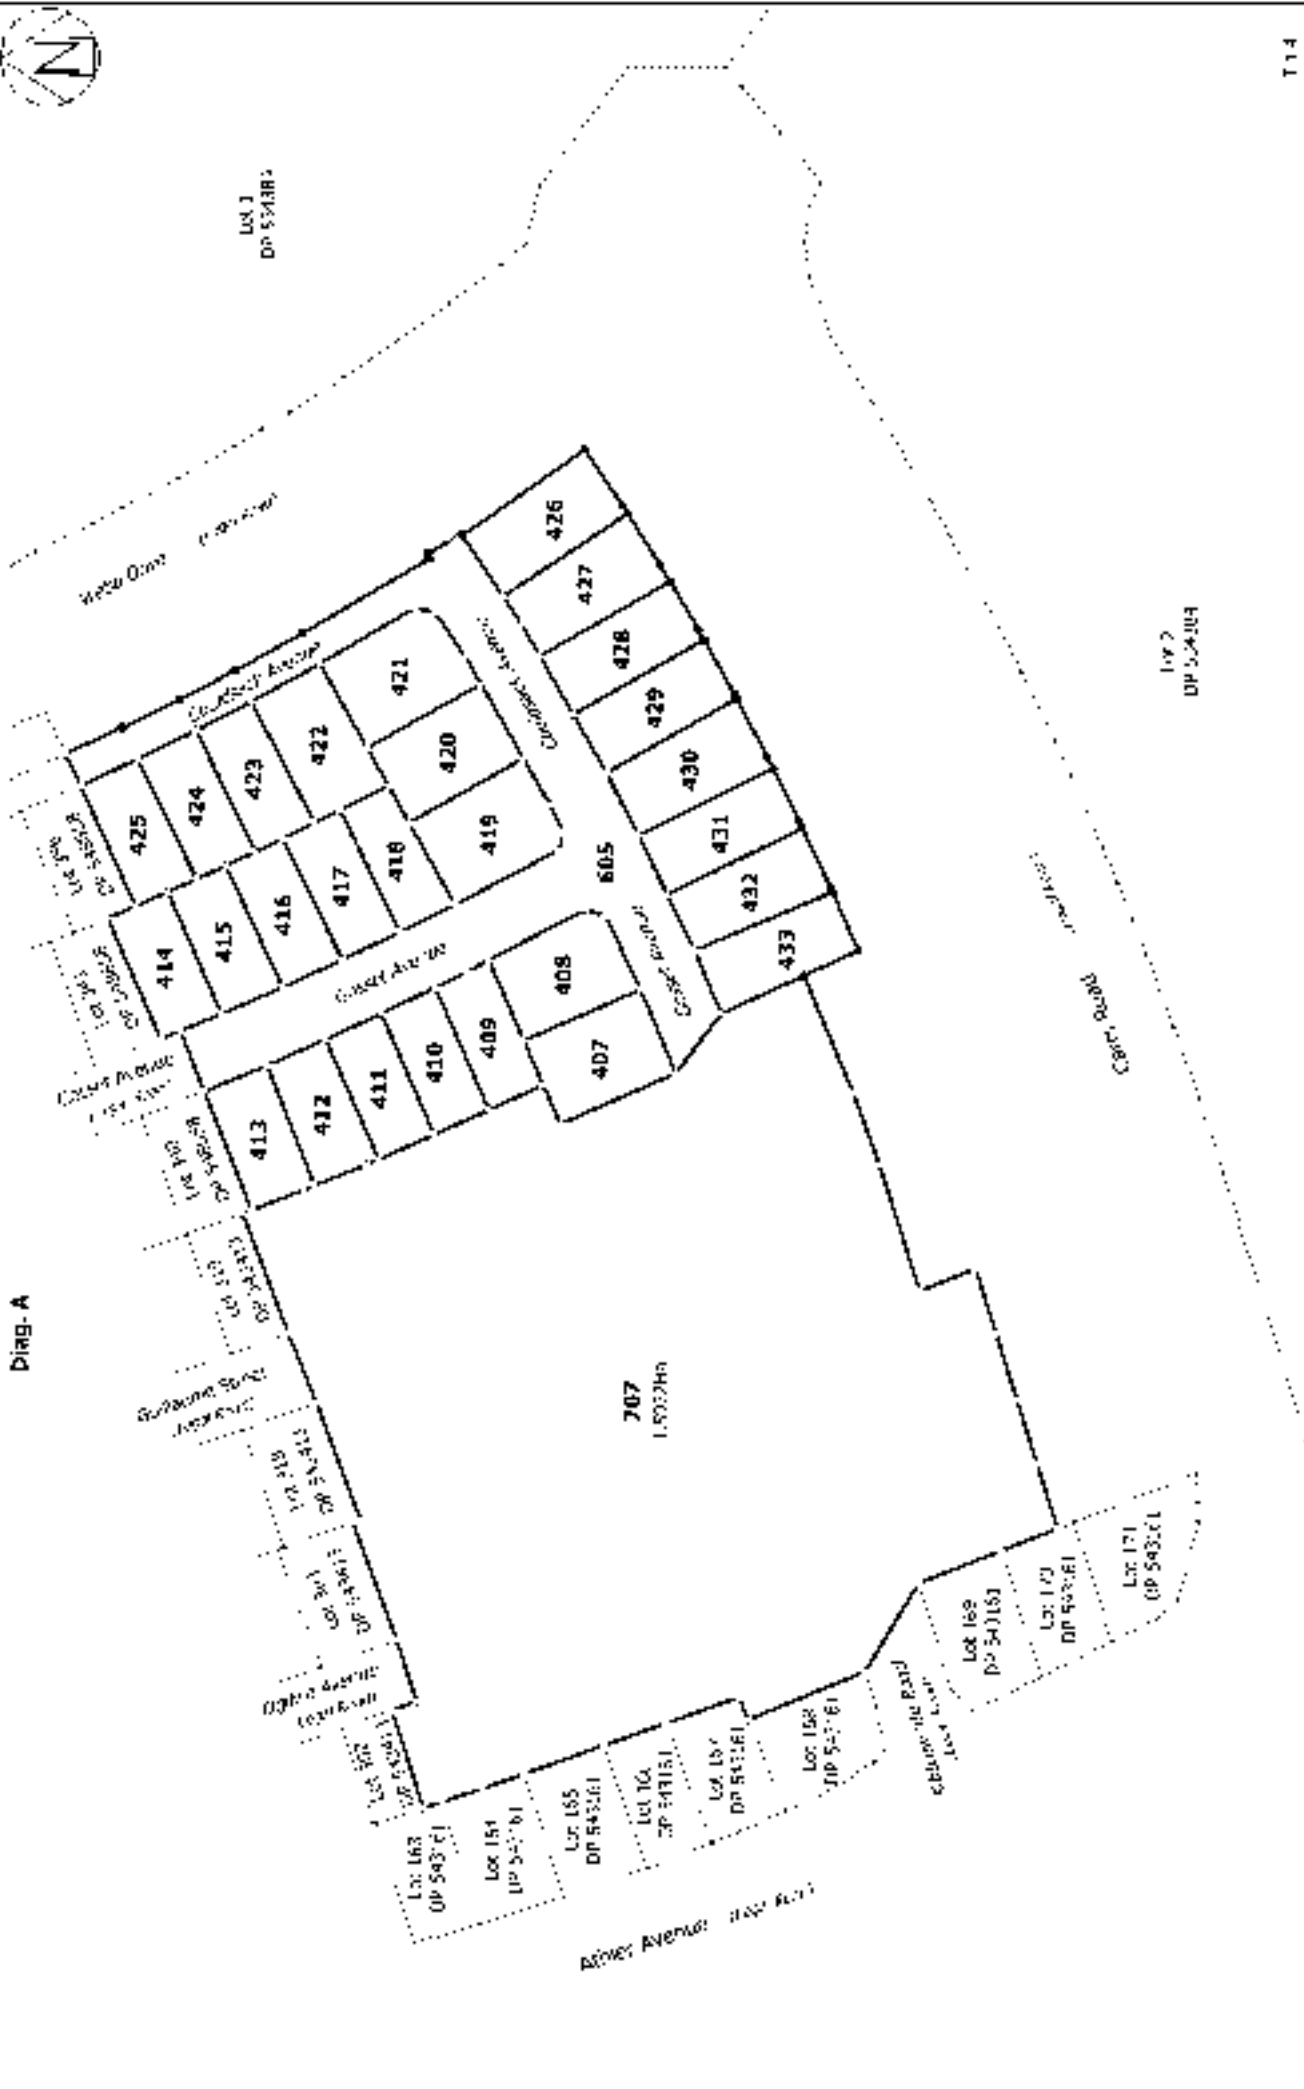

Lot 1
DP 5513R3

Lot 2
DP 524104

T 14




Diag. AB






Diag. AC

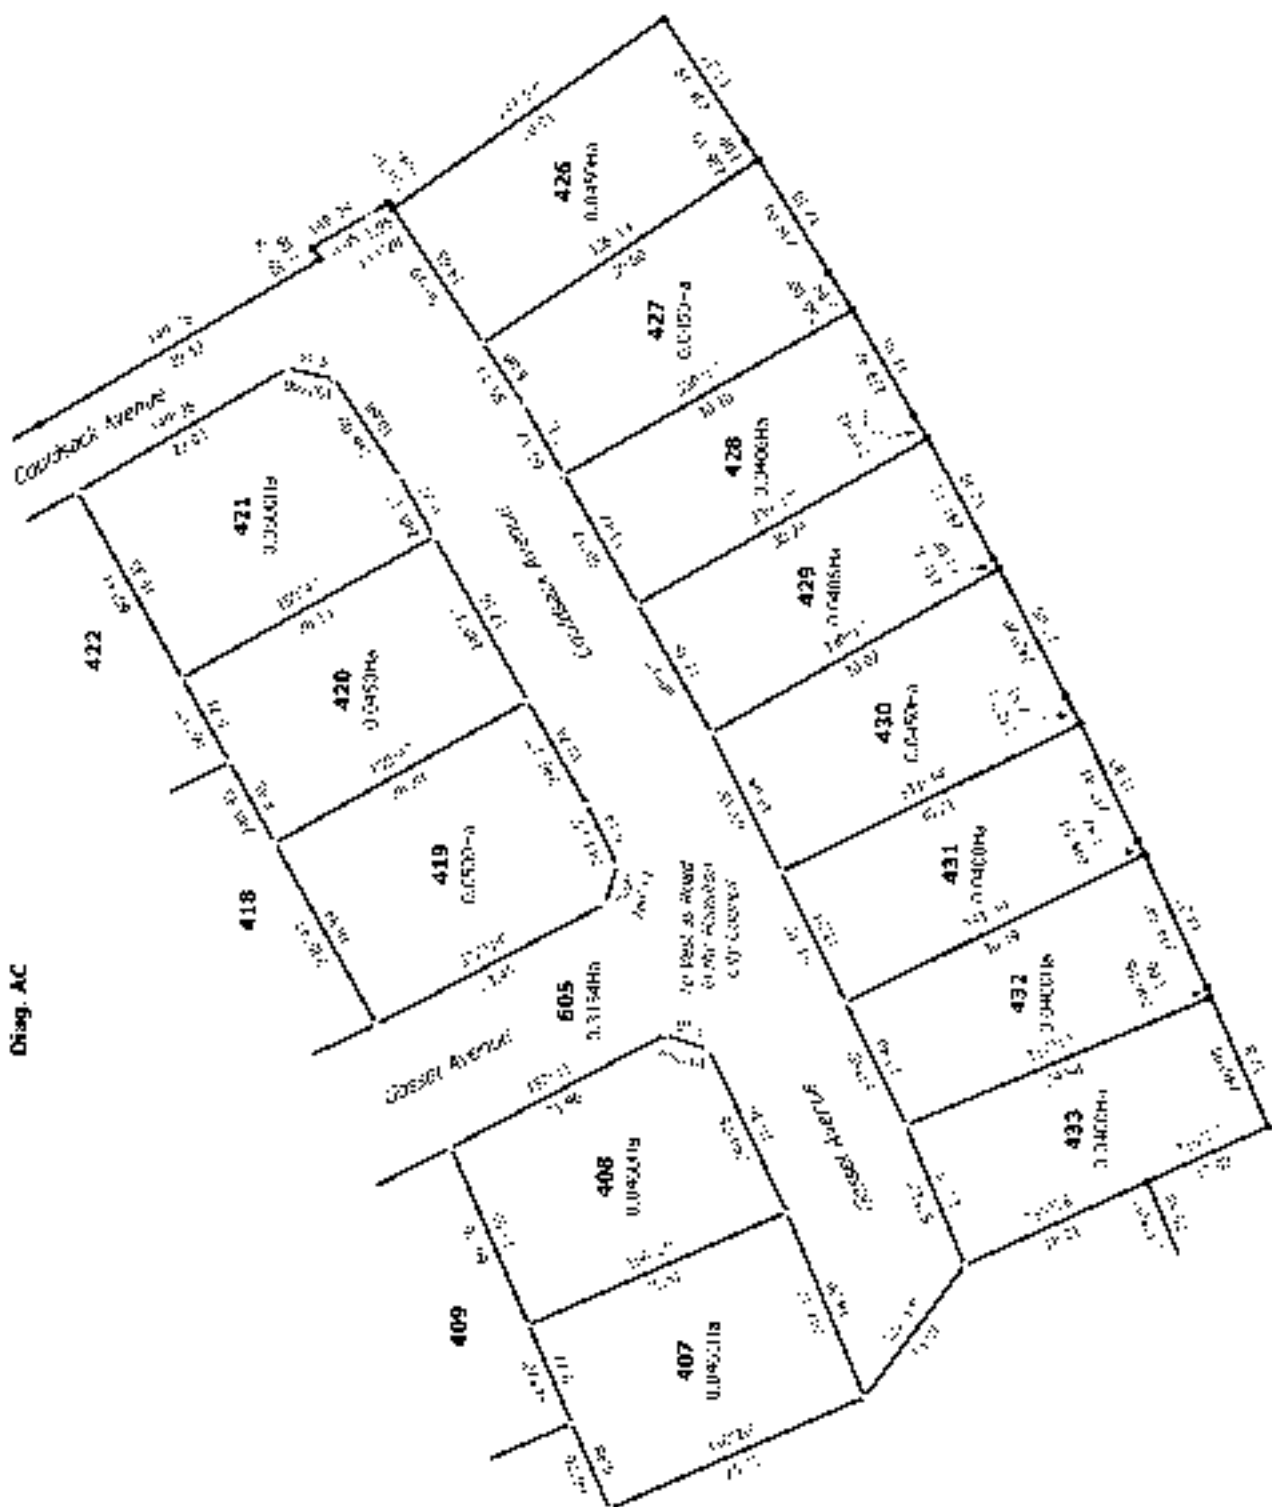

707
1.59774a

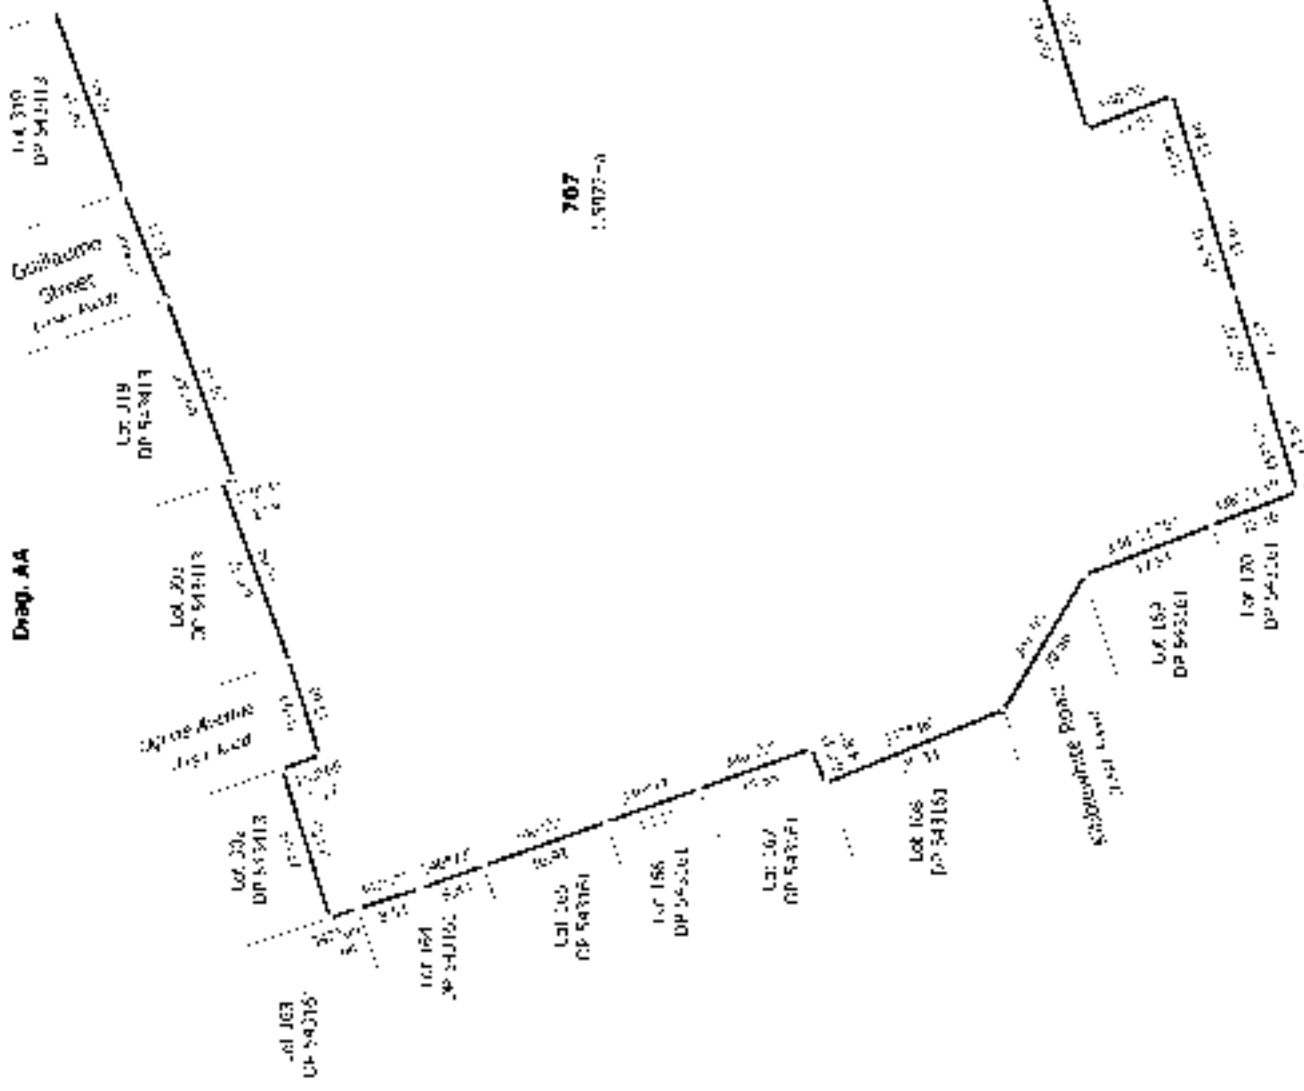

Diag. AA

707
1.5077-a

Land Owner: South American
 Officially Generated Plan
 2025.04.15. 2:00 PM

Lots 407 - 433, 605 and 707 Being a Subdiviso - Lot 706 DP-558430

Surveyor: Scot Robey Co by
 F. J. Ehrmann and J. J. J. Ehrmann

Title Plan:
 LT 560839
 DRAFT

Hamilton City Development Manual	
Volume 4 : Quality Systems for Land Development	Part 9 — Appendices
Authorised by : Design Services Manager	

APPENDIX 4 ii)

PRODUCER STATEMENT — CONSTRUCTION

CONTRACTOR'S CERTIFICATE UPON COMPLETION OF SUBDIVISIONAL WORK

ISSUED BY : Online Contractors 2016 Ltd

 (Contractor)

TO : Chedworth Properties Ltd

 (Principal)

TO BE SUPPLIED TO: Hamilton City Council

 (Territorial Authority)

IN RESPECT OF : Greenhill Park Stage 15

 (Description of subdivisional work)

AT : Gosset Ave and Couldsack Ave, Greenhill Park

 (Address)

Online Contractors 2016 Ltd has contracted to Chedworth Properties Ltd
 (Contractor) (Principal)

to carry out and complete certain subdivisional work in accordance with a contract, titled Contract No.
 for Earthworks and subdivision civil works ("the contract")

I Dan Hopper a duly authorised representative of Online Contractors 2016 Ltd
 (Duly Authorised Agent) (Contractor)

hereby certify that Online Contractors 2016 Ltd

 has carried out and completed the subdivisional works, other than those outstanding works listed below, in accordance with the contract.

Dan Hopper Date 7/4/2021
 (Signature of Authorised Agent on behalf of)

Online Contractors 2016 Ltd

 (Contractor)

PO Box 21187, Rototuna, Hamilton

 (Address)

Outstanding Works

.....

SCHEDULE 6 – FORM OF PRODUCER STATEMENT - CONSTRUCTION

ISSUED BY	ONLINE CONTRACTORS 2016 LTD
TO	CHEDWORTH PROPERTIES LTD
IN RESPECT OF	GREENHILL PARK STAGE 15 INCLUDING: SUBDIVISION CIVIL WORKS, ROADING AND EARTHWORKS
AT	GREENHILL PARK, HAMILTON

ONLINE CONTRACTORS 2016 LTD has contracted to *CHEDWORTH PROPERTIES LTD* to carry out and complete certain building works in accordance with a Contract titled *GREENHILL PARK STAGE 15*.

I Daniel Hopper a duly authorised representative of *ONLINE CONTRACTORS 2016 LTD* believe on reasonable grounds that *ONLINE CONTRACTORS 2016 LTD* as carried out and completed:

All

Part only as specified in the attached particulars of the contract works in accordance with the Contract.

Dan Hopper

7/4/21

Signature of Authorised Agent on behalf of

Date

ONLINE CONTRACTORS 2016 LTD
PO BOX 21187
ROTOTUNA
HAMILTON 3256

Hamilton City Development Manual	
Volume 4 : Quality Systems for Land Development	Part 9 — Appendices
Authorised by : Design Services Manager	

APPENDIX 4 i)

CERTIFICATION UPON COMPLETION OF ROADS, PIPELINES AND OTHER SERVICES

ISSUED BY: Barry Pearson
(suitably qualified professional)

TO: Chedworth Properties Limited
(Development Owner)

TO BE SUPPLIED TO: Hamilton City Council
(Territorial Authority)

IN RESPECT OF: Greenhill Park - Stage 15
(Description of Development Project)

AT: Popham Road, Greenhill Park, Hamilton, New Zealand
(Address)

S & L has been engaged by Chedworth Properties limited
(Survey Firm) (Development Owner)

to provide construction observation, review and certification services in respect of the above development which is described in the specification and shown on the drawings numbered 3411915-CA-2010 to 3411915-CA-2079 approved by Hamilton City Council
(Territorial Authority)

I have sighted the Hamilton City Council consent and conditions of consent to the Development and the approved specification and drawings.
(Territorial Authority)

As an independent professional, I or personnel under my control, have carried out periodic reviews of the works appropriate to the engagement and based upon these reviews, information supplied by the contractor during the course of the works and the contractor's certification upon completion of the works (copy attached) I **BELIEVE ON REASONABLE GROUNDS** that the works, other than those outstanding works listed below, have been completed in accordance with the above consent and sound engineering practice.

 Date 12/4/2021
(Signature suitably qualified Professional)

CMEngNZ, CPEng Member CSNZ NZIS
(Professional Qualifications)
36 Kereiti Street, Mount Maunganui ACENZ IPENZ
(Address) CPEng

Outstanding Works
Nil

Hamilton City Development Manual	
Volume 4 : Quality Systems for Land Development	Part 9 — Appendices
Authorised by : Design Services Manager	

APPENDIX 4 iii)

HAMILTON CITY COUNCIL

CERTIFICATE FOR AS-BUILT DRAWINGS

Greenhill Park - Stage 15
 **DEVELOPMENT**

I, Barry Pearson, Chartered Professional Engineer/Surveyor, hereby certify that all of the information shown on the "as built" drawings and spreadsheets is correct as to location (x, y and z co-ordinates), size, materials. This applies to the following "as built" drawings:

Drawing No.	Title
21879-M-15-WW1-Rev AB	Stage 15 Wastewater Asbuilt Plan
21879-M-15-W1 Rev AB	Stage 15 Water Reticulation Asbuilt Plan
21879-M-15-SW1 Rev AB	Stage 15 Stormwater Asbuilt Plan
21879-M-15-R1-Rev AB	Stage 15 Rooding Asbuilt Plan
.....
.....

Barry Pearson

 Chartered Professional Engineer/Surveyor

14/4/2021

 Date

Strategic Development Unit Works Clearance Checklist

Note: Please refer to the Regional Infrastructure Technical Specifications for testing requirements and guidelines.

Consent Ref: 11.2018.6632

Site Address: Webb Drive, Greenhill Park

New Street Name: Stage 15 – Greenhill Park

Development Engineer:

Documentation	Completed	Date	Notes
General			
GST register for all vested asset (PG L4 and PG L5)			
Upsize contribution documentation	N/A		
WEL completion certificate	Y	8/4/2021	Attached
Gas completion certificate (where necessary)	Y	7/4/2021	Attached
UFF completion certificate	Y	27/3/2021	Attached
Roading			
Completion Certificate (PS4 or similar)	Y	Various	Attached (schedule 6, App 4i, 4ii and 4iii)
Subgrade			
- Stringing or survey of prepared surface (relative shape and height)	Y	1/3/2021	Attached
- Compaction (natural subgrade – Scala, SIL sand-Scala, SIL brown rock – Clegg)	Y	22-1-2021	Attached (Clegg results)
Subbase			
- Stringing (relative shape and height)	N/A		
- Compaction (clegg)	N/A		
- Nuclear densometer (NDMS)	N/A		
Basecourse			

- Stringing (relative shape and height)	Y	15-3-21 Roads 22, 37 & 38	Attached
- Compaction (clegg)	Y	12-3-21 Roads 22, 37 & 38	Attached
- Nuclear densometer (NDMS)	Y	16-3-21 Roads 22, 37 & 38	Attached
- Benkelman beam test	Y	17-3-21 Roads 22, 37 & 38	Attached
RAMM Pavement	Y	8-4-2021	Attached
RAMM Surfacing	Y	1/4/2021	Attached
Streetlight			
Asbuilt Plan	Y	14-4-2021	Attached
RAMM Streetlight	Y	10/3/2021	Attached
Copy of approved application for new connection		8-4-2021	Attached (WEL work clearance)
Producer Statement	Y	10/11/2020	Attached
CoC or ESC signed by authorised person	Y	9/3/2021	Attached
Asbuilt in format approved by WEL		8-4-2021	Attached (WEL work clearance)
Confirmation of practical completion or 224c sign off		8-4-2021	Attached (WEL work clearance)
WEL Networks approval sheet (Written confirmation from WEL for the acceptance of all underground cabling and circuitry)		8-4-2021	Attached (WEL work clearance)
Manufacturer's Warranty Documents	Y	4/3/2021	Attached
Road Drainage			
Asbuilt plan (subsoil/catchpit/leads	Y	14-4-2021	Attached
Secondary flow path	Y	14-4-2021	Attached
Signage and Marking Asbuilt Plan	Y	14-4-2021	Attached
Water			
Water as-built plan	Y	14-4-2021	Attached
Data Sheet	Y	14-4-2021	Attached

Pressure test certificate	Y	4/2/2021	Attached
DXF (if >2 lots)	N/A		
Bacteriological test result	Y	16/2/2021	Attached
Hydrant test (where necessary)	N/A		
RITS checklists			
- F6.1 Water reticulation design confirmation,	N/A		Beca design
- F6.2 Water reticulation pipe laying checklist,	7/4/2021		Attached
- F6.3 Water reticulation final inspection checklist	8/4/2021		Attached
Wastewater			
Wastewater as-built plan	Y	14-4-2021	Attached
Data sheet	Y	14-4-2021	Attached
DXF (if >2 lots)	N/A		
CCTV investigation	Y	12-4-2021	Submission email attached
Pipe Pressure test	Y	16/11/2020	Attached
Manhole pressure test	Y	16/11/2020	Attached
Trench backfill	Y	Not dated	Attached (Clegg results)
RITS checklist			
- F5.1 wastewater design confirmation,	N/A		Beca design
- F5.2 Wastewater pipe laying checklist,	Y	16/12/2020	Attached
- F5.3 Wastewater manhole checklist,	Y	16/12/2020	Attached
- F5.4 Wastewater trench backfill test summary,	Y	16/12/2020	Attached
- F5.6 Wastewater pipe network- final inspection checklist,	Y	9/3/2021	Attached

- F5.7 Pump station control programming checklist	N/A		
Stormwater			
Stormwater as-built plan	Y	14-4-2021	Attached
Data sheet	Y	14-4-2021	Attached
DXF (if >2 lots)	N/A		
Wetland as-built plan (see RITS for minimum details required)	N/A		
Completed planting plan (confirmation that plants are in accordance with the accepted plan)			To be provided
Proprietary device completion certificate	N/A		
Final operation and maintenance manual	N/A		
CCTV investigation	Y	12-4-2021	Submission email attached.
Trench backfill	Y	Not dated	Attached (Clegg Results)
RITS checklist			
- F4.1 Stormwater design checklist,	N/A		Beca design
- F4.2 Stormwater pipe laying checklist,	Y	14/12/2020	Attached
- F4.3 Stormwater manhole checklist,	Y	14/12/2020	Attached
- F4.4 Stormwater trench backfill compaction test summary,	Y	14/12/2020	Attached
- F4.5 Stormwater catchpit checklist,	Y	14/12/2020	Attached
- F4.6 Stormwater pipe network final inspection checklist,	Y	9/3/2021	Attached
- F4.7 Wetland construction inspection checklist,	N/A		
- F4.8 Wetland and inspection/Sign off checklist	N/A		

- Final Operation and Maintenance Manual	N/A		
- Final Water Impact Assessment	N/A		
Parks and Open Spaces Street trees/planting sign off	As Built plan		
Bond			
Quote	N/A		
Signed bond form			To be supplied from HCC
Other:	N/A		



APPENDIX 9

As Built Drawings

- 21879-M-15-WW1 Rev AB – Stage 15 Wastewater Asbuilt Plan
- 21879-M-15-W1 Rev AB – Stage 15 Water Reticulation Asbuilt Plan
- 21879-M-15-SW1 Rev AB – Stage 15 Stormwater Asbuilt Plan
- 21879-M-15-R1 Rev AB – Stage 15 Roading Asbuilt Plan



C:\Users\iparkinson\Downloads\21879-M-15 - CADD - Stage 15 As-built\21879-M-15 - CADD - Stage 15 As-built.dwg - P10.ctb: 15/04/2021

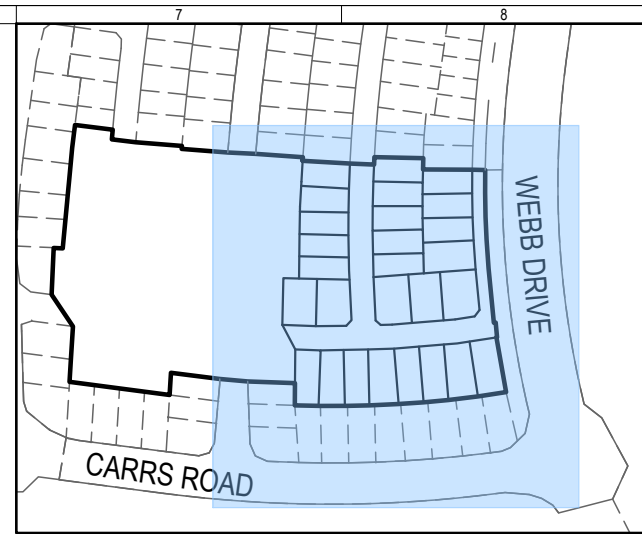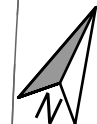

LOCALITY PLAN
SCALE 1:4000

STREETLIGHT COORDINATES		
NAME	EASTING	NORTHING
SL133	447397.26	702957.67
SL134	447421.46	702913.42
SL135	447421.69	702885.72
SL136	447334.76	702918.93
SL137	447359.12	702870.26
SL138	447379.11	702869.65
SL139	447362.60	702852.48

S&L
SHRIMPTON & LIPINSKI
 LAND DEVELOPMENT &
 DESIGN SPECIALISTS
 Ph. 07 577 6069
 Email: info@sltga.co.nz
 P.O. Box 231, Tauranga 3140
 www.sltga.co.nz

- NOTES:**
 1. HCC REF: 011.2018.00006632.001
- LEGEND:**
- ABUTTAL
 - BOUNDARY
 - EDGE OF SEAL
 - VERTICAL KERB
 - MOUNTABLE KERB
 - STAGE PERIMETER
 - SUBSOIL DRAINS
 - FOOTPATH
 - STREETLIGHT
 - TREE
 - OVERLAND FLOW PATH
 - PONDING

Rev	DESCRIPTION	DRN	CKD	APP	DATE
0	PRELIMINARY	NW	SRC	NF	04/21
AB	AS-BUILT	NW	SRC	NF	04/21

SURVEYED	NAME	DATE	DESIGNED	NAME	DATE
	SRC	03/21	BECA	BECA	08/18

COORDINATE SYSTEM: MT EDEN 2000 CIRCUIT
 ORIGIN OF COORDINATES: ALP 4 DP 534481
 HEIGHT DATUM: MOTURIKI DATUM 1953
 ORIGIN OF HEIGHT: SS 507 SO 42451 RL = 44.04m

**STAGE 15
 ROADING
 AS- BUILT PLAN**



ORIGINAL SCALES @ A3	STATUS
1:750	AS-BUILT

DRAWING NO: **21879-M-15-R1** REVISION: **AB**



SHRIMPTON & LIPINSKI

LAND DEVELOPMENT & DESIGN SPECIALISTS

Ph. 07 577 6069
Email: info@sltga.co.nz
P.O. Box 231, Tauranga 3140
www.sltga.co.nz

NOTES:

- HCC REF: 011.2018.00006632.001
- LOT CONNECTIONS AND LATERAL LINES PLOTTED FROM DATA SUPPLIED BY WEST CONSTRUCTION
- LOT CONNECTIONS ARE Ø100 uPVC SN16 RR UNLESS SHOWN OTHERWISE

LEGEND:

- ABUTTAL - - - - -
- BOUNDARY - - - - -
- STAGE PERIMETER - - - - -
- WASTEWATER MAIN - NEW - - - - -
- WASTEWATER CONNECTION - - - - -
- WASTEWATER - EXISTING - - - - -
- WW MANHOLE - NEW ●
- WW MANHOLE - EXISTING ○
- WASTEWATER CONNECTION ■

Rev	DESCRIPTION	DRN	CKD	APP	DATE
0	PRELIMINARY	NW	SRC	NF	04/21
AB	AS-BUILT	NW	SRC	NF	04/21

NAME	DATE	NAME	DATE
SURVEYED SRC	03.21	DESIGNED BECA	08.18

COORDINATE SYSTEM: MT EDEN 2000 CIRCUIT
ORIGIN OF COORDINATES: ALP 4 DP 534481
HEIGHT DATUM: MOTURIKI DATUM 1953
ORIGIN OF HEIGHT: SS 507 SO 42451 RL = 44.04m

STAGE 15 WASTEWATER AS- BUILT PLAN


PREPARED FOR




ORIGINAL SCALES @ A3 STATUS
1:750 AS-BUILT

DRAWING NO: 21879-M-15-WW1 REVISION: AB

COPYRIGHT ON THIS DRAWING IS RESERVED

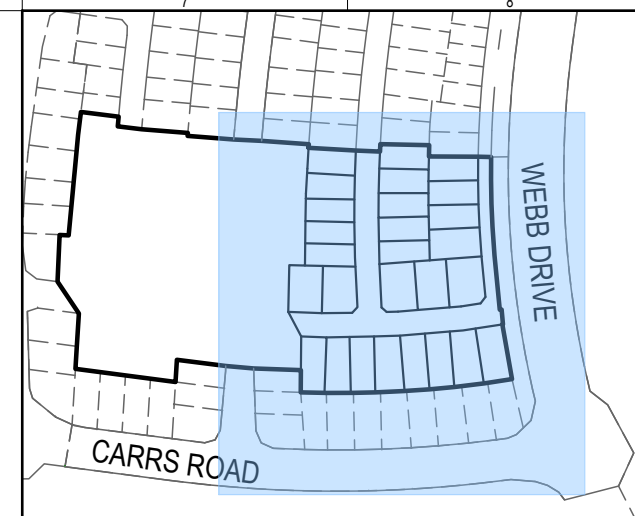

LOCALITY PLAN
SCALE 1:4000

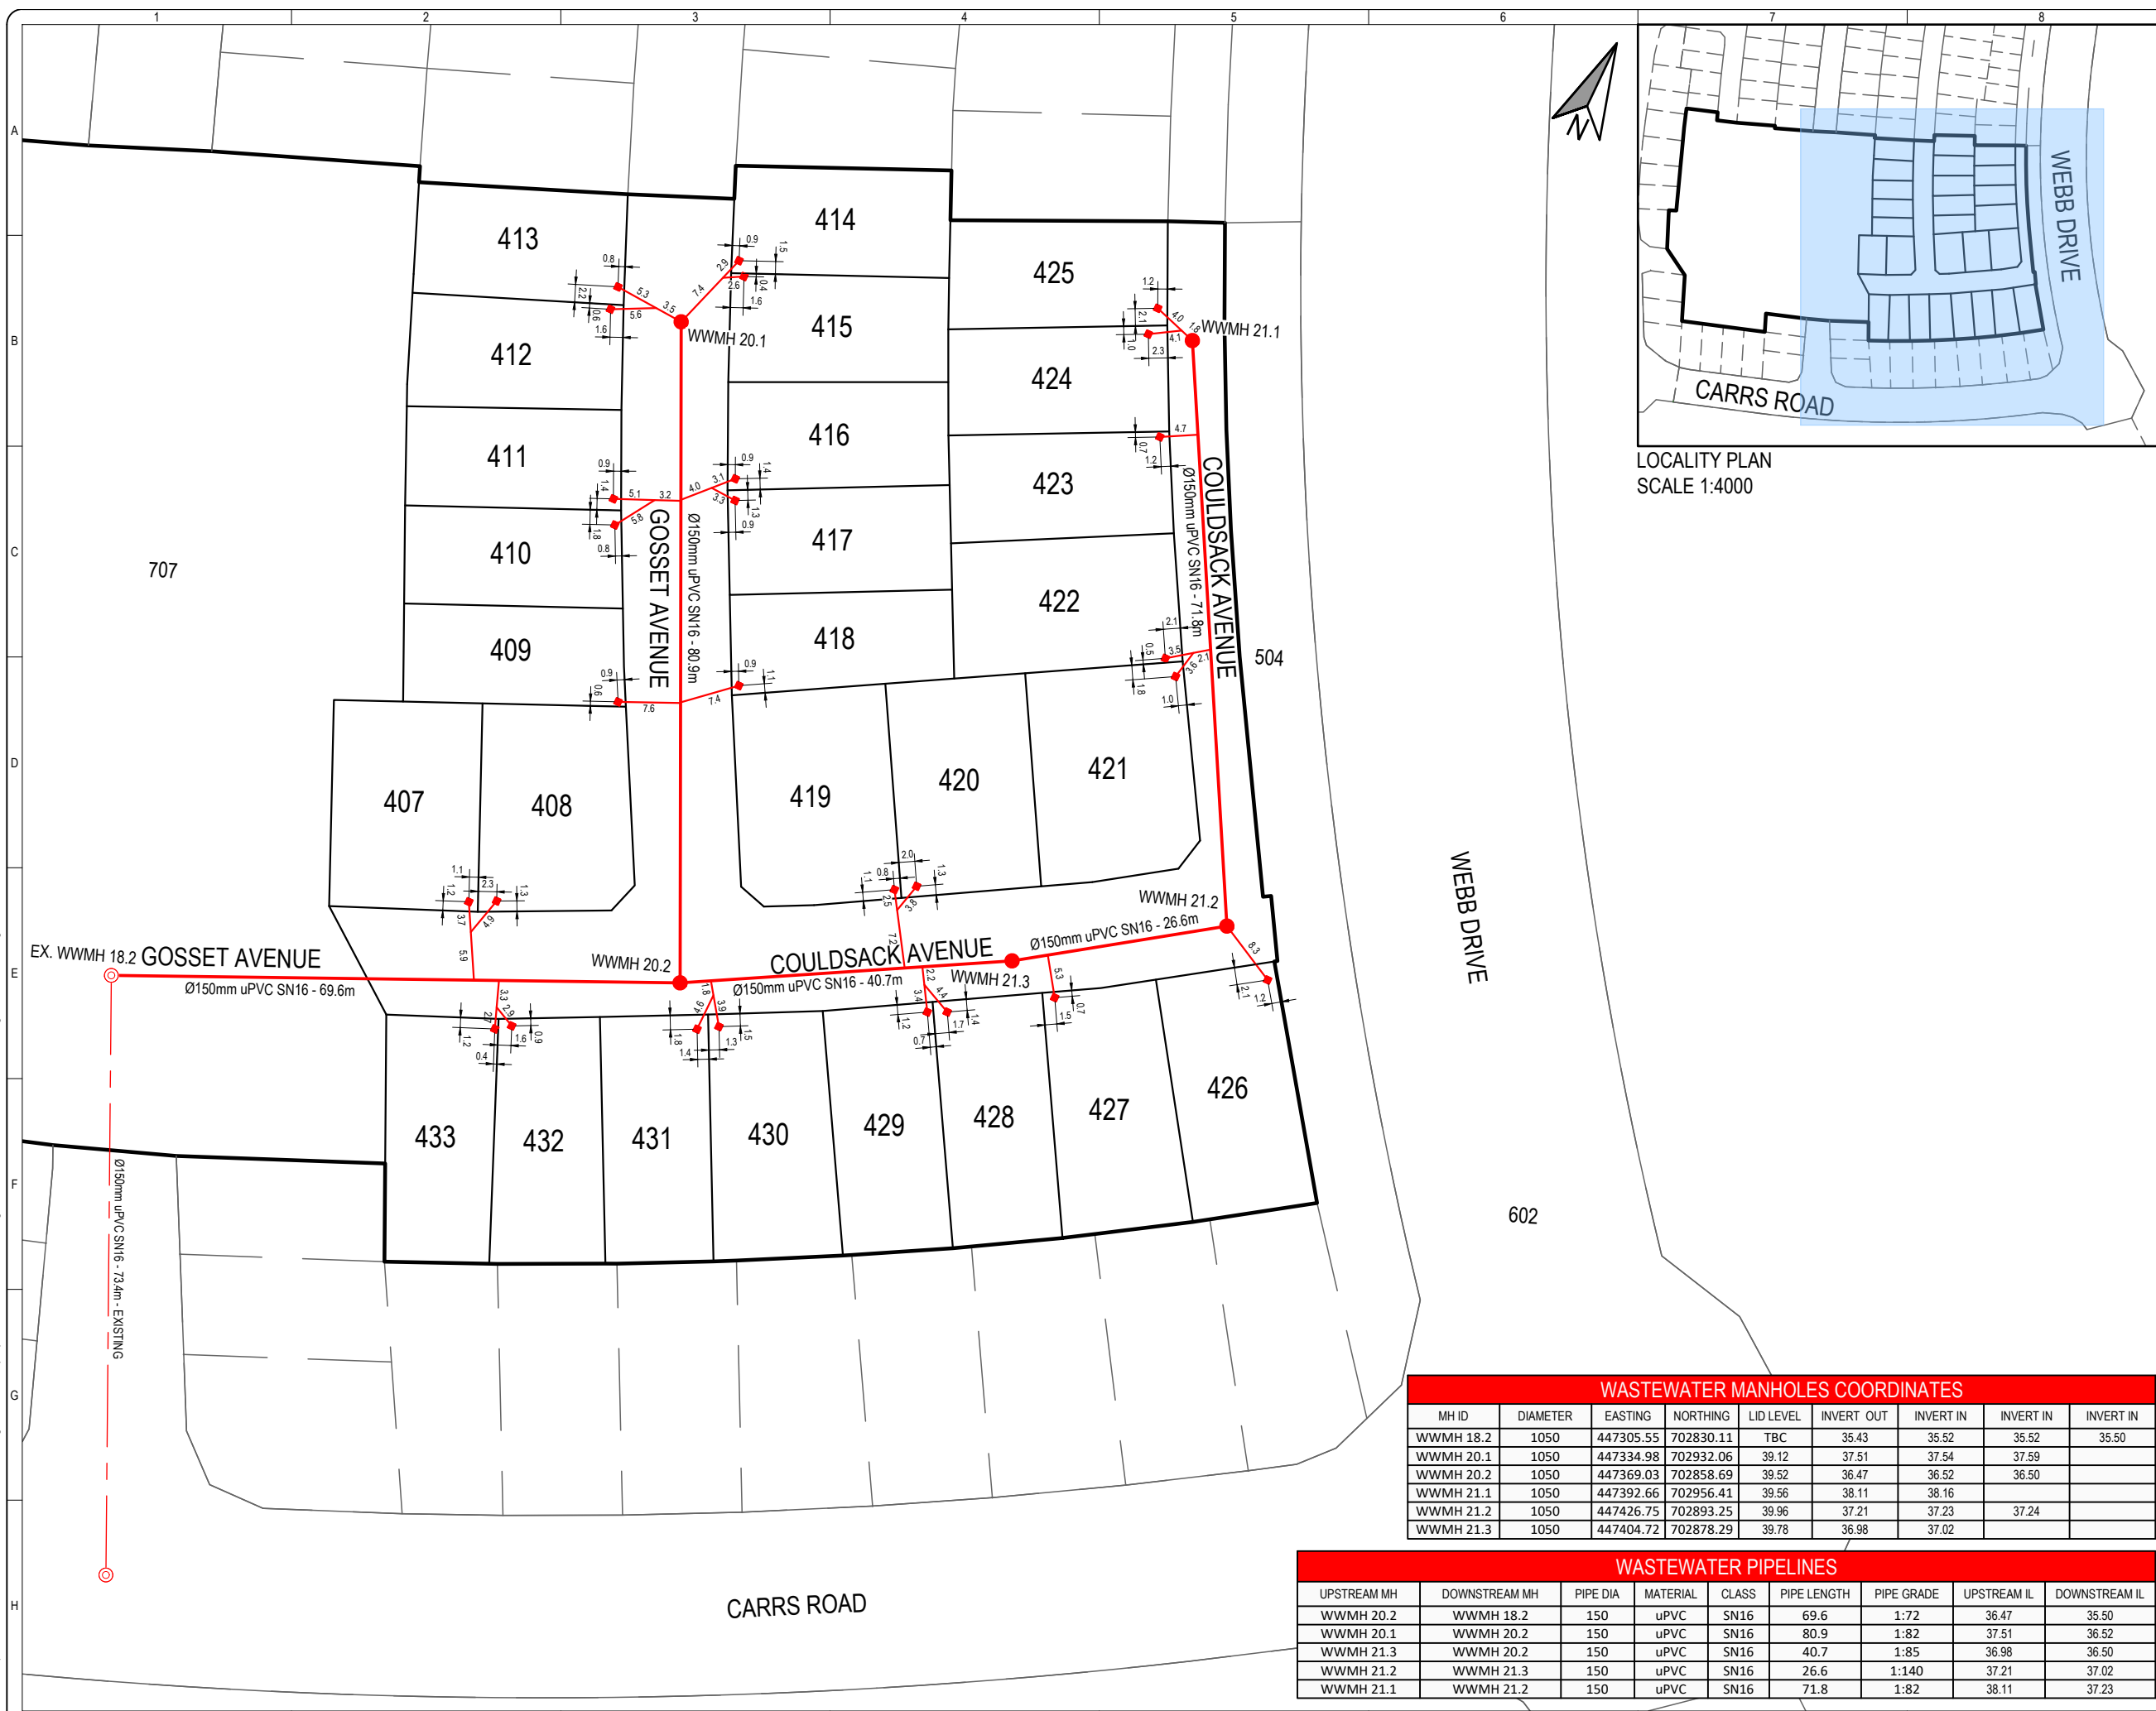

WASTEWATER MANHOLES COORDINATES							
MH ID	DIAMETER	EASTING	NORTHING	LID LEVEL	INVERT OUT	INVERT IN	INVERT IN
WWMH 18.2	1050	447305.55	702830.11	TBC	35.43	35.52	35.52
WWMH 20.1	1050	447334.98	702932.06	39.12	37.51	37.54	37.59
WWMH 20.2	1050	447369.03	702858.69	39.52	36.47	36.52	36.50
WWMH 21.1	1050	447392.66	702956.41	39.56	38.11	38.16	
WWMH 21.2	1050	447426.75	702893.25	39.96	37.21	37.23	37.24
WWMH 21.3	1050	447404.72	702878.29	39.78	36.98	37.02	

WASTEWATER PIPELINES								
UPSTREAM MH	DOWNSTREAM MH	PIPE DIA	MATERIAL	CLASS	PIPE LENGTH	PIPE GRADE	UPSTREAM IL	DOWNSTREAM IL
WWMH 20.2	WWMH 18.2	150	uPVC	SN16	69.6	1:72	36.47	35.50
WWMH 20.1	WWMH 20.2	150	uPVC	SN16	80.9	1:82	37.51	36.52
WWMH 21.3	WWMH 20.2	150	uPVC	SN16	40.7	1:85	36.98	36.50
WWMH 21.2	WWMH 21.3	150	uPVC	SN16	26.6	1:140	37.21	37.02
WWMH 21.1	WWMH 21.2	150	uPVC	SN16	71.8	1:82	38.11	37.23

C:\Users\iparkinson\Downloads\21879-M-15 - CADM - Stage 15 As-Built\21879-M-15 - CADM - Stage 15 As-Built\21879-M-15 - CADM - Stage 15 As-Built.dwg - Plothead: 15/04/2021

APPENDIX 10

Asset Spreadsheets – Hard copy

- Water asset sheets
- Wastewater asset sheets
- Stormwater asset sheets



As Built Datasheet (to accompany As Built Plans) **Waikato Regional ITS**

STORMWATER MANHOLES

Form Version 1 - July 2017

Developer/Contractor: Chedworth Properties Ltd / Online Contractors Prepared by: S & L
 Development/Subdivision/Job: Greenhill Park Date: Apr-21
 Stage: Stage 15
 (North Rim) (Centre) (Centre)

Plan ID	Manhole ID	Property ID (Lot No. or Address)	Street Name	Street Type	Lid Level (m)	Invert Level (m)	MH Width/Diam (mm)	Easting Coordinate	Northing Coordinate	Service Status	Install Date	Asset Value	Comments
21879-M-15-SW1	SWM24142	LOT 410	GOSSET	AVENUE	39.23	37.31	1050	447344.68	702905.13	E	Aug-20	N/A	EXISTING MH FROM STAGE 12 (S&L Ref SWMH 17.1)
21879-M-15-SW1	SWMH 19.1	LOT 707	N/A	NA/	TBC	37.26	1200	447305.16	702835.08	E	Dec-20	N/A	EXISTING MH FROM STAGE 13 (S&L Ref SWMH 19.1) LID LEVEL TO BE PROVIDED IN STAGE 14 AREA M
21879-M-15-SW1	SWMH 21.1	LOT 427	COULDSACK	AVENUE	39.94	38.24	1050	447413.40	702886.29	N	Dec-20	\$4,301	
21879-M-15-SW1	SWMH 21.2	LOT 430	COULDSACK	AVENUE	39.57	37.90	1050	447376.61	702865.14	N	Dec-20	\$4,301	

As Built Datasheet (to accompany As Built Plans) **Waikato Regional ITS**
Form Version 1 - July 2017

Developer/Contractor: Chedworth Properties Ltd / Online Contractors **Prepared by:** S & L
Development/Subdivision/Job: Greenhill Park **Date:** Apr-21
Stage: Stage 15

Plan ID	Upstr MH/ Asset ID	Dwnstr MH/ Asset ID	Street Name	Street Type	Physical Location (where necessary)	Pipe Diameter (mm)	Pipe Length (m)	Pipe Material	Joint Type	Invert Level Upstr (m)	Invert Level Dwnstr (m)	Service Status	Install Date	Asset Value	Comments
21879-M-15-SW1	SWMH 21.2	SWMH 19.1	GOSSET	AVENUE	ROADWAY	375	77.5	RC	RR	37.90	37.28	N	Dec-20	\$24,953	
21879-M-15-SW1	SWMH 21.1	SWMH 21.2	COULDSACK	AVENUE	ROADWAY	375	42.4	RC	RR	38.24	37.91	N	Dec-20	\$13,652	
21879-M-15-SW1	SWM24142	SWM24143	GOSSET	AVENUE	ROADWAY	375	57.6	RC	RR	37.31	37.01	E	Aug-20	N/A	

As Built Datasheet (to accompany As Built Plans) **Waikato Regional ITS**
STORMWATER CONNECTION/SERVICE LINE **Form Version 1 - July 2017**

Developer/Contractor: Chedworth Properties Ltd / Online Contractors
 Development/Subdivision/Job: Greenhill Park
 Stage: Stage 15

Prepared by: S & L
 Date: Apr-21

Plan ID	Upstr MH/ Asset ID	Dwnstr MH/ Asset ID	Property ID (Lot No. or Address)	Street Name	Street Type	Physical Location (where necessary)	Service Pipe Diam (mm)	Service Pipe Length (m)	Service Pipe Material	Invert Level At Private End (m) OR Depth (m)	Easting Coordinate	Northing Coordinate	Distance from left (LB) or right (RB) boundary (m)	Distance from front (FB) or back (BB) boundary (m)	Service Status	Install Date	Asset Value	Comments
21879-M-15-SW1	SWMH21.2	SWMH 19.1	LOT 407	GOSSET	AVENUE	BERM	100/150	7.3	uPVC SN16	1.2	447327.40	702851.28	2.1LB	1.6FB	N	Dec-20	\$664	PIPE SIZE: 4.7m = 100mm; 2.6m = 150mm
21879-M-15-SW1	SWMH21.2	SWMH 19.1	LOT 408	GOSSET	AVENUE	BERM	100	6.6	uPVC SN16	1.2	447352.02	702861.93	10.7LB	1.3FB	N	Dec-20	\$590	
21879-M-15-SW1	-	SWM24142	LOT 409	GOSSET	AVENUE	BERM	100/150	10.6	uPVC SN16	1.2	447342.41	702895.58	1.2RB	1.6FB	N	Dec-20	\$919	PIPE SIZE: 5.0m = 100mm; 5.6m = 150mm
21879-M-15-SW1	-	SWM24142	LOT 410	GOSSET	AVENUE	BERM	100	3.4	uPVC SN16	1.2	447341.55	702897.53	1.0LB	1.5FB	N	Dec-20	\$372	
21879-M-15-SW1	SWM24142	SWM24143	LOT 411	GOSSET	AVENUE	BERM	100/150	8.8	uPVC SN16	1.2	447333.73	702914.57	4.6RB	1.2FB	N	Dec-20	\$747	PIPE SIZE: 8.1m = 100mm; 0.7m = 150mm
21879-M-15-SW1	SWM24142	SWM24143	LOT 412	GOSSET	AVENUE	BERM	100	6.1	uPVC SN16	1.2	447331.15	702919.57	1.1LB	1.5FB	N	Dec-20	\$556	
21879-M-15-SW1	SWM24142	SWM24143	LOT 413	GOSSET	AVENUE	BERM	100	4.4	uPVC SN16	1.2	447321.64	702941.71	1.3RB	1.4FB	N	Dec-20	\$440	
21879-M-15-SW1	SWM24142	SWM24143	LOT 414	GOSSET	AVENUE	BERM	100	4.6	uPVC SN16	1.2	447335.02	702950.16	2.7LB	1.1FB	N	Dec-20	\$454	
21879-M-15-SW1	SWM24142	SWM24143	LOT 415	GOSSET	AVENUE	BERM	100	7.1	uPVC SN16	1.2	447344.46	702929.16	0.7RB	1.6FB	N	Dec-20	\$624	
21879-M-15-SW1	SWM24142	SWM24143	LOT 416	GOSSET	AVENUE	BERM	100/150	11.5	uPVC SN16	1.2	447345.70	702923.35	5.0LB	0.3FB	N	Dec-20	\$958	PIPE SIZE: 8.2m = 100mm; 3.3m = 150mm
21879-M-15-SW1	-	SWM24143	LOT 417	GOSSET	AVENUE	BERM	100	4.2	uPVC SN16	1.2	447355.25	702906.17	1.4RB	1.5FB	N	Dec-20	\$426	
21879-M-15-SW1	-	SWM24143	LOT 418	GOSSET	AVENUE	BERM	100/150	10.9	uPVC SN16	1.2	447355.49	702903.74	0.9LB	0.7FB	N	Dec-20	\$953	PIPE SIZE: 4.0m = 100mm; 6.9m = 150mm
21879-M-15-SW1	-	SWMH 21.2	LOT 419	COULDSACK	AVENUE	BERM	100	8.8	uPVC SN16	1.2	447375.61	702873.91	14.6RB	1.6FB	N	Dec-20	\$740	
21879-M-15-SW1	SWMH 21.1	SWMH 21.2	LOT 420	COULDSACK	AVENUE	BERM	100/150	7.4	uPVC SN16	1.2	447402.01	702888.29	1.7RB	1.2FB	N	Dec-20	\$681	PIPE SIZE: 3.8m = 100mm; 3.6m = 150mm
21879-M-15-SW1	SWMH 21.1	SWMH 21.2	LOT 421	COULDSACK	AVENUE	BERM	100	4.3	uPVC SN16	1.2	447405.24	702889.13	1.5LB	0.4FB	N	Dec-20	\$433	
21879-M-15-SW1	SWMH SP 4.2	SWM25005	LOT 422	COULDSACK	AVENUE	BERM	100	4.9	uPVC SN16	1.2	447399.78	702931.57	1.9RB	1.9FB	N	Dec-20	\$474	
21879-M-15-SW1	SWMH SP 4.2	SWM25005	LOT 423	COULDSACK	AVENUE	BERM	100/150	13.8	uPVC SN16	1.2	447399.10	702934.19	0.8LB	1.2FB	N	Dec-20	\$1,183	PIPE SIZE: 3.7m = 100mm; 10.1m = 150mm
21879-M-15-SW1	SWM25005	SWM25006	LOT 424	COULDSACK	AVENUE	BERM	100	13.4	uPVC SN16	1.2	447393.17	702945.59	1.1LB	1.3FB	N	Dec-20	\$1,054	
21879-M-15-SW1	SWM25005	SWM25006	LOT 425	COULDSACK	AVENUE	BERM	100	4.8	uPVC SN16	1.2	447383.99	702966.52	1.8RB	0.6FB	N	Dec-20	\$467	
21879-M-15-SW1	-	SWMH 21.1	LOT 426	COULDSACK	AVENUE	BERM	100/150	10.2	uPVC SN16	1.2	447423.37	702883.83	1.5RB	0.8FB	N	Dec-20	\$901	PIPE SIZE: 3.7m = 100mm; 6.5m = 150mm
21879-M-15-SW1	-	SWMH 21.1	LOT 427	COULDSACK	AVENUE	BERM	100	3.4	uPVC SN16	1.2	447421.80	702881.95	0.8LB	1.5FB	N	Dec-20	\$372	
21879-M-15-SW1	SWMH 21.1	SWMH 21.2	LOT 428	COULDSACK	AVENUE	BERM	100	7.8	uPVC SN16	1.2	447408.89	702874.74	1.5LB	0.9FB	N	Dec-20	\$672	
21879-M-15-SW1	SWMH 21.1	SWMH 21.2	LOT 429	COULDSACK	AVENUE	BERM	100/150	8.2	uPVC SN16	1.2	447388.20	702862.29	1.3RB	1.5FB	N	Dec-20	\$736	PIPE SIZE: 4.5m = 100mm; 3.7m = 150mm
21879-M-15-SW1	SWMH 21.1	SWMH 21.2	LOT 430	COULDSACK	AVENUE	BERM	100	5.2	uPVC SN16	1.2	447385.03	702861.09	2.0LB	1.1FB	N	Dec-20	\$495	
21879-M-15-SW1	SWMH 21.2	SWMH 19.1	LOT 431	GOSSET	AVENUE	BERM	100	5.5	uPVC SN16	1.2	447364.42	702850.67	2.2RB	1.2FB	N	Dec-20	\$515	
21879-M-15-SW1	SWMH 21.2	SWMH 19.1	LOT 432	GOSSET	AVENUE	BERM	100/150	9.8	uPVC SN16	1.2	447361.53	702848.27	1.4LB	2.1FB	N	Dec-20	\$860	PIPE SIZE: 4.7m = 100mm; 5.1m = 150mm
21879-M-15-SW1	SWMH 21.2	SWMH 19.1	LOT 433	GOSSET	AVENUE	BERM	100/150	10.5	uPVC SN16	1.2	447340.61	702839.62	2.2RB	1.3FB	N	Dec-20	\$916	PIPE SIZE: 4.6m = 100mm; 5.9m = 150mm

As Built Datasheet (to accompany As Built Plans) **Waikato Regional ITS**

STORMWATER CATCHPITS

Form Version 1 - July 2017

Developer/Contractor: Chedworth Properties Ltd / Online Contractors Prepared by: S & L
 Development/Subdivision/Job: Greenhill Park Date: Apr-21
 Stage: Stage 15

Plan ID	Catchpit ID	Property ID (Lot No. or Address)	Street Name	Street Type	Catchpit Type	Grate Level (m)	Easting Coordinate	Northing Coordinate	Service Status	Install Date	Asset Value	Comments
21879-M-15-SW1	CP SP 22	LOT 423	COULDSACK	AVENUE	SINGLE SUMP	39.59	447403.03	702942.99	N	Dec-20	\$2,071	
21879-M-15-SW1	CP 101	LOT 410	GOSSET	AVENUE	SINGLE SUMP	39.16	447343.46	702903.68	N	Dec-20	\$2,071	
21879-M-15-SW1	CP 109	LOT 430	COULDSACK	AVENUE	SINGLE SUMP	39.46	447378.87	702862.41	N	Dec-20	\$2,071	

As Built Datasheet (to accompany As Built Plans)														Waikato Regional ITS
STORMWATER CATCHPIT LEADS														Form Version 1 - July 2017
Developer/Contractor:		Chedworth Properties Ltd / Online Contractors					Prepared by:		S & L					
Development/Subdivision/Job:		Greenhill Park					Date:		Apr-21					
Stage:		Stage 15												
Plan ID	Catchpit ID	Dwnstr MH/ Asset ID	Property ID (Lot No. or Address)	Street Name	Street Type	Physical Location (where necessary)	Catchpit Lead Pipe Diam (mm)	Catchpit Lead Pipe Length (m)	Catchpit Lead Pipe Material	Invert Level at Dwnstrm end	Service Status	Install Date	Asset Value	Comments
21879-M-15-SW1	CP SP 22	SWM25005	LOT 423	COULDSACK	AVENUE	ROADWAY	225	5.9	uPVC SN16	38.47	N	Dec-20	\$1,372	
21879-M-15-SW1	CP 101	SWM24142	LOT 410	GOSSET	AVENUE	ROADWAY	225	1.9	uPVC SN17	37.82	N	Dec-20	\$442	
21879-M-15-SW1	CP 109	SWMH 21.2	LOT 430	COULDSACK	AVENUE	ROADWAY	225	3.5	uPVC SN17	38.23	N	Dec-20	\$814	

As Built Datasheet (to accompany As Built Plans) **Waikato Regional ITS**

STORMWATER SUBSOIL DRAIN

Form Version 1 - July 2017

Developer/Contractor: Chedworth Properties Ltd / Online Contractors
 Development/Subdivision/Job: Greenhill Park
 Stage: Stage 15

Prepared by: S & L
 Date: Apr-21

Plan ID	Dwnstr Asset ID	Street Name	Street Type	Physical Location (where necessary)	Pipe Diameter (mm)	Pipe Length (m)	Pipe Material	Invert Level Upstr (m)	Invert Level Dwnstr (m)	Easting Coordinate Inlet	Northing Coordinate Inlet	Easting Coordinate Outlet	Northing Coordinate Outlet	Service Status	Install Date	Asset Value	Comments
21879-M-15-SW1	CP 101	GOSSET	AVENUE	BERM	100	91.6	NOVA	39.02	38.41					N	Dec-20	\$4,677	
21879-M-15-SW1	CP 102	GOSSET	AVENUE	BERM	100	35.1	NOVA	38.42	38.06					N	Dec-20	\$1,792	EXISTING CATCHPIT
21879-M-15-SW1	CP 103	GOSSET	AVENUE	BERM	100	36.7	NOVA	38.60	37.75					N	Dec-20	\$1,874	EXISTING CATCHPIT
21879-M-15-SW1	CP 109	COULDSACK	AVENUE	BERM	100	125.8	NOVA	39.36	38.71					N	Dec-20	\$6,423	
21879-M-15-SW1	CP SP 22	COULDSACK	AVENUE	BERM	100	112.4	NOVA	39.36	38.84					N	Dec-20	\$5,739	
21879-M-15-SW1	CP SP 23	COULDSACK	AVENUE	BERM	100	27.2	NOVA	38.86	38.43					N	Dec-20	\$1,389	EXISTING CATCHPIT
21879-M-15-SW1	CP SP 24	COULDSACK	AVENUE	BERM	100	27.7	NOVA	39.00	38.12					N	Dec-20	\$1,414	EXISTING CATCHPIT
21879-M-15-SW1	DCP 111	GOSSET	AVENUE	BERM	100	78.7	NOVA	38.92	38.26					N	Dec-20	\$4,018	FUTURE CATCHPIT

As Built Datasheet (to accompany As Built Plans) **Waikato Regional ITS**

WASTEWATER PIPELINES

Form Version 1 - July 2017

Developer/Contractor: Chedworth Properties Ltd / Online Contractors
 Development/Subdivision/Job: Greenhill Park
 Stage: Stage 15

Prepared by: S & L
 Date: Apr-21

Plan ID	Upstr MH/ Asset ID	Dwnstr MH/ Asset ID	Street Name	Street Type	Physical Location (where necessary)	Pipe Diameter (mm)	Pipe Length (m)	Pipe Material	Joint Type	Invert Level Upstr (m)	Invert Level Dwnstr (m)	Service Status	Install Date	Asset Value	Comments
21879-M-15-WW1	WWMH 20.2	WWMH 18.2	GOSSET	AVENUE	ROADWAY	150	69.6	uPVC SN16	RR	36.47	35.50	N	Nov-20	\$9,248	
21879-M-15-WW1	WWMH 20.1	WWMH 20.2	GOSSET	AVENUE	ROADWAY	150	80.9	uPVC SN16	RR	37.51	36.52	N	Nov-20	\$15,331	
21879-M-15-WW1	WWMH 21.3	WWMH 20.2	COULDSACK	AVENUE	ROADWAY	150	40.7	uPVC SN16	RR	36.98	36.50	N	Nov-20	\$10,052	
21879-M-15-WW1	WWMH 21.2	WWMH 21.3	COULDSACK	AVENUE	ROADWAY	150	26.6	uPVC SN16	RR	37.21	37.02	N	Nov-20	\$6,484	
21879-M-15-WW1	WWMH 21.1	WWMH 21.2	COULDSACK	AVENUE	ROADWAY	150	71.8	uPVC SN16	RR	38.11	37.23	N	Nov-20	\$13,897	

As Built Datasheet (to accompany As Built Plans) **Waikato Regional ITS**
Form Version 1 - July 2017

WASTEWATER CONNECTION/SERVICE LINE

Developer/Contractor: Chedworth Properties Ltd / Online Contractors
 Development/Subdivision/Job: Greenhill Park
 Stage: Stage 15

Prepared by: S & L
 Date: Apr-21

Plan ID	Upstr MH/ Asset ID	Dwnstr MH/ Asset ID	Property ID (Lot No. or Address)	Street Name	Street Type	Physical Location (where necessary)	Service Pipe Diam (mm)	Service Pipe Length (m)	Service Pipe Material	Invert Level At Private End (m) OR Depth (m)	Easting Coordinate	Northing Coordinate	Distance from left (LB) or right (RB) boundary (m)	Distance from front (FB) or back (BB) boundary (m)	Service Status	Install Date	Asset Value	Comments
21879-M-15-WW1	WWMH 20.2	WWMH 18.2	LOT 407	GOSSET	AVENUE	BERM	100	9.6	uPVC SN16	1.2	447341.41	702856.75	1.1RB	1.2FB	N	Nov-20	\$648	
21879-M-15-WW1	WWMH 20.2	WWMH 18.2	LOT 408	GOSSET	AVENUE	BERM	100	4.9	uPVC SN16	1.2	447344.46	702858.28	2.3LB	1.3FB	N	Nov-20	\$333	
21879-M-15-WW1	WWMH 20.1	WWMH 20.2	LOT 409	GOSSET	AVENUE	BERM	100	7.6	uPVC SN16	1.2	447347.63	702886.65	0.6LB	0.9FB	N	Nov-20	\$513	
21879-M-15-WW1	WWMH 20.1	WWMH 20.2	LOT 410	GOSSET	AVENUE	BERM	100	5.8	uPVC SN16	1.2	447338.13	702906.10	1.8RB	0.8FB	N	Nov-20	\$392	
21879-M-15-WW1	WWMH 20.1	WWMH 20.2	LOT 411	GOSSET	AVENUE	BERM	100	8.3	uPVC SN16	1.2	447336.62	702908.93	1.4LB	0.9FB	N	Nov-20	\$560	
21879-M-15-WW1	-	WWMH 20.1	LOT 412	GOSSET	AVENUE	BERM	100	5.6	uPVC SN16	1.2	447326.50	702929.81	0.6RB	1.6FB	N	Nov-20	\$378	
21879-M-15-WW1	-	WWMH 20.1	LOT 413	GOSSET	AVENUE	BERM	100	8.8	uPVC SN16	1.2	447326.18	702932.67	2.2LB	0.8FB	N	Nov-20	\$594	
21879-M-15-WW1	-	WWMH 20.1	LOT 414	GOSSET	AVENUE	BERM	100	10.3	uPVC SN16	1.2	447338.25	702941.83	1.5RB	0.9FB	N	Nov-20	\$695	
21879-M-15-WW1	-	WWMH 20.1	LOT 415	GOSSET	AVENUE	BERM	100	2.6	uPVC SN16	1.2	447339.61	702940.33	0.4LB	1.6FB	N	Nov-20	\$176	
21879-M-15-WW1	WWMH 20.1	WWMH 20.2	LOT 416	GOSSET	AVENUE	BERM	100	7.1	uPVC SN16	1.2	447349.10	702917.45	1.4RB	0.9FB	N	Nov-20	\$479	
21879-M-15-WW1	WWMH 20.1	WWMH 20.2	LOT 417	GOSSET	AVENUE	BERM	100	3.3	uPVC SN16	1.2	447350.20	702915.03	1.3LB	0.9FB	N	Nov-20	\$223	
21879-M-15-WW1	WWMH 20.1	WWMH 20.2	LOT 418	GOSSET	AVENUE	BERM	100	7.4	uPVC SN16	1.2	447360.19	702894.69	1.1RB	0.9FB	N	Nov-20	\$500	
21879-M-15-WW1	WWMH 21.3	WWMH 20.2	LOT 419	COULDSACK	AVENUE	BERM	100	9.7	uPVC SN16	1.2	447387.99	702880.10	0.8RB	1.1FB	N	Nov-20	\$655	
21879-M-15-WW1	WWMH 21.3	WWMH 20.2	LOT 420	COULDSACK	AVENUE	BERM	100	3.8	uPVC SN16	1.2	447390.28	702881.63	2.0LB	1.3FB	N	Nov-20	\$257	
21879-M-15-WW1	WWMH 21.1	WWMH 21.2	LOT 421	COULDSACK	AVENUE	BERM	100	3.6	uPVC SN16	1.2	447408.16	702918.27	1.8RB	1.0FB	N	Nov-20	\$243	
21879-M-15-WW1	WWMH 21.1	WWMH 21.2	LOT 422	COULDSACK	AVENUE	BERM	100	5.6	uPVC SN16	1.2	447406.09	702919.76	0.5LB	2.1FB	N	Nov-20	\$378	
21879-M-15-WW1	WWMH 21.1	WWMH 21.2	LOT 423	COULDSACK	AVENUE	BERM	100	4.7	uPVC SN16	1.2	447394.03	702944.03	0.7RB	1.2FB	N	Nov-20	\$317	
21879-M-15-WW1	-	WWMH 21.1	LOT 424	COULDSACK	AVENUE	BERM	100	4.1	uPVC SN16	1.2	447387.45	702954.84	1.0RB	2.3FB	N	Nov-20	\$277	
21879-M-15-WW1	-	WWMH 21.2	LOT 425	COULDSACK	AVENUE	BERM	100	5.8	uPVC SN16	1.2	447387.15	702958.20	2.1LB	1.2FB	N	Nov-20	\$392	
21879-M-15-WW1	-	WWMH 21.2	LOT 426	COULDSACK	AVENUE	BERM	100	8.3	uPVC SN16	1.2	447434.05	702889.37	1.2LB	2.1FB	N	Nov-20	\$560	
21879-M-15-WW1	WWMH 21.2	WWMH 21.3	LOT 427	COULDSACK	AVENUE	BERM	100	5.3	uPVC SN16	1.2	447411.35	702876.40	1.5RB	0.7FB	N	Nov-20	\$358	
21879-M-15-WW1	WWMH 21.3	WWMH 20.2	LOT 428	COULDSACK	AVENUE	BERM	100	4.4	uPVC SN16	1.2	447400.17	702869.25	1.7RB	1.4FB	N	Nov-20	\$297	
21879-M-15-WW1	WWMH 21.3	WWMH 20.2	LOT 429	COULDSACK	AVENUE	BERM	100	5.6	uPVC SN16	1.2	447397.96	702868.22	0.7LB	1.2FB	N	Nov-20	\$378	
21879-M-15-WW1	WWMH 21.3	WWMH 20.2	LOT 430	GOSSET	AVENUE	BERM	100	5.7	uPVC SN16	1.2	447375.60	702855.84	1.3RB	1.5FB	N	Nov-20	\$385	
21879-M-15-WW1	WWMH 21.3	WWMH 20.2	LOT 431	GOSSET	AVENUE	BERM	100	4.6	uPVC SN16	1.2	447373.31	702854.42	1.4LB	1.8FB	N	Nov-20	\$311	
21879-M-15-WW1	WWMH 20.2	WWMH 18.2	LOT 432	GOSSET	AVENUE	BERM	100	2.9	uPVC SN16	1.2	447352.58	702845.21	1.6RB	0.9FB	N	Nov-20	\$196	
21879-M-15-WW1	WWMH 20.2	WWMH 18.2	LOT 433	GOSSET	AVENUE	BERM	100	6.0	uPVC SN16	1.2	447350.86	702844.00	0.4LB	1.2FB	N	Nov-20	\$405	

As Built Datasheet (to accompany As Built Plans) Waikato Regional ITS

WATER HYDRANTS

Form Version 1 - July 2017

Developer/Contractor: Chedworth Properties Ltd / Online Contractors Prepared by: S & L
 Development/Subdivision/Job: Greenhill Park Date: Apr-21
 Stage: Stage 15

Plan ID	Hydrant ID	Pipe ID	Property ID (Lot No. or Address)	Street Name	Street Type	Hydrant Size (mm)	Physical Location (where necessary)	Easting Coordinate	Northing Coordinate	Service Status	Install Date	Asset Value	Comments
21879-M-15-W1	FH1	RM3	LOT 407	GOSSET	AVENUE	150	FOOTPATH	447339.35	702853.15	N	Feb-21	\$2,557	
21879-M-15-W1	FH2	RM6	LOT 426	COULDSACK	AVENUE	150	BERM	447428.83	702889.66	N	Feb-21	\$2,557	

As Built Datasheet (to accompany As Built Plans)**Waikato Regional ITS****WATER PIPELINES**

Form Version 1 - July 2017

Developer/Contractor: Chedworth Properties Ltd / Online ContractorsPrepared by: S & LDevelopment/Subdivision/Job: Greenhill ParkDate: Apr-21Stage: Stage 15

Plan ID	Pipe ID	Pipe Diameter (mm)	Pipe Length (m)	Laying Depth (m)	Pipe Material	Joint Type	Service Status	Install Date	Asset Value	Comments
21879-M-15-W1	RM1	150	7.1	1.2	PVC-M PN12	RRJ	N	Jan-21	\$362	
21879-M-15-W1	RM2	150	39.0	1.2	PVC-M PN12	RRJ	N	Jan-21	\$1,989	
21879-M-15-W1	RM3	150	5.7	1.2	PVC-M PN12	RRJ	N	Jan-21	\$291	
21879-M-15-W1	RM4	150	10.2	1.2	PVC-M PN12	RRJ	N	Jan-21	\$520	
21879-M-15-W1	RM5	150	14.3	1.2	PVC-M PN12	RRJ	N	Jan-21	\$729	
21879-M-15-W1	RM6	150	103.3	1.2	PVC-M PN12	RRJ	N	Jan-21	\$5,268	
21879-M-15-W1	RM7	63	10.9	1.2	PE80 SDR11 PN12.5	RRJ	N	Jan-21	\$240	
21879-M-15-W1	RM8	63	65.4	1.2	PE80 SDR11 PN12.5	RRJ	N	Jan-21	\$1,439	
21879-M-15-W1	RM9	63	12.8	1.2	PE80 SDR11 PN12.5	RRJ	N	Jan-21	\$282	
21879-M-15-W1	RM10	63	60.8	1.2	PE80 SDR11 PN12.5	RRJ	N	Jan-21	\$1,338	
21879-M-15-W1	RM11	63	13.2	1.2	PE80 SDR11 PN12.5	RRJ	N	Jan-21	\$290	
21879-M-15-W1	RM12	63	78.9	1.2	PE80 SDR11 PN12.5	RRJ	N	Jan-21	\$1,736	

As Built Datasheet (to accompany As Built Plans) **Waikato Regional ITS**
WATER CONNECTION/SERVICE LINE Form Version 1 - July 2017

Developer/Contractor: Chedworth Properties Ltd / Online Contractors
 Development/Subdivision/Job: Greenhill Park
 Stage: Stage 15

Prepared by: S & L
 Date: Apr-21

Plan ID	Pipe ID	Property ID (Lot No. or Address)	Street Name	Street Type	Physical Location (where necessary)	Service Pipe Diam (mm)	Service Pipe Length (m)	Service Pipe Material	Easting Coordinate	Northing Coordinate	Distance from left (LB) or right (RB) boundary (m)	Meter Installed (Y/N)	Service Status	Install Date	Asset Value	Comments
		LOT 407														TO BE PROVIDED WITH STAGE 14 ASBUILTS
21879-M-15-W1	RM1	LOT 408	GOSSET	AVENUE	BERM	25	0.5	MDPE	447349.87	702885.40	1.5RB	N	N	Mar-21	\$705	
21879-M-15-W1	RM1	LOT 409	GOSSET	AVENUE	BERM	25	0.6	MDPE	447344.41	702896.28	1.3RB	N	N	Mar-21	\$705	
21879-M-15-W1	RM1	LOT 410	GOSSET	AVENUE	BERM	25	0.7	MDPE	447339.00	702907.56	0.8RB	N	N	Mar-21	\$705	
21879-M-15-W1	RM1	LOT 411	GOSSET	AVENUE	BERM	25	0.7	MDPE	447333.73	702918.72	0.8RB	N	N	Mar-21	\$705	
21879-M-15-W1	RM1	LOT 412	GOSSET	AVENUE	BERM	25	2.6	MDPE	447329.62	702928.06	3.4RB	N	N	Mar-21	\$705	
21879-M-15-W1	EX RM6	LOT 413	GOSSET	AVENUE	BERM	25	0.7	MDPE	447323.71	702942.02	1.8RB	N	N	Mar-21	\$705	PIPE ID IS FROM STAGE 12 ASBUILTS
21879-M-15-W1	EX RM7	LOT 414	GOSSET	AVENUE	BERM	25	0.7	MDPE	447332.86	702950.82	1.2LB	N	N	Mar-21	\$705	PIPE ID IS FROM STAGE 12 ASBUILTS
21879-M-15-W1	RM7	LOT 415	GOSSET	AVENUE	BERM	25	0.9	MDPE	447338.08	702938.67	1.3LB	N	N	Mar-21	\$705	
21879-M-15-W1	RM8	LOT 416	GOSSET	AVENUE	BERM	25	0.9	MDPE	447343.07	702927.24	0.4LB	N	N	Mar-21	\$705	
21879-M-15-W1	RM8	LOT 417	GOSSET	AVENUE	BERM	25	0.6	MDPE	447349.10	702914.29	1.4LB	N	N	Mar-21	\$705	
21879-M-15-W1	RM8	LOT 418	GOSSET	AVENUE	BERM	25	0.6	MDPE	447354.61	702903.03	1.2LB	N	N	Mar-21	\$705	
21879-M-15-W1	RM10	LOT 419	COULDSACK	AVENUE	BERM	25	0.6	MDPE	447376.84	702872.43	14.2RB	N	N	Mar-21	\$705	
21879-M-15-W1	RM10	LOT 420	COULDSACK	AVENUE	BERM	25	0.6	MDPE	447390.92	702880.11	1.8LB	N	N	Mar-21	\$705	
21879-M-15-W1	RM12	LOT 421	COULDSACK	AVENUE	BERM	25	0.7	MDPE	447418.43	702904.11	5.8LB	N	N	Mar-21	\$705	
21879-M-15-W1	RM12	LOT 422	COULDSACK	AVENUE	BERM	25	0.4	MDPE	447401.52	702933.16	1.3RB	N	N	Mar-21	\$705	
21879-M-15-W1	RM12	LOT 423	COULDSACK	AVENUE	BERM	25	0.4	MDPE	447395.58	702944.60	0.8RB	N	N	Mar-21	\$705	
21879-M-15-W1	RM12	LOT 424	COULDSACK	AVENUE	BERM	25	0.5	MDPE	447389.75	702956.62	0.4RB	N	N	Mar-21	\$705	
21879-M-15-W1	RM12	LOT 425	COULDSACK	AVENUE	BERM	25	0.6	MDPE	447385.18	702966.33	2.4RB	N	N	Mar-21	\$705	
21879-M-15-W1	RM6	LOT 426	COULDSACK	AVENUE	BERM	25	0.3	MDPE	447431.83	702890.92	2.1LB	N	N	Mar-21	\$705	
21879-M-15-W1	RM6	LOT 427	COULDSACK	AVENUE	BERM	25	1.3	MDPE	447411.25	702877.79	2.1RB	N	N	Mar-21	\$705	
21879-M-15-W1	RM6	LOT 428	COULDSACK	AVENUE	BERM	25	0.9	MDPE	447398.96	702870.61	1.3RB	N	N	Mar-21	\$705	
21879-M-15-W1	RM6	LOT 429	COULDSACK	AVENUE	BERM	25	1.8	MDPE	447389.07	702865.33	3.6RB	N	N	Mar-21	\$705	
21879-M-15-W1	RM6	LOT 430	COULDSACK	AVENUE	BERM	25	0.9	MDPE	447375.37	702857.86	2.0RB	N	N	Mar-21	\$705	
21879-M-15-W1	RM6	LOT 431	GOSSET	AVENUE	BERM	25	0.7	MDPE	447363.36	702851.93	1.8RB	N	N	Mar-21	\$705	
21879-M-15-W1	RM6	LOT 432	GOSSET	AVENUE	BERM	25	0.7	MDPE	447352.62	702846.74	2.3RB	N	N	Mar-21	\$705	
21879-M-15-W1	RM6	LOT 433	GOSSET	AVENUE	BERM	25	0.8	MDPE	447339.08	702840.85	1.3RB	N	N	Mar-21	\$705	

As Built Datasheet (to accompany As Built Plans) **Waikato Regional ITS**

WATER VALVES

Form Version 1 - July 2017

Developer/Contractor: Chedworth Properties Ltd / Online Contractors
 Development/Subdivision/Job: Greenhill Park
 Stage: Stage 15

Prepared by: S & L
 Date: Apr-21

Plan ID	Valve ID	Pipe ID	Property ID (Lot No. or Address)	Street Name	Street Type	Valve Size (mm)	Valve Manufacturer	Easting Coordinate	Northing Coordinate	Service Status	Install Date	Asset Value	Comments
21879-M-15-W1	SV1	RM1	LOT 408	GOSSET	AVENUE	150	HAWLE	447354.83	702877.43	N	Jan-21	\$2,200	
21879-M-15-W1	SV2	RM2	LOT 407	GOSSET	AVENUE	150	HAWLE	447340.42	702853.54	N	Jan-21	\$2,200	
21879-M-15-W1	SV3	RM4	LOT 407	GOSSET	AVENUE	150	HAWLE	447336.45	702851.98	N	Jan-21	\$2,200	
21879-M-15-W1	SV4	RM3	LOT 407	GOSSET	AVENUE	150	HAWLE	447338.01	702851.16	N	Jan-21	\$2,200	
21879-M-15-W1	SV5	RM5	LOT 433	GOSSET	AVENUE	150	HAWLE	447342.33	702843.14	N	Jan-21	\$2,200	
21879-M-15-W1	PV1	RM7	LOT 415	GOSSET	AVENUE	63	HAWLE	447337.51	702937.56	N	Jan-21	\$930	
21879-M-15-W1	PV2	RM8	LOT 419	GOSSET	AVENUE	63	HAWLE	447366.52	702879.03	N	Jan-21	\$930	
21879-M-15-W1	PV3	RM9	LOT 419	GOSSET	AVENUE	63	HAWLE	447367.22	702877.56	N	Jan-21	\$930	
21879-M-15-W1	PV4	RM10	LOT 421	COULDSACK	AVENUE	63	HAWLE	447417.77	702895.71	N	Jan-21	\$930	
21879-M-15-W1	PV5	RM12	LOT 421	COULDSACK	AVENUE	63	HAWLE	447419.22	702896.99	N	Jan-21	\$930	
21879-M-15-W1	PV6	RM12	LOT 425	COULDSACK	AVENUE	63	HAWLE	447385.24	702967.04	N	Jan-21	\$930	