

S&L
Land Development
and Design Specialists

GREENHILL PARK RESIDENTIAL SUBDIVISION

STAGE 13

INFRASTRUCTURE DEVELOPMENT COMPLETION REPORT

WEBB DRIVE & CARRS ROAD, GREENHILL PARK

CHEDWORTH PROPERTIES LTD

Our reference: 19-30378-03



Prepared for Chedworth Properties Limited



This report has been prepared specifically for Chedworth Properties Ltd and supplied to Hamilton City Council for works clearance for Greenhill Park Subdivision and no responsibility is accepted by S&L Consultants Ltd for the use of any part of this report in other contexts without written approval.

This disclaimer shall apply notwithstanding that the report may be made available to other persons for an application for permission or approval to fulfil a legal requirement.

REVISION	Issued for Application	DATE	12 March 2021
-----------------	------------------------	-------------	---------------

Quality Assurance Statement		
Task	Responsibility	Signature/Approval
Written by:	Barry Pearson Engineer	
Reviewed by:	Nic Fu Client Principal	

Our Ref: 19-30378-03

Prepared by: S&L

36 Kereiti Street - Mount Maunganui - Tauranga 3116

Telephone: 07 577 6069 - Fax: 07 577 6065 - E-mail info@sltga.co.nz

The information contained in this document is intended solely for the use of the client identified on the report cover for the purpose for which it has been prepared and no representation is made or is to be implied as being made to any third party. Other than for the exclusive use of our client, no part of this report may be reproduced, stored in a retrieval; system or transmitted in any form or by any means, electronic, mechanical, photocopying or otherwise without the prior written permission of S&L.

© S&L

Table of Contents

1.0	BACKGROUND	1
1.1	Introduction.....	1
1.2	Entities Involved with Development	1
1.3	Observation of Works.....	2
1.4	As-Built Data.....	2
1.5	CCTV.....	2
1.6	Design and Hamilton City Council Development Unit Design Acceptance	2
1.7	Amendments to approved plans.....	3
2.0	EARTHWORKS	3
3.0	ROADING INFRASTRUCTURE	3
3.1	Road Construction.....	3
3.2	Subgrade.....	3
3.3	Subbase	4
3.4	Basecourse.....	4
3.5	Benkelman Beam Results	5
3.6	Road Surfacing.....	6
4.0	WATER INFRASTRUCTURE	7
4.1	Installation.....	7
4.2	Testing and Disinfection	7
5.0	WASTEWATER INFRASTRUCTURE	8
6.0	STORMWATER INFRASTRUCTURE	8
6.1	Installation.....	8
6.2	Secondary flow paths	9
7.0	STREET LIGHTING, STREET MARKING AND SIGNAGE	9
8.0	LANDSCAPING	9
8.1	Hard Landscaping.....	9
8.2	Soft Landscaping.....	10
9.0	NETWORK UTILITIES	10
9.1	Power.....	10
9.2	Gas	10
9.3	Telecommunications.....	10
10.0	FINAL INSPECTION	10

Appendices

Appendix 1	DBCon Report on Subdivision Earthworks & Recommendations for Building Development
Appendix 2	Road Construction Inspection and Quality Assurance Records
2(a)	Subgrade
2(b)	Basecourse
2(c)	RAMM data
Appendix 3	Water Construction and Quality Assurance Records
Appendix 4	Waste Water Construction and Quality Assurance Records
Appendix 5	Stormwater Construction and Quality Assurance Records
Appendix 6	Landscaping Certifications
Appendix 7	Network Utilities Certifications
Appendix 8	Miscellaneous Check Lists and Producer Statements
Appendix 9	As-Built Drawings/Data
Appendix 10	Asset Spreadsheets – PDF copy



1.0 BACKGROUND

1.1 Introduction

This application relates to Greenhill Park Subdivision Stage 13 located along the northern side of Carrs Road, including Carrs Road and Webb Drive.

Works included the following:

- Stage 13 subdivision roading (including Carrs Road and Webb Drive)
- Wastewater reticulation and lot connections
- Stormwater reticulation for roading and lot connections
- Watermain and lot connections
- Associated Streetlights
- Electrical reticulation for subdivision lots and street lighting
- Ultrafast Broadband reticulation
- Gas supply for subdivision development
- Concrete footpath construction
- Landscape planting

On the north side of Carrs Road, Stage 13 development works for 18 residential lots have been carried out under Hamilton City Council Subdivision Resource Consent 011.2018.6632, granted 05 September 2018.

This application is made on behalf of Chedworth Properties Ltd for Works Clearance from Hamilton City Council. Works clearance is sought in order to obtain certification pursuant to Section 224(c) of the Resource Management Act 1991 for Greenhill Park subdivision, Stage 13, LT 558430 A copy of the land transfer plan is included in Appendix 8.

This report addresses the key details associated with the Infrastructure provided.

1.2 Entities Involved with Development

The following companies have been involved with the construction of the Subdivision;

- Developer: Chedworth Properties Ltd
- Consultant Design Engineers: Beca Consultants
- Consultant Engineers and Surveyors: S&L
- Geotech Engineer: DBCon Engineers
- Landscape Design: Boffa Miskell
- Landscape Planting: Native Awa
- Head Contractor: Online Contractors 2016 Ltd (OLC)
- Subcontractors & Suppliers:
 - Civil Materials Supply: Hynds
 - Stormwater and Wastewater: West Construction Ltd (WC)
 - Drainage



Geotechnical Testing	Opus/WSP
Concrete Supply	Bowers Bros Concrete
Concrete kerbs	Waikato Construction
Carparks	Purrfect Paving
Footpaths	Purrfect Paving
Concrete Cutting	Ironman Concrete Cutting
Streetlights	Ibex Lighting
Power Reticulation	WEL Networks – (Subcontractors: Northpower and Bayonne)
Road Materials Supplier	Stevenson Resources, Gleeson Quarry – Huntly
Road Surfacing Contractor	Higgins Contractors
Road Signs	Directionz Ltd
Road Line Marking	Linemark
Gas	First Gas
Telecommunication	Ultrafast Fibre – (Subcontractor: Civtec)

1.3 Observation of Works

S&L undertook regular inspections of the works as the project progressed and reviewed the contractor’s quality assurance measures including test results. The progress of the construction was reviewed formally at weekly site meetings as well as discussions on site with the contractor.

The observation and supervision activities by S&L were undertaken to a level of CM3 (weekly site visits) as described in the IPENZ document “Guidelines on the Briefing and Engagement of Consulting Engineering Services” with additional inspections when required by the nature of the works under construction.

1.4 As-Built Data

A full set of as-built drawings and excel spreadsheets have been appended to this document in Appendix 9 and 10. These include the as built and asset value information required in accordance with the RITS. The as built data has also been included in this application in electronic format and a copy enclosed in final works clearance report for reference.

1.5 CCTV

CCTV inspections have been completed for the wastewater and stormwater lines. The footage has been provided to Hamilton City Council separately.

1.6 Design and Hamilton City Council Development Unit Design Acceptance

The following Approvals have been gained from the HCC Development Unit:

- Greenhill Park Stage 13 was designed by Beca Consultants and approved by HCC Development Unit.

1.7 Amendments to approved plans

Amendments from the approved plans have been made during construction as follows:

Constructed pavements type 'A' and 'Webb Drive Pavement' as per design in Stage 13. No amendments have been made.

2.0 EARTHWORKS

Earthworks have been carried out onsite under the supervision of S&L and DBCon Engineers. DBCon Engineers were engaged as the geotechnical engineer. The DBCon report of stage 13 subdivision earthworks and recommendations for building development is included in Appendix 1, detailing earthworks compliance with HCC RITS and NZ Standards.

3.0 ROADING INFRASTRUCTURE

3.1 Road Construction

Roads have been constructed in general accordance with the pavement shown on the approved engineering plans.

Review of the road construction is as follows:

3.2 Subgrade

The underlying natural soils comprise sandy silts of varying strengths. Significant subgrade improvement works have been carried out as follows:

- Much of the Stage 13 subgrade consists of imported hardfill for the backfill of the stormwater and sanitary sewer underground lines beneath.
- All areas in the road carriageway that have not been backfilled with hard brown rock have been undercut to a minimum depth of 0.5m below subgrade level and replaced with a subgrade improvement layer of compacted hard brown rock.
- Subsoil drains have been laid beneath kerbs discharging into catchpits

Testing of the subgrade improvement layer included proof rolling with no visible weave, stringing by way of GPS survey, and Clegg hammer testing to confirm that a CIV>15 (CBR>15) had been achieved for all roads in Stage 13. Results of the Clegg hammer testing are included in Appendix 2(a).

A GPS survey was undertaken throughout Stage 13 and checked against the design surface. Results are included in Appendices 2(a, b & c), confirming that design pavements depths have generally been achieved to ITS tolerances.

All road subgrades have been tested using clegg hammers, showing that CBR values over 15 have been consistently achieved on all roads. The results from the Subgrade Clegg Hammer testing are summarised below:

Subgrade Clegg Hammer Results Summary

Carrs Road CH 330 - 580	Range CIV 21 - 65 Mean CIV 37	Min Inferred CBR 31*
Webb Drive East Lane CH 590 - 770	Range CIV 21 - 62 Mean CIV 33	Min Inferred CBR 31*
Webb Drive West Lane CH 530 - 780	Range CIV 28 - 65 Mean CIV 44	Min Inferred CBR 55*
Webb Drive West lane CH 790 - 850	Range CIV 28 - 41 Mean CIV 33	Min Inferred CBR 55*

*Note: CBR = 0.07(CIV)² formula applied in accordance with RITS

3.3 Subbase

Subdivision roading comprises of the following subbase types:

Webb Drive (Webb Drive Pavement)	170mm GAP 65 ex Gleeson Quarry Huntly
Carrs Road (Type 'A' Pavement)	200mm GAP 65 ex Gleeson Quarry Huntly

QA Supplied for the subbase included in Appendix 2(b) includes the following:

- Material testing sheets
- Stringing
- Compaction testing of the basecourse with Nuclear Densometer
- Clegg Hammer tests

3.4 Basecourse

Subdivision roading comprises of the following basecourse types:

Webb Drive	180mm M4 AP40 Stevensons Tauhei modified with 2% cement
Carrs Road (Type 'A' Pavement)	150mm NZTA M/4 AP40 Stevensons Tauhei

QA Supplied for the basecourse included in Appendix 2(c) includes the following:

- Material testing sheets
- Stringing
- Compaction testing of the basecourse with Nuclear Densometer
- Clegg Hammer tests
- Benkelman Beam testing

Stringing

Stringing of the basecourse was carried out from kerbs prior to sealing. Results are included in Appendix 2(c) confirming that design pavements depths have generally been achieved to ITS tolerances.

Clegg Hammer

Clegg hammer testing has been undertaken on the subdivision roading basecourse showing compliance with RITS.

Nuclear Densometer

Nuclear densometer testing was carried out by Opus in order to confirm density.

Nuclear Densometer testing has been undertaken in accordance with RITS Section 3.8.2.5 & 3.8.3.4, Table 3-22. Results are included in Appendix 2(c).

The Target MDD for the TNZ M/4 AP40 pavement is 2.18t/m³ as per Opus MDD report (project number: 2-68015.00, lab reference: HA 6290/1_VHMDD).

Results are summarised below:

Basecourse NDM Results Summary

Webb Dr, southbound lane CH 520 - 790	Min 93% of MDD (Target MDD 2.18t/m ³)	Mean 98% of MDD
Webb Dr, northbound lane CH 520 - 790	Min 94% of MDD (Target MDD 2.18t/m ³)	Mean 98% of MDD
Carrs Rd, CH 10 - 260	Min 96% of MDD (Target MDD 2.18t/m ³)	Mean 100% of MDD
Carrs Rd roundabout	Min 96% of MDD (Target MDD 2.18t/m ³)	Mean 100% of MDD

3.5 Benkelman Beam Results

Benkelman beam tests were carried out by Opus on the basecourse surface following surfacing. Results are summarised below:

Basecourse Benkelman Beam Results Summary

	Deflection (mm)			
	Maximum (mm)	Minimum (mm)	%age over 1.8mm (A2)	Average (mm)
Webb Dr southbound lane CH 520 - 800	0.44	0.04	0	0.27
Webb Dr northbound lane CH 520 - 800	0.59	0.16	0	0.33
Carrs Rod CH 10 - 260	0.9	0.44	0	0.65
Carrs Rd roundabout	0.86	0.44	0	0.58
Carrs Rd roundabout stub road right	0,84	0.70	0	0.77

Results conform to the maximum and average deflection requirements of Section 3.8.3.5, Table 3-23 of the RITS for A3 (between 10⁵ and 10⁶ EDA) roads.

3.6 Road Surfacing

A summary of road surfacing details laid by Higgins is listed below:

Road Surfacing Summary

Road	Membrane Seal	Surface
Pavement Type A (Carrs Rd)	Grade four water proofing seal coat Residual Application Rate: 1.0L/m ²	40mm DG10 (Ave thickness 46mm)
Webb Drive Pavement including roundabout	Grade 4 raked in water proofing seal coat Residual rate 2.0 L/ m ²	50mm AC 14

4.0 WATER INFRASTRUCTURE

4.1 Installation

The water supply reticulation completed by Online Contractors includes the following components:

- 150mm mPVC PN12RRJ principal main
- 63mm PE80 PN12.5 ridermain
- Associated fittings, valves and hydrants
- Residential connections to all lots

Quantities and installation locations are shown on as-built records appended to this document.

4.2 Testing and Disinfection

Online Contractors Ltd carried out all aspects of pressure testing of the supply lines and disinfection prior to livening, in accordance with the ITS and in the presence of HCC.

Testing included the following items:

- Water supply pressure test result
- Water Supply disinfection
- Water Supply E Coli test

The pressure test and the observation of FAC (Free Available Chlorine) was witnessed by HCC's testing officer. The E Coli test samples were collected as part of the testing and the samples have been reviewed by HCC Officer, L. Parkes and passed.

Pressure testing results, pipe laying checklists and Bacto Test results are included in Appendix 3.

5.0 WASTEWATER INFRASTRUCTURE

Supporting quality assurance documentation for Wastewater Infrastructure supplied by the contractor and reviewed by S&L is attached in Appendix 4.

The gravity sewerage system comprises installation of the following components:

- 150mm dia uPVC SN16 wastewater main
- 100mm dia uPVC SN16 sewer laterals and lot connections
- Associated manholes.

Testing and inspection includes the following:

- CCTV inspection which has been supplied separately to Council
- Inspection of Manhole Structures
- Pressure testing of Manhole Structures by West Construction observed by HCC
- Pressure testing of 150mm dia wastewater main by West Construction observed by HCC
- As-buiting by West Construction and S&L with final as-builts compiled by S&L.

6.0 STORMWATER INFRASTRUCTURE

6.1 Installation

In accordance with the approved design, stormwater from Stage 13 pipelines discharge into the Area M and L, K & U swales for treatment and conveyance:

- Swale 3B is located on the south side of Popham Rd and flows west.
- Swale 1D is located on the south side of Carrs Road and flows west

The primary system comprises of:

- UPVC & RCRRJ stormwater mains and headwalls
- UPVC laterals and lot connections
- Road catchpits and leads
- Manholes

Observation of the works was undertaken by S&L and includes:

- CCTV inspection which has been supplied separately to Council
- Inspection of all manhole structures, catch pits, outlets and inlets
- As-buiting by Online Contractors and S&L Consultants with final as-builts compiled by S&L.

QA and checklists provided by the contractor and reviewed by S&L are included in Appendix 5.

6.2 Secondary flow paths

In accordance with the approved design, the stormwater pipelines from Stage 13 discharges into swale 3B and 1D for treatment and conveyance.

A piped drainage network has been designed to collect runoff from the road and lots with standard sumps. The pipes are designed to convey (without significant surcharge) the 50% AEP flows to the network of swales downstream. Each individual lot is provided with a piped connection to the main drainage system in case on-lot soakage is not appropriate.

In events larger than a 50% AEP, secondary stormwater flows for Stage 13 will flow as described below.

Flow down the western side of Webb Drive shoulders to a low point at road 20/25 intersection, then south across the road berm to spill into Swale 3B that runs along the southern side of Popham Road and flows west.

The eastern side of Webb Drive flows down the road shoulder to the southern side of Pardo Rd intersection. The overland flow path is over the road berm to the existing open drain and future swale to the east.

The Carrs Road secondary flow path is west down the road shoulder, across the intersection of Carrs Rd/Athier Ave and into swale 1 via the berm overland flow path.

See attached as-built drawing 21879-M-13-SW1 Rev AB in appendix 9 showing the location and direction of stormwater overland flow.

7.0 STREET LIGHTING, STREET MARKING AND SIGNAGE

Streetlights have been designed, supplied and installed by Ibex Lighting Ltd. All quality assurance documentation for the street lights is included in Appendix 7.

Signage has been installed by OLC subcontractor Directionz Ltd in accordance with approved drawings and RITS requirements.

Carriageway paint marking has been completed by OLC subcontractor Linemark Ltd and is in accordance with approved drawings and RITS requirements.

8.0 LANDSCAPING

8.1 Hard Landscaping

There are no hard landscaping works included in stage 13.

8.2 Soft Landscaping

The landscape planting within the road reserves and the stormwater swales has been completed. An inspection by HCC Parks and Open Spaces has been completed.

9.0 NETWORK UTILITIES

Network utilities have been provided as follows.

9.1 Power

Electrical reticulation has been installed by WEL Networks for both street lighting and residential supply.

A WEL Networks works clearance statement is attached in Appendix 7.

9.2 Gas

First Gas has installed reticulation to enable future connection by individual lot owners. A completion Certificate is included in Appendix 7.

9.3 Telecommunications

Ultrafast Fibre has installed reticulation to individual lots. An acceptance letter is included in Appendix 7.

10.0 FINAL INSPECTION

A final inspection has been undertaken and was attended by Hamilton City Council's Development Engineers and associated staff from S&L and Online Contractors.

A separate inspection by Parks and Open Spaces has also been completed.

APPENDIX 1

Earthworks QA Documentation

- DBCon Engineers Report on Subdivision Earthworks & Recommendations for Building Development





GREENHILL PARK RESIDENTIAL SUBDIVISION

**STAGE 13
Area M, Greenhill Park**

HAMILTON

***REPORT ON SUBDIVISION EARTHWORKS
AND RECOMMENDATIONS FOR BUILDING
DEVELOPMENT***

Our Ref: DB 171738-AREA-M-S13-01

Prepared for: Chedworth Properties Limited

Date: February 2021

Location: Stage 13, Greenhill Park, Hamilton Subdivision Completion Report

Job No: DB 171738-AREA-M-S13-01

Contents

1.1	Subdivision Development Earthworks	3
1.2	Introduction	3
1.3	Earthworks in the Subdivision	3
1.4	Earthworks Standards	4
1.5	Filled Ground	4
1.6	Areas of Cut	5
1.7	Test Results In Filling Placed	5
1.8	Test Results In Areas of Cut and Natural Ground	5
1.8.1	Land Stability	6
1.8.2	Flooding	6
1.8.3	Liquefaction	6
1.8.4	Expansive Ground	6
2.0	Disposal of Stormwater	7
3.0	Retaining Walls	8
4.0	Professional Opinion	8
5.0	Applicability	9
	References	10

Appendices

Appendix I	<u>Reference Drawings</u> Subdivision plan 21879-01-M13-EW1 Site Levels Plan
Appendix II	<u>Geotechnical Completion Forms</u> Checklist 2.2 - Statement of Professional Opinion Summary of Geotechnical Data for Individual Lots
Appendix III	<u>Pre-Construction Test Results</u> BECA Area M Liquefaction Assessment Summary Plan
Appendix IV	<u>Post Construction Test Results</u> Tests by DBCE
Appendix V	<u>Stormwater Management</u> On-lot Water Efficiency Measures Lot Levels (Minimum Lot Levels)

1.0 Subdivision Development Earthworks

1.1 Introduction

Stage 13 of Greenhill Park is currently accessed from Pardoia Boulevard. Stage 13 comprises 18 residential lots (numbered 357 to 374). The locations of these lots are shown on attached Cut/Fill Plan, drawing 21879-01-M13-EW1 included in Appendix I.

Bulk earthworks have been completed to re- contour the previously agricultural landscape for Stage 13 of the Greenhill Park Residential Subdivision in Hamilton. Works have been carried out in accordance with Hamilton City Council's (HCC) Subdivision Resource Consent: 011.2018.6632.001 dated: 05/09/2018. Prior to commencement of earthworks, geotechnical investigations were carried out by Beca Ltd (Beca) in 2016 [1].

HCC's Infrastructure Technical Specifications (ITS) set out the minimum standards for design and construction of public infrastructure within Hamilton City. Section 2.1.5 of the *Earthworks and Geotechnical Requirements* of the ITS states that the developer shall appoint a geo-professional to carry out functions as described in NZS 4404[5] Section 2.2.4. ITS Section 2.3.3.1 states that a geotechnical completion report shall be submitted as per NZS 4404 Section 2.6 including a statement of professional opinion on the suitability of land for building construction [4]. The developer has appointed DB Consulting Engineers (DBCE) Ltd as the geo-professional.

To satisfy the requirements of HCC's Resource Consent, the ITS and NZS 4404, this report summarizes the observations and testing undertaken during the development of the stage, discusses the suitability of the ground for the support of the proposed residential buildings and contains recommendations for the disposal of stormwater runoff generated on individual sites.

Included in Appendix I of this report is the proposed subdivision plan comprising the original Lot 605 DP 516275 and the proposed new lots 357-374 for Area M Stage 13. The included earthworks plan shows the cut/fill extent of the earthworks undertaken, test positions, and road and lot locations.

1.2 Earthworks in the Subdivision

The earthworks for Stage 13 of the subdivision development were undertaken between October 2020 and December 2020.

These earthworks comprised:

1. The stripping of surface topsoil to expose underlying natural soils
2. The placement of filling within lots 357, 358, 359, 360, 367, 368,369,370, 371 and 374.
3. Backfilling and raising the ground level with new fill to create uniform fill platforms.
4. The reinstatement of the surface topsoil cover and subsequent grassing.

The soils encountered during the formation of the site and road subgrades were a mixture of silts, sands and pumiceous gravels, typical of Hinuera formation deposits in this area of Hamilton. These soils were those that had been identified in pre-construction site investigations by the Beca Report.

The filling work was undertaken using these site soils gained from areas of cut on other stages from within the larger Greenhill Subdivision. Filling was undertaken during spring 2020 when drying back of the soils was possible close to optimum moisture contents to achieve near maximum compaction densities.

Upon completion of the earthworks, approximately 200 to 300 mm of topsoil was placed across the sites and the finished surfaces were grassed in accordance with Conditions of the Resource Consent. Areas where an initial grass strike did not take place were re-grassed. While the target topsoil depths after the earthworks were to be around 300 mm, no guarantee is implied or given that the topsoil on any part of any lot is 300 mm or less and it is recommended that future owners or designers or builders check topsoil depths when preparing site development plans and cost schedules.

1.3 Earthworks Standards

The earthworks in filling were undertaken using in situ Silty clay, and sandy silts mixtures gained from areas of cut across the larger subdivision and already used for the earlier stages of the development. The standards for the placement of filling, as stated in the earthworks contract documents, were to comply with NZS 4431:1989 "Code of Practice for Earth fill for Residential Development" and the Council ITS. Filling placed to these standards may be considered as good ground in terms of NZS 3604:2011 "Timber Framed Structures."

The compaction of the filling placed was monitored and tested for compaction density using a hand-held shear vane in finer grained silts and Silty CLAY. Adequate strengths would be achieved when an undrained shear strength of 100 kPa or more had been developed in silts and clays. Scala testing was used on non-cohesive sites.

Materials used where the same basic strata as being used for the previous Stages of works, with a high level of consistency based on previous test results.

1.4 Filled Ground

During the placement of filling on the road subgrades and on areas intended for residential development, the contractor, OLC, stripped and removed all topsoil and other surface organic soils. Post construction testing was carried out to confirm the interface between the cut and fill. Filling was placed in discrete layers with compaction applied through sheepsfoot drum rollers and smooth drum rollers.

As most of the filling placed comprised the Silty CLAY and silts identified in the pre subdivision boreholes, testing of the compaction achieved was mostly undertaken

using a handheld shear vane and NDM testing (Nuclear Density Meter).

The results indicate that the construction filling standards have been met. Foundations may therefore be detailed to NZS 3604:2011 where a timber framed subfloor containing shallow piles, bearers and joists is contemplated. Concrete floors designed to NZS3604 can be used on most lots where they are not immediately adjacent to a stormwater swale.

1.5 Areas of Cut

Areas developed in cut are shown on 21879-01-M13-EW1 (Appendix I). In these areas, the ground at formation levels was observed to comprise the same silts and sands that had been used for filling elsewhere and as identified by pre subdivision tests.

1.6 Test Results In Filling Placed

A summary of the tests undertaken by DBCE is present in Appendix IV. The test positions are shown on 21879-01-M13-EW1 and the test results are in Appendix IV.

The shear vane test results show that acceptable soil strengths had been developed in all fill areas tested.

1.7 Test Results in Areas of Cut and Natural Ground

The natural ground at the finished ground surface or under the filling comprised silty sands and sands as had been identified in the pre-subdivision investigation boreholes.

The results of the tests undertaken indicate that “good ground” as defined in NZS3604:2011 is present. No areas that were tested will require any future ground improvement work for buildings supported

1.8 Land Hazards

1.8.1 Land Stability

There are no landform stability issues within Stage 13 of the Greenhill Park Subdivision. The specification from the developer for the site earthworks was that the lots were to be graded as flat as possible with a desirable gradient of 0.5%.

1.8.2 Flooding

The final lot levels have been set based on infrastructure requirements and freeboard from flood levels developed as part of the stormwater design for the larger subdivision. The means of disposal of stormwater runoff from lots in this stage of the subdivision are described in the catchment and overland flow assessments by Beca (interpretive Report Lot Levels Area M). In the report for area M, a 1% AEP flood event is identified for each swale system. The two relevant swales for Stage 13 are Swale 1D (R.L. 38.1% Flood level). A flood level of 38.00 R.L. has been used in assessing the flood risk in stage 13. This equates to minimum lot levels of 38.500m to 40.120m R.L. across the stage (with low being the north end and high being the south end). A list of Lot Levels for Stage 13 is included in Appendix V.

Site grading during house construction must not lower finished levels below the minimum finished ground levels provided without further review of the impacts on flooding. Earthworks must not direct stormwater runoff to adjacent properties, or towards buildings, or create areas of localized ponding. All overland flow is to be towards the road frontage on each section, where falls will direct surface flow towards the north and Swale 1D.

It is the responsibility of the building design professional to ensure that the requirements for mitigation for the hazard of flooding are met by the design prior to submitting to Council for consent. Confirmation of the swale construction and flood levels are excluded from the scope of this report and are to be covered separately with sign-off of infrastructure works.

1.8.3 Liquefaction

The potential for the hazard of liquefaction for Area M of the Greenhill Park Subdivision is discussed in “Greenhill Park Geotechnical Interpretation and Design - Area M” by Beca and dated 13 July 2018. Foundations within 5m of the top of the swales are classed as TC2 like foundations. The liquefaction summary plan is appended to this Completion report. Specifically, the requirements are:

- 0m – 1.5m no habitable dwellings to be built within 1.5 m of the swale crest.
- 1.5 – 5m adopt an enhanced TC2 _like foundation
- Beyond 5m of swale crest no specific requirements to mitigate liquefaction effects.

The Beca report refers to zones adjacent to the swales being in a TC2 type area as is defined in guidelines published by the Ministry of Business, Innovation and Employment (MBIE). MBIE recommends that TC2 type foundations should typically include ‘an enhanced foundation slab’ as is currently being installed for new houses in Christchurch. Alternatively, MBIE advises that houses may be supported on timber piles and a timber framed subfloor as detailed in NZS 3604 to meet a Type A construction as described in their guidelines. For Stage 13 none of the lots are affected by swale so no specific requirements are needed to mitigate liquefaction.

1.8.4 Expansive Soils

The underlying soil conditions are primarily non-expansive sand strata and shallow slightly expansive silt layers. Zones of fill are encountered across the sites, with deeper fill located in lots 369-371 (backfilling of old drainage ditches). The backfill is typically silty sand and not considered expansive. Overall, Stage 13 is underlain by non or slightly expansive soils. Any soils with a higher expansivity are expected to be limited in extent, and unlikely to result in changing the soil class.

For the purpose of foundation recommendations, Lots 369-371 can be treated as M Class sites. This is indicative of the greater depth of fill under these sites and therefore greater variability in the ground conditions. This is not to say the strata is moderately expansive, but that it may perform with comparable movement.

2.0 Disposal of Stormwater

Greenhill Park has been designed with a swale network to limit peak flows from the subdivision to 80 % of the 1 % AEP pre-development rate, and 90 % of the 10 % and 50 % AEP pre-development rates (Beca Ltd. [2016] Greenhill Park - Stormwater Design, for Chedworth Properties Ltd, 29 June 2016). Area M has been designed to include roadside swales flowing in an approximately east to west direction. Stage 13 includes of swale 1D. The depth of the swales has been designed to accommodate the fall and cover depth required of the piped drainage system. The piped drainage network has been designed to convey the 50 % AEP flows from roads and lots to the swale network, with each lot to be provided with a piped service connection. The stormwater plan is presented in the S&L Drawing 'Stormwater as Built DWGs reported separately.

All lots will require on-site stormwater efficiency measures as per the District Plan requirements (Rule 25.13.4.5 Water Efficiency Measures). These include:

1. Detention of stormwater to 80% of pre-development runoff by an appropriate means. This has largely been achieved by the swale network for events greater than the 50 % AEP storm. For the 50 % AEP and smaller events, the stormwater efficiency measures are expected to provide sufficient additional mitigation to achieve this requirement.
2. Permeable surfaces protected to achieve at least 20% above the minimum standard of the zone (i.e., 40 % site permeability).
 - a. Sites within the Ruakura Medium Density Residential Zone require a minimum permeability of 20 % (Rule 4.6.5) and are limited to 50 % site coverage (Rule 4.6.6).
3. Rainwater tank for non-potable reuse system
4. Other equivalent features

Stormwater management must ensure that the rate of stormwater discharge offsite is at or below pre-development rates. Stormwater management measures shall be implemented, as appropriate, in accordance with the following drainage hierarchy:

1. Retention for reuse
2. Soakage techniques
3. Detention and gradual release to a watercourse
4. Detention and gradual release to stormwater reticulation.

Section 42 of the Subdivision Resource Consent (SRC) relating to Stages 9-15 state that "Each residential lot shall be provided with a means for disposal of stormwater, with no private stormwater pipes or soakage systems crossing from one lot to another except where covered by an easement"

Section 43 of the SRC states that water efficiency measures for the individual residential lots are to be detailed for each subdivision stage. "Where retention for reuse tanks is proposed they shall be a minimum of 5,000L to ensure they are effective or where the lot is less than 300m² should be appropriately designed considering the specific site constraints. The required stormwater efficiency measure is to be implemented at the building consent stage and maintained on an on-going basis at the owners' expense".

Section 44 of the SRC requires a consent notice on each title advising of the required water efficiency measures to be implemented and maintained on an ongoing basis.

Section 55 of the SRC states the requirement for lot development to be undertaken in general accordance with the recommendations in the report: Greenhill Park Geotechnical Interpretation and Design – Area M, prepared by Beca Ltd., 13 July 2018.

In the Stage 13 development area, each site is to be tested for soakage capability by the property owners. For those sites that have a sufficient soakage capability, disposal of stormwater is to be undertaken onsite using soakage and/or bioretention systems with overflow to the lot stormwater service connection. Those sites that are not soakage viable are to retain stormwater for reuse by way of a Slimline Rain Tank or other similar type water tank. The size of the tank is to be 5000 litres and the tank is to be plumbed into the house for use as a non-potable water supply including for garden irrigation and in general accordance with the HCC guidelines for the Implementation of Water Efficiency Measures. The Slimline rain tank system is described in Appendix V. This requirement will be advised to purchasers and will be implemented through the building consent process by HCC. A consent notice is to be registered on the certificates of titles for each lot which describes these investigation and design requirements.

Details of the required stormwater measures are included in Appendix V, sourced from the Greenhill Park Design Guidelines.

3.0 Retaining Walls

There are no retaining walls that were constructed by the developer within stage 13.

4.0 Professional Opinion

It has been demonstrated in this Geotechnical Completion Report, that earthworks have been completed and building platforms have been constructed to comply with Council's ITS specifications and the New Zealand Building Code. Recommendations have been provided within the report for the disposal of stormwater from individual lots, for the ongoing development of the lots and for the mitigation of liquefaction risk where applicable.

In accordance with ITS Section 2.3.3.1, a statement of professional opinion is enclosed in Appendix II of this document. This statement is presented in the form of Checklist 2.2 of Council's Development Manual, Volume 4: Quality Systems for Land Development, and is accompanied by a *Summary of Geotechnical Data for Individual Lots* which summarizes the information and recommendations contained in this report.

5.0 Applicability

Recommendations contained in this document are based on data from observations of site earthworks, boreholes, and test results. Inferences about the nature and continuity of subsoils away from these locations are made but cannot be guaranteed.

In all circumstances, if variations in the subsoils occur which differ from those described or are assumed to exist, the site should be inspected by an engineer suitably qualified to make an informed judgement and provide advice on appropriate improvement measures.

This report has been prepared specifically for Stage 13 as shown for Lots: 357-374 DP543207 of Area M Stage 13 within the Greenhill Park Residential Subdivision. No responsibility is accepted by DB Consulting Engineers Ltd for the use of any part of this report for other development sites without their written approval.

DB Consulting Engineers Ltd

Report prepared by Ranjan Ghiloria

Report reviewed by Michael Richardson
CPEng 1005467 Geotechnical Engineer

February 2021

References

- [1] Ruakura Land Development - LDP Geotechnical Factual Report by Beca, 15 April 2016.
- [2] C. Hughes and K. Read, "Ruakura Development - Stage 1 Geotechnical Investigation – Liquefaction Potential Detailed Assessment," Opus International Consultants, Ltd., Hamilton, New Zealand, 2014.
- [3] M. Hughes and L. Shuler, "Report on Preliminary Geotechnical Investigation, Ruakura Development, Hamilton," S&L Consultants, Ltd., Tauranga, New Zealand, 2015.
- [4] "Section 2 Earthworks and Geotechnical Requirements," in *Infrastructure Technical Specifications*, Hamilton, New Zealand, Hamilton City Council, 2013.
- [5] "NZS 4404 Land Development and Subdivision Infrastructure," in *New Zealand Standards*, Wellington, New Zealand, Standards New Zealand, 2010.
- [6] "Greenhill Park - Geotechnical Interpretation and Design-Area 1" by Beca 28 October 2016.
- [7] "Part 5: Earthquake Actions - New Zealand," in *NZS 1170.5:2004 Structural Design Actions*, Standards New Zealand, 2004.
- [8] "Greenhill Park Design Report - Area I (Stage 5, 6, 7 & 8) by Beca 20 December 2016
- [9] "Clause B1: Structure," in *Acceptable Solutions and Verification Methods For New Zealand Building Code*, Wellington, Ministry of Business, Innovation and Employment, 2014.
- [10] "Part A: Technical Guidance," in *Repairing and rebuilding houses affected by the Canterbury earthquakes*, Wellington, Ministry of Business, Innovation and Employment, 2012.
- [11] "Clause E1: Surface Water," in *Acceptable Solutions and Verification Methods For New Zealand Building Code*, Wellington, Ministry of Business, Innovation and Employment, 2014.
- [12] "Section 4 Stormwater," in *Infrastructure Technical Specifications*, Hamilton, New Zealand, Hamilton City Council, 2015.


Appendix I

Reference Drawings

Subdivision Plan

Cut/Fill Plan 21879-01-

M13-EW1 Site Levels Plan

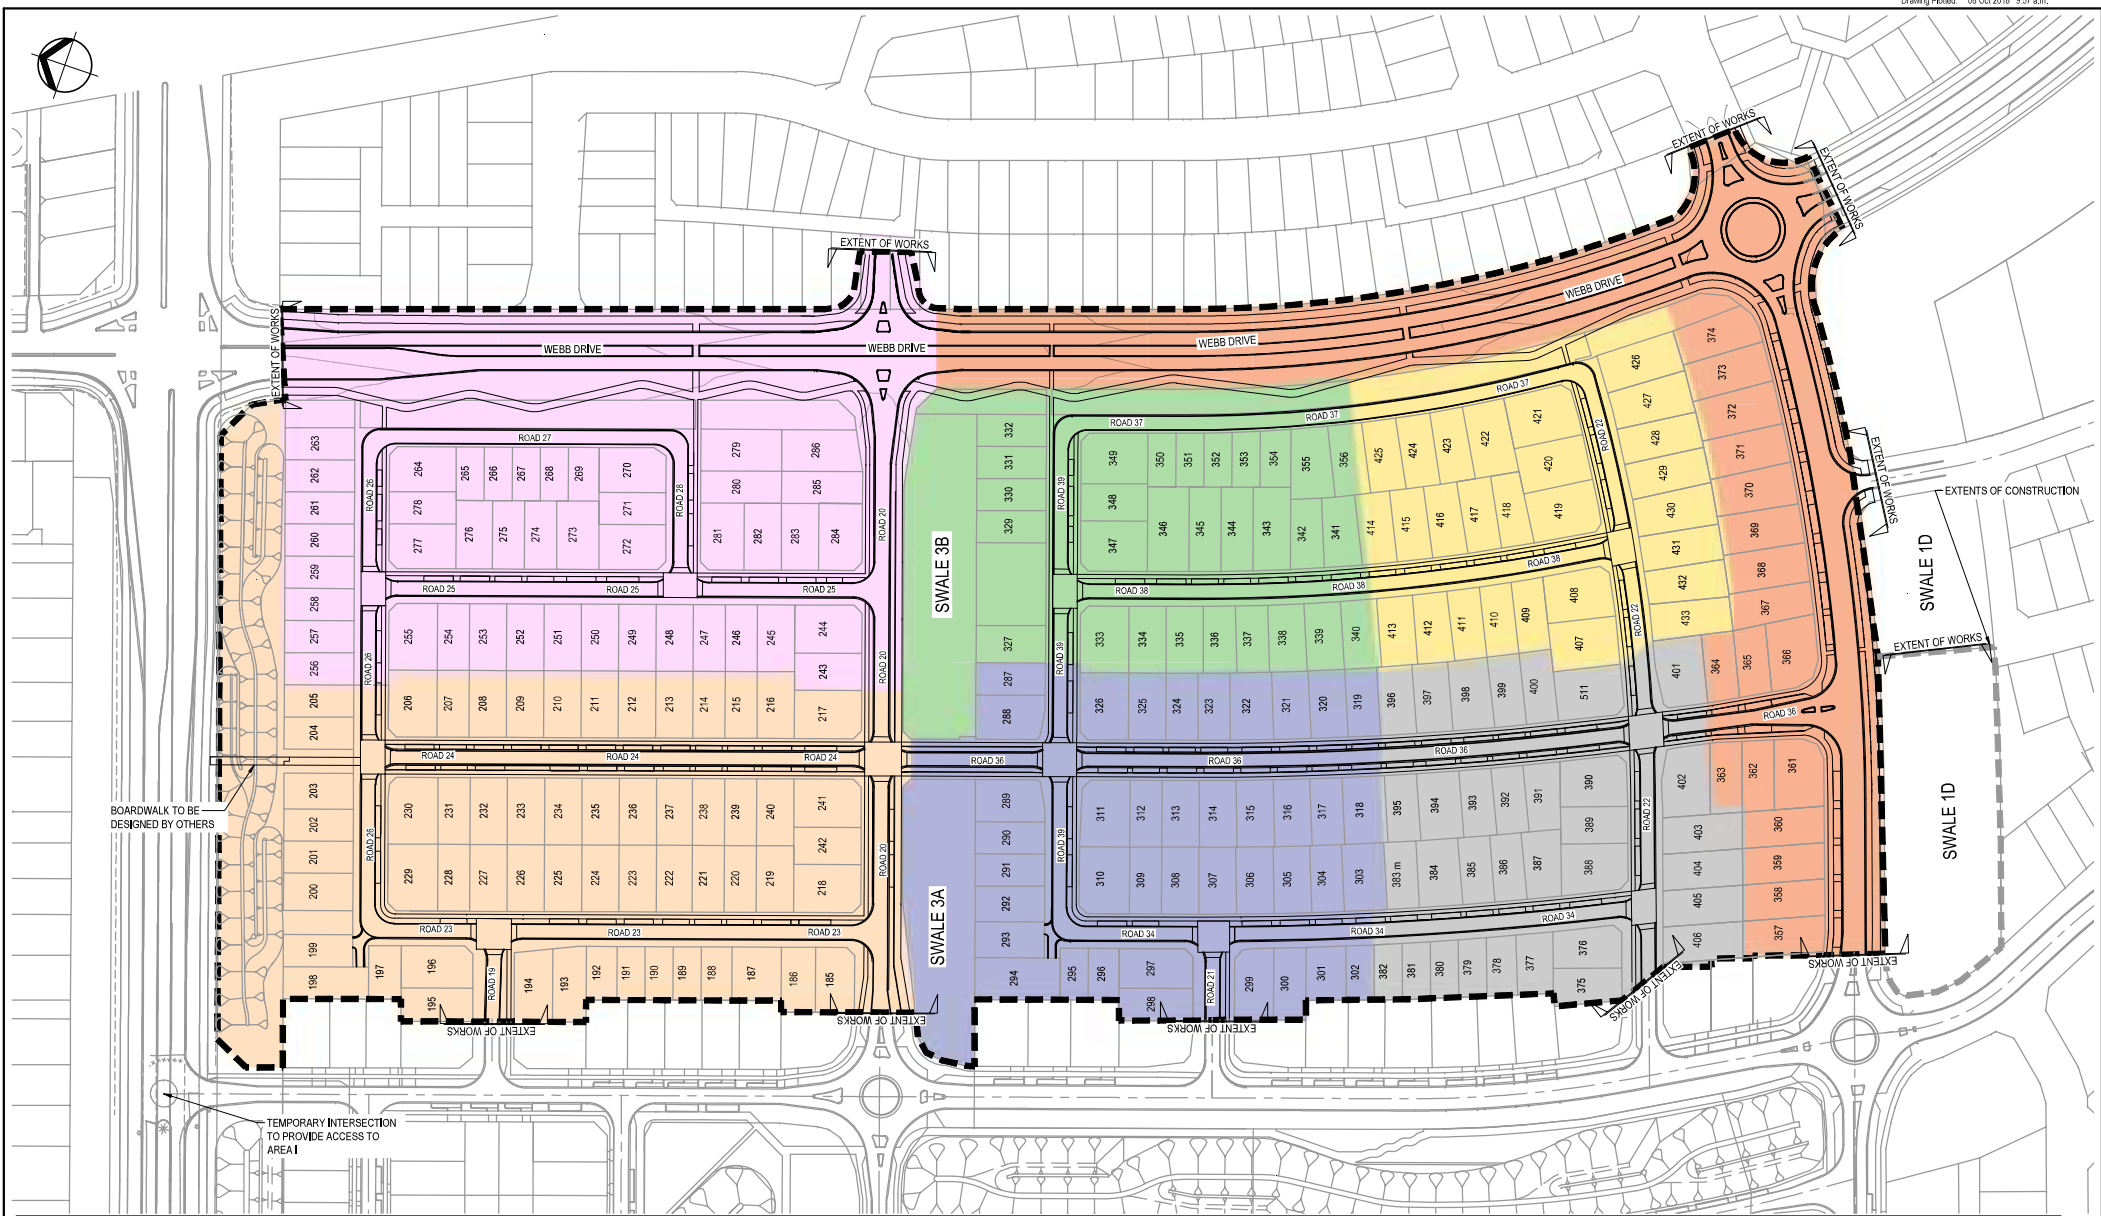

LEGEND:

	AREA M EXTENTS		AREA M - STAGE 10		AREA M - STAGE 13
	STORMWATER CULVERT		AREA M - STAGE 11		AREA M - STAGE 14
	BASIN LOW FLOW CHANNEL		AREA M - STAGE 12		AREA M - STAGE 15
	AREA M - STAGE 9				

- NOTES:**
1. EXTENT OF WORKS IS DEFINED AS THE "AREA M EXTENTS" AS SHOWN ON THE PLANS.
 2. ALL WORKS TO BE CONSTRUCTED IN ACCORDANCE WITH HAMILTON CITY COUNCIL INFRASTRUCTURE TECHNICAL SPECIFICATIONS (UNLESS OTHERWISE SPECIFIED).
 3. DETAILS OF INTERFACING WITH OTHER PROJECT STAGES TO BE CONFIRMED ON SITE PRIOR TO CONSTRUCTION

**ORIGINAL DRAWING
IN COLOUR**

FOR CONSTRUCTION

No.	Revision	SM	PP	AJ	21.09.18
1	FOR CONSTRUCTION				



Original Scale (A1)	Design	REMK	17.08.18	Approved For Construction*
1:1000	Drawn	SM	17.08.18	AJ
Reduced Scale (A3)	Design Checker	GJC	17.08.18	Date
1:2000	Day Check	GDC	17.08.18	21.09.18

* Refer to Revision 1 for Original Signature

Client:



Project:

Title: ROADING AND EARTHWORKS GENERAL ARRANGEMENT

Discipline: CIVIL ENGINEERING
Drawing No: 3411915-CA-2010
Rev: 1





SHRIMPTON & LIPINSKI

LAND DEVELOPMENT & DESIGN SPECIALISTS

Ph. 07 577 6069
Email: info@sltga.co.nz
P.O. Box 231, Tauranga 3140

www.sltga.co.nz

Elevations Table			
Number	Minimum Elevation	Maximum Elevation	Color
1	-2.245	-2.000	Light Green
2	-2.000	-1.750	Blue
3	-1.750	-1.500	Light Blue
4	-1.500	-1.250	Light Cyan
5	-1.250	-1.000	Light Green
6	-1.000	-0.750	Light Green
7	-0.750	-0.500	Light Green
8	-0.500	-0.250	Light Green
9	-0.250	0.000	Light Green
10	0.000	0.250	Yellow-Green
11	0.250	0.500	Yellow-Green
12	0.500	0.750	Yellow-Green
13	0.750	1.000	Yellow-Green
14	1.000	1.250	Yellow-Green
15	1.250	1.500	Yellow-Green
16	1.500	1.750	Yellow-Green
17	1.750	2.000	Yellow-Green
18	2.000	2.426	Yellow-Green

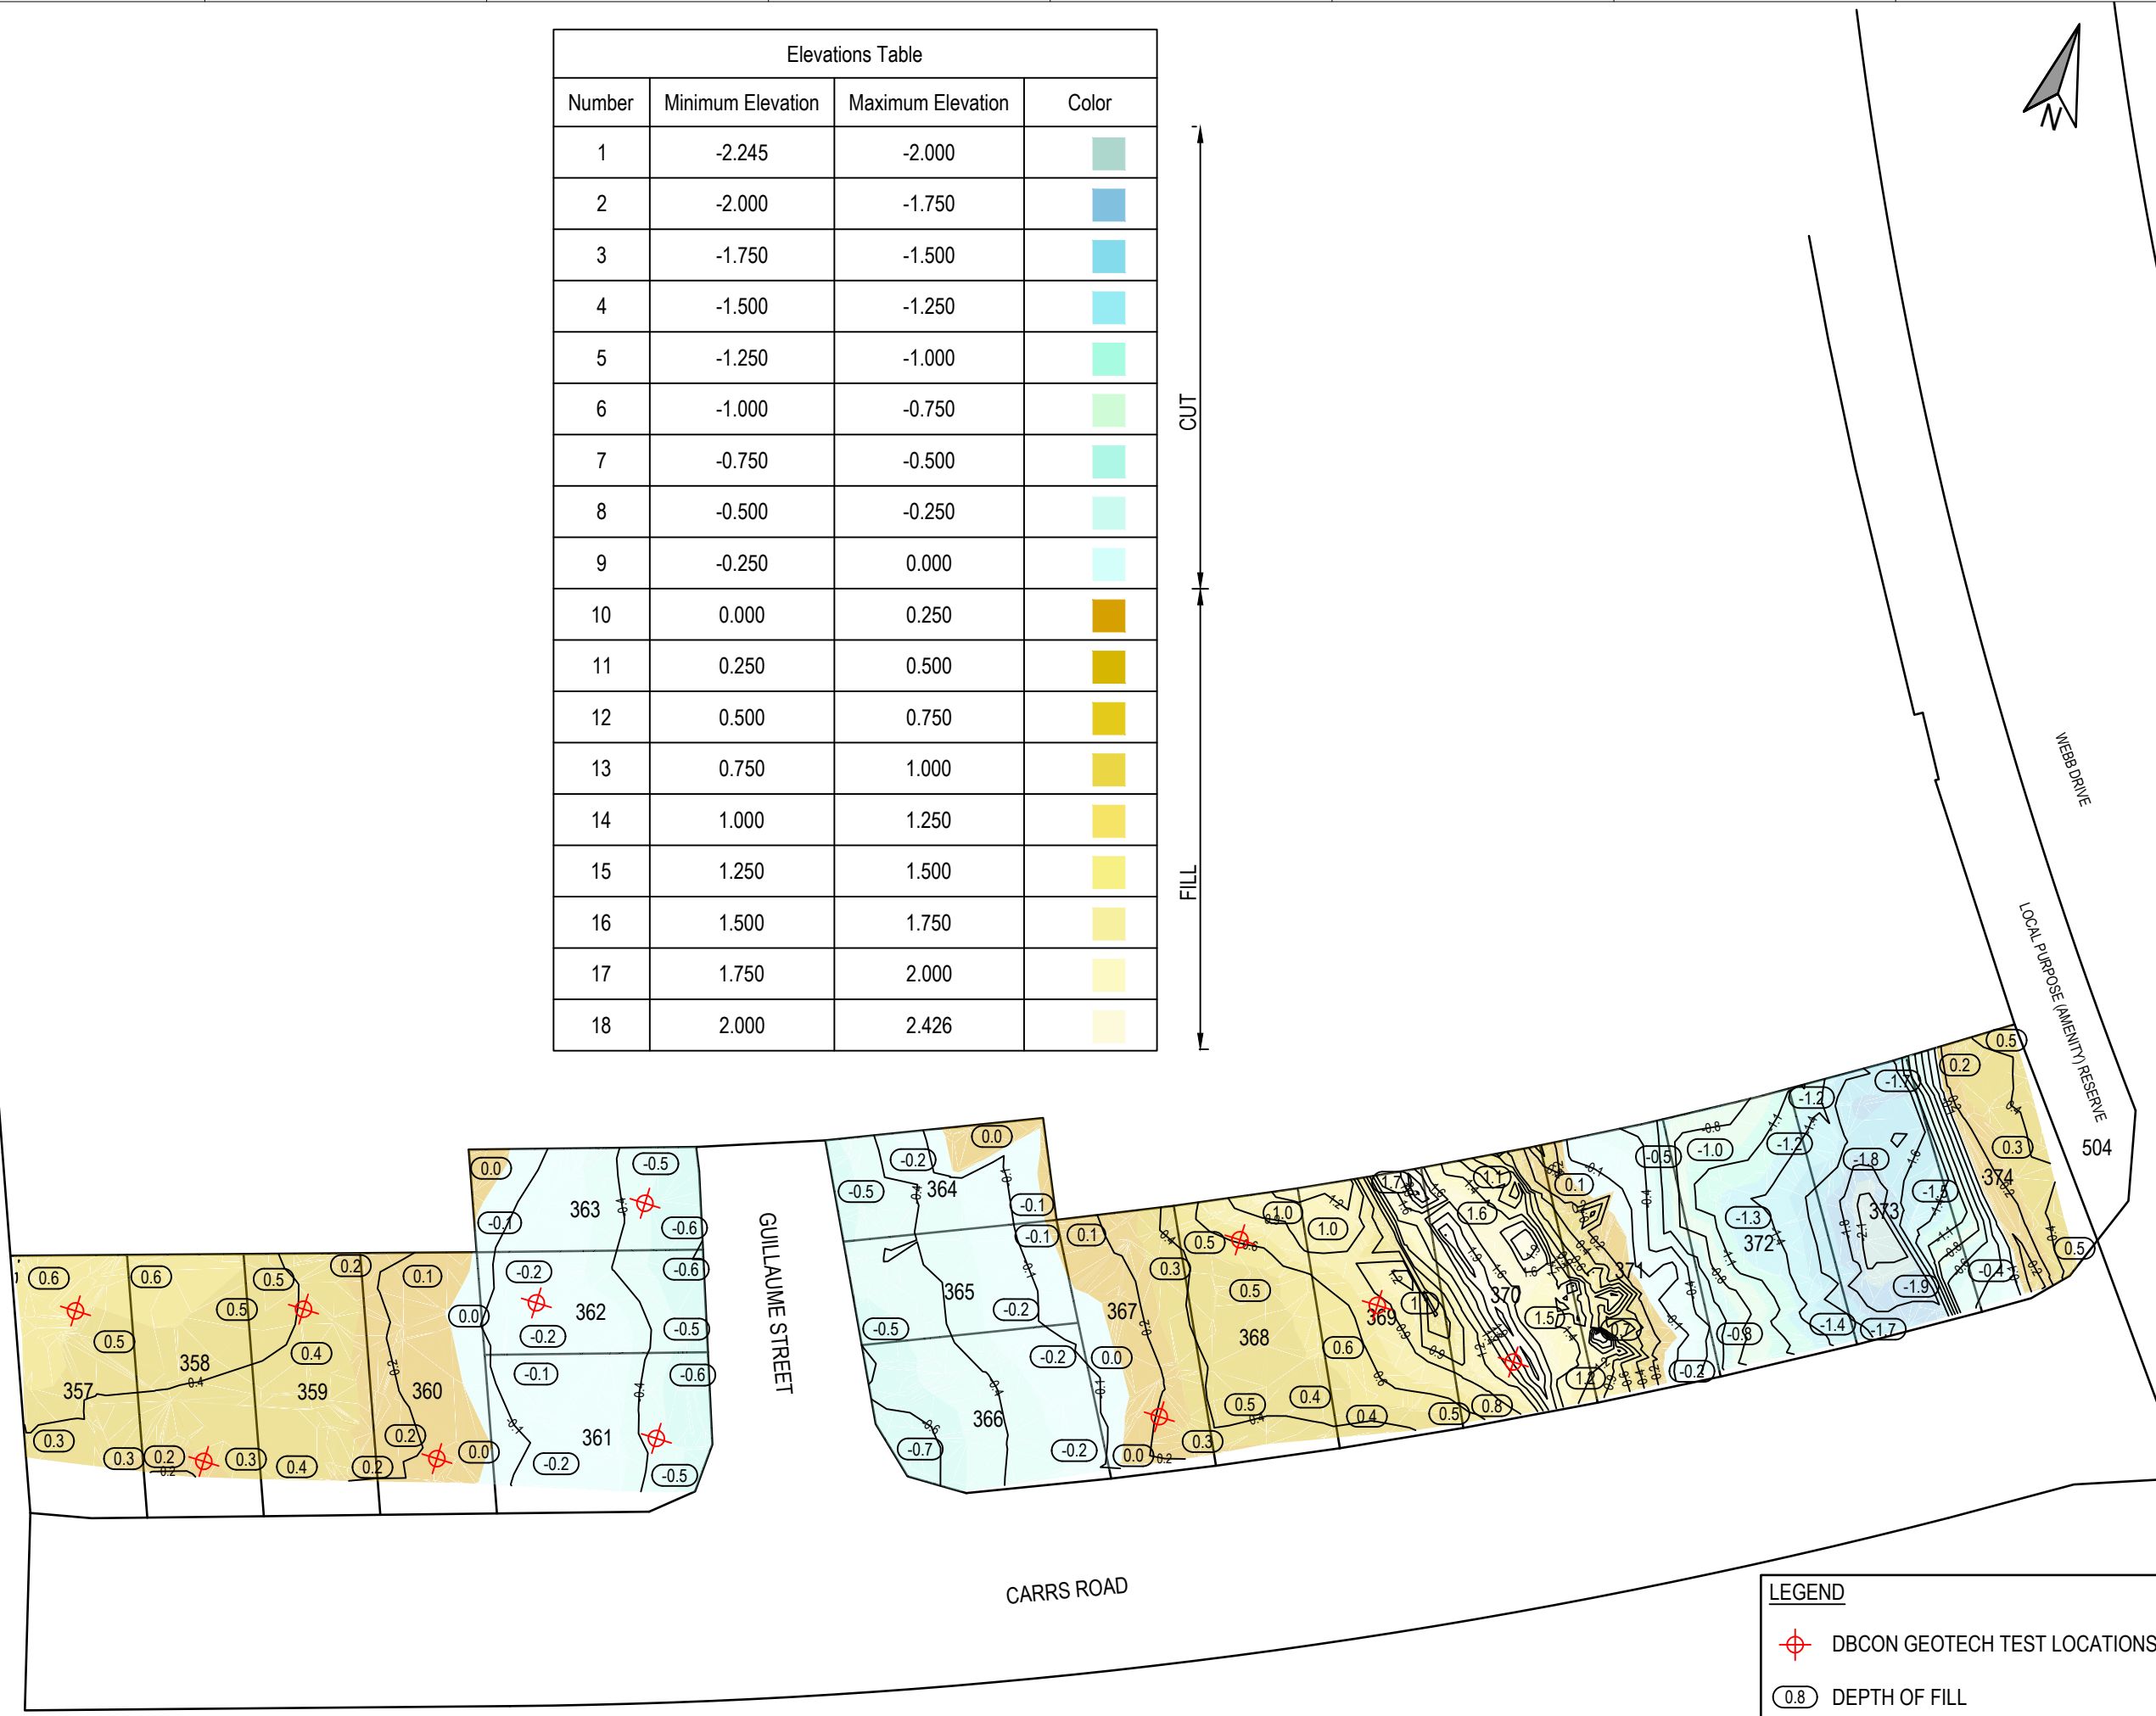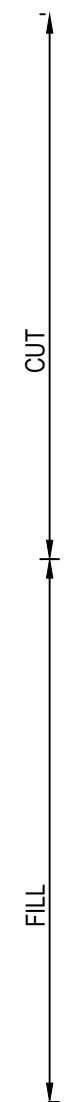

Rev	DESCRIPTION	DRN	CKD	APP	DATE
AB	AS-BUILT	NP	SC	SC	02/21

SURVEYED	SRC	DESIGNED	NAME	DATE

COORDINATE SYSTEM: MT EDEN 2000 CIRCUIT
 ORIGIN OF COORDINATES: ALP3 DP 534481
 HEIGHT DATUM: MOTURIKI DATUM
 ORIGIN OF HEIGHT: SS 507 SO 42451 RL = 44.04

TITLE

**CHEDWORTH PROPERTIES LTD
GREENHILL PARK
STG 13 CUT/FILL**

PREPARED FOR



ORIGINAL SCALES @ A3	STATUS
1:750	AS-BUILT
DO NOT SCALE DIMENSIONS	
DRAWING NO	REVISION
21879-01-M13-EW1	AB

LEGEND

- DBCON GEOTECH TEST LOCATIONS
- DEPTH OF FILL

CUT/FILL CONTOUR INTERVAL: 0.25M

H:\0000 - H Drive\parkinson\Autocad\21879-01 - C.ADM - Stage 13 Cut Fill and Geotech Plans.dwg - Plotted: 10/02/2021



SHRIMPTON & LIPINSKI

LAND DEVELOPMENT & DESIGN SPECIALISTS

Ph. 07 577 6069
Email: info@sltga.co.nz
P.O. Box 231, Tauranga 3140

www.sltga.co.nz



Rev	DESCRIPTION	DRN	CKD	APP	DATE
AB	AS-BUILT	NP	SC	SC	02/21

SURVEYED	SRC	DATE	DESIGNED	NAME	DATE
		26/1/21			

COORDINATE SYSTEM: MT EDEN 2000 CIRCUIT
 ORIGIN OF COORDINATES: ALP3 DP 534481
 HEIGHT DATUM: MOTURIKI DATUM
 ORIGIN OF HEIGHT: SS 507 SO 42451 RL = 44.04

**SECTION LEVELS & FLOW
 GEOTECHNICAL
 REQUIREMENT
 STAGE 13 AREA M**

PREPARED FOR



ORIGINAL SCALES @ A3	STATUS
1:750	AS-BUILT
DO NOT SCALE DIMENSIONS	
DRAWING NO	REVISION
21879-01-M13-G1	AB

LEGEND

← FLOW ARROW

(39.2) SPOT HEIGHT (GROUND LEVEL)

LEVELS ARE TAKEN ON REPLACED TOPSOIL.
 THIS PLAN IS NOT TO BE USED FOR DESIGN PURPOSES

H:\0000 - H Drive\parkinson\Autocad\21879-01 - CADM - Stage 13 Cut Fill and Geotech Plans.dwg - Plotter: 10/02/2021

Appendix II *Geotechnical Completion Forms*

Checklist 2.2 - Statement of Professional Opinion Summary of Geotechnical Data for Individual Lots
Summary of Geotechnical Data for individual Lots

STATEMENT OF PROFESSIONAL OPINION AS TO SUITABILITY OF LAND FOR BUILDING CONSTRUCTION

Development: Greenhill Park Stage 13 Developer: Chedworth Properties Limited

At Pardoia Boulevard, Chartwell, Hamilton

I, Michael Richardson of DB Consulting Engineers, PO Box 1123, Taupo

Hereby confirm that:

- 1.0 I am a geo-professional as defined in clause 1.2.2 of NZS 4404:2010 and was retained by the developer as the geo- professional on the above development.
- 2.0 The extent of my inspections during construction, and the results of all tests carried out are described in my geotechnical completion report for Greenhill Park Area M Stage 13 dated November 2020 (reference 171738-AREA-M-S13-01)
- 3.0 In my professional opinion, not to be construed as a guarantee, I consider that:
 - a. The completed works give due regard to land slope and foundation stability considerations.
 - b. The site ground affected by engineered certified filling is suitable for the erection thereon of buildings designed according to the report recommendations provided that:
 - i. Lots 369-371 are subject to engineering review of foundations and specific design as required to address the deeper engineered fill in this location. An M Class Waffle slab or similar is expected as an appropriate foundation type for this area.
 - ii. All lots are subject to an engineering inspection during foundation excavations unless of further soils testing is carried out for building consent. Previous stages have not required further soils testing, but Council requirements are in the process of changing. Clarification should be sought from Council as to the the need for site specific soil testing. If in doubt, then 4 additional soils tests per lots should be carried out. We recommend construction supervision from an engineer should be carried out to confirm the shallow ground conditions are in accordance with this report and suitable for NZS3604 foundations for bearing strength.
- 4.0 This professional opinion is furnished to Hamilton City Council and the developer for their purposes alone on the express condition that it will not be relied upon by any other person and does not remove the necessity for the normal inspection of foundation conditions at the time of erection of any dwelling.
- 5.0 This certificate shall be read in conjunction with my geotechnical completion report referred to in clause 2 above and shall not be copied or reproduced except in conjunction with the full geotechnical completion report.

Signed

Date: 26 February 2021

Michael Richardson
Chartered Professional Engineer (Geotechnical)
CPEng 1005467


Summary of Geotechnical Data for Individual Lots

DP No:	TBC	Property Address	Greenhill Park, Stage 13, Hamilton													RC No:	11/2018/6632		
Lot No:	Area (m ²)	Subsurface Data						Foundations		Building Restriction Line	S/W Specific Design	S/W Soakage	S/W Reticulated	Designated Building Platform	Minimum Building	Compressible Soils	On-site Effluent Disposal	Consent Notice	Comment
		Shear Strength (kPa)	Subdivision Filling		Natural Topography Unworked	Natural Topography Earthworked	Conventional Shallow Foundation to NZS 3604:2011	Specific Design	Y/N/NA										
		Y/N	Depth (m)	Y/N	Y/N	Depth (mm)	Y/N/NA	Y/N/NA											
357	500	Note 1	Y	0.3-0.4 ²	N	Y	200 ²	Y	N	N	Y	Y ⁴	N	N	N	N	N	Y	
358	360	Note 1	Y	0.3-0.4 ²	N	Y	200 ²	Y	N	N	Y	Y ⁴	N	N	N	N	N	Y	
359	360	Note 1	Y	0.4-0.5 ²	N	Y	200 ²	Y	N	N	Y	Y ⁴	N	N	N	N	N	Y	
360	500	Note 1	Y	0.1-0.2 ²	N	Y	200 ²	Y	N	N	Y	Y ⁴	N	N	N	N	N	Y	
361	450	Note 1	N	-	N	Y	200 ²	Y	N	N	Y	Y ⁴	N	N	N	N	N	Y	
362	300	Note 1	N	-	N	Y	200 ²	Y	N	N	Y	Y ⁴	N	N	N	N	N	Y	
363	300	Note 1	N	-	N	Y	200 ²	Y	N	N	Y	Y ⁴	N	N	N	N	N	Y	
364	305	Note 1	N	-	N	Y	200 ²	Y	N	N	Y	Y ⁴	N	N	N	N	N	Y	
365	305	Note 1	N	-	N	Y	200 ²	Y	N	N	Y	Y ⁴	N	N	N	N	N	Y	
366	450	Note 1	N	-	N	Y	200 ²	Y	N	N	Y	Y ⁴	N	N	N	N	N	Y	
367	400	Note 1	Y	0.2-0.4 ²	N	Y	200 ²	Y	N	N	Y	Y ⁴	N	N	N	N	N	Y	
368	450	Note 1	Y	0.5-0.6 ²	N	Y	200 ²	Y	N	N	Y	Y ⁴	N	N	N	N	N	Y	
369	450	Note 1	Y	0.9-1.2 ²	N	Y	200 ²	N	Y	N	Y	Y ⁴	N	N	N	N	N	Y	
370	450	Note 1	Y	1.1-1.9 ²	N	Y	200 ²	N	Y	N	Y	Y ⁴	N	N	N	N	N	Y	
371	435	Note 1	Y	0.1-0.7 ²	N	Y	200 ²	N	Y	N	Y	Y ⁴	N	N	N	N	N	Y	
372	470	Note 1	N	-	N	Y	200 ²	Y	N	N	Y	Y ⁴	N	N	N	N	N	Y	
373	440	Note 1	N	-	N	Y	200 ²	Y	N	N	Y	Y ⁴	N	N	N	N	N	Y	
374	425	Note 1	Y	0.2-0.5 ²	N	Y	200 ²	Y	N	N	Y	Y ⁴	N	N	N	N	N	Y	


NOTES:

- 1) Testing undertaken with Shera vane and NDM (Nuclear Density Meter)
- 2) This considers approximately 200mm of topsoil removal across all lots prior to subdivision filling.
- 3) Setback required for properties adjacent swales. TC2 type foundation to be adopted within 1.5m-5m from top of slope, no foundations to be constructed <1.5m from top of slope, No specific engineer design required >5m from top of slope
- 4) Soakage testing required on individual lots. Ground soakage and stormwater storage devices required

Appendix III Pre-Construction Assessment (exerts)
BECA Area M Liquefaction Assessment Summary Plan

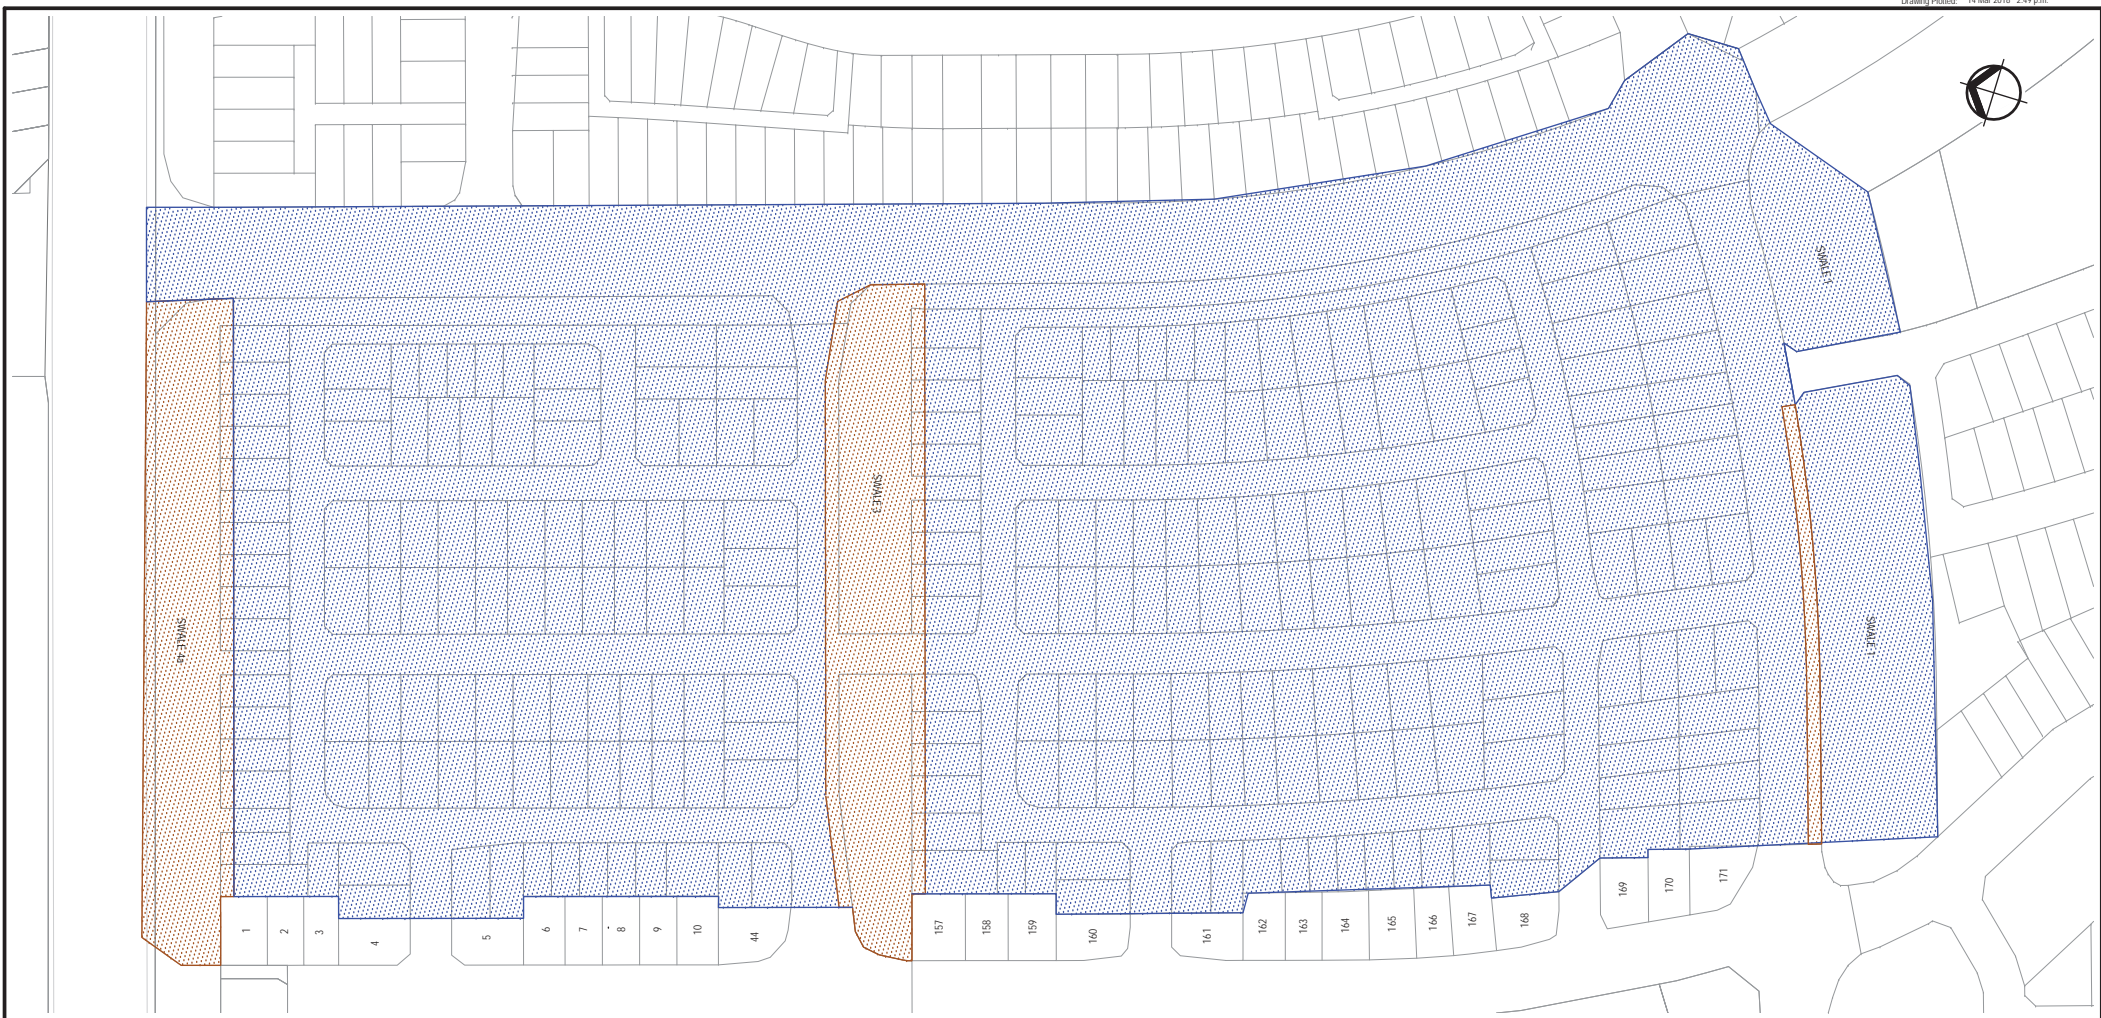

KEY

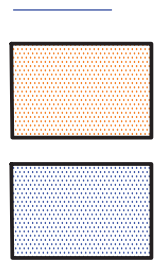


EXTENT OF AREA M


MEDIUM LIQUEFACTION VULNERABILITY
 - MINOR TO MODERATE LIQUEFACTION-INDUCED GROUND DAMAGE IN 500 YEAR EARTHQUAKE TO MITIGATE LIQUEFACTION AND SEISMIC SLOPE INSTABILITY EFFECTS ADOPT LIQUEFACTION MITIGATION OPTION 1 OR 2.

LOW LIQUEFACTION VULNERABILITY
 - NONE TO MINOR LIQUEFACTION-INDUCED GROUND DAMAGE IN 500 YEAR EARTHQUAKE. NO SPECIFIC REQUIREMENTS TO MITIGATE LIQUEFACTION EFFECTS.

LIQUEFACTION MITIGATION OPTION 1:

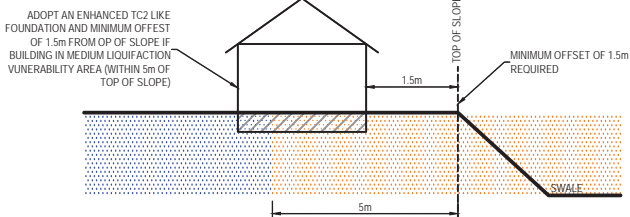

LIQUEFACTION MITIGATION OPTION 2:

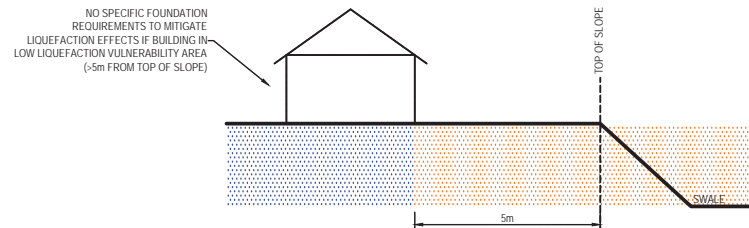

**FOR INFORMATION
NOT FOR CONSTRUCTION**

A FOR INFORMATION		SM	MP	PR	12.03.18
No.	Revision	By	chk	Asst	Date

Drawing Originator	Original Scale (A1)	Design	MLP	27.09.16	Approved For Construction*
	1:3000	Drawn	SM	12.03.18	
	Reduced	Day Checker	EAR	12.03.18	
	Scale (A3)	Design Check			Date
	1:6000				

Client	Chedworth	Project	Area M
--------	-----------	---------	--------

Discipline	GEOTECHNICAL
Drawing No.	3411915-GC-K068
Rev	A

AREA M LIQUEFACTION ASSESSMENT SUMMARY PLAN

Appendix IV Post-Construction Test Results

Completion Testing by DCBE Ltd




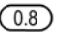
REV	DESCRIPTION	DRN	END	APP	DATE
AB	AS-BUILT	MP	SC	SC	02/21

SURVEYED	BY	DATE	DESIGNED	BY	DATE

COORDINATE SYSTEM: NAD 83
ORIGIN OF COORDINATES: ALP3 DP 534481
HEIGHT DATUM: MONTANA DATUM
ORIGIN OF HEIGHT: 55 507 50 52451 RL = 44.04

**CHEDWORTH
PROPERTIES LTD
GREENHILL PARK
STG 13 CUT/FILL**

PREPARED FOR	
ORIGINAL SCALES @ AS STATUS	AS-BUILT
1:750	
DRAWING NO	REVISION
21879-01-M13-EW1	AB

LEGEND
 DBCON GEOTECH TEST LOCATIONS
 DEPTH OF FILL
 CUT/FILL CONTOUR INTERVAL: 0.25M

C:\Users\m_storey\AppData\Local\Temp\Temp1_21879-01 - CADM - Stage 13 Cut Fill and Geotech Plans - Autocad zipped\21879-01 - CADM - Stage 13 Cut Fill and Geotech Plans.dwg - Plotted: 26/02/2021



Project Name Area M, Stage 13, Greenhill Park, Hamilton		Job Ref. 171738-AREA-M-S13-01	
Tested by RG	Date 28/01/2021	Sheet No. 1	Test Site Lot 357

Depth (mm)	Undrained Shear (kPa)	No of blows /100mm	Scala Penetrometer (Blows/100mm)		Soil Description	Water Table
			0 2 4 6 8 10 12 14 16			
100		2		Good Ground	Topsoil	
200		10		Result	SILT with gravels and sand, light greyish brown, medium dense, moist.	
300		7				
400		7			Sand with minor silt, coarse gravels, brown, dense to very dense, moist.	
500		14				
600		11			EOB at 0.7m Unable to penetrate due to coarse gravel.	
700		13				
800		12				
900						
1000						
Notes:	EOB = End Of Borehole UTP = Unable To Penetrate UTE = Unable To Extract
1	Weather leading up to test was:
2	Ground water was not encountered during testing
3	Shear Vane readings are converted readings, as per calibration Certificate. (Values are undrained shear strength)
4	Shear Vane records include Re-moulded values where possible
5	Shear Vane Serial No.: 2641 Exp. Date: 02/06/2021

Project Name Area M, Stage 13, Greenhill Park, Hamilton		Job Ref. 171738-AREA-M-S13-01	
Tested by Jessel Lawda	Date 28/01/2021	Sheet No. 2	Test Site Lot 358

Depth (mm)	Undrained Shear (kPa)	No of blows /100mm	Scala Penetrometer (Blows/100mm)		Soil Description	Water Table
			0 2 4 6 8 10 12 14 16			
100		2		Good Ground	Topsoil	
200		4				
300		13		Result	Silt with gravel and sand, brown	
400		14			EOB @ 0.4m Unable to penetrate due to coarse gravel	
500		19				
600		25				
700		32				
800		27				
900		34				
1000						
1100						
Notes:	EOB = End Of Borehole UTP = Unable To Penetrate UTE = Unable To Extract
1	Weather leading up to test was:
2	Ground water was not encountered during testing
3	Shear Vane readings are converted readings, as per calibration Certificate. (Values are undrained shear strength)
4	Shear Vane records include Re-moulded values where possible
5	Shear Vane Serial No.: C365 Exp. Date: 04/02/2021



Project Name Area M, Stage 13, Greenhill Park, Hamilton		Job Ref. 171738-AREA-M-S13-01	
Tested by RG	Date 28/01/2021	Sheet No. 3	Test Site Lot 359

Depth (mm)	Undrained Shear (kPa)	No of blows /100mm	Scala Penetrometer (Blows/100mm)		Soil Description	Water Table
			0	2 4 6 8 10 12 14 16		
100		2			Topsoil	
200		2				
300		5			Silty SAND, gravels, brown, dense, moist.	
400		7				
500		6			SAND, with trace gravels, dense, moist.	
600		4				
700	128/28					
800						
900	117/21				Clayey SILT, trace sand, yellowish brown, very stiff, moist.	
1000						
1100						
1200		3				
1300		5			SAND, trace silt, brown, medium dense, moist.	
1400		3				
1500		4				
1600		5				
1700		4			SAND, medium to coarse, medium dense, moist.	
1800		4				
1900		3				
2000					EOB at 2.0m	
2100						
2200						
Notes:	EOB = End Of Borehole UTP = Unable To Penetrate UTE = Unable To Extract
1	Weather leading up to test was:
2	Ground water was not encountered during testing
3	Shear Vane readings are converted readings, as per calibration Certificate. (Values are undrained shear strength)
4	Shear Vane records include Re-moulded values where possible
5	Shear Vane Serial No.: 2641 Exp. Date: 02/06/2021



Project Name Area M, Stage 13, Greenhill Park, Hamilton		Job Ref. 171738-AREA-M-S13-01	
Tested by Jessel Lawda	Date 28/01/2021	Sheet No. 4	Test Site Lot 360

Depth (mm)	Undrained Shear (kPa)	No of blows /100mm	Scala Penetrometer (Blows/100mm)		Soil Description	Water Table
			0 2 4 6 8 10 12 14 16			
100		1			Topsoil	
200		3				
300		9				
400		21+			Sand, some silt, dense, light brown	
500		Refusal				
600						
700					Sand, light brown, gravel	
800						
900						
1000					Sand, minor clay, light brown	
1100						
1200					EOB @ 1.2m unable to penetrate due to coarse gravel	
1300						
1400						
Notes:	EOB = End Of Borehole	UTP = Unable To Penetrate	UTE = Unable To Extract
1	Weather leading up to test was:		
2	Ground water was not encountered during testing		
3	Shear Vane readings are converted readings, as per calibration Certificate. (Values are undrained shear strength)		
4	Shear Vane records include Re-moulded values where possible		
5	Shear Vane Serial No.: C365	Exp. Date: 04/02/2021	



DB CONSULTING ENGINEERS

Project Name Area M, Stage 13, Greenhill Park, Hamilton		Job Ref. 171738-AREA-M-S13-01	
Tested by RG	Date 28/01/2021	Sheet No. 5	Test Site Lot 361


Depth (mm)	Undrained Shear (kPa)	No of blows /100mm	Scala Penetrometer (Blows/100mm)		Soil Description	Water Table
			0	2 4 6 8 10 12 14 16		
100		2			Topsoil	
200		8				
300		10			Silty SAND, light brown, dense, moist.	
400		8				
500		7				
600		8				
700		7			SAND, trace silt, yellowish brown, dense, moist.	
800		8				
900		6				
1000		6				
1100		8			Silty SAND, brown, medium dense to dense, moist	
1200		10				
1300		11				
1400		10			SAND, with gravels, brownish orange, dense to very dense, moist.	
1500		Refusal				
1600					EOB at 1.6m Unable to penetrate due to coarse gravels.	
1700						
1800						
Notes:	EOB = End Of Borehole UTP = Unable To Penetrate UTE = Unable To Extract
1	Weather leading up to test was:
2	Ground water was not encountered during testing
3	Shear Vane readings are converted readings, as per calibration Certificate. (Values are undrained shear strength)
4	Shear Vane records include Re-moulded values where possible
5	Shear Vane Serial No.: 2641 Exp. Date: 02/06/2021



Project Name Area M, Stage 13, Greenhill Park, Hamilton		Job Ref. 171738-AREA-M-S13-01	
Tested by Jessel Lawda	Date 28/01/2021	Sheet No. 6	Test Site Lot 362

Depth (mm)	Undrained Shear (kPa)	No of blows /100mm	Scala Penetrometer (Blows/100mm)		Soil Description	Water Table
			0 2 4 6 8 10 12 14 16			
100		2			Topsoil	
200		7			Silty SAND, brown	
300		7				
400		7			EOB @ 0.5m unable to penetrate due to coarse gravel	
500		9				
600		7				
700		8				
800		4				
900		3				
1000						
1100						
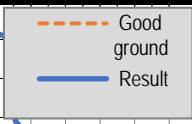

Notes:		EOB = End Of Borehole	UTP = Unable To Penetrate	UTE = Unable To Extract
1	Weather leading up to test was:			
2	Ground water was not encountered during testing			
3	Shear Vane readings are converted readings, as per calibration Certificate. (Values are undrained shear strength)			
4	Shear Vane records include Re-moulded values where possible			
5	Shear Vane Serial No.: C365	Exp. Date: 04/02/2021		



DB CONSULTING ENGINEERS

Project Name Area M, Stage 13, Greenhill Park, Hamilton		Job Ref. 171738-AREA-M-S13-01	
Tested by Jessel Lawda	Date 28/01/2021	Sheet No. 7	Test Site Lot 363

Depth (mm)	Undrained Shear (kPa)	No of blows /100mm	Scala Penetrometer (Blows/100mm)		Soil Description	Water Table
			0	2 4 6 8 10 12 14 16		
100		4			Topsoil	
200		6				
300		7			UTP @ 0.3m due to coarse gravel	
400		5				
500		5				
600		14				
700		15				
800		13				
900		17				
1000						
1100						
Notes:	EOB = End Of Borehole	UTP = Unable To Penetrate	UTE = Unable To Extract
1	Weather leading up to test was:		
2	Ground water was not encountered during testing		
3	Shear Vane readings are converted readings, as per calibration Certificate. (Values are undrained shear strength)		
4	Shear Vane records include Re-moulded values where possible		
5	Shear Vane Serial No.: C365	Exp. Date: 04/02/2021	



DB CONSULTING ENGINEERS

Project Name Area M, Stage 13, Greenhill Park, Hamilton		Job Ref. 171738-AREA-M-S13-01	
Tested by Jessel Lawda	Date 28/01/2021	Sheet No. 8	Test Site Lot 364

Depth (mm)	Undrained Shear (kPa)	No of blows /100mm	Scala Penetrometer (Blows/100mm)	Soil Description	Water Table	
			0 2 4 6 8 10 12 14 16			
100		1		Topsoil		
200		3				
300		2				
400		8			Sand, minor silt, light/dark brown	
500		7				
600		5				
700		7			EOB @ 0.7m unable to penetrate due to coarse gravel	
800		9				
900		9				
1000						
1100						
Notes:	EOB = End Of Borehole	UTP = Unable To Penetrate	UTE = Unable To Extract
1	Weather leading up to test was:		
2	Ground water was not encountered during testing		
3	Shear Vane readings are converted readings, as per calibration Certificate. (Values are undrained shear strength)		
4	Shear Vane records include Re-moulded values where possible		
5	Shear Vane Serial No.: C365	Exp. Date: 04/02/2021	



DB CONSULTING ENGINEERS

Project Name Area M, Stage 13, Greenhill Park, Hamilton		Job Ref. 171738-AREA-M-S13-01	
Tested by Jessel Lawda	Date 28/01/2021	Sheet No. 9	Test Site Lot 365

Depth (mm)	Undrained Shear (kPa)	No of blows /100mm	Scala Penetrometer (Blows/100mm)		Soil Description	Water Table
			0	2 4 6 8 10 12 14 16		
100		4			Topsoil	
200		6				
300		7				
400		5				
500		5				
600		14				
700		15				
800		17				
900		18				
1000						
1100						
1200					EOB at 1.2m, unable to penetrate due to coarse gravel	
1300						
1400						
Notes:		EOB = End Of Borehole	UTP = Unable To Penetrate	UTE = Unable To Extract
1	Weather leading up to test was:			
2	Ground water was not encountered during testing			
3	Shear Vane readings are converted readings, as per calibration Certificate. (Values are undrained shear strength)			
4	Shear Vane records include Re-moulded values where possible			
5	Shear Vane Serial No.: C365	Exp. Date: 04/02/2021		



DB CONSULTING ENGINEERS

Project Name Area M, Stage 13, Greenhill Park, Hamilton		Job Ref. 171738-AREA-M-S13-01	
Tested by RG	Date 28/01/2021	Sheet No. 10	Test Site Lot 366

Depth (mm)	Undrained Shear (kPa)	No of blows /100mm	Scala Penetrometer (Blows/100mm)		Soil Description	Water Table
			0	2 4 6 8 10 12 14 16		
100		3			Topsoil	
200		3				
300		2				
400		6			Sity SAND, light greyish brown, medium desne, moist.	
500		13				
600		15			SAND, greyish brown, dense, moist.	
700		10				
800		6				
900		6			SAND, greyish brown, dense, moist.	
1000		6				
1100		13			EOB at 1.2m Unable to penetrate due to coarse gravel.	
1200		15				
1300		10				
1400						
1500						
Notes:		EOB = End Of Borehole	UTP = Unable To Penetrate	UTE = Unable To Extract
1	Weather leading up to test was:			
2	Ground water was not encountered during testing			
3	Shear Vane readings are converted readings, as per calibration Certificate. (Values are undrained shear strength)			
4	Shear Vane records include Re-moulded values where possible			
5	Shear Vane Serial No.: 2641	Exp. Date: 02/06/2021		



DB CONSULTING ENGINEERS

Project Name Area M, Stage 13, Greenhill Park, Hamilton		Job Ref. 171738-AREA-M-S13-01	
Tested by Jessel Lawda	Date 28/01/2021	Sheet No. 11	Test Site Lot 367

Depth (mm)	Undrained Shear (kPa)	No of blows /100mm	Scala Penetrometer (Blows/100mm)													Soil Description	Water Table
			0	2	4	6	8	10	12	14	16						
100		5														Topsoil	
200		2															
300		5															
400		8															
500		9															
600		9															
700		4															
800		3															
900		3															
1000																	
1100																	
1200		6															
1300		7															
1400		6															
1500		5															
1600		7															
1700		6															
1800		6															
1900		7															
2000																	
2100																	
Notes: EOB = End Of Borehole UTP = Unable To Penetrate UTE = Unable To Extract

- Weather leading up to test was:
- Ground water was not encountered during testing
- Shear Vane readings are converted readings, as per calibration Certificate. (Values are undrained shear strength)
- Shear Vane records include Re-moulded values where possible
- Shear Vane Serial No.: C365 Exp. Date: 04/02/2021



Project Name Area M, Stage 13, Greenhill Park, Hamilton		Job Ref. 171738-AREA-M-S13-01	
Tested by RG	Date 28/01/2021	Sheet No. 12	Test Site Lot 368

Depth (mm)	Undrained Shear (kPa)	No of blows /100mm	Scala Penetrometer (Blows/100mm)		Soil Description	Water Table
			0	2 4 6 8 10 12 14 16		
100		4			Topsoil with silt and gravels.	
200		4				
300		3			SILT, some sand, brown, medium desne, moist.	
400		7				
500	180+/-	7			Clayey SILT, trace sand, brown, very stiff, moist.	
600		13				
700	153/43					
800					trace garvels	
900						
1000						
1100						
1200		6				
1300		5			Silty SAND, brown, medium dense, moist.	
1400		3				
1500		4				
1600		3				
1700		3				
1800		6			Silty CLAY, trace sand, brownish orange, moist.	
1900		7				
2000					EOB AT 2.0m	
2100						
2200						
Notes:	EOB = End Of Borehole UTP = Unable To Penetrate UTE = Unable To Extract
1	Weather leading up to test was:
2	Ground water was not encountered during testing
3	Shear Vane readings are converted readings, as per calibration Certificate. (Values are undrained shear strength)
4	Shear Vane records include Re-moulded values where possible
5	Shear Vane Serial No.: 2641 Exp. Date: 02/06/2021



DB CONSULTING ENGINEERS

Project Name Area M, Stage 13, Greenhill Park, Hamilton		Job Ref. 171738-AREA-M-S13-01	
Tested by Jessel Lawda	Date 28/01/2021	Sheet No. 13	Test Site Lot 369

Depth (mm)	Undrained Shear (kPa)	No of blows /100mm	Scala Penetrometer (Blows/100mm)													Soil Description	Water Table
			0	2	4	6	8	10	12	14	16						
100																Topsoil	
200																	
300																	
400																Sand, loose, brown	
500	120+																
600																	
700	154/55															Silty clay, brown streaked orange	
800																	
900	124/47																
1000																UTP @ 1m due to coarse gravel	
1100																	
1200																	
Notes:	EOB = End Of Borehole	UTP = Unable To Penetrate	UTE = Unable To Extract
1	Weather leading up to test was:		
2	Ground water was not encountered during testing		
3	Shear Vane readings are converted readings, as per calibration Certificate. (Values are undrained shear strength)		
4	Shear Vane records include Re-moulded values where possible		
5	Shear Vane Serial No.: C365	Exp. Date: 04/02/2021	



Project Name Area M, Stage 13 Greenhill Park, Hamilton		Job Ref. 171738-AREA-M-S13-01	
Tested by Jessel Lawda	Date 18/02/2021	Sheet No. 19	Test Site Lot 369a

Depth (mm)	Undrained Shear (kPa)	No of blows /100mm	Scala Penetrometer (Blows/100mm)		Soil Description	Water Table
			0	2 4 6 8 10 12 14 16		
100					Topsoil with silt, greyish brown, dry	
200						
300						
400					Clay, some silt, brownish orange, moist (FILL)	
500	165/45					
600					Silty CLAY, brownish orange, (FILL)	
700						
800	180+/ 180					
900					Silty SAND, brown with trace gravel (NATURAL)	
1000						
1100						
1200		5			Silty SAND, brown with trace gravel (NATURAL)	
1300		9				
1400		5				
1500		8			Sand trace silt brown moist (NATURAL)	
1600		7				
1700		8				
1800		5			EOB @ 2m	
1900		5				
2000						
2100						
Notes:	EOB = End Of Borehole UTP = Unable To Penetrate UTE = Unable To Extract
1	Weather leading up to test was:
2	Ground water was not encountered during testing
3	Shear Vane readings are converted readings, as per calibration Certificate. (Values are undrained shear strength)
4	Shear Vane records include Re-moulded values where possible
5	Shear Vane Serial No.: 2641 Exp. Date: 02/06/2021



DB CONSULTING ENGINEERS

Project Name Area M, Stage 13, Greenhill Park, Hamilton		Job Ref. 171738-AREA-M-S13-01	
Tested by RG	Date 28/01/2021	Sheet No. 14	Test Site Lot 370

Depth (mm)	Undrained Shear (kPa)	No of blows /100mm	Scala Penetrometer (Blows/100mm)	Soil Description	Water Table	
						0 2 4 6 8 10 12 14 16
100				Topsoil with silt.		
200						
300	180+/-					
400						CLAY, some silt, brownish orange, very stiff, moist.
500						
600	180+/-					
700						
800						
900	138/57					Silty CLAY, brownish orange, very stiff, moist.
1000						
1100						
1200						
1300						CLAY, some silt, brownish orange, very stiff, moist.
1400						
1500	153/50					
1600						
1700						Silty CLAY, minor sand, brownish orange, very stiff, moist.
1800						
1900	128/43					
2000						EOB at 2.0m
2100						
2200						
Notes:	EOB = End Of Borehole	UTP = Unable To Penetrate	UTE = Unable To Extract
1	Weather leading up to test was:		
2	Ground water was not encountered during testing		
3	Shear Vane readings are converted readings, as per calibration Certificate. (Values are undrained shear strength)		
4	Shear Vane records include Re-moulded values where possible		
5	Shear Vane Serial No.: 2641	Exp. Date: 02/06/2021	



Project Name Area M, Stage 13 Greenhill Park, Hamilton		Job Ref. 171738-AREA-M-S13-01	
Tested by Jessel Lawda	Date 18/02/2021	Sheet No. 20	Test Site Lot 370a

Depth (mm)	Undrained Shear (kPa)	No of blows /100mm	Scala Penetrometer (Blows/100mm)		Soil Description	Water Table
			0	2 4 6 8 10 12 14 16		
100					Topsoil	
200						
300					Silty SAND, gravel, light greyish brown (FILL)	
400						
500					Silty SAND, trace gravel (FILL)	
600	180+/-					
700						
800						
900						
1000					Silty CLAY, greyish brown, streaked white, moist, (FILL)	
1100						
1200	180+/45					
1300						
1400						
1500	160/60					
1600						
1700					Clay, some silt, brownish orange, moist (NATURAL)	
1800						
1900	128/43					
2000					EOB @ 2m	
2100						
2200						
Notes:	EOB = End Of Borehole	UTP = Unable To Penetrate	UTE = Unable To Extract
1	Weather leading up to test was:		
2	Ground water was not encountered during testing		
3	Shear Vane readings are converted readings, as per calibration Certificate. (Values are undrained shear strength)		
4	Shear Vane records include Re-moulded values where possible		
5	Shear Vane Serial No.: 2641	Exp. Date: 02/06/2021	



DB CONSULTING ENGINEERS

Project Name Area M, Stage 13, Greenhill Park, Hamilton		Job Ref. 171738-AREA-M-S13-01	
Tested by Jessel Lawda	Date 28/01/2021	Sheet No. 15	Test Site Lot 371

Depth (mm)	Undrained Shear (kPa)	No of blows /100mm	Scala Penetrometer (Blows/100mm)		Soil Description	Water Table
			0	2 4 6 8 10 12 14 16		
100		7			Topsoil	
200		7				
300		14			UTP @ 0.3m due to coarse gravel	
400		13				
500		6				
600		6				
700		6				
800		5				
900		6				
1000						
1100						
Notes:	EOB = End Of Borehole	UTP = Unable To Penetrate	UTE = Unable To Extract
1	Weather leading up to test was:		
2	Ground water was not encountered during testing		
3	Shear Vane readings are converted readings, as per calibration Certificate. (Values are undrained shear strength)		
4	Shear Vane records include Re-moulded values where possible		
5	Shear Vane Serial No.: C365	Exp. Date: 04/02/2021	



DB CONSULTING ENGINEERS

Project Name Area M, Stage 13 Greenhill Park, Hamilton		Job Ref. 171738-AREA-M-S13-01	
Tested by Jessel Lawda	Date 18/02/2021	Sheet No. 21	Test Site Lot 371a

Depth (mm)	Undrained Shear (kPa)	No of blows /100mm	Scala Penetrometer (Blows/100mm)		Soil Description	Water Table
			0	2 4 6 8 10 12 14 16		
100		3			Topsoil, silt	
200		3				
300		6				
400		67			Silt, greyish brown, moist (FILL)	
500		6				
600		4				
700	180+/-					
800					Silty CLAY, brownish orange, moist (NATURAL)	
900	180+/-					
1000						
1100						
1200	115/65					
1300						
1400						
1500	87/43				Clay, trace silt, brownish orange, moist (NATURAL)	
1600						
1700						
1800						
1900						
2000					EOB @ 2m	
2100						
2200						
Notes:	EOB = End Of Borehole	UTP = Unable To Penetrate	UTE = Unable To Extract
1	Weather leading up to test was:		
2	Ground water was not encountered during testing		
3	Shear Vane readings are converted readings, as per calibration Certificate. (Values are undrained shear strength)		
4	Shear Vane records include Re-moulded values where possible		
5	Shear Vane Serial No.: 2641	Exp. Date: 02/06/2021	



Project Name Area M, Stage 13, Greenhill Park, Hamilton		Job Ref. 171738-AREA-M-S13-01	
Tested by RG	Date 28/01/2021	Sheet No. 16	Test Site Lot 372

Depth (mm)	Undrained Shear (kPa)	No of blows /100mm	Scala Penetrometer (Blows/100mm)		Soil Description	Water Table
			0	2 4 6 8 10 12 14 16		
100					Topsoil with silt.	
200						
300	180+/-					
400					CLAY, some silt, brownish orange, very stiff, moist.	
500						
600	180+/-					
700					CLAY, trace silt, brownish orange, very stiff, moist.	
800						
900	180+/-					
1000					CLAY, some silt, brownish orange, streaked white, very stiff, moist.	
1100						
1200						
1300	180+/-					
1400					Silty CLAY, light brown, moist, streaked white, trace mica, very stiff, moist.	
1500						
1600	180+/-					
1700					EOB at 2.0m	
1800						
1900	140/50					
2000						
2100						
Notes:	EOB = End Of Borehole UTP = Unable To Penetrate UTE = Unable To Extract
1	Weather leading up to test was:
2	Ground water was not encountered during testing
3	Shear Vane readings are converted readings, as per calibration Certificate. (Values are undrained shear strength)
4	Shear Vane records include Re-moulded values where possible
5	Shear Vane Serial No.: 2641 Exp. Date: 02/06/2021



Project Name Area M, Stage 13, Greenhill Park, Hamilton		Job Ref. 171738-AREA-M-S13-01	
Tested by RG	Date 28/01/2021	Sheet No. 17	Test Site Lot 373

Depth (mm)	Undrained Shear (kPa)	No of blows /100mm	Scala Penetrometer (Blows/100mm)		Soil Description	Water Table
			0	2 4 6 8 10 12 14 16		
100					Topsoil	
200						
300	180+/-					
400						
500					CLAY, some silt, brownish orange, very stiff, moist.	
600	180+/-					
700						
800						
900	UTP				CLAY, trace silt, trace sand, trace mica, brownish orange, dry.	
1000						
1100						
1200	180+/-					
1300					CLAY, some silt, brownish orange, very stiff, moist.	
1400						
1500						
1600	130/28					
1700					Silty CLAY, brownish orange, very stiff, moist.	
1800						
1900	121/31					
2000					EOB at 2.0m	
2100						
2200						
Notes:	EOB = End Of Borehole UTP = Unable To Penetrate UTE = Unable To Extract
1	Weather leading up to test was:
2	Ground water was not encountered during testing
3	Shear Vane readings are converted readings, as per calibration Certificate. (Values are undrained shear strength)
4	Shear Vane records include Re-moulded values where possible
5	Shear Vane Serial No.: 2641 Exp. Date: 02/06/2021



DB CONSULTING ENGINEERS

Project Name Area M, Stage 13, Greenhill Park, Hamilton		Job Ref. 171738-AREA-M-S13-01	
Tested by Jessel Lawda	Date 28/01/2021	Sheet No. 18	Test Site Lot 374

Depth (mm)	Undrained Shear (kPa)	Scala Penetrometer (Blows/100mm)		Soil Description	Water Table
		0	2 4 6 8 10 12 14 16		
100				Topsoil	▼
200					
300	120+				
400				Silty CLAY, minor sand, light brown	
500					
600	120+			Silty CLAY, light brown	
700					
800					
900	139/49				
1000				Clayey SILT, trace sand, dark brown streaked white	
1100					
1200	120+				
1300					
1400					
1500	120+				
1600				Clayey SILT, light brown, very stiff, low plasticity,	
1700					
1800					
1900	120+				
2000				EOB @ 2m	
2100					
2200					
Notes:		EOB = End Of Borehole	UTP = Unable To Penetrate	UTE = Unable To Extract
1	Weather leading up to test was:			
2	Ground water was not encountered during testing			
3	Shear Vane readings are converted readings, as per calibration Certificate. (Values are undrained shear strength)			
4	Shear Vane records include Re-moulded values where possible			
5	Shear Vane Serial No.: C365	Exp. Date: 04/02/2021		

Appendix V Stormwater Management
On-lot Water Efficiency Measures
Lot Levels (Minimum Lot Levels)

ON-LOT WATER EFFICIENCY MEASURES

WATER SUPPLY AND WASTEWATER DISPOSAL

The efficiency of taps, showers and toilets contribute to how much water we use. A reduction in the use of potable water by each house directly relates to the amount of wastewater generated (i.e. reduced water use results in reduced wastewater generation). To reduce potable water demand and the amount of wastewater generated, as a minimum, each house is required to install low demand fittings for kitchen, bathroom and laundry facilities.


All household fittings are required to have a minimum 3 Star Rating.

STORMWATER DISPOSAL

Each lot is required to adopt an on-lot stormwater efficiency measure to ensure that surface water runoff is appropriately managed.

First, the suitability of the site for soakage needs to be assessed. Soakage is the process of helping stormwater soak into the ground using specially designed soakage devices. Soakage allows for the infiltration of stormwater into the soil which recharges the groundwater table below.

A site infiltration test is mandatory for all lots to confirm the in-situ soils are capable of achieving the minimum percolation rates. Refer to Hamilton City Council 'Three Waters Practice Note HCC 03: Soakage' for guidance on soil testing.

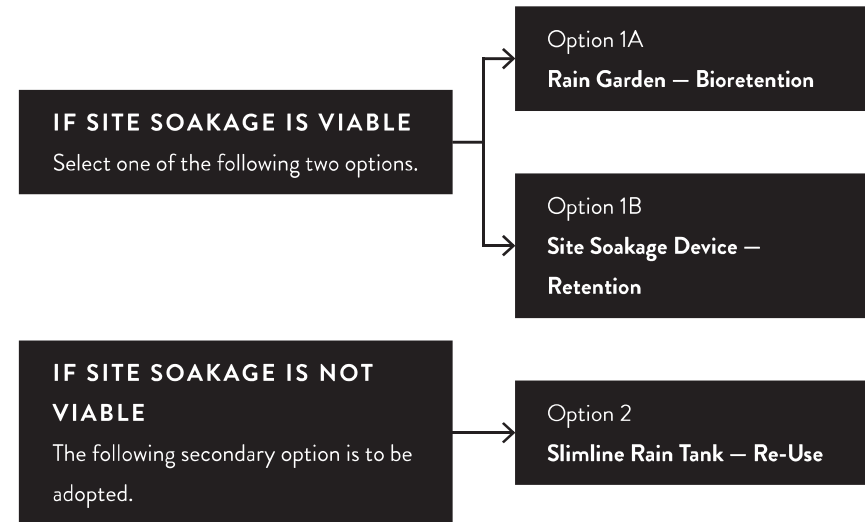

* Other alternative stormwater efficiency options will also be considered subject to approval by Greenhill Park and Hamilton City Council.

The selected option is to be designed by a suitably qualified Engineer and approved by the Hamilton City Council Building Control Unit. Refer to page 33 to 36 of these guidelines for further information of the design requirements for Options 1A, 1B & 2.

Hamilton City Council also encourages the installation of multiple stormwater efficiency options within a property, where practical.

Option 1A

RAIN GARDEN – BIORETENTION

Design to provide minimum 'live storage' retention for runoff from a 10mm rainfall event for trafficked hardstand areas.

The following table outlines indicative storage volumes and estimated rain garden areas for a range of lot sizes.

Lot Area (m ²)	Live Storage Volume (m ³)	Rain Garden Area (m ²)
300	0.8	4.1
350	0.9	4.7
400	1.1	5.4
450	1.2	6.1
500	1.4	6.8
550	1.5	7.4

Based on hardstand coverage equal to 30% of total lot area

KEY REQUIREMENTS

- Rain garden to be located to capture runoff from main hardstand areas within the lot (as much as practical).
- Maximum live storage depth to be 300mm (safety requirements to be considered when device is at maximum storage capacity).
- A channel and grate to be installed across vehicle entrance to capture hardstand run off and direct it to rain garden.

- Rain garden to be integrated with garden design (refer to page 34 for details).
- Overflow to be connected to stormwater connection provided.

FOR MORE INFORMATION

Refer to Hamilton City Council 'Three Waters Practice Note – HCC04 – Bio-retention (Rain Gardens)' for information on typical design requirements.

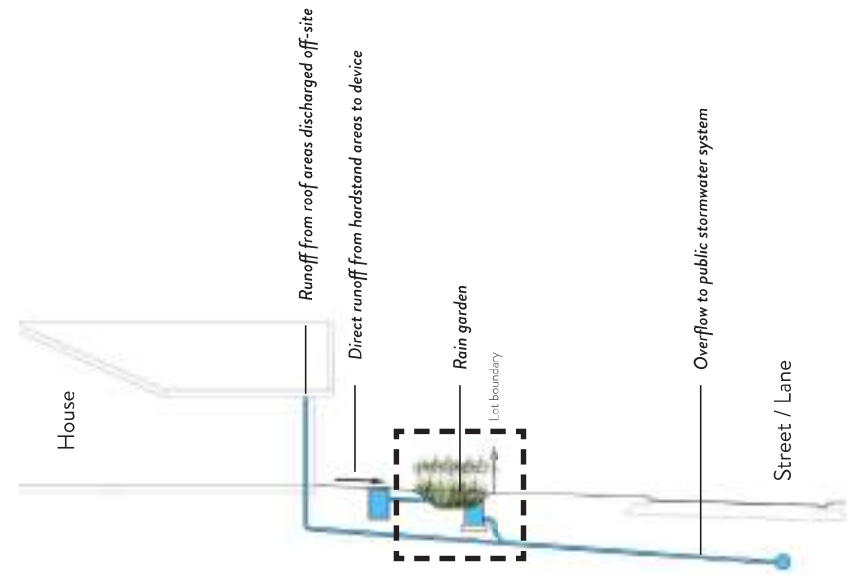


DIAGRAM — 7
Rain Garden – Bioretention

GREENHILL PARK RAIN GARDEN PLANT LIST

Native plants are encouraged, but other exotic plant species which complement your front yard planting design could be used. Deciduous plants should not be used as their leaf-fall can block the outflow.

The plants selected need to —

- Be able to tolerate short periods of inundation and longer dry periods
- Be perennial rather than annual
- Have deep fibrous root systems and a spreading growth form
- Form a dense, weed-suppressing cover



Botanical Name	Common Name
Apodasmia similis	oioi
Blechnum penna-marina	alpine hard fern
Libertia ixioides	mikoikoi
Carex dipsacea	teasel sedge
Carex secta	purei
Carex virgata	pukio
Dianella nigra	turutu
Libertia grandiflora	mikoikoi
Lobelia angulata	panakenake
Pimelea prostrata	pinatoro

All rain garden plants to be a minimum grade of Pb 8 at the time of planting. * Other plant species can be approved at the discretion of the Design Review Panel.

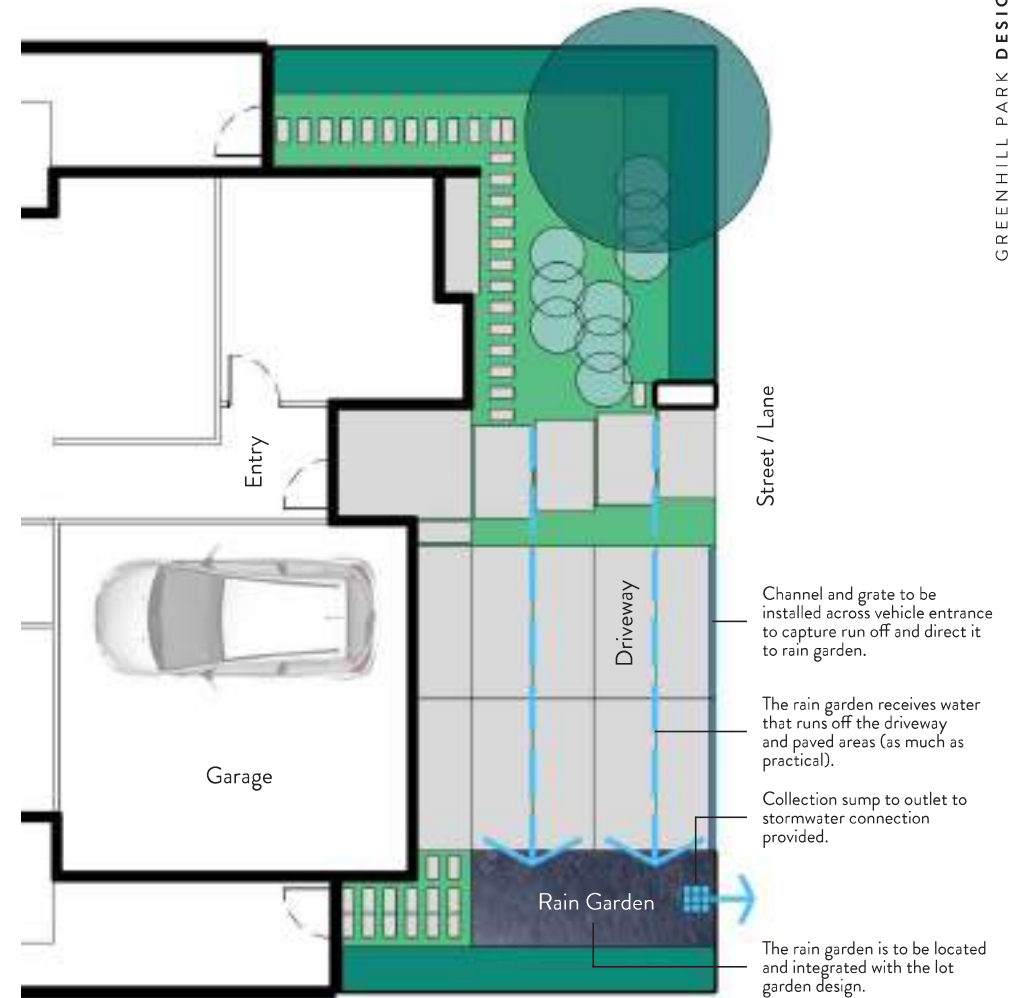


DIAGRAM — 8
Rain Garden Typical Location

Option 1B

SITE SOAKAGE DEVICE – RETENTION

Design to provide minimum 'live storage' retention for runoff from a 10mm rainfall event for roof and trafficked hardstand areas.

The following table outlines indicative storage volumes for a range of lot sizes.

Lot Area (m ²)	Live Storage Volume (m ³)
300	2.2
350	2.6
400	3.0
450	3.4
500	3.7
550	4.1

Based on 80% site coverage (roof and hardstand areas)

KEY REQUIREMENTS

- Soakage device(s) to be located to capture runoff from roof downpipes and hardstand areas (as much as practical).
- A channel and grate to be installed across vehicle entrance to capture hardstand run off and direct it to soakage device.
- Soakage device to be integrated with garden design.
- Overflow to be connected to stormwater connection provided.

FOR MORE INFORMATION

Refer to Hamilton City Council 'Three Waters Practice Note HCC 03: Soakage' for information on typical design requirements.

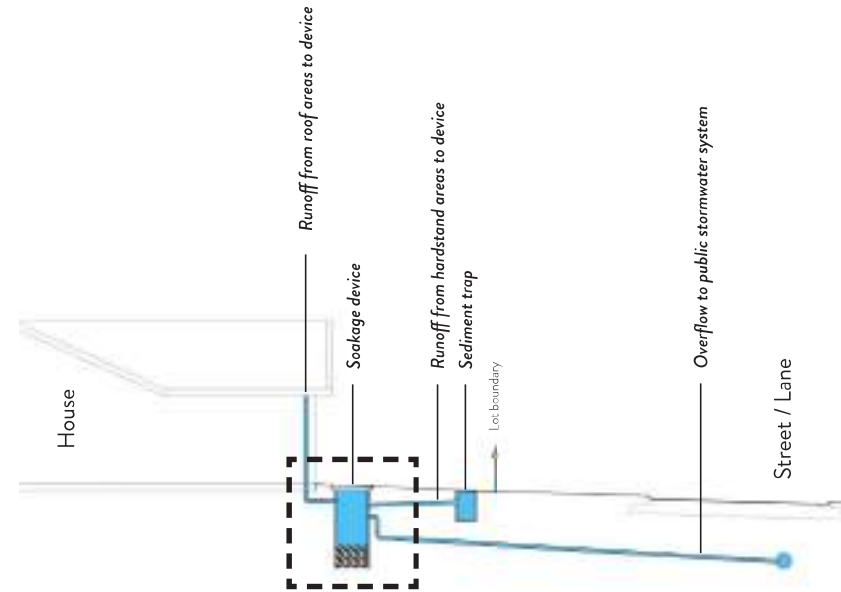


DIAGRAM — 9
Site Soakage Device – Retention

Option 2

SLIMLINE RAIN TANK – RE-USE

The slimline rain tank is to be connected to a separate grey-water household re-use system with a minimum capacity of 5,000L.

KEY REQUIREMENTS

- Rain tank to be connected into a fully integrated grey-water re-use system within the main dwelling with connections to toilets, laundry and irrigation systems.
- All roof run-off is to be captured by rain tanks and available for re-use. Run-off from hardstand areas (driveways and paving) can be discharged directly into stormwater connection provided.
- A maximum of two (2) tanks may be used to achieve the required storage and align with downpipe locations.
- Overflow to be connected to stormwater connection provided.

LOCATION AND INSTALLATION

Slimline rain tanks should be placed in the rear or side yard of the lot as unobtrusively as possible. Care should be taken, where tanks are placed next to the house, to ensure they are placed adjacent to a blank wall and not in front of a window.

COLOUR

The colour of all rain tanks should match the colour of the homes exterior wall cladding adjacent to the tank.

* Colours that do not match but are complementary to the design and materials of the house can be approved at the discretion of the Design Review Panel.

FOR MORE INFORMATION

Refer to Hamilton City Council 'Three Waters Practice Note – HCC02 – Rainwater Re-use Systems (Rain Tanks)' for information on design requirements.

APPROVED RAIN TANK PRODUCTS

Tanksalot® Slimline Tank www.tanksalot.co.nz

ThinTanks™ NZ Slimline Rainwater Poly Tank www.thintanks.co.nz

* Other rain tank products will also be considered subject to approval by Greenhill Park.

Note below ground tanks (sealed tanks only) are also considered an appropriate design option and are pre-approved for use on this subdivision.

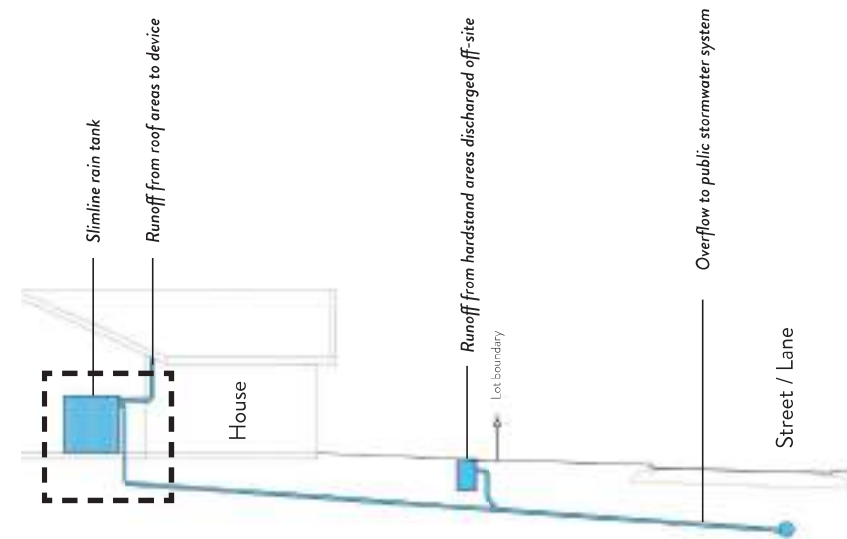


DIAGRAM – 10
Slimline Rain Tank – Re-use

Lot	Stage	Minimum Lot Level (mRL)	1% AEP Flood Level (mRL)	Flood Level Reference	Calculated Freeboard (to Lot Level - m)
347	12	38.703	36.46	Swale 3B	2.243
348	12	38.700	36.46	Swale 3B	2.240
349	12	38.751	36.46	Swale 3B	2.291
350	12	39.039	36.46	Swale 3B	2.579
351	12	39.109	36.46	Swale 3B	2.649
352	12	39.179	36.46	Swale 3B	2.719
353	12	39.248	36.46	Swale 3B	2.788
354	12	39.317	36.46	Swale 3B	2.857
355	12	39.393	36.46	Swale 3B	2.933
356	12	39.486	36.46	Swale 3B	3.026
357	13	38.500 ^a	38.00	Swale 1D	0.500
358	13	38.500 ^a	38.00	Swale 1D	0.500
359	13	38.500 ^a	38.00	Swale 1D	0.500
360	13	38.500 ^a	38.00	Swale 1D	0.500
361	13	38.670	38.00	Swale 1D	0.670
362	13	38.696	38.00	Swale 1D	0.696
363	13	38.925	38.00	Swale 1D	0.925
364	13	38.802	38.00	Swale 1D	0.802
365	13	38.681	38.00	Swale 1D	0.681
366	13	38.610	38.00	Swale 1D	0.610
367	13	39.145	38.00	Swale 1D	1.145
368	13	39.300	38.00	Swale 1D	1.300
369	13	39.448	38.00	Swale 1D	1.448
370	13	39.571	38.00	Swale 1D	1.571
371	13	39.713	38.00	Swale 1D	1.713
372	13	39.845	38.00	Swale 1D	1.845
373	13	39.987	38.00	Swale 1D	1.987
374	13	40.120	36.46	Swale 3B	3.660
375	14	39.017	37.24	Swale 1	1.777
376	14	39.095	37.24	Swale 1	1.855
377	14	39.170	36.40	Swale 3A	2.770
378	14	39.226	36.40	Swale 3A	2.826
379	14	39.174	36.40	Swale 3A	2.774
380	14	39.122	36.40	Swale 3A	2.722
381	14	39.069	36.40	Swale 3A	2.669
382	14	39.016	36.40	Swale 3A	2.616
383	14	39.162	36.40	Swale 3A	2.762
384	14	39.223	36.40	Swale 3A	2.823
385	14	39.305	36.40	Swale 3A	2.905
386	14	39.366	36.40	Swale 3A	2.966
387	14	39.427	36.40	Swale 3A	3.027

^a Lots 357-360 edited by DBCE to provide 0.5m minimum freeboard.

APPENDIX 2

Roading QA Documentation

Road Subgrade – 2(a)

- Drawing 21879-M-R3-AB Webb Dr (in lieu of strings)
- Drawing 21879-M-R4-AB Webb Dr (in lieu of strings)
- Drawing 21879-M-R7-AB Carrs Rd (in lieu of strings)
- Clegg Hammer Tests

Road Sub-Base 2(b)

- Sub- Base Strings
- Nuclear Densometer Results
- Benkelman Beam Test Results
- Sub-Base Clegg Hammer Tests
- GAP65 Material Tests

Road Basecourse 2(c)

- Basecourse strings
- Nuclear Densometer Results
- Benkelman Beam Test Results
- TNZ M/4 AP40 Material Tests

Surfacing & RAMM Data 2(d)

- HCC pavement RAMM data
- Surfacing RAMM data

APPENDIX 2(a)

Roading QA Documentation

Road Subgrade – 2(a)

- Drawing 21879-M-R3-AB Webb Dr (in lieu of strings)
- Drawing 21879-M-R4-AB Webb Dr (in lieu of strings)
- Drawing 21879-M-R7-AB Carrs Rd (in lieu of strings)
- Clegg Hammer Tests






NOTES:

DEPTHS CALCULATED FROM
ONLINE CONSTRUCTORS
MEASUREMENTS V DESIGN
SURFACE.

TARGET DEPTHS
WEBB DRIVE 0.40m
CARRS ROAD 0.40m

MEASUREMENTS TAKEN
TO BROWNROCK SUBGRADE
IMPROVEMENT LAYER

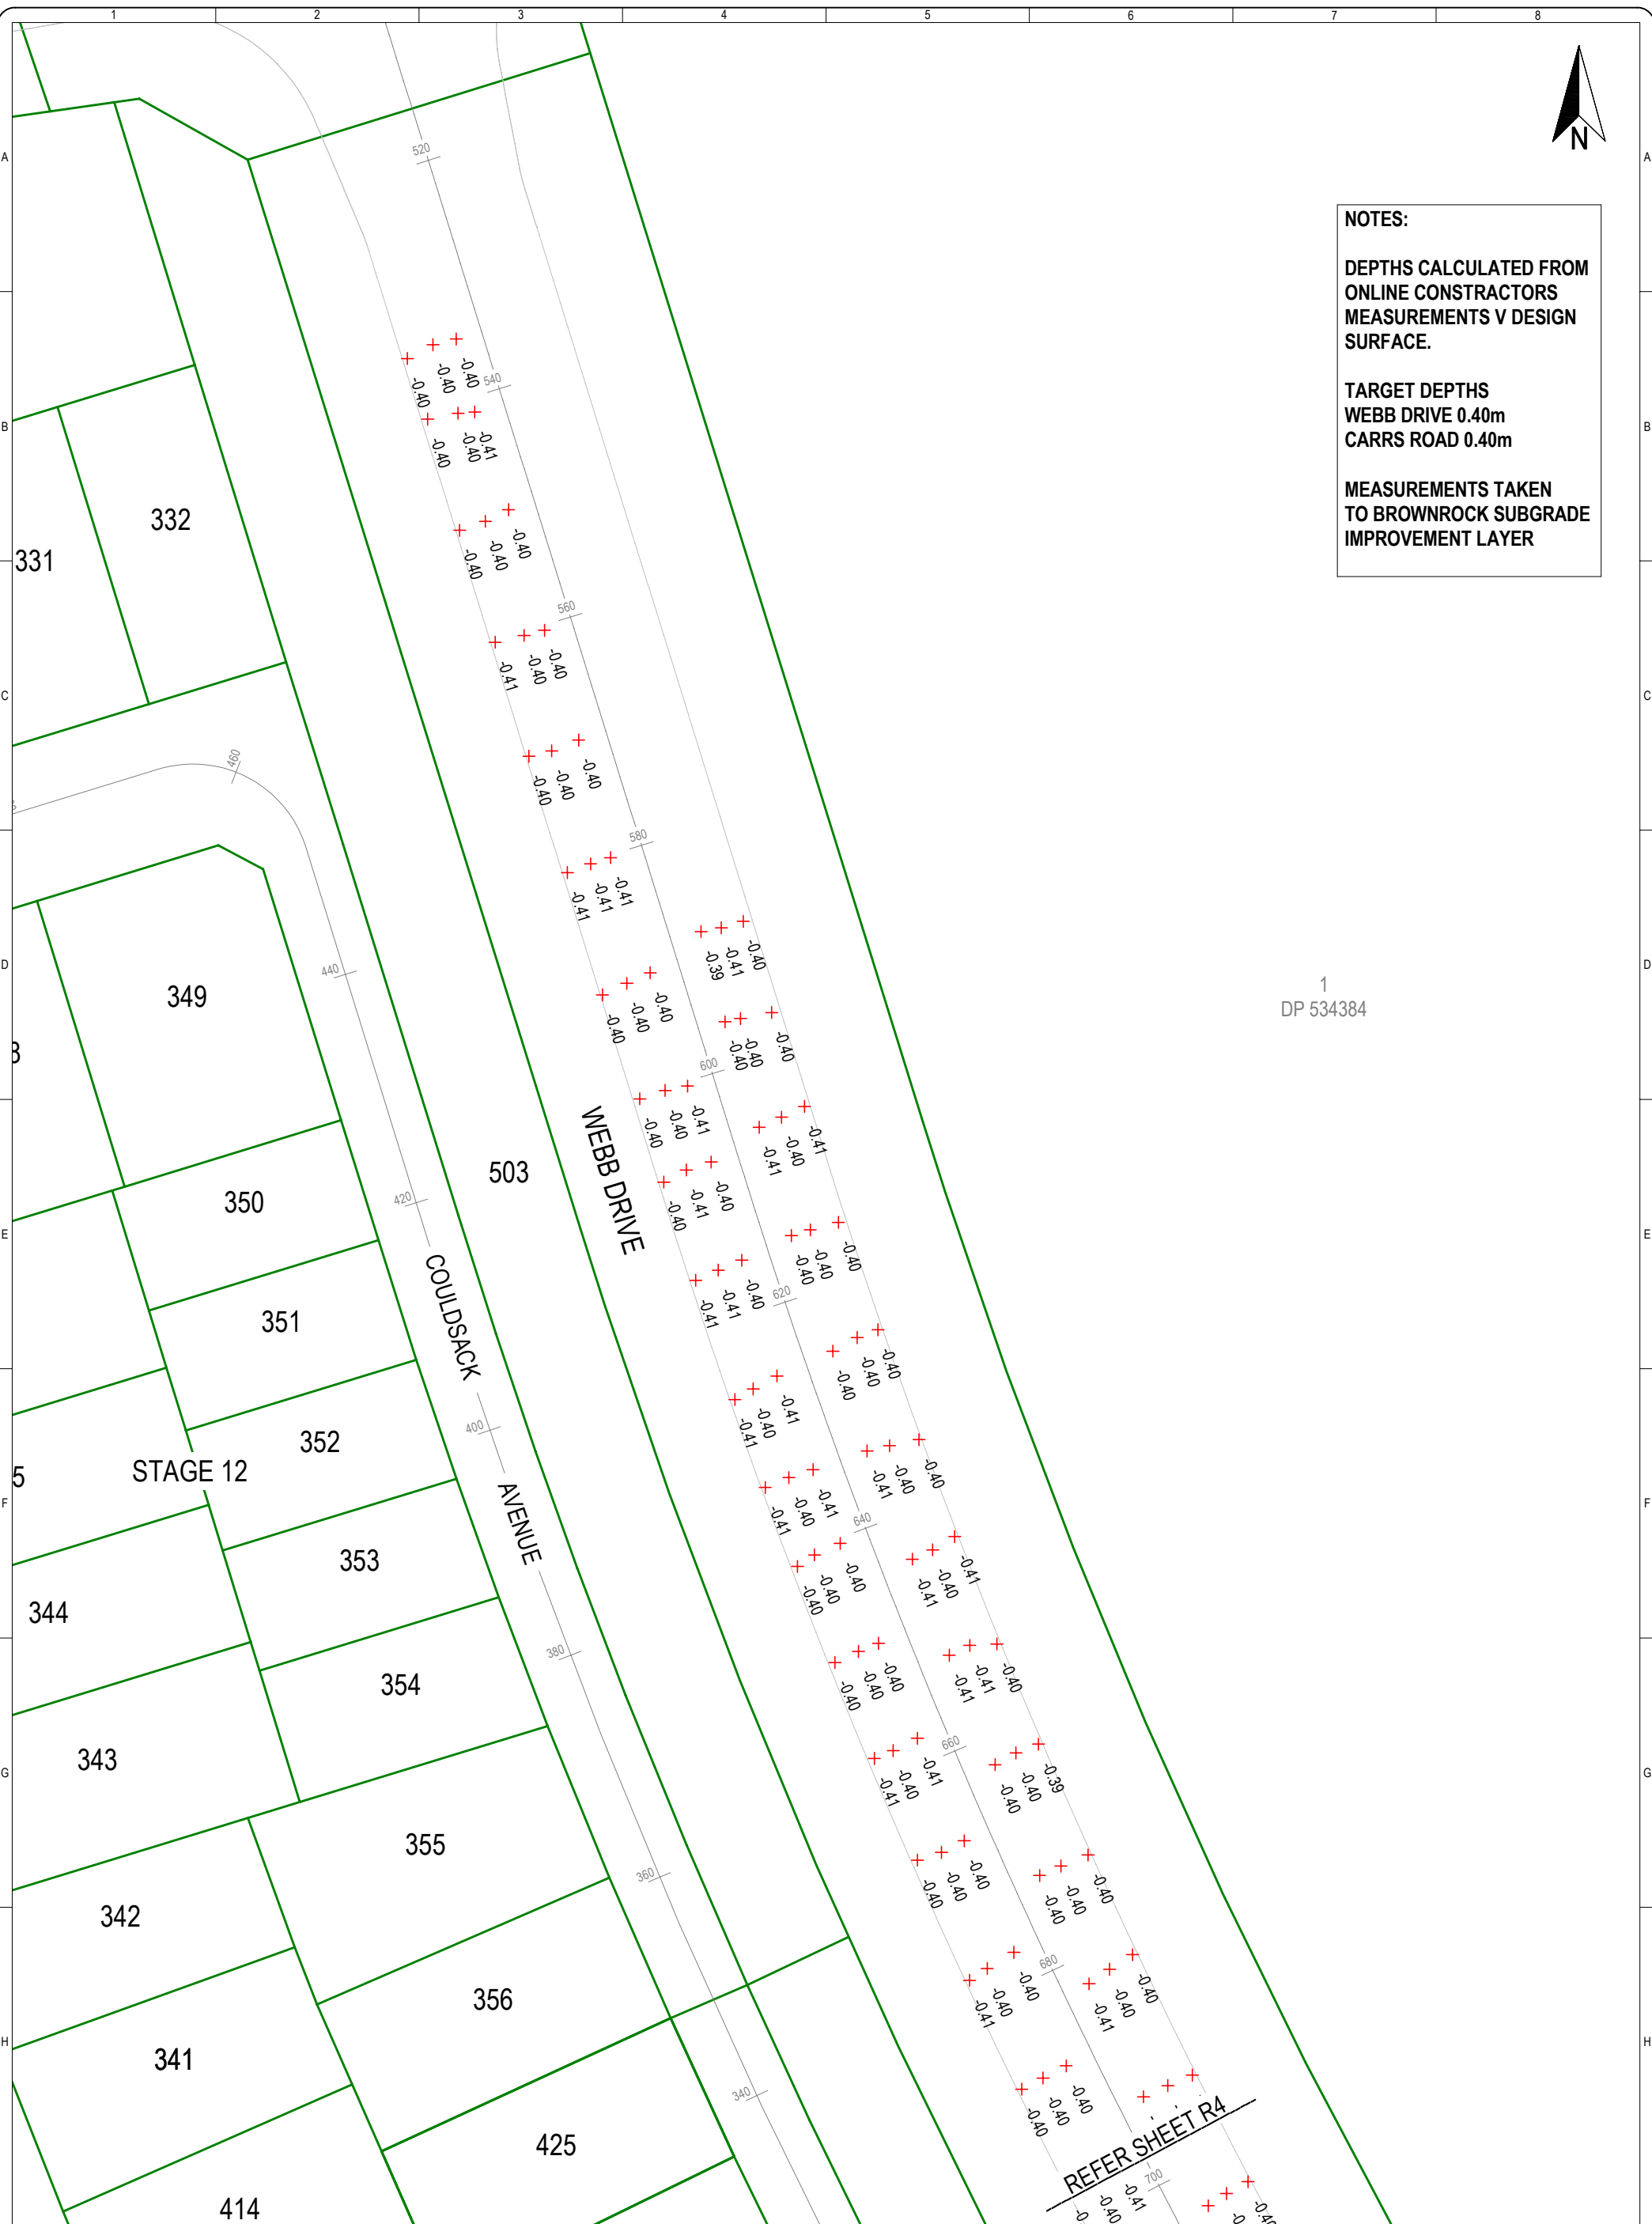

1
DP 534384

REFER SHEET R4



S&L
Land Development
and Design Specialists
Ph. 07 577 6069
Email: info@stga.co.nz
36 Kereiti Street, Mt Maunganui, Tauranga 3116
P.O. Box 231, Tauranga 3140
www.stga.co.nz

**QUALITY ASSURANCE
COMPARISON OF BROWNROCK V DESIGN
ROADING LAYOUT
WEBB DRIVE AREA M**



Rev	Description	Drn	Ckd	App	Date
AB	ISSUE TO HCC	SRC	KU	NF	11/20
0	INTERNAL REVIEW	SRC	KU	NF	11/20

Coordinate System: Mt Eden 2000 Circuit	
Origin of Coordinates: ALP 3 DP 534481	
Height Datum: Moturiki Vertical Datum 1953	
Origin of Height: SS 507 SO 42451 RL = 44.04m	
Original Scales @ A3	Status
1:500	AS-BUILT
Do Not Scale Dimensions	
Drawing No	Revision
21879-M-R3	AB

Copyright on this drawing is reserved




NOTES:

DEPTHS CALCULATED FROM
ONLINE CONSTRUCTORS
MEASUREMENTS V DESIGN
SURFACE.

TARGET DEPTHS
WEBB DRIVE 0.40m
CARRS ROAD 0.40m

MEASUREMENTS TAKEN
TO BROWNROCK SUBGRADE
IMPROVEMENT LAYER

1
DP 534384

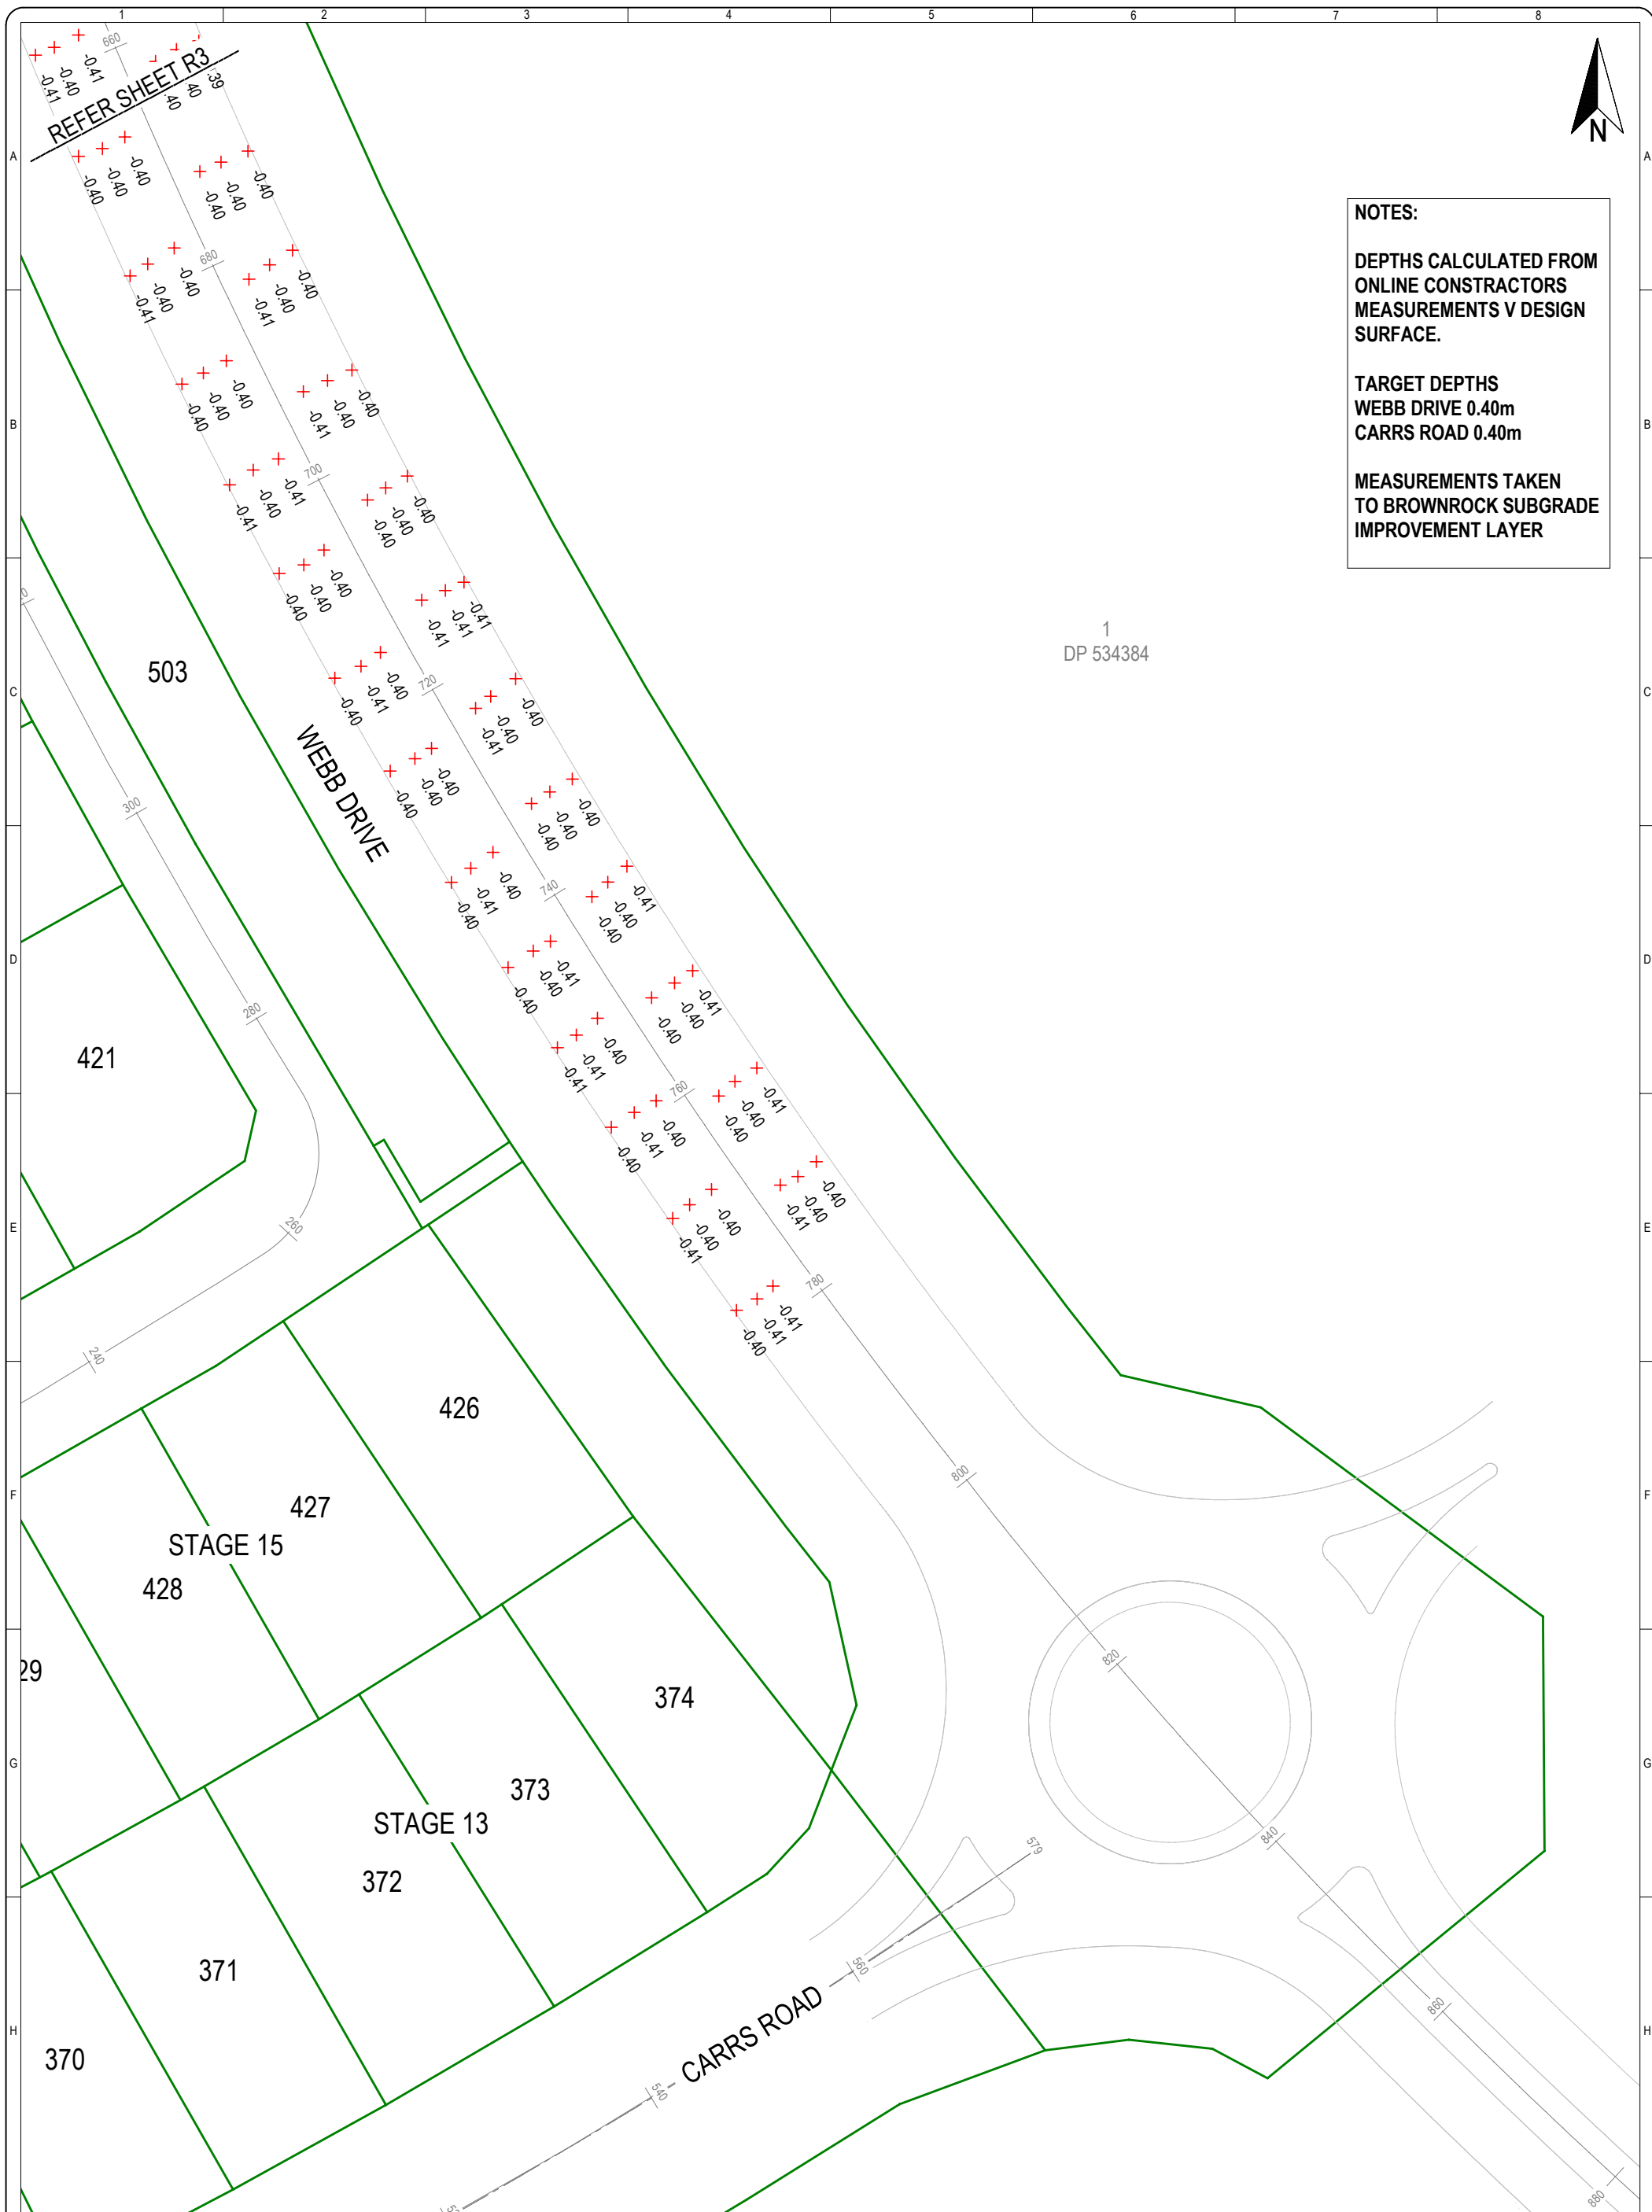

S&L
Land Development
and Design Specialists
Ph. 07 577 6069
Email: info@stlga.co.nz
36 Kereiti Street, Mt Maunganui, Tauranga 3116
P.O. Box 231, Tauranga 3140
www.stlga.co.nz

**QUALITY ASSURANCE
COMPARISON OF BROWNROCK V DESIGN
ROADING LAYOUT
WEBB DRIVE AREA M**



Rev	Description	Drn	Ckd	App	Date
AB	ISSUE TO HCC	SRC	KU	NF	11/20
0	INTERNAL REVIEW	SRC	KU	NF	11/20

Coordinate System: Mt Eden 2000 Circuit	
Origin of Coordinates: ALP 3 DP 534481	
Height Datum: Moturiki Vertical Datum 1953	
Original of Height: SS 507 SO 42451 RL = 44.04m	
Original Scales @ A3	Status
1:500	AS-BUILT
Do Not Scale Dimensions	
Drawing No	Revision
21879-M-R4	AB

Copyright on this drawing is reserved



NOTES:

DEPTHS CALCULATED FROM ONLINE CONSTRUCTORS MEASUREMENTS V DESIGN SURFACE.

TARGET DEPTHS
 CARRS ROAD 0.39m
 GUILLAUME STREET 0.26m

MEASUREMENTS TAKEN TO BROWNROCK SUBGRADE IMPROVEMENT LAYER

AB	ISSUE TO HCC	SRC	KU	NF	12/2020
0	INTERNAL REVIEW	SRC	KU	NF	12/2020
Rev	Description	Drm	Ckd	App	Date
	Name	Date	Name	Date	
E	Surveyed	ONLINE	12/2020	Designed	

Coordinate System: MT EDEN 2000 CIRCUIT
 Origin of Coordinates: ALP 3 DP 534481
 Height Datum: MOTURIKI DATUM 1953
 Origin of Height: SS 507 SO 42451 RL = 44.04m

S&L

S&L
 Land Development
 and Design Specialists

Ph. 07 577 6069
 Email: info@sltga.co.nz
 36 Kereiti Street, Mt Maunganui, Tauranga 3116
 P.O. Box 231, Tauranga 3140
 www.sltga.co.nz

Title

**QUALITY ASSURANCE
 COMPARISON OF
 BROWNROCK V DESIGN
 ROADING LAYOUT
 STAGE 13 AREA M**



Original Scales @ A3	Status
1:700	AS-BUILT
Do Not Scale Dimensions	
Drawing No	Revision
21879-M-R7	AB

COMPACTION - CLEGG TESTS

Contract	GHP	Job No.	
Site/Chainage	Stage 13 Carrs road	Date	1/12/2020
Material	Brown rock SIL	Recorded by	Emil Karlsson

Chn	1m from kerb - Left	Centre Line	1m from kerb - Right	Notes
330		35		
340			28	
350	26			
360		38		
370			24	
380	24			
390		29		
400			28	
410	26			
420		43		
430			24	
440	41			
450		54		
460			37	
470	21			
480		52		
490			35	
500	53			
510		65		
520			33	
530	46			
540		30		
550			32	
560	45			
570		25		
580			31	

Source of conversion: $Inferred\ CBR\% = 0.07(Impact\ Value)^2 / 100$

Remarks _____

COMPACTION - CLEGG TESTS

Contract	GHP Stage 12	Job No.	
Site/Chainage	Webb D East Lane	Date	5/11/2020
Material	Brown rock SIL	Recorded by	Emil Karlsson

Chn	1m from kerb - Left	Centre Line	1m from kerb - Right	Notes
590	62			
600			34	
610	35			
620			48	
630	28			
640			26	
650	36			
660			21	
670	28			
680			18	
690	26			
700			32	
710	28			
720			44	
730	32			
740			29	
750	33			
760			36	
770	24			

Source of conversion: $Inferred\ CBR\% = 0.07(Impact\ Value)^2 / 100$

Remarks _____

COMPACTION - CLEGG TESTS

Contract	Stage 12 GHP	Job No.	
Site/Chainage	Webb Dr West Lane	Date	3/11/2020
Material	Brown rock SIL	Recorded by	Tyler Mahi

Chn	1m from kerb - Left	Centre Line	1m from kerb - Right	Notes
530	65			
540			30	
550	57			
560			28	
570	41			
580			38	
590	30			
600			56	
610	40			
620			32	
630	58			
640			44	
650	45			
660			56	
670	36			
680			60	
690	68			
700			42	
710	58			
720			34	
730	32			
740			30	
750	37			
760			40	
770	43			
780			41	

Source of conversion: $Inferred\ CBR\% = 0.07(Impact\ Value)^2 / 100$

Remarks _____


APPENDIX 2(b)

Roading QA Documentation

Road Sub-Base 2(b)

- Sub- Base Strings
- Nuclear Densometer Results
- Benkelman Beam Test Results
- Sub-Base Clegg Hammer Tests
- GAP65 Material Tests



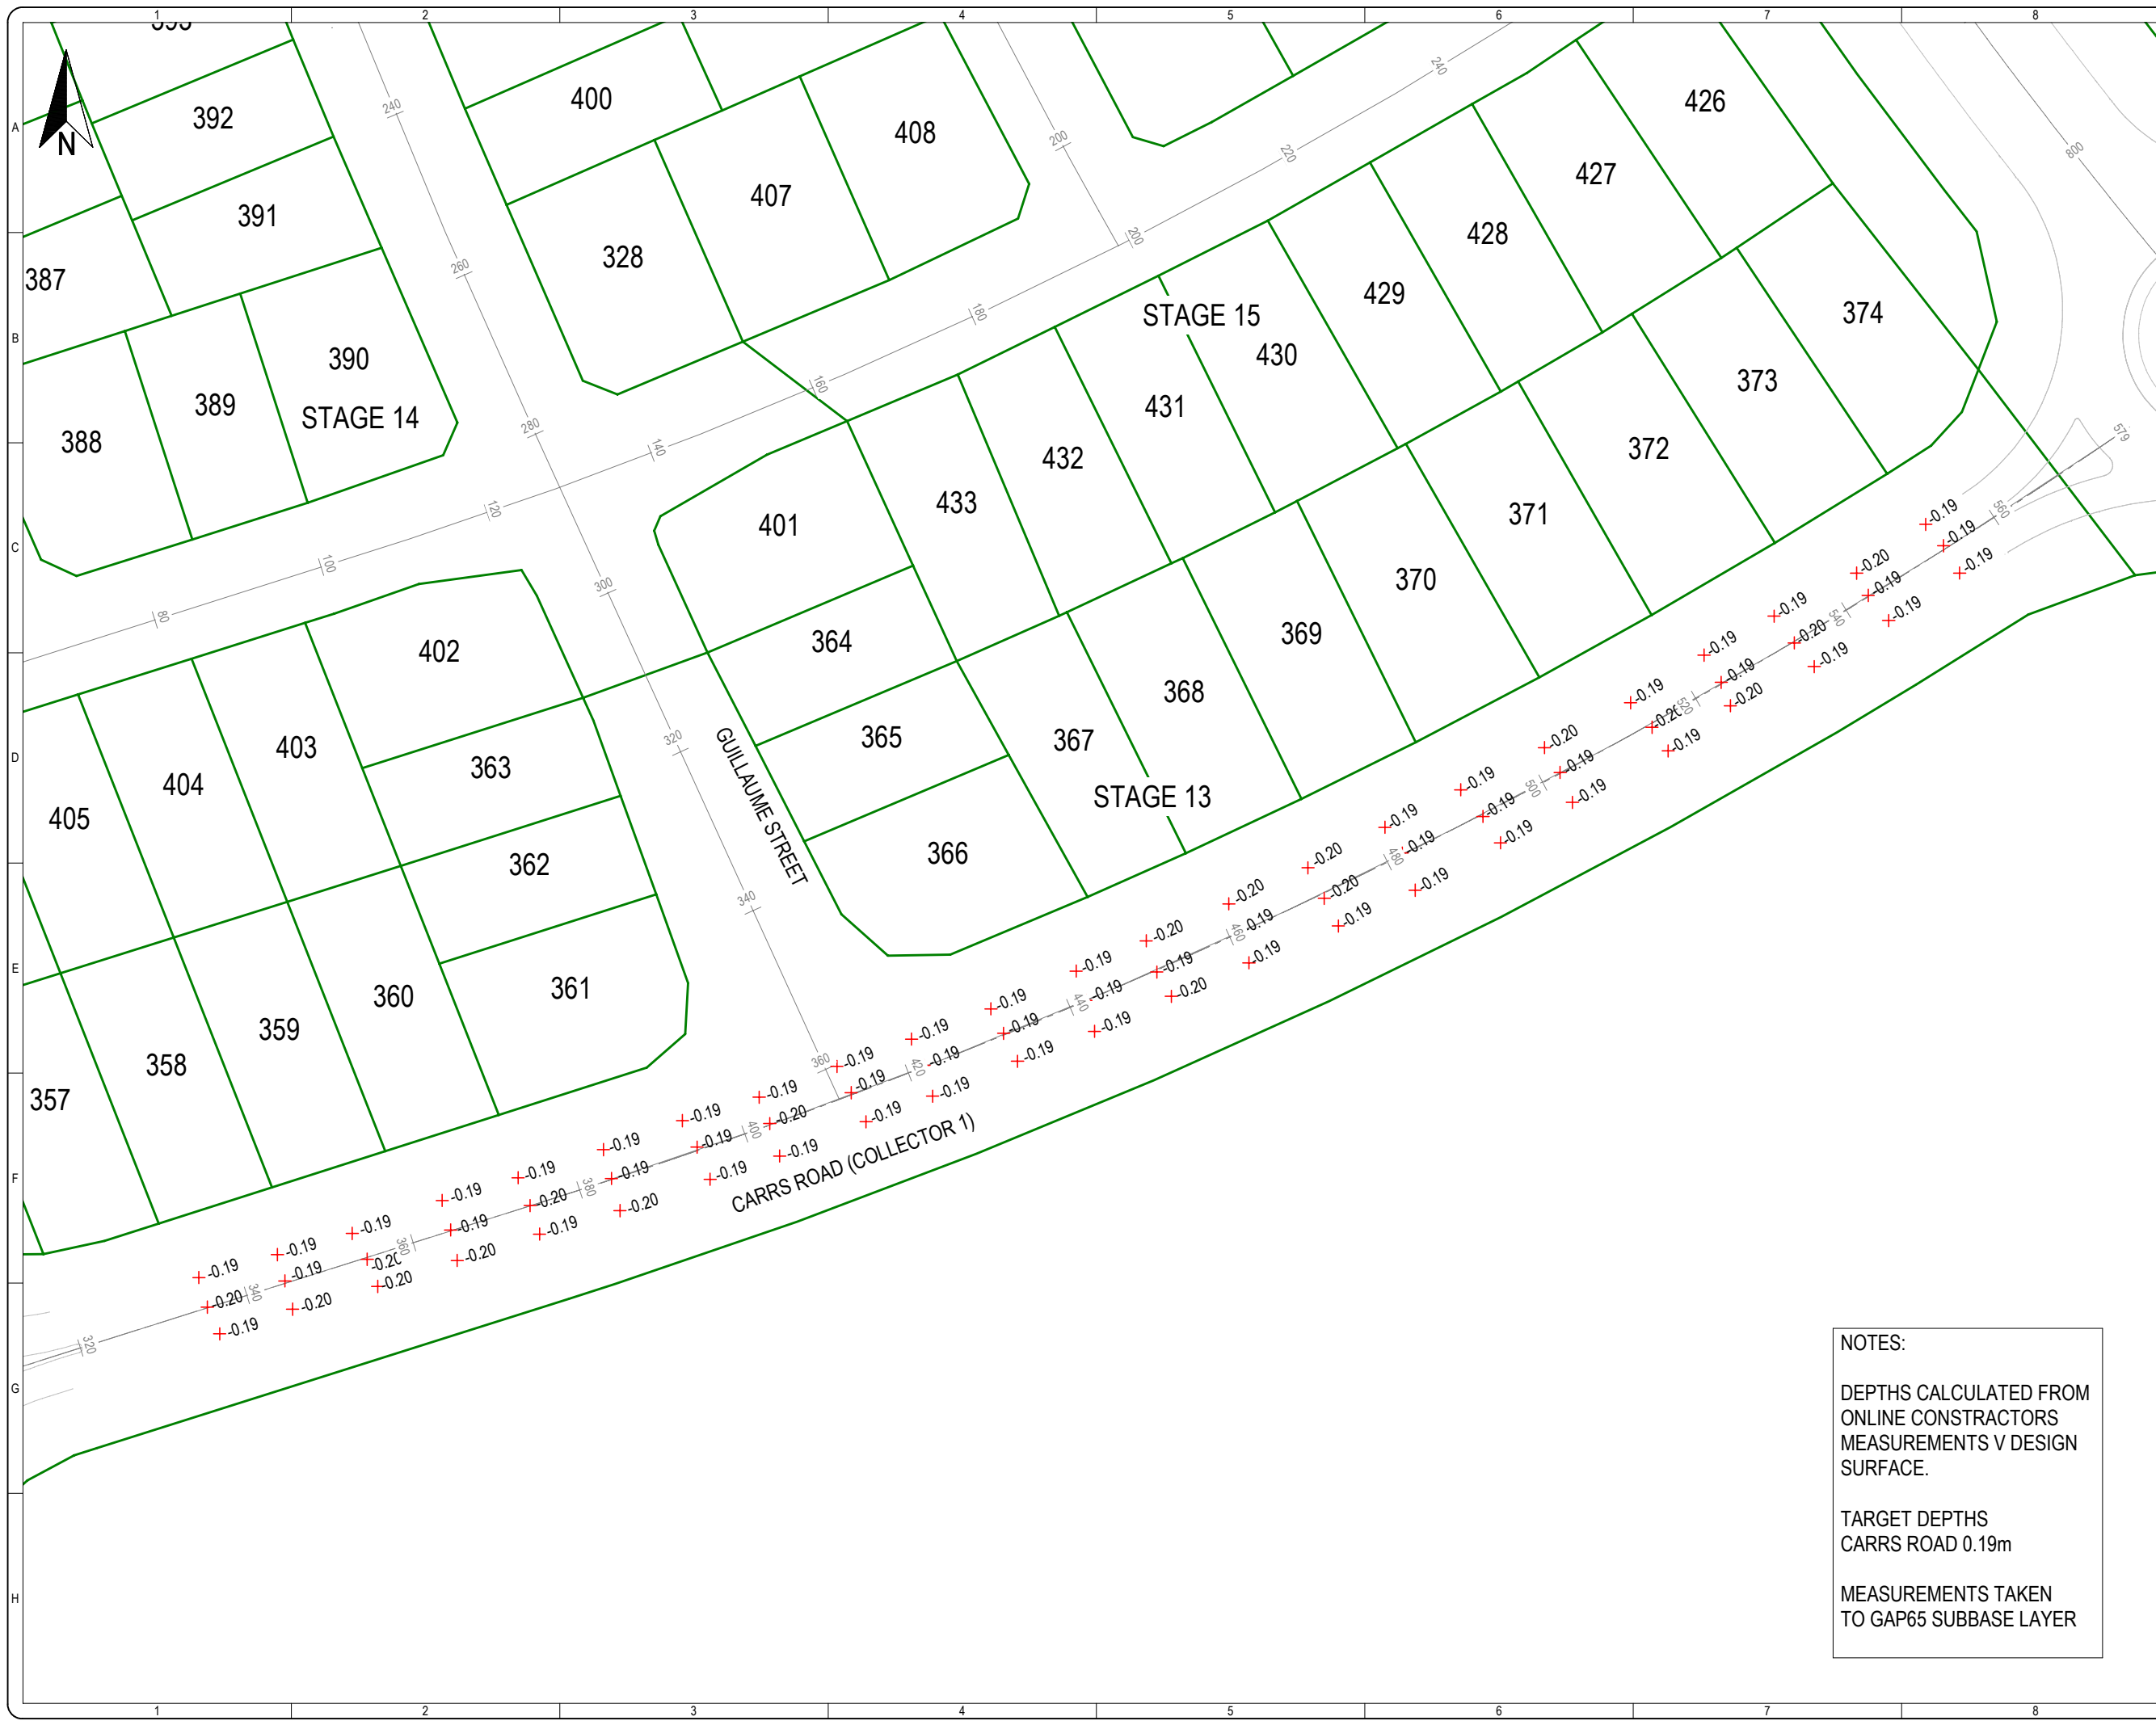


AB	ISSUE TO HCC	SRC	KU	NF	12/2020
0	INTERNAL REVIEW	SRC	KU	NF	12/2020
Rev	Description	Drm	Ckd	App	Date
	Name	Date		Name	Date
E	Surveyed	ONLINE	12/2020	Designed	

Coordinate System: MT EDEN 2000 CIRCUIT
 Origin of Coordinates: ALP 3 DP 534481
 Height Datum: MOTURIKI DATUM 1953
 Origin of Height: SS 507 SO 42451 RL = 44.04m

S&L
 S&L
 Land Development
 and Design Specialists
 Ph. 07 577 6069
 Email: info@sltga.co.nz
 36 Kereiti Street, Mt Maunganui, Tauranga 3116
 P.O. Box 231, Tauranga 3140
 www.sltga.co.nz

**QUALITY ASSURANCE
 COMPARISON OF
 GAP65 V DESIGN
 ROADING LAYOUT
 STAGE 13 AREA M**

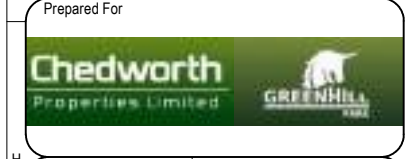

Original Scales @ A3	Status
1:700	AS-BUILT
Do Not Scale Dimensions	
Drawing No	Revision
21879-M-R8	AB

NOTES:

DEPTHS CALCULATED FROM
 ONLINE CONSTRUCTORS
 MEASUREMENTS V DESIGN
 SURFACE.

TARGET DEPTHS
 CARRS ROAD 0.19m

MEASUREMENTS TAKEN
 TO GAP65 SUBBASE LAYER

COMPACTION - CLEGG TESTS

Contract	GHP Stage 13	Job No.	
Site/Chainage	Carrs Road	Date	4/12/2020
Material	GAP 65 Subbase	Recorded by	Emil Karlsson

Chn	1m from kerb - Left	Centre Line	1m from kerb - Right	Notes
330			38	
340		43		
350	34			
360			45	
370		38		
380	44			
390			44	
400		46	53	
410	47			
420			61	
430		51		
440	55			
450			32	
460		29		
470	44			
480			52	
490		28		
500	31			
510			53	
520		44		
530	50			
540			50	
550		31		
560	34			
570			36	
580		52		

Source of conversion: $Inferred\ CBR\% = 0.07(Impact\ Value)^2 / 100$

Remarks _____



NOTES:

DEPTHS CALCULATED FROM
ONLINE CONSTRUCTORS
MEASUREMENTS V DESIGN
SURFACE.

TARGET DEPTHS:
WEBB DRIVE 0.23m

MEASUREMENTS TAKEN
TO GAP65 SUBBASE LAYER



1
DP 534384



S&L
Land Development
and Design Specialists
Ph. 07 577 6069
Email: info@sltga.co.nz
36 Kereiti Street, Mt Maunganui, Tauranga 3116
P.O. Box 231, Tauranga 3140
www.sltga.co.nz

Title

**QUALITY ASSURANCE
COMPARISON OF GAP65 V DESIGN
ROADING LAYOUT
WEBB DRIVE AREA M**




AB	ISSUE TO HCC	SRC	KU	NF	11/20
0	INTERNAL REVIEW	SRC	KU	NF	11/20
Rev	Description	Drn	Ckd	App	Date
	Name	Date		Name	Date
Surveyed	Online	2020	Designed		

Coordinate System: Mt Eden 2000 Circuit	
Origin of Coordinates: ALP 3 DP 534481	
Height Datum: Moturiki Vertical Datum 1953	
Origin of Height: SS 507 SO 42451 RL = 44.04m	
Original Scales @ A3	Status
1:500	AS-BUILT
Do Not Scale Dimensions	
Drawing No	Revision
21879-M-R5	AB

Copyright on this drawing is reserved




NOTES:

DEPTHS CALCULATED FROM
ONLINE CONSTRUCTORS
MEASUREMENTS V DESIGN
SURFACE.

TARGET DEPTHS:
WEBB DRIVE 0.23m

MEASUREMENTS TAKEN
TO GAP65 SUBBASE LAYER

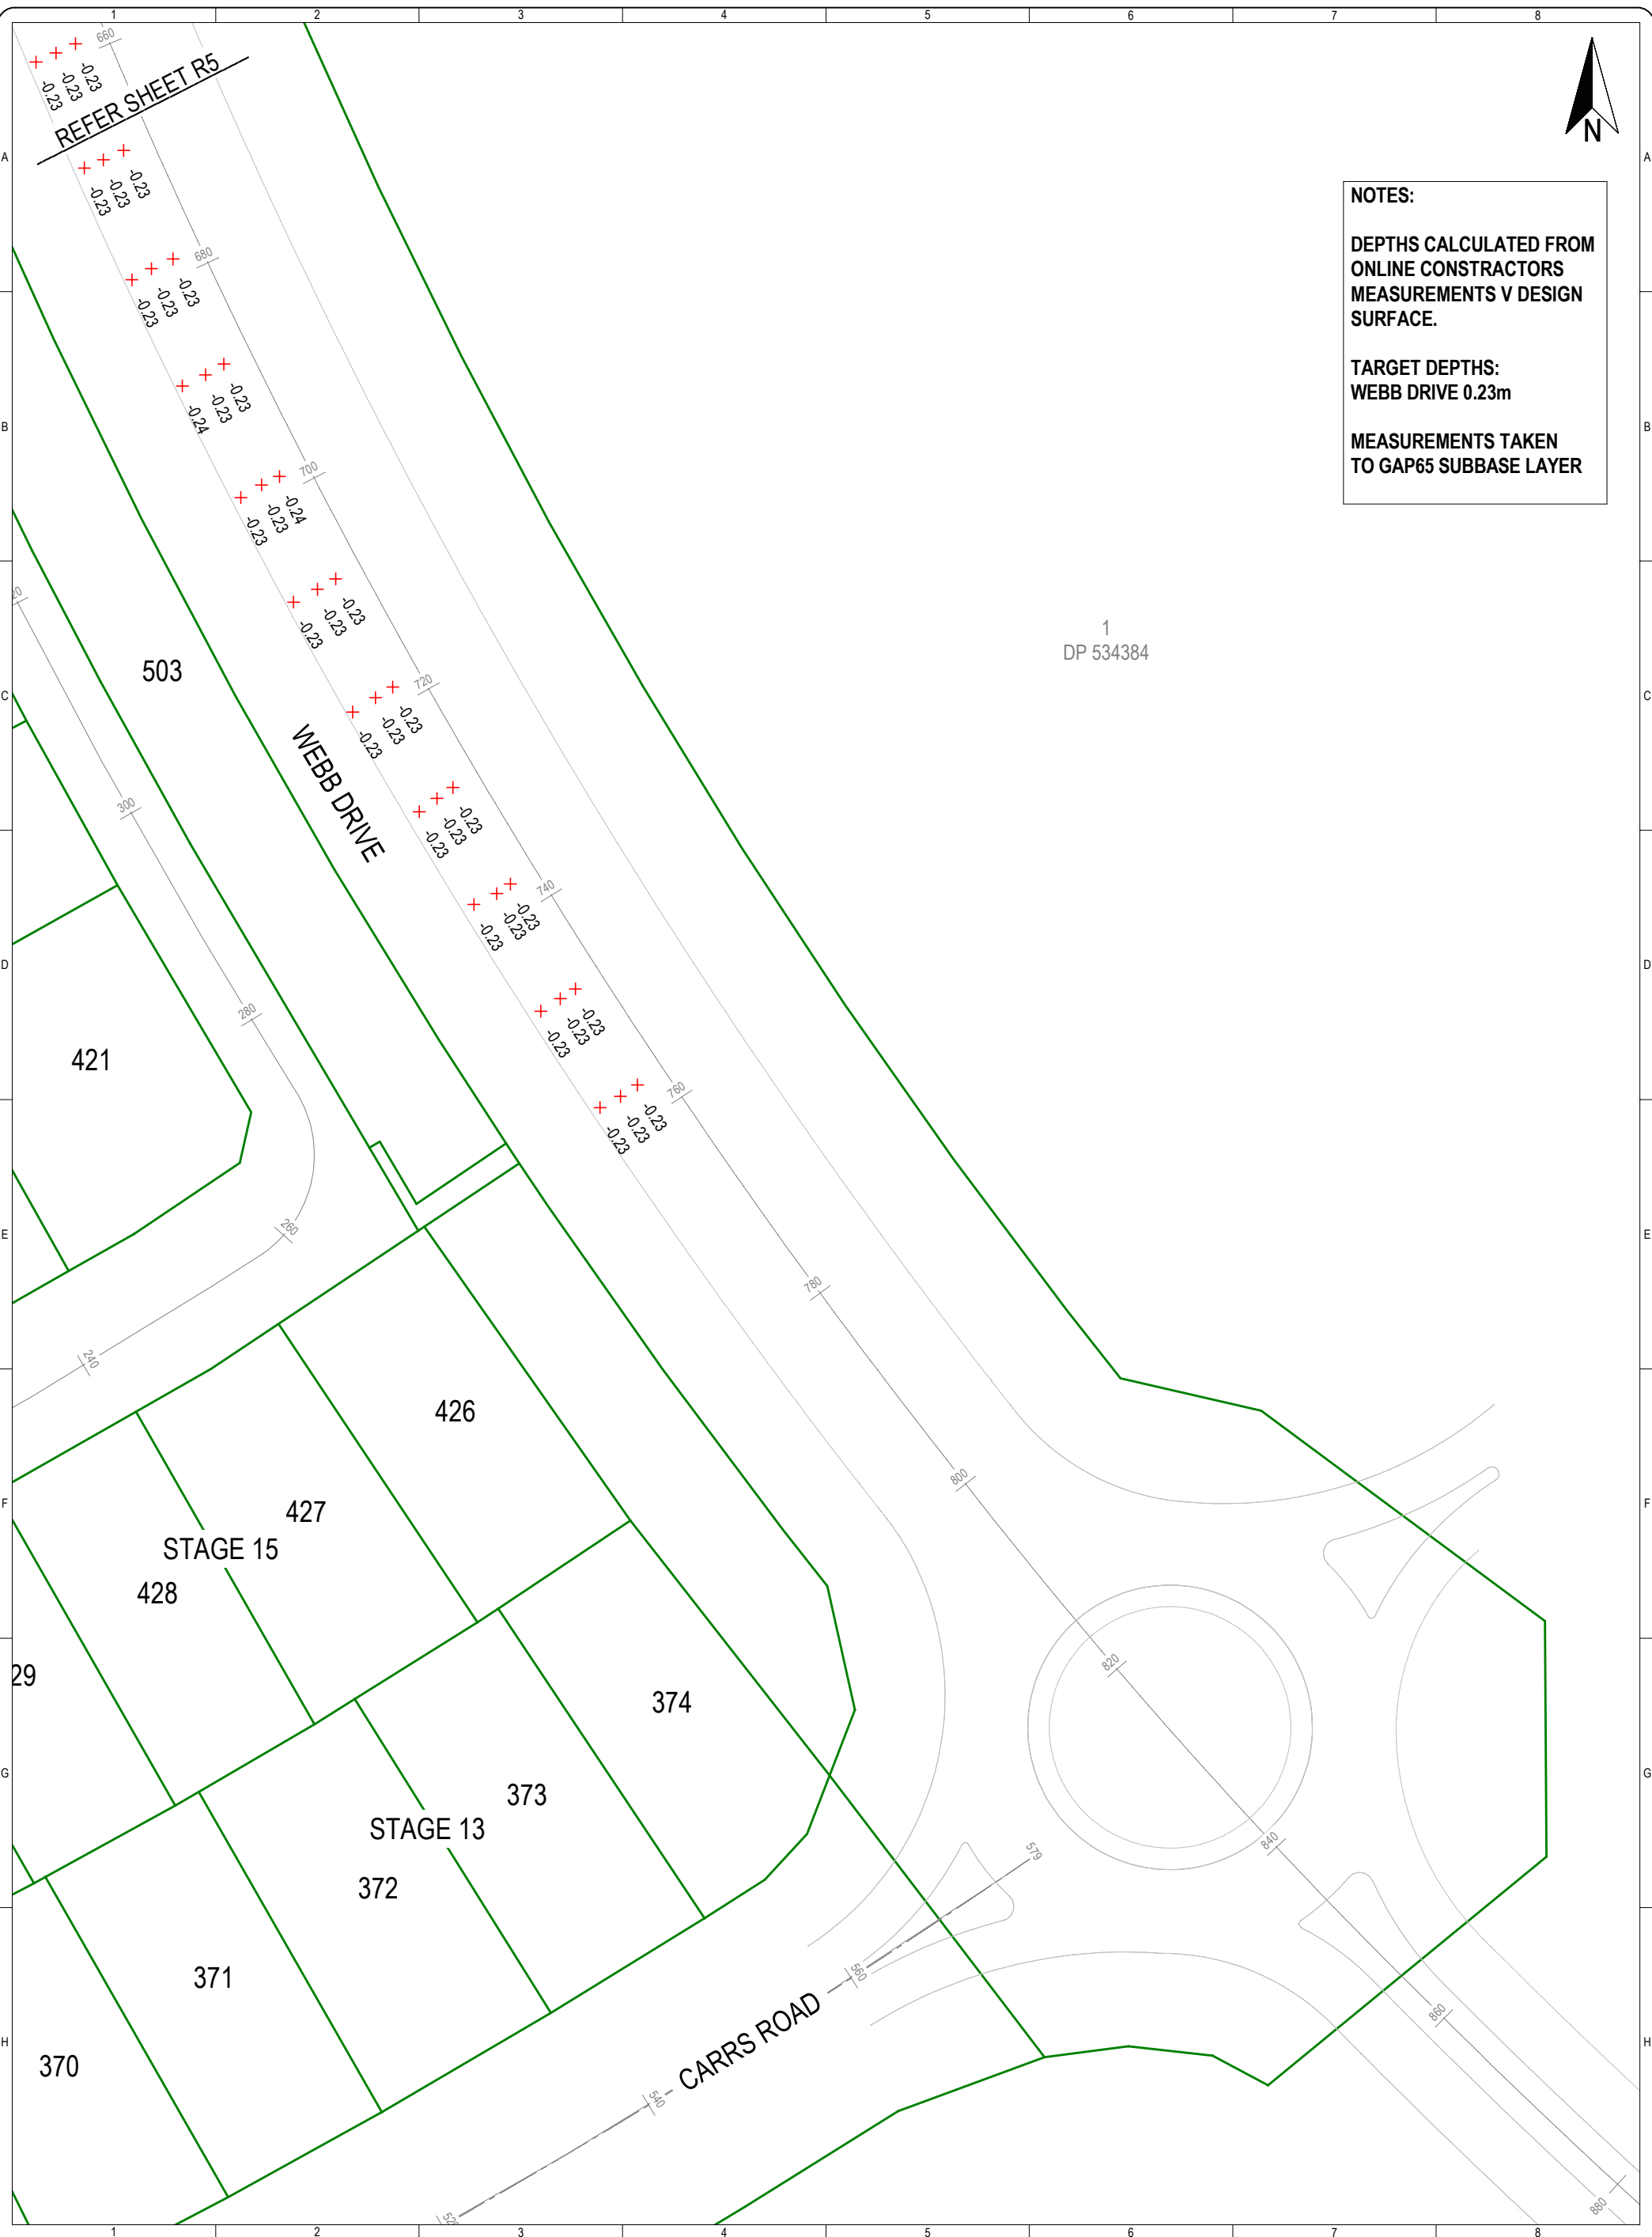

1
DP 534384



S&L
Land Development
and Design Specialists
Ph. 07 577 6069
Email: info@stlga.co.nz
36 Kereiti Street, Mt Maunganui, Tauranga 3116
P.O. Box 231, Tauranga 3140
www.stlga.co.nz

Title

**QUALITY ASSURANCE
COMPARISON OF GAP65 V DESIGN
ROADING LAYOUT
WEBB DRIVE AREA M**



AB	ISSUE TO HCC	SRC	KU	NF	11/20
0	INTERNAL REVIEW	SRC	KU	NF	11/20
Rev	Description	Drn	Ckd	App	Date
	Name	Date		Name	Date
Surveyed	Online	2020	Designed		

Coordinate System: Mt Eden 2000 Circuit	
Origin of Coordinates: ALP 3 DP 534481	
Height Datum: Moturiki Vertical Datum 1953	
Origin of Height: SS 507 SO 42451 RL = 44.04m	
Original Scales @ A3	Status
1:500	AS-BUILT
Do Not Scale Dimensions	
Drawing No	Revision
21879-M-R6	AB

Copyright on this drawing is reserved

COMPACTION - CLEGG TESTS

Contract	GHP Stage 13	Job No.	
Site/Chainage	Webb Dr West Lane CH 540-760	Date	10/11/2020
Material	GAP 65	Recorded by	Emil Karlsson

Chn	1m from kerb - Left	Centre Line	1m from kerb - Right	Notes
540	46			
550			44	
560	32			
570			50	
580	50			
590			45	
600	54			
610			51	
620	58			
630			51	
640	59			
650			60	
660	47			
670			54	
680	45			
690			48	
700	52			
710			55	
720	52			
730			48	
740	59			
750			46	
760	46			

Source of conversion: $Inferred\ CBR\% = 0.07(Impact\ Value)^2 / 100$

Remarks _____



P O Box 21187, Rototuna
 Hamilton, 3256
 Email: Todd@onlinecontractors.co.nz

Ph: 07 853 9422

COMPACTION - CLEGG TESTS

Contract	GHP Stage 13	Job No.	
Site/Chainage	Webb Dr West Lane	Date	4/12/2020
Material	GAP 65	Recorded by	Emil Karlsson

Chn	1m from kerb - Left	Centre Line	1m from kerb - Right	Notes
770			45	
780		45		
790	41			
800			35	
810		36		
820	39			
830			32	
840		52		
850	44			

Source of conversion: $Inferred\ CBR\% = 0.07(Impact\ Value)^2 / 100$

Remarks

COMPACTION - CLEGG TESTS

Contract GHP Stage 13 Job No. _____
 Site/Chainage Webb Dr West Lane CH 540-760 Date 10/11/2020
 Material GAP 65 Recorded by Emil Karlsson

Chn	1m from kerb - Left	Centre Line	1m from kerb - Right	Notes
540	46			
550			44	
560	32			
570			50	
580	50			
590			45	
600	54			
610			51	
620	58			
630			51	
640	59			
650			60	
660	47			
670			54	
680	45			
690			48	
700	52			
710			55	
720	52			
730			48	
740	59			
750			46	
760	46			

Source of conversion: $Inferred\ CBR\% = 0.07(Impact\ Value)^2 / 100$

Remarks _____

**BASECOURSE COMPACTION CONTROL
TNZ - B2 TEST RESULTS**



Project : Greenhill - Stage 13
 Location : Webb Drive (Northbound Lane)
 Client : Online Contractors (2016) Limited
 Contractor : Online Contractors (2016) Limited
 Tested by : J. Waru-Savage
 Date tested : 10/11/20

Sample description : GAP65 (ex Gleeson Quarry, Huntly)
 Nuclear densometer no : 33576
 Solid density (tested) : 2.66 t/m³
 Max dry density (tested) : 2.10 t/m³
 Opt. water content (tested) : 5.0 %

Project No : 2-68015.00
 Lab Ref No : HA6559_NDM
 Client Ref No :

Nuclear Densometer Test Results

Test Number	1	2	3	4	5	6	7	8	9	10	11	12	13	14
Test Position	CH540	CH550	CH560	CH570	CH580	CH590	CH600	CH610	CH620	CH630	CH640	CH650	CH660	CH670
Offset	RWT	LWT	RWT	LWT	RWT	LWT	RWT	LWT	RWT	LWT	RWT	LWT	RWT	LWT
Probe Depth (mm)	B/S	B/S	B/S	B/S	B/S	B/S	B/S	B/S	B/S	B/S	B/S	B/S	B/S	B/S
Wet Density (t/m ³)	2.32	2.24	2.27	2.14	2.33	2.20	2.32	2.28	2.28	2.28	2.27	2.32	2.25	2.24
Dry Density (t/m ³)	2.21	2.13	2.17	2.05	2.23	2.10	2.19	2.17	2.16	2.16	2.14	2.20	2.13	2.13
Water Content (%)	5.1	5.2	4.6	4.4	4.6	4.5	5.6	4.8	5.5	5.4	5.9	5.1	5.6	4.9
% of MDD	105	101	103	98	106	100	104	104	103	103	102	105	102	102
% Saturation	67	55	54	40	63	45	70	57	64	62	65	65	60	53

Oven Corrected Test Results

Dry Density (t/m ³)														
Water Content (%)														
% of MDD														
% Saturation														

NOT TESTED

Test Methods	Notes
In situ Density - NZS 4407 : 2015, Test 4.3 for Backscatter Mode	MDD from WSP, Hamilton Lab; Report No. HA6290/2_VHMDD (30/09/20) Offsets based off increasing chainage.

This report may only be reproduced in full

IANZ Approved Signatory

Designation : Senior Civil Engineering Technician
 Date : 11/11/20

Date reported : 11/11/20



All tests reported herein have been performed in accordance with the laboratory's scope of accreditation

**BASECOURSE COMPACTION CONTROL
TNZ - B2 TEST RESULTS**

Project : Greenhill - Stage 13
 Location : Webb Drive (Northbound Lane)
 Client : Online Contractors (2016) Limited
 Contractor : Online Contractors (2016) Limited
 Tested by : J. Waru-Savage
 Date tested : 10/11/20

Sample description : GAP65 (ex Gleeson Quarry, Huntly)
 Nuclear densometer no : 33576
 Solid density (tested) : 2.66 t/m³
 Max dry density (tested) : 2.10 t/m³
 Opt. water content (tested) : 5.0 %

Project No : 2-68015.00
 Lab Ref No : HA6559_NDM
 Client Ref No :

Nuclear Densometer Test Results										
Test Number	15	16	17	18	19	20	21	22	23	
Test Position	CH680	CH690	CH700	CH710	CH720	CH730	CH740	CH750	CH760	
Offset	RWT	LWT	RWT	LWT	RWT	LWT	RWT	LWT	RWT	
Probe Depth (mm)	B/S	B/S	B/S	B/S	B/S	B/S	B/S	B/S	B/S	
Wet Density (t/m ³)	2.28	2.34	2.31	2.26	2.25	2.26	2.20	2.13	2.22	
Dry Density (t/m ³)	2.16	2.22	2.19	2.15	2.15	2.15	2.10	2.02	2.12	
Water Content (%)	5.4	5.4	5.7	4.8	4.9	5.0	5.0	5.2	4.9	
% of MDD	103	106	104	102	102	102	100	96	101	
% Saturation	62	72	70	54	55	56	50	44	51	

Oven Corrected Test Results										
Dry Density (t/m ³)										
Water Content (%)										
% of MDD										
% Saturation										

Test Methods	Notes
In situ Density : NZS 4407 : 2015, Test 4.3 for Backscatter Mode	MDD from WSP, Hamilton Lab; Report No. HA6290/2_VHMDD (30/09/20) Offsets based off increasing chainage.

This report may only be reproduced in full

IANZ Approved Signatory

Designation : Senior Civil Engineering Technician
 Date : 11/11/20

Date reported : 11/11/20



All tests reported herein have been performed in accordance with the laboratory's scope of accreditation

**GAP65
TEST REPORT**



Project : Quality Assurance
 Location : Stockpile
 Client : Online Contractors (2016) Limited
 Contractor : -
 Sampled by : C. Robertson (WSP Hamilton Lab)
 Date sampled : 10/09/2020 @ 10:00am
 Sampling method : NZS 4407:2015:2.4.6.3.2
 Sample description : GAP65
 Sample condition : Moist
 Source : Gleeson Quarry Huntly

Project No : 2-68015.00
 Lab Ref No : HA6290/2_SA
 Client Ref No : -

Particle Size Distribution			
Sieve Size (mm)	Sample	Percentage Passing	
		Lower Limit - Coarse	Upper Limit - Fine
63.0	97	100	100
37.5	62	-	-
19.0	40	40	65
9.5	30	-	-
4.75	19	-	-
2.36	12	-	-
1.18	9	-	-
0.600	6	-	-
0.300	5	0	10
0.150	4	-	-
0.075	3	-	-

% passing the finest sieve is obtained by difference


Crushing Resistance		
% Fines @ Spec. Load	2.4	%
Specification	<10	%
Crushing Resistance	>130	kN
Nom Aggregate Size	13.2 - 9.5	mm
Specified Load	100	kN

Broken Faces Content of Aggregate		
Fraction (mm)	Percentage by Weight	
	Sample	Lower Limit
63.0 - 37.5	-	-
37.5 - 19.0	-	-
19.0 - 9.5	-	-
9.5 - 4.75	-	-

Plasticity Index	
Sample CPL	-
Sample PI	-

Clay Index	
Sample CI	-
Specification	-

Sand Equivalent (Washed, Mechanical Shaking)	
Sample SE	30
Specified	>= 25

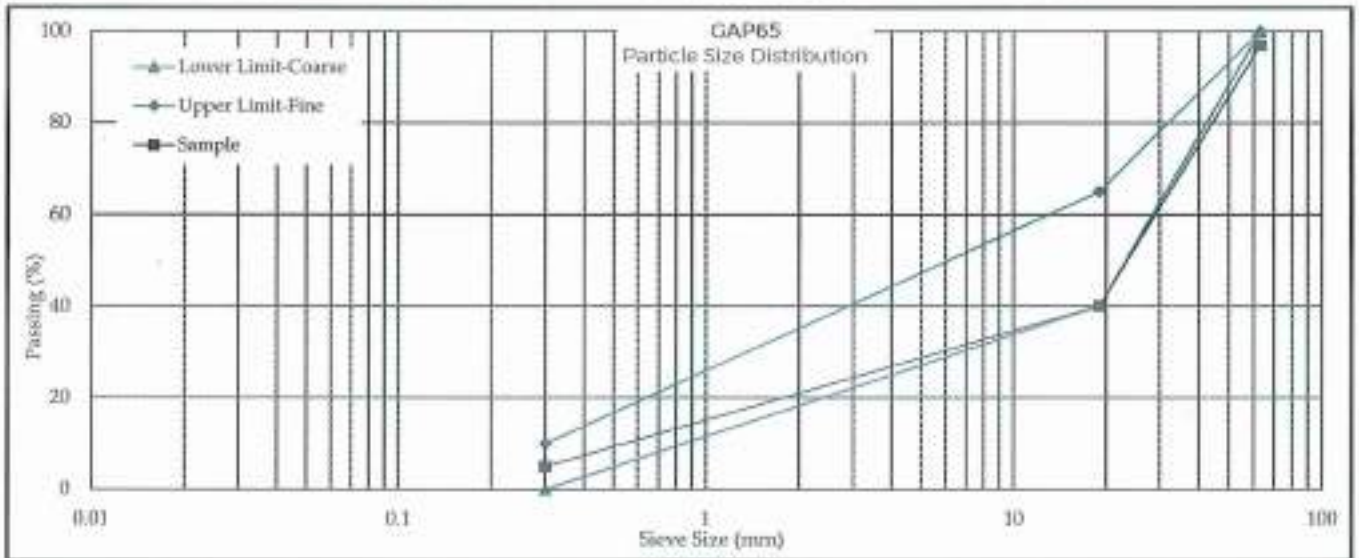

Test Methods	
Particle Size Distribution	NZS 4407 : 2015 : Test 3.8.1
Sand Equivalent	NZS 4407 : 2015 : Test 3.6
Crushing Resistance	NZS 4407 : 2015 : Test 3.10

Grading envelope from Waikato Local Authority RITS (2018)

Date tested : 14-28/09/20 Sampling is covered by IANZ Accreditation
 Date reported : 30/09/20 This report may only be reproduced in full

IANZ Approved Signatory

Designation : Senior Civil Engineering Technician
 Date : 30/09/20



All tests reported herein have been performed in accordance with the laboratory's scope of accreditation

**SOLID DENSITY OF AGGREGATE PARTICLES
TEST REPORT**



Project : Quality Assurance
 Location : Gleeson Quarries, Huntly GAP65 Stockpile
 Client : Online Contractors (2016) Limited
 Contractor : -
 Sampled by : C Robertson (WSP)
 Date sampled : 10/09/2020 @ 10:00am
 Sampling method : NZS 4407:2015:2.4.6.3.2
 Sample description : GAP65
 Sample condition : Moist
 Source : Gleeson Quarries, Huntly

Project No : 2-68015.00
 Lab Ref No : HA6290/2_SD
 Client Ref No : -

Test Results

Sample Solid Density : 2.66 t/m³

Test Method	Notes
NZS 4407: 2015 Test 3.7.2	Material tested : Retained on 4.75mm sieve

Date tested : 15/09/20
 Date reported : 16/09/20

Sampling is covered by IANZ Accreditation
 This report may only be reproduced in full
 All information supplied by Client

IANZ Approved Signatory

Designation : Senior Civil Engineering Technician
 Date : 16/09/20



All tests reported herein
 have been performed in
 accordance with the
 laboratory's scope of
 accreditation


**DRY DENSITY / WATER CONTENT RELATIONSHIP
VIBRATING COMPACTION**



Project : Quality Assurance
 Location : Stockpile
 Client : Online Contractors (2016) Limited
 Contractor : -
 Sampled by : C. Robertson (WSP Hamilton Lab)
 Date sampled : 10/09/2020 @ 10:00am
 Sampling method : NZS 4407:2015:2.4.6.3.2
 Sample description : GAP65
 Sample condition : Moist
 Solid density : 2.66 t/m³ (Tested)
 Source : Gleeson Quarry, Huntly

Project No : 2-68015.00
 Lab Ref No : HA6290/2_VHMDD
 Client Ref No : -

Test Results							
Maximum dry density	2.10	t/m ³	Natural water content	4.3	%		
Optimum water content	5	%	Fraction tested	<37.5mm			
Sample ID	-134	-67	Nat	67	133	200	
Bulk density	2.102	2.158	2.160	2.206	2.198	2.167	
Water content	2.3	3.3	4.3	5.1	6.0	7.2	
Dry density	2.055	2.070	2.070	2.098	2.074	2.021	
Sample condition	Dry/Moist M Dense	Moist Dense	Moist Dense	Wet Dense	Wet/Saturated M Dense	Saturated M Dense	

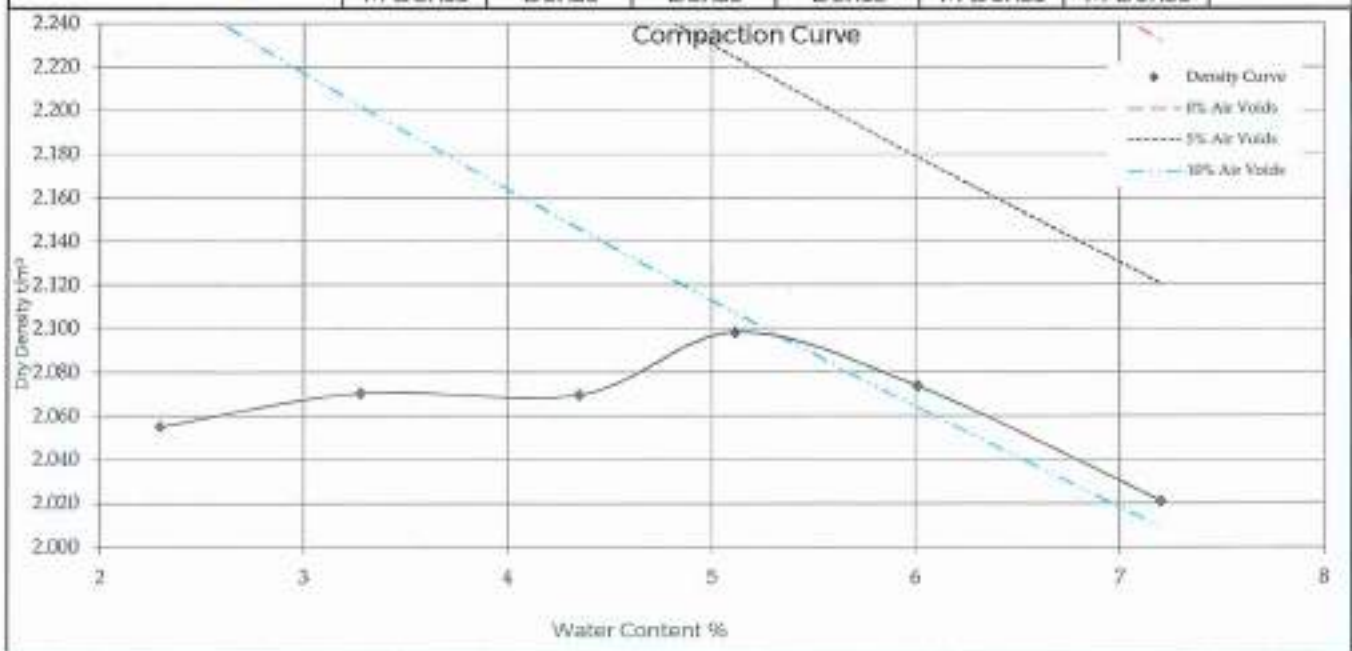

Test Methods	Notes
Compaction : NZS 4402:1986: Test 4.13	Solid density from report HA6290/2_SD

Date tested : 24/09/20
 Date reported : 30/09/20

Sampling is covered by IANZ Accreditation
 This report may only be reproduced in full

IANZ Approved Signatory

Designation : Senior Civil Engineering Technician
 Date : 30/09/20



All tests reported herein have been performed in accordance with the laboratory's scope of accreditation

**WEATHERING QUALITY OF COARSE AGGREGATE
TEST REPORT**




Project : Quality Assurance
 Location : Stockpile
 Client : Online Contractors (2016) Ltd
 Contractor : -
 Sampled by : C Robertson (WSP Hamilton Lab)
 Date sampled : 10/09/20 @ 10:00am
 Sampling method : NZS 4407:2015:2.4.6.3.2
 Sample description : GAP65
 Sample condition : Moist
 Source : Gleeson Quarry, Huntly

Project No : 2-68015.00
 Lab Ref No : HA6290/2_WQI
 Client Ref No : -

Test Results

Percentage Retained on 4.75mm BS Sieve After 10 Cycles : 95
 Cleanness Value After 10 Cycles : 91
 Weathering Quality Index (see table below) : BA

Cleanness Value	Percentage Retained on 4.75mm Sieve			Specified
	96 - 100	91 - 95	up to 90	
91 - 100	AA	BA	CA	AA, AB, AC BA, BB, CA or CB
71 - 90	AB	BB	CB	
up to 70	AC	BC	CC	

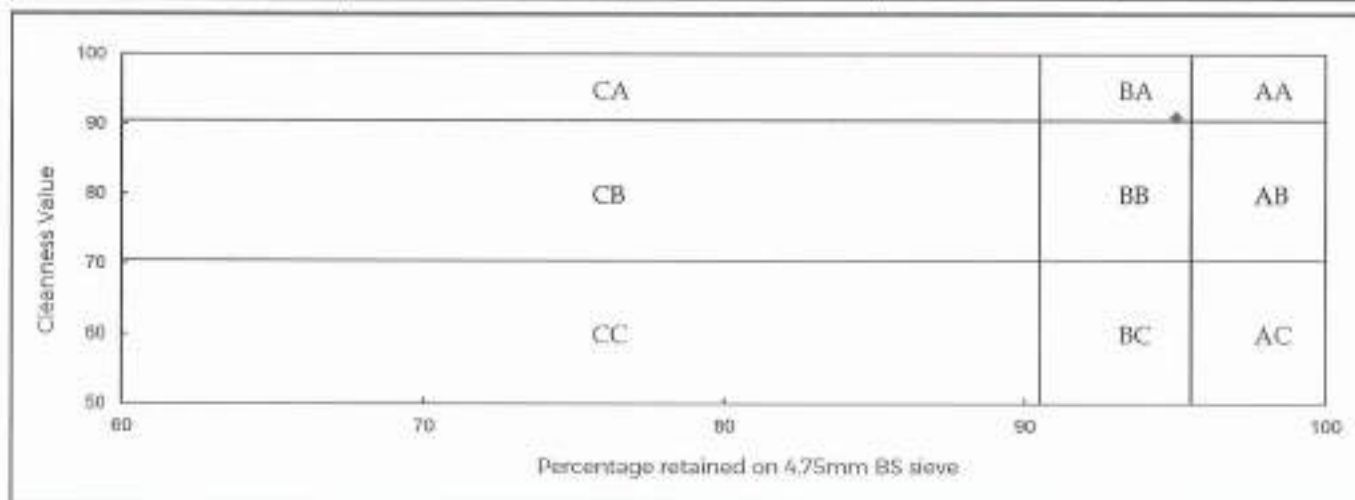

Test Method	Notes
Weathering Quality Index, NZS 4407:2015, Test 3.1f	* Is graphed value of Weathering Quality Index. Specification from RITS March 2018

Date tested : 30/09/2020
 Date reported : 2/10/20

Sampling is covered by IANZ Accreditation
 This report may only be reproduced in full

IANZ Approved Signatory

Designation : Senior Civil Engineering Technician
 Date : 2/10/20



All tests reported herein have been performed in accordance with the laboratory's scope of accreditation

APPENDIX 2(c)

Roading QA Documentation

Road Basecourse 2(c)

- Basecourse strings
- Nuclear Densometer Results
- Benkelman Beam Test Results
- TNZ M/4 AP40 Material Tests



STRING TEST

Contract Greenhill Stage 13 Job No. 19-30378-03
 Site Webb Drive Date 11/02/2021
 Chainage 520 to 800 (Road 20 to Carra Road roundabout) Recorded by B. Pearson and Online
 Material Basecourse Pre-sal Murray Giles and Daniel of HCC present _____

String target lift 200mm, Tolerance TNZ B2 -5mm +15mm

Chn	Southbound lane of dual carriageway			Northbound lane of dual carriageway		
	left	centre	right	left	centre	right
520	210	210	200	200	200	200
540	220	210	200	210	200	200
560	205	200	205	210	210	205
580	200	200	205	210	220	220
600	205	200	205	205	200	205
620	210	205	210	200	205	210
640	205	200	200	205	200	200
660	205	200	210	210	200	200
680	210	200	205	210	205	205
700	200	200	205	210	210	210
720	205	200	200	200	205	210
740	200	200	200	205	200	200
760	210	210	205	200	200	200
780	205	200	200	210	205	210
800	200	200	210	200	200	205

Acceptance confirmed by HCC
 Staff on the day to allow
 seal coat to be applied as programmed.

B. L. Pearson
 S&L Consultants



CONTRACTORS

P O Box 21187, Rototuna
Hamilton, 3256
Email: Todd@onlinecontractors.co.nz

Ph: 07 853 9422

COMPACTION - CLEGG TESTS

Contract	GHP	Job No.	
Site/Chainage	Stage 13 Carrs Road	Date	18/02/2021
Material	TNZ 40	Recorded by	Bikal Baniya

Chn	1m from kerb - Left	Centre Line	1m from kerb - Right	Notes
320			60	
330		64		
340	67			
350			67	
360		60		
370	83			
380			71	
390		69		
400	71			
410			77	
420		75		
430	80			
440			71	
450		86		
460	81			
470			77	
480		69		
490	79			
500			75	
510		71		
520	80			
530			73	
540		69		
550	78			
560			63	
570		75		

Source of conversion: Inferred CBR% = 0.07 (Impact Value)² / 100

Remarks

COMPACTION CONTROL
PLATEAU DENSITY TEST RESULTS



Project: Greenhill - Stage 13
 Location: Webb Drive (South of Popham)
 Position: Southbound, Run 1
 Client: Online Contractors (2016) Ltd
 Tested by: G Tait & C Brown
 Date tested: 04/02/21

Sample description: Cement (2%) Stabilised Basecourse
 Sample condition: Wet, compacted
 Nuclear densometer no.: 33576
 Plateau dry density (corrected): 2.18 t/m³
 * Maximum dry density report: 2.18 t/m³
 * Optimum water content: 7.0 %

Project No: 2-68015.00
 Lab Ref No: HA6868_PD
 Client Ref No:

Nuclear Densometer Test Results									
Roller Passes	4	6	8	10	4	8	12	16	
Compaction Type	Vib	Vib	Vib	Vib	Static	Static	Static	Static	Static
Wet Density (t/m ³)	2.17	2.18	2.24	2.20	2.22	2.29	2.32	2.29	
Dry Density (t/m ³)	1.99	2.01	2.06	2.03	2.04	2.11	2.14	2.10	
Water Content (%)	8.8	8.7	8.5	8.5	8.9	8.6	8.3	8.9	
% of MDD target	91	92	95	93	94	97	98	96	

Oven Corrected Test Results									
Dry Density (t/m ³)	2.03	2.04	2.10	2.07	2.08	2.15	2.18	2.14	
Water Content (%)	6.8	6.7	6.5	6.5	6.9	6.6	6.3	6.9	
% of MDD target	93	94	96	95	95	99	100	98	

Test Methods	Notes
Insitu Density: NZS 4407: 2015, Test 4.3 for Backscatter Mode	One forward / back motion = 2 roller passes
Oven Water Content: NZS 4407: 2015, Test 3.1	After Sheepfoot roller a twin Drum roller used.
Rollers used for compaction	* MDD report from: HA6290/1
Sheepfoot Single Drum Roller (Prior to testing)	
7T Twin Steel Drum Roller used for Vibratory & Static passes	
NDM vs Oven Moisture correction from report: HA6868_WC	NDM Vs Oven correction factor (%) = 2.0

This report may only be reproduced in full

IANZ Approved Signatory
 Designation: Senior Civil Engineering Technician
 Date: 09/02/21

Test results indicated as not accredited are outside the scope of the laboratory's accreditation



**WATER CONTENT
TEST REPORT**



Project : Greenhill - Stage 13
 Location : Webb Drive (South of Popham)
 Position : Southbound, Run 1
 Client : Online Contractors (2016) Ltd
 Sampled by : G Tait & C Brown
 Date sampled : 04/02/21
 Sampling method : As received
 Sample description : Cement (2%) Stabilised Basecourse
 Sample condition : Moist
 Sample source : Run 1, Southbound

Project No : 2-68015.00
 Lab Ref No : HA6868_WC
 Client Ref No :

Test Results

Sample No.	NDM Water Content (%)	Oven Water Content (%)	Difference (%)
1	8.6	7.1	1.5
2	8.3	6.5	1.8
3	9.5	7.4	2.1
4	8.7	6.3	2.4
5	8.8	6.6	2.2
		Average	2.0

Test Methods

NZS 4407: 2015, Test 3.1
 Insitu Density : NZS 4407 : 2015, Test 4.3 for Backscatter Mode

Notes

NDM's taken at start of compaction, with samples taken at each position.

Date tested : 04/02/21
 Date reported : 09/02/21

Sampling is not covered by IANZ Accreditation. Results apply only to sample tested.
 This report may only be reproduced in full

IANZ Approved Signatory

Designation : Senior Civil Engineering Technician
 Date : 09/02/21



Test results indicated as not accredited are outside the scope of the laboratory's accreditation

BASECOURSE COMPACTION CONTROL
TNZ - B2 TEST RESULTS



Project: Greenhill Stage 13
 Location: Webb Drive, Southbound Lane
 Client: Online Contractors (2016) Ltd
 Contractor: Online Contractors (2016) Ltd
 Tested by: C.Brown, G.Tait
 Date tested: 09/02/21

Sample description: Stabilised TNZ40
 Nuclear densimeter no: 33576
 Solid density (tested): 2.72 t/m³
 Max dry density (tested): 2.18 t/m³
 Opt water content (tested): 5.5 %

Project No: 2-68015.00
 Lab Ref No: HA6883a_NDM
 Client Ref No:

Nuclear Densometer Test Results

Test Number	1	2	3	4	5	6	7	8	9	10	11	12	13	14
Test Position	CH520	CH530	CH540	CH550	CH560	CH570	CH580	CH590	CH600	CH610	CH620	CH630	CH640	CH650
Offset	RWT	LWT	RWT	LWT	RWT	LWT	RWT	LWT	RWT	LWT	RWT	LWT	RWT	LWT
Probe Depth (mm)	B/S	B/S	B/S	B/S	B/S	B/S	B/S	B/S	B/S	B/S	B/S	B/S	B/S	B/S
Wet Density (t/m ³)	2.22	2.26	2.21	2.23	2.27	2.25	2.24	2.22	2.23	2.15	2.36	2.20	2.24	2.29
Dry Density (t/m ³)	2.10	2.11	2.08	2.08	2.13	2.12	2.11	2.06	2.09	2.02	2.22	2.08	2.12	2.16
Water Content (%)	5.7	6.8	6.3	7.5	6.3	6.1	6.4	7.5	6.3	6.1	6.1	5.9	5.9	6.1
% of MDD	97	97	96	95	98	97	97	95	96	93	102	95	97	99
% Saturation	53	64	56	66	62	58	60	64	57	48	74	52	56	63

Oven Corrected Test Results

Dry Density (t/m ³)	2.14	2.15	2.12	2.12	2.17	2.16	2.15	2.10	2.13	2.06	2.26	2.12	2.16	2.20
Water Content (%)	3.7	4.8	4.3	5.5	4.3	4.1	4.4	5.5	4.3	4.1	4.1	3.9	3.9	4.1
% of MDD	98	99	97	97	100	99	99	96	98	95	104	97	99	101
% Saturation	38	50	42	52	47	43	45	51	43	35	55	38	41	47

Test Methods

Test Method: NZS 4407:2015, Test 6.3 for Backscatter Mode
 Water Content: NZS 4407:2015, Test 3.1 for aggregates

Notes: Max dry density from: WSP Hamilton Lab, Report ID: HA6289a_VHMDD_AUC20
 Water Content from report HA6883a_NDM FEB21

This report may only be reproduced in full

IANZ Approved Signatory
 Designation: Senior Civil Engineering Technician
 Date: 10/02/21



All tests reported herein have been performed in accordance with the laboratory's scope of accreditation

09-1A9-037 (10/07/2020)

BASECOURSE COMPACTION CONTROL
TNZ - B2 TEST RESULTS



Project: Greenhill Stage 13
Location: Webb Drive, Southbound Lane
Client: Online Contractors (2016) Ltd
Contractor: Online Contractors (2016) Ltd
Tested by: C.Brown, C.Tait
Date tested: 09/02/21

Sample description: Stabilised TNZ40
Nuclear densometer no: 33576
Solid density (tested): 2.72 t/m³
Max dry density (tested): 2.18 t/m³
Opt. water content (tested): 5.5 %

Project No: 2-68015.00
Lab Ref No: HA68834_NDM
Client Ref No:

Test Number	Nuclear Densometer Test Results																													
	15	16	17	18	19	20	21	22	23	24	25	26	27	28	CH660	CH670	CH680	CH690	CH700	CH710	CH720	CH730	CH740	CH750	CH760	CH770	CH780	CH790		
Test Position	CH660	CH670	CH680	CH690	CH700	CH710	CH720	CH730	CH740	CH750	CH760	CH770	CH780	CH790																
Offset	RWT	LWT	RWT	LWT	RWT	LWT	RWT	LWT	RWT	LWT	RWT	LWT	RWT	LWT																
Probe Depth (mm)	B/S	B/S	B/S	B/S	B/S	B/S	B/S	B/S	B/S	B/S	B/S	B/S	B/S	B/S																
Wet Density (t/m ³)	2.31	2.32	2.16	2.22	2.30	2.25	2.21	2.30	2.32	2.27	2.33	2.31	2.26	2.30																
Dry Density (t/m ³)	2.19	2.17	2.05	2.09	2.16	2.11	2.10	2.16	2.20	2.14	2.19	2.17	2.13	2.16																
Water Content (%)	5.7	6.9	5.1	6.2	6.6	6.4	5.0	6.1	5.4	6.1	6.2	6.5	6.2	6.2																
% of MDD	100	99	94	96	99	97	96	99	101	98	101	99	99	99																
% Saturation	64	74	43	56	69	61	46	64	62	61	70	70	60	66																

	Oven Corrected Test Results													
	2.23	2.22	2.09	2.13	2.20	2.15	2.14	2.20	2.24	2.18	2.24	2.21	2.17	2.21
Dry Density (t/m ³)	3.7	4.6	3.1	4.2	4.6	4.4	3.0	4.1	3.4	4.1	4.2	4.5	4.2	4.2
Water Content (%)	102	102	96	98	101	99	98	101	103	100	103	101	99	101
% Saturation	46	55	28	41	53	45	30	48	44	45	53	53	45	49

Test Methods
Instru Density : NZS 4407 : 2015, Test 4.3 for Backscatter Mode
Water Content : NZS 4407 : 2015, Test 3.1 for aggregates

This report may only be reproduced in full

IANZ Approved Signatory
Designation : Senior Civil Engineering Technician
Date : 10/02/21



All tests reported herein have been performed in accordance with the laboratory's scope of accreditation

BASECOURSE COMPACTION CONTROL
TNZ - B2 TEST RESULTS



Project : Greenhill Stage 13
Location : Webb Drive, Southbound Lane
Client : Online Contractors (2016) Ltd
Contractor : Online Contractors (2016) Ltd
Tested by : C.Brown, G.Tait
Date tested : 09/02/21

Sample description : Stabilised TNZ40
Nuclear densometer no.: 33576
Solid density (tested) : 2.72 t/m³
Max dry density (tested) : 2.18 t/m³
Opt. water content (tested) : 5.5 %

Project No.: 2-68015.00
Lab Ref No.: HA6883a_NDM
Client Ref No.:

Nuclear Densometer Test Results									
Test Number	29								
Test Position	CH800								
Offset	RWT								
Probe Depth (mm)	B/S								
Wet Density (t/m ³)	2.25								
Dry Density (t/m ³)	2.13								
Water Content (%)	5.5								
% of MDD	98								
% Saturation	54								

Oven Corrected Test Results									
Dry Density (t/m ³)	2.17								
Water Content (%)	3.5								
% of MDD	100								
% Saturation	38								

IANZ Approved Signatory

Designation: Senior C/IVL Engineering Technician
 Date: 10/02/21



All tests reported herein have been performed in accordance with the laboratory's scope of accreditation

This report may only be reproduced in full

IP-VA8-087 (10/07/2020)

WSP
 Hamilton (Fox St)
 Quality Management Systems Certified to ISO 9001

4 Fox Street
 Private Bag 3057, Waikato Mail Centre, 3240
 Hamilton, New Zealand

Telephone +64 7 856 2870
 Website www.wsp.com.nz

BASECOURSE COMPACTION CONTROL
TNZ - B2 TEST RESULTS



Project : Greenhill Stage 13
 Location : Webb Drive Northbound Lane
 Client : Online Contractors (2016) Ltd
 Contractor : Online Contractors (2016) Ltd
 Tested by : C.Brown
 Date tested : 11/02/21

Sample description : Stabilised TNZ40
 Nuclear densometer no : 33576
 Solid density (tested) : 2.72 t/m³
 Max dry density (tested) : 2.18 t/m³
 Opt water content (tested) : 5.5 %

Project No : 2-68015.00
 Lab Ref No : HA6899_NDM
 Client Ref No :

Nuclear Densometer Test Results

Test Number	1	2	3	4	5	6	7	8	9	10	11	12	13	14
Test Position	CH520	CH530	CH540	CH550	CH560	CH570	CH580	CH590	CH600	CH610	CH620	CH630	CH640	CH650
Offset	RWT	LWT	RWT	LWT	RWT	LWT	RWT	LWT	RWT	LWT	RWT	LWT	RWT	LWT
Probe Depth (mm)	B/S	B/S	B/S	B/S	B/S	B/S	B/S	B/S	B/S	B/S	B/S	B/S	B/S	B/S
Wet Density (t/m ³)	2.26	2.27	2.31	2.30	2.26	2.50	2.32	2.26	2.34	2.20	2.32	2.24	2.24	2.30
Dry Density (t/m ³)	2.11	2.11	2.16	2.15	2.10	2.33	2.17	2.10	2.21	2.06	2.17	2.09	2.07	2.16
Water Content (%)	7.2	7.4	7.1	7.1	8.0	7.0	7.0	7.3	6.1	6.6	7.0	7.2	8.1	6.7
% of MDD	97	97	99	99	96	107	99	97	101	94	99	96	95	99
% Saturation	68	70	74	73	73	115	75	68	72	56	74	65	70	70

Oven Corrected Test Results

Dry Density (t/m ³)	2.15	2.15	2.20	2.19	2.14	2.38	2.21	2.14	2.25	2.10	2.21	2.13	2.11	2.16
Water Content (%)	5.2	5.4	5.1	5.1	6.0	5.0	5.0	5.3	4.1	4.6	5.0	5.2	6.1	6.7
% of MDD	99	99	101	100	98	109	101	98	103	96	101	98	97	99
% Saturation	53	56	59	57	60	94	59	54	54	42	58	51	57	70

Test Methods

Insta Density : NZS 4407 : 2015, Test 4.3 for Backscatter Mode

Notes:
 Max dry density from : WSP Hamilton Lab, Report ID: HA623961_VHMDDO SERPZO
 Water Content from report: HA6898_MC_FEB21

This report may only be reproduced in full

IANZ Approved Signatory

Designation : Senior Civil Engineering Technician
 Date : 11/02/21



All tests reported herein have been performed in accordance with the laboratory's scope of accreditation

Date reported : 11/02/21

PR-UG-037 (11/07/2020)

BASECOURSE COMPACTION CONTROL
TNZ - B2 TEST RESULTS



Project : Greenhill Stage 13
Location : Webb Drive Northbound Lane
Client : Online Contractors (2016) Ltd
Contractor : Online Contractors (2016) Ltd
Tested by : C.Brown
Date tested : 11/02/21

Sample description : Stabilised TNZ40
Nuclear densimeter no : 33576
Solid density (tested) : 2.72 t/m³
Max dry density (tested) : 2.18 t/m³
Opt. water content (tested) : 5.5 %

Project No : 2-68015/00
Lab Ref No : HA6899_LNDM
Client Ref No :

		Nuclear Densimeter Test Results															
Test Number	Test Position	15	16	17	18	19	20	21	22	23	24	25	26	27	28		
CH660	RWT	LWT	RWT	LWT	RWT	LWT	RWT	LWT	RWT	LWT	RWT	LWT	RWT	LWT	RWT		
Probe Depth (mm)	B/S	B/S	B/S	B/S	B/S	B/S	B/S	B/S	B/S	B/S	B/S	B/S	B/S	B/S	B/S		
Wet Density (t/m ³)	2.22	2.28	2.24	2.22	2.29	2.20	2.26	2.36	2.30	2.31	2.35	2.28	2.28	2.34	2.31		
Dry Density (t/m ³)	2.07	2.12	2.09	2.06	2.13	2.06	2.22	2.15	2.15	2.15	2.19	2.13	2.10	2.18	2.13		
Water Content (%)	7.2	7.3	7.2	7.6	7.3	6.9	6.6	7.1	7.5	7.1	7.1	6.9	8.3	7.4	8.0		
% of MDD	95	97	96	95	98	94	102	99	99	99	100	98	96	100	98		
% Saturation	62	71	65	65	72	59	79	73	77	80	68	77	77	81	79		

		Oven Corrected Test Results															
Dry Density (t/m ³)	Water Content (%)	2.11	2.16	2.13	2.10	2.17	2.10	2.26	2.19	2.19	2.23	2.18	2.14	2.22	2.17		
% of MDD	97	99	98	96	100	96	104	100	100	102	102	100	98	102	100		
% Saturation	49	56	51	52	57	45	61	57	62	63	53	63	65	65			

Test Methods
 Instru Density : NZS 4407 : 2015, Test 4.3 for Backscatter Mode
 Water Content : NZS 4407 : 2015, Test 3.1 for aggregates

Notes
 Max dry density from : WSP Hamilton Lab Report ID: HA6289/L_VHMDP SEP20
 Water Content from report HA6888_WC_FEB21
 This report may only be reproduced in full

IANZ Approved Signatory
 Designation : Senior Civil Engineering Technician
 Date : 11/02/21



All tests reported herein have been performed in accordance with the laboratory's scope of accreditation

#F-JAR-037 11/07/2021

BASECOURSE COMPACTION CONTROL
TNZ - B2 TEST RESULTS



Project: Greenhill Stage 13
Location: Webb Drive Northbound Lane
Client: Online Contractors (2016) Ltd
Contractor: Online Contractors (2016) Ltd
Tested by: C Brown
Date tested: 11/02/21

Sample description: Stabilised TNZ40
Nuclear densometer no: 33576
Solid density (tested): 2.72 t/m³
Max dry density (tested): 2.18 t/m³
Opt. water content (tested): 5.5 %

Project No: 2-68015.00
Lab Ref No: HA6899_NDM
Client Ref No:

Nuclear Densometer Test Results

Test Number	29																		
Test Position	CH800																		
Offset	RWT																		
Probe Depth (mm)	B/S																		
Wet Density (t/m ³)	2.28																		
Dry Density (t/m ³)	2.11																		
Water Content (%)	8.1																		
% of MDD	97																		
% Saturation	76																		

Oven Corrected Test Results

Dry Density (t/m ³)	2.15																		
Water Content (%)	6.1																		
% of MDD	98																		
% Saturation	62																		

Test Methods

Instru Density : NZS 4407 : 2015, Test 4.3 for Backscatter Mode
 Water Content : NZS 4407 : 2015, Test 3.1 for aggregates

Notes

Max dry density from WSP Hamilton Lab Report ID: HA628997_VHMDD SEP20
 Water Content from report HA6899_WC FEB21

This report may only be reproduced in full

IANZ Approved Signatory

Designation : Senior Civil Engineering Technician
 Date : 11/02/21



All tests reported herein have been performed in accordance with the laboratory's scope of accreditation

Date reported : 11/02/21

pc-uab-037 11/07/2020

BASECOURSE COMPACTION CONTROL
TNZ - B2 TEST RESULTS



Project : Greenhill stage 13
Location : Carrs Road
Client : Online Contractors (2016) Ltd
Contractor : Online Contractors (2016) Ltd
Tested by : C.Brown
Date tested : 14/02/21

Sample description : Basecourse (TNZ40)
Nuclear densometer no : 33576
Solid density (tested) : 2.72 t/m³
Max dry density (tested) : 2.18 t/m³
Opt water content (tested) : 5.5 %

Project No : 2-66015.00
Lab Ref No : HA6913a_NDM
Client Ref No :

Nuclear Densometer Test Results														
Test Number	1	2	3	4	5	6	7	8	9	10	11	12	13	14
Test Position	CH10	CH20	CH30	CH40	CH50	CH60	CH70	CH80	CH90	CH100	CH110	CH120	CH130	CH140
Offset	RWT	LWT	CL	CL	LWT	CL	RWT	LWT	CL	RWT	LWT	CL	RWT	LWT
Probe Depth (mm)	B/5	B/5	B/5	B/5	B/5	B/5	B/5	B/5	B/5	B/5	B/5	B/5	B/5	B/5
Wet Density (t/m ³)	2.28	2.30	2.25	2.29	2.29	2.29	2.34	2.26	2.21	2.27	2.31	2.25	2.30	2.31
Dry Density (t/m ³)	2.18	2.20	2.16	2.19	2.18	2.19	2.25	2.17	2.12	2.18	2.20	2.16	2.20	2.21
Water Content (%)	4.7	4.5	4.4	4.6	5.0	4.4	4.2	4.3	4.4	4.3	4.7	4.5	4.6	4.8
% of MDD	100	101	99	100	100	101	103	99	97	100	101	99	101	101
% Saturation	52	50	46	51	55	50	54	46	42	47	55	47	53	56

Oven Corrected Test Results

Dry Density (t/m ³)														
Water Content (%)														
% of MDD														
% Saturation														

NOT TESTED

Test Methods: Nenes
 Insitu Density : NZS 4407 : 2015 Test 4.3 for Backscatter Mode
 Max dry density from : WSP Hamilton Lab. Report ID: HA62591_VHMOD SEP20
 CH0 = Edge of Asphalt on existing Carrs Rd

This report may only be reproduced in full

IANZ Approved Signatory
 Designation : Senior Civil Engineering Technician
 Date : 14/02/21



All tests reported herein have been performed in accordance with the laboratory's scope of accreditation

BASECOURSE COMPACTION CONTROL
TNZ - B2 TEST RESULTS



Project : Greenhill stage 13
Location : Carrs Road
Client : Online Contractors (2016) Ltd
Contractor : Online Contractors (2016) Ltd
Tested by : C.Brown
Date tested : 14/02/21

Sample description : Basecourse (TNZ40)
Nuclear densometer no : 33576
Solid density (tested) : 2.72 t/m³
Max dry density (tested) : 2.18 t/m³
Opt water content (tested) : 5.5 %

Project No : 2-68015.00
Lab Ref No : HA6913a_NDM
Client Ref No :

Nuclear Densometer Test Results												
Test Number	15	16	17	18	19	20	21	22	23	24	25	26
Test Position	CH150	CH160	CH170	CH180	CH190	CH200	CH210	CH220	CH230	CH240	CH250	CH260
Offset	CL	RWT	LWT	CL	RWT	LWT	CL	RWT	LWT	CL	RWT	LWT
Probe Depth (mm)	B/S	B/S	B/S	B/S	B/S	B/S	B/S	B/S	B/S	B/S	B/S	B/S
Wet Density (t/m ³)	2.27	2.27	2.29	2.23	2.33	2.36	2.21	2.25	2.29	2.77	2.38	2.25
Dry Density (t/m ³)	2.18	2.17	2.20	2.15	2.22	2.26	2.11	2.14	2.19	2.16	2.24	2.11
Water Content (%)	4.4	4.2	4.1	3.6	4.7	4.2	4.5	4.9	4.8	5.0	6.0	6.7
% of MDD	100	100	101	99	102	104	97	98	100	99	103	97
% Saturation	48	45	47	37	57	57	42	50	53	52	76	63

Oven Corrected Test Results

Dry Density (t/m ³)												
Water Content (%)												
% of MDD												
% Saturation												

NOT TESTED

Test Methods

Instru Density : NZS 4407 : 2015 Test 4.3 for Backscatter Mode

Notes
Max dry density from : WSP Hamilton Lab Report ID: HA62897_VHMDD SEP20
CHD = Edge of Asphalt on existing Carrs Rd

This report may only be reproduced in full

IANZ Approved Signatory

Designation : Senior Civil Engineering Technician
Date : 14/02/21



All tests reported herein have been performed in accordance with the laboratory's scope of accreditation

Date reported : 14/02/21

AP-CAR-037 (11/07/2020)

WSP
Hamilton (Fox St)
Quality Management Systems Certified to ISO 9001

4 Fox Street
Private Bag 3057, Waikato Mail Centre, 3240,
Hamilton, New Zealand

Telephone +64 7 856 2870
Website www.wsp.com/tnz

BASECOURSE COMPACTION CONTROL
TNZ - B2 TEST RESULTS



Project: Greenhill stage 13
Location: Carrs Road, Roundabout
Client: Online Contractors (2016) Ltd
Contractor: Online Contractors (2016) Ltd
Tested by: C Brown
Date tested: 14/02/21

Sample description: Stabilised TNZ40
Nuclear densometer no: 33576
Solid density (tested): 2.72 t/m³
Max dry density (tested): 2.18 t/m³
Opt water content (tested): 5.5 %

Project No: 2-68015.00
Lab Ref No: HA6913b_NDM_LR
Client Ref No:

Nuclear Densometer Test Results									
Test Number	1	2	3	4	5	6	7	8	
Test Position	CH10	CH10	CH20	CH30	CH40	CH50	CH60	CH70	
Offset	LWT	RWT	LWT	RWT	LWT	RWT	LWT	RWT	
Probe Depth (mm)	B/5	B/5	B/5	B/5	B/5	B/5	B/5	B/5	
Wet Density (t/m ³)	2.29	2.28	2.25	2.28	2.25	2.29	2.35	2.31	
Dry Density (t/m ³)	2.15	2.14	2.10	2.15	2.14	2.14	2.22	2.17	
Water Content (%)	6.2	6.2	7.0	6.0	5.4	6.6	5.8	6.8	
% of MDD	99	98	96	99	98	98	102	99	
% Saturation	64	63	64	62	54	67	70	72	

Oven Corrected Test Results									
	1	2	3	4	5	6	7	8	
Dry Density (t/m ³)	2.20	2.18	2.14	2.20	2.18	2.19	2.26	2.21	
Water Content (%)	4.2	4.2	5.0	4.0	3.4	4.6	3.8	4.8	
% of MDD	101	100	98	101	100	100	104	101	
% Saturation	48	46	50	46	37	51	51	56	

Test Methods
In situ Density: NZS 4407: 2015, Test 4.3 for Backscatter Mode
Water Content: NZS 4407: 2015, Test 3.1 for aggregates

Notes:
Max dry density from: WSP Hamilton Lab Report ID: HA62897_VHMDD SEFZO
Water Content from report: HA6866_WC FEB21
CH10 = Centreline of Carrs Road, tested clockwise
This report replaces report HA6913b_NDM dated 14/2/21

This report may only be reproduced in full

IANZ Approved Signatory 
Designation: Senior Civil Engineering Technician
Date: 15/02/21



All tests reported herein have been performed in accordance with the laboratory's scope of accreditation

Date reported: 15/02/21
SP-448-037 (14/02/2021)

**BENKELMAN BEAM
TEST REPORT**



Project : Greenhill Stage 13
 Location : Carrs Road
 Client : Online Contractors (2016) Ltd
 Contractor : Online Contractors (2016) Ltd
 Test method : TNZ T/1 1977
 Pavement type : Basecourse (TNZ 40)
 Pavement temp °C : -
 Weight on rear axle: 8.3 tonnes
 Tested by : C.Brown, G.Tait

Project No : 2-68015.00
 Lab Ref No : HA6913a
 Client Ref :

Test Results				
Location Metres	Deflections (mm)			Comments
	Left Outer	Centre	Right Outer	
10			0.64	CHO = Edge of Asphalt on existing Carrs Rd Plant in the way
20	0.76			
30		0.60		
40		0.66		
50	0.56			
60		0.90		
70			0.60	
80	0.70			
90		0.66		
100			0.58	
110	0.58			
120		0.87		
130			0.54	
140	0.64			
150		0.60		
160			0.72	
170	0.64			
180		0.76		
190			0.70	
200	0.56			
210		0.70		
220			0.64	
230	0.64			
240		0.64		
250			0.44	
260	0.50			
		0.76		90 Percentile calculated for all data in columns 1 to 4.

Deflection Statistical Analysis (for all deflections)

Maximum (mm): 0.90	Minimum (mm): 0.44	Average (mm): 0.65
--------------------	--------------------	--------------------

Note: Results in *italics* have a difference between intermediate and Final readings that are greater than 3 (refer TNZ T/1 1977).

This report may only be reproduced in full

Date tested : 14/02/2021
 Date reported : 14/02/2021

IANZ Approved Signatory

Designation : *Senior Civil Engineering Technician*
 Date : 14/02/2021



All tests reported herein have been performed in accordance with the laboratory's scope of accreditation

**BENKELMAN BEAM
TEST REPORT**



Project : Greenhill Stage 13
 Location : Carrs Road, Roundabout
 Client : Online Contractors (2016) Ltd
 Contractor : Online Contractors (2016) Ltd
 Test method : TNZ T/1977
 Pavement type : Stabilised (TNZ 40)
 Pavement temp °C : -
 Weight on rear axle: 8.3 tonnes
 Tested by : C.Brown, G.Tait

Project No : 2-68015.00
 Lab Ref No : HA6913b_R
 Client Ref :

Test Results				
Location Metres	Deflections (mm)			Comments
	Left Outer	Right Outer		
0	0.50			CH0 = Centreline of Carrs Rd, tested clockwise
10		0.50		
20	0.56			
30		0.60		
40	0.86			
50		0.64		
60	0.50			
70		0.44		
	0.71			90 Percentile calculated for all data in columns 1 to 2.

Deflection Statistical Analysis (for all deflections)

Maximum (mm): 0.86	Minimum (mm): 0.44	Average (mm): 0.58
--------------------	--------------------	--------------------

Note: Results in italics have a difference between Intermediate and Final readings that are greater than 3 (refer TNZ T/1977)

This report replaces report HA6913b_NDM, dated 14/2/21

This report may only be reproduced in full

Date tested : 14/02/2021
 Date reported : 14/02/2021

IANZ Approved Signatory

Designation : Senior Civil Engineering Technician
 Date : 15/02/2021



All tests reported herein have been performed in accordance with the laboratory's scope of accreditation

**BENKELMAN BEAM
TEST REPORT**



Project : Greenhill Stage 13
 Location : Side stub (RHS)
 Client : Online Contractors (2016) Ltd
 Contractor : Online Contractors (2016) Ltd
 Test method : TNZ T/1 1977
 Pavement type : Basecourse (TNZ 40)
 Pavement temp °C : -
 Weight on rear axle : 8.3 tonnes
 Tested by : C.Brown, G.Tait

Project No : 2-68015.00
 Lab Ref No : HA6913c
 Client Ref :

Test Results				
Location Metres	Deflections (mm)			Comments
	Left Outer	Right Outer		
10	0.84			CHD = Centreline of Carrs Rd
20		0.70		
			0.83	90 Percentile calculated for all data in columns 1 to 4.

Deflection Statistical Analysis (for all deflections)

Maximum (mm): 0.84 Minimum (mm): 0.70 Average (mm): 0.77

Note: Results in *italics* have a difference between Intermediate and Final readings that are greater than 3 (refer TNZ T/1 1977)

This report may only be reproduced in full

Date tested : 14/02/2021
 Date reported : 14/02/2021

IANZ Approved Signatory

Designation : Senior Civil Engineering Technician
 Date : 14/02/2021



All tests reported herein have been performed in accordance with the laboratory's scope of accreditation

**BENKELMAN BEAM
TEST REPORT**



Project : Greenhill, Stage 13
 Location : Webb Drive, Southbound Lane
 Client : Online Contractors (2016) Limited
 Contractor : Online Contractors (2016) Limited
 Test method : TNZ T/1 1977
 Pavement type : Stabilised TNZ40
 Pavement temp °C : -
 Weight on rear axle : 8.3 tonnes
 Tested by : C.Brown, G.Tait

Project No : 2-68015.00
 Lab Ref No : HA6883a
 Client Ref :

Test Results				
Location Metres	Deflections (mm)			Comments
	Left WT	Right WT		
520	0.32			
530		0.10		
540	0.40			
550		0.30		
560	0.04			
570		0.30		
580	0.10			
590		0.36		
600	0.10			
610		0.36		
620	0.44			
630		0.30		
640	0.10			
650		0.32		
660	0.32			
670		0.32		
680	0.16			
690		0.30		
700	0.28			
710		0.40		
720	0.30			
730		0.40		
740	0.20			
750		0.26		
760	0.30			
770		0.34		
780	0.20			
790		0.20		
800	0.20			
	0.4			90 Percentile calculated for all data in columns 1 to 2.

Deflection Statistical Analysis (for all deflections)

Maximum (mm): 0.44	Minimum (mm): 0.04	Average (mm): 0.27
--------------------	--------------------	--------------------

Note: Results in *italics* have a difference between intermediate and Final readings that are greater than 3 (refer TNZ T/1 1977).

This report may only be reproduced in full

Date tested : 9/02/2021
 Date reported : 10/02/2021

IANZ Approved Signatory

Designation : Senior Civil Engineering Technician
 Date : 10/02/2021



All tests reported herein have been performed in accordance with the laboratory's scope of accreditation

**BENKELMAN BEAM
TEST REPORT**



Project : Greenhill, Stage 13
 Location : Webb Drive, Northbound Lane
 Client : Online Contractors (2016) Limited
 Contractor : Online Contractors (2016) Limited
 Test method : TNZ T/1 1977
 Pavement type : Stabilised TNZ40
 Pavement temp °C : -
 Weight on rear axle: 8.3 tonnes
 Tested by : C.Brown, G.Tait

Project No : 2-68015.00
 Lab Ref No : HA6883b_R
 Client Ref :

Test Results				
Location Metres	Deflections (mm)			Comments
	Left W1	Right W1		
540	0.24			
550		0.44		
560	0.40			
570		0.48		
580	0.36			
590		0.44		
600	0.32			
610		0.20		
620	0.30			
630		0.22		
640	0.44			
650		0.30		
660	0.44			
670		0.30		
680	0.40			
690		0.16		
700	0.40			
710		0.34		
720	0.30			
730		0.16		
740	0.59			
750		0.20		
760	0.16			
	0.44			90 Percentile calculated for all data in columns 1 to 2.

Deflection Statistical Analysis (for all deflections)

Maximum (mm): 0.59	Minimum (mm) : 0.16	Average (mm): 0.33
---------------------------	---------------------	--------------------

Note: Results in italics have a difference between Intermediate and Final readings that are greater than 3 (refer TNZ T/1 1977).

Note: This report replaces report HA6883b dated 10/2/21.

This report may only be reproduced in full

Date tested : 9/02/2021
 Date reported : 10/02/2021

IANZ Approved Signatory

Designation : Senior Civil Engineering Technician
 Date : 10/02/2021



All tests reported herein have been performed in accordance with the laboratory's scope of accreditation

Surfacing & RAMM Data 2(d)

- HCC pavement RAMM data
- Surfacing RAMM data



F3.7 RAMM ASPHALT DATA

(to be completed for each seal layer on each road section)

Subdivision Greenhill Park Stage 13

Road No / Name Carrs Rd

Start m	Start Description	End of seal
<u>CH320</u>		
<u>CH580</u>		<u>end of seal</u>
	<u>End Description</u>	<u>prior to roundabout</u>

Width 9m

Contractor Online Contractors 2016 LTD

Date of Work _____

Asphalt Type (circle one) AC / OGPA / SMA / Other

Grading (e.g. M/10 DG10) DG10

Area Surfaced (m²) 2400

Average thickness (mm) 46 mm

Laying Temperature (°C) 14.9°C

Tack Coat Residual Application Rate (L/m²) 1.0 L/m²

Additional Notes (e.g. Weather, Temp, Polymer Modification) Dry.

F3.8 RAMM CHIPSEAL DATA

(to be completed for each seal layer on each road section)

Subdivision	Greenhill Park Stage 13		
Road No / Name	Carrs Rd		
Start m	CH320	Start Description	end of seal
End m	CH560	End Description	prior to roundabout
Width	9m		
Contractor	Online Contractors 2016 Ltd		
Date of Work			
Seal Type (circle one)	1 Coat / Racked in Chipseal / 2 Coat / Other		
Seal Reason	Waterproofing First Coat / Second Coat / Asphalt Membrane		
Area Sealed (m ²)	2400		
Chip Grading (e.g. 3/5)	n grade 4		
Binder Type (e.g. B180/200)	CRS2 - Emulsion		
Chip Source Company	J-Swap		
Chip Source Quarry	Papatua Quarry		
Total Volume of Binder Used (Hot) (Litres)	3360		
Temperature of Binder (°C)	80°C		
Residual Binder Rate (L/m ²)	1.0L/m ²		
Cutter (e.g. 3 pph Kero)	-		
Other Additives with concentrations (e.g. Polymer modification RS1, 3%)			
Sealing Notes (e.g. Weather, Temp)	-		
Surfacing Chip PSV testing form attached	<input type="checkbox"/>		

F3.7 RAMM ASPHALT DATA

(to be completed for each seal layer on each road section)

Subdivision Greenhill Park Stage 13

Road No / Name Webb Dr **Including Roundabout**

Start m CH520 Start Description end of seal

End m CH980 End Description to roundabout south side

Width 5.3m each lane

Contractor Online Contractors 2016 Ltd

Date of Work 06-03-21

Asphalt Type (circle one) AC OGPA / SMA / Other

Grading (e.g. M10 DG10) AC 14

Area Surfaced (m²) 4107

Average thickness (mm) 50 mm

Laying Temperature (°C) 14.9°C

Tack Coat Residual Application Rate (L/m²) 1.02/m²

Additional Notes (e.g. Weather, Temp, Polymer Modification) Dry

F3.8 RAMM CHIPSEAL DATA

(to be completed for each seal layer on each road section)

Subdivision	Greenhill Park Stage 13		
Road No / Name	Webb Dr		
Start m	CH520	Start Description	end of seal
End m	CH860	End Description	to roundabout southside
Width	5.3m each lane		
Contractor	Online Contractors 2016 Ltd		
Date of Work			
Seal Type (circle one)	1 Coat / Racked in Chipseal / 2 Coat / Other.		
Seal Reason	Waterproofing First Coat / Second Coat / Asphalt Membrane		
Area Sealed (m ²)	9107 m ²		
Chip Grading (e.g. 3/5)	Grade 4		
Binder Type (e.g. B180/200)	CRS2 Emulsion		
Chip Source Company	J. SWAP.		
Chip Source Quarry	TACTAD900A		
Total Volume of Binder Used (Hot) (Litres)	8624.7		
Temperature of Binder (°C)	80°C.		
Residual Binder Rate (L/m ²)	2.0L/m ²		
Cutter (e.g. 3 pph Kero)	-		
Other Additives with concentrations (e.g. Polymer modification RS1, 3%)	-		
Sealing Notes (e.g. Weather, Temp)			
Surfacing Chip PSV testing form attached	<input type="checkbox"/>		

F3.9 RAMM PAVEMENT DATA

(to be completed for each road section)

Subdivision GREENHILL PARK - STAGE 13
 Road No / Name CARRS ROAD
 Start m 330 Start Description ATHIER AVENUE
 End m 580 End Description WEBB DRIVE ROUNDABOUT
 Width 9m

Basecourse

Date Completed 18-2-21
 Thickness 150mm
 Grading TNZ M/A AP40
 Quarry STEVENSONS TAUHEI

Sub-Base

Date Completed 4-12-2020
 Thickness 200mm
 Grading GAP65
 Quarry GLEESON (HUNTLY)

Undercut / Imported Subgrade (If Required)

Whole Site Yes No
 Length 250m
 Width 9.5m
 Depth 0.5m
 Backfill Material HARD BROWN ROCK

Subgrade

CBR Without 15
 Stabilisation _____
 Material _____
 Stabilised? No / Cement / Lime
 % Stabilising Agent _____
 Stabilised Depth _____
 Stabilised CBR _____

F3.9 RAMM PAVEMENT DATA

(to be completed for each road section)

Subdivision GREENHILL PARK - STAGE 13
 Road No / Name WEBB DRIVE
 Start m 540 Start Description ROAD 20
 End m 850 End Description CARRS ROAD ROUNDABOUT
 Width 5m SOUTHBOUND & 5m NORTHBOUND

Basecourse

Date Completed 11-2-2021
 Thickness 180mm 2% CEMENT
 Grading TNZ M/A AP40
 Quarry STEVENSONS TAUHEI

Sub-Base

Date Completed 10-11-2020
 Thickness 170mm
 Grading GAP 65
 Quarry GLEESON (HUNTLY)

Undercut / Imported Subgrade (If Required)

Whole Site Yes No
 Length 310m
 Width 5.5m SOUTHBOUND & 5.5m NORTHBOUND
 Depth 0.5m
 Backfill Material HARD BROWN ROCK

Subgrade

CBR Without 15
 Stabilisation _____
 Material _____
 Stabilised? No Cement Lime
 % Stabilising Agent _____
 Stabilised Depth _____
 Stabilised CBR _____

APPENDIX 3

Water Construction QA Documentation

- Pipe Laying Checklists F6.2
- Final Inspection Checklist F6.3
- Laboratory Water Test Results
- Pressure Test Results





WATER SUPPLY PIPE LAYING CHECKLIST

SITE ADDRESS: GREENHILL PARK STAGE 13

NAME OF DEVELOPER: ^{OUTSTANDING} ONLINE CONTRACTORS

NAME OF QUALIFIED WATER SERVICE PERSON: TC RUKI SUREHAN

Location: Pipe length (Intersection to Intersection and side)	FROM	WEST EAST		Tick if satisfactory	Tick if satisfactory	Tick if satisfactory	Tick if satisfactory	Tick if satisfactory
		EOS NEB3 OR	EOS WEL6 OR					
	TO	RNABOUE	RNABOUE					
Pipe size, pressure rating, material, acceptable products checked (attach photo of manufacturer's stamp on pipe)		250	150					
Foundation support attached		N/A	N/A					
Dynamic cone penetrometer (DCP) results available		N/A	N/A					
If under-cutting required, note metreage and DCP:		N/A	N/A					
Bedding type and backfill material (DCP results for road crossings and driveways attached?) YES <input type="checkbox"/> NO <input checked="" type="checkbox"/>		SAND	SAND					
Valves and hydrants not in carriageway		✓	✓					
Alignment and cover		✓	✓					
All service connections in place (Table of water meter and backflow preventor numbers with corresponding lot numbers attached?) YES <input type="checkbox"/> NO <input type="checkbox"/>		N/A	N/A					
Connections and Toby Box correctly located horizontally and vertically (as per standard drawings)		✓	✓					
Hydrants and valves positioned correctly (as per standard drawings)		✓	✓					
Thrust blocks installed		✓	✓					
Pipelines flushed		✓	✓					
As-built measurements taken prior to backfill		✓	✓					
Pressure test witnessed and passed by Council representative		✓	✓					

	Tick if satisfactory	Tick if satisfactory	Tick if satisfactory	Tick if satisfactory	Tick if satisfactory
Bacto sample taken and passed by Council representative PRIOR to connection to the live Council main	✓	✓			
Connection to live main by Council (unless specifically approved)	✓	✓			

Main left charged at FAC level of _____ ppm

DAN HOPKIN

Developer/Contractor's name
(please print)



Developer/Contractor's signature

11-03-21

Date signed

Council Representative's name (please print)

Council Representative's signature

Date signed



WATER SUPPLY PIPE LAYING CHECKLIST

SITE ADDRESS: GREENHILL ROAD STAGE 13

NAME OF DEVELOPER: ^{CONTRACTOR} ONLINE CONNECTIONS

NAME OF QUALIFIED WATER SERVICE PERSON: TE RUCI STEPHAN


Location: Pipe length (Intersection to Intersection and side)	M + 4		4H		
	FROM	TO	150	250	
			Tick if satisfactory	Tick if satisfactory	Tick if satisfactory
Pipe size, pressure rating, material, acceptable products checked (attach photo of manufacturer's stamp on pipe)			150	250	
Foundation support attached			N/A	MA	
Dynamic cone penetrometer (DCP) results available			N/A	MA	
If under-cutting required, note metreage and DCP:			MA	N/A	
Bedding type and backfill material (DCP results for road crossings and driveways attached?) YES <input type="checkbox"/> NO <input checked="" type="checkbox"/>			SAND	SAND	
Valves and hydrants not in carriageway			/	/	
Alignment and cover			/	/	
All service connections in place (Table of water meter and backflow preventor numbers with corresponding lot numbers attached?) YES <input checked="" type="checkbox"/> NO <input type="checkbox"/>			/	/	
Connections and Toby Box correctly located horizontally and vertically (as per standard drawings)			/	/	
Hydrants and valves positioned correctly (as per standard drawings)			/	/	
Thrust blocks installed			/	/	
Pipelines flushed			/	/	
As-built measurements taken prior to backfill			/	/	
Pressure test witnessed and passed by Council representative			/	/	

	Tick if satisfactory	Tick if satisfactory	Tick if satisfactory	Tick if satisfactory	Tick if satisfactory
Bacto sample taken and passed by Council representative PRIOR to connection to the live Council main	/	/			
Connection to live main by Council (unless specifically approved)	/	/			

Main left charged at FAC level of _____ ppm

DAM HOPKIN

Developer/Contractor's name
(please print)

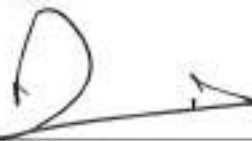

Developer/Contractor's signature

11-03-21

Date signed

Council Representative's name (please print)

Council Representative's signature

Date signed

WATER SUPPLY FINAL INSPECTION CHECKLIST

DEVELOPER/CONTRACTOR ONLINE CONTRACTORS LTD

SITE/LOCATION GREENHILL PARK STAGE 13

SUB /

CONTRACT NO

Developer to verify checklist prior to meeting	Developer Check	Council Rep Check
1. All lines flushed out	✓	
2. All backfilling complete and reinstated	✓	
3. Water Supply Design Confirmation form completed	✓	
4. Water Supply Pipe Laying Checklist completed	✓	
5. Final as-built plans attached for site inspection	✓	
6. Connected to existing supply by Council (<i>refer Water Supply Pipe Laying Checklist</i>)	✓	
Site Meeting:		
1. Valves and hydrants correctly marked <i>(Refer standard drawings for indicator posts)</i>	✓	
2. FH pavement markers in place	✓	
3. Fire hydrant lids painted	✓	
4. Valve and FH boxes installed correctly (<i>Refer standard drawings</i>)	✓	
5. All valves checked on/off	✓	
6. Remedial work required? Yes (<i>please list</i>) No		

DAN HOPPER
Developer/Contractor's name
(please print)


Developer/Contractor's signature

1/03/21
Date signed

Council Representative's name
(please print)

Council Representative's signature

Date signed

Sample ID	Sample Type	Site	Date Sampled	Date Received	Parameter Name	Result	Units	Lab	Status
2021000845	Hamilton Reticulation Maintenance	150 Greenhill west	16/02/2021	16/02/2021	Heterotrophic Plate Count 35°C	<1	cfu/mL	HCC Laboratory	e
2021000845	Hamilton Reticulation Maintenance	150 Greenhill west	16/02/2021	16/02/2021	Temperature On Arrival	17.1	°C	HCC Laboratory	e
2021000845	Hamilton Reticulation Maintenance	150 Greenhill west	16/02/2021	16/02/2021	E.coli Enumerated	<1	MPN/100mL	HCC Laboratory	e
2021000845	Hamilton Reticulation Maintenance	150 Greenhill west	16/02/2021	16/02/2021	Total Coliforms Enumerated	<1	MPN/100mL	HCC Laboratory	e
2021000845	Hamilton Reticulation Maintenance	150 Greenhill west	16/02/2021	16/02/2021	Time Sampled (client)	06:30		Client	e
2021000845	Hamilton Reticulation Maintenance	150 Greenhill west	16/02/2021	16/02/2021	Sampler (client)	Lance Parkes		Client	e
2021000846	Hamilton Reticulation Maintenance	150 Greenhill North	16/02/2021	16/02/2021	Heterotrophic Plate Count 35°C	5	cfu/mL	HCC Laboratory	e
2021000846	Hamilton Reticulation Maintenance	150 Greenhill North	16/02/2021	16/02/2021	Temperature On Arrival	16.8	°C	HCC Laboratory	e
2021000846	Hamilton Reticulation Maintenance	150 Greenhill North	16/02/2021	16/02/2021	E.coli Enumerated	<1	MPN/100mL	HCC Laboratory	e
2021000846	Hamilton Reticulation Maintenance	150 Greenhill North	16/02/2021	16/02/2021	Total Coliforms Enumerated	<1	MPN/100mL	HCC Laboratory	e
2021000846	Hamilton Reticulation Maintenance	150 Greenhill North	16/02/2021	16/02/2021	Time Sampled (client)	06:35		Client	e
2021000846	Hamilton Reticulation Maintenance	150 Greenhill North	16/02/2021	16/02/2021	Sampler (client)	Lance Parkes		Client	e
2021000847	Hamilton Reticulation Maintenance	150 Greenhill East	16/02/2021	16/02/2021	Heterotrophic Plate Count 35°C	<1	cfu/mL	HCC Laboratory	e
2021000847	Hamilton Reticulation Maintenance	150 Greenhill East	16/02/2021	16/02/2021	Temperature On Arrival	17.7	°C	HCC Laboratory	e
2021000847	Hamilton Reticulation Maintenance	150 Greenhill East	16/02/2021	16/02/2021	E.coli Enumerated	<1	MPN/100mL	HCC Laboratory	e
2021000847	Hamilton Reticulation Maintenance	150 Greenhill East	16/02/2021	16/02/2021	Total Coliforms Enumerated	<1	MPN/100mL	HCC Laboratory	e
2021000847	Hamilton Reticulation Maintenance	150 Greenhill East	16/02/2021	16/02/2021	Time Sampled (client)	06:45		Client	e
2021000847	Hamilton Reticulation Maintenance	150 Greenhill East	16/02/2021	16/02/2021	Sampler (client)	Lance Parkes		Client	e

Test Certificate

Date	4 Feb 2021
Project Name	Greenhill
Plan No.	Stage 15, 14 & 13
Contractor	Online
Contractors Rep	Tyler Maiki
HCC Officer	M. Gibs

Water Reticulation

Pressure Test – Water

171-PSI




or

1200kPa



for 15mins

Test Name	PN Rating	Pipe Size	Start	Finish	Length	Result
PT	16	150mm 63mm	10.45	11.00	600m	Pass

Signature HCC Test Official	
Signature Contractor Representative	

APPENDIX 4

Wastewater Construction and QA Records

- Wastewater Pipe Laying Checklist F5.2
- Wastewater Manhole Checklist F5.3
- Wastewater trench Backfill Summary Checklist F5.4
- Wastewater Final Inspection Checklist F5.6
- Pressure Test Results
- CCTV submission email



F5.2 WASTEWATER PIPE LAYING CHECKLIST

Engineering plan number(s): <u>21879-M-13-S01</u>					
Name of certified drainlayer: <u>Zane Millar</u>					
Location: Pipe length (MH To MH)	<u>FEI</u> to <u>18.5</u>	<u>18.5</u> to <u>18.4</u>	<u>18.4</u> to <u>16.3</u>	<u>16.3</u> to <u>18.1</u>	<u>18.1</u> to <u>18.2</u>

Pipe Laying Checks

Trench Safety	<input checked="" type="checkbox"/>	<input checked="" type="checkbox"/>	<input checked="" type="checkbox"/>	<input checked="" type="checkbox"/>	<input checked="" type="checkbox"/>
(d) Shield	<input checked="" type="checkbox"/>	<input checked="" type="checkbox"/>	<input checked="" type="checkbox"/>	<input checked="" type="checkbox"/>	<input checked="" type="checkbox"/>
(e) Batter	<input type="checkbox"/>	<input type="checkbox"/>	<input type="checkbox"/>	<input type="checkbox"/>	<input type="checkbox"/>
(f) Other	<input type="checkbox"/>	<input type="checkbox"/>	<input type="checkbox"/>	<input type="checkbox"/>	<input type="checkbox"/>
Pipe size, quality, manufacturer, on acceptable products list	<input checked="" type="checkbox"/>	<input checked="" type="checkbox"/>	<input checked="" type="checkbox"/>	<input checked="" type="checkbox"/>	<input checked="" type="checkbox"/>
Set out	<input checked="" type="checkbox"/>	<input checked="" type="checkbox"/>	<input checked="" type="checkbox"/>	<input checked="" type="checkbox"/>	<input checked="" type="checkbox"/>
- Surveyors name <u>Online</u>	<input checked="" type="checkbox"/>	<input checked="" type="checkbox"/>	<input checked="" type="checkbox"/>	<input checked="" type="checkbox"/>	<input checked="" type="checkbox"/>
Service connections

All service connections in place, taped, and staked	<input checked="" type="checkbox"/>	<input checked="" type="checkbox"/>	<input checked="" type="checkbox"/>	<input checked="" type="checkbox"/>	<input checked="" type="checkbox"/>
As-built measurements taken, GPS located	<input checked="" type="checkbox"/>	<input checked="" type="checkbox"/>	<input checked="" type="checkbox"/>	<input checked="" type="checkbox"/>	<input checked="" type="checkbox"/>
CCTV pipe inspection data and comments supplied	<input checked="" type="checkbox"/>	<input checked="" type="checkbox"/>	<input checked="" type="checkbox"/>	<input checked="" type="checkbox"/>	<input checked="" type="checkbox"/>

West Construction

16/12/20

Developer/Contractor

Date

F5.2 WASTEWATER PIPE LAYING CHECKLIST

Engineering plan number(s):	21879-M-13-501				
Name of certified drainlayer:	Zane Milliken				
Location: Pipe length (MH To MH)	18.2 to 18.1	18.2 to 19.2	19.2 to 19.1	19.2 to 19.1	19.2 to 20.2

Pipe Laying Checks

Trench Safety	<input checked="" type="checkbox"/>	<input checked="" type="checkbox"/>	<input checked="" type="checkbox"/>	<input checked="" type="checkbox"/>	<input checked="" type="checkbox"/>
(d) Shield	<input checked="" type="checkbox"/>	<input checked="" type="checkbox"/>	<input checked="" type="checkbox"/>	<input checked="" type="checkbox"/>	<input checked="" type="checkbox"/>
(e) Batter	<input type="checkbox"/>	<input type="checkbox"/>	<input type="checkbox"/>	<input type="checkbox"/>	<input type="checkbox"/>
(f) Other	<input type="checkbox"/>	<input type="checkbox"/>	<input type="checkbox"/>	<input type="checkbox"/>	<input type="checkbox"/>
Pipe size, quality, manufacturer, on acceptable products list	<input checked="" type="checkbox"/>	<input checked="" type="checkbox"/>	<input checked="" type="checkbox"/>	<input checked="" type="checkbox"/>	<input checked="" type="checkbox"/>
Set out	<input checked="" type="checkbox"/>	<input checked="" type="checkbox"/>	<input checked="" type="checkbox"/>	<input checked="" type="checkbox"/>	<input checked="" type="checkbox"/>
- Surveyors name <u>Online</u>	<input checked="" type="checkbox"/>	<input checked="" type="checkbox"/>	<input checked="" type="checkbox"/>	<input checked="" type="checkbox"/>	<input checked="" type="checkbox"/>
- Set out checked	<input checked="" type="checkbox"/>	<input checked="" type="checkbox"/>	<input checked="" type="checkbox"/>	<input checked="" type="checkbox"/>	<input checked="" type="checkbox"/>
Bulk backfill compaction (DCP results from pipe to ground level attached)	<input checked="" type="checkbox"/>	<input checked="" type="checkbox"/>	<input checked="" type="checkbox"/>	<input checked="" type="checkbox"/>	<input checked="" type="checkbox"/>
Alignment - control points identified	<input checked="" type="checkbox"/>	<input checked="" type="checkbox"/>	<input checked="" type="checkbox"/>	<input checked="" type="checkbox"/>	<input checked="" type="checkbox"/>
Pressure test witnessed and passed by Council representative.	<input checked="" type="checkbox"/>	<input checked="" type="checkbox"/>	<input checked="" type="checkbox"/>	<input checked="" type="checkbox"/>	<input checked="" type="checkbox"/>

Service connections

All service connections in place, taped, and staked	<input checked="" type="checkbox"/>	<input checked="" type="checkbox"/>	<input checked="" type="checkbox"/>	<input checked="" type="checkbox"/>	<input checked="" type="checkbox"/>
As-built measurements taken, GPS located	<input checked="" type="checkbox"/>	<input checked="" type="checkbox"/>	<input checked="" type="checkbox"/>	<input checked="" type="checkbox"/>	<input checked="" type="checkbox"/>
CCTV pipe inspection data and comments supplied	<input checked="" type="checkbox"/>	<input checked="" type="checkbox"/>	<input checked="" type="checkbox"/>	<input checked="" type="checkbox"/>	<input checked="" type="checkbox"/>

West Construction

16/12/20

Developer/Contractor

Date

F5.2 WASTEWATER PIPE LAYING CHECKLIST

Engineering plan number(s):	21879-M-13-501												
Name of certified drainlayer:	Zane Miller												
Location: Pipe length (MH To MH)	20.2	to	20.1	20.2	to	21.3	21.2	to	21.2	21.1	22.2	to	22.1

Pipe Laying Checks

Trench Safety	<input checked="" type="checkbox"/>	<input checked="" type="checkbox"/>	<input checked="" type="checkbox"/>	<input checked="" type="checkbox"/>	<input checked="" type="checkbox"/>
(d) Shield	<input checked="" type="checkbox"/>	<input checked="" type="checkbox"/>	<input checked="" type="checkbox"/>	<input checked="" type="checkbox"/>	<input checked="" type="checkbox"/>
(e) Batter	<input type="checkbox"/>	<input type="checkbox"/>	<input type="checkbox"/>	<input type="checkbox"/>	<input type="checkbox"/>
(f) Other	<input type="checkbox"/>	<input type="checkbox"/>	<input type="checkbox"/>	<input type="checkbox"/>	<input type="checkbox"/>
Pipe size, quality, manufacturer, on acceptable products list	<input checked="" type="checkbox"/>	<input checked="" type="checkbox"/>	<input checked="" type="checkbox"/>	<input checked="" type="checkbox"/>	<input checked="" type="checkbox"/>
Set out	<input checked="" type="checkbox"/>	<input checked="" type="checkbox"/>	<input checked="" type="checkbox"/>	<input checked="" type="checkbox"/>	<input checked="" type="checkbox"/>
West Construction

16/12/20

Developer/Contractor

Date

F5.3 WASTEWATER MANHOLE CHECKLIST

Engineering Plan Number(s) <i>21879-M-13-502</i>					
Name of certified drainlayer: <i>Zane Miller</i>					
Location: Pipe length (MH To MH)	<i>18.5</i>	<i>18.4</i>	<i>18.3</i>	<i>18A1</i>	<i>18.2</i>
Manhole Construction Checklist	MH number				
Manhole size, quality, manufacturer on acceptable materials list	<input checked="" type="checkbox"/>	<input checked="" type="checkbox"/>	<input checked="" type="checkbox"/>	<input checked="" type="checkbox"/>	<input checked="" type="checkbox"/>
Set out /orientation	<input checked="" type="checkbox"/>	<input checked="" type="checkbox"/>	<input checked="" type="checkbox"/>	<input checked="" type="checkbox"/>	<input checked="" type="checkbox"/>
Sealing strip between risers	<input checked="" type="checkbox"/>	<input checked="" type="checkbox"/>	<input checked="" type="checkbox"/>	<input checked="" type="checkbox"/>	<input checked="" type="checkbox"/>
Benching					
• Height	<input checked="" type="checkbox"/>	<input checked="" type="checkbox"/>	<input checked="" type="checkbox"/>	<input checked="" type="checkbox"/>	<input checked="" type="checkbox"/>
• Alignment and cross section	<input checked="" type="checkbox"/>	<input checked="" type="checkbox"/>	<input checked="" type="checkbox"/>	<input checked="" type="checkbox"/>	<input checked="" type="checkbox"/>
• Half pipe lining (wastewater only)	<input checked="" type="checkbox"/>	<input checked="" type="checkbox"/>	<input checked="" type="checkbox"/>	<input checked="" type="checkbox"/>	<input checked="" type="checkbox"/>
• Step recesses (if applicable)	<input type="checkbox"/>	<input type="checkbox"/>	<input type="checkbox"/>	<input type="checkbox"/>	<input type="checkbox"/>
Flexible joints	<input checked="" type="checkbox"/>	<input type="checkbox"/>	<input type="checkbox"/>	<input type="checkbox"/>	<input type="checkbox"/>
West Construction

16/12/20

Developer/Contractor

Date

F5.3 WASTEWATER MANHOLE CHECKLIST

Engineering Plan Number(s)	21879-M-13-S01				
Name of certified drainlayer:	Zane Milken				
Location: Pipe length (MH To MH)	18.1	19.2	19.1	19.1	20.2
Manhole Construction Checklist	MH number				
Manhole size, quality, manufacturer on acceptable materials list	<input checked="" type="checkbox"/>	<input type="checkbox"/>	<input checked="" type="checkbox"/>	<input checked="" type="checkbox"/>	<input checked="" type="checkbox"/>
Set out /orientation	<input checked="" type="checkbox"/>	<input checked="" type="checkbox"/>	<input checked="" type="checkbox"/>	<input checked="" type="checkbox"/>	<input checked="" type="checkbox"/>
Sealing strip between risers	<input checked="" type="checkbox"/>	<input checked="" type="checkbox"/>	<input checked="" type="checkbox"/>	<input checked="" type="checkbox"/>	<input checked="" type="checkbox"/>
Benching					
• Height	<input checked="" type="checkbox"/>	<input checked="" type="checkbox"/>	<input checked="" type="checkbox"/>	<input checked="" type="checkbox"/>	<input checked="" type="checkbox"/>
• Alignment and cross section	<input checked="" type="checkbox"/>	<input checked="" type="checkbox"/>	<input checked="" type="checkbox"/>	<input checked="" type="checkbox"/>	<input checked="" type="checkbox"/>
• Half pipe lining (wastewater only)	<input checked="" type="checkbox"/>	<input checked="" type="checkbox"/>	<input checked="" type="checkbox"/>	<input checked="" type="checkbox"/>	<input checked="" type="checkbox"/>
• Step recesses (if applicable)	<input type="checkbox"/>	<input type="checkbox"/>	<input type="checkbox"/>	<input type="checkbox"/>	<input type="checkbox"/>
Flexible joints	<input checked="" type="checkbox"/>	<input checked="" type="checkbox"/>	<input checked="" type="checkbox"/>	<input checked="" type="checkbox"/>	<input checked="" type="checkbox"/>
WAST Construction

Developer/Contractor

16/12/20

Date

F5.3 WASTEWATER MANHOLE CHECKLIST

Engineering Plan Number(s) <i>21879-M-13-502</i>						
Name of certified drainlayer: <i>Zane Milder</i>						
Location: Pipe length (MH To MH)	<i>20.1</i>	<i>21.3</i>	<i>21.2</i>	<i>21.1</i>	<i>22.2</i>	<i>22.1</i>
Manhole Construction Checklist	MH number					
Manhole size, quality, manufacturer on acceptable materials list	<input checked="" type="checkbox"/>	<input checked="" type="checkbox"/>	<input checked="" type="checkbox"/>	<input checked="" type="checkbox"/>	<input checked="" type="checkbox"/>	<input checked="" type="checkbox"/>
Set out /orientation	<input checked="" type="checkbox"/>	<input checked="" type="checkbox"/>	<input checked="" type="checkbox"/>	<input checked="" type="checkbox"/>	<input checked="" type="checkbox"/>	<input checked="" type="checkbox"/>
Sealing strip between risers	<input checked="" type="checkbox"/>	<input checked="" type="checkbox"/>	<input checked="" type="checkbox"/>	<input checked="" type="checkbox"/>	<input checked="" type="checkbox"/>	<input checked="" type="checkbox"/>
Benching						
• Height	<input checked="" type="checkbox"/>	<input checked="" type="checkbox"/>	<input checked="" type="checkbox"/>	<input checked="" type="checkbox"/>	<input checked="" type="checkbox"/>	<input checked="" type="checkbox"/>
• Alignment and cross section	<input checked="" type="checkbox"/>	<input checked="" type="checkbox"/>	<input checked="" type="checkbox"/>	<input checked="" type="checkbox"/>	<input checked="" type="checkbox"/>	<input checked="" type="checkbox"/>
• Half pipe lining (wastewater only)	<input checked="" type="checkbox"/>	<input checked="" type="checkbox"/>	<input checked="" type="checkbox"/>	<input checked="" type="checkbox"/>	<input checked="" type="checkbox"/>	<input checked="" type="checkbox"/>
Date

F5.4 WASTEWATER TRENCH BACKFILL COMPACTION TEST SUMMARY (ATTACH INDIVIDUAL TEST REPORTS)

Technician Carrying out Tests:	West Construction
Location:	Greenhill Park 13, 14, 15
Plan No(s):	21872-M-13-502
From MH	22.2 - 22.1
Acceptance Criteria:	
Tests by:	West Construction

(attached)

Analysis of Results

Trench backfill completed satisfactorily

or

Trench backfill requires remedial work as follows:

West Construction

Developer/Contractor

16/12/20

Date

F5.4 WASTEWATER TRENCH BACKFILL COMPACTION TEST SUMMARY (ATTACH INDIVIDUAL TEST REPORTS)

Technician Carrying out Tests:	West Construction
Location:	Greenhill Park 13/14/15
Plan No(s):	21879-M-13-501
From MH	19.2-20.2-21.3-21.2-21.1-20.1
Acceptance Criteria:	CBR > 16
Tests by:	West Construction

(attached)

Analysis of Results

Trench backfill completed satisfactorily

or

Trench backfill requires remedial work as follows:

•

West Construction

Developer/Contractor

16/12/20

Date

F5.4 WASTEWATER TRENCH BACKFILL COMPACTION TEST SUMMARY (ATTACH INDIVIDUAL TEST REPORTS)

Technician Carrying out Tests:	West Construction
Location:	Greenhill Park 13, 14, 15
Plan No(s):	21879-M-13-SOA
From MH	FET, 18.5, 18.4, 18.3, 18.2, 18.1, 18A1
Acceptance Criteria:	CBR > 16
Tests by:	West Construction

(attached)

Analysis of Results

Trench backfill completed satisfactorily

or

Trench backfill requires remedial work as follows:

-

West Construction

Developer/Contractor

16/12/20

Date

F5.4 WASTEWATER TRENCH BACKFILL COMPACTION TEST SUMMARY (ATTACH INDIVIDUAL TEST REPORTS)

Technician Carrying out Tests:	West Construction
Location:	Greenhill 13,14,15
Plan No(s):	21879-M-13-502
From MH	18.2-19.2,17A1-19.1
Acceptance Criteria:	CBR > 16
Tests by:	West Construction

(attached)

Analysis of Results

Trench backfill completed satisfactorily

or

Trench backfill requires remedial work as follows:

•

West Construction

Developer/Contractor

16/12/20

Date

F4.6 STORMWATER PIPE NETWORK - FINAL INSPECTION CHECKLIST

Site/Location: *Greenhill Park Stages 13,14,15*

Developer/Contractor: *West Construction*

SUB ____ / ____ Contract No: _____

PRE-MEETING TASKS

Developer to verify checklist prior to meeting:	Developer Check	Council Rep Check
1. All relevant stormwater checklists completed	<input checked="" type="checkbox"/>	<input type="checkbox"/>
2. All lines flushed out	<input checked="" type="checkbox"/>	<input type="checkbox"/>
3. All required CCTV inspections carried out, reviewed and any re-work completed.	<input checked="" type="checkbox"/>	<input type="checkbox"/>
4. All manholes checked (eg infiltration, plastering)	<input checked="" type="checkbox"/>	<input type="checkbox"/>
5. All backfilling complete and tidied up	<input checked="" type="checkbox"/>	<input type="checkbox"/>
6. Final as-built and operational plans attached for site inspection	<input type="checkbox"/>	<input type="checkbox"/>

SITE MEETING

1. Inspect all lines	<input type="checkbox"/>	<input type="checkbox"/>
2. Inspect all manholes and catchpits	<input type="checkbox"/>	<input type="checkbox"/>
3. Works on third party land completed to satisfaction of owner	<input type="checkbox"/>	<input type="checkbox"/>
4. Overland flow to and from adjoining properties not affected	<input type="checkbox"/>	<input type="checkbox"/>
5. Remedial work required? <input type="checkbox"/> Yes (please list) <input type="checkbox"/> No		

West Construction

Developer

Council

Date *9/3/21*

Date

F5.6 WASTEWATER PIPE NETWORK - FINAL INSPECTION CHECKLIST

Site/Location: *Greenhill Park Stages 13,14,15*

Developer/Contractor: *West Construction*

SUB _____ / _____ Contract No: _____

Developer to verify checklist prior to meeting:	Developer Check	Council Rep Check
6. All checklists completed (add form numbers)	<input checked="" type="checkbox"/>	<input type="checkbox"/>
7. All lines flushed out	<input checked="" type="checkbox"/>	<input type="checkbox"/>
8. All required CCTV inspections carried out, reviewed and any re-work completed.	<input checked="" type="checkbox"/>	<input type="checkbox"/>
9. All manholes checked (eg. Infiltration, plastering)	<input checked="" type="checkbox"/>	<input type="checkbox"/>
10. All backfilling complete and tidied up	<input checked="" type="checkbox"/>	<input type="checkbox"/>
11. Pressure test completed and witnessed	<input checked="" type="checkbox"/>	<input type="checkbox"/>
12. Final as-built and operational plans attached for site inspection	<input type="checkbox"/>	<input type="checkbox"/>

Site Meeting

13. Inspect all lines	<input type="checkbox"/>	<input type="checkbox"/>
14. Inspect all manholes and catchpits	<input type="checkbox"/>	<input type="checkbox"/>
15. Inspect SW inlet and outlet structures	<input type="checkbox"/>	<input type="checkbox"/>
16. Secondary flowpaths and detention ponds	<input type="checkbox"/>	<input type="checkbox"/>
17. Works on third party land completed to satisfaction of owner	<input type="checkbox"/>	<input type="checkbox"/>
18. Wastewater pumping station data complete and test results (Form F5.7) attached	<input type="checkbox"/>	<input type="checkbox"/>
19. Overland flow to and from adjoining properties not affected	<input type="checkbox"/>	<input type="checkbox"/>
20. Remedial work required?	<input type="checkbox"/> Yes (please list)	<input type="checkbox"/> No

Council _____

Developer _____

West Construction 9/3/21



BACKFILL RESULT SHEET

TESTED BY: West Construction

PROJECT NAME : Greenhill Park Stages 13,14,15

Sewer Chainage	C/L Trench(CIV VALUES)		Remarks
	1ST LIFT	SECOND LIFT	
FEI WWMH1.9			
10	24	21	BROWN ROCK 1M TESTS
20	26	19	BROWN ROCK 1M TESTS
SSMH18.5			
10	21	17	BROWN ROCK 1M TESTS
20	23	22	BROWN ROCK 1M TESTS
30	27	29	BROWN ROCK 1M TESTS
40	29	24	BROWN ROCK 1M TESTS
50	22	21	BROWN ROCK 1M TESTS
60	24	27	BROWN ROCK 1M TESTS
70	28	20	BROWN ROCK 1M TESTS
80	26	23	BROWN ROCK 1M TESTS
SSMH18.4			
10	27	24	BROWN ROCK 1M TESTS
20	21	25	BROWN ROCK 1M TESTS
30	24	20	BROWN ROCK 1M TESTS
40	21	18	BROWN ROCK 1M TESTS
50	27	24	BROWN ROCK 1M TESTS
60	20	22	BROWN ROCK 1M TESTS
SSMH18.3			
10	22	18	BROWN ROCK 1M TESTS
20	21	22	BROWN ROCK 1M TESTS
30	27	20	BROWN ROCK 1M TESTS
40	25	27	BROWN ROCK 1M TESTS
50	29	23	BROWN ROCK 1M TESTS
60	19	22	BROWN ROCK 1M TESTS
70	21	26	BROWN ROCK 1M TESTS
SSMH18.2			
10	20	24	BROWN ROCK 1M TESTS
20	22	19	BROWN ROCK 1M TESTS
30	24	29	BROWN ROCK 1M TESTS
40	21	26	BROWN ROCK 1M TESTS
50	21		BROWN ROCK 1M TESTS
60	23		BROWN ROCK 1M TESTS
70	25		BROWN ROCK 1M TESTS
80	21		BROWN ROCK 1M TESTS
SSMH18.1			
SSMH18.3			
10	23	21	BROWN ROCK 1M TESTS
20	27	26	BROWN ROCK 1M TESTS
30	21	25	BROWN ROCK 1M TESTS
40	24		BROWN ROCK 1M TESTS
50	29		BROWN ROCK 1M TESTS
60	24		BROWN ROCK 1M TESTS
SSMH18.A1			
SSMH18.2			
10	22	19	BROWN ROCK 1M TESTS
20	24	22	BROWN ROCK 1M TESTS

TESTED BY:	West Construction		
PROJECT NAME :	Greenhill Park Stages 13,14,15		
30	21	24	BROWN ROCK 1M TESTS
40	29	26	BROWN ROCK 1M TESTS
50	24	25	BROWN ROCK 1M TESTS
60	27	30	BROWN ROCK 1M TESTS
SSMH19.2			
10	29	22	BROWN ROCK 1M TESTS
20	24	26	BROWN ROCK 1M TESTS
30	25	23	BROWN ROCK 1M TESTS
40	26	24	BROWN ROCK 1M TESTS
50	24		BROWN ROCK 1M TESTS
60	21		BROWN ROCK 1M TESTS
70	26		BROWN ROCK 1M TESTS
80	28		BROWN ROCK 1M TESTS
90	24		BROWN ROCK 1M TESTS
SSMH19.1			
SSMH19.2			
10	22		BROWN ROCK 1M TESTS
SSMH19.A1			
SSMH18.2			
10	21	26	BROWN ROCK 1M TESTS
20	23	22	BROWN ROCK 1M TESTS
30	24	24	BROWN ROCK 1M TESTS
40	27	36	BROWN ROCK 1M TESTS
50	19	25	BROWN ROCK 1M TESTS
60	21	24	BROWN ROCK 1M TESTS
SSMH20.2			
10	19	23	BROWN ROCK 1M TESTS
20	20	24	BROWN ROCK 1M TESTS
30	24	21	BROWN ROCK 1M TESTS
40	26	22	BROWN ROCK 1M TESTS
50	22		BROWN ROCK 1M TESTS
60	23		BROWN ROCK 1M TESTS
70	20		BROWN ROCK 1M TESTS
80	21		BROWN ROCK 1M TESTS
SSMH20.1			
SSMH20.2			
10	25	19	BROWN ROCK 1M TESTS
20	24	18	BROWN ROCK 1M TESTS
30	23	26	BROWN ROCK 1M TESTS
40	26	21	BROWN ROCK 1M TESTS
SSMH21.3			
10	20	25	BROWN ROCK 1M TESTS
20	24	23	BROWN ROCK 1M TESTS
SSMH21.2			
10	24	21	BROWN ROCK 1M TESTS
20	25	23	BROWN ROCK 1M TESTS
30	28	25	BROWN ROCK 1M TESTS
40	23	22	BROWN ROCK 1M TESTS
50	29		BROWN ROCK 1M TESTS
60	21		BROWN ROCK 1M TESTS

TESTED BY:	West Construction		
PROJECT NAME :	Greenhill Park Stages 13,14,15		
70	25		BROWN ROCK 1M TESTS
SSMH21.1			

HCC WW testing Report

HCC WW testing Report

Complete

Score	0%	Failed items	0	Actions	0
Location	Greenhill area M Stages 13, 14, 15, Chartwell, Hamilton 3281, New Zealand (-37.7490854, 175.2960279)				
Conducted on	16th Nov, 2020 11:22 AM NZDT				
Test type	Wastewater pressure test MH pressure test -				
Pipe type	100mm - SN16 - uPVC 150mm - SN16 - uPVC				
MH # tested	WWMH's 19.1, 19a.1, 19.2, 18a.1, 18.1, 18.2, 18.3, 18.4, 18.5, 20.1, 20.2, 21.1, 21.2, 21.3.				
MH # to MH #	WWMH's 19a.1 to 19.2 to 19.1, 19.2 to 18.2 to 18.1, 18.2 to 18.3 to 18a.1, 18.2 to 20.2 to 20.1, 20.2 to 21.3 to 21.2 to 21.1, 18.3 to 18.4 to 18.5 to interceptor.				
Tested by	Matt from Wests Construction 16th Nov, 2020 11:52 AM NZDT				
Inspector/Auditor	Lance Parkes				
Comments	WWMH's tested - WWMH's 19.1, 19a.1, 19.2, 18a.1, 18.1, 18.2, 18.3, 18.4, 18.5, 20.1, 20.2, 21.1, 21.2, 21.3. WW main tested - WWMH's 19a.1 to 19.2 to 19.1, 19.2 to 18.2 to 18.1, 18.2 to 18.3 to 18a.1, 18.2 to 20.2 to 20.1, 20.2 to 21.3 to 21.2 to 21.1, 18.3 to 18.4 to 18.5 to interceptor.				
Photos					
Pass/Fail	Pass				

Barry Pearson

From: Barry Pearson (Shrimpton and Lipinski Limited Partnership (HQ - Tauranga))
<bpearson@sltga.co.nz>
Sent: Wednesday, 10 March 2021 4:36 PM
To: Lance Parkes (Hamilton City Council (Hamilton))
Subject: Document Issue No. 7 - 19-30378-03 - Greenhill Park - Area M Stage 13, 14 and 15
Attachments: 19-30378-03 - Greenhill Park - Area M Stage 13, 14 and 15 - Issue 7.pdf

19-30378-03 - Greenhill Park - Area M Stage 13, 14 and 15 Issue 7

Issued by: Barry Pearson (Shrimpton and Lipinski Limited Partnership)
On: 10 Mar 2021

Good afternoon

See attached Greenhill Park Stage 13 stormwater (SW) and wastewater (SS and WW) CCTV for review

Note that we intent to submit our Greenhill Park stage 13 engineering completion report to HCC approx. 12th March 2021.

Access has already been given to Martyn Smith and Murray Giles of Hamilton City Council.

Regards

[Access the documents for this issue](#)

Recipients:

Lance Parkes (Hamilton City Council (Hamilton))

BARRY PEARSON



S&L
Land Development
and Design Specialists

36 Kereiti Street, Tauranga 3110
PO Box 231, Tauranga 3140
07 577 6069 bpearson@sltga.co.nz
www.sltga.co.nz

APPENDIX 5

Stormwater Construction and QA Records

- Stormwater Pipe Laying Checklist F4.11 F5.2
- Stormwater Manhole Checklist F4.12 F5.3
- Trench Backfill Compaction Test Summary F4.13
- Stormwater Backfill Compaction Test Results
- Stormwater Catchpit Checklist F4.14
- Stormwater Final Inspection Checklist F4.6
- CCTV submission email



F4.2 STORMWATER PIPE LAYING CHECKLIST

Engineering plan number(s):											
Name of certified drainlayer:											
Location: Pipe length (MH To MH)											
	Swart 15	to 19.5	19.5	to 19.4	19.4	to 19.1	19.1	to 20.1	20.1	to 21.2	21.2

Pipe Laying Checks

Trench Safety					
(a) Shield	<input checked="" type="checkbox"/>	<input checked="" type="checkbox"/>	<input checked="" type="checkbox"/>	<input checked="" type="checkbox"/>	<input checked="" type="checkbox"/>
(b) Batter	<input checked="" type="checkbox"/>	<input checked="" type="checkbox"/>	<input checked="" type="checkbox"/>	<input checked="" type="checkbox"/>	<input checked="" type="checkbox"/>
(c) Other	<input type="checkbox"/>	<input type="checkbox"/>	<input type="checkbox"/>	<input type="checkbox"/>	<input type="checkbox"/>
Pipe size, quality, manufacturer, on acceptable products list	<input checked="" type="checkbox"/>	<input checked="" type="checkbox"/>	<input checked="" type="checkbox"/>	<input checked="" type="checkbox"/>	<input checked="" type="checkbox"/>
Set out					
- Surveyors name <u>Online</u>	<input checked="" type="checkbox"/>	<input checked="" type="checkbox"/>	<input checked="" type="checkbox"/>	<input checked="" type="checkbox"/>	<input checked="" type="checkbox"/>
- Set out checked	<input checked="" type="checkbox"/>	<input checked="" type="checkbox"/>	<input checked="" type="checkbox"/>	<input checked="" type="checkbox"/>	<input checked="" type="checkbox"/>
Foundation support attached					
- Dynamic cone penetrometer (DCP) results	<input checked="" type="checkbox"/>	<input checked="" type="checkbox"/>	<input checked="" type="checkbox"/>	<input checked="" type="checkbox"/>	<input checked="" type="checkbox"/>
- if under cutting required, note metreage and DCP results.	<input checked="" type="checkbox"/>	<input checked="" type="checkbox"/>	<input checked="" type="checkbox"/>	<input checked="" type="checkbox"/>	<input checked="" type="checkbox"/>
Record daily level check and confirm on grade	<input checked="" type="checkbox"/>	<input checked="" type="checkbox"/>	<input checked="" type="checkbox"/>	<input checked="" type="checkbox"/>	<input checked="" type="checkbox"/>
Bedding type and surround material:					
<u>40/20 - Sand</u>	<input checked="" type="checkbox"/>	<input checked="" type="checkbox"/>	<input checked="" type="checkbox"/>	<input checked="" type="checkbox"/>	<input checked="" type="checkbox"/>
Bulk Backfill material:					
<u>Brown Rock</u>	<input type="checkbox"/>	<input type="checkbox"/>	<input type="checkbox"/>	<input type="checkbox"/>	<input type="checkbox"/>
Bulk backfill compaction (DCP results from pipe to ground level attached)	<input checked="" type="checkbox"/>	<input checked="" type="checkbox"/>	<input checked="" type="checkbox"/>	<input checked="" type="checkbox"/>	<input checked="" type="checkbox"/>
Alignment – control points identified	<input checked="" type="checkbox"/>	<input checked="" type="checkbox"/>	<input checked="" type="checkbox"/>	<input checked="" type="checkbox"/>	<input checked="" type="checkbox"/>
Pressure test witnessed and passed by Council representative.	<input type="checkbox"/>	<input type="checkbox"/>	<input type="checkbox"/>	<input type="checkbox"/>	<input type="checkbox"/>

Service connections

All service connections in place, taped, and staked	<input checked="" type="checkbox"/>	<input checked="" type="checkbox"/>	<input checked="" type="checkbox"/>	<input checked="" type="checkbox"/>	<input checked="" type="checkbox"/>
As-built measurements taken, GPS located	<input checked="" type="checkbox"/>	<input checked="" type="checkbox"/>	<input checked="" type="checkbox"/>	<input checked="" type="checkbox"/>	<input checked="" type="checkbox"/>
CCTV pipe inspection data and comments supplied	<input checked="" type="checkbox"/>	<input checked="" type="checkbox"/>	<input checked="" type="checkbox"/>	<input checked="" type="checkbox"/>	<input checked="" type="checkbox"/>

West Construction

Developer/Contractor

14/12/20

Date

F4.2 STORMWATER PIPE LAYING CHECKLIST

Engineering plan number(s):									
Name of certified drainlayer:									
Location: Pipe length (MH To MH)	21.2	to 21.1	15.2	to 15.1	19.4	to 22.2	22.2	to 22.1	to

Pipe Laying Checks

Trench Safety					
(a) Shield	<input checked="" type="checkbox"/>	<input checked="" type="checkbox"/>	<input checked="" type="checkbox"/>	<input checked="" type="checkbox"/>	<input type="checkbox"/>
(b) Batter	<input checked="" type="checkbox"/>	<input checked="" type="checkbox"/>	<input checked="" type="checkbox"/>	<input checked="" type="checkbox"/>	<input type="checkbox"/>
(c) Other	<input type="checkbox"/>	<input type="checkbox"/>	<input type="checkbox"/>	<input type="checkbox"/>	<input type="checkbox"/>
Pipe size, quality, manufacturer, on acceptable products list	<input checked="" type="checkbox"/>	<input checked="" type="checkbox"/>	<input checked="" type="checkbox"/>	<input checked="" type="checkbox"/>	<input type="checkbox"/>
Set out					
- Surveyors name <u>online</u>	<input checked="" type="checkbox"/>	<input checked="" type="checkbox"/>	<input checked="" type="checkbox"/>	<input checked="" type="checkbox"/>	<input type="checkbox"/>
- Set out checked	<input checked="" type="checkbox"/>	<input checked="" type="checkbox"/>	<input checked="" type="checkbox"/>	<input checked="" type="checkbox"/>	<input type="checkbox"/>
Foundation support attached					
- Dynamic cone penetrometer (DCP) results	<input checked="" type="checkbox"/>	<input checked="" type="checkbox"/>	<input checked="" type="checkbox"/>	<input checked="" type="checkbox"/>	<input type="checkbox"/>
- if under cutting required, note metreage and DCP results.	<input checked="" type="checkbox"/>	<input checked="" type="checkbox"/>	<input checked="" type="checkbox"/>	<input checked="" type="checkbox"/>	<input type="checkbox"/>
Record daily level check and confirm on grade	<input checked="" type="checkbox"/>	<input checked="" type="checkbox"/>	<input checked="" type="checkbox"/>	<input checked="" type="checkbox"/>	<input type="checkbox"/>
Bedding type and surround material:					
<u>40/20 - Sand</u>	<input checked="" type="checkbox"/>	<input checked="" type="checkbox"/>	<input checked="" type="checkbox"/>	<input checked="" type="checkbox"/>	<input type="checkbox"/>
Bulk Backfill material:					
<u>Broken Rock</u>	<input checked="" type="checkbox"/>	<input checked="" type="checkbox"/>	<input checked="" type="checkbox"/>	<input checked="" type="checkbox"/>	<input type="checkbox"/>
Bulk backfill compaction (DCP results from pipe to ground level attached)	<input checked="" type="checkbox"/>	<input checked="" type="checkbox"/>	<input checked="" type="checkbox"/>	<input checked="" type="checkbox"/>	<input type="checkbox"/>
Alignment - control points identified	<input checked="" type="checkbox"/>	<input checked="" type="checkbox"/>	<input checked="" type="checkbox"/>	<input checked="" type="checkbox"/>	<input type="checkbox"/>
Pressure test witnessed and passed by Council representative.	<input type="checkbox"/>	<input type="checkbox"/>	<input type="checkbox"/>	<input type="checkbox"/>	<input type="checkbox"/>

Service connections

All service connections in place, taped, and staked	<input checked="" type="checkbox"/>	<input checked="" type="checkbox"/>	<input checked="" type="checkbox"/>	<input checked="" type="checkbox"/>	<input type="checkbox"/>
As-built measurements taken, GPS located	<input checked="" type="checkbox"/>	<input checked="" type="checkbox"/>	<input checked="" type="checkbox"/>	<input checked="" type="checkbox"/>	<input type="checkbox"/>
CCTV pipe inspection data and comments supplied	<input checked="" type="checkbox"/>	<input checked="" type="checkbox"/>	<input checked="" type="checkbox"/>	<input checked="" type="checkbox"/>	<input type="checkbox"/>

Was Construction

Developer/Contractor

14/12/20

Date

F4.3 STORMWATER MANHOLE CHECKLIST

Engineering Plan Number(s)						
Name of certified drainlayer:						
Location:	Pipe length (MH To MH)	<i>Outlet 15</i>	<i>19.5</i>	<i>19.4</i>	<i>19.1</i>	<i>20.1</i>

MH number

Manhole Construction Checklist

Manhole size, quality, manufacturer on acceptable materials list	<input checked="" type="checkbox"/>	<input checked="" type="checkbox"/>	<input checked="" type="checkbox"/>	<input checked="" type="checkbox"/>	<input checked="" type="checkbox"/>
Set out /orientation	<input checked="" type="checkbox"/>	<input checked="" type="checkbox"/>	<input checked="" type="checkbox"/>	<input checked="" type="checkbox"/>	<input checked="" type="checkbox"/>
Sealing strip between risers	<input checked="" type="checkbox"/>	<input checked="" type="checkbox"/>	<input checked="" type="checkbox"/>	<input checked="" type="checkbox"/>	<input checked="" type="checkbox"/>
Benching - Height - alignment and cross section - half pipe lining (wastewater only) - Step recesses (if applicable)	<input checked="" type="checkbox"/> <input checked="" type="checkbox"/> <input checked="" type="checkbox"/> <input checked="" type="checkbox"/>	<input checked="" type="checkbox"/> <input checked="" type="checkbox"/> <input checked="" type="checkbox"/> <input checked="" type="checkbox"/>	<input checked="" type="checkbox"/> <input checked="" type="checkbox"/> <input checked="" type="checkbox"/> <input checked="" type="checkbox"/>	<input checked="" type="checkbox"/> <input checked="" type="checkbox"/> <input checked="" type="checkbox"/> <input checked="" type="checkbox"/>	<input checked="" type="checkbox"/> <input checked="" type="checkbox"/> <input checked="" type="checkbox"/> <input checked="" type="checkbox"/>
West Construction

14/12/20

Developer/Contractor

Date

F4.3 STORMWATER MANHOLE CHECKLIST

Engineering Plan Number(s)					
Name of certified drainlayer:					
Location: Pipe length (MH To MH)	15.1	21.2	21.1	22.2	22.1

MH number

Manhole Construction Checklist

Manhole size, quality, manufacturer on acceptable materials list	<input checked="" type="checkbox"/>	<input checked="" type="checkbox"/>	<input checked="" type="checkbox"/>	<input checked="" type="checkbox"/>	<input checked="" type="checkbox"/>
Set out /orientation	<input checked="" type="checkbox"/>	<input checked="" type="checkbox"/>	<input checked="" type="checkbox"/>	<input checked="" type="checkbox"/>	<input checked="" type="checkbox"/>
Sealing strip between risers	<input checked="" type="checkbox"/>	<input checked="" type="checkbox"/>	<input checked="" type="checkbox"/>	<input checked="" type="checkbox"/>	<input checked="" type="checkbox"/>
Benching - Height - alignment and cross section - half pipe lining (wastewater only) - Step recesses (if applicable)	<input checked="" type="checkbox"/>	<input checked="" type="checkbox"/>	<input checked="" type="checkbox"/>	<input checked="" type="checkbox"/>	<input checked="" type="checkbox"/>
Flexible joints	<input checked="" type="checkbox"/>	<input checked="" type="checkbox"/>	<input checked="" type="checkbox"/>	<input checked="" type="checkbox"/>	<input checked="" type="checkbox"/>
Cutting and plastering of connections	<input checked="" type="checkbox"/>	<input checked="" type="checkbox"/>	<input checked="" type="checkbox"/>	<input checked="" type="checkbox"/>	<input checked="" type="checkbox"/>
Access details per drawings (e.g. manhole cover sited over steps).	<input checked="" type="checkbox"/>	<input checked="" type="checkbox"/>	<input checked="" type="checkbox"/>	<input checked="" type="checkbox"/>	<input checked="" type="checkbox"/>
Step irons including epoxy to outside recesses	<input checked="" type="checkbox"/>	<input checked="" type="checkbox"/>	<input checked="" type="checkbox"/>	<input checked="" type="checkbox"/>	<input checked="" type="checkbox"/>
Bedding type and surround	<input checked="" type="checkbox"/>	<input checked="" type="checkbox"/>	<input checked="" type="checkbox"/>	<input checked="" type="checkbox"/>	<input checked="" type="checkbox"/>
Bulk backfill compaction - Dynamic Cone Penetrometer (DCP) results attached	<input checked="" type="checkbox"/>	<input checked="" type="checkbox"/>	<input checked="" type="checkbox"/>	<input checked="" type="checkbox"/>	<input checked="" type="checkbox"/>
No debris in pipelines	<input checked="" type="checkbox"/>	<input checked="" type="checkbox"/>	<input checked="" type="checkbox"/>	<input checked="" type="checkbox"/>	<input checked="" type="checkbox"/>
Pipe invert fall through manhole	<input checked="" type="checkbox"/>	<input checked="" type="checkbox"/>	<input checked="" type="checkbox"/>	<input checked="" type="checkbox"/>	<input checked="" type="checkbox"/>

West Construction

14/12/20

Developer/Contractor

Date

F4.4 STORMWATER TRENCH BACKFILL COMPACTION TEST SUMMARY

(attach individual test reports)

Technician West Construction Carrying out Tests

Location: Greenhill Park Stage 13, 14, 15

Plan No(s): 21879-M-13-S02

From MH 19.4-22.2-22.1 to MH

Acceptance Criteria: CBR > 16

Tests by: West Construction (attached)

Analysis of Results

Trench backfill completed satisfactorily as follows: or Trench backfill requires remedial work

West Construction

Developer/Contractor

Date

14/12/20

F4.4 STORMWATER TRENCH BACKFILL COMPACTION TEST SUMMARY

(attach individual test reports)

Technician West Construction Carrying out Tests

Location: Greenhill Park Stage B-14-15

Plan No(s): 21879-M-13-S01

From MH 15.2-15.1 to MH

Acceptance Criteria: CBR > 15

Tests by: West Construction (attached)

Analysis of Results

Trench backfill completed satisfactorily as follows: or Trench backfill requires remedial work

West Construction

Developer/Contractor

Date 14/12/20

F4.4 STORMWATER TRENCH BACKFILL COMPACTION TEST SUMMARY

(attach individual test reports)

Technician West Construction Carrying out Tests 2021

Location: Greenhill Park Stage 13, 14, 15

Plan No(s): 21879 - M - 13 - 501

From MH 19.1-21.2-21.1 to MH

Acceptance Criteria: CBR > 16

Tests by: West Construction (attached)

Analysis of Results

Trench backfill completed satisfactorily or Trench backfill requires remedial work as follows:

West Construction

Developer/Contractor

Date 14/12/20

F4.4 STORMWATER TRENCH BACKFILL COMPACTION TEST SUMMARY

(attach individual test reports)

Technician West Construction 2011 Carrying out Tests

Location: Greenhill Park Stage 13, 14, 15

Plan No(s): 21877-M-13-S01

From MH 19.4-19.1-20.1 to MH

Acceptance Criteria: CBR > 16

Tests by: West Construction (attached)

Analysis of Results

Trench backfill completed satisfactorily as follows: or Trench backfill requires remedial work

West Construction

Developer/Contractor

Date 14/12/20

F4.5 STORMWATER CATCHPIT CHECKLIST

Location:	117	118	119	114	115
Catchpit Number					

Catchpit Construction Checklist

Catchpit , type, size, quality, accepted material checked	<input checked="" type="checkbox"/>	<input checked="" type="checkbox"/>	<input checked="" type="checkbox"/>	<input checked="" type="checkbox"/>	<input type="checkbox"/>
Set out /orientation	<input checked="" type="checkbox"/>	<input checked="" type="checkbox"/>	<input checked="" type="checkbox"/>	<input checked="" type="checkbox"/>	<input checked="" type="checkbox"/>
Location checked	<input checked="" type="checkbox"/>	<input checked="" type="checkbox"/>	<input checked="" type="checkbox"/>	<input checked="" type="checkbox"/>	<input checked="" type="checkbox"/>
Depth of sump below outlet correct	<input checked="" type="checkbox"/>	<input checked="" type="checkbox"/>	<input checked="" type="checkbox"/>	<input checked="" type="checkbox"/>	<input checked="" type="checkbox"/>
Cutting and plastering of outlet connection	<input checked="" type="checkbox"/>	<input checked="" type="checkbox"/>	<input checked="" type="checkbox"/>	<input checked="" type="checkbox"/>	<input checked="" type="checkbox"/>
West Construction

Developer/Contractor

14/12/20

Date

F4.5 STORMWATER CATCHPIT CHECKLIST

Location:	107	108	087	101	109
	Catchpit Number				

Catchpit Construction Checklist

Catchpit , type, size, quality, accepted material checked	<input checked="" type="checkbox"/>	<input checked="" type="checkbox"/>	<input checked="" type="checkbox"/>	<input checked="" type="checkbox"/>	<input checked="" type="checkbox"/>
Set out /orientation	<input checked="" type="checkbox"/>	<input checked="" type="checkbox"/>	<input checked="" type="checkbox"/>	<input checked="" type="checkbox"/>	<input checked="" type="checkbox"/>
Location checked	<input checked="" type="checkbox"/>	<input checked="" type="checkbox"/>	<input checked="" type="checkbox"/>	<input checked="" type="checkbox"/>	<input checked="" type="checkbox"/>
Depth of sump below outlet correct	<input checked="" type="checkbox"/>	<input checked="" type="checkbox"/>	<input checked="" type="checkbox"/>	<input checked="" type="checkbox"/>	<input checked="" type="checkbox"/>
Cutting and plastering of outlet connection	<input checked="" type="checkbox"/>	<input checked="" type="checkbox"/>	<input checked="" type="checkbox"/>	<input checked="" type="checkbox"/>	<input checked="" type="checkbox"/>
Floating debris baffle installed correctly	<input checked="" type="checkbox"/>	<input checked="" type="checkbox"/>	<input checked="" type="checkbox"/>	<input checked="" type="checkbox"/>	<input checked="" type="checkbox"/>
Backfill compaction around pit checked	<input checked="" type="checkbox"/>	<input checked="" type="checkbox"/>	<input checked="" type="checkbox"/>	<input checked="" type="checkbox"/>	<input checked="" type="checkbox"/>
Seating and plastering of surround and grate to sump barrel	<input checked="" type="checkbox"/>	<input checked="" type="checkbox"/>	<input checked="" type="checkbox"/>	<input checked="" type="checkbox"/>	<input checked="" type="checkbox"/>
All silt and debris removed from sump	<input checked="" type="checkbox"/>	<input checked="" type="checkbox"/>	<input checked="" type="checkbox"/>	<input checked="" type="checkbox"/>	<input checked="" type="checkbox"/>

West Construction

Developer/Contractor

14/12/20

Date

F4.5 STORMWATER CATCHPIT CHECKLIST

Location:	116	112	113	111	110
	Catchpit Number				

Catchpit Construction Checklist

Catchpit , type, size, quality, accepted material checked	<input checked="" type="checkbox"/>	<input checked="" type="checkbox"/>	<input checked="" type="checkbox"/>	<input checked="" type="checkbox"/>	<input checked="" type="checkbox"/>
Set out /orientation	<input checked="" type="checkbox"/>	<input checked="" type="checkbox"/>	<input checked="" type="checkbox"/>	<input checked="" type="checkbox"/>	<input checked="" type="checkbox"/>
Location checked	<input checked="" type="checkbox"/>	<input checked="" type="checkbox"/>	<input checked="" type="checkbox"/>	<input checked="" type="checkbox"/>	<input checked="" type="checkbox"/>
Depth of sump below outlet correct	<input checked="" type="checkbox"/>	<input checked="" type="checkbox"/>	<input checked="" type="checkbox"/>	<input checked="" type="checkbox"/>	<input checked="" type="checkbox"/>
Cutting and plastering of outlet connection	<input checked="" type="checkbox"/>	<input checked="" type="checkbox"/>	<input checked="" type="checkbox"/>	<input checked="" type="checkbox"/>	<input checked="" type="checkbox"/>
West Construction

Developer/Contractor

14/12/20

Date



BACKFILL RESULT SHEET

TESTED BY:	West Construction	
PROJECT NAME :	Greenhill Park Stages 13,14,15	
Chainage	C/L Trench(CIV VALUES)	Remarks
SWMH 19.5	1ST LIFT	
10	NA	BERM
20	NA	BERM
30	21	BROWN ROCK 1M TESTS
40	23	BROWN ROCK 1M TESTS
SWMH 19.4		
10	19	BROWN ROCK 1M TESTS
20	23	BROWN ROCK 1M TESTS
30	21	BROWN ROCK 1M TESTS
40	25	BROWN ROCK 1M TESTS
50	26	BROWN ROCK 1M TESTS
60	24	BROWN ROCK 1M TESTS
70	21	BROWN ROCK 1M TESTS
SWMH 22.2		
10	25	BROWN ROCK 1M TESTS
20	26	BROWN ROCK 1M TESTS
30	24	BROWN ROCK 1M TESTS
40	17	BROWN ROCK 1M TESTS
50	24	BROWN ROCK 1M TESTS
SWMH 22.1		
SWMH 19.4		
10	19	BROWN ROCK 1M TESTS
20	20	BROWN ROCK 1M TESTS
30	23	BROWN ROCK 1M TESTS
40	24	BROWN ROCK 1M TESTS
50	29	BROWN ROCK 1M TESTS
60	27	BROWN ROCK 1M TESTS
70	23	BROWN ROCK 1M TESTS
SWMH 19.1		
10	24	BROWN ROCK 1M TESTS
20	29	BROWN ROCK 1M TESTS
30	27	BROWN ROCK 1M TESTS
40	23	BROWN ROCK 1M TESTS
50	24	BROWN ROCK 1M TESTS
60	28	BROWN ROCK 1M TESTS
70	21	BROWN ROCK 1M TESTS
SWMH 21.2		
10	30	BROWN ROCK 1M TESTS
20	25	BROWN ROCK 1M TESTS
30	26	BROWN ROCK 1M TESTS
40	22	BROWN ROCK 1M TESTS
SWMH 21.1		
SWMH 19.1		
10	27	BROWN ROCK 1M TESTS
20	29	BROWN ROCK 1M TESTS
30	19	BROWN ROCK 1M TESTS
40	24	BROWN ROCK 1M TESTS
50	23	BROWN ROCK 1M TESTS
60	24	BROWN ROCK 1M TESTS
70	22	BROWN ROCK 1M TESTS
80	24	BROWN ROCK 1M TESTS
SWMH20.1		
SWMH15.2EX		
20	21	BROWN ROCK 1M TESTS
30	23	BROWN ROCK 1M TESTS
40	24	BROWN ROCK 1M TESTS
50	21	BROWN ROCK 1M TESTS
SWMH15.1		

F4.6 STORMWATER PIPE NETWORK - FINAL INSPECTION CHECKLIST

Site/Location: *Greenhill Park Stages 13,14,15*

Developer/Contractor: *West Construction*

SUB ____ / ____ Contract No: _____

PRE-MEETING TASKS

Developer to verify checklist prior to meeting:	Developer Check	Council Rep Check
1. All relevant stormwater checklists completed	<input checked="" type="checkbox"/>	<input type="checkbox"/>
2. All lines flushed out	<input checked="" type="checkbox"/>	<input type="checkbox"/>
3. All required CCTV inspections carried out, reviewed and any re-work completed.	<input checked="" type="checkbox"/>	<input type="checkbox"/>
4. All manholes checked (eg infiltration, plastering)	<input checked="" type="checkbox"/>	<input type="checkbox"/>
5. All backfilling complete and tidied up	<input checked="" type="checkbox"/>	<input type="checkbox"/>
6. Final as-built and operational plans attached for site inspection	<input type="checkbox"/>	<input type="checkbox"/>

SITE MEETING

1. Inspect all lines	<input type="checkbox"/>	<input type="checkbox"/>
2. Inspect all manholes and catchpits	<input type="checkbox"/>	<input type="checkbox"/>
3. Works on third party land completed to satisfaction of owner	<input type="checkbox"/>	<input type="checkbox"/>
4. Overland flow to and from adjoining properties not affected	<input type="checkbox"/>	<input type="checkbox"/>
5. Remedial work required? <input type="checkbox"/> Yes (please list) <input type="checkbox"/> No		

Developer *West Construction*

Council

Date *9/3/21*

Date

F5.6 WASTEWATER PIPE NETWORK - FINAL INSPECTION CHECKLIST

Site/Location: *Greenhill Park Stages 13,14,15*

Developer/Contractor: *West Construction*

SUB _____ / _____ Contract No: _____

Developer to verify checklist prior to meeting:	Developer Check	Council Rep Check
6. All checklists completed (add form numbers)	<input checked="" type="checkbox"/>	<input type="checkbox"/>
7. All lines flushed out	<input checked="" type="checkbox"/>	<input type="checkbox"/>
8. All required CCTV inspections carried out, reviewed and any re-work completed.	<input checked="" type="checkbox"/>	<input type="checkbox"/>
9. All manholes checked (eg. Infiltration, plastering)	<input checked="" type="checkbox"/>	<input type="checkbox"/>
10. All backfilling complete and tidied up	<input checked="" type="checkbox"/>	<input type="checkbox"/>
11. Pressure test completed and witnessed	<input checked="" type="checkbox"/>	<input type="checkbox"/>
12. Final as-built and operational plans attached for site inspection	<input type="checkbox"/>	<input type="checkbox"/>

Site Meeting

13. Inspect all lines	<input type="checkbox"/>	<input type="checkbox"/>
14. Inspect all manholes and catchpits	<input type="checkbox"/>	<input type="checkbox"/>
15. Inspect SW inlet and outlet structures	<input type="checkbox"/>	<input type="checkbox"/>
16. Secondary flowpaths and detention ponds	<input type="checkbox"/>	<input type="checkbox"/>
17. Works on third party land completed to satisfaction of owner	<input type="checkbox"/>	<input type="checkbox"/>
18. Wastewater pumping station data complete and test results (Form F5.7) attached	<input type="checkbox"/>	<input type="checkbox"/>
19. Overland flow to and from adjoining properties not affected	<input type="checkbox"/>	<input type="checkbox"/>
20. Remedial work required?	<input type="checkbox"/> Yes (please list)	<input type="checkbox"/> No

Council _____

Developer _____

West Construction 9/3/21

APPENDIX 6

Landscaping Certifications

- Landscaping final inspection form requested from HCC



APPENDIX 7

Network Utilities Certifications

- Ultrafast Fibre Completion Letter
- First Gas Completion Letter
- Street Light Product Warranty
- WEL Completion Letter
- Street light Suppliers Declaration of Conformity
- Streetlight Producer Statement
- Streetlight COC & ROI Certificates
- HCC Form Street Light RAMM Data



Ref: S&L Consultants, Surveyors & Engineers – 20413-S13
ID: HN-086-16



8th of March 2021

0800 342 735
info@ultrafast.co.nz

ultrafastfibre.co.nz

ACCEPTANCE BY ULTRAFIBRE LIMITED AS TELECOMMUNICATIONS OPERATOR

Subdivision: Greenhill Park Ruakura Residential Stage 13 (18 Lots), Lot 702, DP 534481, Chartwell, Hamilton.

1. Ultrafast Fibre Limited (UFF) confirms that UFF will be the telecommunications operator of the telecommunications reticulation in the proposed public roads for the Ruakura Residential Stage 13 [Greenhill Park] Hamilton, Subdivision by Chedworth Properties Ltd. (the “**Subdivision**”) Lot 702, DP 534481, to provide network connections to Lot 357 through to Lot 374, in the Subdivision (the “**Reticulation**”).
2. The Reticulation is now installed in accordance with:
 - (a) the requirements and standards set by the Hamilton City Council and advised to UFF via the Council’s website; and
 - (b) the requirements of the Telecommunications Act 2001 and all other applicable laws, regulations and codes (as amended).
3. The Reticulation has been installed by Broadspectrum Limited to UFF’s satisfaction, for the specific subdivision lots detailed on the “final” Scheme Plan as attached, with UFF remaining the owner, operator and maintainer of the Reticulation.
4. The attached “final” Scheme Plan must match your submission to the Hamilton City Council and must have the UFF stamp of ‘Approval’ accompanied by sign-off. Any additional lots created after initial deployment of multi-duct/fibre infrastructure will be chargeable.
5. One or more retail service providers will be available to supply telecommunications services over the completed Reticulation when service is available, provided that UFF shall not be responsible if the retail service provider’s offer to supply such telecommunications services or the number of such providers varies from time to time.


SIGNED for and on behalf of
ULTRAFIBRE LIMITED by:

Signature:

A handwritten signature in black ink, appearing to read "R. Gibson", written over a white background.

Name: Russell Gibson

Date: 8th of March 2021

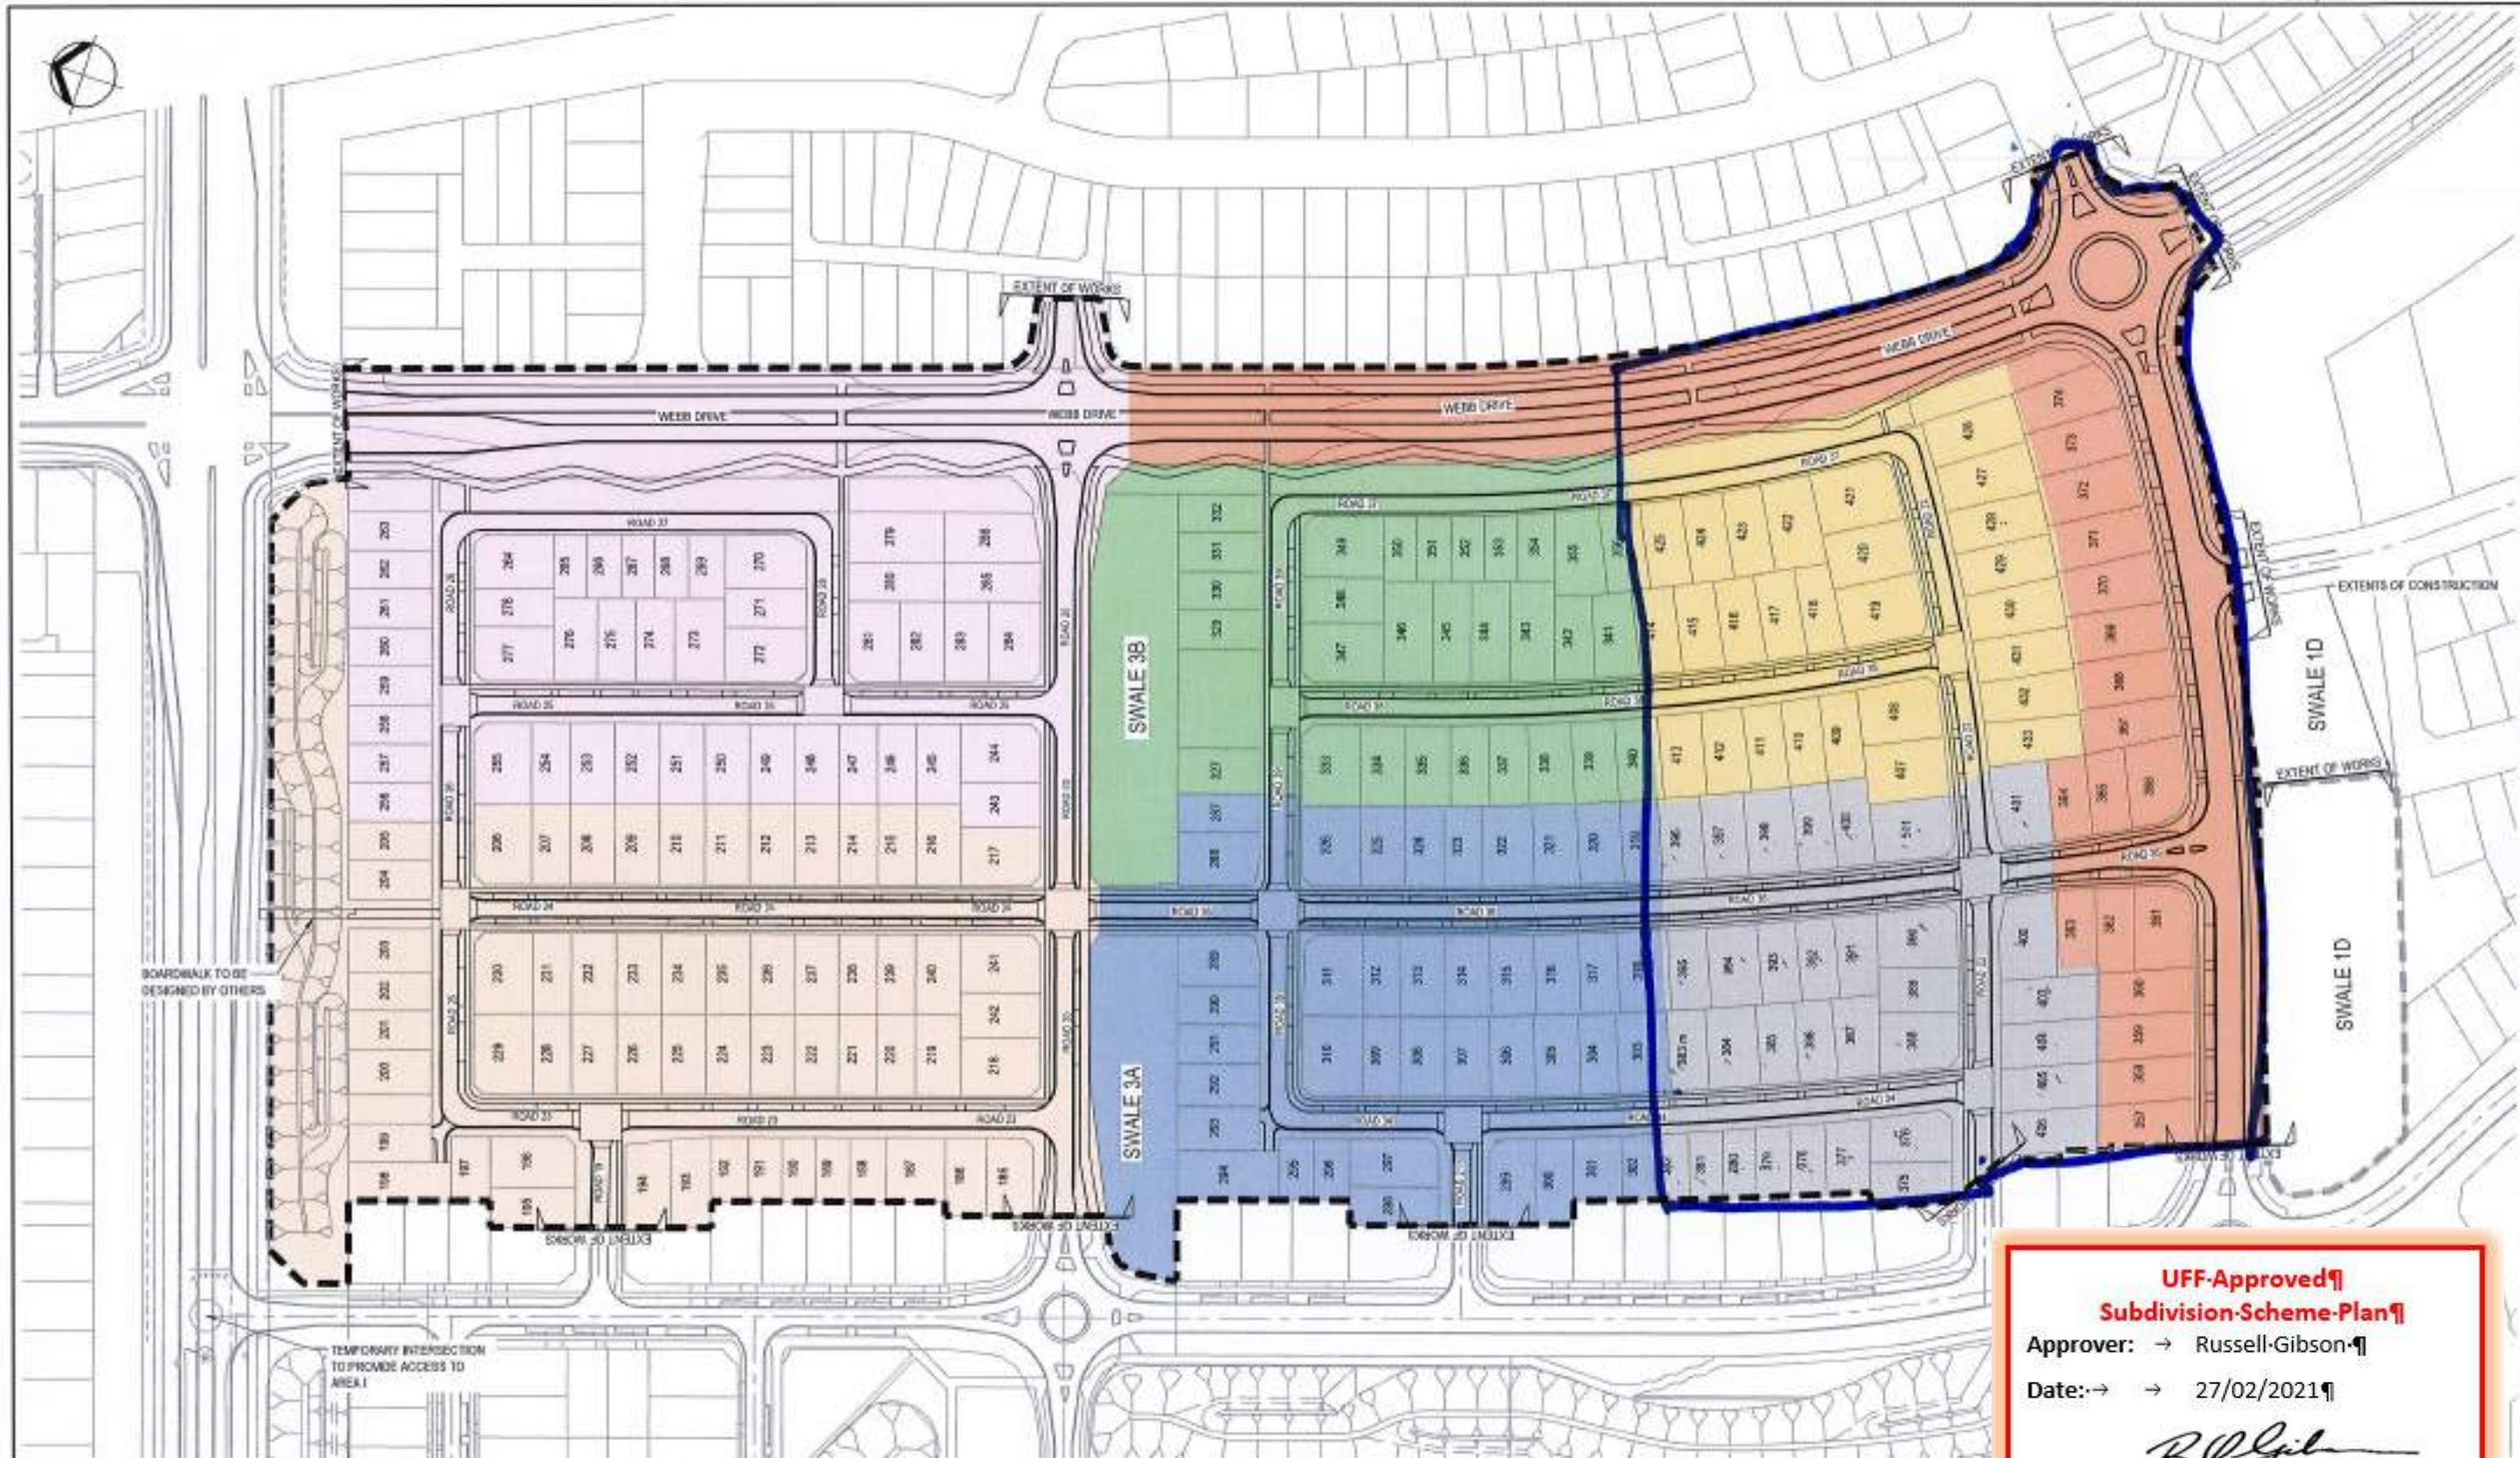

UFF-Approved
Subdivision-Scheme-Plan
 Approver: → Russell-Gibson
 Date: → → 27/02/2021
 Signature: *R. Gibson*

LEGEND:

AREA M-EXTENTS	AREA M - STAGE 10	AREA M - STAGE 13
STORMWATER CULVERT	AREA M - STAGE 11	AREA M - STAGE 14
BASIN LOW FLOW CHANNEL	AREA M - STAGE 12	AREA M - STAGE 15
AREA N - STAGE 9		

18 lots
33 lots
27 lots

- NOTES:**
1. EXTENT OF WORKS IS DEFINED AS THE "AREA M-EXTENTS" AS SHOWN ON THE PLANS.
 2. ALL WORKS TO BE CONSTRUCTED IN ACCORDANCE WITH HAMILTON CITY COUNCIL INFRASTRUCTURE TECHNICAL SPECIFICATIONS (UNLESS OTHERWISE SPECIFIED).
 3. DETAILS OF INTERFACING WITH OTHER PROJECT STAGES TO BE CONFIRMED ON SITE PRIOR TO CONSTRUCTION.

1	FOR CONSTRUCTION	SA	PP	AJ	27/02/21
No.	Revised	By	Date	Appr.	Date



Design	ASAR	07/08/18	Approved/Checked
Drawn	SM	07/08/18	By
Checked	GAC	07/08/18	By
Design	QDC	07/08/18	Date: 27/02/21



ROADING AND EARTHWORKS
 GENERAL ARRANGEMENT

CIVIL ENGINEERING
 3411915-CA-2010

Completion Certificate

To: Chedworth Properties Limited
From: Paul Bird
Cc: Barry Pearson
Date: 4 March 2021

**SUBJECT: Greenhill Park Subdivision – Stage 13
(First Gas Distribution Network)**



MESSAGE:

This Completion Certificate confirms that the First Gas Distribution Network installed at the above-mentioned development, has been laid, tested and commissioned in accordance with First Gas Technical Standards and relevant Gas Regulations.

Regards

A handwritten signature in blue ink, appearing to read 'Paul Bird'.

Paul Bird

Distribution Accounts Manager - New Developments

Firstgas

First Gas | Level 6, Resimac House | 45 Johnston St | Wellington | 6011

DDI 04 979 5367 | M 027 531 0060 | firstgas.co.nz

IBEX 10 Year Limited Warranty – Project Warranty

Date: 04-03-2021

Project: Greenhill Park, Stage 13

Ref: 7137-01

Issued To: Chedworth Properties Limited

Transfer Provision: Hamilton City Council

a) This limited warranty is provided by Ibex International limited (“Ibex”) in relation to the following products;

Luminaire – Vizulo Mini Stork Optic 20 (5 year warranty)

Column – 8m Tapered column with ‘Milford’ Outreach (10yr Warranty Black paint Finish)

10m Octagonal column with 2m curved Outreach (10yr Warranty Black paint Finish)

b) Ibex warrants to the purchaser that it will deliver the product in new condition in the product’s factory packaging. Further, the product will be free of defects in materials and/or workmanship for the warranty period stated.

c) Ibex has sole discretion as to whether any warranty claim shall be valid considering all factors including (without limitation) the operating conditions the product has endured and the overall performance of the product. this warranty is only valid when proof of purchase can be provided and if the product has been operating within New Zealand

d) The warranty period commences from the date of Ibex’s invoice or the product’s delivery date whichever is the earlier.

e) If Ibex determines that a warranty claim is valid, Ibex will at its sole discretion either refund the purchase price of the product, refund the current market cost of an alternative product, repair the product or replace the product. In case of the repair or replacement the replacement product may not necessary be an identical product but an improved version due to ongoing technological developments and/or supply of original components currently available.

f) Ibex reserve the right to recondition/refurbish any article that is subject to a warranty claim or replace parts with new or used parts in satisfaction of this warranty.

2 - Warranty Exclusions

a) This warranty excludes any costs incurred by the purchaser including (without limitation) equipment hire, labour charges, accommodation charges, transport charges and travel charges.

b) This warranty does not apply to loss or damages to the product caused by one or more of the following:

- Negligence and/or incorrect handling of the product by the buyer, installer, service agent or any other party acting on behalf or for the buyer;
- Improper installation;
- Improper handling;
- the product not being installed or maintained as set out in the installation instruction guide for the product;
- Acts of nature , fire , vandalism;
- Civil disturbances;
- Damages caused by fall or collision
- Installation or operation under environmental conditions beyond the manufacturer’s recommendations;
- Power surges;
- Electrical supply fluctuations or faults;

-
- Mechanical failures as a result of actions not considered by Ibex to be within the normal operating conditions of the product;

Improper service and/or maintenance work carried out by someone not considered by the Ibex as an approved service agent/facilitator; and/or

- any other situation and/or event or circumstance deemed by Ibex as sufficient to render this warranty void.

c) Notwithstanding any other provision of this warranty or any statute or rule of law, to the greatest extent possible Ibex shall have no liability for any costs, damages or other losses directly or indirectly attributable to failure of the product. Further, Ibex shall have no liability for any costs incurred by any party for any maintenance or remedial work.

3 - Product performance

a) Ibex retains the sole discretion to determine whether a product is defective.

b) This warranty shall apply only to the malfunction of products due to defects in material and or workmanship exceeding nominal failure rates. Unless otherwise stipulated in the product and application specifications provided by Ibex, the nominal failure rate for electronic operating devices and components such as LED's shall be set at 0.2% per 1000 operating hours. Furthermore a decrease in luminous flux of up to 0.6% per 1,000 operating hours and colour shift as per the LED Module /chip suppliers technical data information shall be considered normal and is not covered by this warranty.

c) In the event that LED modules/Chips are replaced, lighting properties may vary from the original product.

4 - Warranty Transfers

this warranty may not be transferred to any entity without either the express written consent of Ibex or this being explicitly stated in the cover notes of this document. Ibex may withhold such consent at its sole and absolute discretion.

5 - Warranty Terms and Conditions

a) In the event where a warranty is claimed on a product which is not faulty, Ibex reserves the right to seek compensation from the entity claiming on the warranty for all costs that have been incurred by Ibex including (without limitation) travel, accommodation, costs of access equipment, and third party service agents' costs.

b) The warranty terms are those specified in wiring in this warranty document only.

c) Ibex's warranty is a back-to-base warranty. Ibex shall bear no responsibility of any charges incurred by any entity for transport of the product to Ibex and/or from Ibex to the warranty claimant.

d) Labour and Service charge incurred by Ibex in repairing / refurbishing any product are not covered in this warranty.

e) The warranty shall be void if the product has been tampered with or parts replaced by personnel that have not be previously authorised by Ibex in writing.

Ibex reserves the right to modify this warranty at any time without prior notification and the new warranty terms shall be valid for all orders placed with the Ibex on or after the new issue date, from the date that the new warranty terms are posted on Ibex's website.

Supplier's Declaration of Conformity (in accordance with ISO/IEC 17050-1)

Number: 2692777035194
Issuer's Name: Ibex International Ltd.
Issuer's Address: PO BOX 9077 Greerton
Tauranga
3142

Object of the Declaration: We declare that the items described are Electrically Safe as required in the Electricity (Safety) Regulations 2010 Regulation 80.

MINI STORK (V) 13.8KLM 20LED OPTIC20 3000K S-CAP BLACK

The Object of the Declaration described above is in conformity with the requirements of the following documents:

Document Number:	Title	Edition / Date of Issue
AS/NZS 3820	Essential Safety Requirements For Electrical Equipment	2009/AMD 1

Additional information

Signed for and on behalf of: Ibex International Ltd.
Tauranga

Date: 4/03/2021



Kingsley Holt Supply Chain & Innovation Manager

Supplier's Declaration of Conformity (in accordance with ISO/IEC 17050-1)

Number: 2692777036320
Issuer's Name: Ibex International Ltd.
Issuer's Address: PO BOX 9077 Greerton
Tauranga
3142

Object of the Declaration: We declare that the items described are Electrically Safe as required in the Electricity (Safety) Regulations 2010 Regulation 80.

MINI STORK (V) - 7.8KLM 9LED OPTIC20 3000K S-CAP BLACK

The Object of the Declaration described above is in conformity with the requirements of the following documents:

Document Number:	Title	Edition / Date of Issue
AS/NZS 3820	Essential Safety Requirements For Electrical Equipment	2009/AMD 1

Additional information

Signed for and on behalf of: Ibex International Ltd.
Tauranga

Date: 4/03/2021



Kingsley Holt Supply Chain & Innovation Manager

Supplier's Declaration of Conformity (in accordance with ISO/IEC 17050-1)

Number: 2692777036368
Issuer's Name: Ibex International Ltd.
Issuer's Address: PO BOX 9077 Greerton
Tauranga
3142

Object of the Declaration: We declare that the items described are Electrically Safe as required in the Electricity (Safety) Regulations 2010 Regulation 80.

MINI STORK (V) - 9350LM 20LED OPTIC20 77W 3000K S-CAP BLACK

The Object of the Declaration described above is in conformity with the requirements of the following documents:

Document Number:	Title	Edition / Date of Issue
AS/NZS 3820	Essential Safety Requirements For Electrical Equipment	2009/AMD 1

Additional information

Signed for and on behalf of: Ibex International Ltd.
Tauranga

Date: 4/03/2021



Kingsley Holt Supply Chain & Innovation Manager

6 October 2020

Ref: 7137

PRODUCER STATEMENT FOR STREET LIGHTING

Project: Greenhill Park Area M Stage 13

Location: Carrs Road Hamilton

The lighting for this Project has been designed to comply with the New Zealand standard AS/NZS1158.3.1.2020 for PR4 and PR5 using Perfectlite and AGI32 lighting design software and in conjunction with the Hamilton City Council and RITS Code of Practice requirements

Product The P Category luminaires are Mini Stork 4 LED Optic P, 3000K, and the lighting columns and outreach arms are manufactured from steel which is hot dipped galvanised after fabrication and then coated with a 10 year warranty paint finish

The V Category luminaires are Mini Stork 9 LED Optic 20, 3000K and Mini Stork 20 LED Optic 20, 3000k, and the lighting columns and outreach arms are manufactured from steel which is hot dipped galvanised after fabrication and then coated with a 10 year warranty paint finish.

Lifetime The luminaire have an economic life of 15-20 years where normal maintenance is carried out. The pole and outreach have an economic life of 40 years.

Yours Faithfully
IBEX INTERNATIONAL LIMITED



MERRITT STRICKETT
Account Manager - Roadway
M +64 21 220 1291 T +64 9 915 1083
merritts@ibexlighting.com
IBEXLIGHTING.COM

DESIGN CERTIFICATE

INFRASTRUCTURE/ LAND DEVELOPMENT

ISSUED BY: Merritt C Strickett.

TO: Chedworth Properties Ltd

TO BE SUPPLIED TO: Hamilton City Council

IN RESPECT OF: Greenhill Park Stage 13, Hamilton

AT: Carrs Road, Hamilton

Merritt C Strickett has been engaged by Chedworth Properties Ltd

To provide Street Lighting Design to AS/NZS1158 Standard and to Hamilton City Councils Code of Practice and RITS code of practice.

in respect of the infrastructure/land development described above.

Drawing references - REF 7137

I **Merritt C Strickett** have the qualifications and experience relevant to this project as set out herein and have designed the subject works and confirm that the design is to current good engineering practice, and that it satisfies all relevant Resource Consent conditions, relevant TA requirements, and applicable codes and standards. My company holds professional indemnity insurance in the sum of **\$5,000,000.00**

Qualifications and experience

NZIHT Workshop, 32 years' experience in Street lighting design.

Efficient Road Lighting Resource Workshop.

ae

Date: 6 October 2020



ELECTRICAL CERTIFICATE OF COMPLIANCE & ELECTRICAL SAFETY CERTIFICATE

REFERENCE/CERTIFICATE ID No.:

This form has been designed to be used by licensed electrical workers to certify that installations or Part installations under Part 1 or Part 2 of AS/NZS 3000 are safe to be connected to the specified system of electrical supply.

Location Details:

Contact Details:
(Name and address)

Name of Electrical worker:

Registration/Practising licence number:

Phone & email:

Name and registration number of person(s) supervised:

Certificate of Compliance

Type of work:

Addition

Alteration

New work

The prescribed electrical work is:

Low risk

General

High-risk (Specify):

Means of compliance:

Part 1 of AS/NZS 3000

Part 2 of AS/NZS 3000

Additional Standards or electrical code of practice were required:

No Yes (specify):

Date or range of dates that prescribed electrical work undertaken:

Contains fittings that are safe to connect to a power supply?

Yes

No

Specify type of supply system:

The installation has an earthing system that is correctly rated (where applicable)

Yes

No

Parts of the installation to which this certificate relates that are safe to connect to a power supply?

All Parts (specify)

The work relies on manufacturers instructions:

Yes

No

If yes - identify the instruction manual including name, date and version. Also attach a copy of manufacturer's instructions to this certificate.

(Or provide reference to readily accessible electronic format, eg Internet link.)

Identify: Manufacturer's instructions attached: VIOLU Stark Little Brother LED street luminaire, 2005/2019

Link:

The work has been done in accordance with a certified design:

Yes

No

If yes - identify the certified design including name, date and version. Also attach a copy of the certified design to this certificate.

(Or provide reference to readily accessible electronic format, eg Internet link.)

Identify: Certified design attached: Roadway Lighting Plan drawing

Link:

The work relies on a Supplier Declaration of Conformity (SDoC):

Yes

No

If yes - identify the SDoC including name, date and version OR EESS registration. Also attach a copy of the SDoC to this certificate.

(Or provide reference to readily accessible electronic format, eg Internet link.)

Identify: SDoC attached

Link:

The installation has been satisfactorily tested in accordance with the Electricity (Safety) Regulations 2010

No Yes

Description of Work:

Install New Street Column with LED Head
Install MEN Board, Main Earth and Earth Stake, Cad Welded Connection - Light Risk
Mains Cable, Mains Installation by others.
Livened by others.

Test Results (provide values)

Polarity (Independent earth):	
Insulation resistance:	200+ M Ohms
Earth Continuity:	0.1 Ohms
Bonding:	0.1 Ohms
Fault Loop impedance	Ohms
Other (specify):	

By signing this document I certify that the completed prescribed electrical work to which this Certificate of Compliance applies has been done lawfully and safely, and the information in the certificate is correct.

Certifier's signature:

Date:

Electrical Safety Certificate

By signing this document I certify that the installation, or part of the installation, to which this Electrical Safety Certificate applies is connected to a power supply and is safe to use.

Certifier's name:

Registration/Practising licence number:

Certifier's signature:

Certificate Issue Date:

Connection Date:

CUSTOMER COPY - THIS IS AN IMPORTANT DOCUMENT AND SHOULD BE RETAINED FOR A MINIMUM OF 7 YEARS



ELECTRICAL CERTIFICATE OF COMPLIANCE & ELECTRICAL SAFETY CERTIFICATE

REFERENCE/CERTIFICATE ID NO.: NWELCOC15792

This form has been designed to be used by licensed electrical workers to certify that installations or Part installations under Part 1 or Part 2 of AS/NZS 3000 are safe to be connected to the specified system of electrical supply.

Location Details: Subdivision Area M - Stage 9 to 15 Greenhill Park Hamilton #109

Contact Details: (Name and address)

Name of Electrical worker: Yeti Martyn Registration/Practising licence number: E257490

Phone & email: yetimartyn@hotmail.com

Name and registration number of person(s) supervised:

Certificate of Compliance

Type of work: Addition Alteration New work

The prescribed electrical work is: Low risk General High-risk (Specify):

Means of compliance: Part 1 of AS/NZS 3000 Part 2 of AS/NZS 3000

Additional Standards or electrical code of practice were required: No Yes (specify):

Date or range of dates that prescribed electrical work undertaken: 20/02/2021

Contains fittings that are safe to connect to a power supply? Yes No

Specify type of supply system: 230V Mains MEN

The installation has an earthing system that is correctly rated (where applicable) Yes No

Parts of the installation to which this certificate relates that are safe to connect to a power supply?
 All Parts (specify):

The work relies on manufacturers instructions: Yes No

If yes - identify the instruction manual including name, date and version. Also attach a copy of manufacturer's instructions to this certificate.
 (Or provide reference to readily accessible electronic format, eg Internet link.)

Identify: Manufacturer's instructions attached. VOLU Stok Little Brother LED street luminaire. 20/05/2019

Link:

The work has been done in accordance with a certified design: Yes No

If yes - identify the certified design including name, date and version. Also attach a copy of the certified design to this certificate.
 (Or provide reference to readily accessible electronic format, eg Internet link.)

Identify: Certified design attached. Roadway Lighting Plan drawing

Link:

The work relies on a Supplier Declaration of Conformity (SDoC): Yes No

If yes - identify the SDoC including name, date and version OR EESS registration. Also attach a copy of the SDoC to this certificate.
 (Or provide reference to readily accessible electronic format, eg Internet link.)

Identify: SDoC attached

Link:

The installation has been satisfactorily tested in accordance with the Electricity (Safety) Regulations 2010 No Yes

Description of Work:

Install New Street Column with LED Head
Install MEN Board, Main Earth and Earth Stake, Cad Welded Connection - Light Risk
Mains Cable, Mains Installation by others.
Livened by others.

Test Results (provide values)	
Polarity (Independent earth):	
Insulation resistance:	<u>200+ M Ohms</u>
Earth Continuity:	<u>0.1 Ohms</u>
Bonding:	<u>0.1 Ohms</u>
Fault Loop impedance	<u>Ohms</u>
Other (specify):	

By signing this document I certify that the completed prescribed electrical work to which this Certificate of Compliance applies has been done lawfully and safely, and the information in the certificate is correct.

Certifier's signature: [Signature] Date: 20/02/2021

Electrical Safety Certificate

By signing this document I certify that the installation, or part of the installation, to which this Electrical Safety Certificate applies is connected to a power supply and is safe to use.

Certifier's name: Registration/Practising licence number:

Certifier's signature: Certificate Issue Date: Connection Date:

CUSTOMER COPY - THIS IS AN IMPORTANT DOCUMENT AND SHOULD BE RETAINED FOR A MINIMUM OF 7 YEARS



ELECTRICAL CERTIFICATE OF COMPLIANCE & ELECTRICAL SAFETY CERTIFICATE

REFERENCE/CERTIFICATE ID No.:

This form has been designed to be used by licensed electrical workers to certify that installations or Part installations under Part 1 or Part 2 of AS/NZS 3000 are safe to be connected to the specified system of electrical supply.

Location Details:

Contact Details:
(Name and address)

Name of Electrical worker:

Registration/Practising licence number:

Phone & email:

Name and registration number of person(s) supervised:

Certificate of Compliance

Type of work:

Addition

Alteration

New work

The prescribed electrical work is:

Low risk

General

High-risk (Specify):

Means of compliance:

Part 1 of AS/NZS 3000

Part 2 of AS/NZS 3000

Additional Standards or electrical code of practice were required:

No Yes (specify):

Date or range of dates that prescribed electrical work undertaken:

Contains fittings that are safe to connect to a power supply?

Yes

No

Specify type of supply system:

The installation has an earthing system that is correctly rated (where applicable)

Yes

No

Parts of the installation to which this certificate relates that are safe to connect to a power supply?

All Parts (specify)

The work relies on manufacturers instructions:

Yes

No

If yes - identify the instruction manual including name, date and version. Also attach a copy of manufacturer's instructions to this certificate.

(Or provide reference to readily accessible electronic format, eg Internet link.)

Identify: Manufacturer's instructions attached. VOLU Stok Little Brother LED street luminaire. 20050019

Link:

The work has been done in accordance with a certified design:

Yes

No

If yes - identify the certified design including name, date and version. Also attach a copy of the certified design to this certificate.

(Or provide reference to readily accessible electronic format, eg Internet link.)

Identify: Certified design attached. Roadway Lighting Plan drawing

Link:

The work relies on a Supplier Declaration of Conformity (SDoC):

Yes

No

If yes - identify the SDoC including name, date and version OR EESS registration. Also attach a copy of the SDoC to this certificate.

(Or provide reference to readily accessible electronic format, eg Internet link.)

Identify: SDoC attached

Link:

The installation has been satisfactorily tested in accordance with the Electricity (Safety) Regulations 2010

No

Yes

Description of Work:

Install New Street Column with LED Head
Install MEN Board, Main Earth and Earth Stake, Cad Welded Connection - Light Risk
Mains Cable, Mains Installation by others.
Livened by others.

Test Results (provide values)

Polarity (Independent earth):	
Insulation resistance:	200+ M Ohms
Earth Continuity:	0.1 Ohms
Bonding:	0.1 Ohms
Fault Loop Impedance:	Ohms
Other (specify):	

By signing this document I certify that the completed prescribed electrical work to which this Certificate of Compliance applies has been done lawfully and safely, and the information in the certificate is correct.

Certifier's signature:

Date:

Electrical Safety Certificate

By signing this document I certify that the installation, or part of the installation, to which this Electrical Safety Certificate applies is connected to a power supply and is safe to use.

Certifier's name:

Registration/Practising licence number:

Certifier's signature:

Certificate Issue Date:

Connection Date:

CUSTOMER COPY - THIS IS AN IMPORTANT DOCUMENT AND SHOULD BE RETAINED FOR A MINIMUM OF 7 YEARS



ELECTRICAL CERTIFICATE OF COMPLIANCE & ELECTRICAL SAFETY CERTIFICATE

REFERENCE/CERTIFICATE ID No.: NWELCOC1579 4

This form has been designed to be used by licensed electrical workers to certify that installations or Part installations under Part 1 or Part 2 of AS/NZS 3000 are safe to be connected to the specified system of electrical supply.

Location Details: Subdivision Area M - Stage 9 to 15 Greenhill Park Hamilton # 111

Contact Details:
(Name and address)

Name of Electrical worker: Yeti Martyn **Registration/Practising licence number:** E257490

Phone & email: yeti1martyn@hotmail.com

Name and registration number of person(s) supervised:

Certificate of Compliance

Type of work: Addition Alteration New work

The prescribed electrical work is: Low risk General High-risk (Specify):

Means of compliance: Part 1 of AS/NZS 3000 Part 2 of AS/NZS 3000

Additional Standards or electrical code of practice were required: No Yes (specify):

Date or range of dates that prescribed electrical work undertaken: 20/02/2021

Contains fittings that are safe to connect to a power supply? Yes No

Specify type of supply system: 230V Mains MEN

The installation has an earthing system that is correctly rated (where applicable) Yes No

Parts of the installation to which this certificate relates that are safe to connect to a power supply?
 All Parts (specify)

The work relies on manufacturers instructions: Yes No

If yes - Identify the instruction manual including name, date and version. Also attach a copy of manufacturer's instructions to this certificate.
(Or provide reference to readily accessible electronic format, eg Internet link.)

Identify: Manufacturer's instructions attached. VIGLU 500k Luxe Brother LED street luminare, 20055019
Link:

The work has been done in accordance with a certified design: Yes No

If yes - Identify the certified design including name, date and version. Also attach a copy of the certified design to this certificate.
(Or provide reference to readily accessible electronic format, eg Internet link.)

Identify: Certified design attached. Roadway Lighting Plan drawing
Link:

The work relies on a Supplier Declaration of Conformity (SDoC): Yes No

If yes - Identify the SDoC including name, date and version OR EESS registration. Also attach a copy of the SDoC to this certificate.
(Or provide reference to readily accessible electronic format, eg Internet link.)

Identify: SDoC attached
Link:

The installation has been satisfactorily tested in accordance with the Electricity (Safety) Regulations 2010 No Yes

Description of Work:

Install New Street Column with LED Head
Install MEN Board, Main Earth and Earth Stake, Cad Welded Connection - Light Risk
Mains Cable, Mains Installation by others.
Livened by others.

Test Results (provide values)	
Polarity (Independent earth):	
Insulation resistance:	200+ M Ohms
Earth Continuity:	0.1 Ohms
Bonding:	0.1 Ohms
Fault Loop impedance	Ohms
Other (specify):	

By signing this document I certify that the completed prescribed electrical work to which this Certificate of Compliance applies has been done lawfully and safely, and the information in the certificate is correct.

Certifier's signature: [Signature] **Date:** 20/02/2021

Electrical Safety Certificate

By signing this document I certify that the installation, or part of the installation, to which this Electrical Safety Certificate applies is connected to a power supply and is safe to use.

Certifier's name: **Registration/Practising licence number:**

Certifier's signature: **Certificate Issue Date:** **Connection Date:**

CUSTOMER COPY - THIS IS AN IMPORTANT DOCUMENT AND SHOULD BE RETAINED FOR A MINIMUM OF 7 YEARS

This Electrical Safety Certificate also confirms that the electrical work complies with the building code for the purposes of Section 19(1)(a) of the Building Act 2004.



ELECTRICAL CERTIFICATE OF COMPLIANCE & ELECTRICAL SAFETY CERTIFICATE

REFERENCE/CERTIFICATE ID No.:

This form has been designed to be used by licensed electrical workers to certify that installations or Part installations under Part 1 or Part 2 of AS/NZS 3000 are safe to be connected to the specified system of electrical supply.

Location Details:

Contact Details: (Name and address)

Name of Electrical worker: Registration/Practising licence number:

Phone & email:

Name and registration number of person(s) supervised:

Certificate of Compliance

Type of work: Addition Alteration New work
The prescribed electrical work is: Low risk General High-risk (Specify):

Means of compliance: Part 1 of AS/NZS 3000 Part 2 of AS/NZS 3000

Additional Standards or electrical code of practice were required: No Yes (specify):

Date or range of dates that prescribed electrical work undertaken:

Contains fittings that are safe to connect to a power supply? Yes No

Specify type of supply system:

The installation has an earthing system that is correctly rated (where applicable) Yes No

Parts of the installation to which this certificate relates that are safe to connect to a power supply?

All Parts (specify)

The work relies on manufacturers instructions: Yes No

If yes - identify the instruction manual including name, date and version. Also attach a copy of manufacturer's instructions to this certificate. (Or provide reference to readily accessible electronic format, eg internet link.)

Identify: Manufacturer's instructions attached. WOLU Stark Little Brother LED street luminaire, 20/05/2019
Link:

The work has been done in accordance with a certified design: Yes No

If yes - identify the certified design including name, date and version. Also attach a copy of the certified design to this certificate. (Or provide reference to readily accessible electronic format, eg internet link.)

Identify: Certified design attached. Roadway Lighting Plan drawing.
Link:

The work relies on a Supplier Declaration of Conformity (SDoC): Yes No

If yes - identify the SDoC including name, date and version OR EESS registration. Also attach a copy of the SDoC to this certificate. (Or provide reference to readily accessible electronic format, eg internet link.)

Identify: SDoC attached
Link:

The installation has been satisfactorily tested in accordance with the Electricity (Safety) Regulations 2010 No Yes

Description of Work:
Install New Street Column with LED Head
Install MEN Board, Main Earth and Earth Stake, Cad Welded Connection - Light Risk
Mains Cable, Mains Installation by others.
Livened by others.

Test Results (provide values)	
Polarity (Independent earth):	
Insulation resistance:	200+ M Ohms
Earth Continuity:	0.1 Ohms
Bonding:	0.1 Ohms
Fault Loop impedance	Ohms
Other (specify):	

By signing this document I certify that the completed prescribed electrical work to which this Certificate of Compliance applies has been done lawfully and safely, and the information in the certificate is correct.

Certifier's signature: Date:

Electrical Safety Certificate

By signing this document I certify that the installation, or part of the installation, to which this Electrical Safety Certificate applies is connected to a power supply and is safe to use.

Certifier's name: Registration/Practising licence number:

Certifier's signature: Certificate Issue Date: Connection Date:

CUSTOMER COPY - THIS IS AN IMPORTANT DOCUMENT AND SHOULD BE RETAINED FOR A MINIMUM OF 7 YEARS

This Electrical Safety Certificate also confirms that the electrical work complies with the building code for the purposes of Section 19(1)(e) of the Building Act 2004.



ELECTRICAL CERTIFICATE OF COMPLIANCE & ELECTRICAL SAFETY CERTIFICATE

REFERENCE/CERTIFICATE ID No.: **NWELCOC15796**

This form has been designed to be used by licensed electrical workers to certify that installations or Part installations under Part 1 or Part 2 of AS/NZS 3000 are safe to be connected to the **specified** system of electrical supply.

Location Details:

Subdivision Area M - Stage 9 to 15 Greenhill Park Hamilton #1/3

Contact Details:
(Name and address)

Name of Electrical worker:

Yeti Martyn

Registration/Practising licence number:

E257490

Phone & email:

yetimartyn@hotmail.com

Name and registration number of person(s) supervised:

Certificate of Compliance

Type of work:

Addition Alteration New work

The prescribed electrical work is:

Low risk General High-risk (Specify):

Means of compliance:

Part 1 of AS/NZS 3000 Part 2 of AS/NZS 3000

Additional Standards or electrical code of practice were required: No Yes (specify):

Date or range of dates that prescribed electrical work undertaken: 20/02/2021

Contains fittings that are safe to connect to a power supply?

Yes No

Specify type of supply system: 230V Mains MEN

The installation has an earthing system that is correctly rated (where applicable)

Yes No

Parts of the installation to which this certificate relates that are safe to connect to a power supply?

All Parts (specify)

The work relies on manufacturers instructions:

Yes No

If yes - identify the instruction manual including name, date and version. Also attach a copy of manufacturer's instructions to this certificate. (Or provide reference to readily accessible electronic format, eg Internet link.)

Identify: Manufacturer's instructions attached. VCLU Stark Little Brother LED street luminaire. 20/05/2019

Link:

The work has been done in accordance with a certified design:

Yes No

If yes - identify the certified design including name, date and version. Also attach a copy of the certified design to this certificate. (Or provide reference to readily accessible electronic format, eg Internet link.)

Identify: Certified design attached. Roadway Lighting Plan drawing

Link:

The work relies on a Supplier Declaration of Conformity (SDoC):

Yes No

If yes - identify the SDoC including name, date and version OR EESS registration. Also attach a copy of the SDoC to this certificate. (Or provide reference to readily accessible electronic format, eg Internet link.)

Identify: SDoC attached

Link:

The installation has been satisfactorily tested in accordance with the Electricity (Safety) Regulations 2010

No Yes

Description of Work:

Install New Street Column with LED Head
Install MEN Board, Main Earth and Earth Stake, Cad Welded Connection - Light Risk
Mains Cable, Mains Installation by others.
Livened by others.

Test Results (provide values)

Polarity (Independent earth):	
Insulation resistance:	200+ M Ohms
Earth Continuity:	0.1 Ohms
Bonding:	0.1 Ohms
Fault Loop Impedance	Ohms
Other (specify):	

By signing this document I certify that the completed prescribed electrical work to which this Certificate of Compliance applies has been done lawfully and safely, and the information in the certificate is correct.

Certifier's signature:

Date: 20/02/2021

Electrical Safety Certificate

By signing this document I certify that the installation, or part of the installation, to which this Electrical Safety Certificate applies is connected to a power supply and is safe to use.

Certifier's name:

Registration/Practising licence number:

Certifier's signature:

Certificate Issue Date:

Connection Date:

CUSTOMER COPY - THIS IS AN IMPORTANT DOCUMENT AND SHOULD BE RETAINED FOR A MINIMUM OF 7 YEARS



ELECTRICAL CERTIFICATE OF COMPLIANCE & ELECTRICAL SAFETY CERTIFICATE

REFERENCE/CERTIFICATE ID No.: NWELCOC1579714

This form has been designed to be used by licensed electrical workers to certify that installations or Part installations under Part 1 or Part 2 of AS/NZS 3000 are safe to be connected to the specified system of electrical supply.

Location Details:

Subdivision Area M - Stage 9 to 15 Greenhill Park Hamilton #114

Contact Details:
(Name and address)

Name of Electrical worker:

Yeti Martyn

Registration/Practising licence number:

E257490

Phone & email:

yetimartyn@hotmail.com

Name and registration number of person(s) supervised:

Certificate of Compliance

Type of work:

Addition Alteration New work
 Low risk General High-risk (Specify):

The prescribed electrical work is:

Means of compliance:

Part 1 of AS/NZS 3000 Part 2 of AS/NZS 3000

Additional Standards or electrical code of practice were required: No Yes (specify):

Date or range of dates that prescribed electrical work undertaken: 20/02/2021

Contains fittings that are safe to connect to a power supply? Yes No

Specify type of supply system: 230V Mains MEN

The installation has an earthing system that is correctly rated (where applicable) Yes No

Parts of the installation to which this certificate relates that are safe to connect to a power supply?

All Parts (specify)

The work relies on manufacturers instructions: Yes No

If yes - identify the instruction manual including name, date and version. Also attach a copy of manufacturer's instructions to this certificate. (Or provide reference to readily accessible electronic format, eg Internet link.)

Identify: Manufacturer's instructions attached: VICKI Stark Little Brother LED street luminaires, 2005/0019

Link:

The work has been done in accordance with a certified design: Yes No

If yes - identify the certified design including name, date and version. Also attach a copy of the certified design to this certificate. (Or provide reference to readily accessible electronic format, eg Internet link.)

Identify: Certified design attached: Roadway Lighting Plan drawing

Link:

The work relies on a Supplier Declaration of Conformity (SDoC): Yes No

If yes - identify the SDoC including name, date and version OR EESS registration. Also attach a copy of the SDoC to this certificate. (Or provide reference to readily accessible electronic format, eg Internet link.)

Identify: SDoC attached

Link:

The installation has been satisfactorily tested in accordance with the Electricity (Safety) Regulations 2010 No Yes

Description of Work:

Install New Street Column with LED Head
Install MEN Board, Main Earth and Earth Stake, Cad Welded Connection - Light Risk
Mains Cable, Mains Installation by others.
Livened by others.

Test Results (provide values)

Polarity (Independent earth):	
Insulation resistance:	200+ M Ohms
Earth Continuity:	0.1 Ohms
Bonding:	0.1 Ohms
Fault Loop impedance	Ohms
Other (specify):	

By signing this document I certify that the completed prescribed electrical work to which this Certificate of Compliance applies has been done lawfully and safely, and the information in the certificate is correct.

Certifier's signature:

[Signature]

Date: 20/02/2021

Electrical Safety Certificate

By signing this document I certify that the installation, or part of the installation, to which this Electrical Safety Certificate applies is connected to a power supply and is safe to use.

Certifier's name:

Registration/Practising licence number:

Certifier's signature:

Certificate Issue Date:

Connection Date:

CUSTOMER COPY - THIS IS AN IMPORTANT DOCUMENT AND SHOULD BE RETAINED FOR A MINIMUM OF 7 YEARS



ELECTRICAL CERTIFICATE OF COMPLIANCE & ELECTRICAL SAFETY CERTIFICATE

REFERENCE/CERTIFICATE ID No.: NWELCOC1579

This form has been designed to be used by licensed electrical workers to certify that installations or Part installations under Part 1 or Part 2 of AS/NZS 3000 are safe to be connected to the specified system of electrical supply.

Location Details:

Subdivision Area M - Stage 9 to 15 Greenhill Park Hamilton #115

Contact Details:
(Name and address)

Name of Electrical worker:

Yeti Martyn

Registration/Practising licence number:

E257490

Phone & email:

yetimartyn@hotmail.com

Name and registration number of person(s) supervised:

Certificate of Compliance

Type of work:

- Addition Alteration New work
 The prescribed electrical work is: Low risk General High-risk (Specify):

Means of compliance:

- Part 1 of AS/NZS 3000 Part 2 of AS/NZS 3000

Additional Standards or electrical code of practice were required: No Yes (specify):

Date or range of dates that prescribed electrical work undertaken: 20/02/2021

Contains fittings that are safe to connect to a power supply? Yes No

Specify type of supply system: 230V Mains MEN

The installation has an earthing system that is correctly rated (where applicable) Yes No

Parts of the installation to which this certificate relates that are safe to connect to a power supply?

All Parts (specify)

The work relies on manufacturers instructions: Yes No

If yes - identify the instruction manual including name, date and version. Also attach a copy of manufacturer's instructions to this certificate. (Or provide reference to readily accessible electronic format, eg Internet link.)

Identify: Manufacturer's instructions attached. VOLU Slek Little Brother LED street luminaire, 20/05/2019

Link:

The work has been done in accordance with a certified design: Yes No

If yes - identify the certified design including name, date and version. Also attach a copy of the certified design to this certificate. (Or provide reference to readily accessible electronic format, eg Internet link.)

Identify: Certified design attached. Roadway Lighting Plan drawing.

Link:

The work relies on a Supplier Declaration of Conformity (SDoC): Yes No

If yes - identify the SDoC including name, date and version OR EESS registration. Also attach a copy of the SDoC to this certificate. (Or provide reference to readily accessible electronic format, eg Internet link.)

Identify: SDoC attached

Link:

The installation has been satisfactorily tested in accordance with the Electricity (Safety) Regulations 2010 No Yes

Description of Work:

Install New Street Column with LED Head
 Install MEN Board, Main Earth and Earth Stake, Cad Welded Connection - Light Risk
 Mains Cable, Mains Installation by others.
 Livened by others.

Test Results (provide values)

Polarity (Independent earth):	
Insulation resistance:	200+ M Ohms
Earth Continuity:	0.1 Ohms
Bonding:	0.1 Ohms
Fault Loop Impedance	Ohms
Other (specify):	

By signing this document I certify that the completed prescribed electrical work to which this Certificate of Compliance applies has been done lawfully and safely, and the information in the certificate is correct.

Certifier's signature:

Date: 20/02/2021

Electrical Safety Certificate

By signing this document I certify that the installation, or part of the installation, to which this Electrical Safety Certificate applies is connected to a power supply and is safe to use.

Certifier's name:

Registration/Practising licence number:

Certifier's signature:

Certificate Issue Date:

Connection Date:

CUSTOMER COPY - THIS IS AN IMPORTANT DOCUMENT AND SHOULD BE RETAINED FOR A MINIMUM OF 7 YEARS



ELECTRICAL CERTIFICATE OF COMPLIANCE & ELECTRICAL SAFETY CERTIFICATE

REFERENCE/CERTIFICATE ID NO.: NWELCOC1579 9

This form has been designed to be used by licensed electrical workers to certify that installations or Part installations under Part 1 or Part 2 of AS/NZS 3000 are safe to be connected to the specified system of electrical supply.

Location Details: Subdivision Area M - Stage 9 to 15 Greenhill Park Hamilton # 116

Contact Details: (Name and address)

Name of Electrical worker: Yeti Martyn Registration/Practising licence number: E257490

Phone & email: yetimartyn@hotmail.com

Name and registration number of person(s) supervised:

Certificate of Compliance

Type of work: Addition Alteration New work
The prescribed electrical work is: Low risk General High-risk (Specify):

Means of compliance: Part 1 of AS/NZS 3000 Part 2 of AS/NZS 3000

Additional Standards or electrical code of practice were required: No Yes (specify):

Date or range of dates that prescribed electrical work undertaken: 20/02/2021

Contains fittings that are safe to connect to a power supply? Yes No

Specify type of supply system: 230V Mains MEN

The installation has an earthing system that is correctly rated (where applicable) Yes No

Parts of the installation to which this certificate relates that are safe to connect to a power supply?

All Parts (specify)

The work relies on manufacturers instructions: Yes No

If yes - identify the instruction manual including name, date and version. Also attach a copy of manufacturer's instructions to this certificate. (Or provide reference to readily accessible electronic format, eg Internet link.)

Identify: Manufacturer's instructions attached. VIOU Stok Lille Brother LED street luminaires. 2005/2019

Link:

The work has been done in accordance with a certified design: Yes No

If yes - identify the certified design including name, date and version. Also attach a copy of the certified design to this certificate. (Or provide reference to readily accessible electronic format, eg Internet link.)

Identify: Certified design attached. Roadway Lighting Plan drawing.

Link:

The work relies on a Supplier Declaration of Conformity (SDoC): Yes No

If yes - identify the SDoC including name, date and version OR EESS registration. Also attach a copy of the SDoC to this certificate. (Or provide reference to readily accessible electronic format, eg Internet link.)

Identify: SDoC attached

Link:

The installation has been satisfactorily tested in accordance with the Electricity (Safety) Regulations 2010 No Yes

Description of Work:
Install New Street Column with LED Head
Install MEN Board, Main Earth and Earth Stake, Cad Welded Connection - Light Risk
Mains Cable, Mains Installation by others.
Livened by others.

Test Results (provide values)	
Polarity (Independent earth):	
Insulation resistance:	<u>200+ M Ohms</u>
Earth Continuity:	<u>0.1 Ohms</u>
Bonding:	<u>0.1 Ohms</u>
Fault Loop impedance:	<u>Ohms</u>
Other (specify):	

By signing this document I certify that the completed prescribed electrical work to which this Certificate of Compliance applies has been done lawfully and safely, and the information in the certificate is correct.

Certifier's signature: [Signature] Date: 20/02/2021

Electrical Safety Certificate

By signing this document I certify that the installation, or part of the installation, to which this Electrical Safety Certificate applies is connected to a power supply and is safe to use.

Certifier's name: [Blank] Registration/Practising licence number: [Blank]

Certifier's signature: [Blank] Certificate Issue Date: [Blank] Connection Date: [Blank]

CUSTOMER COPY - THIS IS AN IMPORTANT DOCUMENT AND SHOULD BE RETAINED FOR A MINIMUM OF 7 YEARS

The Electrical Safety Certificate also confirms that the electrical work complies with the building code for the purposes of Section 19(1)(e) of the Building Act 2004.



ELECTRICAL CERTIFICATE OF COMPLIANCE & ELECTRICAL SAFETY CERTIFICATE

REFERENCE/CERTIFICATE ID NO.:

This form has been designed to be used by licensed electrical workers to certify that installations or Part installations under Part 1 or Part 2 of AS/NZS 3000 are safe to be connected to the specified system of electrical supply.

Location Details:

Contact Details:
(Name and address)

Name of Electrical worker:

Registration/Practising licence number:

Phone & email:

Name and registration number of person(s) supervised:

Certificate of Compliance

Type of work:

Addition Alteration New work

The prescribed electrical work is:

Low risk General High-risk (Specify):

Means of compliance:

Part 1 of AS/NZS 3000 Part 2 of AS/NZS 3000

Additional Standards or electrical code of practice were required: No Yes (specify):

Date or range of dates that prescribed electrical work undertaken:

Contains fittings that are safe to connect to a power supply? Yes No

Specify type of supply system:

The installation has an earthing system that is correctly rated (where applicable) Yes No

Parts of the installation to which this certificate relates that are safe to connect to a power supply?

All Parts (specify)

The work relies on manufacturers instructions: Yes No

If yes - identify the instruction manual including name, date and version. Also attach a copy of manufacturer's instructions to this certificate. (Or provide reference to readily accessible electronic format, eg internet link.)

Identify: Manufacturer's instructions attached, VOLU Stark Little Brother LED street luminaires, 20/05/2019

Link:

The work has been done in accordance with a certified design: Yes No

If yes - identify the certified design including name, date and version. Also attach a copy of the certified design to this certificate. (Or provide reference to readily accessible electronic format, eg internet link.)

Identify: Certified design attached, Roadway Lighting Plan drawing

Link:

The work relies on a Supplier Declaration of Conformity (SDoC): Yes No

If yes - identify the SDoC including name, date and version OR EESS registration. Also attach a copy of the SDoC to this certificate. (Or provide reference to readily accessible electronic format, eg internet link.)

Identify: SDoC attached

Link:

The installation has been satisfactorily tested in accordance with the Electricity (Safety) Regulations 2010 No Yes

Description of Work:

Install New Street Column with LED Head
Install MEN Board, Main Earth and Earth Stake, Cad Welded Connection - Light Risk
Mains Cable, Mains Installation by others.
Livened by others.

Test Results (provide values)

Polarity (Independent earth):	
Insulation resistance:	200+ M Ohms
Earth Continuity:	0.1 Ohms
Bonding:	0.1 Ohms
Fault Loop impedance:	Ohms
Other (specify):	

By signing this document I certify that the completed prescribed electrical work to which this Certificate of Compliance applies has been done lawfully and safely, and the information in the certificate is correct.

Certifier's signature:

Date:

Electrical Safety Certificate

By signing this document I certify that the installation, or part of the installation, to which this Electrical Safety Certificate applies is connected to a power supply and is safe to use.

Certifier's name:

Registration/Practising licence number:

Certifier's signature:

Certificate Issue Date:

Connection Date:

CUSTOMER COPY - THIS IS AN IMPORTANT DOCUMENT AND SHOULD BE RETAINED FOR A MINIMUM OF 7 YEARS



ELECTRICAL CERTIFICATE OF COMPLIANCE & ELECTRICAL SAFETY CERTIFICATE

REFERENCE/CERTIFICATE ID No.:

This form has been designed to be used by licensed electrical workers to certify that installations or Part installations under Part 1 or Part 2 of AS/NZS 3000 are safe to be connected to the specified system of electrical supply.

Location Details:
Contact Details: (Name and address)

Name of Electrical worker: Registration/Practising licence number:

Phone & email:

Name and registration number of person(s) supervised:

Certificate of Compliance

Type of work: Addition Alteration New work
The prescribed electrical work is: Low risk General High-risk (Specify):

Means of compliance: Part 1 of AS/NZS 3000 Part 2 of AS/NZS 3000

Additional Standards or electrical code of practice were required: No Yes (specify):

Date or range of dates that prescribed electrical work undertaken:

Contains fittings that are safe to connect to a power supply? Yes No

Specify type of supply system:

The installation has an earthing system that is correctly rated (where applicable) Yes No

Parts of the installation to which this certificate relates that are safe to connect to a power supply?

All Parts (specify)

The work relies on manufacturers instructions: Yes No

If yes - identify the instruction manual including name, date and version. Also attach a copy of manufacturer's instructions to this certificate. (Or provide reference to readily accessible electronic format, eg Internet link.)

Identify: Manufacturer's instructions attached: WOLU Blok LED Brother LED street luminaires, 20/05/2019
Link:

The work has been done in accordance with a certified design: Yes No

If yes - identify the certified design including name, date and version. Also attach a copy of the certified design to this certificate. (Or provide reference to readily accessible electronic format, eg Internet link.)

Identify: Certified design attached: Roadway Lighting Plan drawing
Link:

The work relies on a Supplier Declaration of Conformity (SDoC): Yes No

If yes - identify the SDoC including name, date and version OR EESS registration. Also attach a copy of the SDoC to this certificate. (Or provide reference to readily accessible electronic format, eg Internet link.)

Identify: SDoC attached
Link:

The installation has been satisfactorily tested in accordance with the Electricity (Safety) Regulations 2010 No Yes

Description of Work:
Install New Street Column with LED Head
Install MEN Board, Main Earth and Earth Stake, Cad Welded Connection - Light Risk
Mains Cable, Mains Installation by others.
Livened by others.

Test Results (provide values)	
Polarity (Independent earth):	
Insulation resistance:	200+ M Ohms
Earth Continuity:	0.1 Ohms
Bonding:	0.1 Ohms
Fault Loop Impedance	Ohms
Other (specify):	

By signing this document I certify that the completed prescribed electrical work to which this Certificate of Compliance applies has been done lawfully and safely, and the information in the certificate is correct.

Certifier's signature: Date:

Electrical Safety Certificate

By signing this document I certify that the installation, or part of the installation, to which this Electrical Safety Certificate applies is connected to a power supply and is safe to use.

Certifier's name: Registration/Practising licence number:

Certifier's signature: Certificate Issue Date: Connection Date:

CUSTOMER COPY - THIS IS AN IMPORTANT DOCUMENT AND SHOULD BE RETAINED FOR A MINIMUM OF 7 YEARS

This Electrical Safety Certificate also confirms that the electrical work complies with the building code for the purposes of Section 19(1)(c) of the Building Act 2004.



ELECTRICAL CERTIFICATE OF COMPLIANCE & ELECTRICAL SAFETY CERTIFICATE

REFERENCE/CERTIFICATE ID No.: NWELCOC1579/2

This form has been designed to be used by licensed electrical workers to certify that installations or Part installations under Part 1 or Part 2 of AS/NZS 3000 are safe to be connected to the specified system of electrical supply.

Location Details:

Subdivision Area M - Stage 9 to 15 Greenhill Park Hamilton #119

Contact Details:
(Name and address)

Name of Electrical worker:

Yeti Martyn

Registration/Practising licence number:

E257490

Phone & email:

yetimartyn@hotmail.com

Name and registration number of person(s) supervised:

Certificate of Compliance

Type of work:

Addition Alteration New work
 Low risk General High-risk (Specify):

The prescribed electrical work is:

Means of compliance:

Part 1 of AS/NZS 3000 Part 2 of AS/NZS 3000

Additional Standards or electrical code of practice were required: No Yes (specify):

Date or range of dates that prescribed electrical work undertaken: 20/02/2021

Contains fittings that are safe to connect to a power supply? Yes No

Specify type of supply system: 230V Mains MEN

The installation has an earthing system that is correctly rated (where applicable) Yes No

Parts of the installation to which this certificate relates that are safe to connect to a power supply?

All Parts (specify)

The work relies on manufacturers instructions: Yes No

If yes - identify the instruction manual including name, date and version. Also attach a copy of manufacturer's instructions to this certificate. (Or provide reference to readily accessible electronic format, eg Internet link.)

Identify: Manufacturer's instructions attached: WOLU Slock Little Brother LED street luminaire, 20/05/2019

Link:

The work has been done in accordance with a certified design: Yes No

If yes - identify the certified design including name, date and version. Also attach a copy of the certified design to this certificate. (Or provide reference to readily accessible electronic format, eg Internet link.)

Identify: Certified design attached: Roadway Lighting Plan drawing

Link:

The work relies on a Supplier Declaration of Conformity (SDoC): Yes No

If yes - identify the SDoC including name, date and version OR EESS registration. Also attach a copy of the SDoC to this certificate. (Or provide reference to readily accessible electronic format, eg Internet link.)

Identify: SDoC attached

Link:

The installation has been satisfactorily tested in accordance with the Electricity (Safety) Regulations 2010 No Yes

Description of Work:

Install New Street Column with LED Head
Install MEN Board, Main Earth and Earth Stake, Cad Welded Connection - Light Risk
Mains Cable, Mains Installation by others.
Livened by others.

Test Results (provide values)

Polarity (Independent earth):	
Insulation resistance:	<u>200+ M Ohms</u>
Earth Continuity:	<u>0.1 Ohms</u>
Bonding:	<u>0.1 Ohms</u>
Fault Loop impedance	<u>Ohms</u>
Other (specify):	

By signing this document I certify that the completed prescribed electrical work to which this Certificate of Compliance applies has been done lawfully and safely, and the information in the certificate is correct.

Certifier's signature:

Date: 20/02/2021

Electrical Safety Certificate

By signing this document I certify that the installation, or part of the installation, to which this Electrical Safety Certificate applies is connected to a power supply and is safe to use.

Certifier's name:

Yeti Martyn

Registration/Practising licence number:

E257490

Certifier's signature:

Certificate Issue Date:

20/02/2021

Connection Date:

20/02/2021

CUSTOMER COPY - THIS IS AN IMPORTANT DOCUMENT AND SHOULD BE RETAINED FOR A MINIMUM OF 7 YEARS



ELECTRICAL CERTIFICATE OF COMPLIANCE & ELECTRICAL SAFETY CERTIFICATE

REFERENCE/CERTIFICATE ID NO.: **NWELCOC1579 13**

This form has been designed to be used by licensed electrical workers to certify that installations or Part installations under Part 1 or Part 2 of AS/NZS 3000 are safe to be connected to the specified system of electrical supply.

Location Details:

Subdivision Area M - Stage 9 to 15 Greenhill Park Hamilton #121

Contact Details:
(Name and address)

Name of Electrical worker:

Yeti Martyn

Registration/Practising licence number:

E257490

Phone & email:

yetimartyn@hotmail.com

Name and registration number of person(s) supervised:

Certificate of Compliance

Type of work:

- Addition Alteration New work
 Low risk General High-risk (Specify):

The prescribed electrical work is:

Means of compliance:

- Part 1 of AS/NZS 3000 Part 2 of AS/NZS 3000

Additional Standards or electrical code of practice were required: No Yes (specify):

Date or range of dates that prescribed electrical work undertaken: 20/02/2021

Contains fittings that are safe to connect to a power supply? Yes No

Specify type of supply system: 230V Mains MEN

The installation has an earthing system that is correctly rated (where applicable) Yes No

Parts of the installation to which this certificate relates that are safe to connect to a power supply?

All Parts (specify)

The work relies on manufacturers instructions:

- Yes No

If yes - identify the instruction manual including name, date and version. Also attach a copy of manufacturer's instructions to this certificate. (Or provide reference to readily accessible electronic format, eg Internet link.)

Identify: Manufacturer's instructions attached. VOLLI Stock Little Brother LED street luminaire, 20/02/2021

Link:

The work has been done in accordance with a certified design: Yes No

If yes - identify the certified design including name, date and version. Also attach a copy of the certified design to this certificate. (Or provide reference to readily accessible electronic format, eg Internet link.)

Identify: Certified design attached. Roadway Lighting Plan drawing

Link:

The work relies on a Supplier Declaration of Conformity (SDoC): Yes No

If yes - identify the SDoC including name, date and version OR EESS registration. Also attach a copy of the SDoC to this certificate. (Or provide reference to readily accessible electronic format, eg Internet link.)

Identify: SDoC attached

Link:

The installation has been satisfactorily tested in accordance with the Electricity (Safety) Regulations 2010 No Yes

Description of Work:

Install New Street Column with LED Head
 Install MEN Board, Main Earth and Earth Stake, Cad Welded Connection - Light Risk
 Mains Cable, Mains Installation by others.
 Livened by others.

Test Results (provide values)

Polarity (independent earth):	
Insulation resistance:	200+ M Ohms
Earth Continuity:	0.1 Ohms
Bonding:	0.1 Ohms
Fault Loop impedance:	Ohms
Other (specify):	

By signing this document I certify that the completed prescribed electrical work to which this Certificate of Compliance applies has been done lawfully and safely, and the information in the certificate is correct.

Certifier's signature:

[Signature]

Date: 20/02/2021

Electrical Safety Certificate

By signing this document I certify that the installation, or part of the installation, to which this Electrical Safety Certificate applies is connected to a power supply and is safe to use.

Certifier's name:

Registration/Practising licence number:

Certifier's signature:

Certificate Issue Date:

Connection Date:

CUSTOMER COPY - THIS IS AN IMPORTANT DOCUMENT AND SHOULD BE RETAINED FOR A MINIMUM OF 7 YEARS



ELECTRICAL CERTIFICATE OF COMPLIANCE & ELECTRICAL SAFETY CERTIFICATE

REFERENCE/CERTIFICATE ID No.:

This form has been designed to be used by licensed electrical workers to certify that installations or Part installations under Part 1 or Part 2 of AS/NZS 3000 are safe to be connected to the specified system of electrical supply.

Location Details:

Contact Details:
(Name and address)

Name of Electrical worker:

Registration/Practising licence number:

Phone & email:

Name and registration number of person(s) supervised:

Certificate of Compliance

Type of work:

Addition Alteration New work

The prescribed electrical work is:

Low risk General High-risk (Specify):

Means of compliance:

Part 1 of AS/NZS 3000 Part 2 of AS/NZS 3000

Additional Standards or electrical code of practice were required: No Yes (specify):

Date or range of dates that prescribed electrical work undertaken:

Contains fittings that are safe to connect to a power supply? Yes No

Specify type of supply system:

The installation has an earthing system that is correctly rated (where applicable) Yes No

Parts of the installation to which this certificate relates that are safe to connect to a power supply?

All Parts (specify)

The work relies on manufacturers instructions:

Yes No

If yes - identify the instruction manual including name, date and version. Also attach a copy of manufacturer's instructions to this certificate. (Or provide reference to readily accessible electronic format, eg Internet link.)

Identify: Manufacturer's instructions attached: VOLU Stok Little Brother LED street luminaires, 20/05/2019

Link:

The work has been done in accordance with a certified design: Yes No

If yes - identify the certified design including name, date and version. Also attach a copy of the certified design to this certificate. (Or provide reference to readily accessible electronic format, eg Internet link.)

Identify: Certified design attached: Roadway Lighting Plan drawing

Link:

The work relies on a Supplier Declaration of Conformity (SDoC): Yes No

If yes - identify the SDoC including name, date and version OR EESS registration. Also attach a copy of the SDoC to this certificate. (Or provide reference to readily accessible electronic format, eg Internet link.)

Identify: SDoC attached

Link:

The installation has been satisfactorily tested in accordance with the Electricity (Safety) Regulations 2010 No Yes

Description of Work:

Install New Street Column with LED Head
Install MEN Board, Main Earth and Earth Stake, Cad Welded Connection - Light Risk
Mains Cable, Mains Installation by others.
Livened by others.

Test Results (provide values)

Polarity (Independent earth):	
Insulation resistance:	200+ M Ohms
Earth Continuity:	0.1 Ohms
Bonding:	0.1 Ohms
Fault Loop impedance:	Ohms
Other (specify):	

By signing this document I certify that the completed prescribed electrical work to which this Certificate of Compliance applies has been done lawfully and safely, and the information in the certificate is correct.

Certifier's signature:

Date:

Electrical Safety Certificate

By signing this document I certify that the installation, or part of the installation, to which this Electrical Safety Certificate applies is connected to a power supply and is safe to use.

Certifier's name:

Registration/Practising licence number:

Certifier's signature:

Certificate Issue Date:

Connection Date:

CUSTOMER COPY - THIS IS AN IMPORTANT DOCUMENT AND SHOULD BE RETAINED FOR A MINIMUM OF 7 YEARS



ELECTRICAL CERTIFICATE OF COMPLIANCE & ELECTRICAL SAFETY CERTIFICATE

Reference/Certificate ID No.: NWELCOG 583 JS

This form is to be completed and used by licensed electrical workers to certify that a part of an electrical installation meets the Part 1 or Part 2 of AS/NZS 3000 (as applicable) in accordance with the specified voluntary national standard.

Location Details: Subdivision Area M Stage 9 to 15 Greenhill Park Hamilton # 7/3

Contact Details: (Name and address)

Name of Electrical worker: Yeti Martyn Registration/Practising licence number: E257490

Phone & email: (optional) (provide details)

Name and registration number of person(s) supervised:

Certificate of Compliance

Type of work: Addition Alteration New work
The prescribed electrical work is: Low Risk General High Risk (see 4.1)

Means of compliance: Part 1 of AS/NZS 3000 Part 2 of AS/NZS 3000

Additional Standards or electrical code of practice were required: No Yes (specify):

Date or range of dates that prescribed electrical work undertaken: 18/03/2021

Contains fittings that are safe to connect to a power supply? Yes No

Specify type of supply system: 240V Mains M/FH

The installation has an earthing system that is correctly rated (where applicable) Yes No

Parts of the installation to which this certificate relates that are safe to connect to a power supply? All Parts (specify):

The work relies on manufacturers instructions: Yes No
Specify (identify the installation and include name, date and version). Also attach a copy of manufacturer's instructions to this certificate.
Or provide reference to readily accessible electronic format (eg internet link).

The work has been done in accordance with a certified design: Yes No
If yes - identify the certified design including name, date and version. Also attach a copy of the certified design to this certificate.
(Or provide reference to readily accessible electronic format, eg internet link)

The work relies on a Supplier Declaration of Conformity (SDoC): Yes No
If yes - identify a SDoC including name, date and version or CE/UKCA registration. Also attach a copy of the SDoC to this certificate.
(Or provide reference to readily accessible electronic format, eg internet link)

The installer has been satisfactorily tested in accordance with the Electricity (Safety) Regulations 2010 No Yes

Description of Work: Install New Street Column with LED Head
Install MEN Board, Main Earth and Earth Stake, Cad Welded Connection - Light Risk
Mains Cable, Mains installation by others
Livered by others.

Test Results (provide values)	
Isolation	
Insulation resistance	240V - 1M Ohms
Earth Continuity	0 Ohms
Bonding	0 Ohms
Earth Loop Impedance	0 Ohms
Other (specify)	

By signing this document I certify that the completed prescribed electrical work to which this Certificate of Compliance applies has been done lawfully and safely, and the information in the certificate is correct.

Certifier's signature: [Signature] Date: 09/03/2021

Electrical Safety Certificate

By signing this document I certify that the installation, or part of the installation, to which this Electrical Safety Certificate applies is connected to a power supply and is safe to use.

Certifier's name: _____ Registration/Practising licence number: _____
Certifier's signature: _____ Cert issue date: _____ Connection date: _____



ELECTRICAL CERTIFICATE OF COMPLIANCE & ELECTRICAL SAFETY CERTIFICATE

Registration/Certificate ID No

EWEL0001683-7

This certificate is an integral part of the prescribed electrical work to which it relates and is not valid unless used in accordance with Part 2 of AS/NZS 3000 and the rules contained in the prescribed safety rules.

Location Details:

Subdivision Area M - Stage 8 to 15 Greenhill Park Hamilton # 120

Contact Details:
(Name & address)

Name of Electrical worker:

Yeti Martyn

Registration/Practising licence number:

E257490

Phone & email:

yetimartyn@shining.com

Name and registration number of person(s) supervised:

Certificate of Compliance

Type of work:

Addition

Alteration

New work

Is prescribed electrical work in:

Low risk

General

High Risk (Safety)

Means of compliance:

Part 1 of AS/NZS 3000

Part 2 of AS/NZS 3000

Additional standards or electrical code of practice were required:

No

Yes (specify)

Date or range of dates that prescribed electrical work undertaken:

Contains fittings that are safe to connect to a power supply?

Yes

No

Specify type of supply system: 200V Mains MEN

The installation has an earthing system that is correctly rated (where applicable)

Yes

No

Parts of the installation to which this certificate relates that are safe to connect to a power supply?

All

Parts (specify)

The work relies on manufacturers instructions:

Yes

No

If yes - identify the instructions (manufacturer name, date and version). Also attach a copy of manufacturer's instructions to this certificate.

If provide reference to readily accessible electronic format, eg internet link

Identify manufacturer's name, date and version. Attach a copy of manufacturer's instructions to this certificate.

Link

The work has been done in accordance with a certified design:

Yes

No

If yes - identify the certified design (drawing name, date and version). Also attach a copy of the certification to this certificate.

If provide reference to readily accessible electronic format, eg internet link

Identify manufacturer's name, date and version.

Link

The work relies on a Supplier Declaration of Conformity (SDoC):

Yes

No

If yes - identify the SDoC (relating name, date and version) of IESS signatory. Also attach a copy of the SDoC to this certificate.

If provide reference to readily accessible electronic format, eg internet link

Identify manufacturer's name

Link

The installation has been satisfactorily tested in accordance with the Electricity (Safety) Regulations 2010

No

Yes

Description of Work:

Install New Street Column with LED Head

Install MEN Board, Main Earth and Earth Stake, Cad Welded Connection - Light Risk

Mains Cable, Mains installation by others.

Livened by others.

Test Results (provide values)

Insulation resistance	200 M Ohms
Earth Continuity	0.1 Ohms
Resistance	0.1 Ohms
Fault loop impedance	Ohms
Other (specify)	

By signing this document I certify that the completed prescribed electrical work to which this Certificate of Compliance applies has been done lawfully and safely, and the information in the certificate is correct.

Certifier's signature:

Date: 10/03/2021

Electrical Safety Certificate

By signing this document I certify that the installation, or part of the installation, to which this Electrical Safety Certificate applies is connected to a power supply and is safe to use.

Certifier's name:

Registration/Practising licence number:

Certifier's signature:

Certificate Issue Date:

Connection Date:

CUSTOMER COPY - THIS IS AN IMPORTANT DOCUMENT AND SHOULD BE RETAINED FOR A MINIMUM OF 7 YEARS



ELECTRICAL CERTIFICATE OF COMPLIANCE & ELECTRICAL SAFETY CERTIFICATE

Reference/Certificate ID No. NWEL00018870

This Certificate is valid up to the next 12 months unless a written extension of validity is obtained from the Electrical Safety Council or Part 2 of AS/NZS 3000 is not fully complied to the specified date and time of issue.

Location Details:

Subdivision Area M - Stage 9 to 15 Greenhill Park Hamilton #1DS

Contact Details:
(Name and address)

Name of Electrical worker:

Yeti Martyn

Registration/Practising licence number:

E257490

Phone & email:

0274981824 / yeti@yetimartyn.co.nz

Name and registration number of person(s) supervised:

Certificate of Compliance

Type of work:

Addition

Alteration

New work

The prescribed electrical work is:

Low risk

General

High-risk category

Means of compliance:

Part 1 of AS/NZS 3000

Part 2 of AS/NZS 3000

Additional Standards or Electrical code of practice were required:

No Yes (specify)

Date or range of dates that prescribed electrical work undertaken:

Contains fittings that are safe to connect to a power supply?

Yes No

Specify type of supply system: 230V Mains MGN

The installation has an earthing system that is correctly rated (where applicable)

Yes No

Parts of the installation to which this certificate relates that are safe to connect to a power supply?

All Parts (specify)

The work relies on manufacturers instructions:

Yes No

If yes - identify the instructions (including name, date and version) and attach a copy of manufacturer's instructions to this certificate

If unable refer to the readily accessible internet link, eg. [www.ecnz.co.nz](#)

Identify the internet link to the readily accessible electronic format, eg. internet link

The work has been done in accordance with a certified design:

Yes No

If yes - identify the certified design (including name, date and version) and attach a copy of the certified design to this certificate

(Or provide a readily accessible electronic format, eg. internet link)

Identify the internet link to the readily accessible electronic format, eg. internet link

The work relies on a Supplier Declaration of Conformity (SDoC):

Yes No

If yes - identify the SDoC (including name, date and version) if it is registration also attach a copy of the SDoC to this certificate

(Or provide a readily accessible electronic format, eg. internet link)

Identify the internet link

The installation has been satisfactorily tested in accordance with the Electricity (Safety) Regulations 2010

No Yes

Description of Work:

Install New Street Column with LED Head

Install MEN Board, Main Earth and Earth Stake, Gas Welded

Connection - Light Risk

Mains Cable, Mains Installation by others.

Livened by others

Test Results (provide values)

Test	Value	Limit
Insulation resistance	<u>200</u> M Ohms	Ohms
Earth Continuity	<u>0.1</u>	Ohms
Resistance	<u>0.1</u>	Ohms
Earth Loop Impedance		Ohms
Continuity		

By signing this document I certify that the completed prescribed electrical work to which this Certificate of Compliance applies has been done lawfully and safely, and the information in the certificate is correct

Certifier's signature:

Date: 03/03/2021

Electrical Safety Certificate

By signing this document I certify that the installation, or part of the installation, to which this Electrical Safety Certificate applies is connected to a power supply and is safe to use.

Certifier's name:

Registration/Practising licence number:

Certifier's signature:

Certificate Issue Date:

Connection Date:

Customer Copy - This is an important document and should be retained for a minimum of 7 years

© 2019 Electrical Safety Council of New Zealand. All rights reserved. This document is the property of the Electrical Safety Council of New Zealand.



Electrical Workers Registration Board

www.electricalworkers.co.nz

Record of Inspection (ROI) of High-Risk Prescribed Electrical Work

(Pursuant to the Electricity (Safety) Regulations 2010)



Reference/Record Number:

Nat onwired greenhill

Issuer (Inspector) details:

Name of inspector: Gavin Bodey

Registration #: 1250728

Email Address: gavin@bodeyspark.co.nz

Telephone: 021 426 820

Location of Installation:

Location details: Greenhill park subdivision, Area M, Street light 133, stage 9-15

Location Type: Domestic Non-Domestic Accommodation Industrial Commercial
 Educational Healthcare Miscellaneous (other)

Certifying Electrical Work and Certificate of Compliance (CoC) details:

Name of Electrical worker(s): Yari Martyn

Registration #: L257490

FW121000

CoC details: Nationwired 15931

CoC(s) attached

Certifying Electrical Work and CoC details:

What was inspected:

New Installation. New Streetlight with M.E.N. board, New Main Neutral bar and circuit protection. New Main Earthing System. Bonding of Pole and cabinet door.

Specify the regulation(s) and companion standard(s), or identify the certified design, followed when carrying out the inspection:
AS/NZS3000 part 2

What are the results of the inspection:

Earthing and bonding visually ok,

so only

M.E.C. mp < 5 Ohm

M.E.N. int.,

HRPA #005830023M

High Risk Category:

- Not to AS/NZS 3000 Part 2 – 6A(2)(a)(i) Photovoltaic system – 6A(2)(a)(iv) Electrical medical area – 6A(2)(b)(i)
- High voltage installation – 6A(2)(a)(ii) Hazardous area – 6A(2)(a)(v) Mains work – 6A(2)(b)
- Mains parallel generation – 6A(2)(a)(iii) Animal stunning or heat conditioning – 6A(2)(c)
- Other – please describe: _____

Declaration

I hereby confirm that the work described above has been done in accordance with the regulations, and the ~~responsibility~~ ^{responsibility} on which the work has been done is, and will be ~~correct~~ ^{correct}, when delivered, electrically safe.

(Note: Strike out or delete the applicable words highlighted in red above.)

Signature: _____

Date: 10/03/21



Electrical Workers Registration Board

www.electricalworkers.co.nz

Record of Inspection (ROI) of High-Risk Prescribed Electrical Work

(Prescribed to the Electricity (Safety) Regulations 2010)



Reference/Record Number:

Nationwired greenh ll

Issuer (Inspector) details:

Name of Inspector: Gavin Bodey

Registration #: E250728

Email Address: gavin@bodeyspark.co.nz

Telephone: 021 428 820

Location of Installation:

Location details: Greenhill park subdivision, Area M, Streetlight 134 stage 3-15

Location Type: Domestic Non-Domestic Accommodation Industrial Commercial
 Educational Healthcare Miscellaneous (other)

Certifying Electrical Work and Certificate of Compliance (CoC) details:

Name of Electrical worker(s): Yeti Martyn

Registration #: E257400

EW# 21000

CoC details: Nationwired 15832

CoC(s) attached

Certifying Electrical Work and CoC details:

What was Inspected:

New installation, New Streetlight with M.E.N. board, New Main Neutral bar and circuit protection, New Main Earthing System, Bonding of Pole and cabinet door.

Specify the regulation(s) and comparison standard(s), or identify the certified design, followed when carrying out the inspection:
AS/NZS 3000 part 2

What are the results of the inspection

Earthing and bonding visual ok

polarity

M.E.C. imp < 5 Ohm

M.E.N. links: HIRPA #0058304115G

High Risk Category:

- Not to AS/NZS 3000 Part 2 - SA(2)(a)(i)
 High voltage installation - SA(2)(a)(ii)
 Main parallel generation - SA(2)(a)(iii)
 Other - please describe: _____
- Protection system - SA(2)(a)(iv)
 Hazardous area - SA(2)(a)(v)
 Aerial working or line conditioning - SA(2)(ii)
- Electrical medical area - SA(2)(a)(vi)
 Main work - SA(2)(b)

Declaration

I hereby confirm that the work described above has been done in accordance with the regulations, and the installation part installation on which the work has been done is, and will be, when finished, electrically safe.

(Please strike out or delete the inapplicable categories highlighted in red above.)

Signature: _____

Date: 10/03/21



Electrical Workers Registration Board

100-100, Victoria Street, Auckland

Record of Inspection (ROI) of High-Risk Prescribed Electrical Work

(Pursuant to the Electricity (Safety) Regulations 2000)



Reference/Record Number:

Nationwired greenhill

Issuer (Inspector) details:

Name of Inspector: Gavin Boddy

Registration #: 1250728

Email Address: gavin@pococyspark.co.nz

Telephone: 021 428 820

Location of Installation:

Location details: Greenhill park subdivision, Area M, Streetlight 135, stage 9-15

Location Type: Domestic Non-Domestic Accommodation Industrial Commercial
 Educational Healthcare Miscellaneous (other)

Certifying Electrical Work and Certificate of Compliance (CoC) details:

Name of Electrical worker(s): Yeti Martyn

Registration #: E257490

EW171000

CoC details: Nationwired 15B33

CoC(s) attached

Certifying Electrical Work and CoC details:

What was inspected:

New Installation, New Streetlight with M.E.N. board, New Main Neutral bar and circuit protection, New Main Earthing System, Bonding of Pole and cabinet, door

Specify the regulation(s) and companion standard(s), or identify the certified design, followed when carrying out the inspection:
AS/NZS 3000 part 2

What are the results of the inspection:

Earthing and bonding visual ok,

polarity

M.E.C. imp < 5 Ohm

M.E.N. link

IRPA #00583062CV

High Risk Category:

- Not to AS/NZS 3000 Part 2 - 6A(2)(a)(i) Photovoltaic system - 6A(2)(a)(iv) Electrical remedial area - 6A(2)(a)(v)
 High-voltage installation - 6A(2)(a)(ii) Hazardous area - 6A(2)(a)(vi) Main work - 6A(2)(b)
 Main parallel generation - 6A(2)(a)(iii) Animal stunning or meat conditioning - 6A(2)(c)
 Other - please describe

Declaration

I hereby confirm that the work described above has been done in compliance with the regulations; and the workmanship / part installation on which the work has been done is, and will be safe when re-energised, electrically safe

(Note: Strike out or delete the inappropriate work highlighted in red above.)

Signature

Date 10/03/21



Electrical Workers Registration Board

Electrical Workers Registration Board (EWRB)

Record of Inspection (ROI) of High-Risk Prescribed Electrical Work

(Pursuant to the Electricity (Safety) Regulations 2010)



Reference/Record Number:

Nationwired greenhll

Issuer (Inspector) details:

Name of Inspector: Gav'n Bodey

Registration #: I250728

Email Address: gavin@bodeyspark.co.nz

Telephone: 021 428 820

Location of Installation:

Location details: Greenhill park subdivision, Area M, Streetlight 130, stage 9-15

Location Type: Domestic Non-Domestic Accommodation Industrial Commercial
 Educational Healthcare Miscellaneous (other)

Certifying Electrical Work and Certificate of Compliance (CoC) details:

Name of Electrical worker(s): Yell Martyn

Registration #: E257490

CoC details: Nationwired 15834

EW121000

CoC(s) attached

Certifying Electrical Work and CoC details:

What was inspected:

New Installation. New Streetlight with M.E.N. board. New Main Neutral bar and circuit protection. New Main Earthing System Bonding of Pole and cabinet door.

Specify the regulation(s) and comparison standard(s), or identify the certified design, followed when carrying out the inspection.
AS/NZS 3000 part 2

What are the results of the inspection:

Earthing and bonding visual ok

potenti

M.E.C. link < 5 Ohm

M.E.N. link..

HRPA #0358357K6D

High Risk Category:

- Not to AS/NZS 3000 Part 2 - 6A(2)(i) Photovoltaic system - 6A(2)(ii) Electrical medium area - 5A(2)(iv)
 High voltage installation - 6A(2)(iii) Hazardous area - 6A(2)(v) Mains work - 6A(2)(b)
 Mains parallel generation - 5A(2)(ii) Animal stunning or meat conditioning - 6A(2)(c)
 Other - please describe.

Declaration

I hereby confirm that the work described above, has been done in accordance with the regulations; and the installation/part installation on which the work has been done is, and will be, when enforced, electrically safe

(Note: Strike out or underline inappropriate words highlighted in red above)

Signature:

Date: 10/03/21



Electrical Workers Registration Board

100 Victoria Street, Auckland, New Zealand

Record of Inspection (ROI) of High-Risk Prescribed Electrical Work

(Pursuant to the Electricity (Safety) Regulations 2002)



Reference/Record Number:

Nationwired greenhill II

Issuer (Inspector) details:

Name of Inspector: Gavin Booley

Registration #: 1250/28

Email Address: gavin@booleyspark.co.nz

Telephone: 021 426 620

Location of Installation:

Location details: Greenhill park subdivision, Area M, Streetlight 137, stage 9-15

Location Type: Domestic Non-Domestic Accommodation Industrial Commercial
 Educational Healthcare Miscellaneous (other)

Certifying Electrical Work and Certificate of Compliance (CoC) details:

Name of Electrical worker(s): Yes: Martyn

Registration #: E26/490

EW121000

CoC details: Nationwired 15335

CoC(s) attached

Certifying Electrical Work and CoC details:

What was inspected:

New Installation, New Streetlight with M.E.N. board New Main Neutral bar and circuit protection, New Main Earthing System, Bonding of Pole and cabinet door

Specify the regulation(s) and companion standard(s), or identify the certified design, followed when carrying out the inspection:
AS/NZS 3000 part 2

What are the results of the inspection:

Earthing and bonding visual ok.

polarity

M.E.N. imp < 5 Ohm

M.E.N. link..

IRPA #0059311v28

High Risk Category:

- Not to AS/NZS 3000 Part 2 - 6A(7)(b)(i) Photovoltaic system - 6A(2)(a)(iv) Electrical medical area - 6A(2)(a)(vi)
 High voltage installation - 6A(2)(a)(ii) Hazardous area - 6A(2)(a)(v) Mains work - 6A(2)(b)
 Mains parallel generation - 6A(2)(a)(iii) Animal stunning or meat conditioning - 6A(2)(c)
 Other - please describe: _____

Declaration

I hereby confirm that the work described above has been done in accordance with the regulations and the ~~relevant~~ part installation on which the work has been done is, and will be ~~fit for use~~, when delivered, electrically safe.

(Note: Strike out or delete the inappropriate words highlighted in red above.)

Signature:

Date: 10/03/21



Electrical Workers Registration Board

Electrical Workers Registration Board
PO Box 100, Wellington, New Zealand

Record of Inspection (RO) of High-Risk Prescribed Electrical Work

(Pursuant to the Electricity (Safety) Regulations 2010)



Reference/Record Number:

Nationwired greenhill

Issuer (Inspector) details:

Name of Inspector: Gavin Bodey

Registration #: J250728

Email Address: gavin@bodeyspark.co.nz

Telephone: 021 423 870

Location of Installation:

Location details: Greenhill park subdivision, Area M, Streetlight 138, stage 9-16

Location Type: Domestic Non-Domestic/Accommodation Industrial Commercial
 Educational Healthcare Miscellaneous (other)

Certifying Electrical Work and Certificate of Compliance (CoC) details:

Name of Electrical worker(s): Yeli Martyn

Registration #: E257490

EW: 21000

CoC details: Nationwired 15835

CoC(s) attached

Certifying Electrical Work and CoC details:

What was inspected:

New installation: New Streetlight with M.E.N. board. New Main Neutral bar and circuit protection. New Main Earthing System. Banding of Pole and cabinet door.

Specify the regulation(s) and comparison standard(s), or identify the certified design, followed when carrying out the inspection AS/NZS 3000 part 2

What are the results of the inspection:

banding and bonding visual ok

polarity

M.E.C. imp < 5 Ohm

M.F.N. link

HRPA #0358393M20

High Risk Category:

- Not to AS/NZS 3000 Part 2 – 6A(2)(a)(i) Fluorinated system – 6A(2)(a)(iv) Electrical medical area – 6A(2)(a)(v)
- High voltage installation – 6A(2)(a)(ii) Hazardous area – 6A(2)(a)(vi) Mains work – 6A(2)(b)
- Mains parallel generation – 6A(2)(a)(iii) Animal stunning or meat conditioning – 6A(2)(c)
- Other – please describe:

Declaration

I hereby confirm that the work described above has been done in accordance with the regulations, and the installation/part installation on which the work has been done is, and will be, when delivered, electrically safe.

(Note: Strike out or delete the inappropriate words highlighted in red above.)

Signature

Date: 10/03/21



Electrical Workers Registration Board

Electrical Workers Registration Board
PO Box 100, Wellington, New Zealand

Record of Inspection (ROI) of High-Risk Prescribed Electrical Work

(Pursuant to the Electricity (Safety) Regulations 2010)



Reference/Record Number:

Nationwired greenhill

Issuer (Inspector) details

Name of Inspector: Gavin Bodoy

Registration #: 1250728

Email Address: gav'n@bodoyspark.co.nz

Telephone: 021 428 820

Location of Installation:

Location details: Greenhill park subdivision, Area M, Streetlight 139, stage 3-15

Location Type: Domestic Non-Domestic Accommodation Industrial Commercial
 Educational Healthcare Miscellaneous (other)

Certifying Electrical Work and Certificate of Compliance (CoC) details:

Name of Electrical worker(s): Yeti Martyn

Registration #: E257490

EW121000

CoC details: Nationwired # 5837

CoC(s) attached

Certifying Electrical Work and CoC details:

What was inspected:

New installation New Streetlight with M.E.N. board, New Main Neutral bar and circuit protection, New Main Earthing System Bonding of Poles and cabinet door

Specify the regulation(s) and comparison standard(s), or identify the certified design, followed when carrying out the inspection: AS/NZS 3000 part 2

What are the results of the inspection:

Earthing and bonding visual ok,

polarity

M.F.C. imp = 5 Ohm

M.E.N. link = RPA #0038315F7X

High Risk Category:

- Not to AS/NZS 3000 Part 7 - 6A(2)(a)(v)
 High voltage installation - 6A(2)(b)(ii)
 Mains parallel generation - 6A(2)(c)(ii)
 Other - please describe: _____
- Photovoltaic system - 6A(2)(a)(v)
 Hazardous area - 6A(2)(b)(v)
 Animal stunning or meat conditioning - 6A(2)(c)
- Vertical medical area - 6A(2)(b)(vi)
 Mains work - 6A(2)(a)

Declaration

I hereby confirm that the work described above has been done in accordance with the regulations; and the installation/part installation to which the work has been done is, and will be, when delivered, electrically safe

(Note: Strike out or delete the inappropriate work highlighted in red above.)

Signature

Date: 10/03/21



Electrical Workers Registration Board

Electrical Workers Registration Board
PO Box 10000, Auckland 1142

Record of Inspection (ROI) of High-Risk Prescribed Electrical Work

(Pursuant to the Electricity (Safety) Regulations 2010)



Reference/Record Number:

Nationwired greenhill

Issuer (Inspector) details:

Name of Inspector: Gavin Bodey

Registration #: I250728

Email Address: gavin@bodeyspark.co.nz

Telephone: 021 428 820

Location of Installation:

Location details: Greenhill park subdivision, Area M, Streetlight 109 stage 9-16

Location Type: Domestic Non-Domestic Accommodation Industrial Commercial
 Educational Healthcare Miscellaneous (other)

Certifying Electrical Work and Certificate of Compliance (CoC) details:

Name of Electrical worker(s): Yeti Marilyn

Registration #: E257490

EW121000

CoC details: Nationwired 15792 Streetlight: 109

CoC(s) attached

Certifying Electrical Work and CoC details:

What was inspected:

New Installation, New Streetlight with M.E.N. board, New Main Neutral bar and circuit protection, New Main Earthing System, Bonding of Pole and cabinet door.

Specify the regulation(s) and compliance standard(s), or identify the certified design, followed when carrying out the inspection
AS/NZS3000 part 2

What are the results of the inspection:

Earthing and bonding system ok,

only

M.E.C. Imp < 5 Ohm

M.E.N. Imp. -RPA #005836744L

High Risk Category:

- Not to AS/NZS 3000 Part 2 - 6A(2)(a)(i) Photovoltaic system - 6A(2)(b)(iv) Electrical medical area - 6A(2)(a)(ii-A)
 High voltage installation - 6A(2)(b)(v) Hazardous area - 6A(2)(a)(iv) Mains work - 6A(2)(b)
 Mains parallel generator - 6A(2)(b)(iii) Animal stunning or meat conditioning - 6A(2)(c)
 Other - please describe:

Declaration

I hereby confirm that the work described above has been done in ~~full~~ accordance with the regulations, and the ~~regulation~~ part
installation on which the work has been done is, and will be ~~correct~~, when oil tested, electrically safe.

(Note: Strike out or delete the inapplicable words highlighted in red above.)

Signature:

Date: 10/03/21



Electrical Workers Registration Board

Electrical Workers Registration Board
PO Box 10000, Auckland, New Zealand

Record of Inspection (ROI) of High-Risk Prescribed Electrical Work

(Pursuant to the Electricity (Safety) Regulations 2010)



Reference/Record Number:

Nationwired greenhill

Issuer (Inspector) details

Name of Inspector: Gavin Rooney

Registration #: 1250728

Email Address: gavin@todayspark.co.nz

Telephone: 021 428 820

Location of Installation:

Location details: Greenhill park subdivision, Area M, Streetlight 110slage 9-15

Location Type: Domestic Non-Domestic Accommodation Industrial Commercial
 Educational Healthcare Miscellaneous (other)

Certifying Electrical Work and Certificate of Compliance (CoC) details:

Name of Electrical worker(s): Yeri Martyn

Registration #: E257480

EW121000

CoC details: Nationwired 157923 Streetlight 110

CoC(s) attached

Certifying Electrical Work and CoC details:

What was inspected:

New installation, New Streetlight with M.E.N board, New Main Neutral bar and circuit protection, New Main Earthing System Bonding of Pole and cabinet door

Specify the regulation(s) and companion standard(s), or identify the certified design, followed when carrying out the inspection:
AS/NZS 3000 part 2

What are the results of the inspection:

Earthing and bonding visual ok,

isolate

M.E.C. imp < 5 Ohm

M.E.N. link

HRPA 00058367K4L

High Risk Category:

- Not to AS/NZS 3000 Part 2 - 6A(2)(a)(i) Photovoltaic system - 6A(2)(a)(iv) Electrical medical area - 6A(2)(a)(ii)
 High voltage installation - 6A(2)(a)(iii) Hazardous area - 6A(2)(a)(v) Mains work - 6A(2)(b)
 Mains parallel generation - 6A(2)(a)(ii) Artificial stunning or meat conditioning - 6A(2)(c)
 Other - please describe:

Declaration

I hereby confirm that the work described above has been done in / ~~is~~ accordance with the regulations; and the ~~installation / part~~ installation on which the work has been done is, and will be / ~~not be~~, when delivered, electrically safe.

(Note: Strike out or delete the italicized words highlighted in red above.)

Signature

Date: 10/03/21



Electrical Workers Registration Board

10001, 1000101, 1000102, 1000103, 1000104

Record of Inspection (ROI) of High-Risk Prescribed Electrical Work

(Pursuant to the Electricity (Safety) Regulations 2010)



Reference/Record Number:

Nationwired greenhill

Issuer (Inspector) details:

Name of Inspector:	Gav'n Bodey	Registration #	I250728
Email Address:	gavyn@bodeyspark.co.nz	Telephone	021 428 829

Location of Installation:

Location details: Greenhill park subdivision, Area M, Streetlight 11 stage 9-15

Location Type: Domestic Non-Residential Accommodation Industrial Commercial
 Educational Healthcare Miscellaneous (other)

Certifying Electrical Work and Certificate of Compliance (CoC) details:

Name of Electrical worker(s):	Yeli Martyn	Registration #:	E257460
			EW121000
CoC details:	Nationwired 15/94 Streetlight 11	<input type="checkbox"/> CoC(s) attached	

Certifying Electrical Work and CoC details:

What was inspected

New installation, New Streetlight with M E N board, New Main Neutral bar and circuit protection, New Main Earthing System Bonding at Pole and cabinet door.

Specify the regulation(s) and comparison standard(s), or identify the certified design, followed when carrying out the inspection: AS/NZS3000 part 2

What are the results of the inspection.

Earthing and bonding visual ok

polarity

M E C. Imp < 5 Ohm

M E N. ok

HRPA #0358372015

High Risk Category:

- | | | |
|--|--|---|
| <input type="checkbox"/> Not to AS/NZS 3000 Part 2 – 5A(2)(a)(i) | <input type="checkbox"/> Photovoltaic system – 6A(2)(a)(iv) | <input type="checkbox"/> Electrical meter area – 5A(2)(a)(vi) |
| <input type="checkbox"/> High voltage installation – 6A(2)(a)(ii) | <input type="checkbox"/> Hazardous area – 6A(2)(a)(v) | <input checked="" type="checkbox"/> Mains work – 6A(2)(b) |
| <input type="checkbox"/> Mains parallel generation – 6A(2)(a)(iii) | <input type="checkbox"/> Animal stunning or meat wind tunneling – 6A(2)(c) | |
| <input type="checkbox"/> Other – please describe: | | |

Declaration

I hereby confirm that the work described above has been done in accordance with the regulations, and the ~~relevant standard~~/part of the regulation on which the work has been done is, and will be ~~safe~~ when delivered, electrically safe.

(Note: Strike out or delete the inapplicable words highlighted in red above.)

Signature

Date: 10/03/21



Electrical Workers Registration Board

100 Eymers Park, Eymers Park NSW 2177

Record of Inspection (ROI) of High-Risk Prescribed Electrical Work

(Pursuant to the Electricity (Safety) Regulations 2010)



Reference/Record Number:

Nationwired greenhill

Issuer (Inspector) details:

Name of Inspector: Gavin Bockey

Registration #: I250728

Email Address: gavin@pooeyspark.com.au

Telephone: 021 428 820

Location of Installation:

Location details: Greenhill park subdivision, Area M, Streetlight 112 stage 9-15

Location type: Domestic Non-Domestic Accommodation Industrial Commercial
 Educational Healthcare Miscellaneous (other)

Certifying Electrical Work and Certificate of Compliance (CoC) details:

Name of Electrical worker(s): Yeti Martyn

Registration #: L25749C

FW121000

CoC details: Nationwired, 15796 Streetlight 112

CoC(s) attached

Certifying Electrical Work and CoC details:

What was inspected:

New Installation, New Streetlight with M.F.N. board, New Main Neutral bar and circuit protection, New Main Earthing System Bonding of Pole and cabinet door.

Specify the regulation(s) and companion standard(s), or identify the certified design, followed when carrying out the inspection:
AS/NZS 3000 part 2

What are the results of the inspection

Earthing and bonding visually OK,
continuity

M.F.C. imp < 5 Ohm

M.E.N. link.

FRPA #00583/3010

High Risk Category:

- Not to AS/NZS 3000 Part 2 - 6A(2)(a)(i) Protective system - 6A(2)(a)(iv) Electrical area - 6A(2)(a)(vi)
 High voltage installation - 6A(2)(a)(v) Hazardous area - 6A(2)(a)(vii) Mains work - 6A(2)(a)(viii)
 Mains parallel generation - 6A(2)(a)(iii) Animal stabling or meat conditioning - 6A(2)(a)(ix)
 Other - please describe

Declaration

I hereby confirm that the work described above has been done in accordance with the regulations and the regulations part installation on which the work has been done is, and will be, when energised, electrically safe.

(Note: Strike out or delete for inapplicable words highlighted in red above.)

Signature:

Date: 10/03/21



Electrical Workers Registration Board

1211 L St, Christchurch, New Zealand

Record of Inspection (ROI) of High-Risk Prescribed Electrical Work

(Extract to the Electricity (Safety) Regulations 2010)



Reference/Record Number:

Nationwired greenhill

Issuer (Inspector) details:

Name of Inspector: Gavin Boday

Registration #: 1250728

Email Address: gavin@bodayspark.co.nz

Telephone: 021 428 820

Location of Installation:

Location details: Greenhill park subdivision, Area M, Streetlight 13 stage 9-15

Location type: Domestic Non Domestic Accommodation Industrial Commercial
 Educational Healthcare Miscellaneous (other)

Certifying Electrical Work and Certificate of Compliance (CoC) details:

Name of Electrical worker(s): Yell Marilyn

Registration #: E257490

EW121000

CoC details: Nationwired 15795 Streetlight 13

CoC (s) attached

Certifying Electrical Work and CoC details:

What was inspected?

New installation, New Streetlight with M.E.N. board, New Main Neutral bar and circuit protection, New Main Earthing System Bonding of Pole and cabinet door

Specify the regulation(s) and comparison standard(s), or identify the certified design, followed when carrying out the inspection AS/NZS 3000 part 2

What are the results of the inspection

Earthing and bonding visual ok

polarity

M.F.C. imp = 5 Ohm

M.E.N. link: HIRPA #10683774V6S

High Risk Category:

- Not to AS/NZS 3000 Part 2 - GA(2)(a)(i) Photovoltaic system - EA(2)(a)(iv) Electrical medical area - GA(2)(a)(vi)
 High voltage installation - GA(2)(b)(ii) Hazardous area - GA(2)(b)(v) Mains work - GA(2)(c)
 Motor parallel generation - GA(2)(c)(ii) Animal stunning or meat conditioning - GA(2)(c)
 Other - please describe.

Declaration

I hereby confirm that the work described above has been done in accordance with the regulations and the installation on which the work has been done is, and will be, when completed, electrically safe.

(Note: Strike out or delete the words in bold which are highlighted in red above.)

Signature:

Date: 10/03/21



Electrical Workers Registration Board

100 Victoria Street, Auckland, New Zealand

Record of Inspection (ROI) of High-Risk Prescribed Electrical Work

(Pursuant to the Electricity (Safety) Regulations 2000)



Reference/Record Number:

Nat onwired greenhill

Issuer (Inspector) details:

Name of Inspector: Gavin Bodey

Registration #: 250720

Email Address: gavin@bodeyspark.co.nz

Telephone: 021 426 820

Location of Installation:

Location details: Greenhill park subdivision, Area M, Streetlight 114 stage 9-15

Location type: Domestic Non-Domestic Accommodation Industrial Commercial
 Educational Healthcare Miscellaneous (Other)

Certifying Electrical Work and Certificate of Compliance (CoC) details:

Name of Electrical worker(s): Yeli Marilyn

Registration #: E25/490

EW121000

CoC details: Nat onwired 16797 Streetlight 114

CoC(s) attached

Certifying Electrical Work and CoC details:

What was inspected:

New Installation. New Street light with M.E.N. tower. New Main Neutral bar and circuit protection, New Main Earthing System. Bonding of Pole and cabinet door.

Specify the regulation(s) and companion standard(s), or identify the certified design, followed when carrying out the inspection AS/NZS3000 part 2

What are the results of the inspection:

Earthing and bonding visual ok,

polarity

M.F.C. Imp < .5 Ohm

M.E.N. ok.

HRPA #0059375X45

High Risk Category:

- Not to AS/NZS 3000 Part 2 - 6A(2)(a)(i) Photovoltaic system - 6A(2)(a)(v) Electrical medical area - 6A(2)(a)(vi)
 High voltage installation - 6A(2)(a)(ii) Hazardous area - 6A(2)(a)(vii) Mains work - 6A(2)(b)
 Mains parallel generation - 6A(2)(a)(iii) Artificial stunning or meat tenderizing - 6A(2)(c)
 Other - please describe:

Declaration

I hereby confirm that the work described above has been done in accordance with the regulations, and the installation/part installation or which the work has been done is, and will be found to be when performed, electrically safe.

(Note: Strike out or delete the inapplicable items highlighted in red above.)

Signature:

Date: 10/03/21



Electrical Workers Registration Board

Electricity (Safety) Regulations 2010

Record of Inspection (ROI) of High-Risk Prescribed Electrical Work

(Pursuant to the Electricity (Safety) Regulations 2010)



Reference/Record Number:

Nationwired greenhill II

Issuer (Inspector) details

Name of Inspector: Gavin Hecoy

Registration #: 1250728

Email Address: gavin@bodeyspark.co.nz

Telephone: 021 428 820

Location of Installation:

Location details: Greenhill park subdivision, Area M, Streetlight 107stage 9-15

Location Type: Domestic Non-Domestic Accommodation Industrial Commercial
 Situational Healthcare Miscellaneous (other)

Certifying Electrical Work and Certificate of Compliance (CoC) details:

Name of Electrical worker(s): Yen Martyn

Registration #: E257490

EW121000

CoC details: Nationwired 15791 Streetlight 107

CoC(s) attached

Certifying Electrical Work and CoC details:

What was inspected:

New installation, New Streetlight with M.E.N. board. New Main Neutral bar and ground protection. New Main Earthing System. Banding of Pole and cabinet door

Specify the regulation(s) and comparison standard(s), or identify the certified design, followed when carrying out the inspection:
AS/NZS 3000 part 2

What are the results of the inspection:

Earthing and bonding visual ok.

polarity

M.E.C. imp < 5 Ohm

M.E.N. link IIRPA #0056853B7H

High Risk Category:

- Not to AS/NZS 3000 Part 2 - 6A(2)(a)(i) Photovoltaic system - 6A(2)(a)(iv) Hermetic electrical amp - 6A(2)(a)(v)
 High voltage installation - 6A(2)(a)(ii) Hazardous area - 6A(2)(a)(v) Mains work - 6A(2)(b)
 Mains parallel general on - 6A(2)(a)(iii) Animal stunning or meat conditioning - 6A(2)(c)
 Other - please describe

Declaration

I hereby confirm that the work described above has been done in / ~~will be~~ accordance with the regulations; and the ~~installation~~ / part installation on which the work has been done is and will be / ~~not be~~, when activated, electrically safe

(Note: Strike out or delete the inappropriate words highlighted in red above.)

Signature:

Date: 10/03/21



Electrical Workers Registration Board

10000-10000-10000-10000

Record of Inspection (ROI) of High-Risk Prescribed Electrical Work

(Pursuant to the Electricity (Safety) Regulations 2010)



Reference/Record Number:

Nationwired greenhill

Issuer (Inspector) details:

Name of Inspector: Gavin Bodey

Registration #: 1250728

Email Address: gavin@bodeyspark.co.nz

Telephone: 021 428 820

Location of Installation:

Location data is: Greenhill park subdivision, Area M, Streetlight 43 stage 2-15

Location type: Domestic Non-Domestic Accommodation Industrial Commercial
 Educational Healthcare Miscellaneous (other)

Certifying Electrical Work and Certificate of Compliance (CoC) details:

Name of Electrical worker(s): Yali Martyn

Registration #: E257450

EW121000

CoC details: Nationwired 15838

CoC(s) attached

Certifying Electrical Work and CoC details:

What was inspected:

New Installation New Streetlight with M E N board, New Main Neutral bar and circuit protection, New Van Earthing System Banding of Pole and cabinet door

Specify the regulation(s) and comparison standard(s), or identify the certified design, followed when carrying out the inspection:
AS/NZS 3000 part 2

What are the results of the inspection:

Earthing and bonding visual ok,

potenti

M.E.C. imp < 5 Ohm

M.E.N. link

HRPA #005334343

High Risk Category:

- Not to AS/NZS 3000 Part 2 – SA(2)(a)(i) Photovoltaic system – SA(2)(a)(iv) Electrical medical area – SA(2)(a)(vi)
- High voltage installation – SA(2)(a)(a) Hazardous area – SA(2)(a)(c) Mains work – SA(2)(b)
- Mains parallel generation – SA(2)(a)(ii) Animal stunning or meat conditioning – SA(2)(g)
- Other – please describe

Declaration

I hereby confirm that the work described above has been done in accordance with the regulations; and the installation / part installation on which the work has been done is and will be function, when energised, electrically safe.

(Note: Strike out or delete the inappropriate words highlighted in red above.)

Signature:

Date: 10/03/21



Electrical Workers Registration Board

100 Victoria Street, Auckland

Record of Inspection (ROI) of High-Risk Prescribed Electrical Work

(Pursuant to the Electricity (Safety) Regulations 2010)



Reference/Record Number:

Nationwired greenhill

Issuer (Inspector) details:

Name of Inspector: Gavin Rodley

Registration # 12510/28

Email Address: gavin@bodcyspark.co.nz

Telephone 021 428 820

Location of Installation:

Location details: Greenhill park subdivision, Area M, Street light 120 stage 9-15

Location Type: Domestic Non-Domestic Accommodation Industrial Commercial
 Educational Healthcare Miscellaneous (other)

Certifying Electrical Work and Certificate of Compliance (CoC) details:

Name of Electrical worker(s): Yeti Martyn

Registration # E257490

EW121030

CoC details: Nat owned 15839

CoC(s) attained

Certifying Electrical Work and CoC details:

What was inspected:

New Installation, New Streetlight with M.E.N. board, New Main Neutral bar and circuit protection, New Main Earthing System, Bonding of Pole and cabinet door.

Specify the regulation(s) and companion standard(s), or identify the certified design, followed when carrying out the inspection
AS/NZS3000 part 2

What are the results of the inspection:

Earthing and bonding visual ok.

polarity

M.E.C. imp < 5 Ohm

M.E.N. link.

HRPA #0058356F1Z

High Risk Category:

- Not to AS/NZS 3000 Part 2 – SA(2)(a)(i) Photovoltaic system – SA(2)(a)(iv) Electrical medical area – SA(2)(a)(vii)
 High voltage installation – SA(2)(a)(ii) Hazardous area – SA(2)(a)(i) Mains work – SA(2)(b)
 Mains parallel connection – SA(2)(a)(iii) Animal stunning or meat conditioning – SA(2)(c)
 Other – please describe:

Declaration

I hereby confirm that the work described above has been done in accordance with the regulations; and the installation/part installation on which the work has been done is, and will be, when energised, electrically safe.

(Note: Strike out or delete the inapplicable words highlighted in red above.)

Signature:

Date: 07/03/21



Electrical Workers Registration Board

100-100, The Esplanade, Manly, NSW 1585

Record of Inspection (ROI) of High-Risk Prescribed Electrical Work

(Pursuant to the Electricity (Safety) Regulations 2010)



Reference/Record Number:

Nationwired greenhill

Issuer (Inspector) details:

Name of Inspector: Gavin Boddy

Registration # E250728

Email Address: gavin@boddeyspark.co.nz

Telephone: 021 428 820

Location of Installation:

Location details: Greenhill park subdivision, Area M, Streetlight 108 stage 9-15

Location Type: Domestic Non-Domestic Accommodation Industrial Commercial
 Educational Healthcare Miscellaneous (other)

Certifying Electrical Work and Certificate of Compliance (CoC) details:

Name of Electrical worker(s): Yehi Martyn

Registration # E257480

EW121000

CoC details: Nationwired: 158510

CoC(s) attached

Certifying Electrical Work and CoC details:

What was inspected:

New Installation, New Streetlight with M.E.N. board, New Main Neutral bar and circuit protection, New Main Earthing System Bonding of Pole and cabinet door

Specify the regulation(s) and companion standard(s), or identify the certified design, followed when carrying out the inspection
AS/NZS 3000 part 2

What are the results of the inspection:

Earthing and bonding visual ok.

polarity

M.F.C. imp < 5 Ohm

M.E.N. ins.: URPA 4005805607T

High Risk Category:

- Not to AS/NZS 3000 Part 2 - 6A(2)(a)(i) Proscenium system - 6A(2)(a)(ii) Electrical medical area - 6A(2)(a)(iv)
 High voltage installation - 6A(2)(a)(i) Hazardous area - 6A(2)(a)(ii) Handwork - 6A(2)(i)
 Mains parallel generation - 6A(2)(a)(iii) Animal stunning or meat conditioning - 6A(2)(e)
 Other - please describe

Declaration

I hereby confirm that the work described above has been done in accordance with the regulations, and the modification/parts installation on which the work has been done is, and will be, when delivered, electrically safe

(Note: Strike out or delete the inappropriate words highlighted in red above.)

Signature:

Date: 10/03/21



Electrical Workers Registration Board

100-1000, 100-1000, 100-1000

Record of Inspection (ROI) of High-Risk Prescribed Electrical Work

(Pursuant to the Electricity (Safety) Regulations 2010)



Reference/Record Number:

Natonwired greenhill

Issuer (Inspector) details:

Name of Inspector: Gavin Bodey

Registration #: 1250728

Email Address: gavin@bcdeyapark.co.nz

Telephone: 021 429 820

Location of Installation:

Location details: Greenhill park subdivision, Area M, Streetlight 122 stage 3-5

Location type: Domestic Non-Domestic Accommodation Industrial Commercial
 Educational Healthcare Miscellaneous (other)

Certifying Electrical Work and Certificate of Compliance (CoC) details:

Name of Electrical worker(s): Yell Marilyn

Registration #: E257490

EW121000

CoC details: Natonwired 157314 Streetlight 122

CoC(s) attached

Certifying Electrical Work and CoC details:

What was inspected:

New Installation, New Streetlight with M.E.N. board. New Main Neutral bar and circuit protection, New Main Earthing System. Bonding of Pole and cabinet door.

Specify the regulation(s) and companion standard(s), or identify the certified design, followed when carrying out the inspection:
AS/NZS3000 part 2

What are the results of the inspection:

Earthing and bonding visual ok.

polarity

M.E.C. Imp < 5 Ohm

M.E.N. link..

HRPA #0068393290

High Risk Category:

- Not to AS/NZS 3000 Part 2 - 6A(2)(a)(i) Photovoltaic system - 6A(7)(a)(iv) Electrical overhead area - 6A(2)(a)(vi)
 High voltage installation - 6A(2)(a)(ii) Hazardous area - 6A(2)(a)(v) Fault work - 4A(2)(1)
 Main parallel generation - 6A(2)(a)(iii) Animal stunning or meat conditioning - 6A(2)(i)
 Other - please describe.

Declaration

I hereby confirm that the work described above has been done in ~~full~~ accordance with the regulations, and the installation/part installation on which this work has been done is, and will be ~~safe~~, when completed, electrically safe.

(Note: Strike out or delete the inappropriate words highlighted in red above.)

Signature:

Date: 30/03/21



Electrical Workers Registration Board

www.electricalworkers.co.nz

Record of Inspection (ROI) of High-Risk Prescribed Electrical Work

IPU/50001 to the Electricity (Safety) Regulations 2011



Reference/Record Number:

Nationwired greenhill

Issuer (Inspector) details:

Name of Inspector: Gavin Bodey

Registration #: 1250728

Email Address: gavin@bodeyspark.co.nz

Telephone: 021 428 820

Location of installation:

Location details: Greenhill park subdivision, Area M, Streetlight 115 stage 8-15

Location Type: Domestic Non-Domestic Accommodation Industrial Commercial
 Educational Healthcare Miscellaneous (other)

Certifying Electrical Work and Certificate of Compliance (CoC) details:

Name of Electrical worker(s): Yola Marilyn

Registration #: E257490

EW0121000

CoC details: Nat or wired 15790 Streetlight 115

CoC(s) attached

Certifying Electrical Work and CoC details:

What was inspected:

New Installation. New Streetlight with M.E.N. board, New Main Neutral bar and ground protection, New Main Earthing System, Banding of Pole and cabinet door

Specify the regulation(s) and companion standard(s), or identify the certified design, followed when carrying out the inspection:
AS/NZS3000 part 2

What are the results of the inspection?

Earthing and bonding visual ok,
polarity
M.E.C. imp < 5 Ohm
M.E.N. link IIRPA #006837024X

High Risk Category:

Not to AS/NZS 3000 Part 2 - CA(2)(a)(i) Photovoltaic system - SA(2)(g)(vi) Federal medical area - CA(2)(b)(vi)
 High voltage installation - EA(2)(b)(iv) Hazardous area - SA(2)(a)(c) Pairs work - CA(2)(h)
 Main's parallel generation - SA(2)(b)(iii) Animal stunning or meat conditioning - SA(2)(i)
 Other - please describe

Declaration

I hereby confirm that the work described above has been done in ~~full~~ accordance with the regulations, and the ~~installation~~ part installation on which the work has been done is, and will be, when energised, electrically safe.

(Note: Strike out or delete the inappropriate words highlighted in red above.)

Signature:

Date: 10/03/21



Electrical Workers Registration Board

100-100, Victoria Road, Auckland

Record of Inspection (ROI) of High-Risk Prescribed Electrical Work

(Pursuant to the Electricity (Safety) Regulations 2010)



Reference/Record Number:

Nationwired Greenhill II

Issuer (Inspector) details

Name of Inspector: Garvin Bodey

Registration #: 1250728

Email Address: gavin@bodeyspark.co.nz

Telephone: 021 428 820

Location of Installation:

Location details: Greenhill park subdivision, Area M, Streetlight 116 stage 9-15

Location Type: Domestic Non-Domestic Accommodation Industrial Commercial
 Educational Healthcare Miscellaneous (other)

Certifying Electrical Work and Certificate of Compliance (CoC) details:

Name of Electrical worker(s): Yesi Martyn

Registration #: E:257480

FW121000

CoC details: Nationwired 15759 Greenlight 116

CoC(s) attached

Certifying Electrical Work and CoC details:

What was inspected:

New Installation, New Streetlight with M.E.N. board. New Main Neutral bar and circuit protection. New Main Earthing System. Bonding of Pole and cabinet door

Specify the regulation(s) and companion standard(s), or identify the certified design, followed when carrying out the inspection:
AS/NZS 3000 part 2

What are the results of the inspection:

Earthing and bonding visual ok,

polarity

M.E.C. imp < 5 Ohm

M.E.N. link

HRPA #005957726K

High Risk Category:

Not to AS/NZS 3000 Part 2 – SA(2)(h)(i)

Photovoltaic system – SA(2)(g)(iv)

Partial medical area – SA(2)(b)(4)

High voltage installation – SA(2)(a)(ii)

Hazardous area – SA(2)(c)(v)

Mans work – SA(2)(n)

Mains parallel generation – SA(2)(b)(ii)

Animal stunning or meat conditioning – SA(2)(c)

Other – please describe: _____

Declaration

I hereby confirm that the work described above has been done in full accordance with the regulations; and the work/area/part installation on which the work has been done is, and will be safe, when delivered, electrically safe.

(Note: Strike out or delete the inapplicable words highlighted in red above.)

Signature: _____

Date: 10/03/21



Electrical Workers Registration Board

Electrical Workers Registration Board

Record of Inspection (ROI) of High-Risk Prescribed Electrical Work

(Pursuant to the Electricity (Safety) Regulations 2001)



Reference/Record Number:

Nationwired greenhill

Issuer (Inspector) details:

Name of Inspector: Gavin Bodey

Registration #: F250728

Email Address: gavin@bodeyspark.co.nz

Telephone: 021 428 820

Location of installation:

Location details: Greenhill park subdivision, Area M, Streetlight 117 stage 9-15

Location Type: Domestic Non-Domestic Accommodation Industrial Commercial
 Educational Healthcare Miscellaneous (other)

Certifying Electrical Work and Certificate of Compliance (CoC) details:

Name of Electrical worker(s): Yoni Martyn

Registration #: F257493

EW121000

CoC details: Nationwired 15799 Streetlight 117

CoC(s) attached

Certifying Electrical Work and CoC details:

What was inspected:

New Installation, New Streetlight with M.E.N. board, New Main Neutral bar and circuit protection, New M.E.N. Earthing System Bonding of Pole and cabinet door.

Specify the regulation(s) and comparison standard(s), or identify the certified design, followed when carrying out the inspection:
AS/NZS3000 part 2

What are the results of the inspection:

Earthing and bonding visual ok,

polarity

M.E.C. Imp < 0.1m

M.E.N. link

HRPA #005837GH8C

High Risk Category:

- Not to AS/NZS 3000 Part 2 - 6A(2)(a)(i) Photovoltaic system - 6A(2)(a)(iv) Electrical medical area - 6A(2)(a)(v)
 High voltage installation - 6A(2)(a)(i) Hazardous area - 6A(2)(a)(ii) Mains work - 6A(2)(b)
 Mains parallel generation - 6A(2)(a)(iii) Ancillary stuffing or media conditioning - 6A(2)(c)
 Other - please describe:

Declaration

I hereby confirm that the work described above has been done in / ~~has~~ accordance with the regulations; and the ~~installation~~ / part installation on which the work has been done is, and will be / ~~is~~, when energised, electrically safe.

(Note: Strike out or delete the name of cable work highlighted in red above.)

Signature:

Date: 10/03/21



Electrical Workers Registration Board

100 Victoria Street, Auckland

Record of Inspection (ROI) of High-Risk Prescribed Electrical Work

(Pursuant to the Electricity (Safety) Regulations 2010)



Reference/Record Number:

Nationwired greenhill

Issuer (Inspector) details

Name of Inspector: Gavin Bodey

Registration # 1250728

Email Address gavin@bodeyspark.co.nz

Telephone: 021 428 820

Location of Installation:

Location details Greenhill park subdivision, Area M, Streetlight 113 stage 0-15

Location Type: Domestic Non-Domestic Accommodation Industrial Commercial
 Educational Healthcare Miscellaneous (other)

Certifying Electrical Work and Certificate of Compliance (CoC) details:

Name of Electrical worker(s) Yogi Martyn

Registration # E257480

EW121000

CoC details: Nationwired 157915 Streetlight 116

CoC(s) attached

Certifying Electrical Work and CoC details:

What was inspected

New Installation: New Streetlight with M.E.N. board, New Main Neutral bar and circuit protection, New Main Earthing System Bonding of Pole and cabinet door

Specify the regulation(s) and companion standard(s), or identify the certified design, followed when carrying out the inspection:

AS/NZS3000 part 2

What are the results of the inspection:

Earthing and bonding visual ok,

polarity

M.E.C. Imp < 5 Ohm

M.E.N. link

IRPA 40050382F4F

High Risk Category:

- Not to AS/NZS 3000 Part 2 - 6A(2)(a)(i) Photovoltaic system - 6A(2)(a)(iv) Electrical medical area - 6A(2)(a)(v)
 High voltage installation - 6A(2)(a)(ii) Hazardous area - 6A(2)(a)(iii) Mains work - 6A(2)(b)
 Main parallel generation - 6A(2)(a)(ii) Arma. stunning or meat conditioning - 6A(2)(c)
 Other - please describe: _____

Declaration

I hereby confirm that the work described above has been done in accordance with the regulations, and the ~~regulation~~ part installation on which the work has been done is, and will be ~~correct~~, when anticipated, electrically safe

(Note: Strike out or delete the inapplicable words highlighted in red above.)

Signature:

Date: 10/03/21



Electrical Workers Registration Board

100-1000, The Arcade, Auckland

Record of Inspection (ROI) of High-Risk Prescribed Electrical Work

(Pursuant to the Electricity (Safety) Regulations 2010)



Reference/Record Number:

Nationwired greenhill

Issuer (Inspector) details:

Name of Inspector: Gavin Bodey

Registration #: 1250726

Email Address: gavin@bodeyspark.co.nz

Telephone: 021 428 820

Location of Installation:

Location details: Greenhill park subdivision, Area M, Streetlight 119 stage 9-15

Location Type: Domestic Non-Domestic Accommodation Industrial Commercial
 Institutional Healthcare Miscellaneous (other)

Certifying Electrical Work and Certificate of Compliance (CoC) details:

Name of Electrical worker(s): Yeli Martyn

Registration #: E257450

CoC details: Nationwired 157912 Streetlight 119

EW121000

CoC(s) attached

Certifying Electrical Work and CoC details:

What was inspected:

New Installation, New Streetlight with M.E.N. board, New Main Neutral bar and circuit protection, New Main Earthing System, Bonding of Pole and cabinet door.

Specify the regulation(s) and companion standard(s), or identify the certified design, followed when carrying out the inspection:
AS/NZS3000 part 2

What are the results of the inspection:

Earthing and bonding visual ok,

polarity

M.E.C. Imp < 5 Ohm

M.E.N. link: FRIPA #0358335XCN

High Risk Category:

- Not to AS/NZS 3000 Part 2 – 6A(2)(a)(i) Photo-optic systems – 6A(2)(a)(iv) Electrical medical area – 6A(2)(a)(v)
- High voltage installation – 6A(2)(a)(ii) Hazardous area – 6A(2)(a)(v) Mains work – 6A(2)(b)
- Mains parallel generation – 6A(2)(a)(iii) Animal stunning or meat conditioning – 6A(2)(c)
- Other please describe: _____

Declaration

I hereby confirm that the work described above has been done in full and in accordance with the regulations, and the installation/part installation on which the work has been done is, and will be, safe, when re-energised electrically safe.

(Note: Strike out or delete the words in this form which are highlighted in red above.)

Signature: _____

Date: 10/03/21

F3.10 RAMM STREETLIGHT DATA

(to be completed for each change in streetlight type)

Subdivision and stage/Contract GREENHILL PARK AREA M STAGE 13

Number of street lights of this type 6

General

Date Installed 10/3/21

Control Type Network Streetlight Feed / Photocell / Other:

Origin of Power Supply Streetlight Circuit Metered Power Supply

Light

Manufacturer VIZULO

Model MINI STORK

Total Power Consumption (W) 2 x 58.1 = 116.2W

Light Height (m) 10

Tilt Angle (° Degrees) 0°

Outreach

Outreach Type Curved / Mitre / Other Decorative:

Outreach Distance (m) 2m

Pole

Manufacturer CSP

Type Octagonal / Circular / Power / Other Decorative:

Pole Height (m) 10m

Material Galvanised Steel / Steel / Other:

Coating N/A / Painted / Powder Coated

Colour (if coated) BLACK

Mounting Frangible ground plant / Shear Base

- Manufacturer's Warranty documents for Poles, Lights and Coatings attached.
- Shown on as-built drawings.

F3.10 RAMM STREETLIGHT DATA

(to be completed for each change in streetlight type)

Subdivision and stage/Contract GREENHILL PARK AREA M STAGE 13

Number of street lights of this type 4

General

Date Installed 10/3/21

Control Type Network Streetlight Feed / Photocell / Other:

Origin of Power Supply Streetlight Circuit Metered Power Supply

Light

Manufacturer VIZULO

Model MINI STORK

Total Power Consumption (W) 84 W

Light Height (m) 10m

Tilt Angle (° Degrees) 0°

Outreach

Outreach Type Curved / Mitre / Other Decorative:

Outreach Distance (m) 2m

Pole

Manufacturer CSP

Type Octagonal / Circular / Power / Other Decorative:

Pole Height (m) 10m

Material Galvanised Steel / Steel / Other:

Coating N/A / Painted / Powder Coated

Colour (if coated) BLACK

Mounting Frangible ground plant / Shear Base

- Manufacturer's Warranty documents for Poles, Lights and Coatings attached.
- Shown on as-built drawings.

F3.10 RAMM STREETLIGHT DATA

(to be completed for each change in streetlight type)

Subdivision and stage/Contract GREENHILL PARK AREA M STAGE 13

Number of street lights of this type 4

General

Date Installed 10/3/21

Control Type Network Streetlight Feed / Photocell / Other:

Origin of Power Supply Streetlight Circuit Metered Power Supply

Light

Manufacturer VIZULO

Model MINI STORK

Total Power Consumption (W) 77.5W

Light Height (m) 10

Tilt Angle (° Degrees) 0°

Outreach

Outreach Type Curved / Mitre / Other Decorative:

Outreach Distance (m) 2m

Pole

Manufacturer CSP

Type Octagonal / Circular / Power / Other Decorative:

Pole Height (m) 10m

Material Galvanised Steel / Steel / Other:

Coating N/A Painted Powder Coated

Colour (if coated) BLACK

Mounting Frangible ground plant / Shear Base

- Manufacturer's Warranty documents for Poles, Lights and Coatings attached.
- Shown on as-built drawings.

F3.10 RAMM STREETLIGHT DATA

(to be completed for each change in streetlight type)

Subdivision and stage/Contract GREENHILL PARK AREA M STAGE 13

Number of street lights of this type 2

General

Date Installed 10 / 3 / 21

Control Type Network Streetlight Feed / Photocell / Other:

Origin of Power Supply Streetlight Circuit / Metered Power Supply

Light

Manufacturer VIZULO

Model MINI STORK

Total Power Consumption (W) $131.7 \times 2 = 263.4 W$

Light Height (m) 10m

Tilt Angle (° Degrees) 0°

Outreach

Outreach Type Curved / Mitre / Other Decorative:

Outreach Distance (m) 2m

Pole

Manufacturer CSP

Type Octagonal / Circular / Power / Other Decorative:

Pole Height (m) 10m

Material Galvanised Steel / Steel / Other:

Coating N/A / Painted / Powder Coated

Colour (if coated) BLACK

Mounting Frangible ground plant / Shear Base

- Manufacturer's Warranty documents for Poles, Lights and Coatings attached.
- Shown on as-built drawings.

F3.10 RAMM STREETLIGHT DATA

(to be completed for each change in streetlight type)

Subdivision and stage/Contract GREENHILL PARK AREA M STAGE 13

Number of street lights of this type 2

General

Date Installed 10 / 3 / 21

Control Type Network Streetlight Feed / Photocell / Other:

Origin of Power Supply Streetlight Circuit / Metered Power Supply

Light

Manufacturer VIZULO

Model MINI STORK

Total Power Consumption (W) 77.2W

Light Height (m) 8m

Tilt Angle (° Degrees) 0°

Outreach

Outreach Type Curved / Mitre / Other Decorative: MILFORD

Outreach Distance (m) 1m

Pole

Manufacturer IBEX LIGHTING

Type Octagonal Circular Power / Other Decorative:

Pole Height (m) 8m

Material Galvanised Steel Steel / Other:

Coating N/A Painted Powder Coated

Colour (if coated) BLACK

Mounting Frangible ground plant / Shear Base

- Manufacturer's Warranty documents for Poles, Lights and Coatings attached
- Shown on as-built drawings

APPENDIX 8

Miscellaneous Check Lists and Producer Statements

- Subdivision Works Clearance Application Form
- Subdivision Certification Application Form
- Contractor Producer Statement Form
- Land Transfer Plan LT 558430
- Schedule of Engineering Value
- Developers Tax Invoice
- Consultant Certification Statement Form
- Asbuilt Statement Form



Subdivision Works Clearance Application Form

Agent details (where an agent is applying on behalf of the consent holder)

Agent name:	<input type="text"/>
Agent company:	<input type="text"/>
Postal address:	<input type="text"/>
Telephone:	<input type="text"/>
Email:	<input type="text"/>

Subject Site

Site address:	<input type="text"/>		
Legal description:	<input type="text"/>		
Resource consent number:	<input type="text"/>	Date consent issued:	<input type="text"/>
Stage (if applicable):	<input type="text"/>	No. of lots (excluding roads/reserves):	<input type="text"/>

Clearances required

Certification required: Engineering Landscaping Other (please specify)

Fees and payment

You will be charged for the time spent by staff in preparing for and undertaking engineering works clearance site visits. Refer to Fees and Charges, as set out on our website at www.hamilton.govt.nz for costs.

Payment of fees is due upon invoice which will be issued at s224c subdivision certification stage.

Agent declaration

As a registered professional surveyor/planner, I confirm that:

- I am satisfied that the engineering and landscaping physical works have been completed in accordance with the Resource Consent
- I accept that my application may be returned if there are outstanding agreements relating to development contribution remissions or valuation of land, or if all information required for works clearance is not submitted

Send

Send applications to subdivision@hcc.govt.nz, drop off via the duty planner at the Municipal Building Garden Place, between 8am – 4.45pm, Monday to Friday or post to Planning Guidance Subdivisions, Hamilton City Council, Private Bag 3010, Hamilton 3240.

Documentation to provide:

- The attached checklist
- All required information listed in the checklist

OFFICE USE ONLY

Documentation saved to TRIM

Authority updated

Acknowledgement sent

Planning Guidance

Hamilton City Council
Phone: 07 838 6699

Questions?

For general planning guidance enquiries, contact the duty planner
weekdays 8am – 4.45pm Email: planning.guidance@hcc.govt.nz

Works Clearance Checklist

PART A - QA DOCUMENTATION:

a. General

	Received	Date
Easements required		
Consent notices required		
Power, telecommunication, gas connections certification		
Contractor Certificate		
Producer Statement		

b. Parks

Landscaping Plans Accepted Date:

	Approved by	Date
Final Inspection Checklist		

c. Roading

Engineering Plans Accepted Date:

	Approved by	Date
Subgrade Compaction/Relative Height		
Subbase Compaction/Relative Height		
Basecourse Compaction/Relative Height		
Penetrometer Results		
Clegg Hammer Results		
Benkelman Beam Results		

d. Stormwater

Engineering Plans Accepted Date:

	Approved By	Date
Wetlands and Ponds Management Checklist		
Wetlands and Ponds Inspection Checklist		
Pipe Laying Checklist		
Manhole Checklist		
Trench Backfill Compaction Test		
Catchpit Checklist		
Final Inspection Checklist		
Stormwater device Operations and Maintenance Manual supplied		

e. Wastewater

Engineering Plans Accepted

Date:

	Approved By	Date
Pipe Laying Checklist		
Manhole Checklist		
Trench Backfill Compaction Test		
Final Inspection Pipe Network		
Pumping Station Check Forms		
Pressure Test Results		

f. Water

Engineering Plans Accepted

Date:

Form/Process	Approved By	Date
Pipe Laying Checklist		
Final Inspection Checklist		
Pressure Test Results		
Bacteriological Test Results		

PART B - ASBUILT DATA:

a. Roading

Data	Received	Checked
RAMM data		
Streetlight Data		
Asbuilt Plans		
DXF Files		

b. Stormwater

Data	Received	Checked
Datasheets		
Asbuilt Plans		
DXF Files		

c. Wastewater

Data	Received	Checked
Datasheets		
Asbuilt Plans		
DXF Files		

d. Water

Data	Received	Checked
Datasheets		
Asbuilt Plans		
DXF Files		

e. Parks

Data	Received	Checked
Datasheets		
Asbuilt Plans		
DXF Files		

f. Finance

Data	Received	Checked
GST Values		
Land Values		
Asset Quantities		

PART C – CONDITIONS/BONDS:

Documentation	Received	Checked
Engineering conditions attached and completed		
Bond requested and quote attached		

Subdivision Certification Application Form

Agent details (where an agent is applying on behalf of the consent holder)

Agent name:

Agent company:

Postal address:

Telephone:

Email:

Preferred means of contact: Mail Email Phone

Consent holder name

Consent holder name:

Postal address:

Telephone:

Email:

Debtor details (for invoicing)

Debtor is: Agent Owner Other (please specify)

Debtor's Name:

Postal address:

Subject Site

Site address:

Legal description:

Resource consent number: Stage Number:

Certification required

Certification required: s223 s224(c) s224(f) s32(2)(a)

Other (please specify)

Condition(s) of consent requirements

As a registered professional surveyor/planner, I confirm that:

1. For larger/complex consents, I have attended a pre-application meeting with Hamilton City Council staff to review my draft s224c application.
2. I hereby attach all information required to satisfy Hamilton City Council that all conditions specified in the subdivision consent referenced above (in terms of certification required) have been met.
3. I accept that where it is found that not all information required under clause 2 above is provided, this application shall be returned to the address for re-lodgement.
4. Where an engineering or similar professionally prepared plan and supporting information (such as landscaping or ecological plan) has to be approved by council, I have attached written evidence of such approval.
5. Where evidence of completion and approval of all physical works is required (e.g. construction of services, landscape planting). I have attached written evidence of such approval.
6. The required Landonline electronic certification documentation have been prepared and submitted to Hamilton City Council for approval.

Acceptance

I confirm that all of the above have been satisfied.

Name:

Date:

Send

Send applications to subdivision@hcc.govt.nz, drop off via the duty planner at the Municipal Building Garden Place, between 8am – 4.45pm, Monday to Friday or post to **Planning Guidance Subdivisions, Hamilton City Council, Private Bag 3010, Hamilton 3240.**

Remember to attach:

- Conditions of subdivision consent documentation
- Works clearance certificate

SCHEDULE 6 – FORM OF PRODUCER STATEMENT - CONSTRUCTION

ISSUED BY	ONLINE CONTRACTORS 2016 LTD
TO	CHEDWORTH PROPERTIES LTD
IN RESPECT OF	GREENHILL PARK STAGE 13 INCLUDING: SUBDIVISION CIVIL WORKS, ROADING AND EARTHWORKS
AT	GREENHILL PARK, HAMILTON

ONLINE CONTRACTORS 2016 LTD has contracted to *CHEDWORTH PROPERTIES LTD* to carry out and complete certain building works in accordance with a Contract titled *GREENHILL PARK STAGE 13*.

I Daniel Hopper a duly authorised representative of *ONLINE CONTRACTORS 2016 LTD* believe on reasonable grounds that *ONLINE CONTRACTORS 2016 LTD* as carried out and completed:

All

Part only as specified in the attached particulars of the contract works in accordance with the Contract.

Dan Hopper

8th March 2021

Signature of Authorised Agent on behalf of

Date

ONLINE CONTRACTORS 2016 LTD
PO BOX 21187
ROTOTUNA
HAMILTON 3256

Hamilton City Development Manual	
Volume 4 : Quality Systems for Land Development	Part 9 — Appendices
Authorised by : Design Services Manager	

APPENDIX 4 ii)

PRODUCER STATEMENT — CONSTRUCTION

CONTRACTOR’S CERTIFICATE UPON COMPLETION OF SUBDIVISIONAL WORK

ISSUED BY : Online Contractors 2016 Ltd

 (Contractor)

TO : Chedworth Properties Ltd

 (Principal)

TO BE SUPPLIED TO: Hamilton City Council

 (Territorial Authority)

IN RESPECT OF : Greenhill Park Stage 13

 (Description of subdivisional work)

AT : Gosset Ave and Couldsack Ave, Greenhill Park

 (Address)

Online Contractors 2016 Ltd has contracted to Chedworth Properties Ltd
 (Contractor) (Principal)
 to carry out and complete certain subdivisional work in accordance with a contract, titled Contract No.
 for Earthworks and subdivision civil works ("the contract")

I Dan Hopper a duly authorised representative of Online Contractors 2016 Ltd
 (Duly Authorised Agent) (Contractor)

hereby certify that Online Contractors 2016 Ltd
 has carried out and completed the subdivisional works, other than those outstanding works listed below, in accordance with the contract.

Dan Hopper Date 8th March 2021
 (Signature of Authorised Agent on behalf of)

Online Contractors 2016 Ltd

 (Contractor)

PO Box 21187, Rototuna, Hamilton

 (Address)

Outstanding Works

- road signs installation at the Webb Drive/Carrs Rd roundabout
- Tactile paver installation
-
-



Title Plan - LT 558430

Survey Number LT 558430
Surveyor Reference 218/9 - Greenhill Park - Stage 13
Surveyor Scott Rodney Carley
Survey Firm Shrimpton and Lipinski Limited Partnership
Surveyor Declaration

Survey Details

Dataset Description Lots 357-374, 504, 602, 603 and 706 Being a Subdivision of Lot 705 DP 546658
Status Initiated
Land District South Auckland
Submitted Date
Survey Class Class-A
Survey Approval Date
Deposit Date

Territorial Authorities

Hamilton City

Comprised In

RT 940132

Created Parcels

Parcels	Parcel Intent	Area	RT Reference
Lot 357 Deposited Plan 558430	Fee Simple Title	0.0416 Ha	980784
Lot 358 Deposited Plan 558430	Fee Simple Title	0.0418 Ha	980785
Lot 359 Deposited Plan 558430	Fee Simple Title	0.0417 Ha	980786
Lot 360 Deposited Plan 558430	Fee Simple Title	0.0417 Ha	980787
Lot 361 Deposited Plan 558430	Fee Simple Title	0.0461 Ha	980788
Lot 362 Deposited Plan 558430	Fee Simple Title	0.0415 Ha	980789
Lot 363 Deposited Plan 558430	Fee Simple Title	0.0319 Ha	980790
Lot 364 Deposited Plan 558430	Fee Simple Title	0.0390 Ha	980791
Lot 365 Deposited Plan 558430	Fee Simple Title	0.0398 Ha	980792
Lot 366 Deposited Plan 558430	Fee Simple Title	0.0457 Ha	980793
Lot 367 Deposited Plan 558430	Fee Simple Title	0.0402 Ha	980794
Lot 368 Deposited Plan 558430	Fee Simple Title	0.0450 Ha	980795
Lot 369 Deposited Plan 558430	Fee Simple Title	0.0450 Ha	980796
Lot 370 Deposited Plan 558430	Fee Simple Title	0.0462 Ha	980797
Lot 371 Deposited Plan 558430	Fee Simple Title	0.0452 Ha	980798
Lot 372 Deposited Plan 558430	Fee Simple Title	0.0486 Ha	980799
Lot 373 Deposited Plan 558430	Fee Simple Title	0.0454 Ha	980800
Lot 374 Deposited Plan 558430	Fee Simple Title	0.0435 Ha	980801
Lot 501 Deposited Plan 558430	Vesting on Deposit for Local Purpose Reserve	0.1341 Ha	980802
Lot 602 Deposited Plan 558430	Vesting on Deposit for Road	1.1066 Ha	
Lot 603 Deposited Plan 558430	Vesting on Deposit for Road	0.6422 Ha	



Title Plan - LT 558430

Created Parcels

Parcels	Parcel Intent	Area	KT Reference
Lot 706 Deposited Plan 558430	Fee Simple Title	1 973 011i	980803
Area A Deposited Plan 558430	Leasement		
Total Area		<hr/> 5 596 111i	



S&L
Land Development
and Design Specialists

S&L File: 21879 Stage 13

Land Registration District

South Auckland

Plan Number

DP 558430

Territorial Authority (the Council)


Hamilton City Council

Memorandum of Easements in Gross

Purpose	Shown	Burdened Land	Grantee
Right to Convey Electricity Telecommunications	A	Lot 504	WEL Network Limited




Diag. AC

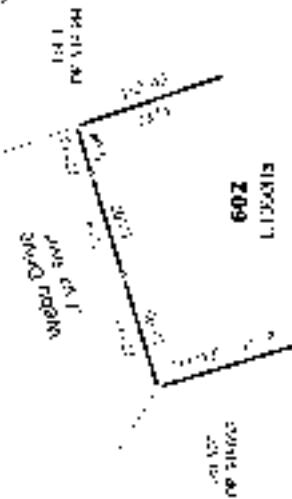

602
LT 558415

Lot 1
CP 53-384

Diag. A

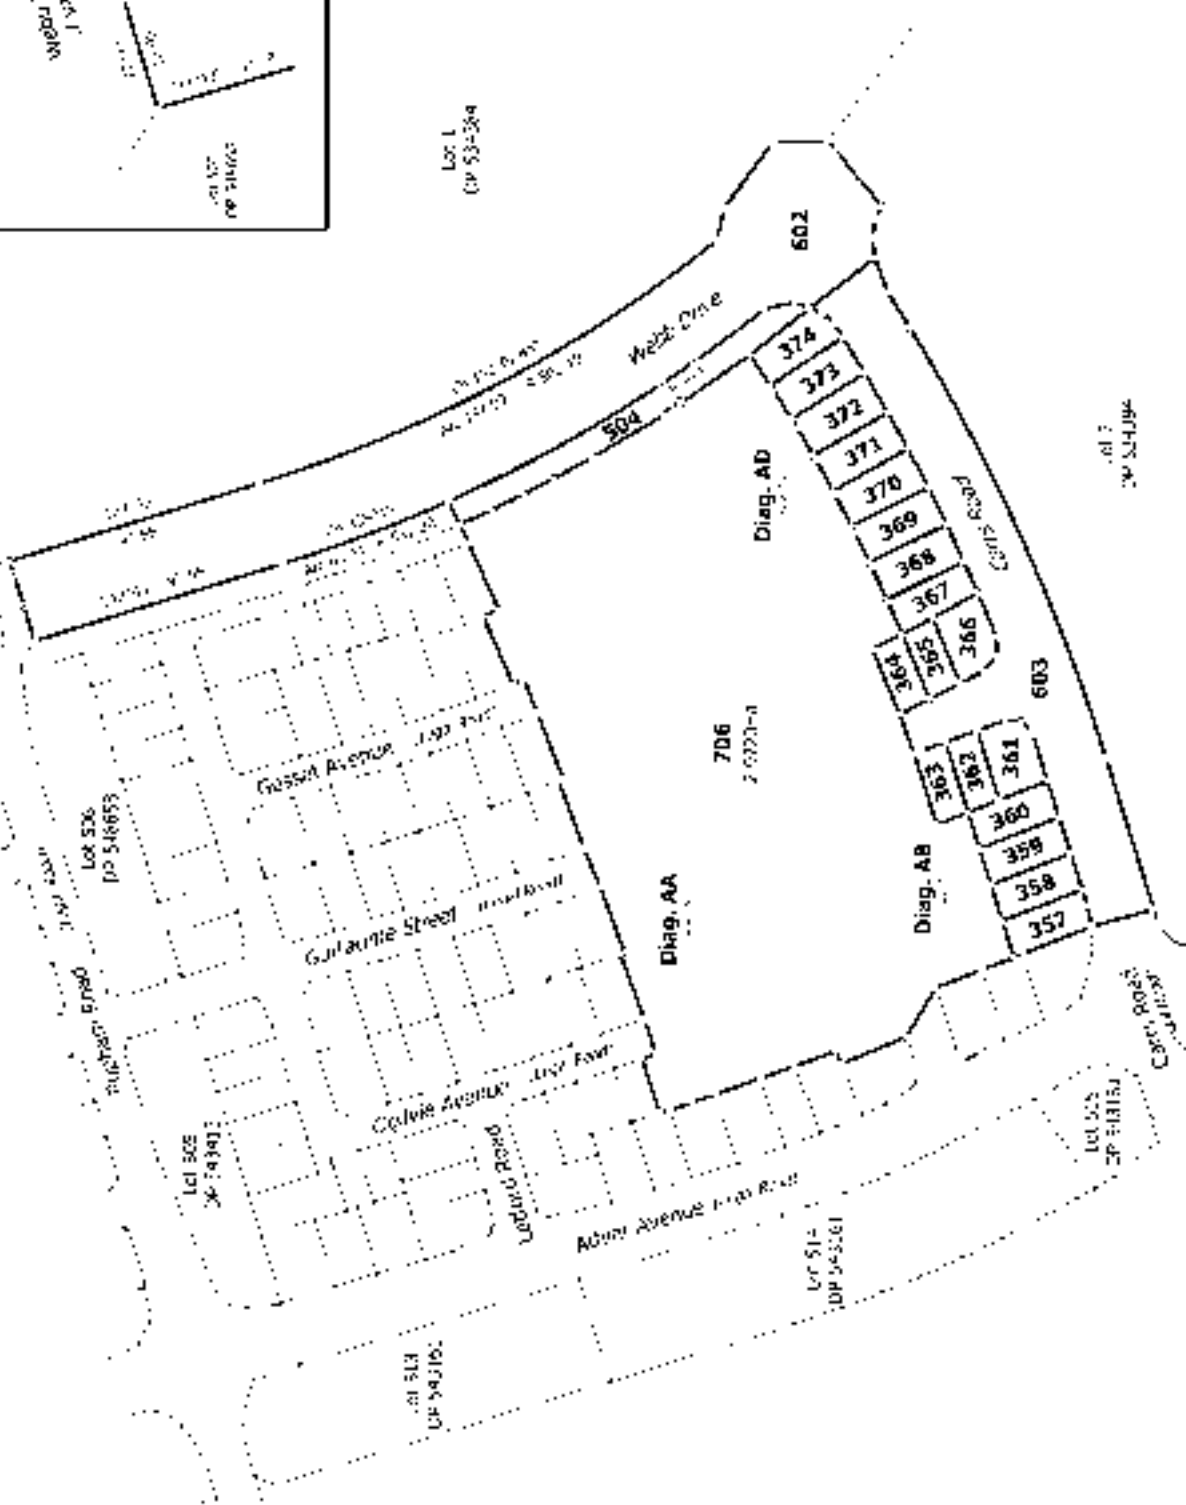

Diag. AD

Diag. AA

Diag. AB

Diag. AC

602

706

603

Lot 513
CP 54176


Lot 514
DP 54361

Lot 525
CP 54175

Lot 7
CP 54194



Diag. AB

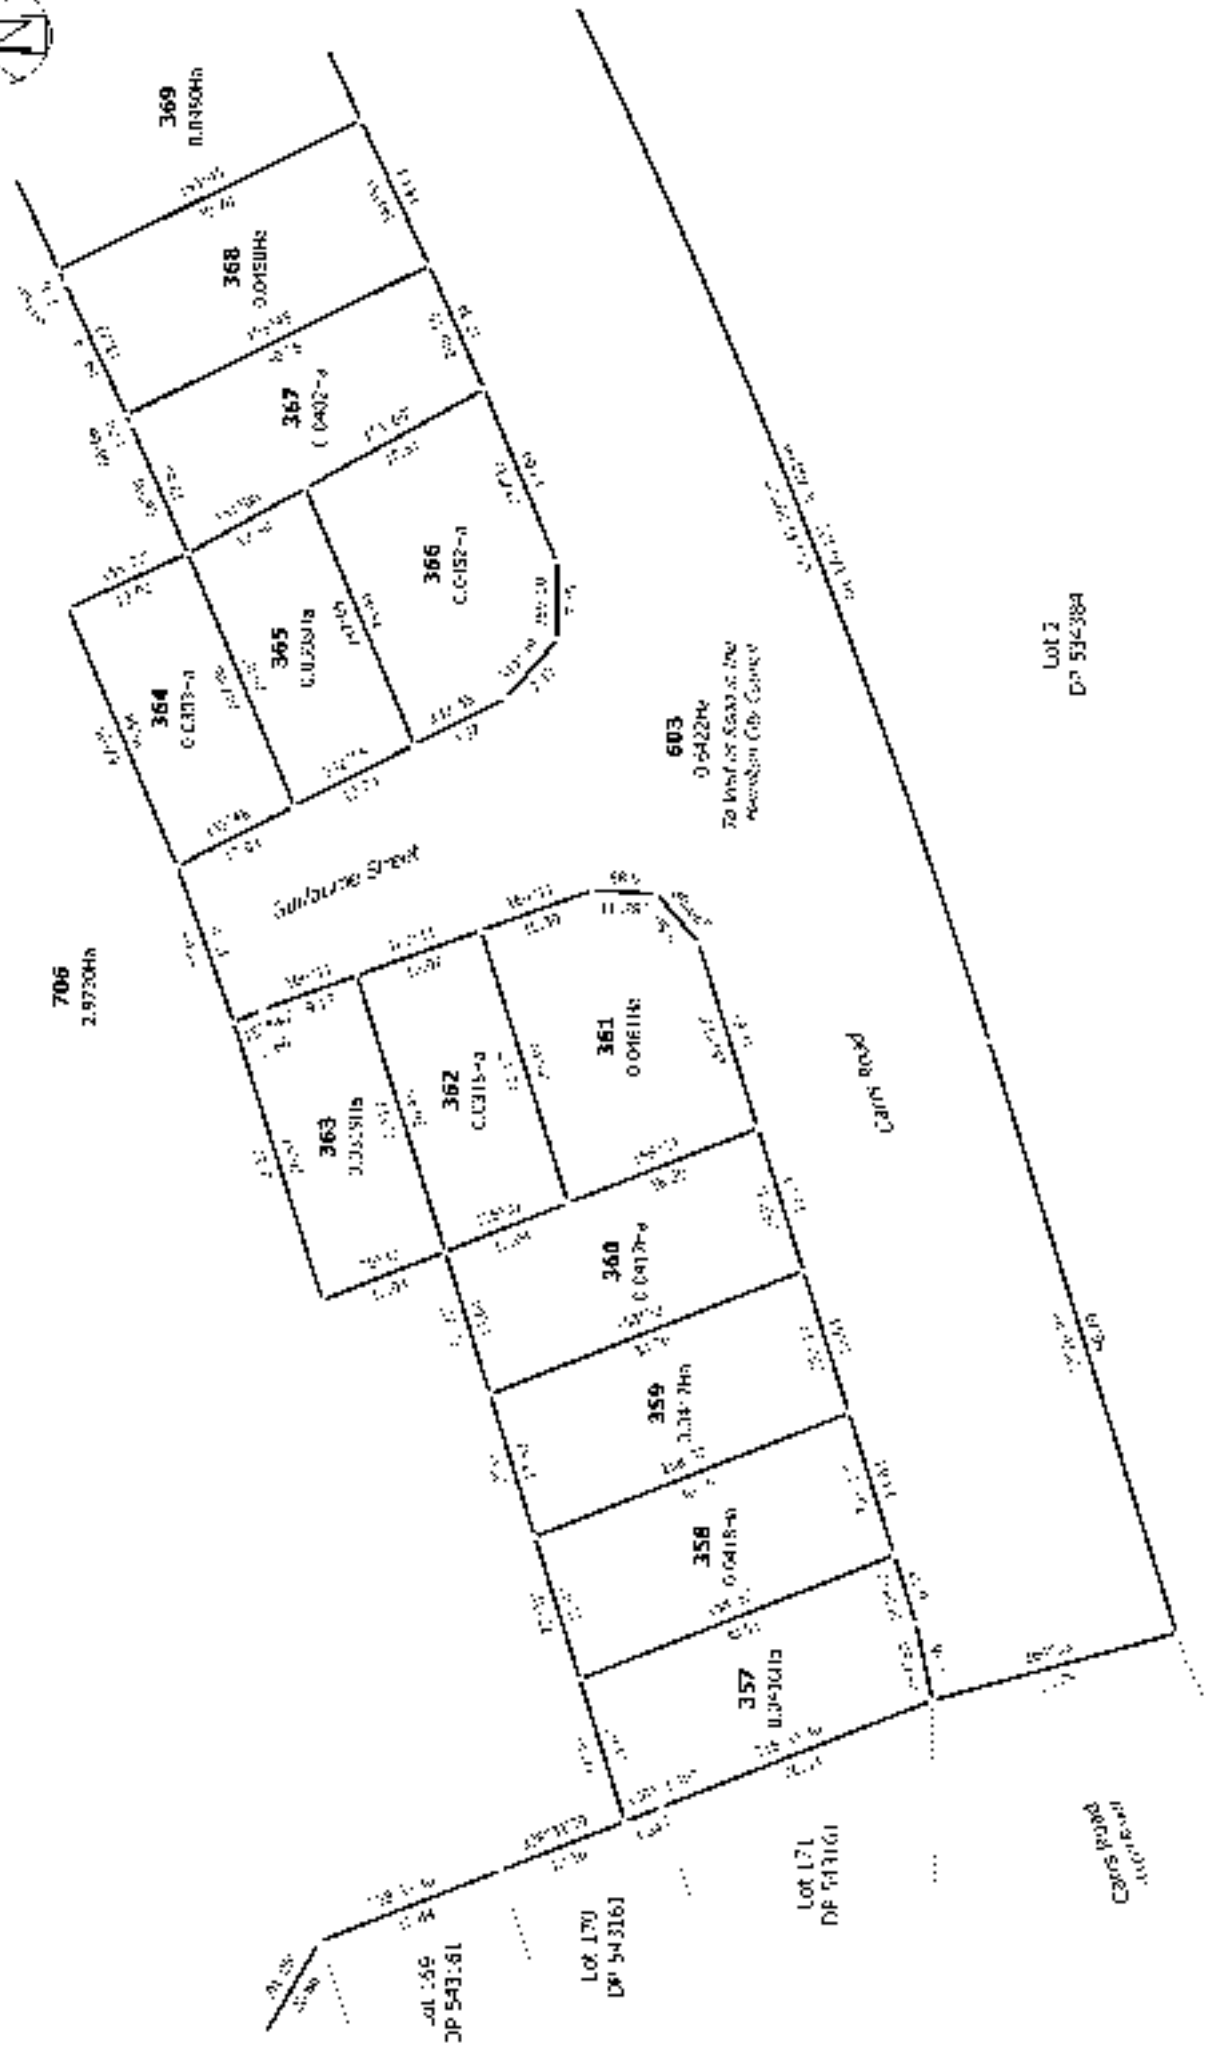

Title Plan
LT 568430
DRAFT

Surveyor Scott Robey Co Inc
For: Enbridge and Jansak Limited Partnership


Lots 357-374, 504, 602, 613 and 706 Being a Subdivision of Lot 705 DP 548656

and District South Assessment

Officially Generated Plan
2015-01-15 10:00:00 AM



Diag. AD

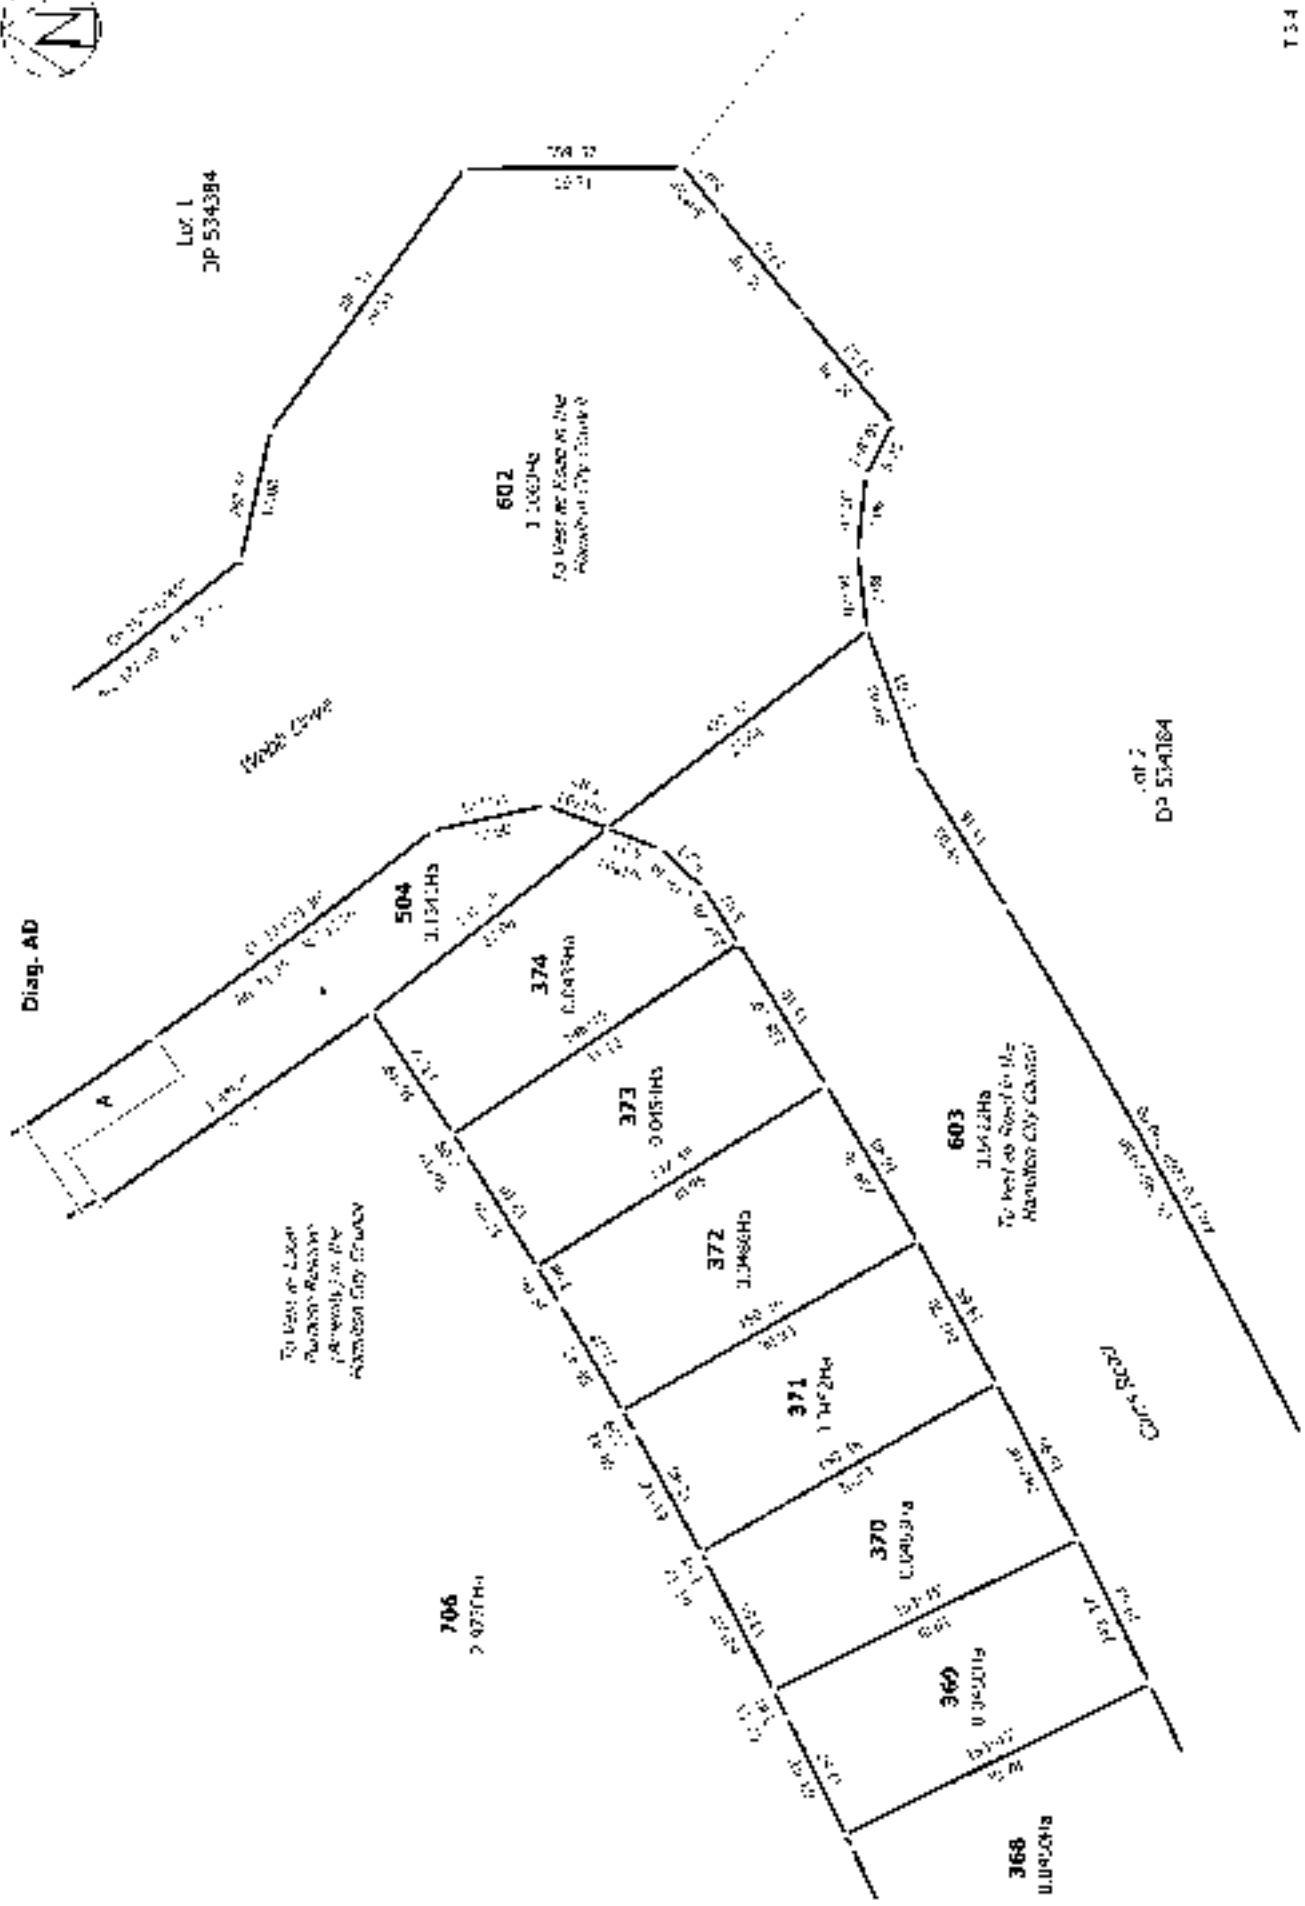

SCHEDULE OF LAND AND ASSETS TO VEST IN COUNCIL

Hamilton City Council will use these values to record the assets once ownership has transferred following approval of s224c certification.

GENERAL DETAILS

Subdivision name: _____

Site address: _____

HCC application number: _____

DPS number(s): _____

Developer name: _____

Postal address: _____

Suburb: _____

City: _____ Postal code: _____

This information is certified as being true and correct

Completed by: Land owner Agent Other (please specify) _____

Name: _____

Signature: Barry Pearson Date signed: _____

SEND

Email this to subdivision@hcc.govt.nz. Alternatively, if you are attending a works clearance pre-application meeting, please bring this completed form with you.

SUMMARY OF LAND AND ASSETS TO VEST IN COUNCIL (excluding GST)

ASSET TYPE	COST/VALUE	REMOVE COUNCIL'S CONTRIBUTION	TOTAL VESTED
Land (A)			
Water supply (B)			
Wastewater (C)			
Stormwater (D)			
Roading (E)			
Parks (F)			
Other (G)			
TOTAL (excluding GST)			

PLANNING GUIDANCE

For general planning guidance enquiries, contact the duty planner weekdays 8am - 4.45pm.

Email: planning.guidance@hcc.govt.nz Phone: 07 838 6699

SCHEDULE OF LAND AND ASSETS TO VEST IN COUNCIL

LAND, WATER SUPPLY, WASTEWATER AND STORMWATER (All values are to be exclusive of GST)

LAND (A)	DPS	MEASURE (AREA M2)	COST/VALUE	COUNCIL'S CONTRIBUTION
Roading				
Recreation reserve				
Local purpose reserve				
Other - please specify				
TOTAL				
TOTAL VESTED				

WATER SUPPLY (B)	MEASURE	COST/VALUE	COUNCIL'S CONTRIBUTION
Mains	Metres		
Ridermains	Metres		
Services	No.		
Hydrants	No.		
Sluice and peat valves	No.		
Other - please specify			
TOTAL			
TOTAL VESTED			

WASTEWATER (C)	MEASURE	COST/VALUE	COUNCIL'S CONTRIBUTION
Mains	Metres		
Manholes	No.		
Connections	No.		
Other - please specify			
TOTAL			
TOTAL VESTED			

STORMWATER (D)	MEASURE	COST/VALUE	COUNCIL'S CONTRIBUTION
Mains	Metres		
Manholes	No.		
Connections	No.		
Outfalls (inlet/outlet structures)	No.		
Wetland/rain garden planting	Area (m ²)		
Other - please specify			
TOTAL			
TOTAL VESTED			

PLANNING GUIDANCE

For general planning guidance enquiries, contact the duty planner weekdays 8am - 4.45pm.

Email: planning.guidance@hcc.govt.nz **Phone:** 07 838 6699

SCHEDULE OF LAND AND ASSETS TO VEST IN COUNCIL

ROADING, PARKS AND OTHER (All values are to be exclusive of GST)

ROADING (E)	MEASURE	COST/VALUE	COUNCIL'S CONTRIBUTION
Pavement	Area (m ²)		
Surfacing	Area (m ²)		
Kerb and channel (full height)	Metres		
Berms	Area (m ²)		
Footpaths (inc. walkways & cycleways)	Area (m ²)		
Vehicle crossings (excl. residential)	Area (m ²)		
Road drainage (catchpits & leads)	No.		
Street lighting	No.		
Signage	No.		
Subsoil drains	Metres		
Tactile pavers	No.		
Parking and bus bays	Area (m ²)		
Sundries (bridges/culverts/walls/etc)	No.		
Other - please specify			
TOTAL			
TOTAL VESTED			

PARKS (F)	MEASURE	COST/VALUE	COUNCIL'S CONTRIBUTION
Bollards	No.		
Landscaping (trees, shrubs)	Area (m ²)		
Paths	Area (m ²)		
Fencing	Metres		
Play equipment	No.		
Seats/benches/tables	No.		
Other - please specify			
TOTAL			
TOTAL VESTED			

OTHER (G)	MEASURE	COST/VALUE	COUNCIL'S CONTRIBUTION
Buildings	No.		
Other - please specify			
TOTAL			
TOTAL VESTED			

PLANNING GUIDANCE

For general planning guidance enquiries, contact the duty planner weekdays 8am - 4.45pm.

Email: planning.guidance@hcc.govt.nz **Phone:** 07 838 6699

Hamilton City Development Manual	
Volume 4 : Quality Systems for Land Development	Part 9 — Appendices
Authorised by : Design Services Manager	

APPENDIX 4 i)

CERTIFICATION UPON COMPLETION OF ROADS, PIPELINES AND OTHER SERVICES

ISSUED BY: Barry Pearson
(suitably qualified professional)

TO: Chedworth Properties Limited
(Development Owner)

TO BE SUPPLIED TO: Hamilton City Council
(Territorial Authority)

IN RESPECT OF: Greenhill Park - Stage 13
(Description of Development Project)

AT: Popham Road, Greenhill Park, Hamilton, New Zealand
(Address)

S & L has been engaged by **Chedworth Properties limited**
(Survey Firm) (Development Owner)

to provide construction observation, review and certification services in respect of the above development which is described in the specification and shown on the drawings numbered 3411915-CA-2000 to 3411915-CA-2516 approved by **Hamilton City Council**
(Territorial Authority)

I have sighted the **Hamilton City Council** consent and conditions of consent to the Development and the approved specification and drawings.
(Territorial Authority)

As an independent professional, I or personnel under my control, have carried out periodic reviews of the works appropriate to the engagement and based upon these reviews, information supplied by the contractor during the course of the works and the contractor's certification upon completion of the works (copy attached) I **BELIEVE ON REASONABLE GROUNDS** that the works, other than those outstanding works listed below, have been completed in accordance with the above consent and sound engineering practice.


(Signature suitably qualified Professional) Date **5/3/2021**

CMEngNZ, CPEng Member **CSNZ** **NZIS**
(Professional Qualifications)

36 Kereiti Street, Mount Maunganui **ACENZ** **IPENZ**
(Address)

CPEng

Outstanding Works

Road signs installation for the Webb Drive/Carrs Road roundabout (supply delay)

Tactile paver installation

Hamilton City Development Manual	
Volume 4 : Quality Systems for Land Development	Part 9 — Appendices
Authorised by : Design Services Manager	

APPENDIX 4 iii)

HAMILTON CITY COUNCIL

CERTIFICATE FOR AS-BUILT DRAWINGS

Greenhill Park - Stage 13
 **DEVELOPMENT**

I, Barry Pearson, Chartered Professional Engineer/Surveyor, hereby certify that all of the information shown on the "as built" drawings and spreadsheets is correct as to location (x, y and z co-ordinates), size, materials. This applies to the following "as built" drawings:

Drawing No.	Title
21879-M-13-WW1-Rev AB	Stage 13 Wastewater Asbuilt Plan
21879-M-13-W1 Rev AB	Stage 13 Water Reticulation Asbuilt Plan
21879-M-13-SW1 Rev AB	Stage 13 Stormwater Asbuilt Plan
21879-M-13-RD1-Rev AB	Stage 13 Rooding Asbuilt Plan
.....
.....

Barry Pearson

 Chartered Professional Engineer/Surveyor

12/3/2021

 Date

Strategic Development Unit Works Clearance Checklist

Note: Please refer to the Regional Infrastructure Technical Specifications for testing requirements and guidelines.

Consent Ref: 11.2018.6632

Site Address: Webb Drive, Greenhill Park

New Street Name: Stage 13 – Greenhill Park

Development Engineer:

Documentation	Completed	Date	Notes
General			
GST register for all vested asset (PG L4 and PG L5)			
Upsize contribution documentation	N/A		
WEL completion certificate	Y	Not received	To be provided
Gas completion certificate (where necessary)	Y	4/3/2021	Attached
UFF completion certificate	Y	8/3/2021	Attached
Roading			
Completion Certificate (PS4 or similar)	Y	Various	Similar Attached
Subgrade			
- Stringing (relative shape and height)	Y	1/12/2020	Attached
- Compaction (natural subgrade – Scala, SIL sand-Scala, SIL brown rock – Clegg)	Y	4/1/2020	Attached
Subbase			
- Stringing (relative shape and height)	Y	4/12/20 Carrs Rd. 10/11/20 Webb Dr	Attached
- Compaction (clegg)	Y	4/12/20 Carrs Rd. 10/11/20 Webb Dr	Attached
- Nuclear densometer (NDMS)	Y	4/12/20 Carrs Rd. 10/11/20 Webb Dr	Attached

Basecourse			
- Stringing (relative shape and height)	Y	17-2-21 Carrs Rd 11/2/2021 Webb Dr	Attached
- Compaction (clegg)	Y	Carrs Rd 18-2-21	Attached
- Nuclear densometer (NDMS)	Y	14/2/21 Carrs Rd. 10/2/21 Webb Dr	Attached
- Benkelman beam test	Y	14/2/2021 Carrs Rd. 9/2/21 Webb Dr	Attached
RAMM Pavement	Y	11/2/2021 Webb Dr 18-2-2021 Carrs Rd	Attached
RAMM Surfacing	Y	6/3/2021	Attached
Streetlight			
Asbuilt Plan		12/3/2021	Attached
RAMM Streetlight	Y	12/3/2021	Attached
Copy of approved application for new connection	Y	Not received	To be provided
Producer Statement	Y	12/3/2021	Attached
CoC or ESC signed by authorised person	Y	20-2-2021 & 9/3/2021	Attached
Asbuilt in format approved by WEL	Y	Not received	To be provided
Confirmation of practical completion or 224c sign off	Y	Not received	To be provided
WEL Networks approval sheet (Written confirmation from WEL for the acceptance of all underground cabling and circuitry)	Y	Not received	To be provided
Manufacturer's Warranty Documents	Y	4/3/2020	Attached
Road Drainage			
Asbuilt plan (subsoil/catchpit/leads	Y	12/3/2021	Attached
Secondary flow path	Y	12/3/2021	Attached

Signage and Marking Asbuilt Plan	Y	12/3/2021	Attached
Water			
Water as-built plan	Y	12/3/2021	Attached
Data Sheet	Y	12/3/2021	Attached
Pressure test certificate	Y	4/2/2021	Attached
DXF (if >2 lots)	N/A		
Bacteriological test result	Y	18/2/2021	Attached
Hydrant test (where necessary)	N/A		
RITS checklists			
- F6.1 Water reticulation design confirmation,	N/A		Beca design
- F6.2 Water reticulation pipe laying checklist,	Y	11/3/2021	Attached
- F6.3 Water reticulation final inspection checklist	Y	11/3/2021	Attached
Wastewater			
Wastewater as-built plan	Y		Attached
Data sheet	Y	12/3/21	Attached
DXF (if >2 lots)	Y	06/11/2020	Attached
CCTV investigation	Y	10/3/2021	Submission email attached
Pipe Pressure test	Y	16/10/2020	Attached
Manhole pressure test	Y	16/10/2020	Attached
Trench backfill	Y	9/3/2021	Attached
RITS checklist			
- F5.1 wastewater design confirmation,	N/A		Beca design
- F5.2 Wastewater pipe laying checklist,	Y	16/12/2020	Attached
- F5.3 Wastewater manhole checklist,	Y	16/12/2020	Attached
- F5.4 Wastewater trench backfill test summary,	Y	16/12/2020	Attached

- F5.6 Wastewater pipe network- final inspection checklist,	Y	9/3/2021	Attached
- F5.7 Pump station control programming checklist	N/A		
Stormwater			
Stormwater as-built plan	Y	06/11/2020	Attached
Data sheet	Y	06/11/2020	Attached
DXF (if >2 lots)	Y	06/11/2020	Attached
Wetland as-built plan (see RITS for minimum details required)	N/A		
Completed planting plan (confirmation that plants are in accordance with the accepted plan)	Y	06/11/2020	Attached
Proprietary device completion certificate	N/A		
Final operation and maintenance manual	N/A		
CCTV investigation	Y	10/3/2021	Submission email attached.
Trench backfill	Y	9/3/2021	Attached
RITS checklist			
- F4.1 Stormwater design checklist,	N/A		Beca design
- F4.2 Stormwater pipe laying checklist,	Y	14/12/2020	Attached
- F4.3 Stormwater manhole checklist,	Y	14/12/2020	Attached
- F4.4 Stormwater trench backfill compaction test summary,	Y	14/12/2020	Attached
- F4.5 Stormwater catchpit checklist,	Y	14/12/2020	Attached
- F4.6 Stormwater pipe network final inspection checklist,	Y	9/3/0221	Attached

- F4.7 Wetland construction inspection checklist,	N/A		
- F4.8 Wetland and inspection/Sign off checklist	N/A		
- Final Operation and Maintenance Manual	N/A		
- Final Water Impact Assessment	N/A		
Parks and Open Spaces Street trees/planting sign off	As Built plan	12-3-2021	Sign off to be supplied from HCC
Bond			
Quote	N/A		
Signed bond form			To be supplied from HCC
Other:	N/A		

APPENDIX 9

As Built Drawings


- 21879-M-13-WW1-Rev AB – Stage 13 Wastewater Asbuilt Plan
- 21879-M-13-W1 Rev AB – Stage 13 Water Reticulation Asbuilt Plan
- 21879-M-13-SW1 Rev AB – Stage 13 Stormwater Asbuilt Plan
- 21879-M-13-RD1-Rev AB – Stage 13 Rooding Asbuilt Plan
- H18006_130 to H18006_ 600 Lanscape As Built drawings by Boffa Miskell – stage 13

APPENDIX 10

Asset Spreadsheets – Hard copy

- Water asset sheets
- Wastewater asset sheets
- Stormwater asset sheets



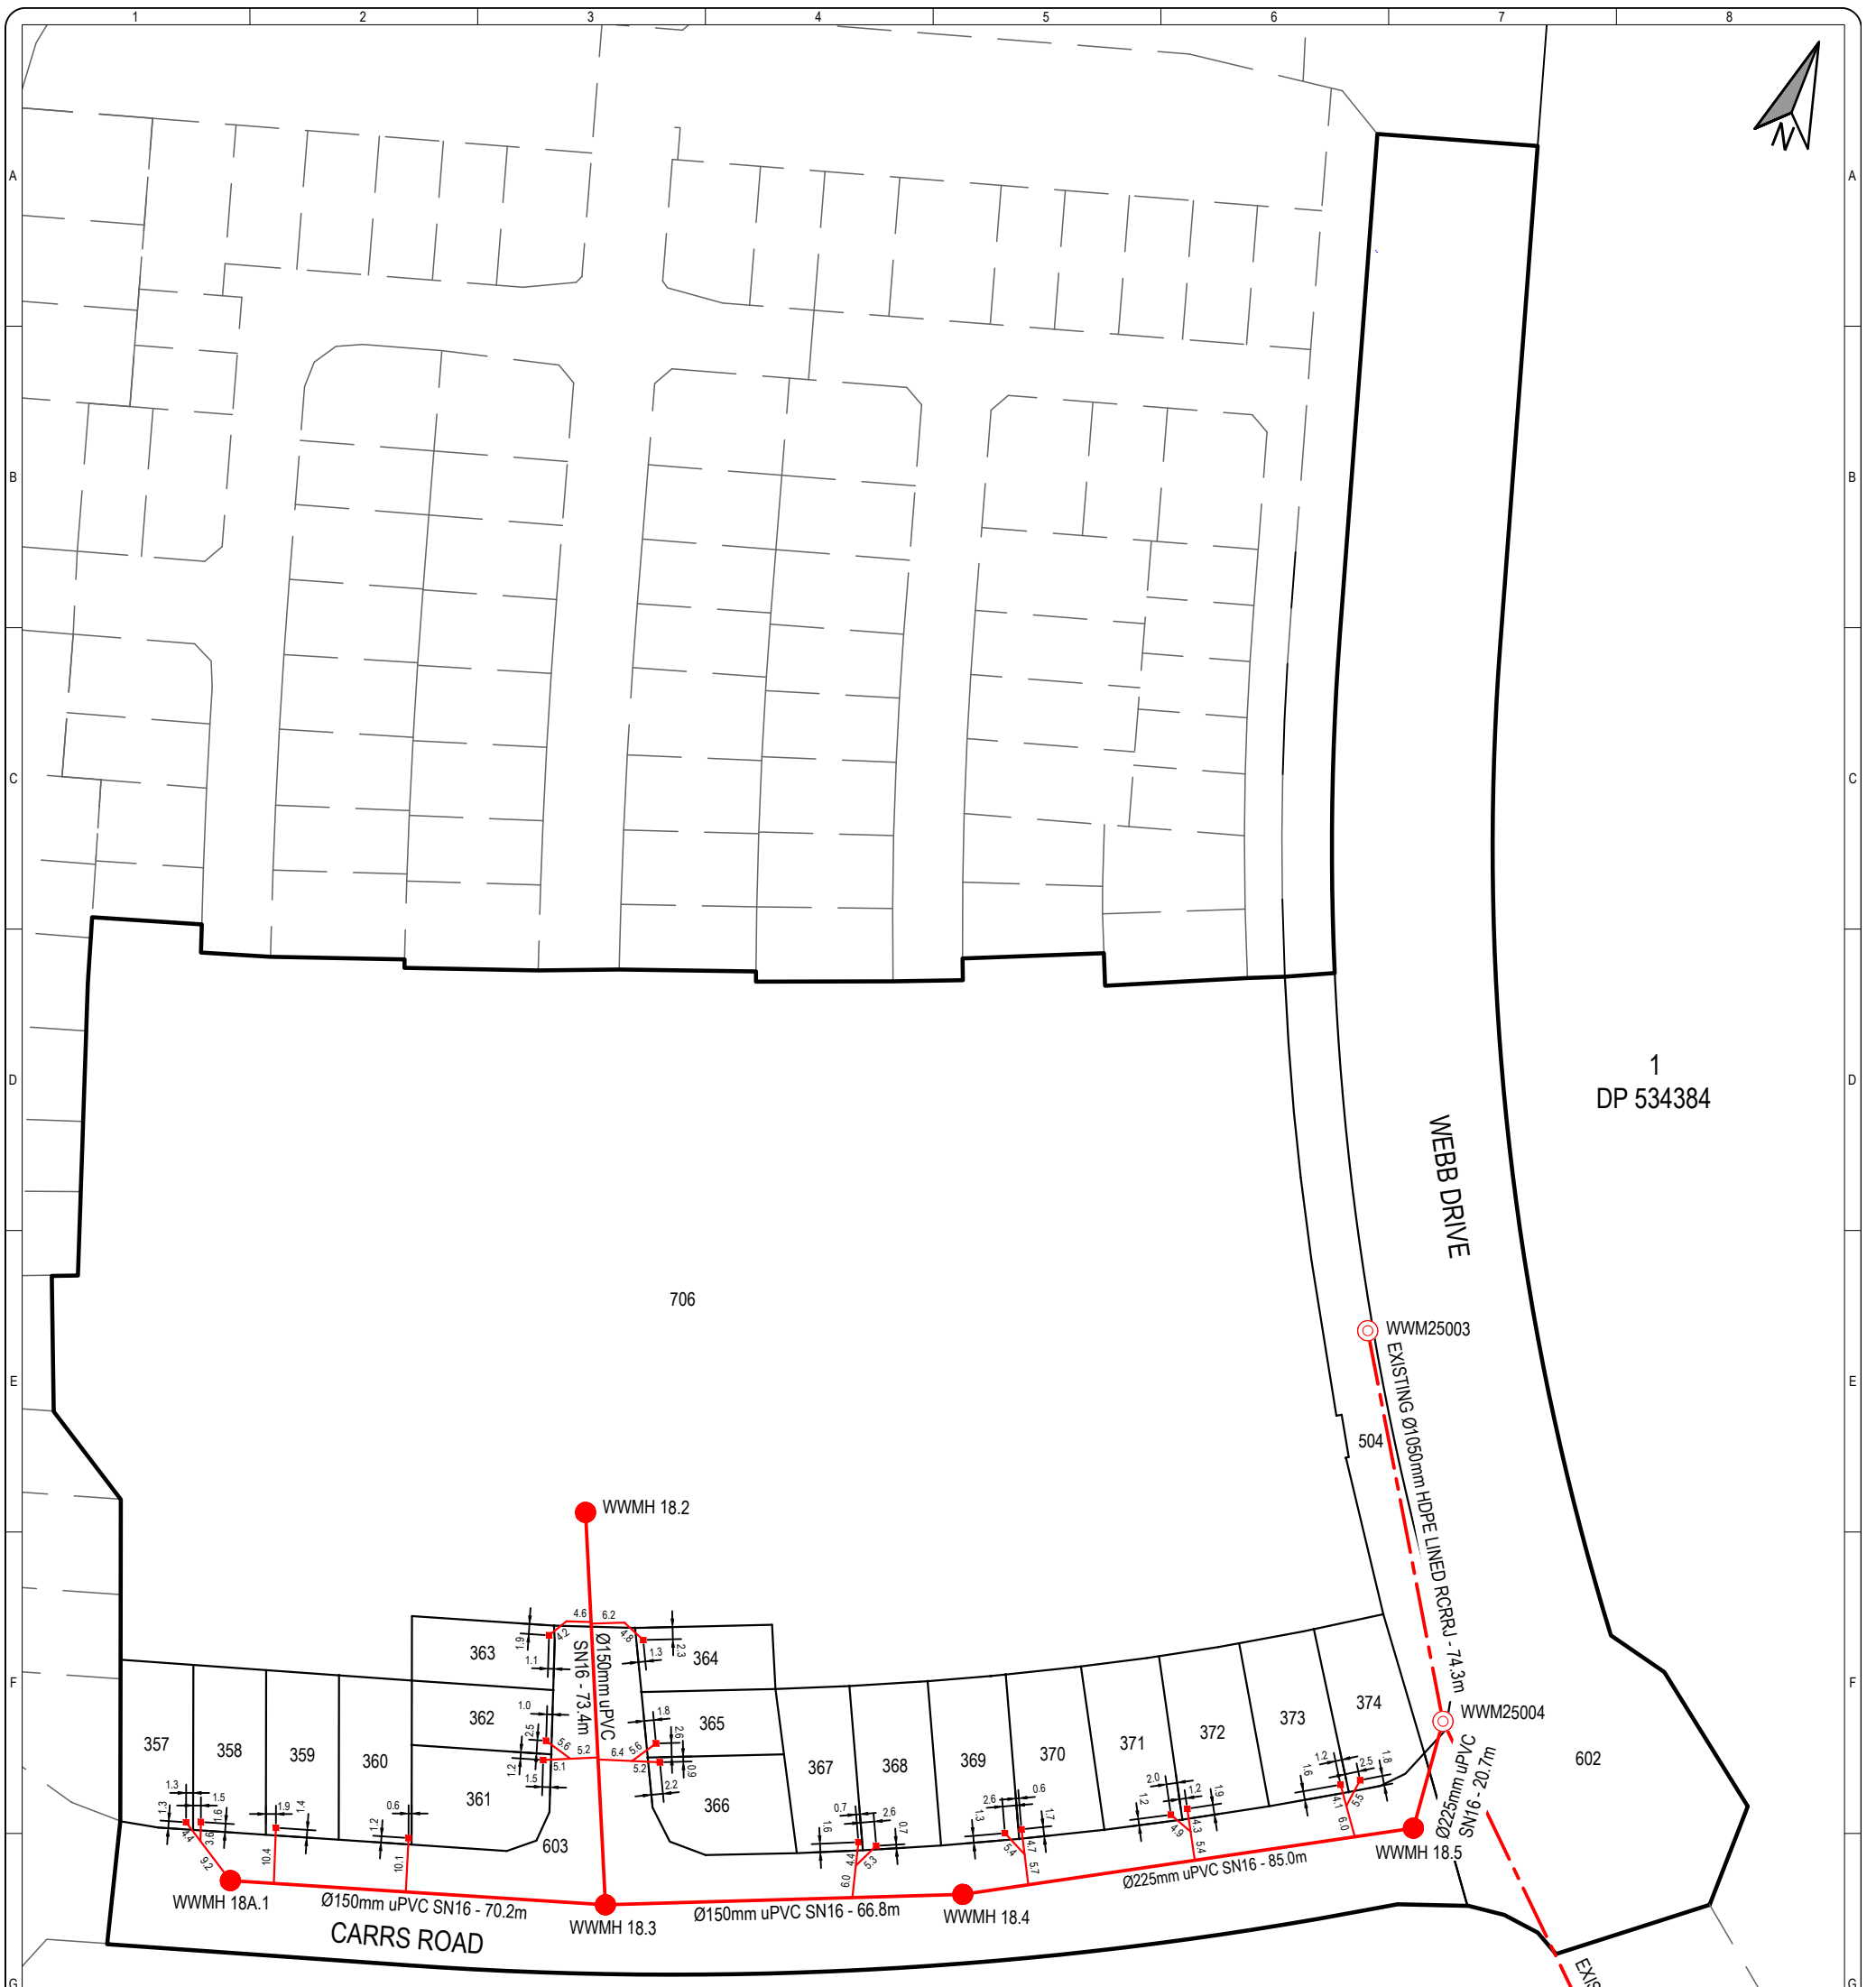

WASTE WATER MANHOLES COORDINATES							
MH ID	DIAMETER	EASTING	NORTHING	LID LEVEL	INVERT OUT	INVERT IN	INVERT IN
WWMH 18.2	1050	447305.55	702830.11	TBC	35.39		
WWMH 18.3	1050	447335.94	702763.33	38.74	34.96	35.01	35.02
WWMH 18.4	1050	447397.28	702789.67	39.30	34.10	34.13	34.13
WWMH 18.5	1200	447470.97	702832.10	40.17	33.63	33.66	
WWM25004	1800	447468.77	702852.69	40.67	32.25	33.15	32.26
WWMH 18A.1	1050	447269.16	702741.78	37.79	36.39	36.58	

WASTE WATER PIPELINES								
UPSTREAM MH	DOWNSTREAM MH	PIPE DIA	MATERIAL	CLASS	PIPE LENGTH	PIPE GRADE	UPSTREAM IL	DOWNSTREAM IL
WWMH 18.5	WWM25004	225	uPVC	SN16	20.7	1:38	33.63	33.08
WWMH 18.4	WWMH 18.5	225	uPVC	SN16	85.0	1:193	34.10	33.66
WWMH 18.3	WWMH 18.4	150	uPVC	SN16	66.8	1:80	34.96	34.13
WWMH 18.2	WWMH 18.3	150	uPVC	SN16	73.4	1:198	35.39	35.02
WWMH 18A.1	WWMH 18.3	150	uPVC	SN16	70.2	1:51	36.39	35.01

LEGEND:

- ABUTTAL
- BOUNDARY
- STAGE PERIMETER
- WASTEWATER MAIN - NEW
- WASTEWATER CONNECTION
- WASTEWATER - EXISTING
- WW MANHOLE - NEW ●
- WW MANHOLE - EXISTING ○
- WASTEWATER CONNECTION ■

NOTES:

- HCC REF: 011.2018.00006632.001
- LOT CONNECTIONS AND LATERAL LINES PLOTTED FROM DATA SUPPLIED BY WEST CONSTRUCTION
- LOT CONNECTIONS ARE Ø100 uPVC SN16 RR UNLESS SHOWN OTHERWISE

2
DP 534384

H:\0000 - H Drive\parkinson\Autocad\21879-M-13 - CAD\M - Stage 13 As-Built - Stage 13 As-Built.dwg - Plotted: 12/03/2021

SHRIMPTON & LIPINSKI
LAND DEVELOPMENT & DESIGN SPECIALISTS
Ph: 07 577 6069
Email: info@sltga.co.nz
P.O. Box 231, Tauranga 3140
www.sltga.co.nz

Chedworth Properties Limited
GREENHILL

**STAGE 13
WASTEWATER
AS-BUILT PLAN**

Rev	Description	Drn	Ckd	App	Date
AB	AS-BUILT	NP	SRC	NF	03/21
0	PRELIMINARY	NP	SRC	NF	02/21


Coordinate System: NZGD 2000 MT EDEN CIRCUIT
Origin of Coordinates: ALP 4 DP 534481
Height Datum: MOTURIKI DATUM 1953
Origin of Height: SS 507 SO 42451 RL 44.04m

Original Scales @ A3 Status
1:1250 AS-BUILT

Do Not Scale Dimensions

Drawing No: **21879-M-13-WW1** Revision: **AB**

Surveyed: HNC 02/21 Designed: _____

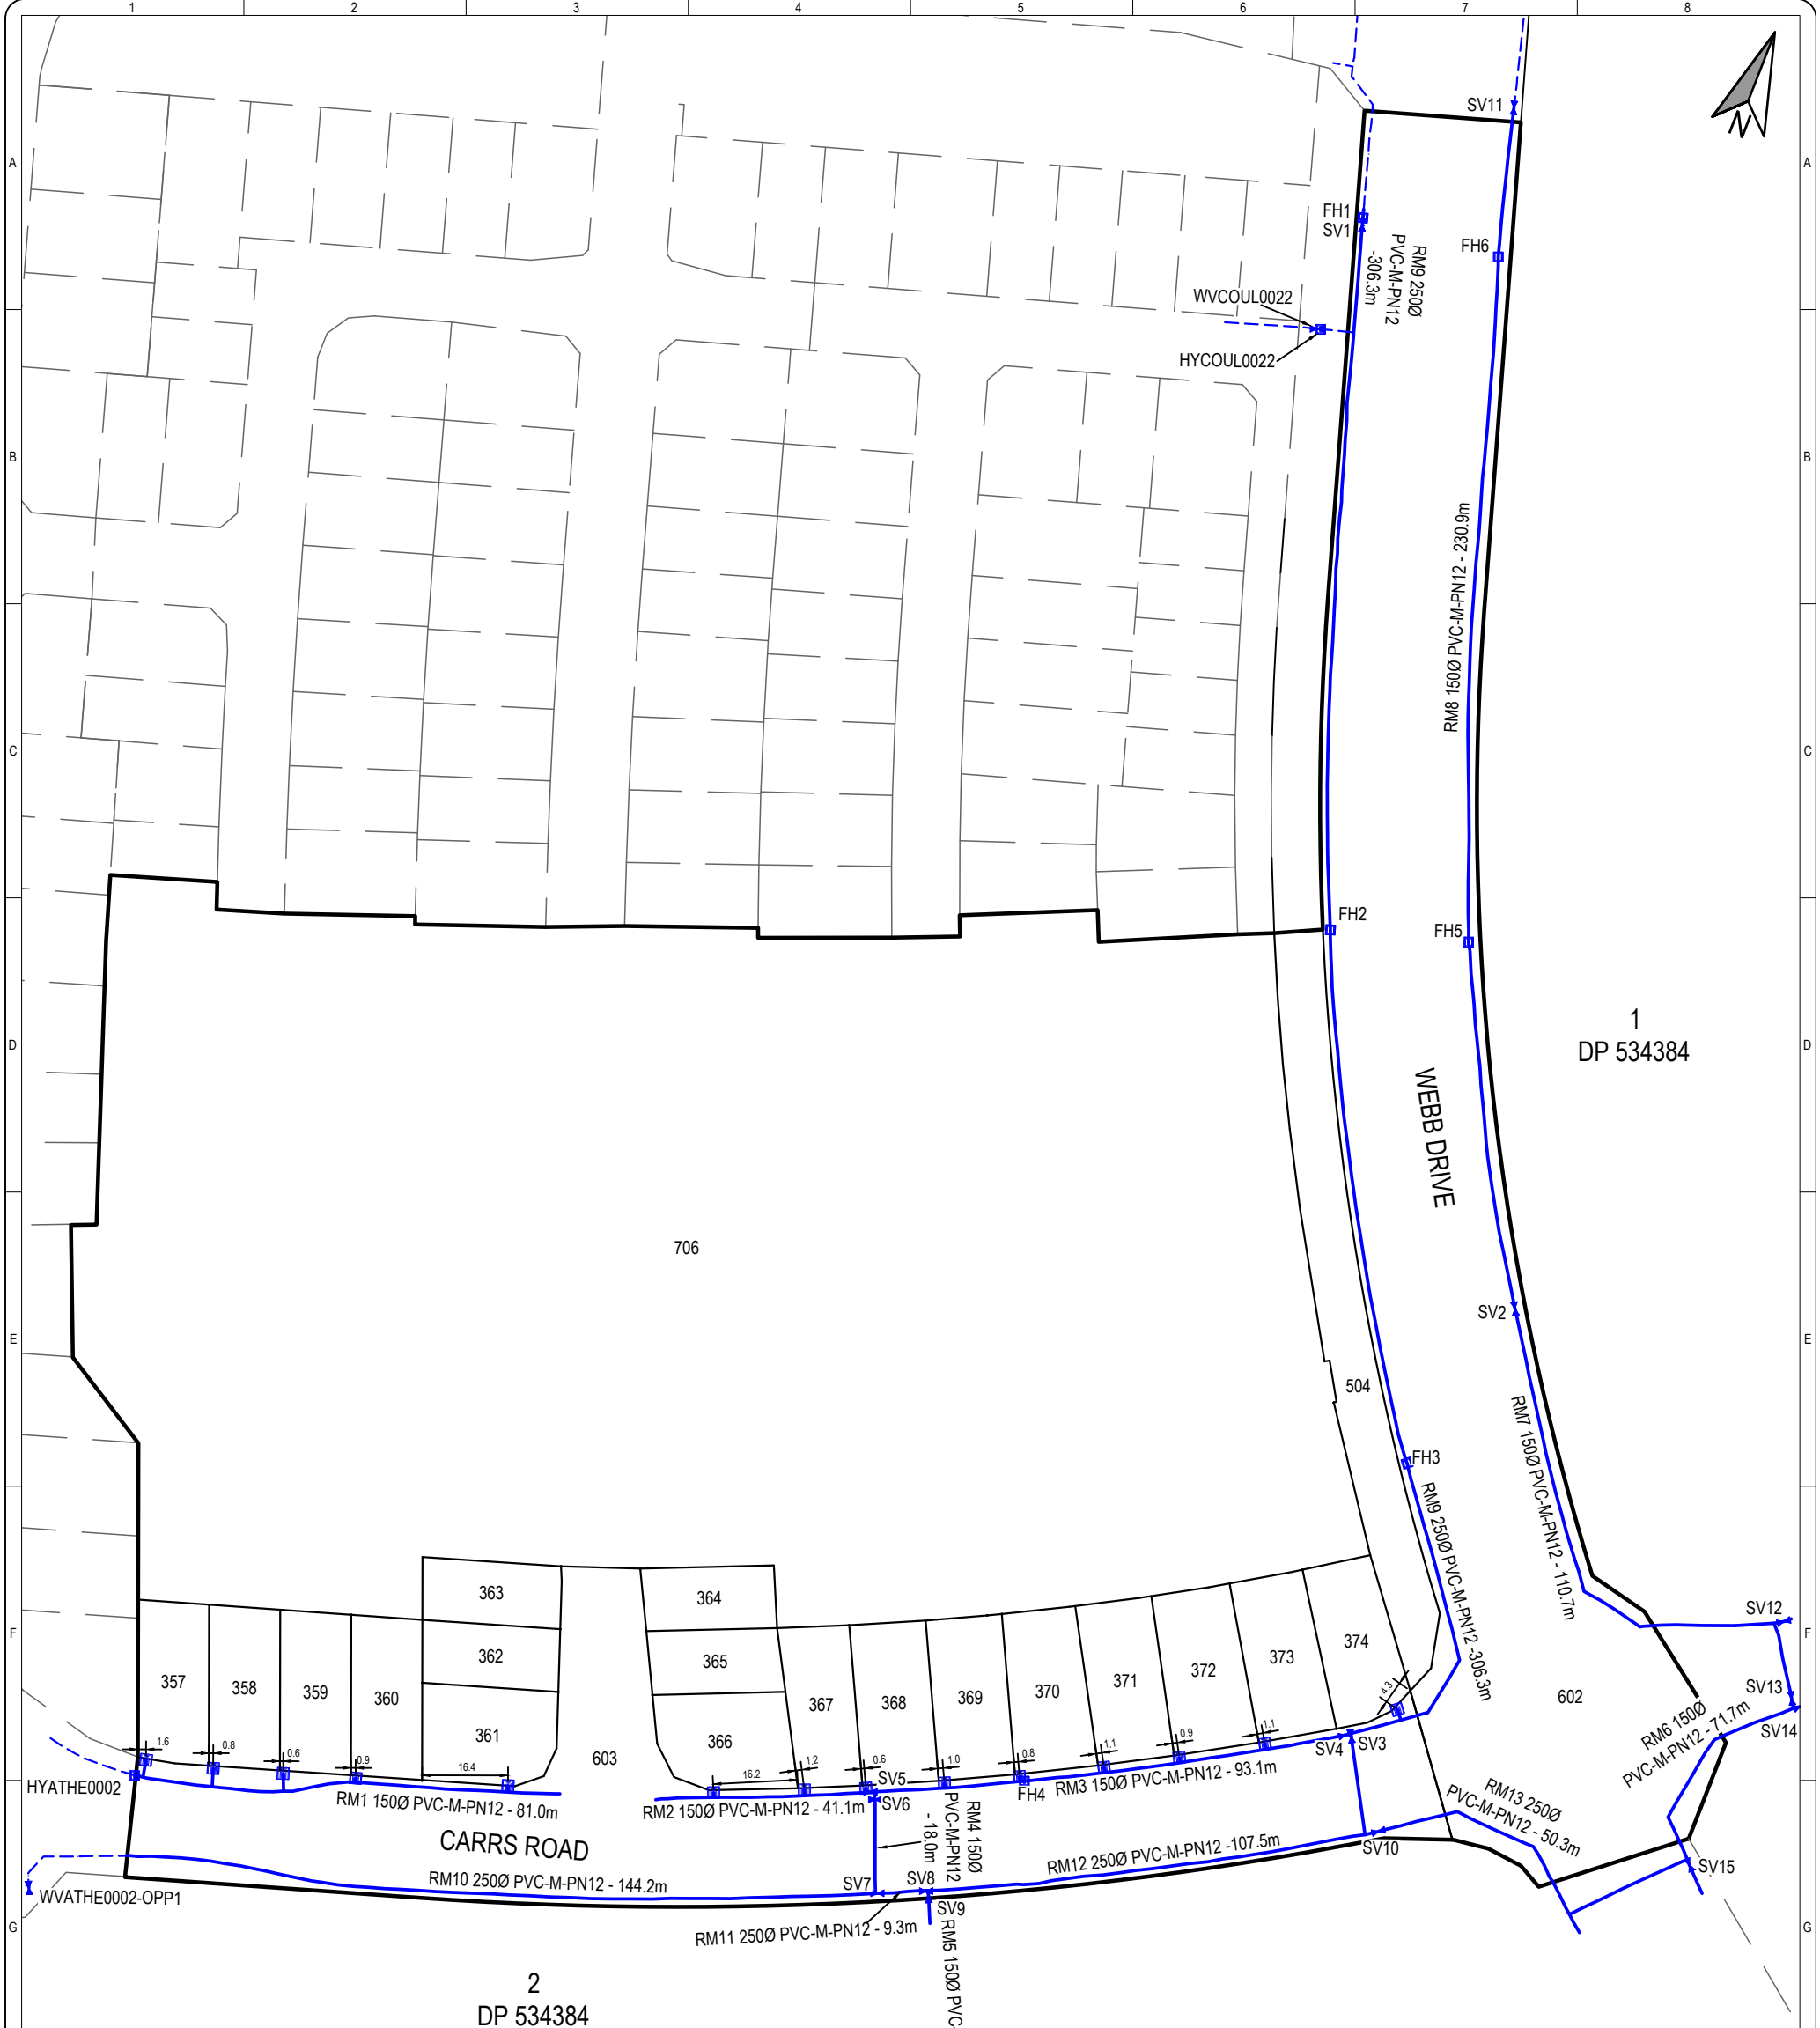

1
DP 534384

2
DP 534384

LEGEND:

ABUTTAL	---
BOUNDARY	---
STAGE PERIMETER	---
WATER MAIN	---
EXISTING WATER MAIN	---
RIDERMAIN	---
WATER METER	M
VALVE - NEW	⋈
VALVE - EXISTING	⋈
FIRE HYDRANT - NEW	H

NOTES:

- HCC REF: 011.2018.00006632.001
- WATERMANS PLOTTED FROM DATA SUPPLIED BY ONLINE CONTRACTORS

SLUICE VALVE COORDINATES		
VALVE ID	EASTING	NORTHING
SV1	447356.04	703103.45
SV2	447459.46	702921.23
SV3	447460.40	702833.61
SV4	447459.27	702833.43
SV5	447378.79	702789.89
SV6	447380.15	702788.87
SV7	447387.15	702772.34
SV8	447395.67	702776.15
SV9	447396.45	702775.43
SV10	447471.96	702818.60
SV11	447374.78	703134.89
SV12	447529.31	702884.47
SV13	447536.12	702871.33
SV14	447538.23	702870.49
SV15	447529.64	702834.50

FIRE HYDRANT COORDINATES		
HYDRANT ID	EASTING	NORTHING
FH1	447355.64	703104.69
FH2	447399.96	702975.68
FH3	447451.13	702886.15
FH4	447405.39	702802.63
FH5	447425.41	702983.23
FH6	447382.49	703107.23

**STAGE 13
WATER RETICULATION
AS-BUILT PLAN**

Rev	Description	Drn	Ckd	App	Date
AB	AS-BUILT	NP	SRC	NF	03/21
0	PRELIMINARY	NP	SRC	NF	02/21

Coordinate System: NZGD 2000 MT EDEN CIRCUIT	
Origin of Coordinates: ALP 4 DP 534481	
Height Datum: MOTURIKI DATUM 1953	
Origin of Height: SS 507 SO 42451 RL 44.04m	
Original Scales @ A3	Status
1:1250	AS-BUILT
Do Not Scale Dimensions	
Drawing No	Revision
21879-M-13-W1	AB

H:\0000 - H Drive\parkinson\Autocad\21879-M-13 - CADM - Stage 13 As-Built - Autocad\21879-M-13 - CADM - Stage 13 As-Built.dwg - Plotted: 12/03/2021

STORM WATER PIPELINES								
UPSTREAM MH	DOWNSTREAM MH	PIPE DIA	MATERIAL	CLASS	PIPE LENGTH	PIPE GRADE	UPSTREAM IL	DOWNSTREAM IL
SWMH 19.5	SWOUT 15	675	RCRRJ	4	4.5	1:38	35.41	35.29
SWMH 19.4	SWMH 19.5	675	RCRRJ	4	40.2	1:35	36.57	35.41
SWMH 19.1	SWMH 19.4	600	RCRRJ	4	81.0	1:127	37.27	36.63
SWMH 22.2	SWMH 19.4	375	RCRRJ	4	72.9	1:89	37.71	36.89
SWMH 22.1	SWMH 22.2	300	uPVC	SN16	57.4	1:88	38.39	37.74
SWMH SP 4.2	SWM25005	300	uPVC	SN16	41.4	1:103	38.59	38.19
SWMH SP 3.4	SWM25001	375	RCRRJ	4	37.5	1:218	37.50	37.25
SWMH SP 3.3	SWMH SP 3.4	300	uPVC	SN16	54.5	1:188	37.81	37.52
SWMH SP 3.2	SWMH SP 3.3	300	uPVC	SN16	56.1	1:160	38.26	37.91
SWMH SP 3.1	SWMH SP 3.2	300	uPVC	SN16	54.6	1:152	38.69	38.33
SWMH 9.5	SWN24075	300	uPVC	SN16	44.7	1:172	36.91	36.65

STORM WATER MANHOLES COORDINATES									
MH ID	DIA	EASTING	NORTHING	LID LEVEL	INVERT OUT	INVERT IN	INVERT IN	INVERT IN	INVERT IN
SWMH 9.5	1050	447278.58	702740.86	37.93	36.91	36.96	37.02	36.94	
SWMH 19.1	1200	447305.16	702835.08	TBC	37.27				
SWMH 19.4	1500	447339.00	702761.45	38.76	36.57	36.63	37.52	36.89	37.30
SWMH 19.5	1050	447314.32	702729.71	36.56	35.41	35.41			
SWMH 22.1	1050	447455.90	702818.80	39.91	38.39	38.80	38.93	38.65	
SWMH 22.2	1050	447405.31	702791.67	39.41	37.71	38.05	37.74	38.06	
SWMH SP 3.1	1050	447446.83	702932.16	39.95	38.69	38.70			
SWMH SP 3.2	1050	447421.79	702980.63	39.56	38.26	38.33	38.50		
SWMH SP 3.3	1050	447400.98	703032.69	39.18	37.81	37.91	38.12		
SWMH SP 3.4	1050	447384.80	703084.71	38.79	37.50	37.52	37.62		
SWM25001	1050	447373.87	703120.54	38.66	37.21	37.25			
SWMH SP 4.2	1050	447428.70	702911.14	40.15	38.59	38.71			
SWM25005	1050	447407.60	702946.78	39.75	38.13	38.36	38.19	38.47	
SWM25006	1050	447381.34	703000.72	39.37	37.52	37.89	37.53	37.78	
SWM25007	1050	447368.36	703046.36	38.94	37.00	37.33	37.06	37.59	
SWM25008	1050	447357.90	703079.80	38.60	36.65	36.66	37.02		
SWM25004	1050	447342.00	703122.13	38.40	36.21	36.34	36.22		
SWN24075	1050	447235.21	702729.92	37.88	36.55	36.60	36.65	36.63	

STORM WATER OUTLETS COORDINATES					
OUTLET ID	DIA	EASTING	NORTHING	TOP OUTLET	INVERT OUT
SWOUT 15	675	447310.10	702728.11	36.28	35.29



LEGEND:

- ABUTTAL
- BOUNDARY
- STAGE PERIMETER
- OVERLAND FLOW PATH
- STORMWATER MAIN
- STORMWATER CONNECTION
- STORMWATER EXISTING
- SW MANHOLE NEW
- SW MANHOLE EXISTING
- SW CONNECTION
- OUTLET
- DOUBLE CATCHPIT
- CATCHPIT

NOTES:

- HCC REF: 011.2018.00006632.001
- DCP'S CONNECTED TO MANHOLES BY Ø300 uPVC SN16 UNLESS OTHERWISE STATED
- CP'S CONNECTED TO MANHOLES BY Ø225 DIA uPVC SN16 UNLESS OTHERWISE STATED
- LOT CONNECTIONS ARE Ø100 FOR SINGLE AND Ø150 FOR DOUBLE UNLESS OTHERWISE STATED
- LOT CONNECTIONS AND LATERALS LINE PLOTTED FROM DATA SUPPLIED BY WEST CONSTRUCTION & ONLINE CONTRACTORS

H:\0000 - H Drive\parkinson\Autocad\21879-M-13 - CAD\1 - Stage 13 As-Built - Plotted: 12/03/2021

SHRIMPTON & LIPINSKI
 LAND DEVELOPMENT & DESIGN SPECIALISTS
 Ph: 07 577 6069
 Email: info@sltgo.co.nz
 P.O. Box 231, Tauranga 3140
 www.sltgo.co.nz


Chedworth
 Properties Limited
 GREENHILL

**STAGE 13
 STORMWATER
 AS-BUILT PLAN**

Rev	Description	Drn	SRC	NF	Ckd	App	Date
AB	AS-BUILT	NP	SRC	NF			03/21
0	PRELIMINARY	NP	SRC	NF			02/21

Coordinate System: NZGD 2000 MT EDEN CIRCUIT	
Origin of Coordinates: ALP 4 DP 534481	
Height Datum: MOTURIKI DATUM 1953	
Origin of Height: SS 507 SO 42451 RL 44.04m	
Original Scales @ A3	Status
1:1250	AS-BUILT
Drawing No: 21879-M-13-SW1	
Revision: AB	

Copyright on this drawing is reserved

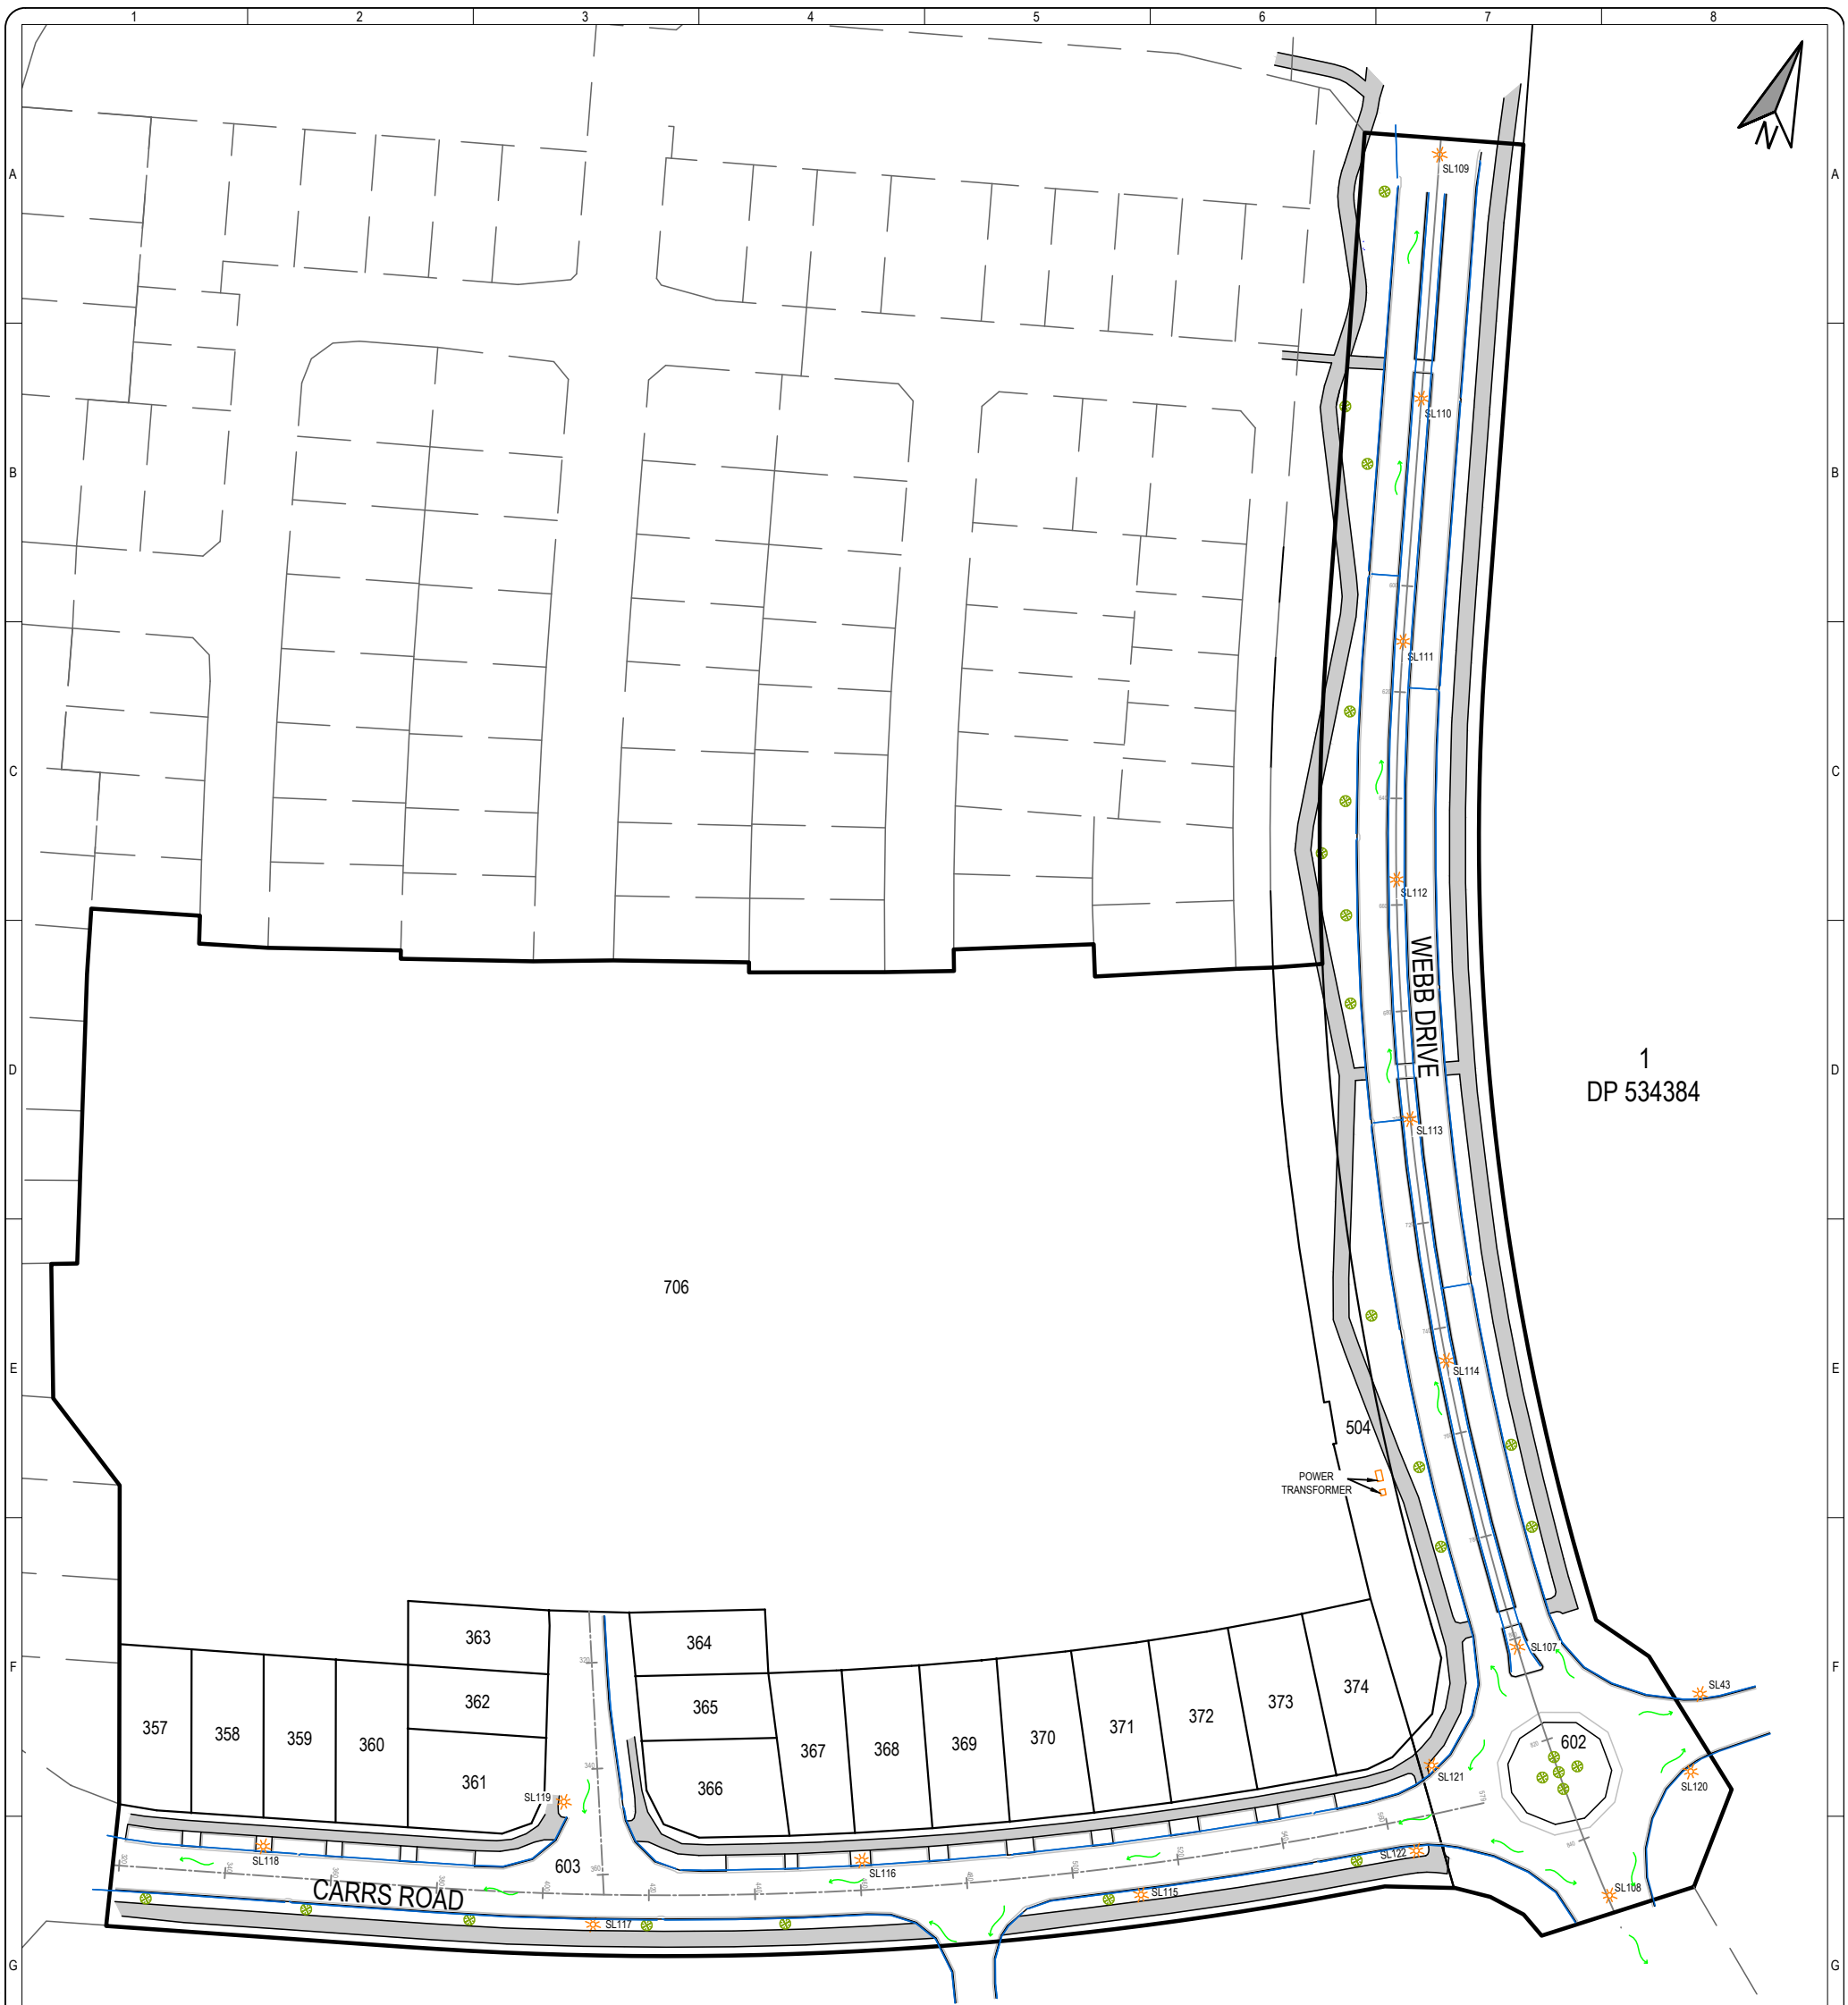

1
DP 534384

2
DP 534384

NOTES:
1. HCC REF: 011.2018.00006632.001

LEGEND:

ABUTTAL	---
BOUNDARY	---
EDGE OF SEAL	---
VERTICAL KERB	---
MOUNTABLE KERB	---
STAGE PERIMETER	---
SUBSOIL DRAINS	---
FOOTPATH	---
STREETLIGHT	
TREE	
OVERLAND FLOW PATH	

STREETLIGHT COORDINATES		
NAME	EASTING	NORTHING
SL107	447480.10	702868.97
SL108	447513.48	702831.79
SL109	447363.06	703125.23
SL110	447376.75	703081.17
SL111	447390.37	703037.34
SL112	447405.77	702995.15
SL113	447424.69	702954.07
SL114	447447.81	702914.25
SL115	447431.33	702799.43
SL116	447380.06	702786.14
SL117	447337.35	702756.26
SL118	447274.16	702747.13
SL119	447323.75	702775.74
SL120	447519.11	702859.13
SL121	447473.31	702842.25
SL122	447476.55	702826.24
SL43	447515.39	702873.38

H:\0000 - H Drive\parkinson\Autocad\21879-M-13 - CADM - Stage 13 As-Built - Autocad\21879-M-13 - CADM - Stage 13 As-Built.dwg - Plotted: 12/03/2021

SHRIMPTON & LIPINSKI
LAND DEVELOPMENT & DESIGN SPECIALISTS
Ph: 07 577 6069
Email: info@sltga.co.nz
P.O. Box 231, Tauranga 3140
www.sltga.co.nz

Chedworth
Properties Limited
GREENHILL

**STAGE 13
ROADING
AS-BUILT PLAN**

Rev	Description	Drn	Ckd	App	Date
AB	AS-BUILT	NP	SRC	NF	03/21
0	PRELIMINARY	NP	SRC	NF	02/21

Coordinate System: NZGD 2000 MT EDEN CIRCUIT	
Origin of Coordinates: ALP 4 DP 534481	
Height Datum: MOTURIKI DATUM 1953	
Origin of Height: SS 507 SO 42451 RL 44.04m	
Original Scales @ A3	Status
1:1250	AS-BUILT
Drawing No	
21879-M-13-R1	Revision
	AB

Copyright on this drawing is reserved

GENERAL NOTES

ALL SET OUT MUST BE CHECKED AND APPROVED BY THE LANDSCAPE ARCHITECT ON SITE.

THE CONTRACTOR SHALL REQUEST, AND HAVE UNDERTAKEN, AN INSPECTION OF ALL SET OUT PRIOR TO ANY CONCRETE BEING PLACED OR PAVING LAID.

THE CONTRACTOR SHALL REQUEST, AND HAVE UNDERTAKEN, AN INSPECTION OF THE SET OUT OF ALL CONTROL JOINTS PRIOR TO COMMENCING SAW CUTTING.

All drawings shall be read in conjunction with the landscape specifications.

Drawings not to be scaled, use dimensioned measurements only.

SITE FURNITURE NOTES

All timber to have a graffiti guard applied in accordance with the manufacturers specifications.

SOFT LANDSCAPE NOTES

All grass areas to be finished 25mm higher than adjoining surface to allow for settlement.

All trees to be inspected and approved by the Landscape Architect prior to delivery to site.

Planting numbers are indicative. Contractor to ensure sufficient stock to achieve the specified planting densities.

All areas of open space planting, amenity planting and berm planting to be mulched in accordance with the specifications and drawings.

Refer to specifications for requirements on the preparation of planting and grass areas.

PLANTING

PLANT LAYOUT

PLANT SPECIES UP TO 0.5M HIGH AT MATURITY
The Contractor shall ensure the planting pit is setback 0.6m (minimum) from the edge of all footpaths and road edges.

PLANT SPECIES 0.5M HIGH OR GREATER AT MATURITY
The Contractor shall ensure the planting pit is setback 1m (minimum) from the edge of all footpaths and road edges.

PAVING

P01 TIMBER DECK
Surface finish: Pinus radiata (H5) timber decking. All timber decking shall be butt-jointed.

Surface fixing: Securely fix decking at each joist with 2 x 304 (or better) stainless steel countersunk timber screws. Ensure all screws are aligned straight.

Finish: Resene Furniture and Decking Oil or equal. Refer Data Sheet D503.

Compaction of subbase to be inspected by Engineer prior to commencement of decking.

P03 INSITU CONCRETE PAVING

Surface finish: U5 soft bristled broom finish in general accordance with NZS 3114, ensure the aggregate is not exposed.

Aggregate: 13mm Greywacke.

Oxide: 8% Black 330 Oxide.

All concrete finishes shall be in accordance with NZS 3114:1987.

Control joints: 5mm wide, formed by sawcutting in accordance with the drawings and specifications.

All insitu concrete paving to include control joints, construction joints and expansion joints in accordance with the drawings and specifications to Engineer's approval.

Compaction of subbase to be inspected by Engineer prior to commencement of paving.

P04 INSITU CONCRETE MOWING STRIP

Note width varies.

Surface finish: U5 soft bristled broom finish in general accordance with NZS 3114, ensure the aggregate is not exposed.

Aggregate: 13mm Greywacke.

Oxide: 8% Black 330 Oxide.

All concrete finishes shall be in accordance with NZS 3114:1987.

Control joints: 5mm wide, formed by sawcutting in accordance with the drawings and specifications.

All insitu concrete paving to include control joints, construction joints and expansion joints in accordance with the drawings and specifications to Engineer's approval.

Compaction of subbase to be inspected by Engineer prior to commencement of paving.

SITE FURNITURE, SPECIAL FEATURES AND STRUCTURES

S01 SEAT

Type: Santa & Cole Trapecio Seat.

Manufacturer: Fel Group Street Furniture NZ.

Contact: Jordan Manfield <jordan@felgroup.co.nz>

Size: L 4000mm with back.

Material: Laminated pine, galvanised mild steel frame.

Finish: Resene Furniture and Decking Oil or equal. Refer Data Sheet D503.

Graffiti guard: Graffiti-Guard™ Shearcote Plus.

Fixing: Surface mount to timber decking.

Sub surface mount into concrete paving.

Installation: In accordance with manufacturer's instructions.

Mowing strip: P04 insitu concrete mowing strip 6100 x 1510mm

(minimum 350mm concrete all round seat).

Maintenance: Reapply Resene Furniture and Decking Oil and Graffiti-Guard™ Shearcote Plus every 2 years in accordance with the manufacturer's instructions.

S02 LITTER BIN

Type: Milford Bin.

Manufacturer: Fel Group Street Furniture NZ.

Contact: Jordan Manfield <jordan@felgroup.co.nz>

Size: 100 Litre.

Material: Eucalyptus saligna timber slats with brass fixings,

polished stainless steel lid and lock.

Finish: Resene Furniture and Decking Oil or equal. Refer Data Sheet D503.

Graffiti guard: Graffiti-Guard™ Shearcote Plus.

Fixing: Plant mounted.

Installation: In accordance with manufacturer's instructions.

S03 BOLLARD

Type: HCC RITS D7.7 Timber Bollard.

Installed at 1.5m centres maximum. No chain.

S04 REMOVABLE LOCKABLE BOLLARD

Type: Removable lockable bollard to match HCC RITS D7.7

Timber Bollard.

Installed at 1.5m centres maximum. No chain.

FITNESS TRAIL

STATION 6 EQUIPMENT

FT12 HORIZONTAL LADDER

Type: Proludic Wooden Trim Trail

JPS21S Horizontal Ladder

Supplied and installed by: Playco Equipment Limited.

Contact: David Morrison

<david@playco.co.nz>

FT13 CLIMBING LADDER

Type: Proludic Wooden Trim Trail

JPS22 Climbing Ladder

Supplied and installed by: Playco Equipment Limited.

Contact: David Morrison

<david@playco.co.nz>

SURFACES

PL01 ARTIFICIAL TURF

Type: Urban Windsor.

15mm sand infill.

Supplied and installed by: Lawn & Turf Contracting Limited.

Contact: Mike Glasson

<office@lawnandturf.co.nz>

PL02 BASE COURSE PREPARATION

Type: 100mm GAP20.

Hidden H5 Pinus radiata edge board for fixing of artificial turf.

Supplied and installed by: Lawn & Turf Contracting Limited.

Contact: Mike Glasson

<office@lawnandturf.co.nz>

PL03 SUB SURFACE DRAINAGE

Type: Ø110mm perforated HDPE coil drain with filter sock.

Trench: 300 x 300mm, backfill with 20/40 drainage chip.

Allow to connect the coil drain to the stormwater system.

All works shall comply with the NZ Building Code, NZ Drainage and

Plumbing Act 1978 and all relevant Local Authority by-laws and

regulations.

All plumbing and drainage work shall be undertaken by a plumber

or drain layer, registered under the Building Act 2003.

PL04 PROPLAY PAD

Type: 25mm thickness for a fall height up to 1.6m.

Supplied and installed by: Lawn & Turf Contracting Limited.

Contact: Mike Glasson

<office@lawnandturf.co.nz>

PL09 INSITU CONCRETE EDGE RESTRAINT

200mm wide x 200mm deep 20MPa edge restraint.

Surface finish: U5 soft bristled broom finish in general accordance

with NZS 3114, ensure the aggregate is not exposed.

Aggregate: 13mm Greywacke.

Oxide: 8% Black 330 Oxide.

All concrete finishes shall be in accordance with NZS 3114:1987.

Lay edging true and straight to grade, alignment and level.

Edge restraint shall be finished flush with the adjacent lawn

surface.

NOTES

CONTRACTORS TO VERIFY ALL DIMENSIONS ON SITE PRIOR TO COMMENCING WORK;

CONTRACTORS ARE RESPONSIBLE FOR CONFIRMING THE LOCATION OF ALL UNDERGROUND SERVICES ON SITE PRIOR TO COMMENCING WORK;

FIGURED DIMENSIONS TO BE TAKEN IN PREFERENCE TO SCALED DIMENSIONS.

KEY

REV	DATE	DESCRIPTION
0	02.07.19	ISSUED FOR CONSTRUCTION
1	12.03.21	AS BUILT

CLIENT
Chedworth Properties Ltd

CONSULTANTS

S & L Consultants

Beca

Kendellier Lighting

AS BUILT

GREENHILL PARK AREA M STAGE 13


GENERAL ARRANGEMENT
KEY SHEET AND NOTES

Design	ARo	Scale	Date
Drawn	ARo	NTS	02.07.19
Check	MHu		
Appv'd			

DRAWING NO. REVISION

H18006_130

1

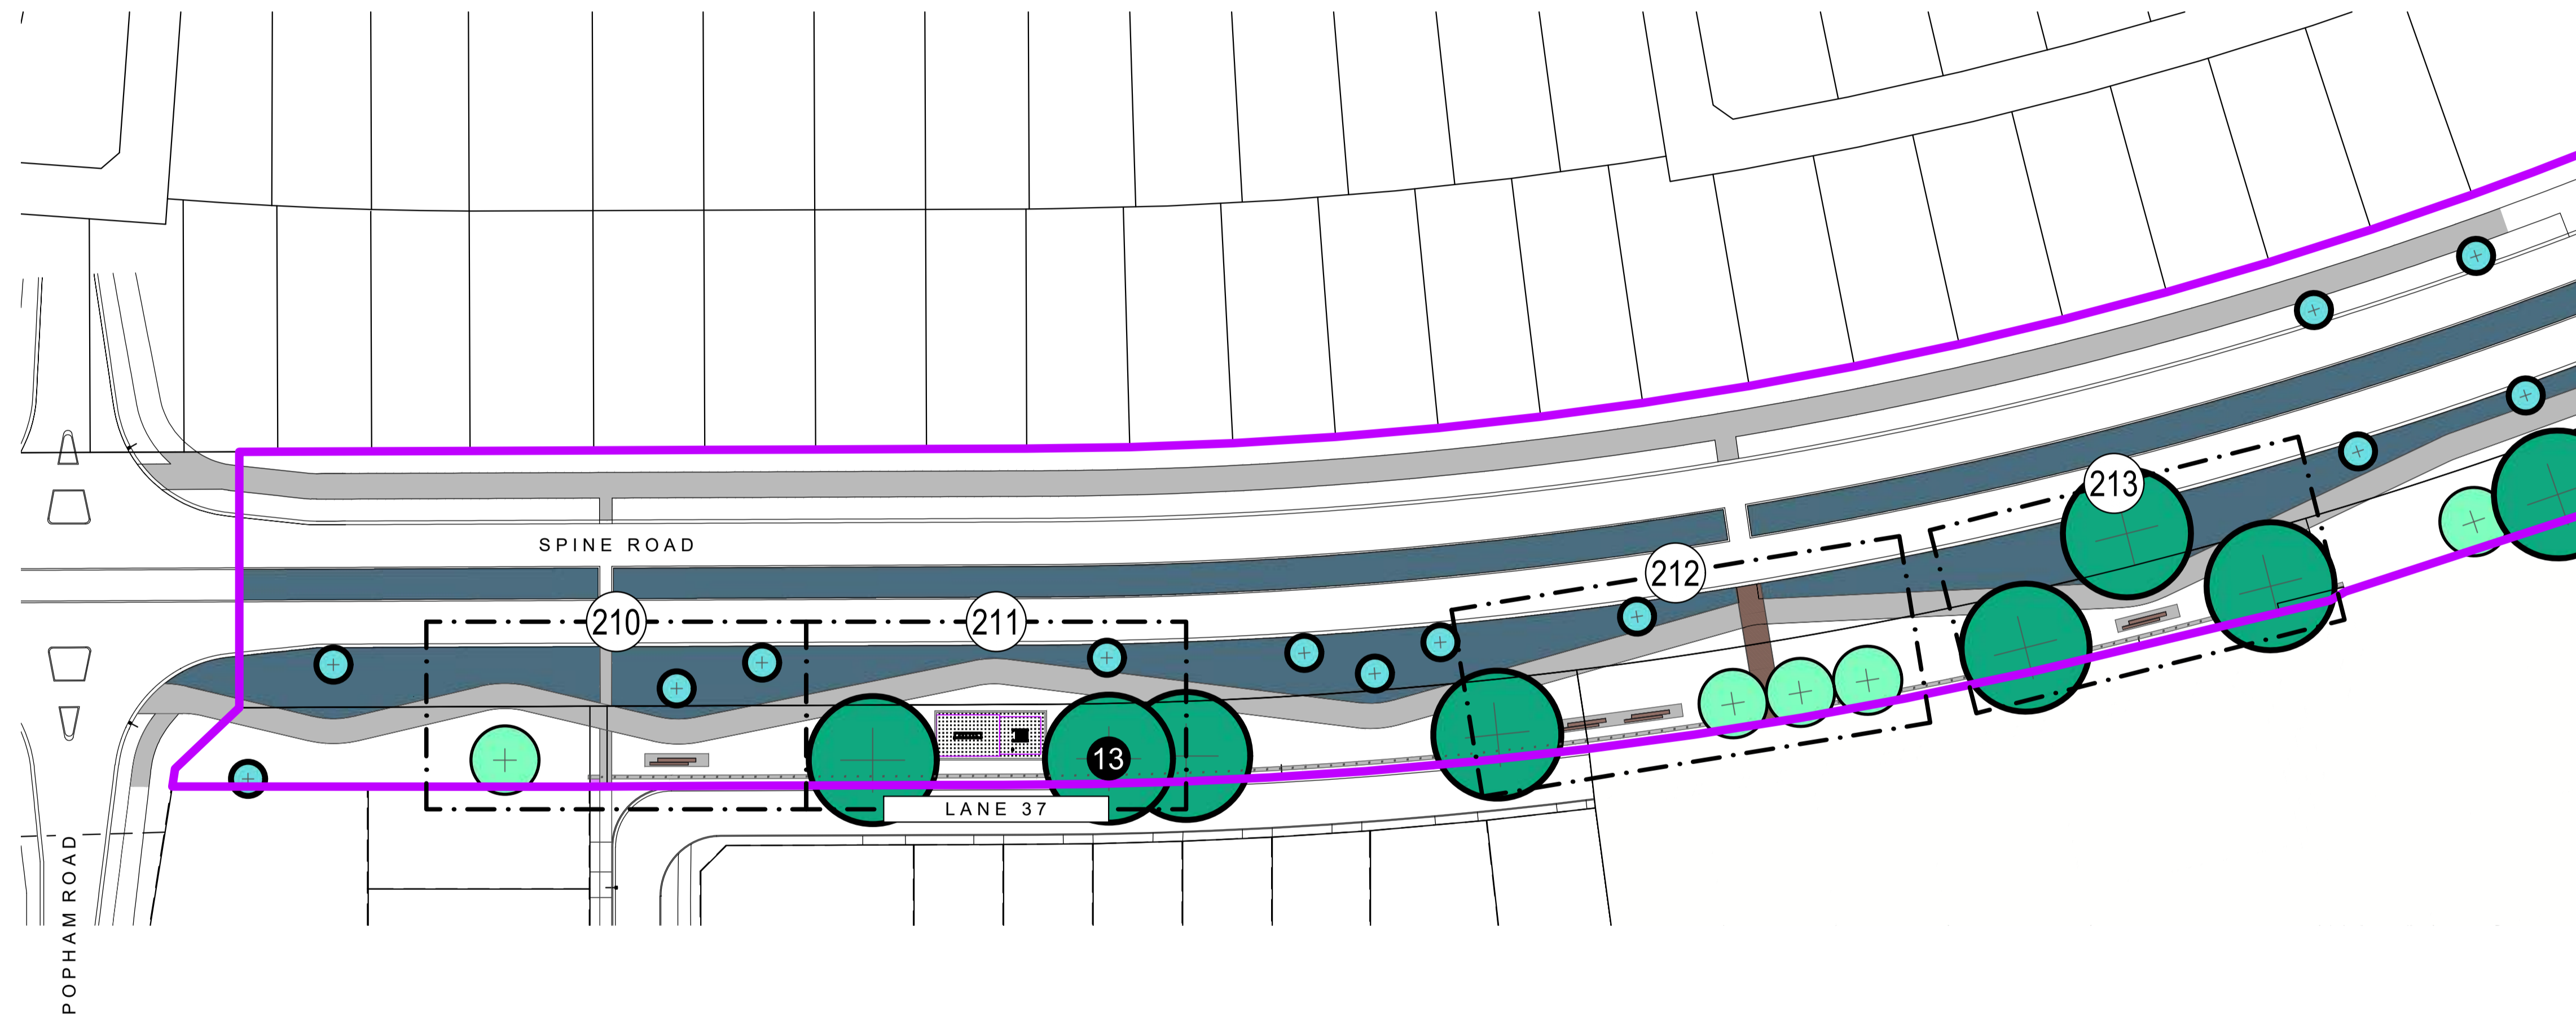

NOTES

CONTRACTORS TO VERIFY ALL DIMENSIONS ON SITE PRIOR TO COMMENCING WORK;
 CONTRACTORS ARE RESPONSIBLE FOR CONFIRMING THE LOCATION OF ALL UNDERGROUND SERVICES ON SITE PRIOR TO COMMENCING WORK;
 FIGURED DIMENSIONS TO BE TAKEN IN PREFERENCE TO SCALED DIMENSIONS.

KEY


REFER TO DRAWING NUMBER H18006_130 GENERAL ARRANGEMENT KEY SHEET AND NOTES
 STAGE 13
 PLANTING
 LAWN

REV	DATE	DESCRIPTION
0	02.07.19	ISSUED FOR CONSTRUCTION
1	31.07.20	PLANTING SUBSTITUTIONS, BACK BERM PLANTING AREAS SUBSTITUTED WITH LAWN
2	12.03.21	AS BUILT

CLIENT
 Chedworth Properties Ltd
 CONSULTANTS
 S & L Consultants
 Beca
 Kendeiler Lighting
AS BUILT

**GREENHILL PARK
 AREA M
 STAGE 13**
 GENERAL ARRANGEMENT
 SHEET LOCATIONS

Design ARo	Scale 1:500 @ A1	Date 02.07.19
Drawn ARo	1:1000 @ A3	
Check MHu		
Appv'd		
DRAWING NO. H18006_200	REVISION 2	

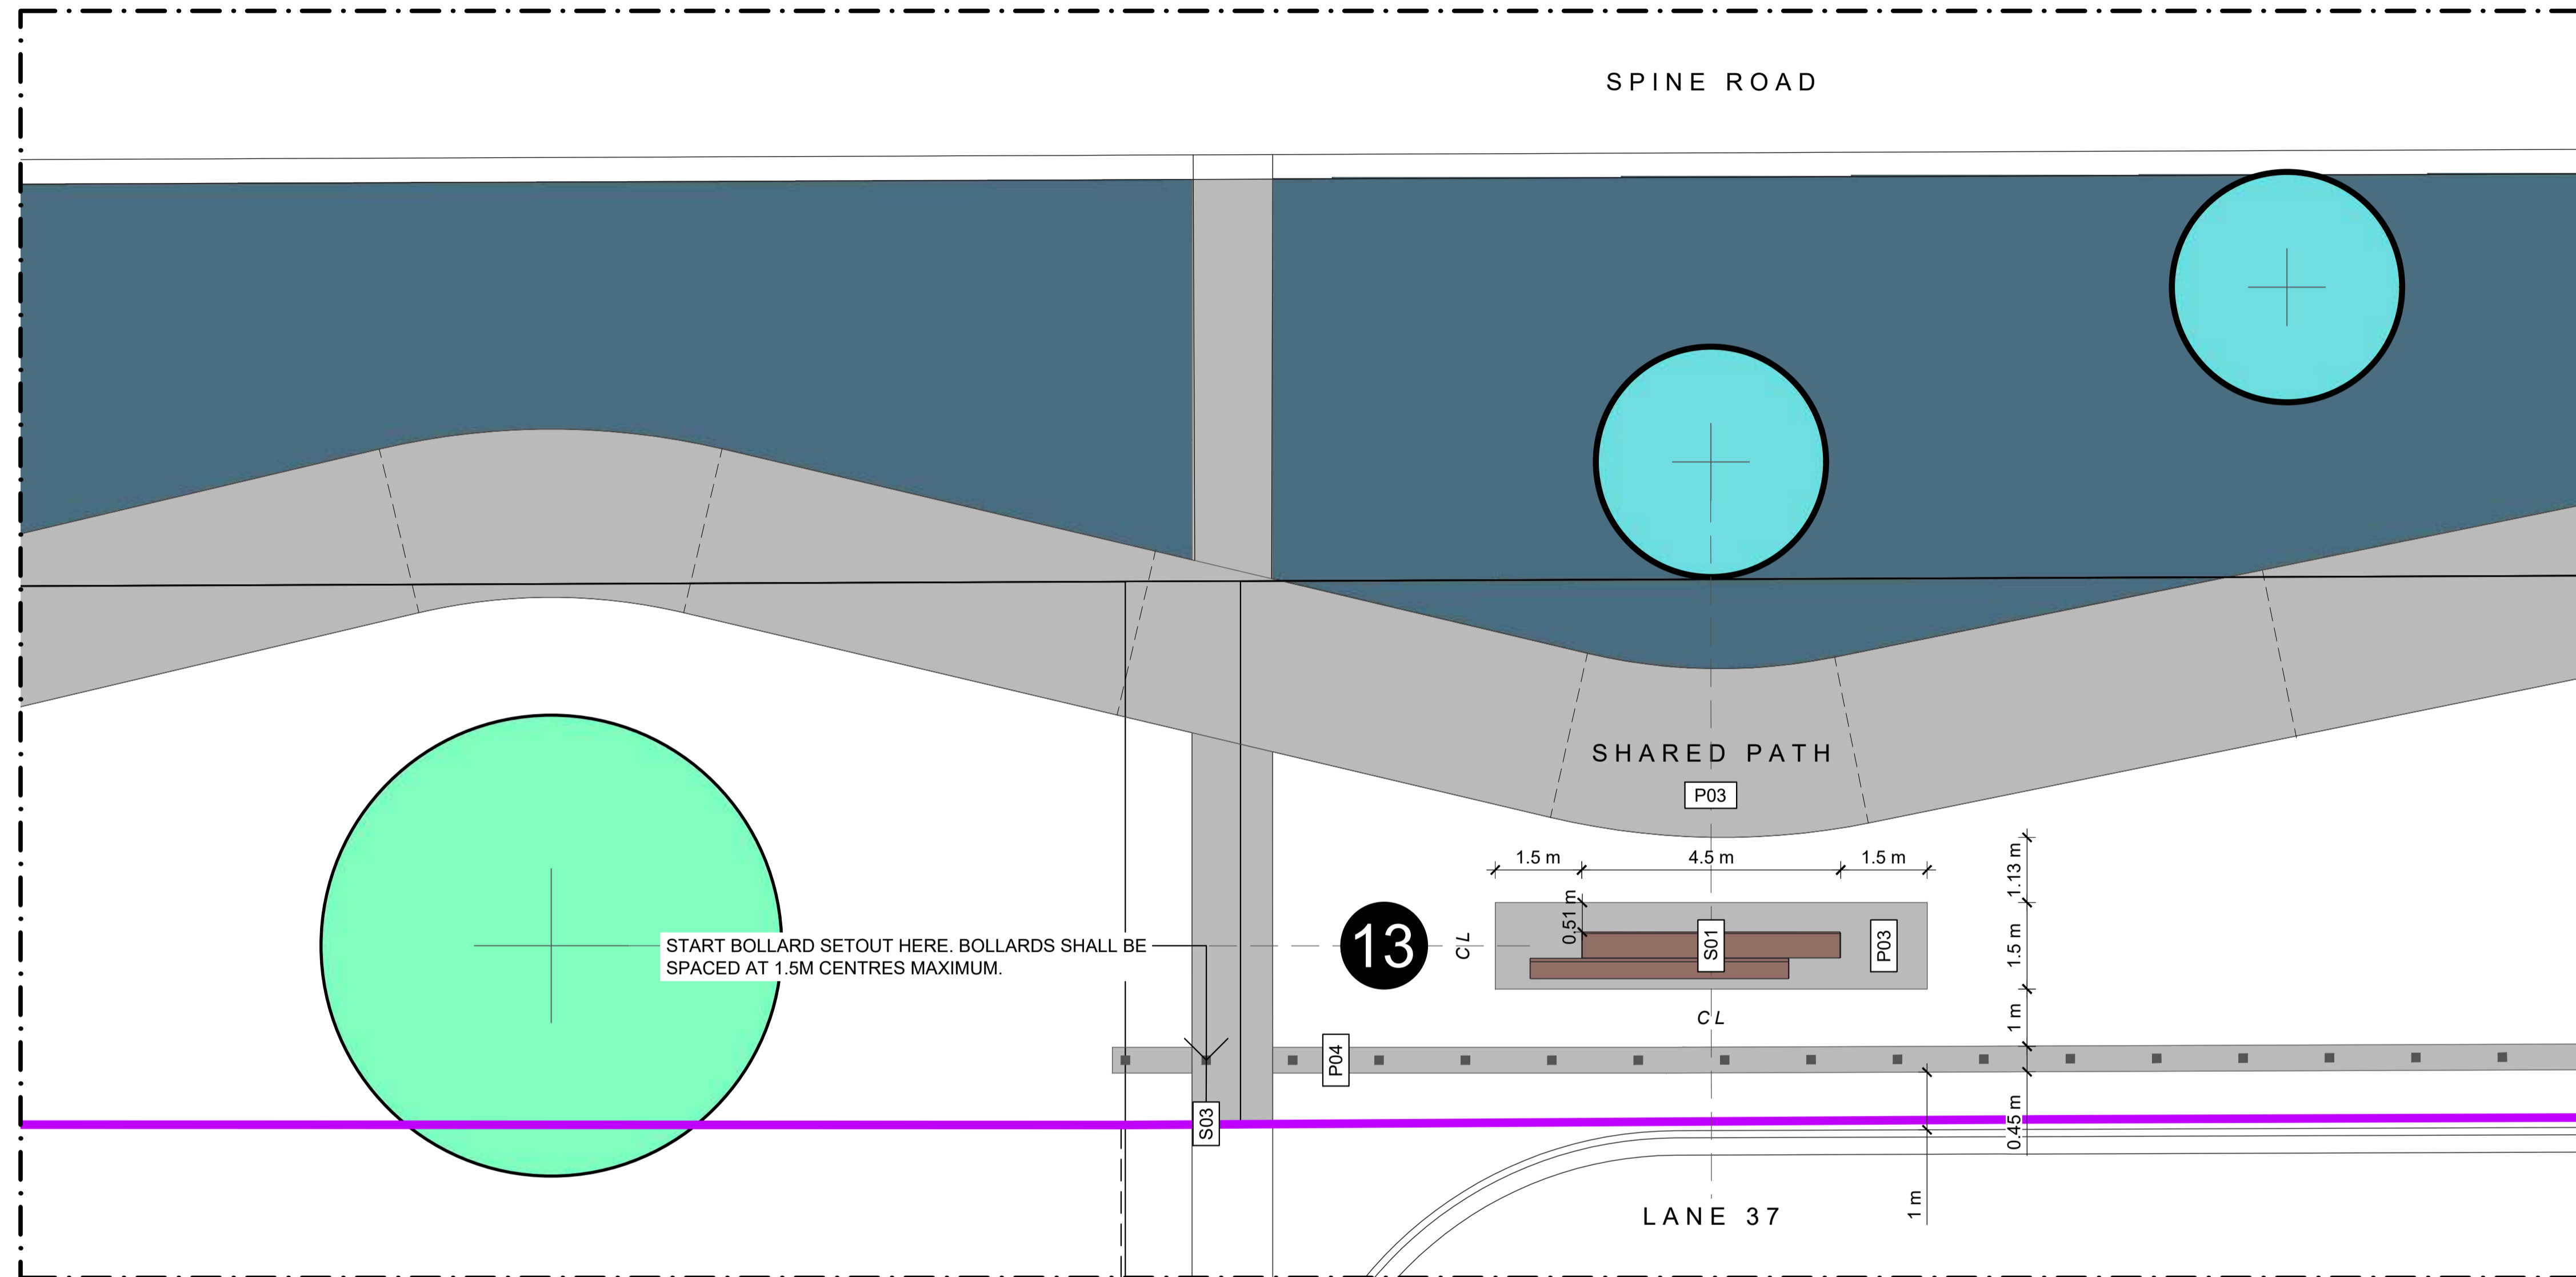

NOTES

ALL SET OUT MUST BE CHECKED AND APPROVED BY THE LANDSCAPE ARCHITECT ON SITE.

THE CONTRACTOR SHALL REQUEST, AND HAVE UNDERTAKEN, AN INSPECTION OF ALL SET OUT PRIOR TO ANY CONCRETE BEING PLACED OR PAVING LAID.

THE CONTRACTOR SHALL REQUEST, AND HAVE UNDERTAKEN, AN INSPECTION OF THE SET OUT OF ALL CONTROL JOINTS PRIOR TO COMMENCING SAW CUTTING.

NOTES

CONTRACTORS TO VERIFY ALL DIMENSIONS ON SITE PRIOR TO COMMENCING WORK;

CONTRACTORS ARE RESPONSIBLE FOR CONFIRMING THE LOCATION OF ALL UNDERGROUND SERVICES ON SITE PRIOR TO COMMENCING WORK;

FIGURED DIMENSIONS TO BE TAKEN IN PREFERENCE TO SCALED DIMENSIONS.

KEY

REFER TO DRAWING NUMBER H18006_130 GENERAL ARRANGEMENT KEY SHEET AND NOTES

- 13 PARK 13
- CONCRETE CONTROL JOINTS
- PLANTING
- LAWN

REV	DATE	DESCRIPTION
0	02.07.19	ISSUED FOR CONSTRUCTION
1	12.03.21	AS BUILT

CLIENT
Chedworth Properties Ltd

CONSULTANTS
S & L Consultants
Beca
Kendellier Lighting

AS BUILT

**GREENHILL PARK
AREA M
STAGE 13**

GENERAL ARRANGEMENT
SHEET 01 OF 04


Design	ARo	Scale	Date
Drawn	ARo	1:75 @ A1	02.07.19
Check	MHu	1:150 @ A3	
App'd			

DRAWING NO. REVISION


H18006_210 1

NOTES

ALL SET OUT MUST BE CHECKED AND APPROVED BY THE LANDSCAPE ARCHITECT ON SITE PRIOR TO ANY CONCRETE BEING PLACED. ALL FITNESS EQUIPMENT SHALL BE INSTALLED IN ACCORDANCE WITH THE MANUFACTURER'S INSTRUCTIONS.

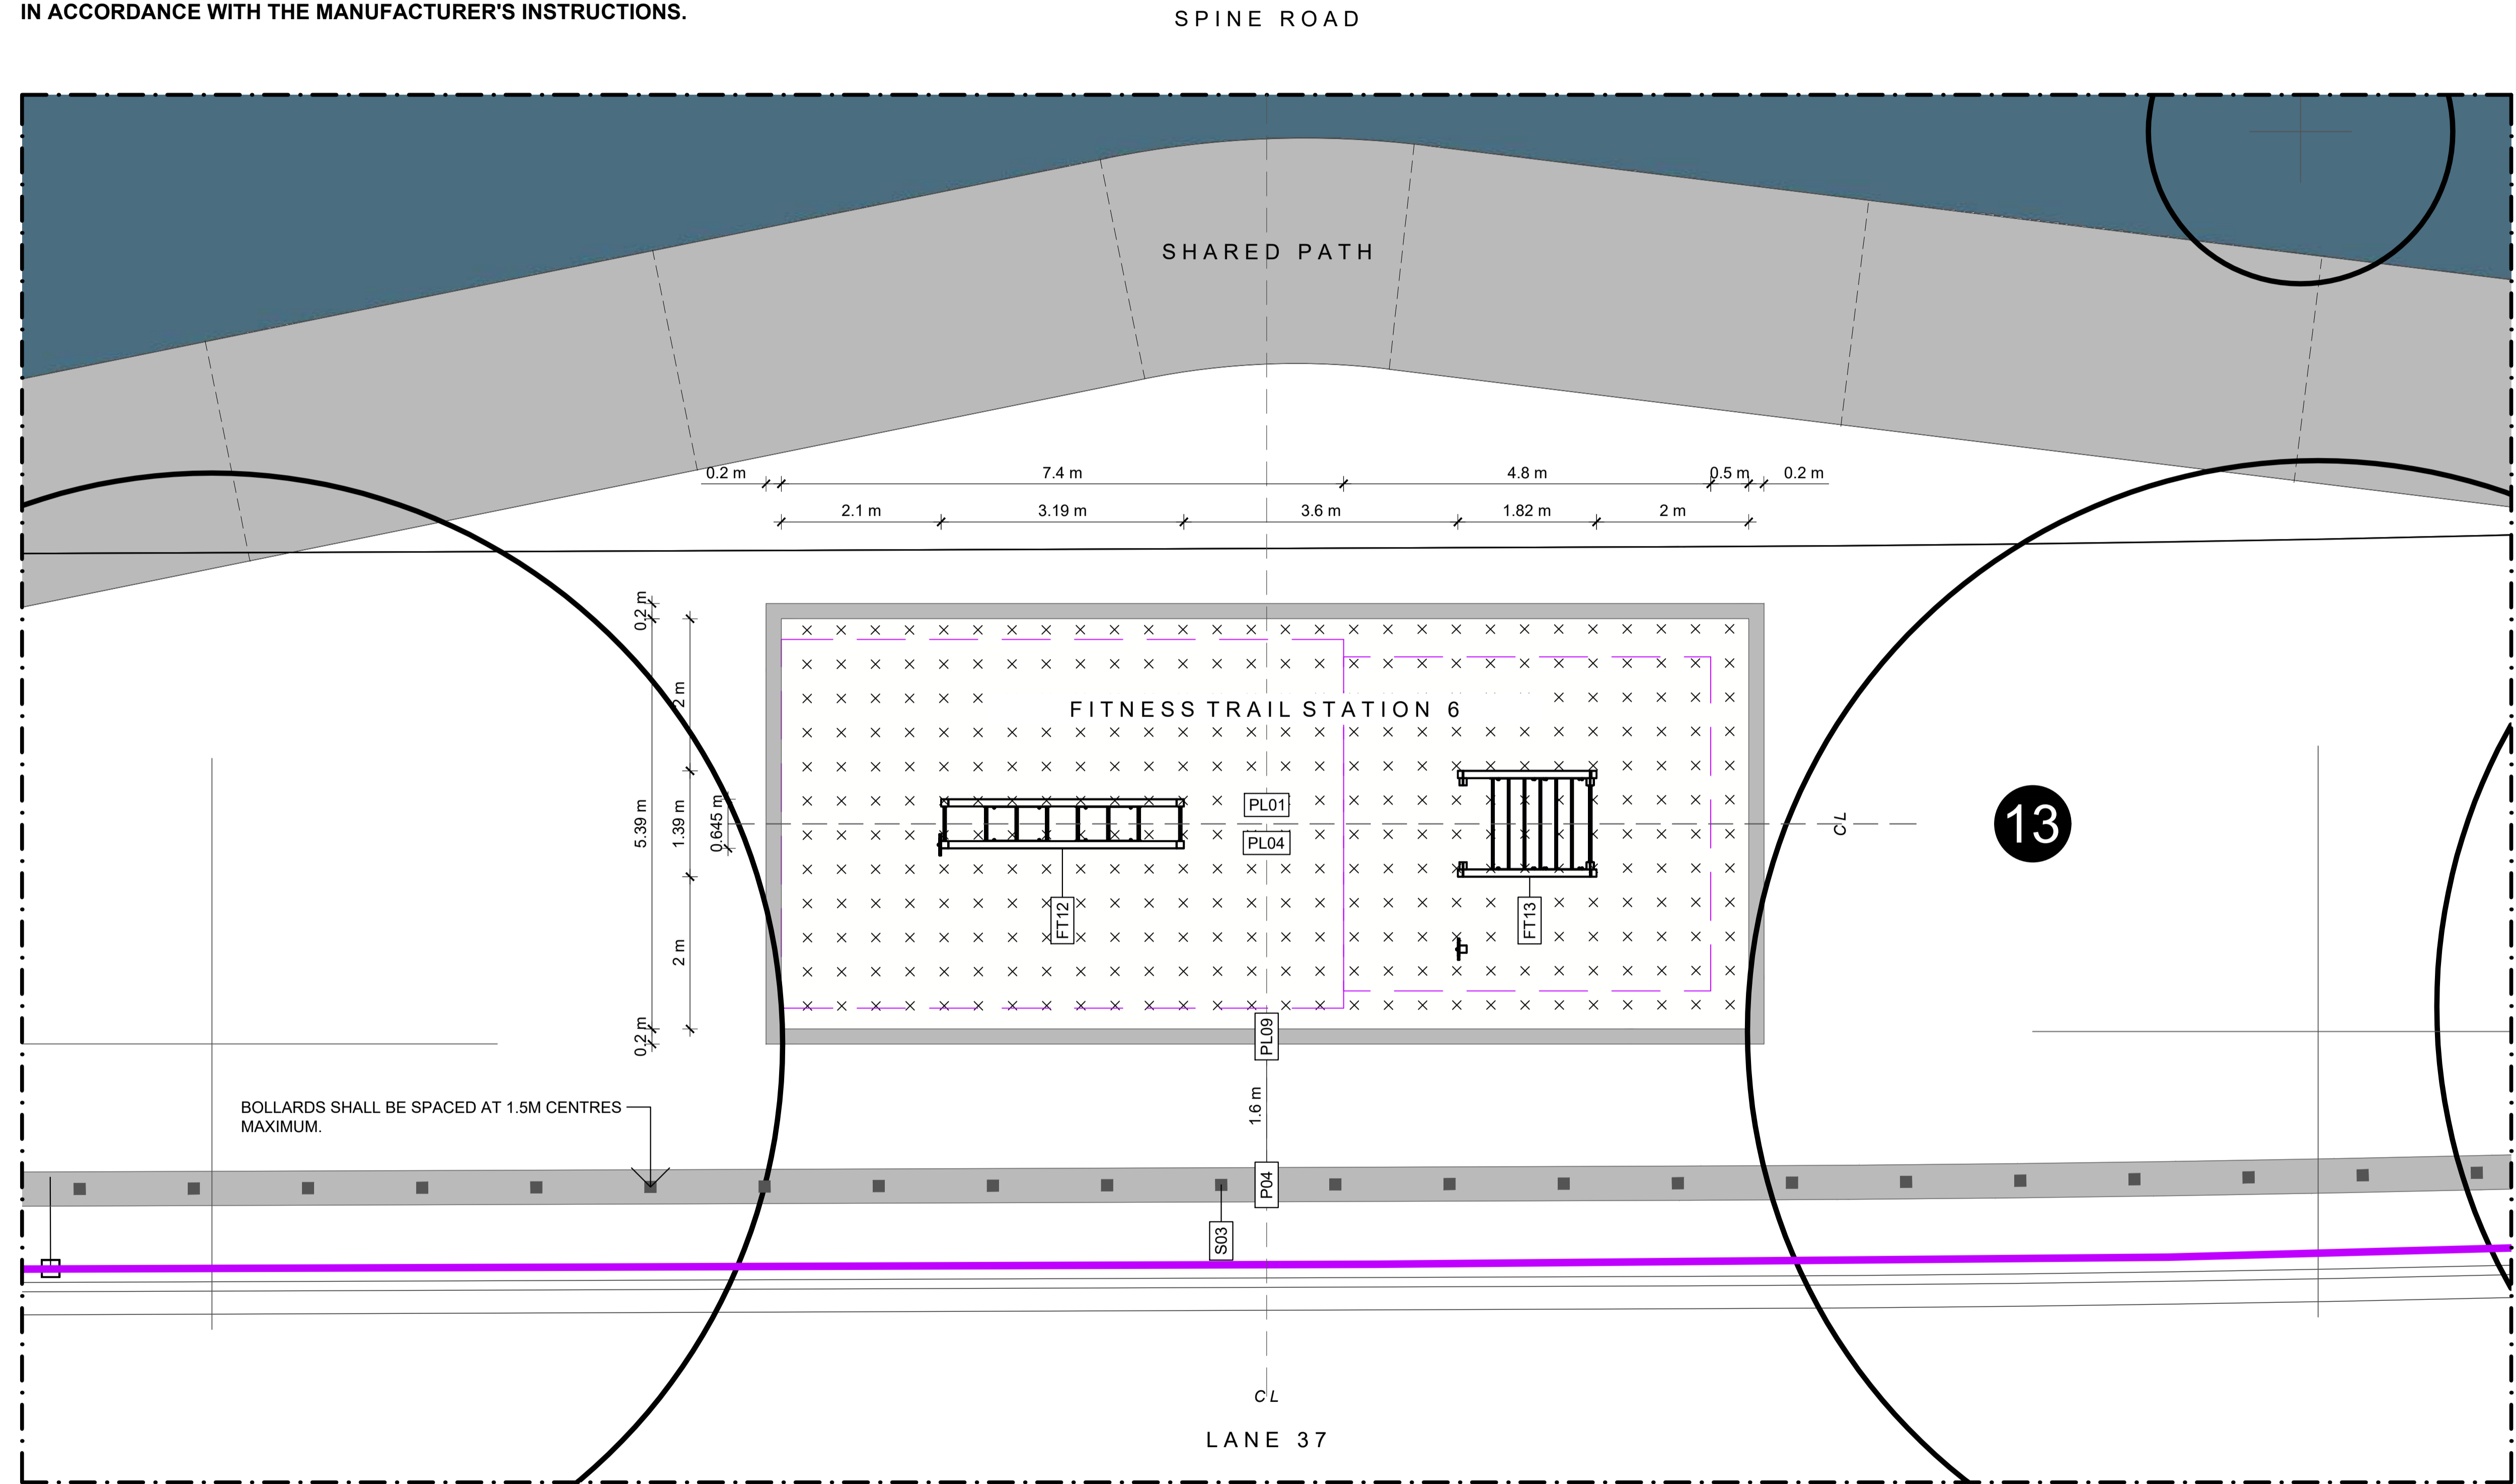

01 211 DETAIL | GENERAL ARRANGEMENT | FITNESS STATION 6
Scale: 1:50 @ A1 1:100 @ A3

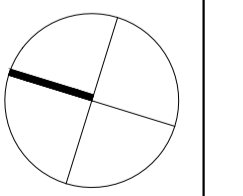

Boffa Miskell Limited
Level 3, SouthBloc
19 Knox Street
PO Box 1094, Hamilton 3240, New Zealand
Tel: +64 7 960 0006
www.boffamiskell.co.nz

NOTES

CONTRACTORS TO VERIFY ALL DIMENSIONS ON SITE PRIOR TO COMMENCING WORK;
CONTRACTORS ARE RESPONSIBLE FOR CONFIRMING THE LOCATION OF ALL UNDERGROUND SERVICES ON SITE PRIOR TO COMMENCING WORK;
FIGURED DIMENSIONS TO BE TAKEN IN PREFERENCE TO SCALED DIMENSIONS.

KEY

- REFER TO DRAWING NUMBER H18006_130 GENERAL ARRANGEMENT KEY SHEET AND NOTES
- 13 PARK 13
- CONCRETE CONTROL JOINTS
- PLANTING
- LAWN

REV	DATE	DESCRIPTION
0	02.07.19	ISSUED FOR CONSTRUCTION
1	12.03.21	AS BUILT

CLIENT
Chedworth Properties Ltd

CONSULTANTS
S & L Consultants
Beca
Kendellier Lighting


AS BUILT

GREENHILL PARK
AREA M
STAGE 13

GENERAL ARRANGEMENT
SHEET 02 OF 04

Design	ARo	Scale	Date
Drawn	ARo	As shown	02.07.19
Check	MHu		
App'd			

DRAWING NO.	REVISION
H18006_211	1

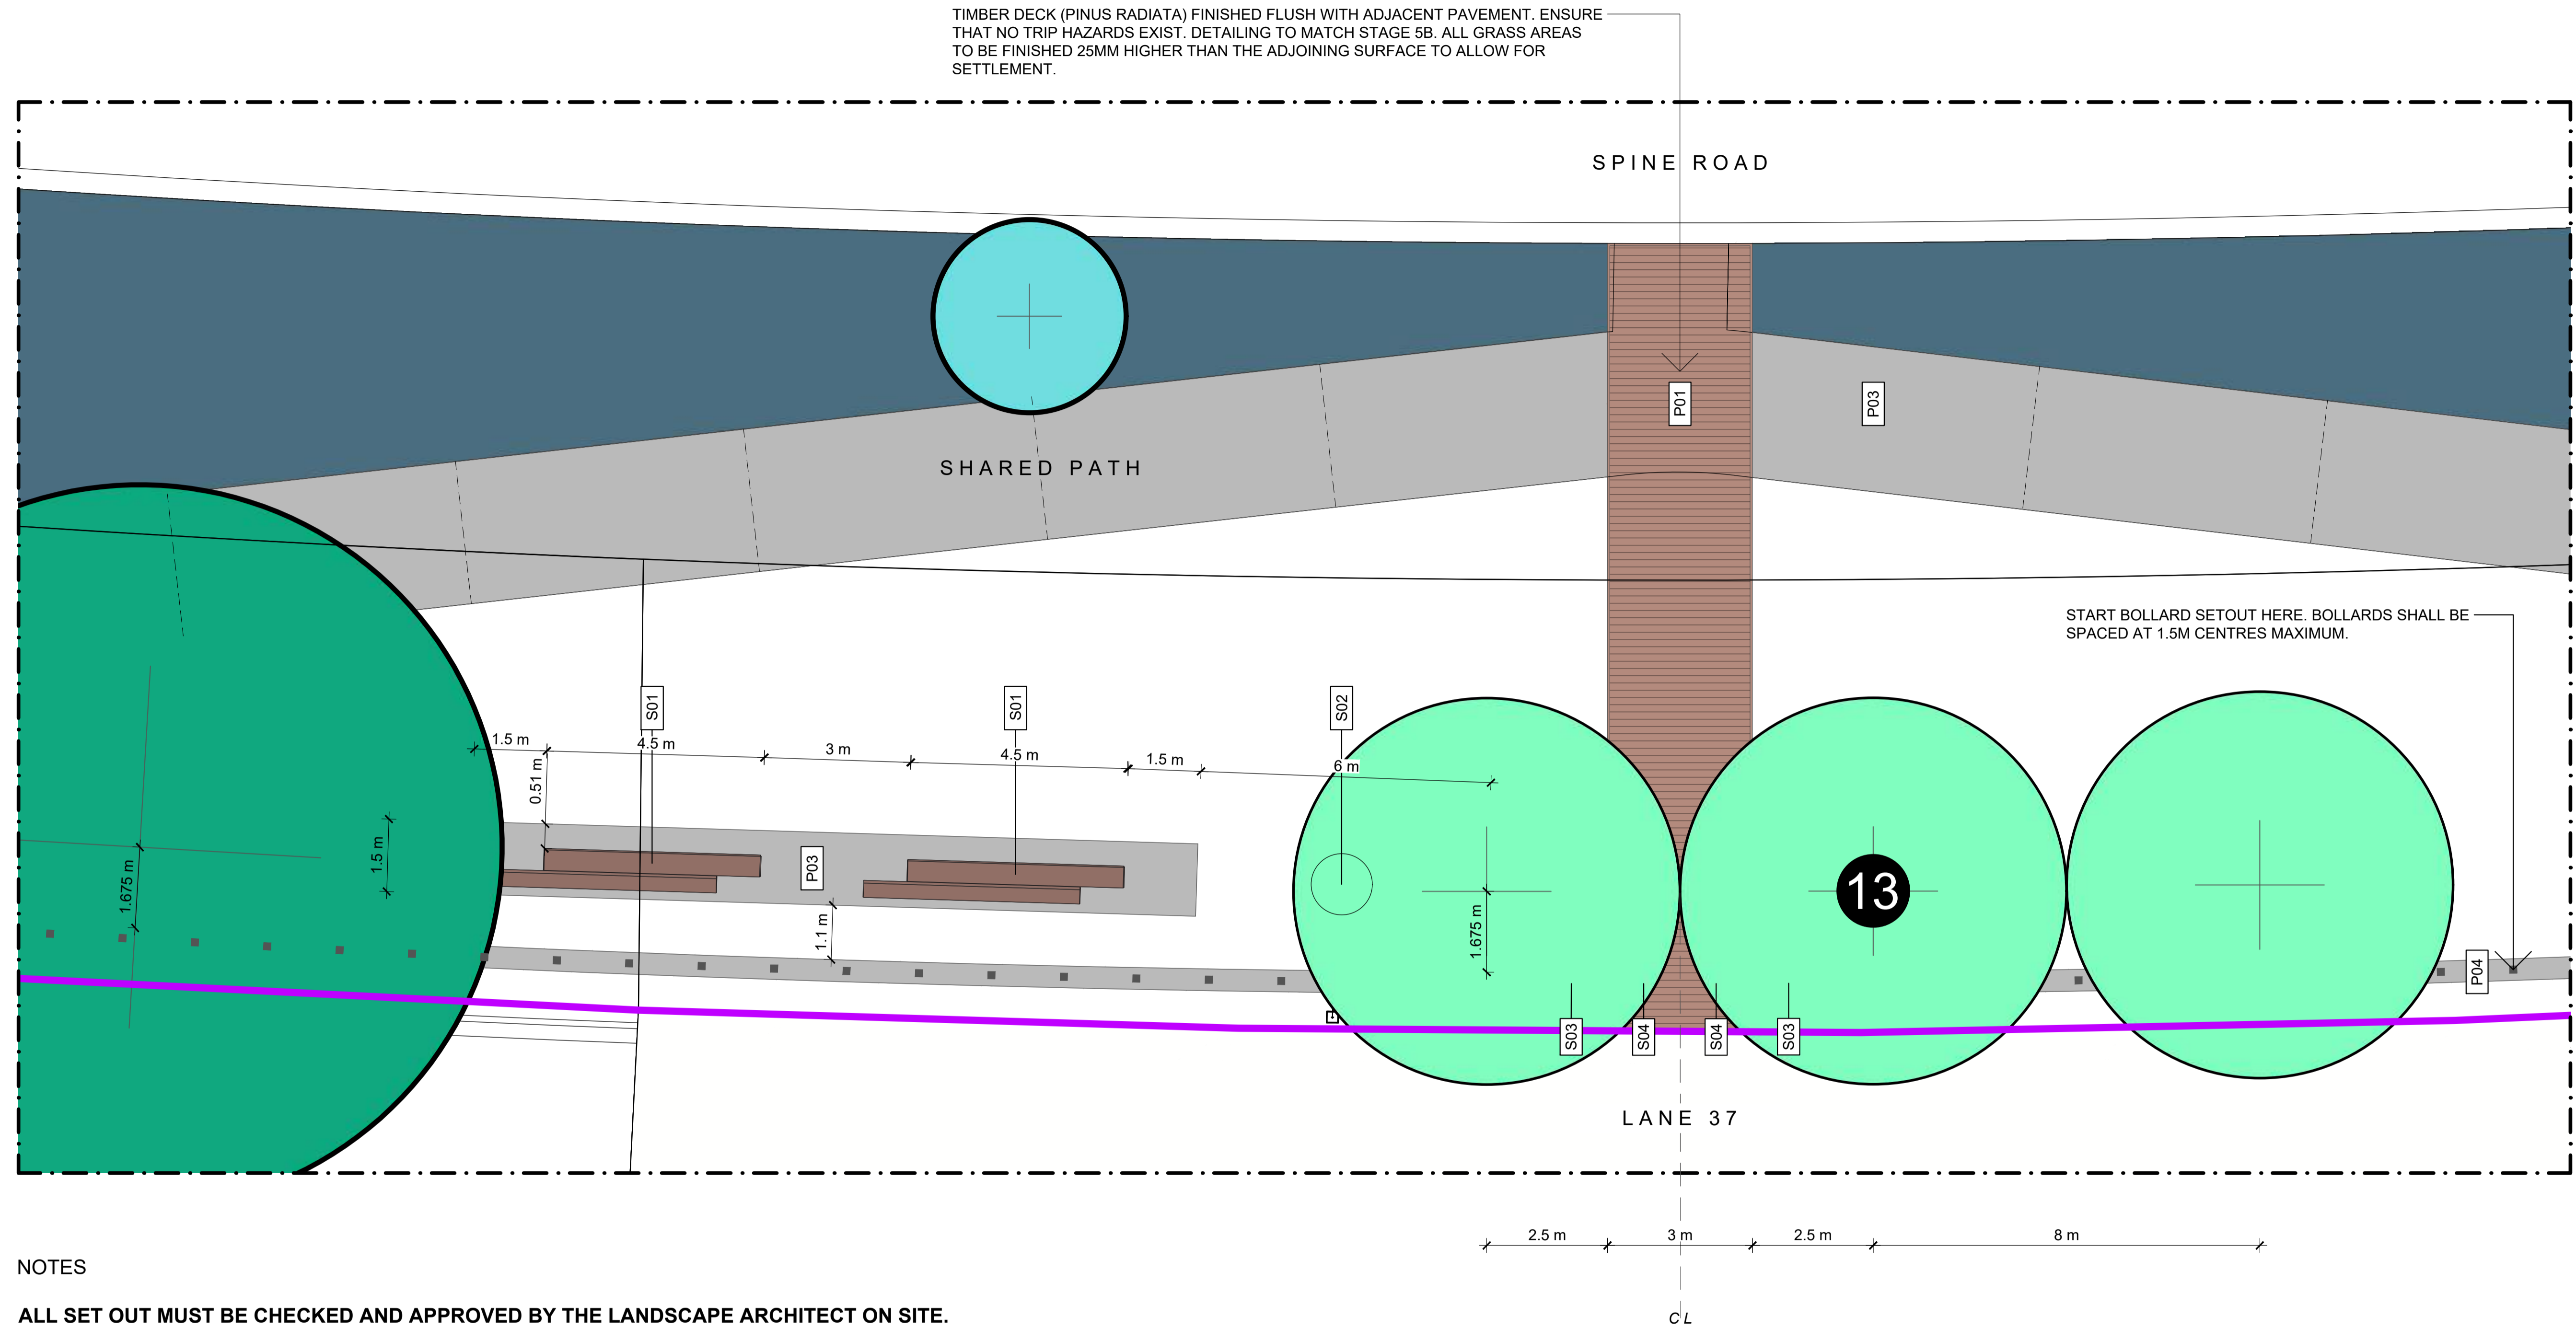

NOTES

ALL SET OUT MUST BE CHECKED AND APPROVED BY THE LANDSCAPE ARCHITECT ON SITE.

THE CONTRACTOR SHALL REQUEST, AND HAVE UNDERTAKEN, AN INSPECTION OF ALL SET OUT PRIOR TO ANY CONCRETE BEING PLACED OR PAVING LAID.

THE CONTRACTOR SHALL REQUEST, AND HAVE UNDERTAKEN, AN INSPECTION OF THE SET OUT OF ALL CONTROL JOINTS PRIOR TO COMMENCING SAW CUTTING.



Boffa Miskell Limited
Level 3, SouthBloc
19 Knox Street
PO Box 1094, Hamilton 3240, New Zealand
Tel: +64 7 960 0006
www.boffamiskell.co.nz

NOTES

CONTRACTORS TO VERIFY ALL DIMENSIONS ON SITE PRIOR TO COMMENCING WORK;

CONTRACTORS ARE RESPONSIBLE FOR CONFIRMING THE LOCATION OF ALL UNDERGROUND SERVICES ON SITE PRIOR TO COMMENCING WORK;

FIGURED DIMENSIONS TO BE TAKEN IN PREFERENCE TO SCALED DIMENSIONS.

KEY

REFER TO DRAWING NUMBER H18006_130 GENERAL ARRANGEMENT KEY SHEET AND NOTES

- 13 PARK 13
- CONCRETE CONTROL JOINTS
- PLANTING
- LAWN

REV	DATE	DESCRIPTION
0	02.07.19	ISSUED FOR CONSTRUCTION
1	12.03.21	AS BUILT

CLIENT
Chedworth Properties Ltd

CONSULTANTS
S & L Consultants
Beca
Kendellier Lighting


AS BUILT

**GREENHILL PARK
AREA M
STAGE 13**

GENERAL ARRANGEMENT
SHEET 03 OF 04

Design	ARo	Scale	Date
Drawn	ARo	1:75 @ A1	02.07.19
Check	MHu	1:150 @ A3	
Appr'd			

DRAWING NO. **H18006_212** REVISION **1**

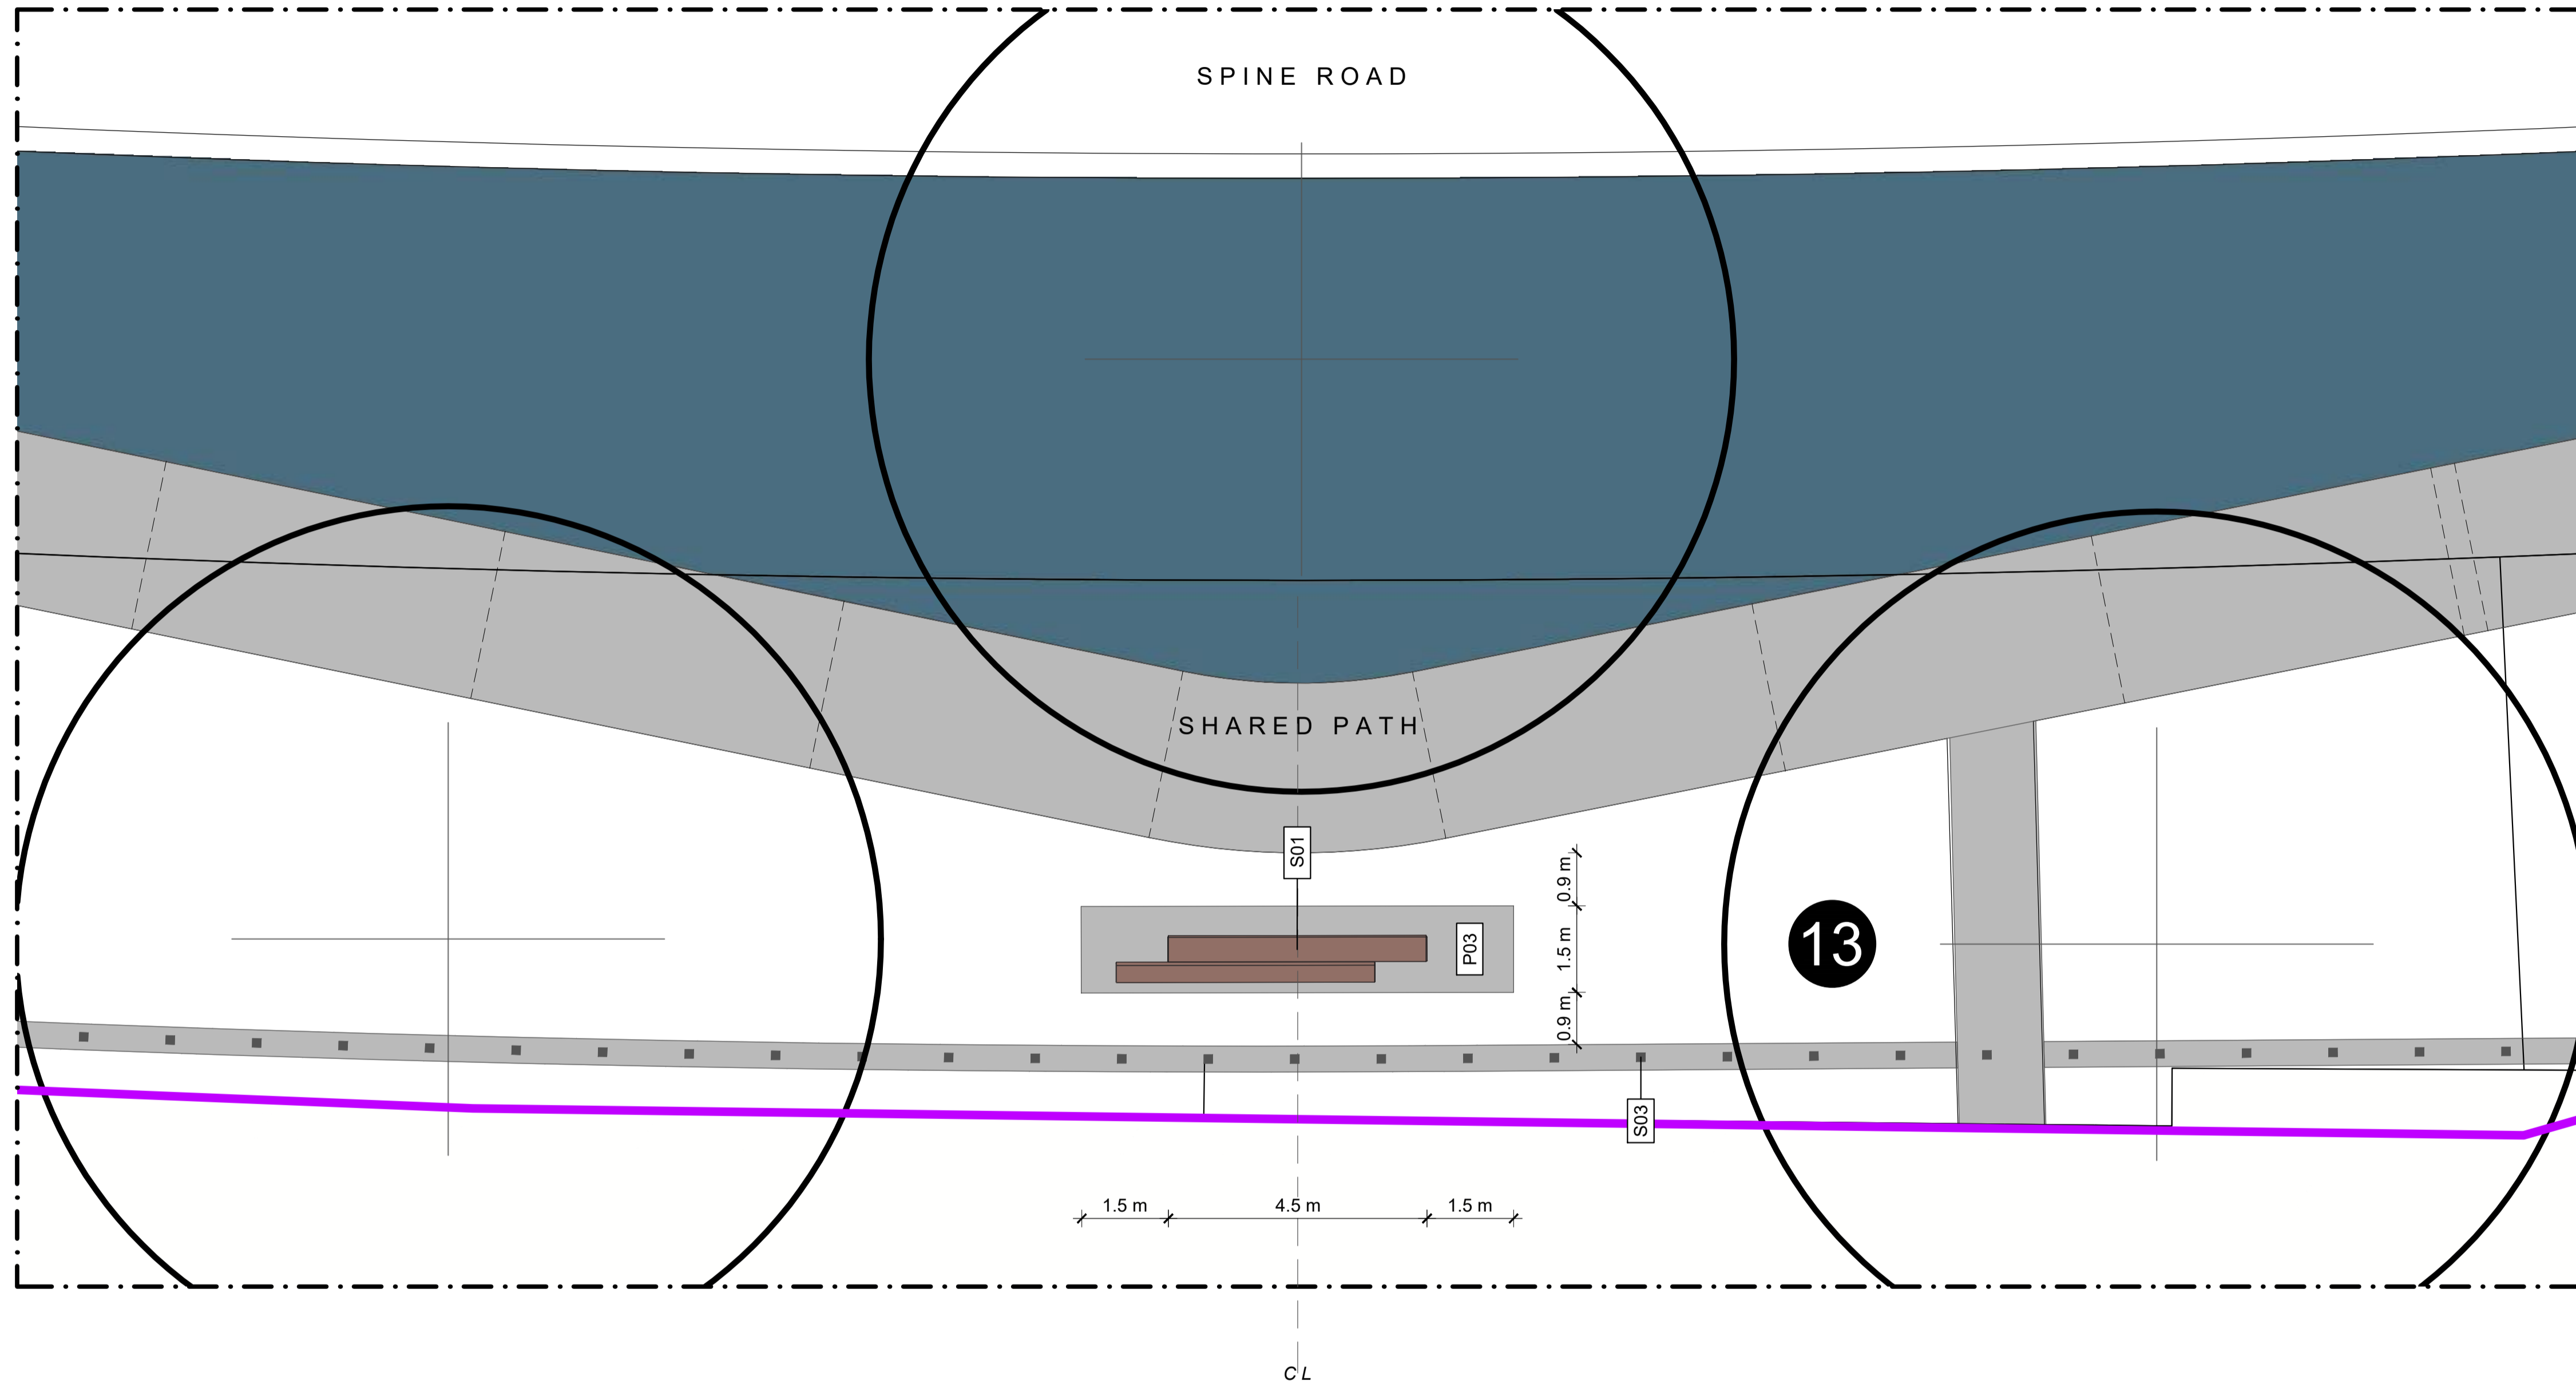


NOTES

ALL SET OUT MUST BE CHECKED AND APPROVED BY THE LANDSCAPE ARCHITECT ON SITE.

THE CONTRACTOR SHALL REQUEST, AND HAVE UNDERTAKEN, AN INSPECTION OF ALL SET OUT PRIOR TO ANY CONCRETE BEING PLACED OR PAVING LAID.

THE CONTRACTOR SHALL REQUEST, AND HAVE UNDERTAKEN, AN INSPECTION OF THE SET OUT OF ALL CONTROL JOINTS PRIOR TO COMMENCING SAW CUTTING.

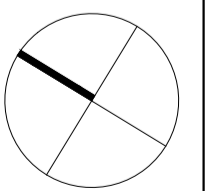

Boffa Miskell Limited
Level 3, SouthBloc
19 Knox Street
PO Box 1094, Hamilton 3240, New Zealand
Tel: +64 7 960 0006
www.boffamiskell.co.nz

NOTES

CONTRACTORS TO VERIFY ALL DIMENSIONS ON SITE PRIOR TO COMMENCING WORK;

CONTRACTORS ARE RESPONSIBLE FOR CONFIRMING THE LOCATION OF ALL UNDERGROUND SERVICES ON SITE PRIOR TO COMMENCING WORK;

FIGURED DIMENSIONS TO BE TAKEN IN PREFERENCE TO SCALED DIMENSIONS.

KEY

REFER TO DRAWING NUMBER H18006_130 GENERAL ARRANGEMENT KEY SHEET AND NOTES

- 13 PARK 13
- CONCRETE CONTROL JOINTS
- PLANTING
- LAWN

REV	DATE	DESCRIPTION
0	02.07.19	ISSUED FOR CONSTRUCTION
1	12.03.21	AS BUILT

CLIENT
Chedworth Properties Ltd

CONSULTANTS
S & L Consultants
Beca
Kendellier Lighting

AS BUILT

**GREENHILL PARK
AREA M
STAGE 13**

GENERAL ARRANGEMENT
SHEET 04 OF 04

Design	ARo	Scale	Date
Drawn	ARo	1:75 @ A1	02.07.19
Check	MHu	1:150 @ A3	
Appv'd			

DRAWING NO. REVISION

H18006_213 1

GENERAL NOTES

All drawings shall be read in conjunction with the landscape specifications.

Drawings not to be scaled, use dimensioned measurements only.

Setout to be checked and approved by the Landscape Architect on site.

SOFT LANDSCAPE NOTES

All trees to be inspected and approved by the Landscape Architect prior to delivery to site.

Planting numbers are indicative. Contractor to ensure sufficient stock to achieve the specified planting densities.

All areas of amenity planting and berm planting to be mulched in accordance with the specifications and drawings.

Refer to specifications for requirements on the preparation of planting and grass areas.

PLANT LAYOUT

PLANT SPECIES UP TO 0.5M HIGH AT MATURITY

The Contractor shall ensure the planting pit is setback 0.45m (minimum) from the edge of all footpaths and road edges.

PLANT SPECIES 0.5M HIGH OR GREATER AT MATURITY

The Contractor shall ensure the planting pit is setback 1m (minimum) from the edge of all footpaths and road edges.

Planting Schedule				
Spine Road				
Botanical Name	Common Name	Size	Centres (m)	Quantity
Specimen Trees				
<i>Fagus sylvatica</i>	European beech	100-180L	As shown	1
<i>Knightia excelsa</i>	revarewa	100-180L	As shown	17
Berm Planting				
<i>Carex dipsacea</i>	teasel sedge	1L	0.5	1,930
<i>Carex testacea</i>	orange sedge	1L	0.5	586
<i>Libertia grandiflora</i>	mikoiko, New Zealand iris	1L	0.5	2,108
<i>Libertia ixioides</i>	mikoiko, New Zealand iris	1L	0.5	635
<i>Lomandra lahika</i>	lahika	1L	0.75	697
<i>Phormium 'Pepe'</i>	flax cultivar	1L	0.5	266
Planting Area				2,810 m ²
Mulch				281 m ³
Collector Road				
Botanical Name	Common Name	Size	Centres (m)	Quantity
Specimen Trees				
<i>Fagus sylvatica</i>	European beech	100-180L	As shown	2
<i>Quercus robur</i>	English oak	100-180L	As shown	5
Berm Planting				
<i>Carex dipsacea</i>	teasel sedge	1L	0.5	385
<i>Phormium 'Pepe'</i>	flax cultivar	1L	0.5	137
Planting Area				275 m ²
Mulch				27.5 m ³
Recreation Reserve				
Botanical Name	Common Name	Size	Centres (m)	Quantity
Specimen Trees				
<i>Fagus sylvatica</i>	European beech	100-180L	As shown	8
<i>Magnolia soulangeana x liliiflora 'Gene'</i>	magnolia	100-180L	As shown	1
<i>Prunus yedoensis 'Awanui'</i>	flowering cherry	100-180L	As shown	5



Boffa Miskell Limited
 Level 3, SouthBloc
 19 Knox Street
 PO Box 1094, Hamilton 3240, New Zealand
 Tel: +64 7 960 0006
 www.boffamiskell.co.nz

NOTES

CONTRACTORS TO VERIFY ALL DIMENSIONS ON SITE PRIOR TO COMMENCING WORK;

CONTRACTORS ARE RESPONSIBLE FOR CONFIRMING THE LOCATION OF ALL UNDERGROUND SERVICES ON SITE PRIOR TO COMMENCING WORK;

FIGURED DIMENSIONS TO BE TAKEN IN PREFERENCE TO SCALED DIMENSIONS.

KEY

REV	DATE	DESCRIPTION
0	02.07.19	ISSUED FOR CONSTRUCTION
1	31.07.20	PLANTING SUBSTITUTIONS, BACK BERM PLANTING AREAS SUBSTITUTED WITH LAWN
2	12.03.21	AS BUILT

CLIENT
 Chedworth Properties Ltd

CONSULTANTS
 S & L Consultants
 Beca
 Kendeiler Lighting

AS BUILT

**GREENHILL PARK
 AREA M
 STAGE 13**


PLANTING SCHEDULE
 GENERAL ARRANGEMENT NOTES

Design ARo	Scale NTS	Date 02.07.19
Drawn ARo		
Check MHu		
App'd		

DRAWING NO. REVISION

H18006_500

2

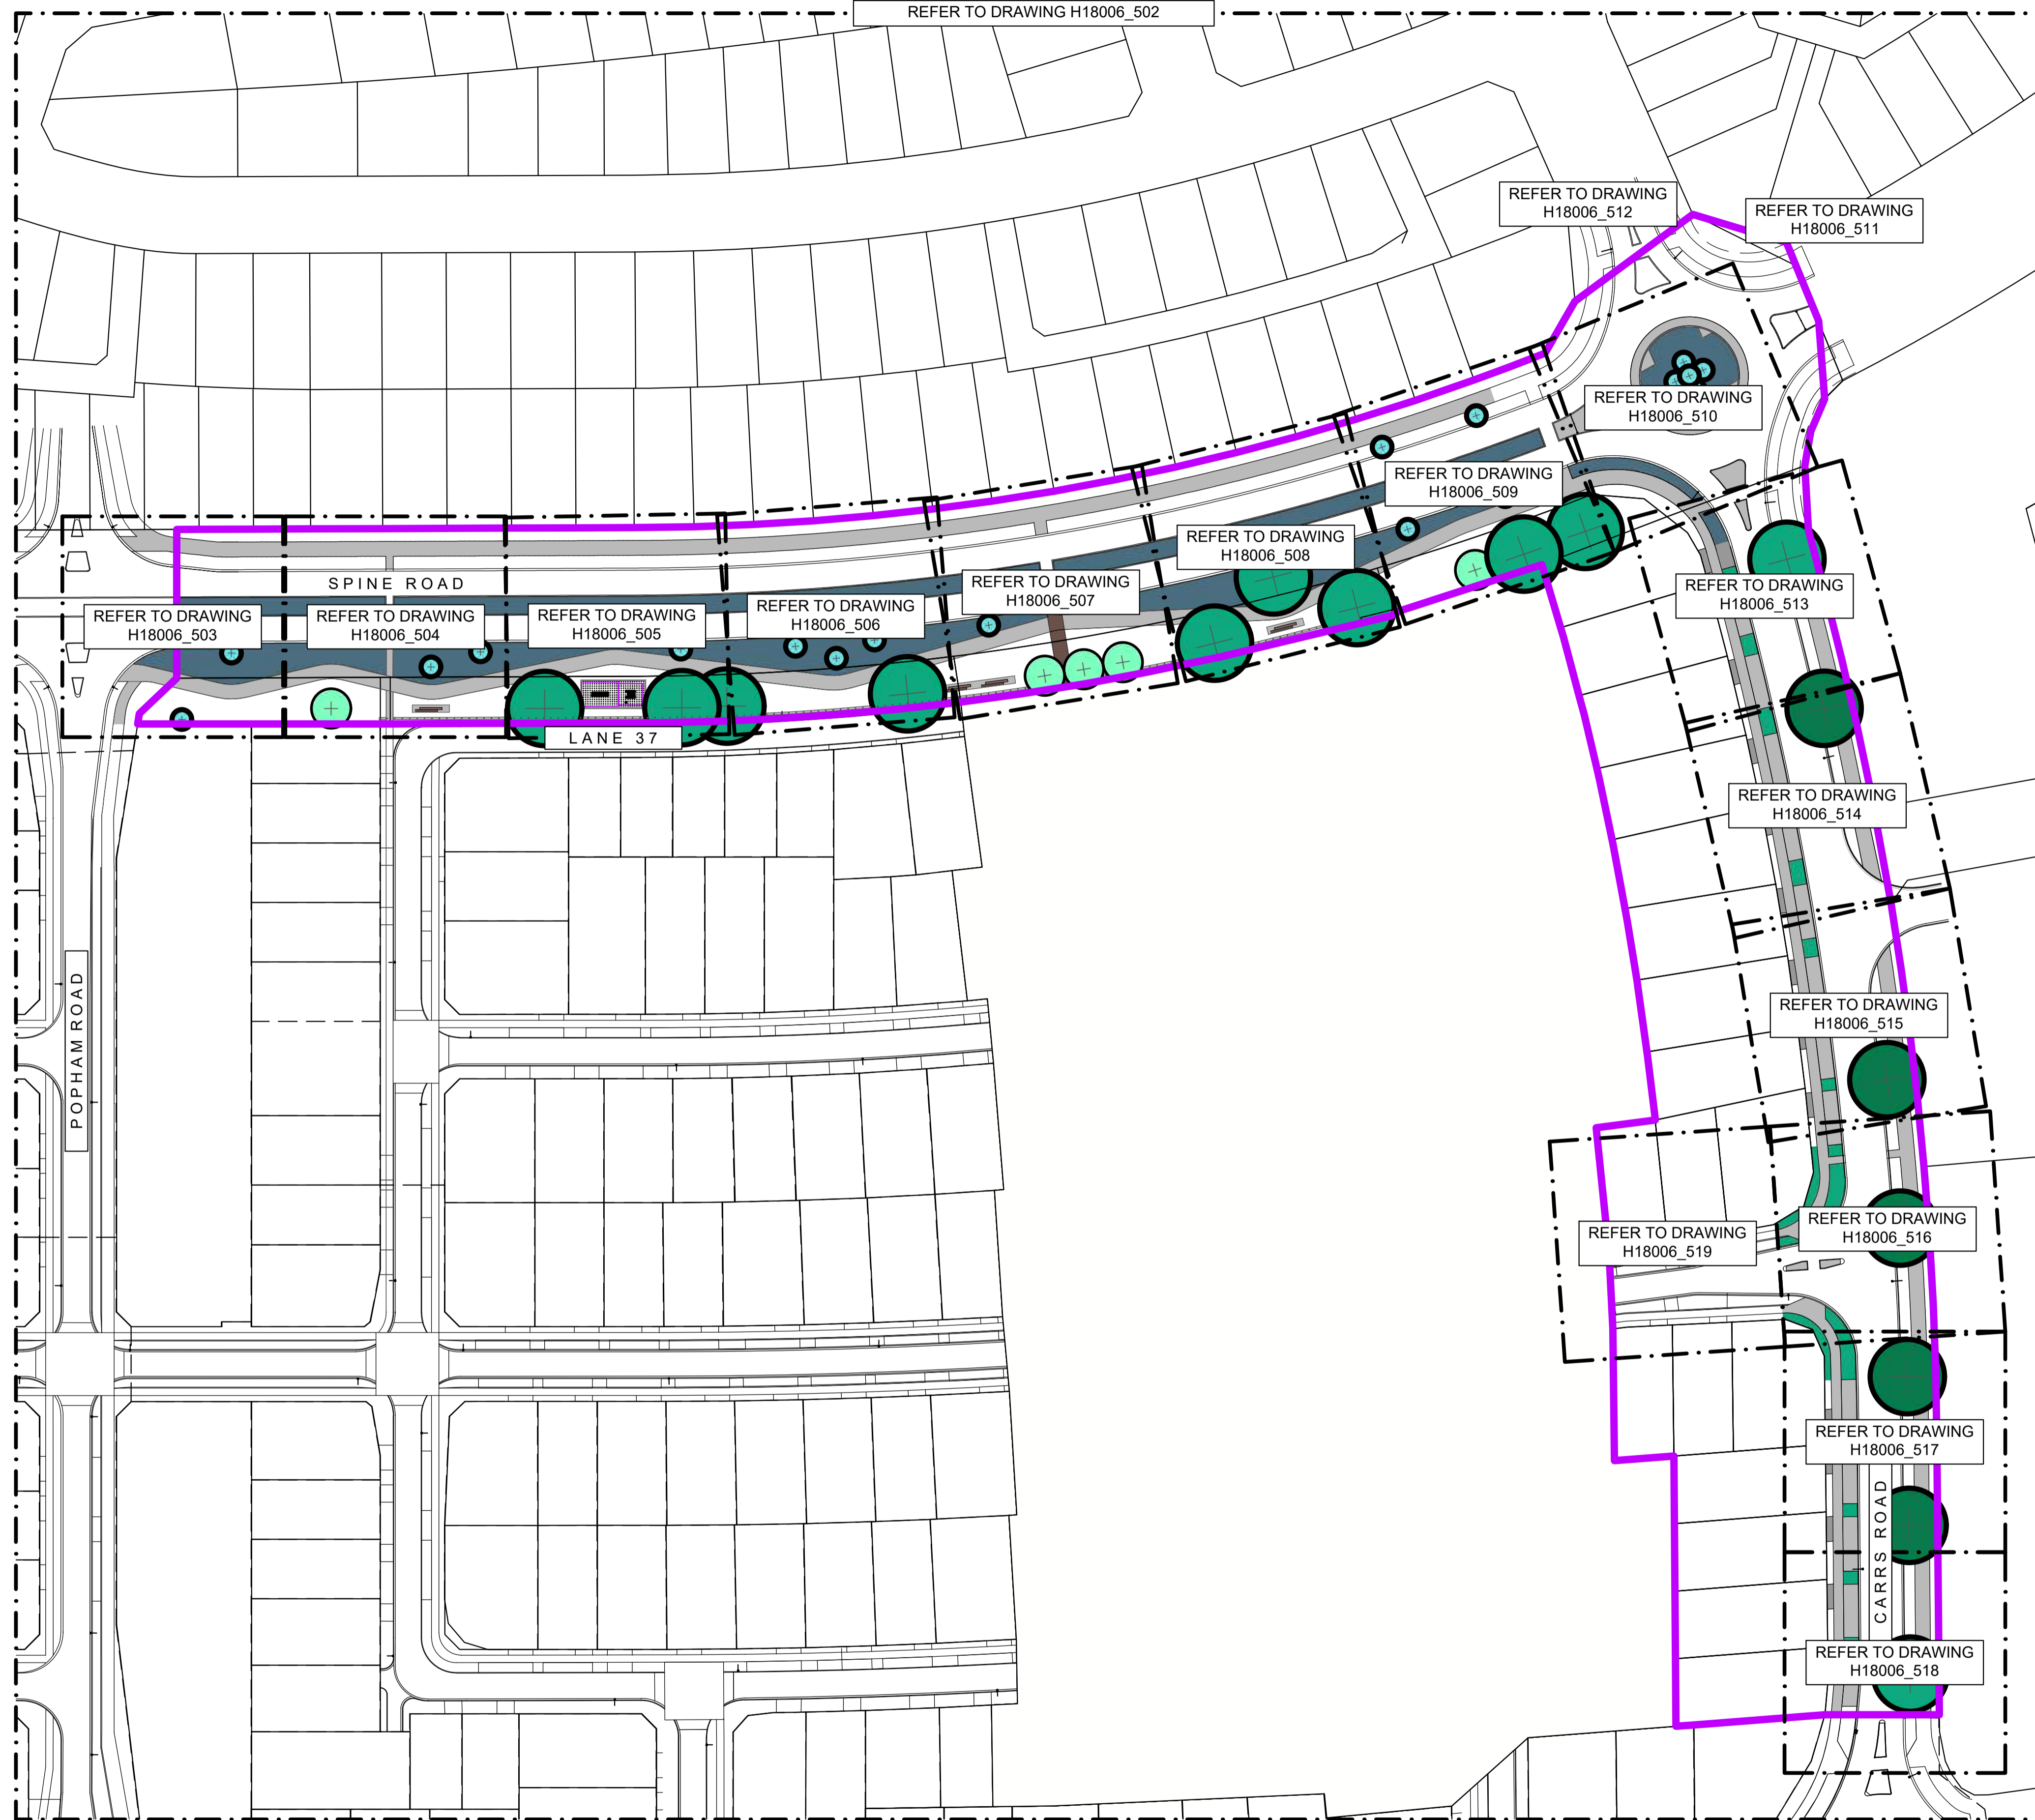

NOTES

CONTRACTORS TO VERIFY ALL DIMENSIONS ON SITE PRIOR TO COMMENCING WORK;
 CONTRACTORS ARE RESPONSIBLE FOR CONFIRMING THE LOCATION OF ALL UNDERGROUND SERVICES ON SITE PRIOR TO COMMENCING WORK;
 FIGURED DIMENSIONS TO BE TAKEN IN PREFERENCE TO SCALED DIMENSIONS.

KEY

REFER TO DRAWING NUMBER H18006_130
 GENERAL ARRANGEMENT KEY SHEET AND NOTES

- STAGE 13
- PLANTING
- LAWN

REV	DATE	DESCRIPTION
0	02.07.19	ISSUED FOR CONSTRUCTION
1	31.07.20	PLANTING SUBSTITUTIONS, BACK BERM PLANTING AREAS SUBSTITUTED WITH LAWN
2	12.03.21	AS BUILT

CLIENT
 Chedworth Properties Ltd

CONSULTANTS
 S & L Consultants
 Beca
 Kendelier Lighting

AS BUILT

**GREENHILL PARK
 AREA M
 STAGE 13**

PLANTING PLAN
 SHEET LOCATIONS

Design ARo	Scale 1:750 @ A1	Date 02.07.19
Drawn ARo	1:1500 @ A3	
Check MHu		
App'd		
DRAWING NO. H18006_501	REVISION 2	

Key


-  SPINE ROAD
-  *Fagus sylvatica* (european beech)
-  *Knightia excelsa* (rewarewa)
-  Berm Planting
-  Lawn
-  COLLECTOR ROAD (CARRS ROAD)
-  *Fagus sylvatica* (european beech)
-  *Quercus robur* (english oak)
-  Berm Planting
-  Lawn
-  RECREATION RESERVE
-  *Fagus sylvatica* (european beech)
-  *Knightia excelsa* (rewarewa)
-  *Prunus yedoensis* 'Awanui' (flowering cherry)
-  Lawn



NOTES

CONTRACTORS TO VERIFY ALL DIMENSIONS ON SITE PRIOR TO COMMENCING WORK;
 CONTRACTORS ARE RESPONSIBLE FOR CONFIRMING THE LOCATION OF ALL UNDERGROUND SERVICES ON SITE PRIOR TO COMMENCING WORK;
 FIGURED DIMENSIONS TO BE TAKEN IN PREFERENCE TO SCALED DIMENSIONS.

KEY

REFER TO DRAWING NUMBER H18006_130 GENERAL ARRANGEMENT KEY SHEET AND NOTES
 STAGE 13




REV	DATE	DESCRIPTION
0	02.07.19	ISSUED FOR CONSTRUCTION
1	31.07.20	PLANTING SUBSTITUTIONS, BACK BERM PLANTING AREAS SUBSTITUTED WITH LAWN
2	12.03.21	AS BUILT


CLIENT	Chedworth Properties Ltd
CONSULTANTS	S & L Consultants Beca Kendellier Lighting
AS BUILT	

GREENHILL PARK
AREA M
STAGE 13
 PLANTING PLAN
 GENERAL ARRANGEMENT

Design	ARo	Scale	1:750 @ A1	Date	02.07.19
Drawn	ARo	Check	MHu	1:1500 @ A3	
Appr'd					
DRAWING NO.	H18006_502			REVISION	2

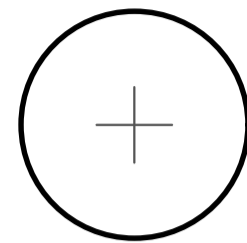Key

-  Tree
-  Spine Road Berm Planting
-  Lawn

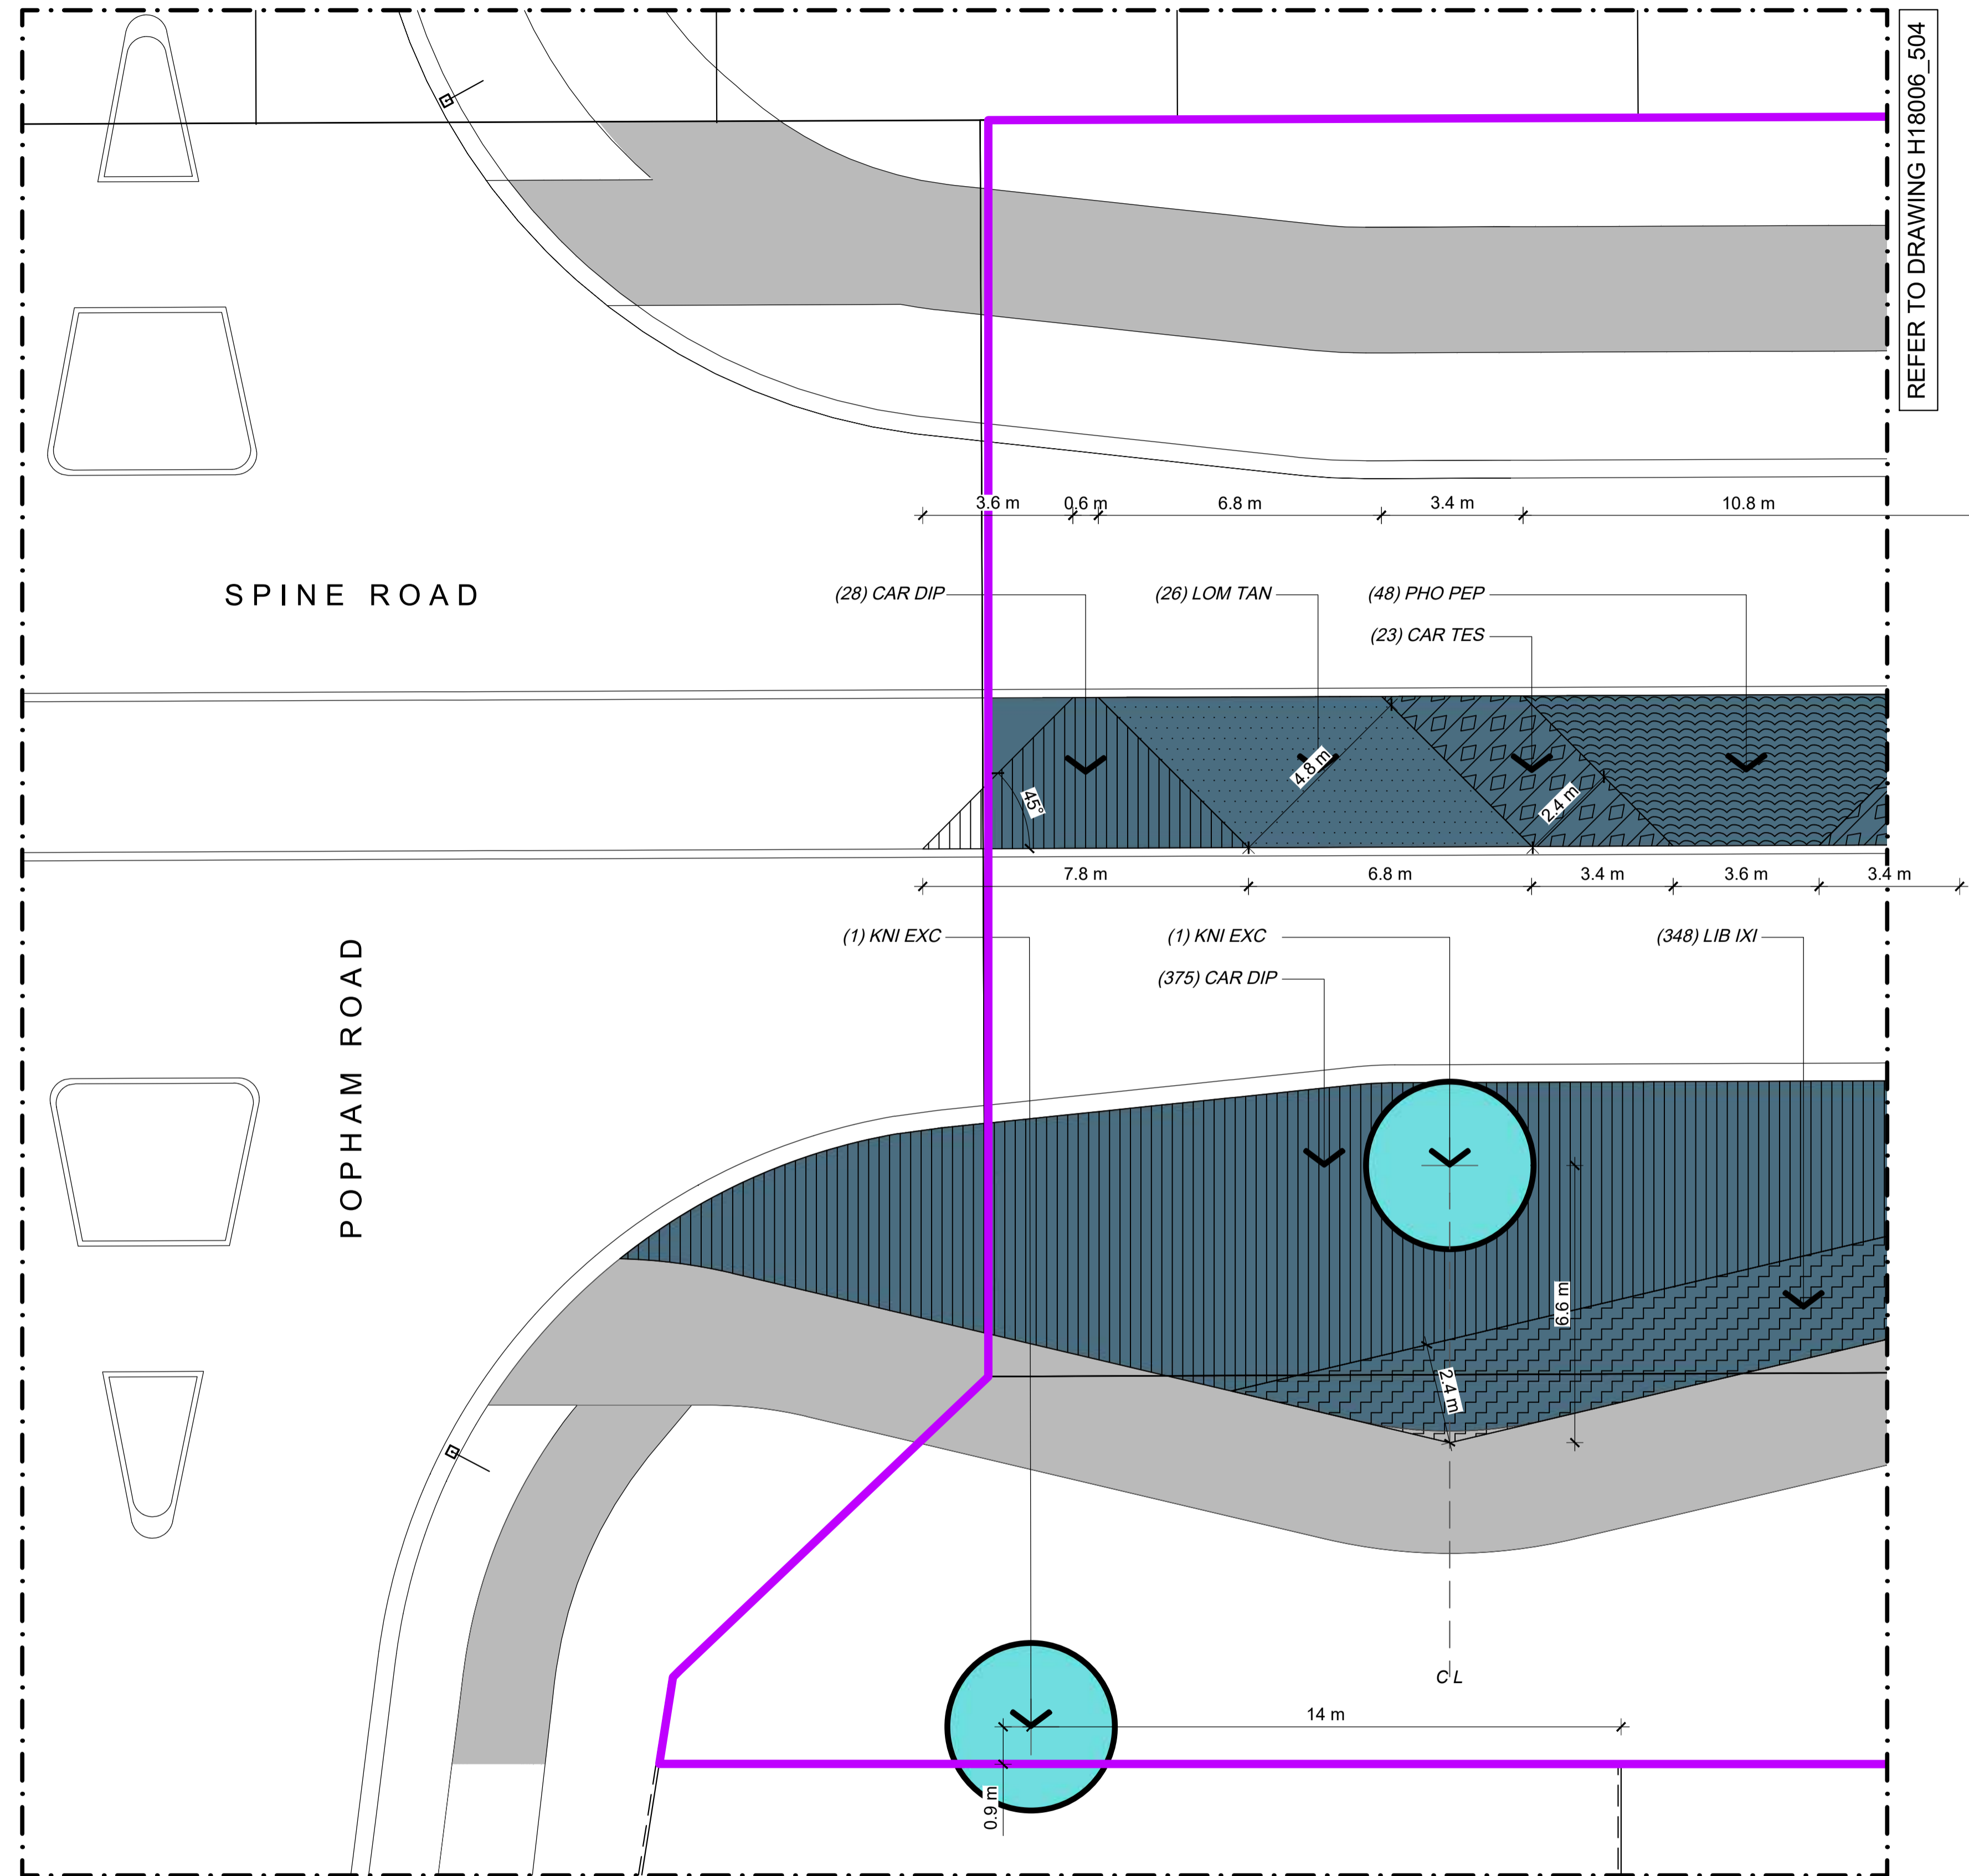


REFER TO DRAWING H18006_504

NOTES

- CONTRACTORS TO VERIFY ALL DIMENSIONS ON SITE PRIOR TO COMMENCING WORK;
- CONTRACTORS ARE RESPONSIBLE FOR CONFIRMING THE LOCATION OF ALL UNDERGROUND SERVICES ON SITE PRIOR TO COMMENCING WORK;
- FIGURED DIMENSIONS TO BE TAKEN IN PREFERENCE TO SCALED DIMENSIONS.

KEY

-  STAGE 13

REV	DATE	DESCRIPTION
0	02.07.19	ISSUED FOR CONSTRUCTION
1	31.07.20	PLANTING SUBSTITUTIONS, BACK BERM PLANTING AREAS SUBSTITUTED WITH LAWN
2	12.03.21	AS BUILT




CLIENT	Chedworth Properties Ltd
CONSULTANTS	S & L Consultants Beca Kendellier Lighting
AS BUILT	


**GREENHILL PARK
AREA M
STAGE 13**

PLANTING PLAN
SHEET 01 OF 17

Design	ARo	Scale	Date
Drawn	ARo	1:100 @ A1	02.07.19
Check	MHu	1:200 @ A3	
App'v'd			
DRAWING NO.		REVISION	
H18006_503		(2)	

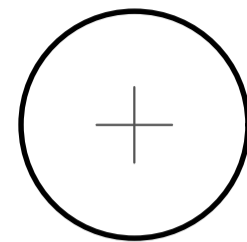Key

-  Tree
-  Spine Road Berm Planting
-  Lawn

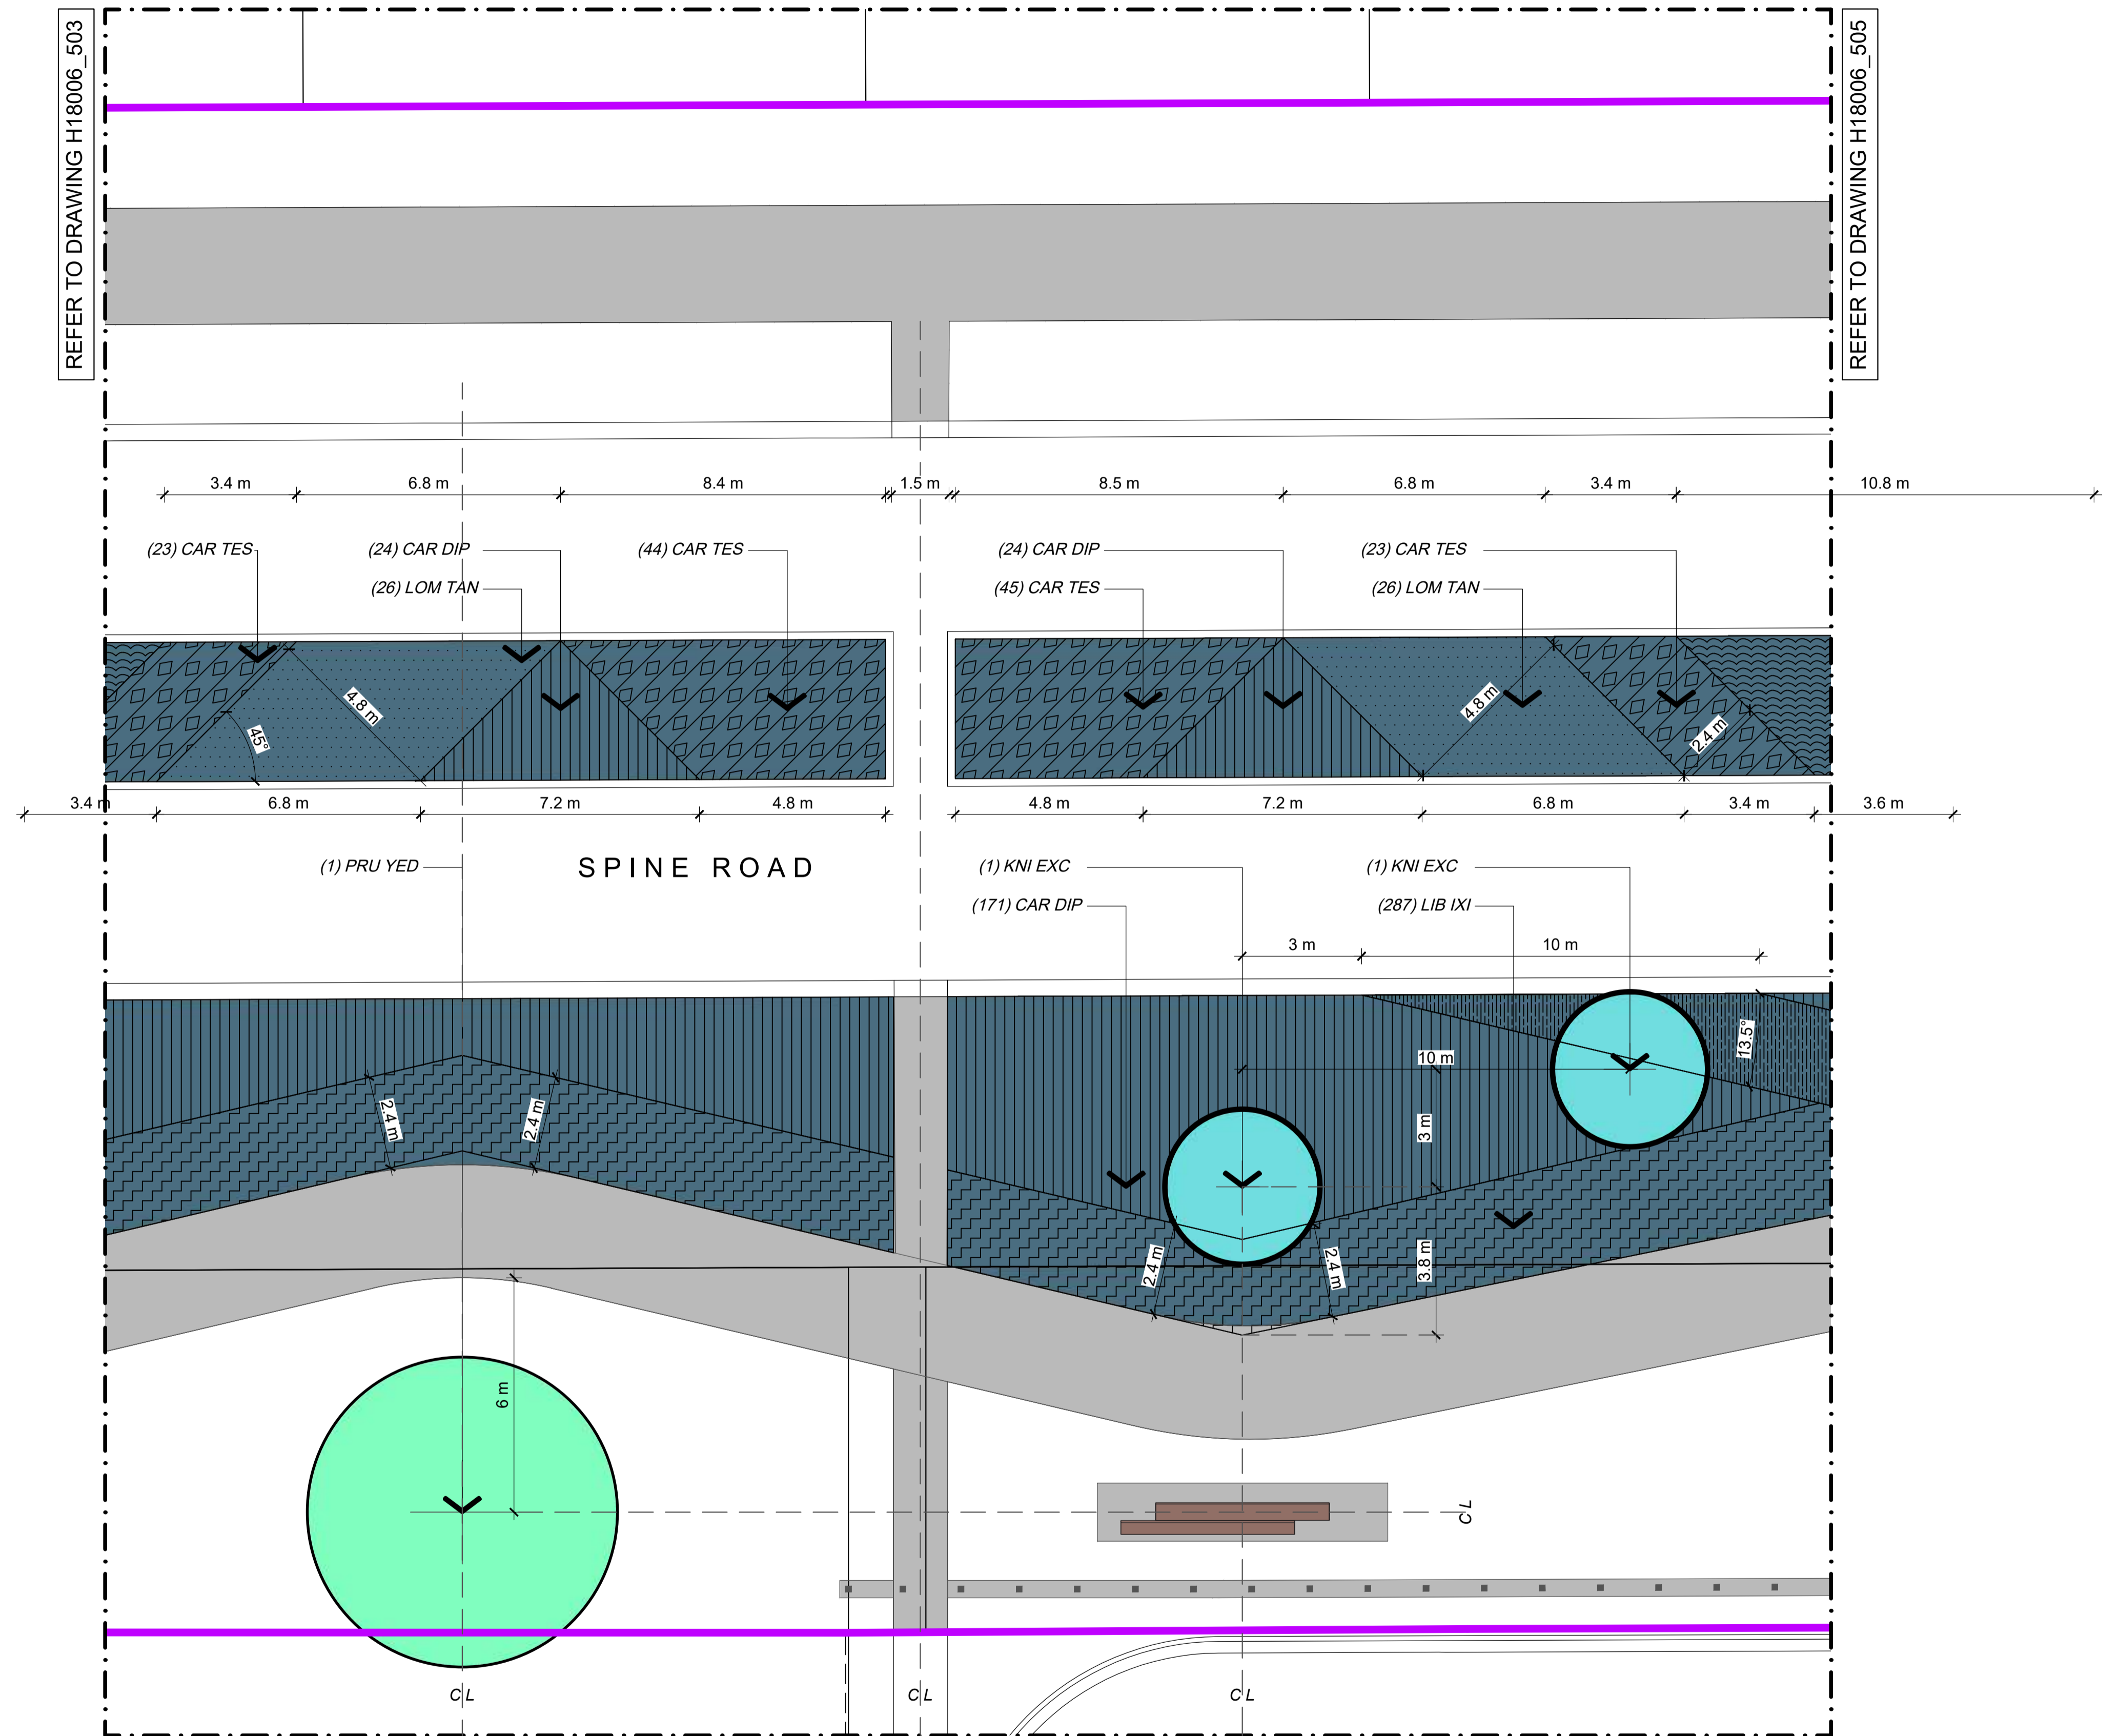

NOTES

- CONTRACTORS TO VERIFY ALL DIMENSIONS ON SITE PRIOR TO COMMENCING WORK;
- CONTRACTORS ARE RESPONSIBLE FOR CONFIRMING THE LOCATION OF ALL UNDERGROUND SERVICES ON SITE PRIOR TO COMMENCING WORK;
- FIGURED DIMENSIONS TO BE TAKEN IN PREFERENCE TO SCALED DIMENSIONS.

KEY

-  STAGE 13

REV	DATE	DESCRIPTION
0	02.07.19	ISSUED FOR CONSTRUCTION
1	31.07.20	PLANTING SUBSTITUTIONS, BACK BERM PLANTING AREAS SUBSTITUTED WITH LAWN
2	12.03.21	AS BUILT

CLIENT
Chedworth Properties Ltd

CONSULTANTS
S & L Consultants
Beca
Kendellier Lighting




AS BUILT


**GREENHILL PARK
AREA M
STAGE 13**

PLANTING PLAN
SHEET 02 OF 17

Design ARo	Scale 1:100 @ A1	Date 02.07.19
Drawn ARo	1:200 @ A3	
Check MHu		
App'd		
DRAWING NO.	REVISION	
H18006_504	2	

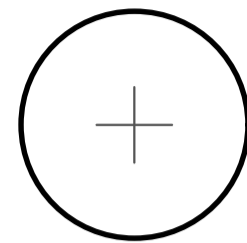Key

-  Tree
-  Spine Road Berm Planting
-  Lawn

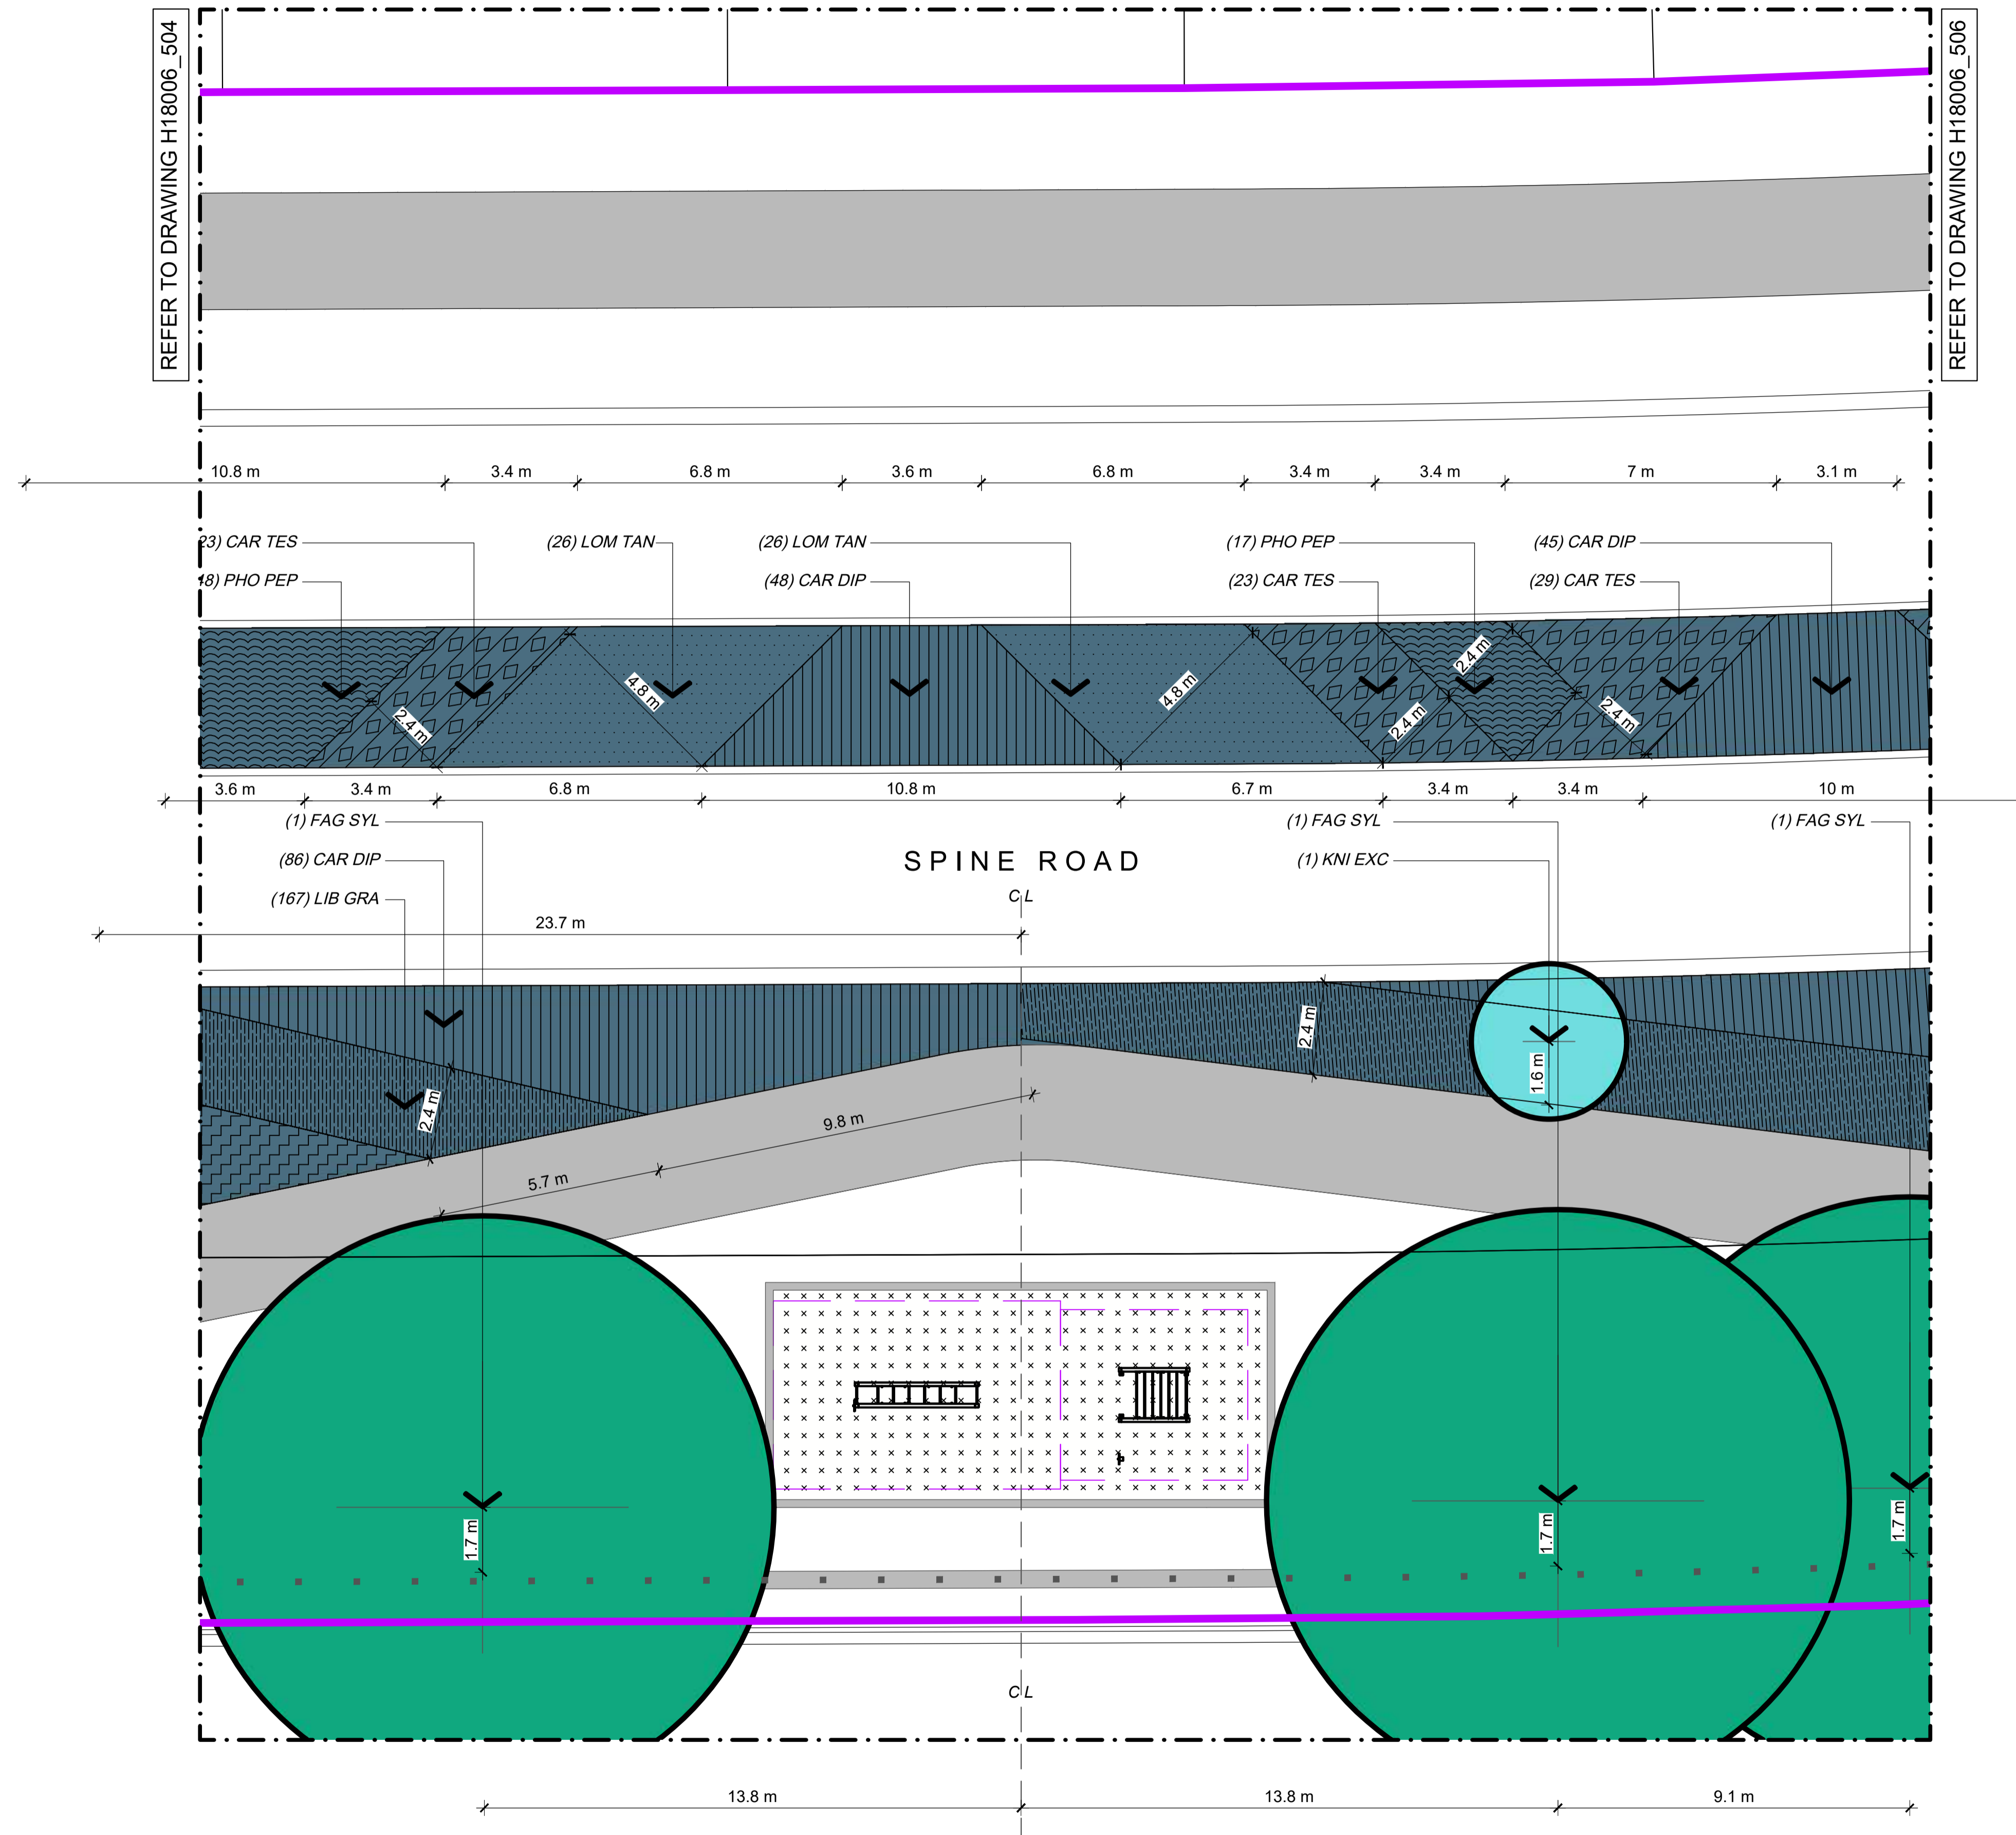

NOTES

- CONTRACTORS TO VERIFY ALL DIMENSIONS ON SITE PRIOR TO COMMENCING WORK;
- CONTRACTORS ARE RESPONSIBLE FOR CONFIRMING THE LOCATION OF ALL UNDERGROUND SERVICES ON SITE PRIOR TO COMMENCING WORK;
- FIGURED DIMENSIONS TO BE TAKEN IN PREFERENCE TO SCALED DIMENSIONS.

KEY

-  STAGE 13

REV	DATE	DESCRIPTION
0	02.07.19	ISSUED FOR CONSTRUCTION
1	31.07.20	PLANTING SUBSTITUTIONS, BACK BERM PLANTING AREAS SUBSTITUTED WITH LAWN
2	12.03.21	AS BUILT

CLIENT
Chedworth Properties Ltd

CONSULTANTS
S & L Consultants
Beca
Kendellier Lighting




AS BUILT


GREENHILL PARK
AREA M
STAGE 13
PLANTING PLAN
SHEET 03 OF 17

Design	ARo	Scale	Date
Drawn	ARo	1:100 @ A1	02.07.19
Check	MHu	1:200 @ A3	
App'v'd			

DRAWING NO.	REVISION
H18006_505	2

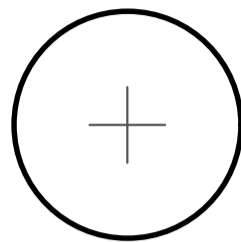Key


-  Tree
-  Spine Road Berm Planting
-  Lawn

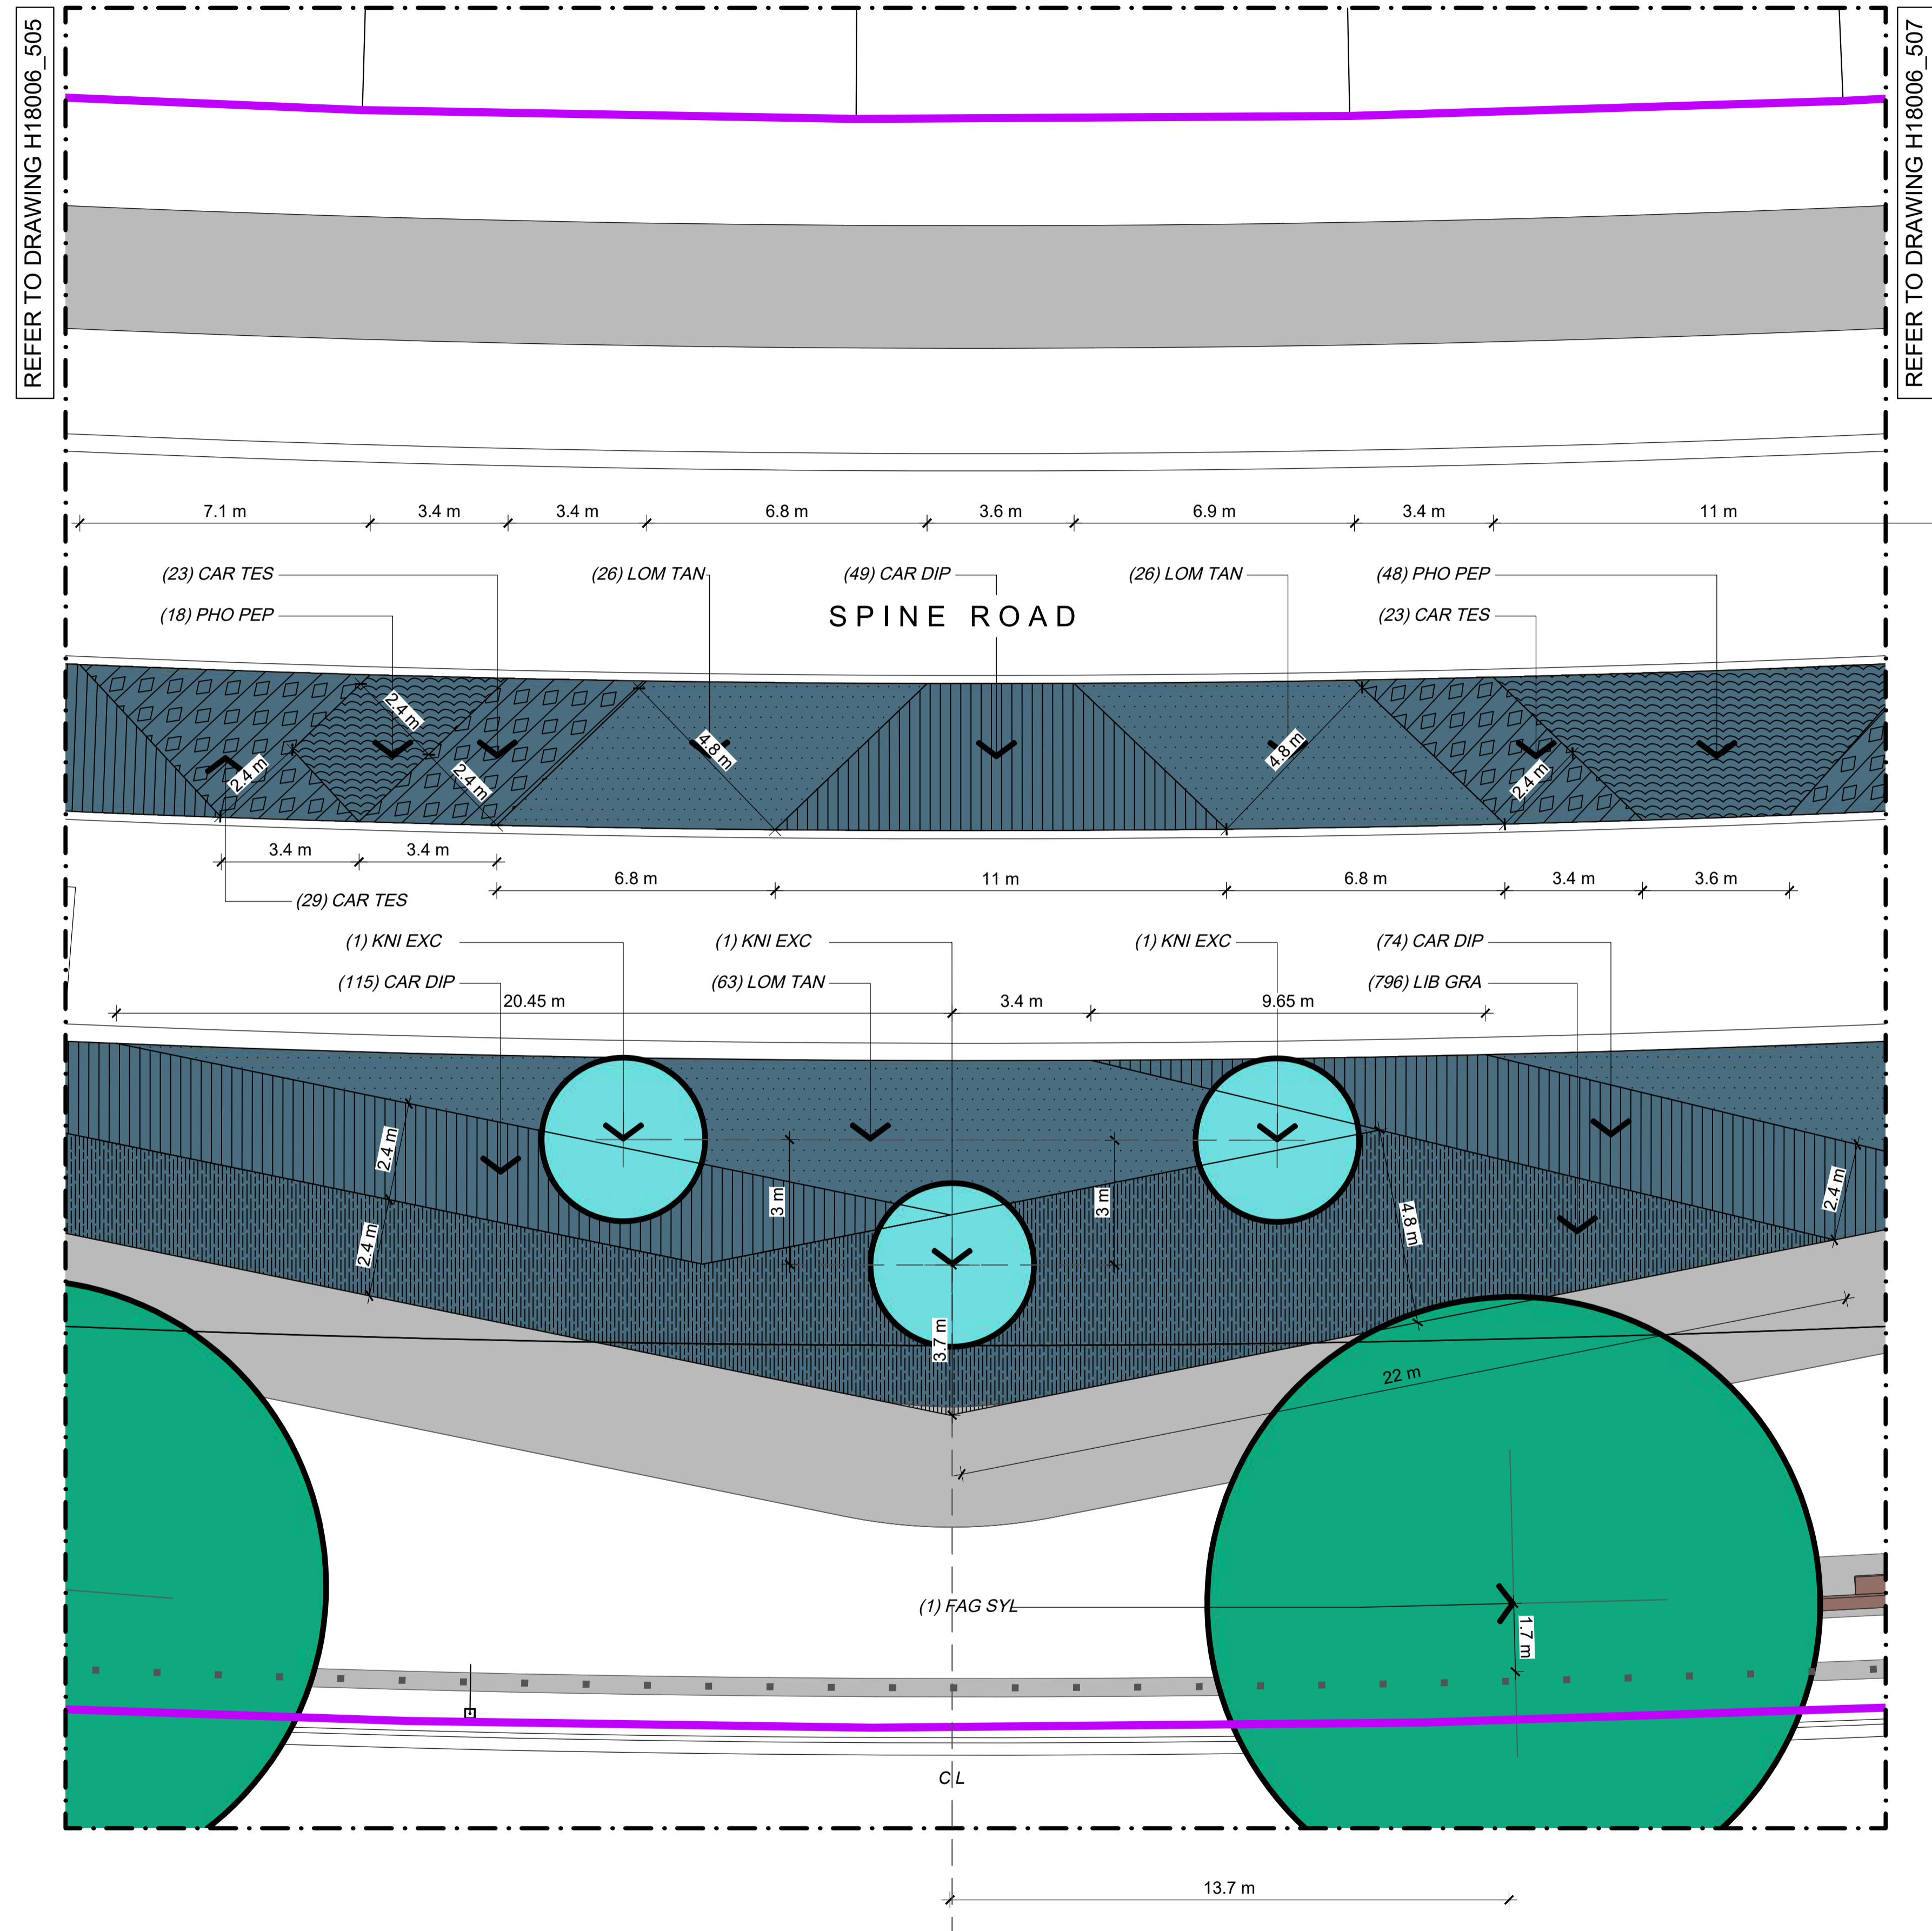

NOTES

- CONTRACTORS TO VERIFY ALL DIMENSIONS ON SITE PRIOR TO COMMENCING WORK;
- CONTRACTORS ARE RESPONSIBLE FOR CONFIRMING THE LOCATION OF ALL UNDERGROUND SERVICES ON SITE PRIOR TO COMMENCING WORK;
- FIGURED DIMENSIONS TO BE TAKEN IN PREFERENCE TO SCALED DIMENSIONS.

KEY

-  STAGE 13

REV	DATE	DESCRIPTION
0	02.07.19	ISSUED FOR CONSTRUCTION
1	31.07.20	PLANTING SUBSTITUTIONS, BACK BERM PLANTING AREAS SUBSTITUTED WITH LAWN
2	12.03.21	AS BUILT

CLIENT
Chedworth Properties Ltd

CONSULTANTS
S & L Consultants
Beca
Kendellier Lighting




AS BUILT


**GREENHILL PARK
AREA M
STAGE 13**

PLANTING PLAN
SHEET 04 OF 17

Design	ARo	Scale	Date
Drawn	ARo	1:100 @ A1	02.07.19
Check	MHu	1:200 @ A3	
App'vd			
DRAWING NO.		REVISION	
H18006_506		2	

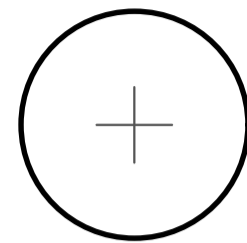
Key

-  Tree
-  Spine Road Berm Planting
-  Lawn

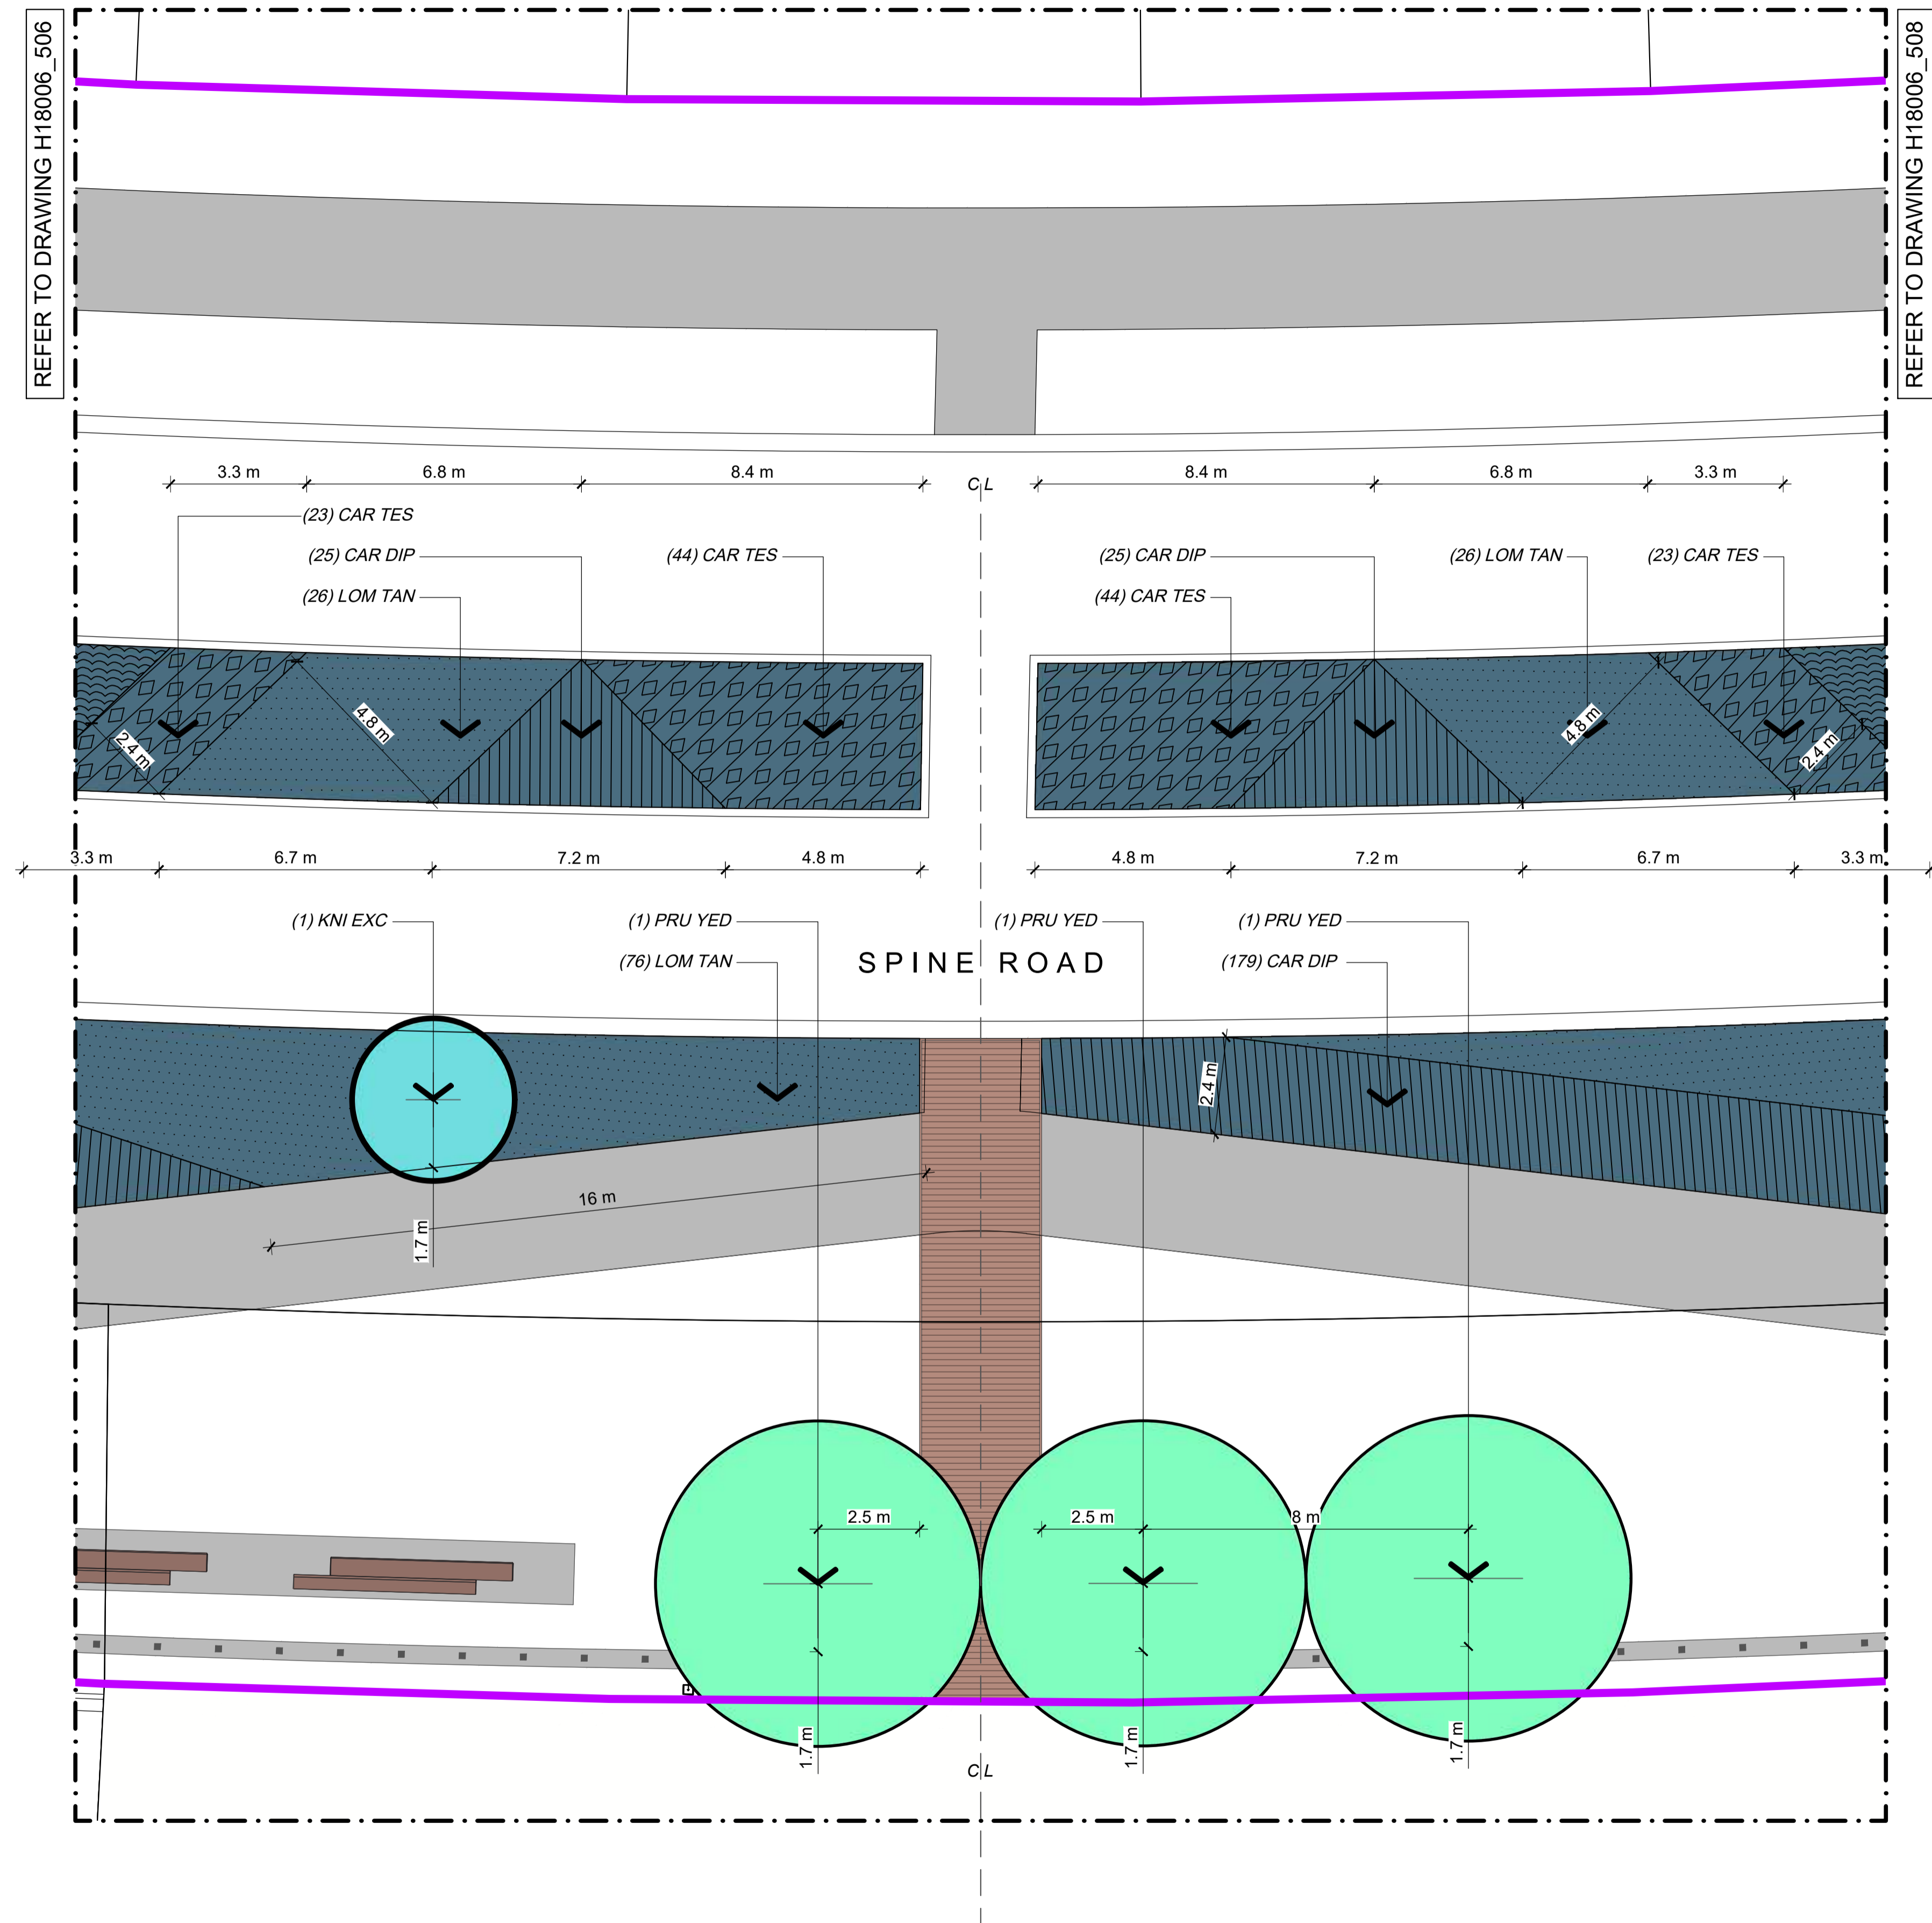

REFER TO DRAWING H18006_506

REFER TO DRAWING H18006_508

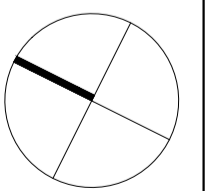


Boffa Miskell Limited
 Level 3, SouthBloc
 19 Knox Street
 PO Box 1094, Hamilton 3240, New Zealand
 Tel: +64 7 960 0006
 www.boffamiskell.co.nz

NOTES

- CONTRACTORS TO VERIFY ALL DIMENSIONS ON SITE PRIOR TO COMMENCING WORK;
- CONTRACTORS ARE RESPONSIBLE FOR CONFIRMING THE LOCATION OF ALL UNDERGROUND SERVICES ON SITE PRIOR TO COMMENCING WORK;
- FIGURED DIMENSIONS TO BE TAKEN IN PREFERENCE TO SCALED DIMENSIONS.

KEY

-  STAGE 13

REV	DATE	DESCRIPTION
0	02.07.19	ISSUED FOR CONSTRUCTION
1	31.07.20	PLANTING SUBSTITUTIONS, BACK BERM PLANTING AREAS SUBSTITUTED WITH LAWN
2	12.03.21	AS BUILT

CLIENT
 Chedworth Properties Ltd

CONSULTANTS
 S & L Consultants
 Beca
 Kendellier Lighting

AS BUILT




**GREENHILL PARK
 AREA M
 STAGE 13**
 PLANTING PLAN
 SHEET 05 OF 17


Design	ARo	Scale	Date
Drawn	ARo	1:100 @ A1	02.07.19
Check	MHu	1:200 @ A3	
App'vd			

DRAWING NO. REVISION

H18006_507 2

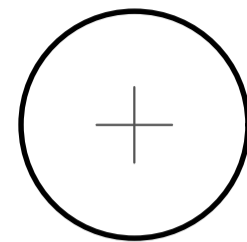
Key

-  Tree
-  Spine Road Berm Planting
-  Lawn

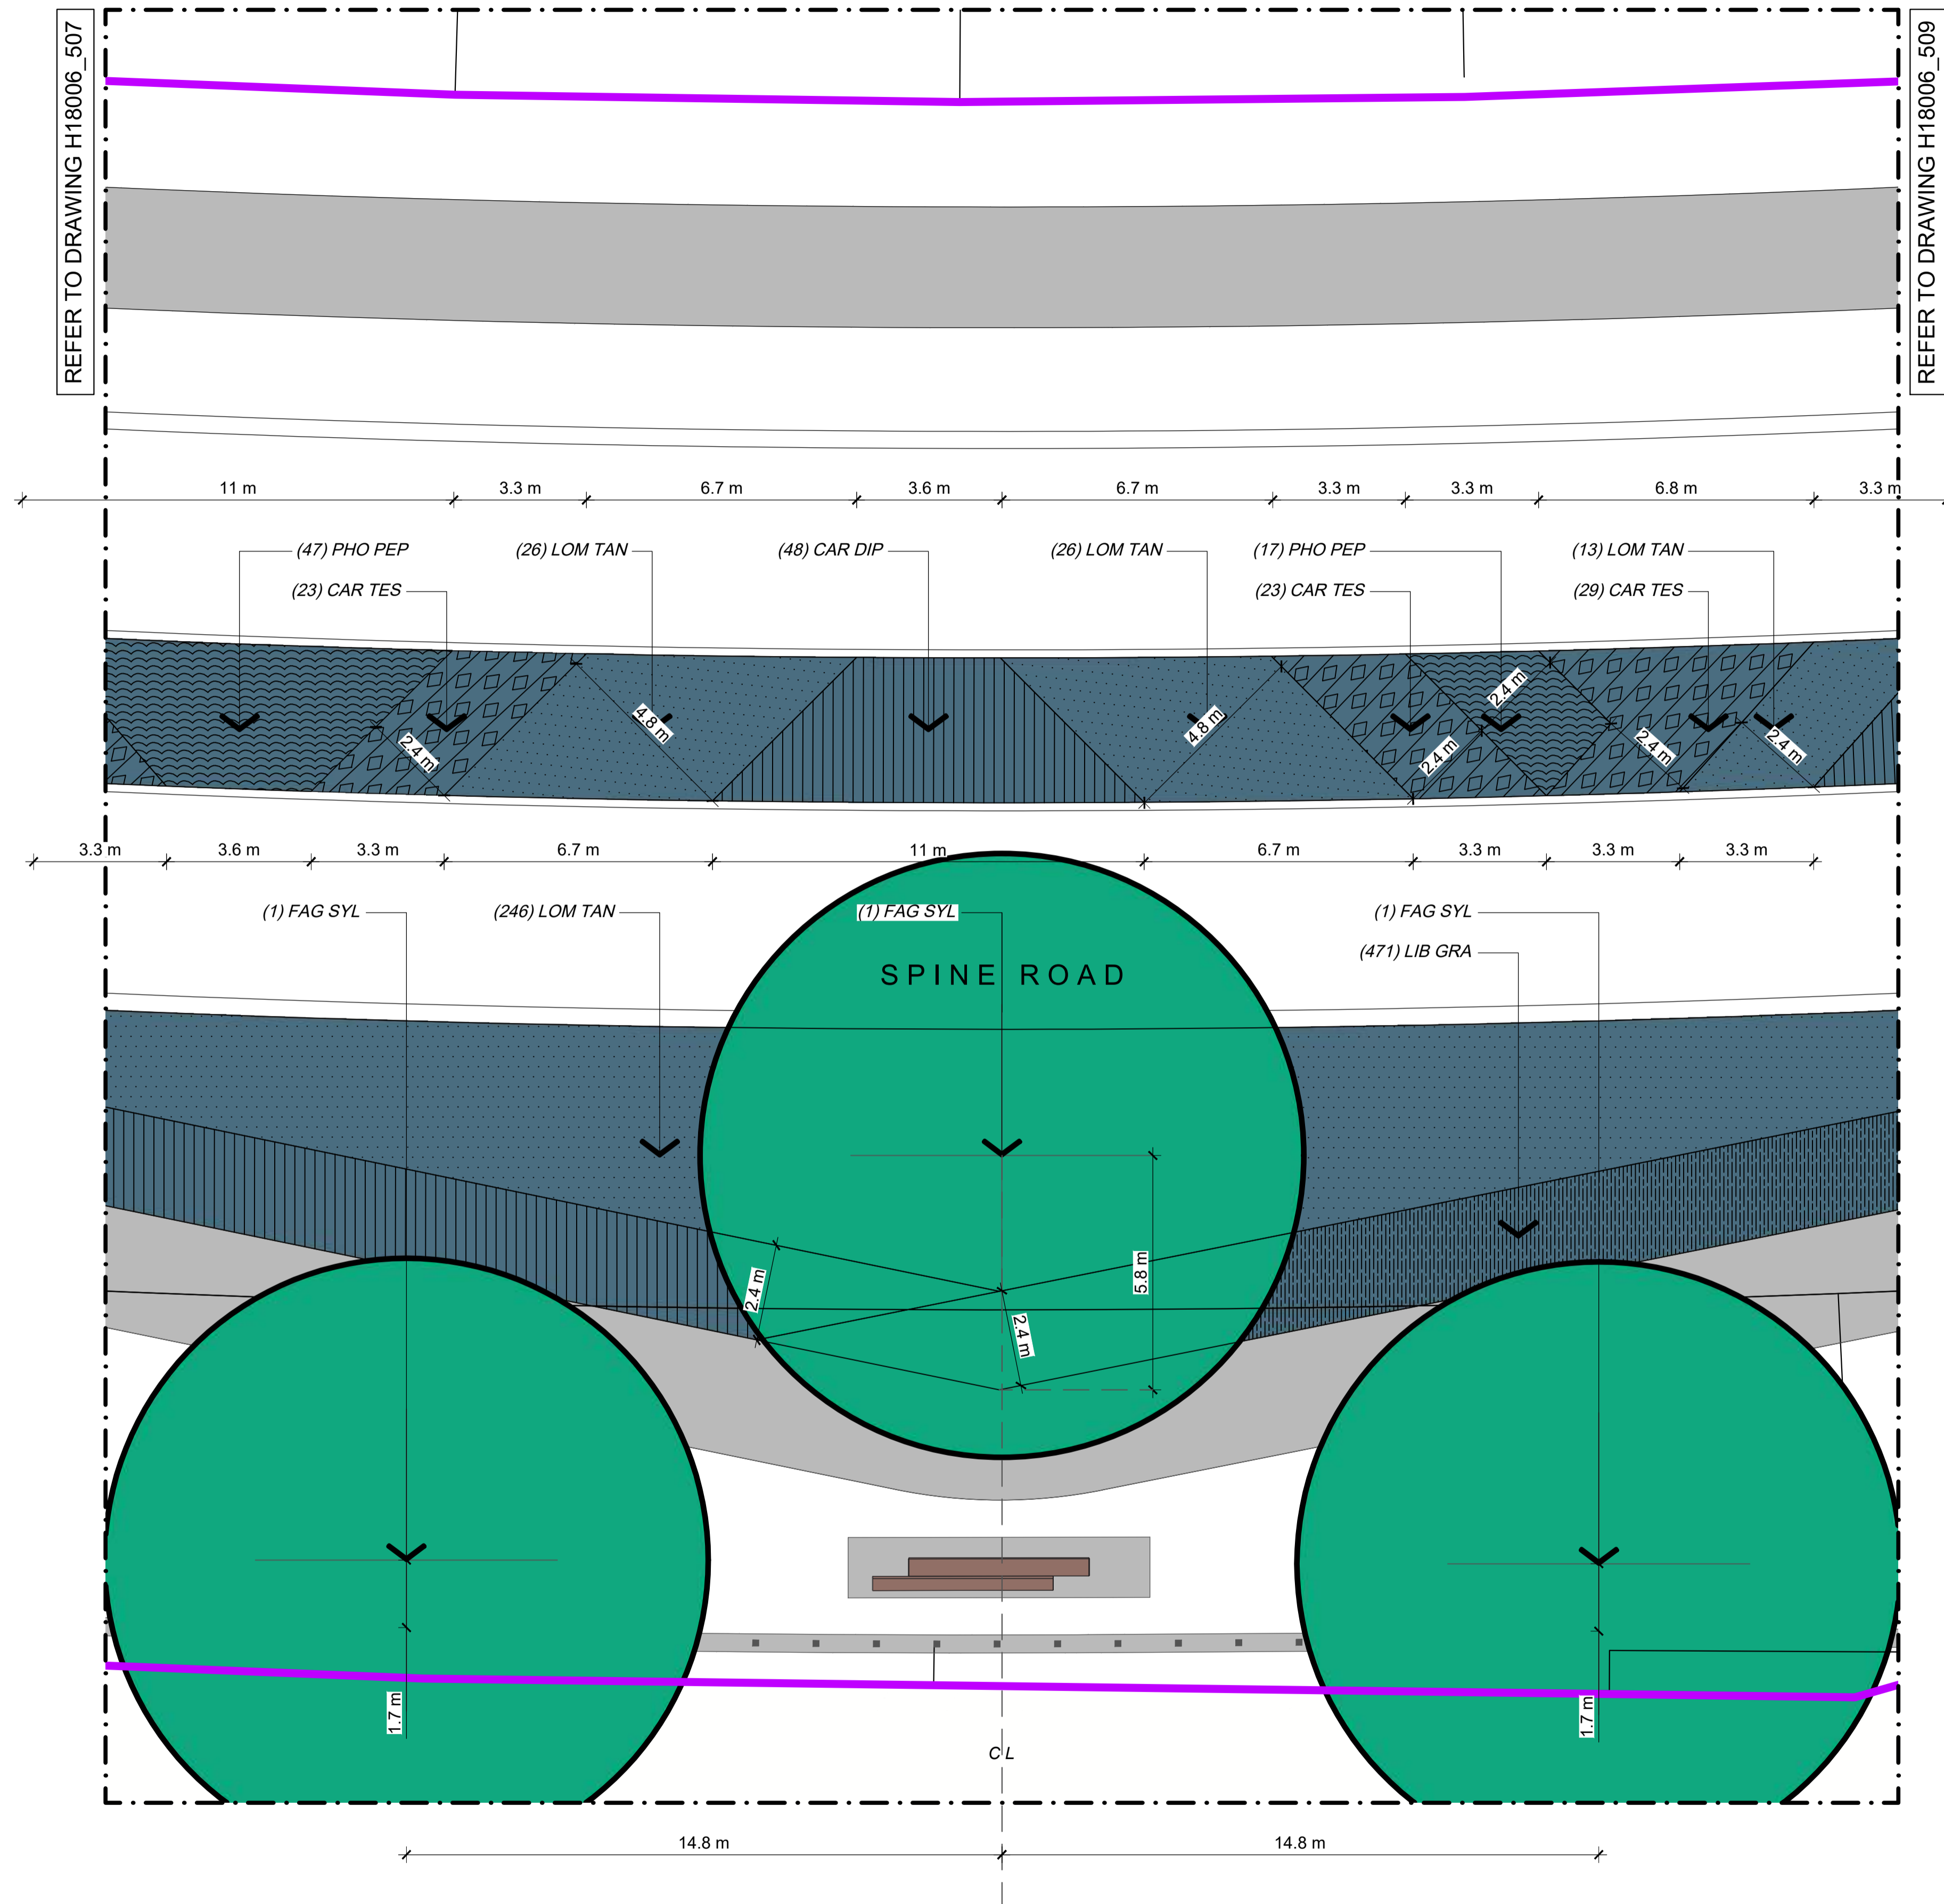

REFER TO DRAWING H18006_507

REFER TO DRAWING H18006_509

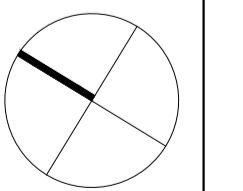

Boffa Miskell Limited
 Level 3, SouthBloc
 19 Knox Street
 PO Box 1094, Hamilton 3240, New Zealand
 Tel: +64 7 960 0006
 www.boffamiskell.co.nz

NOTES

- CONTRACTORS TO VERIFY ALL DIMENSIONS ON SITE PRIOR TO COMMENCING WORK;
- CONTRACTORS ARE RESPONSIBLE FOR CONFIRMING THE LOCATION OF ALL UNDERGROUND SERVICES ON SITE PRIOR TO COMMENCING WORK;
- FIGURED DIMENSIONS TO BE TAKEN IN PREFERENCE TO SCALED DIMENSIONS.

KEY

-  STAGE 13

REV	DATE	DESCRIPTION
0	02.07.19	ISSUED FOR CONSTRUCTION
1	31.07.20	PLANTING SUBSTITUTIONS, BACK BERM PLANTING AREAS SUBSTITUTED WITH LAWN
2	12.03.21	AS BUILT

CLIENT
 Chedworth Properties Ltd

CONSULTANTS
 S & L Consultants
 Beca
 Kendellier Lighting




AS BUILT


**GREENHILL PARK
 AREA M
 STAGE 13**

PLANTING PLAN
 SHEET 06 OF 17

Design	ARo	Scale	Date
Drawn	ARo	1:100 @ A1	02.07.19
Check	MHu	1:200 @ A3	
Appv'd			
DRAWING NO.		REVISION	
H18006_508		(2)	

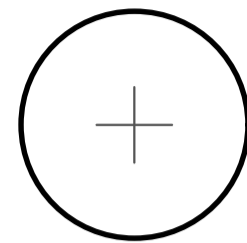Key


-  Tree
-  Spine Road Berm Planting
-  Lawn

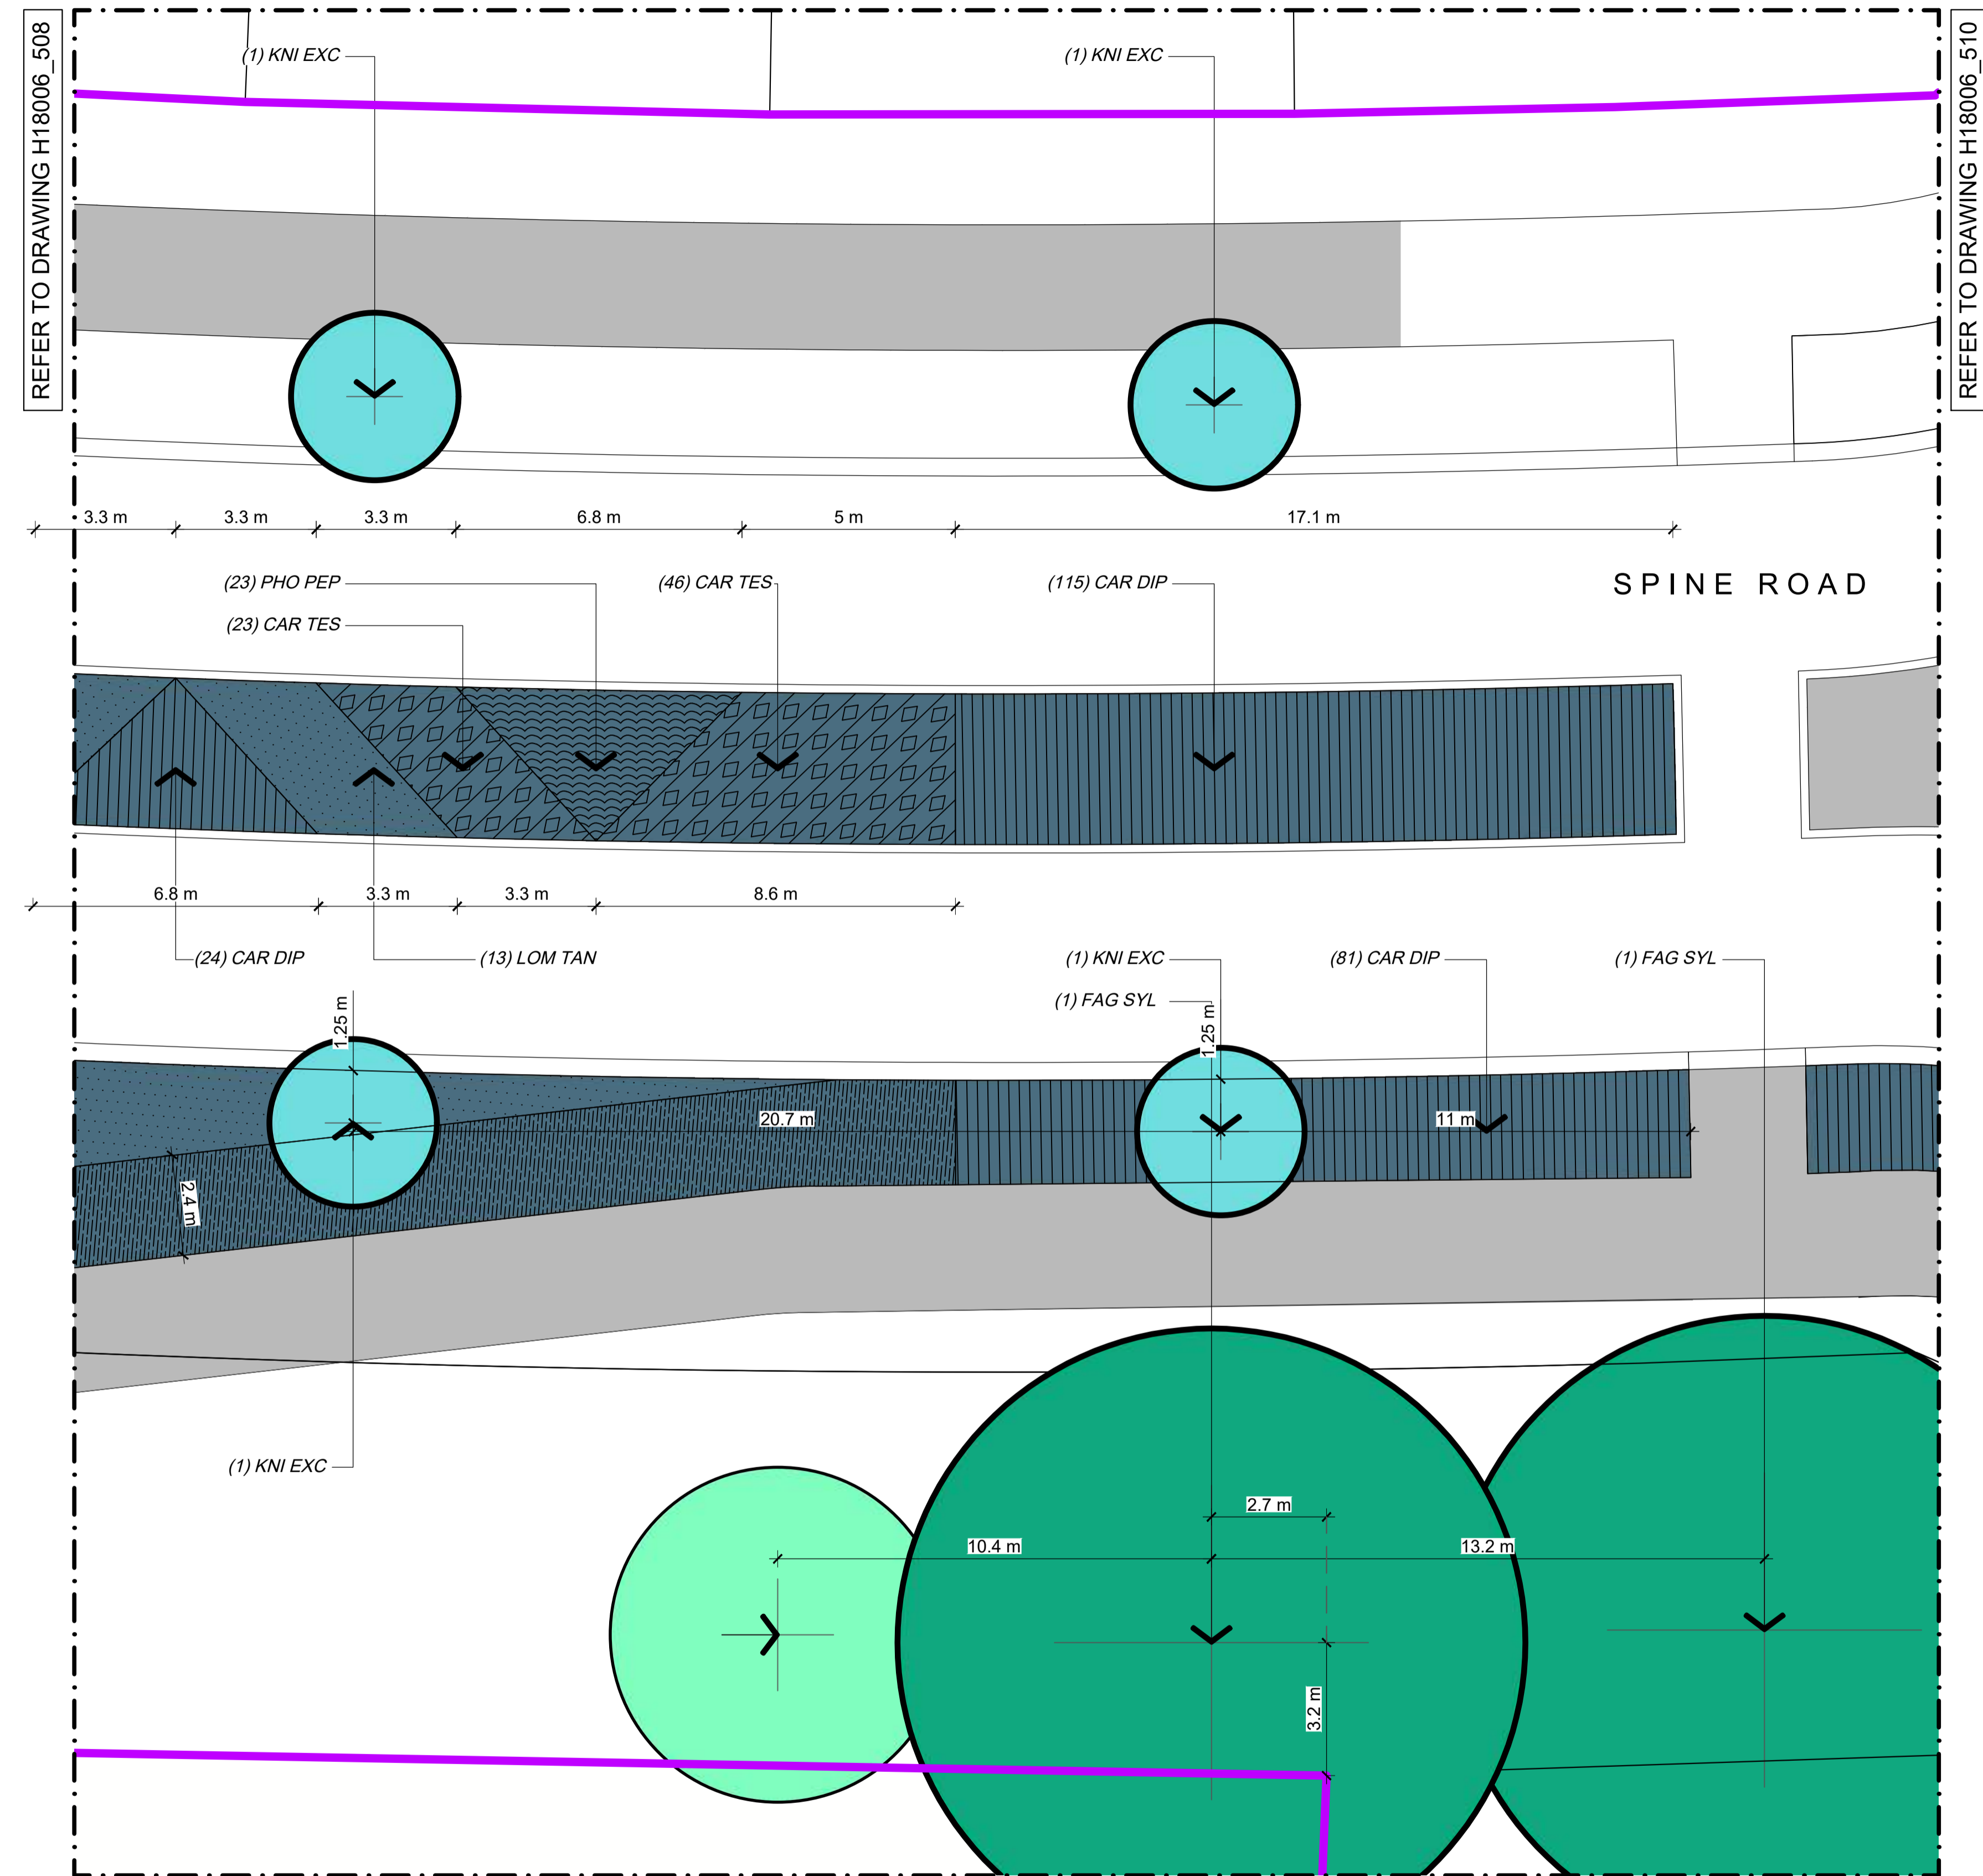

REFER TO DRAWING H18006_508

REFER TO DRAWING H18006_510

SPINE ROAD

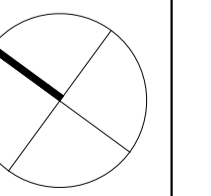

Boffa Miskell Limited
 Level 3, SouthBloc
 19 Knox Street
 PO Box 1094, Hamilton 3240, New Zealand
 Tel: +64 7 960 0006
 www.boffamiskell.co.nz

NOTES

- CONTRACTORS TO VERIFY ALL DIMENSIONS ON SITE PRIOR TO COMMENCING WORK;
- CONTRACTORS ARE RESPONSIBLE FOR CONFIRMING THE LOCATION OF ALL UNDERGROUND SERVICES ON SITE PRIOR TO COMMENCING WORK;
- FIGURED DIMENSIONS TO BE TAKEN IN PREFERENCE TO SCALED DIMENSIONS.

KEY

-  STAGE 13

REV	DATE	DESCRIPTION
0	02.07.19	ISSUED FOR CONSTRUCTION
1	31.07.20	PLANTING SUBSTITUTIONS, BACK BERM PLANTING AREAS SUBSTITUTED WITH LAWN
2	12.03.21	AS BUILT

CLIENT
 Chedworth Properties Ltd

CONSULTANTS
 S & L Consultants
 Beca
 Kendellier Lighting




AS BUILT


**GREENHILL PARK
 AREA M
 STAGE 13**

PLANTING PLAN
 SHEET 07 OF 17

Design ARo	Scale 1:100 @ A1 1:200 @ A3	Date 02.07.19
Drawn ARo		
Check MHu		
App'vd		
DRAWING NO. H18006_509	REVISION (2)	

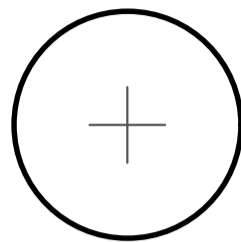Key


-  Tree
-  Spine Road Berm Planting
-  Lawn

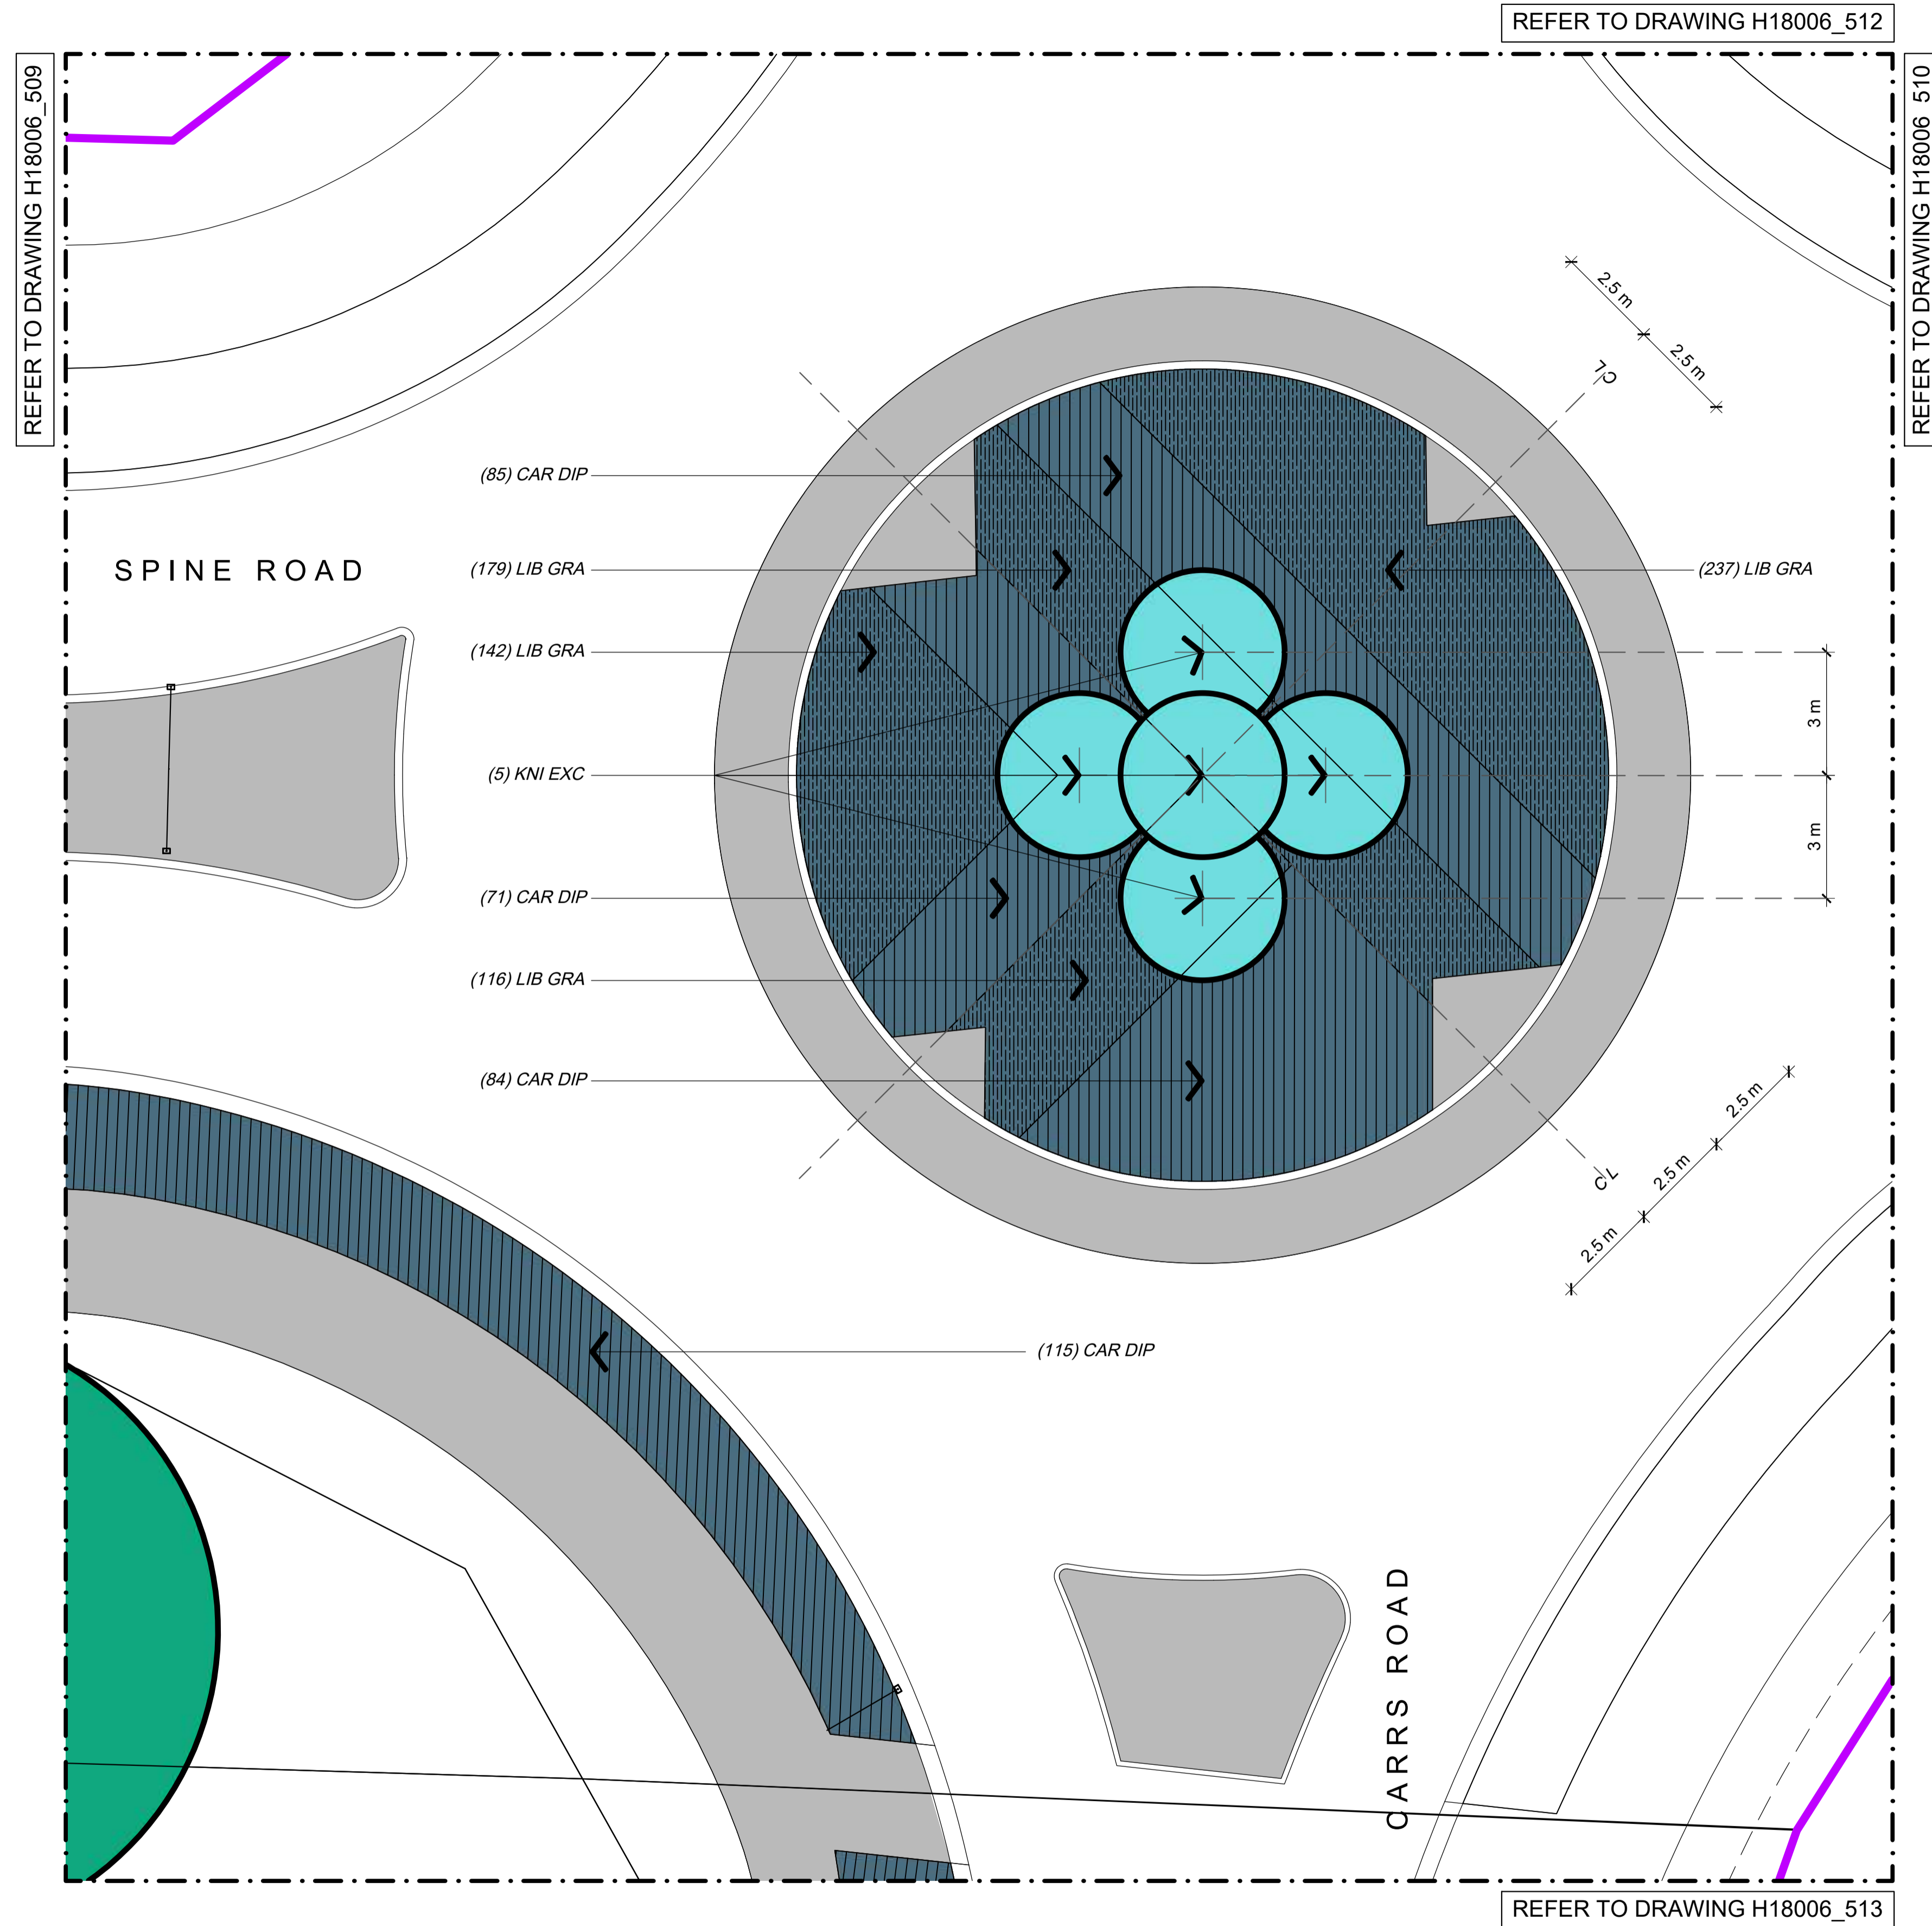

NOTES

CONTRACTORS TO VERIFY ALL DIMENSIONS ON SITE PRIOR TO COMMENCING WORK;
 CONTRACTORS ARE RESPONSIBLE FOR CONFIRMING THE LOCATION OF ALL UNDERGROUND SERVICES ON SITE PRIOR TO COMMENCING WORK;
 FIGURED DIMENSIONS TO BE TAKEN IN PREFERENCE TO SCALED DIMENSIONS.

KEY

 STAGE 13

REV	DATE	DESCRIPTION
0	02.07.19	ISSUED FOR CONSTRUCTION
1	31.07.20	PLANTING SUBSTITUTIONS, BACK BERM PLANTING AREAS SUBSTITUTED WITH LAWN
2	12.03.21	AS BUILT

CLIENT
 Chedworth Properties Ltd


CONSULTANTS
 S & L Consultants
 Beca
 Kendellier Lighting

AS BUILT

**GREENHILL PARK
 AREA M
 STAGE 13**
 PLANTING PLAN
 SHEET 08 OF 17

Design	ARo	Scale	Date
Drawn	ARo	1:100 @ A1	02.07.19
Check	MHu	1:200 @ A3	
Appv'd			

DRAWING NO.	REVISION
H18006_510	2

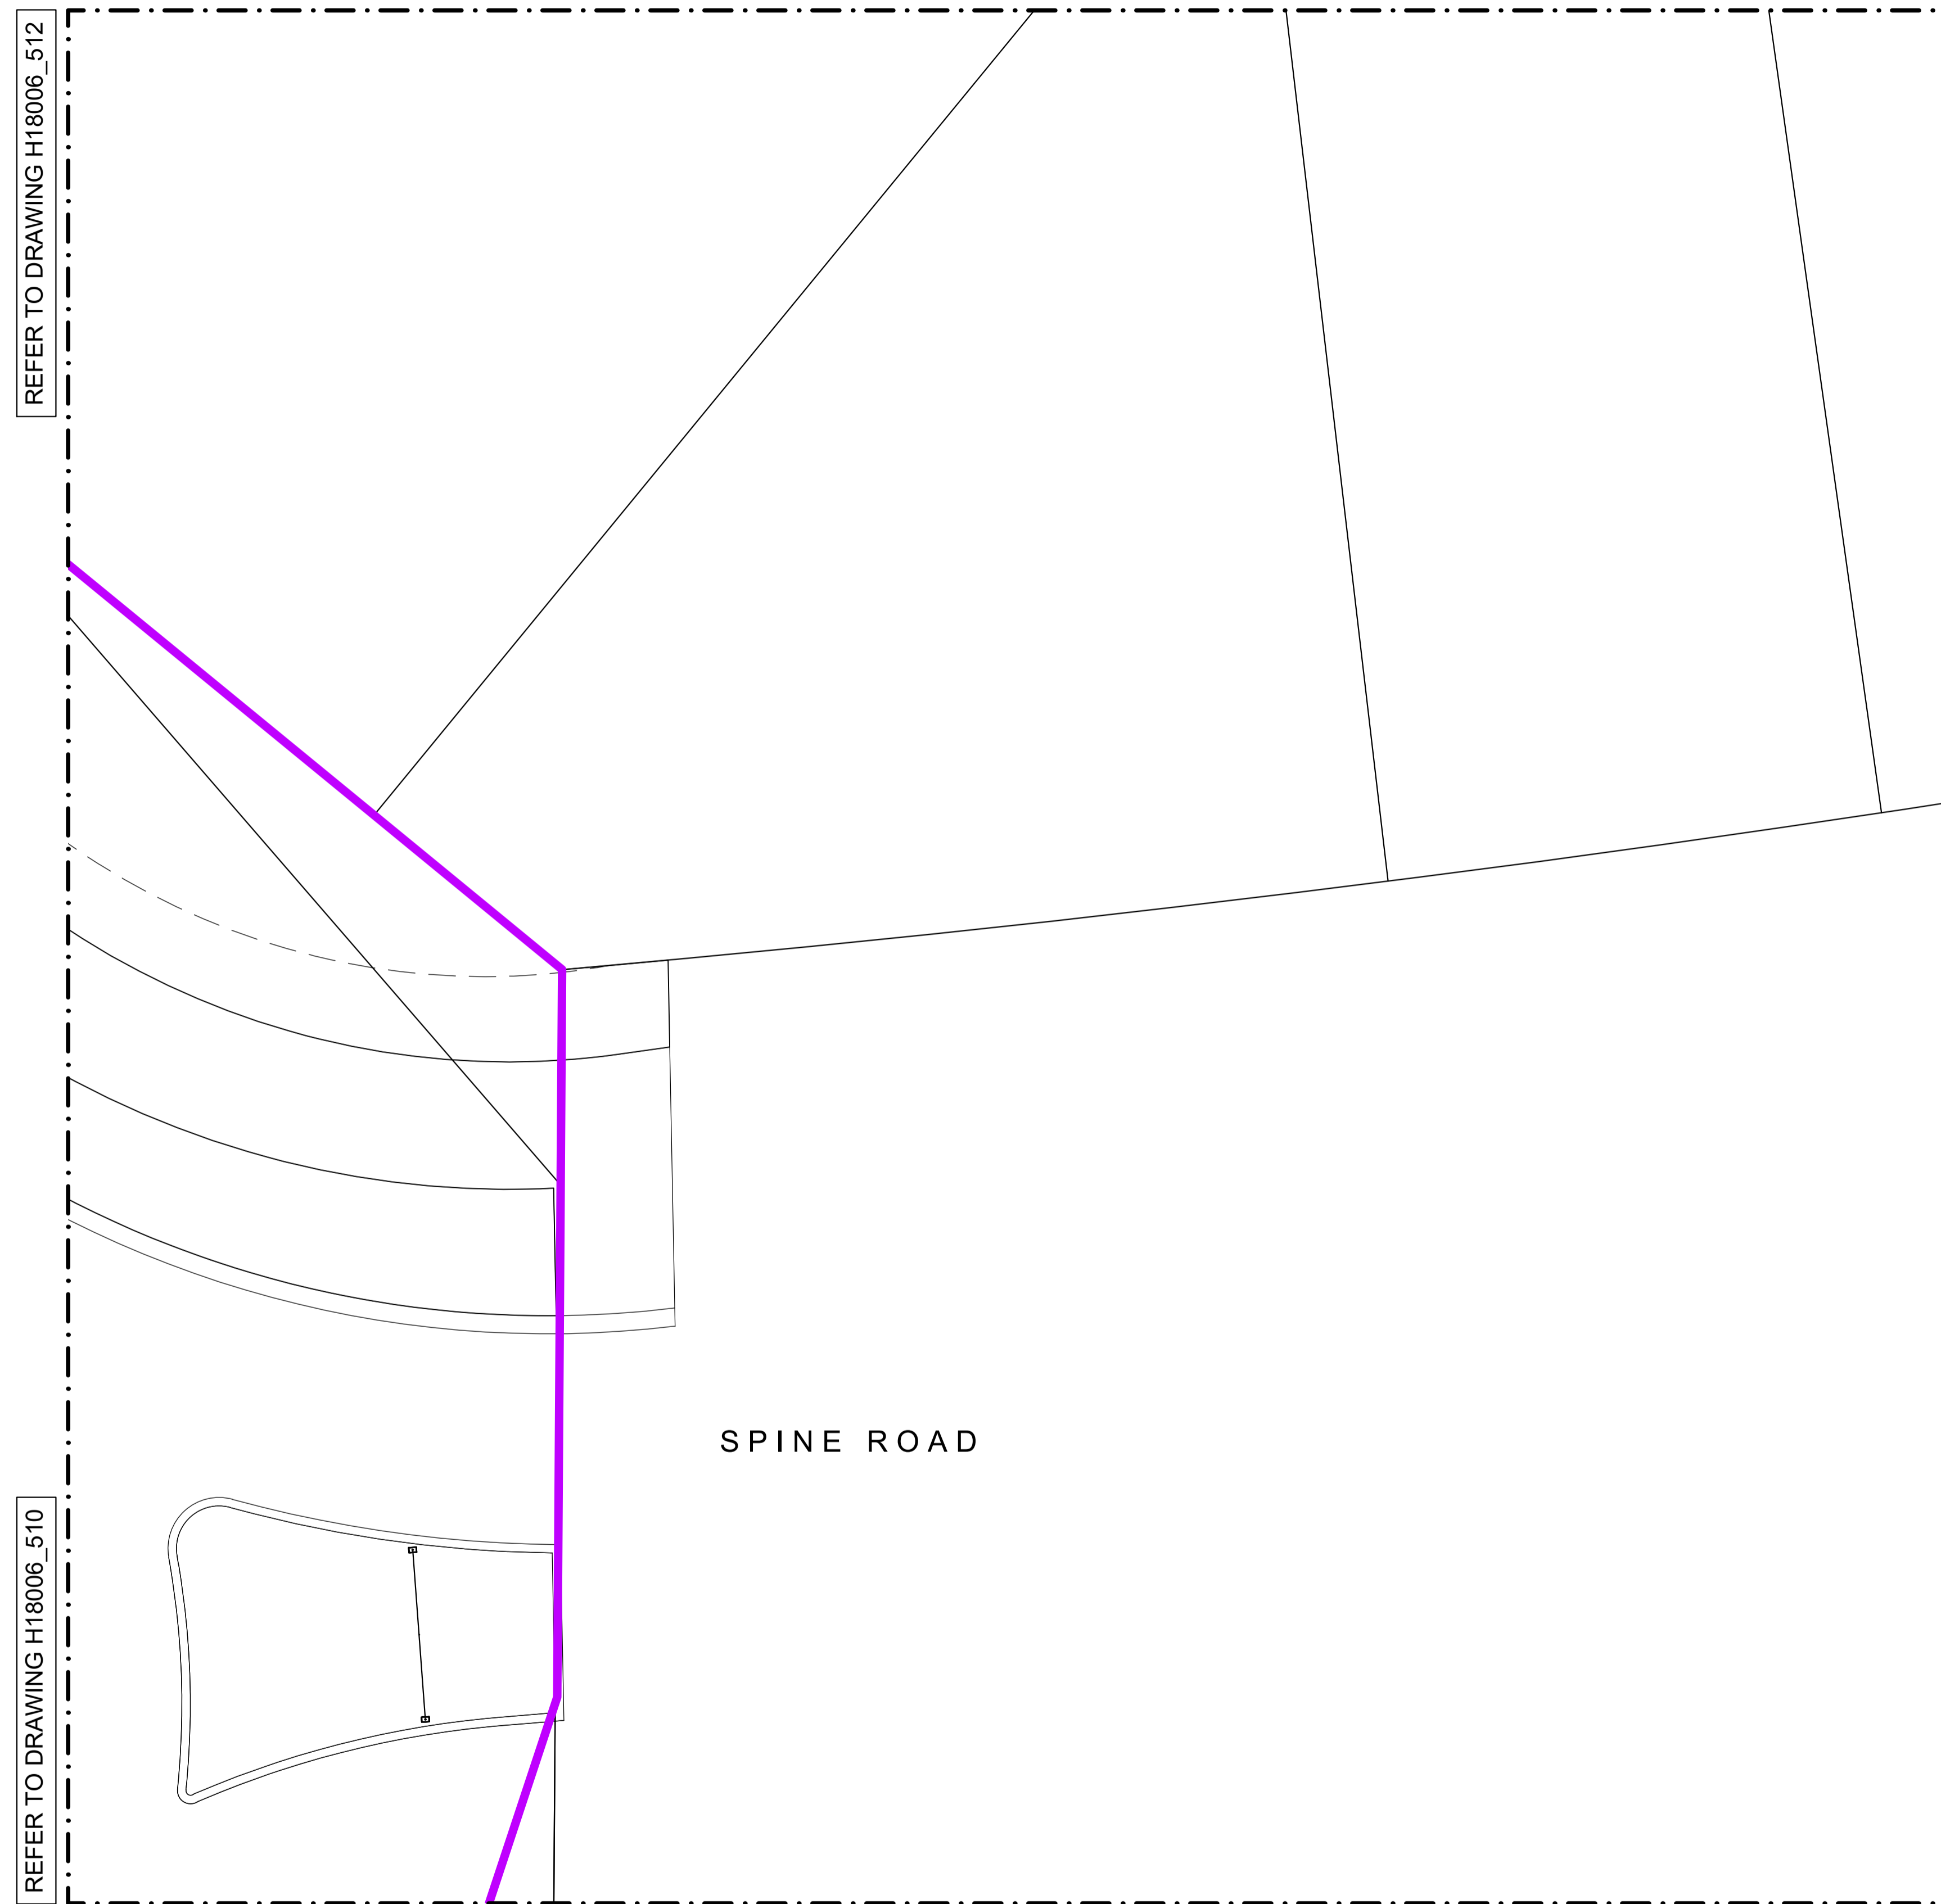

Boffa Miskell Limited
 Level 3, SouthBloc
 19 Knox Street
 PO Box 1094, Hamilton 3240, New Zealand
 Tel: +64 7 960 0006
 www.boffamiskell.co.nz

NOTES

CONTRACTORS TO VERIFY ALL DIMENSIONS ON SITE PRIOR TO COMMENCING WORK;
 CONTRACTORS ARE RESPONSIBLE FOR CONFIRMING THE LOCATION OF ALL UNDERGROUND SERVICES ON SITE PRIOR TO COMMENCING WORK;
 FIGURED DIMENSIONS TO BE TAKEN IN PREFERENCE TO SCALED DIMENSIONS.

KEY

— STAGE 13

REV	DATE	DESCRIPTION
0	02.07.19	ISSUED FOR CONSTRUCTION
1	31.07.20	PLANTING SUBSTITUTIONS, BACK BERM PLANTING AREAS SUBSTITUTED WITH LAWN
2	12.03.21	AS BUILT

CLIENT
 Chedworth Properties Ltd

CONSULTANTS
 S & L Consultants
 Beca
 Kendelier Lighting

AS BUILT

**GREENHILL PARK
 AREA M
 STAGE 13**



PLANTING PLAN
 SHEET 09 OF 17

Design	ARo	Scale	Date
Drawn	ARo	1:100 @ A1	02.07.19
Check	MHu	1:200 @ A3	
Appv'd			

DRAWING NO. REVISION

H18006_511

2

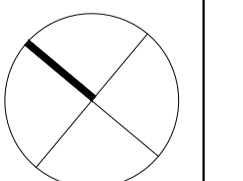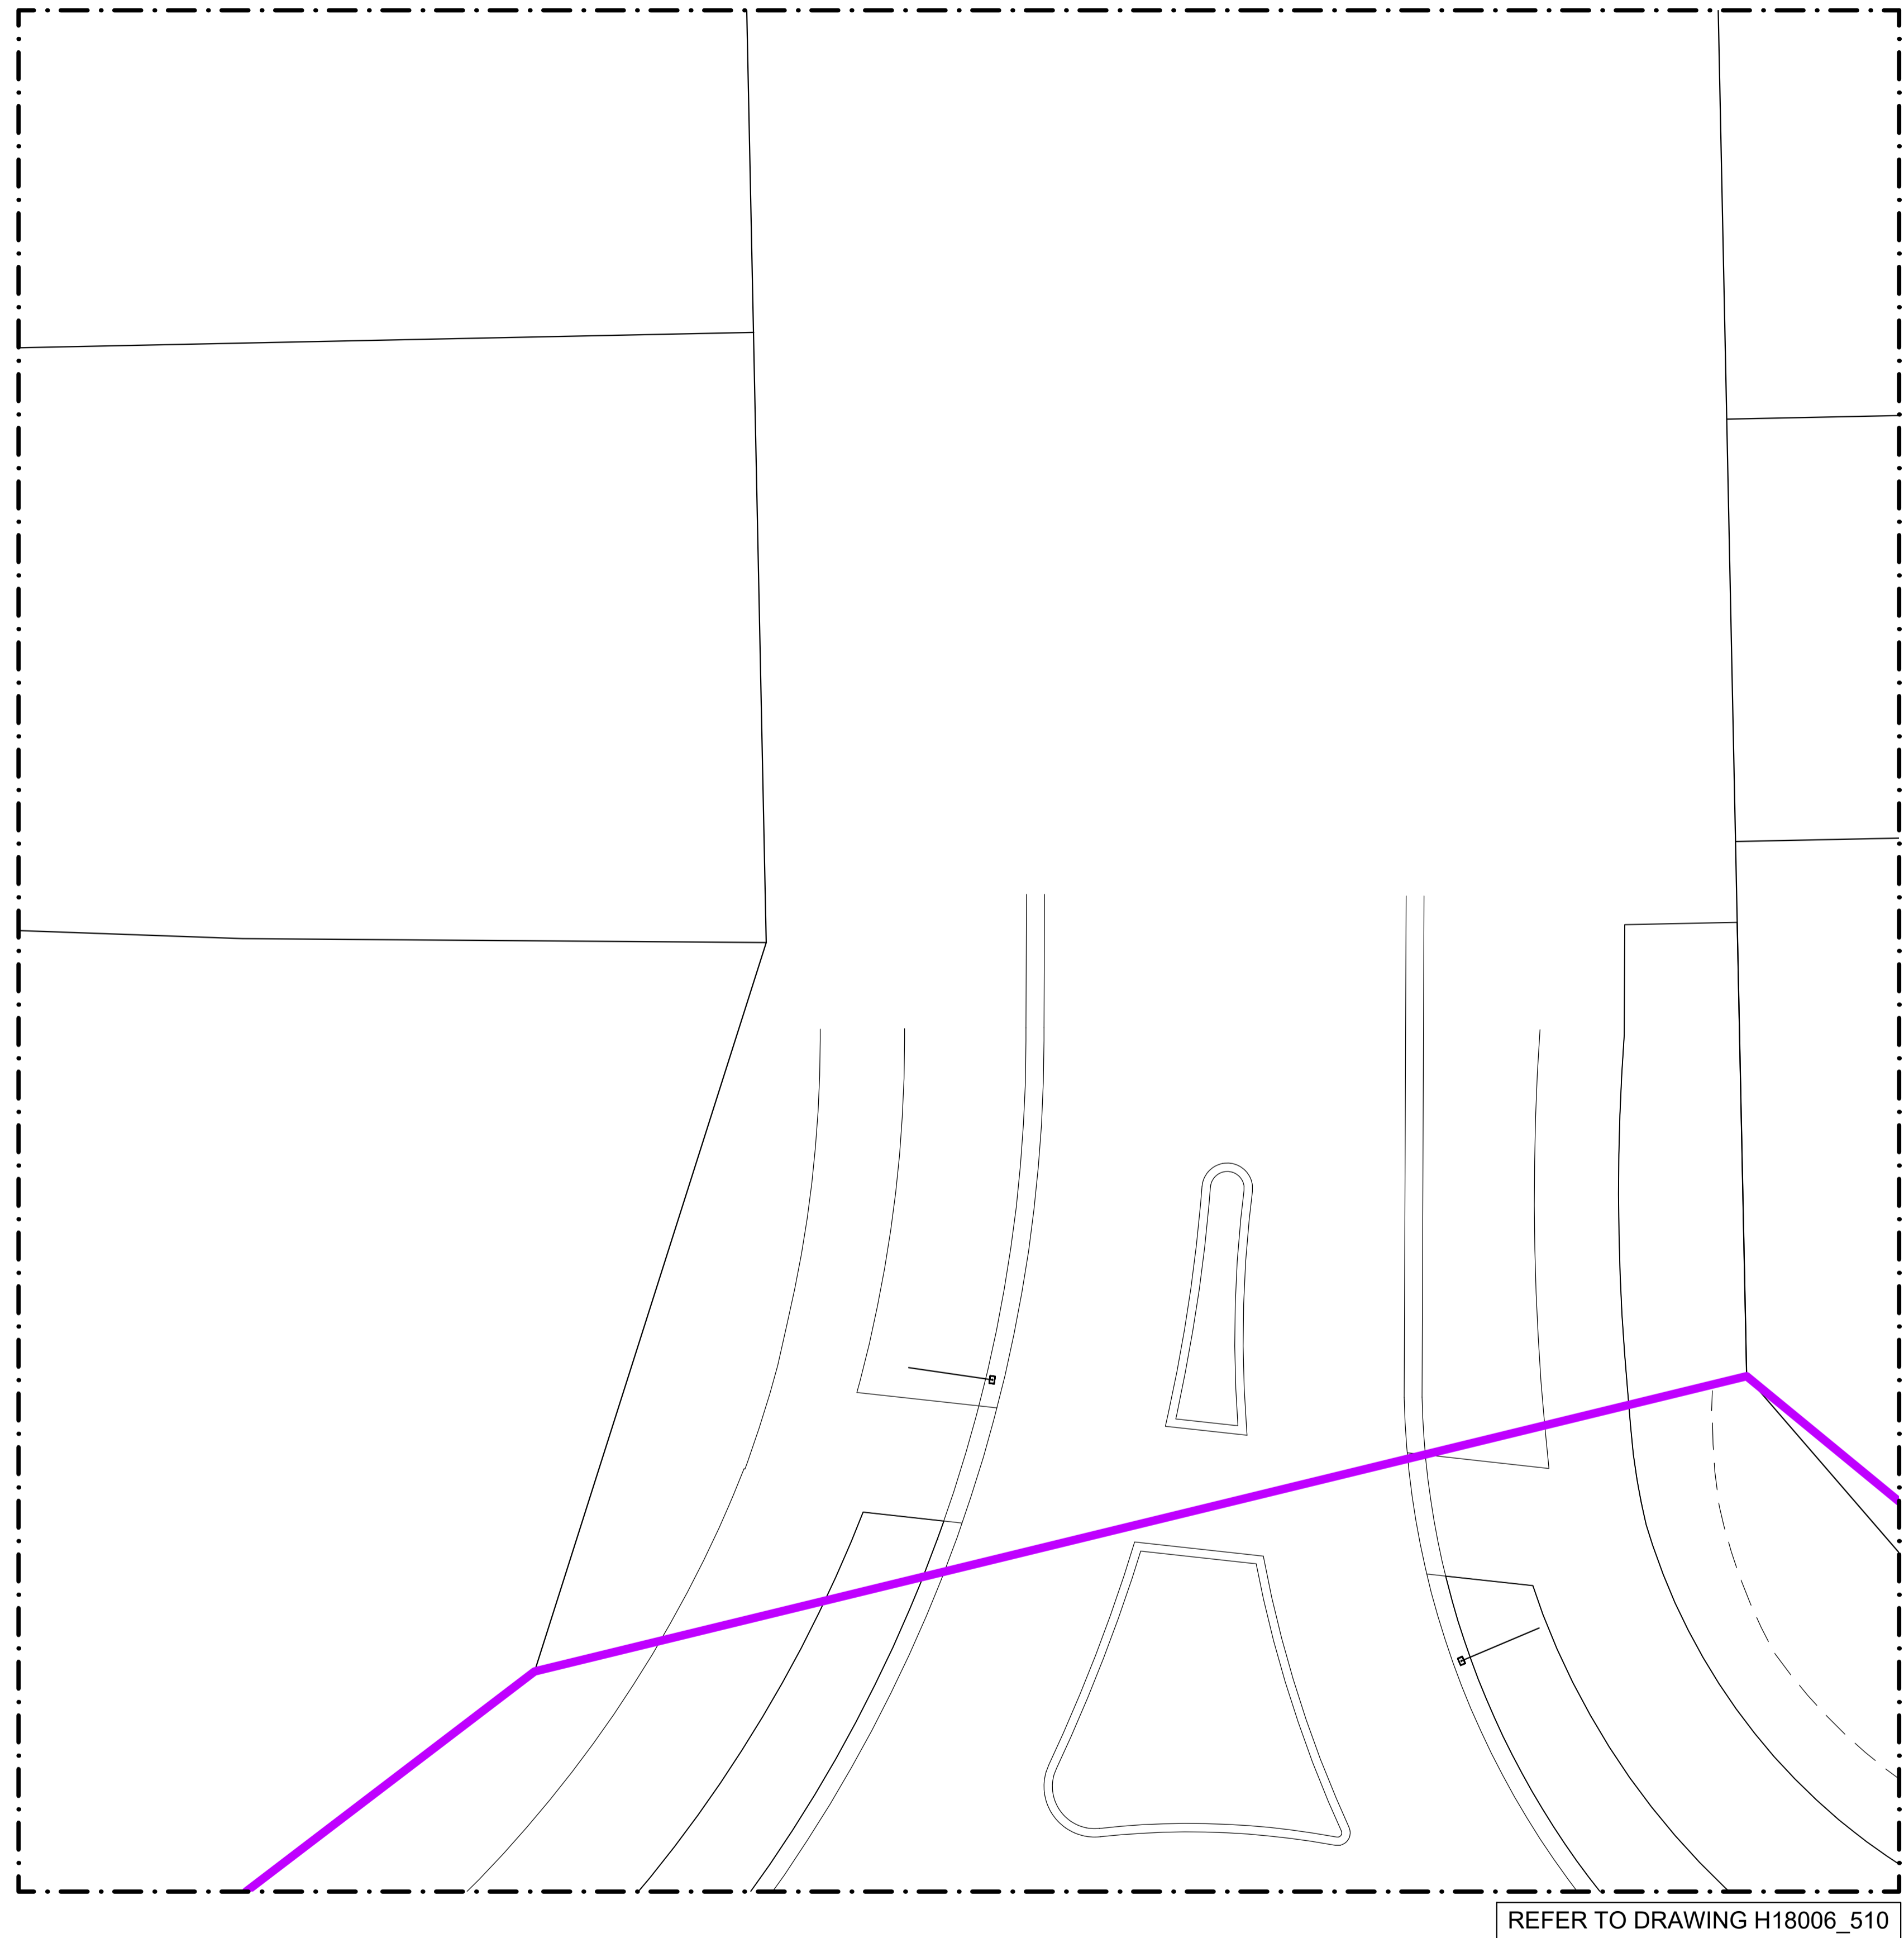

Boffa Miskell Limited
 Level 3, SouthBloc
 19 Knox Street
 PO Box 1094, Hamilton 3240, New Zealand
 Tel: +64 7 960 0006
 www.boffamiskell.co.nz

NOTES

CONTRACTORS TO VERIFY ALL DIMENSIONS ON SITE PRIOR TO COMMENCING WORK;
 CONTRACTORS ARE RESPONSIBLE FOR CONFIRMING THE LOCATION OF ALL UNDERGROUND SERVICES ON SITE PRIOR TO COMMENCING WORK;
 FIGURED DIMENSIONS TO BE TAKEN IN PREFERENCE TO SCALED DIMENSIONS.

KEY

— STAGE 13

REV	DATE	DESCRIPTION
0	02.07.19	ISSUED FOR CONSTRUCTION
1	31.07.20	PLANTING SUBSTITUTIONS, BACK BERM PLANTING AREAS SUBSTITUTED WITH LAWN
2	12.03.21	AS BUILT

CLIENT
 Chedworth Properties Ltd

CONSULTANTS
 S & L Consultants
 Beca
 Kendeiler Lighting

AS BUILT

**GREENHILL PARK
 AREA M
 STAGE 13**





PLANTING PLAN
 SHEET 10 OF 17


Design	ARo	Scale	Date
Drawn	ARo	1:100 @ A1	02.07.19
Check	MHu	1:200 @ A3	
Appv'd			

DRAWING NO. REVISION

H18006_512 (2)

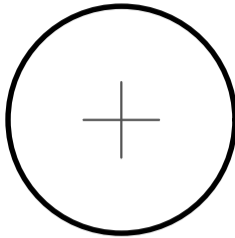
Key

-  Tree
-  Spine Road Berm Planting
-  Collector Road Berm Planting
-  Lawn

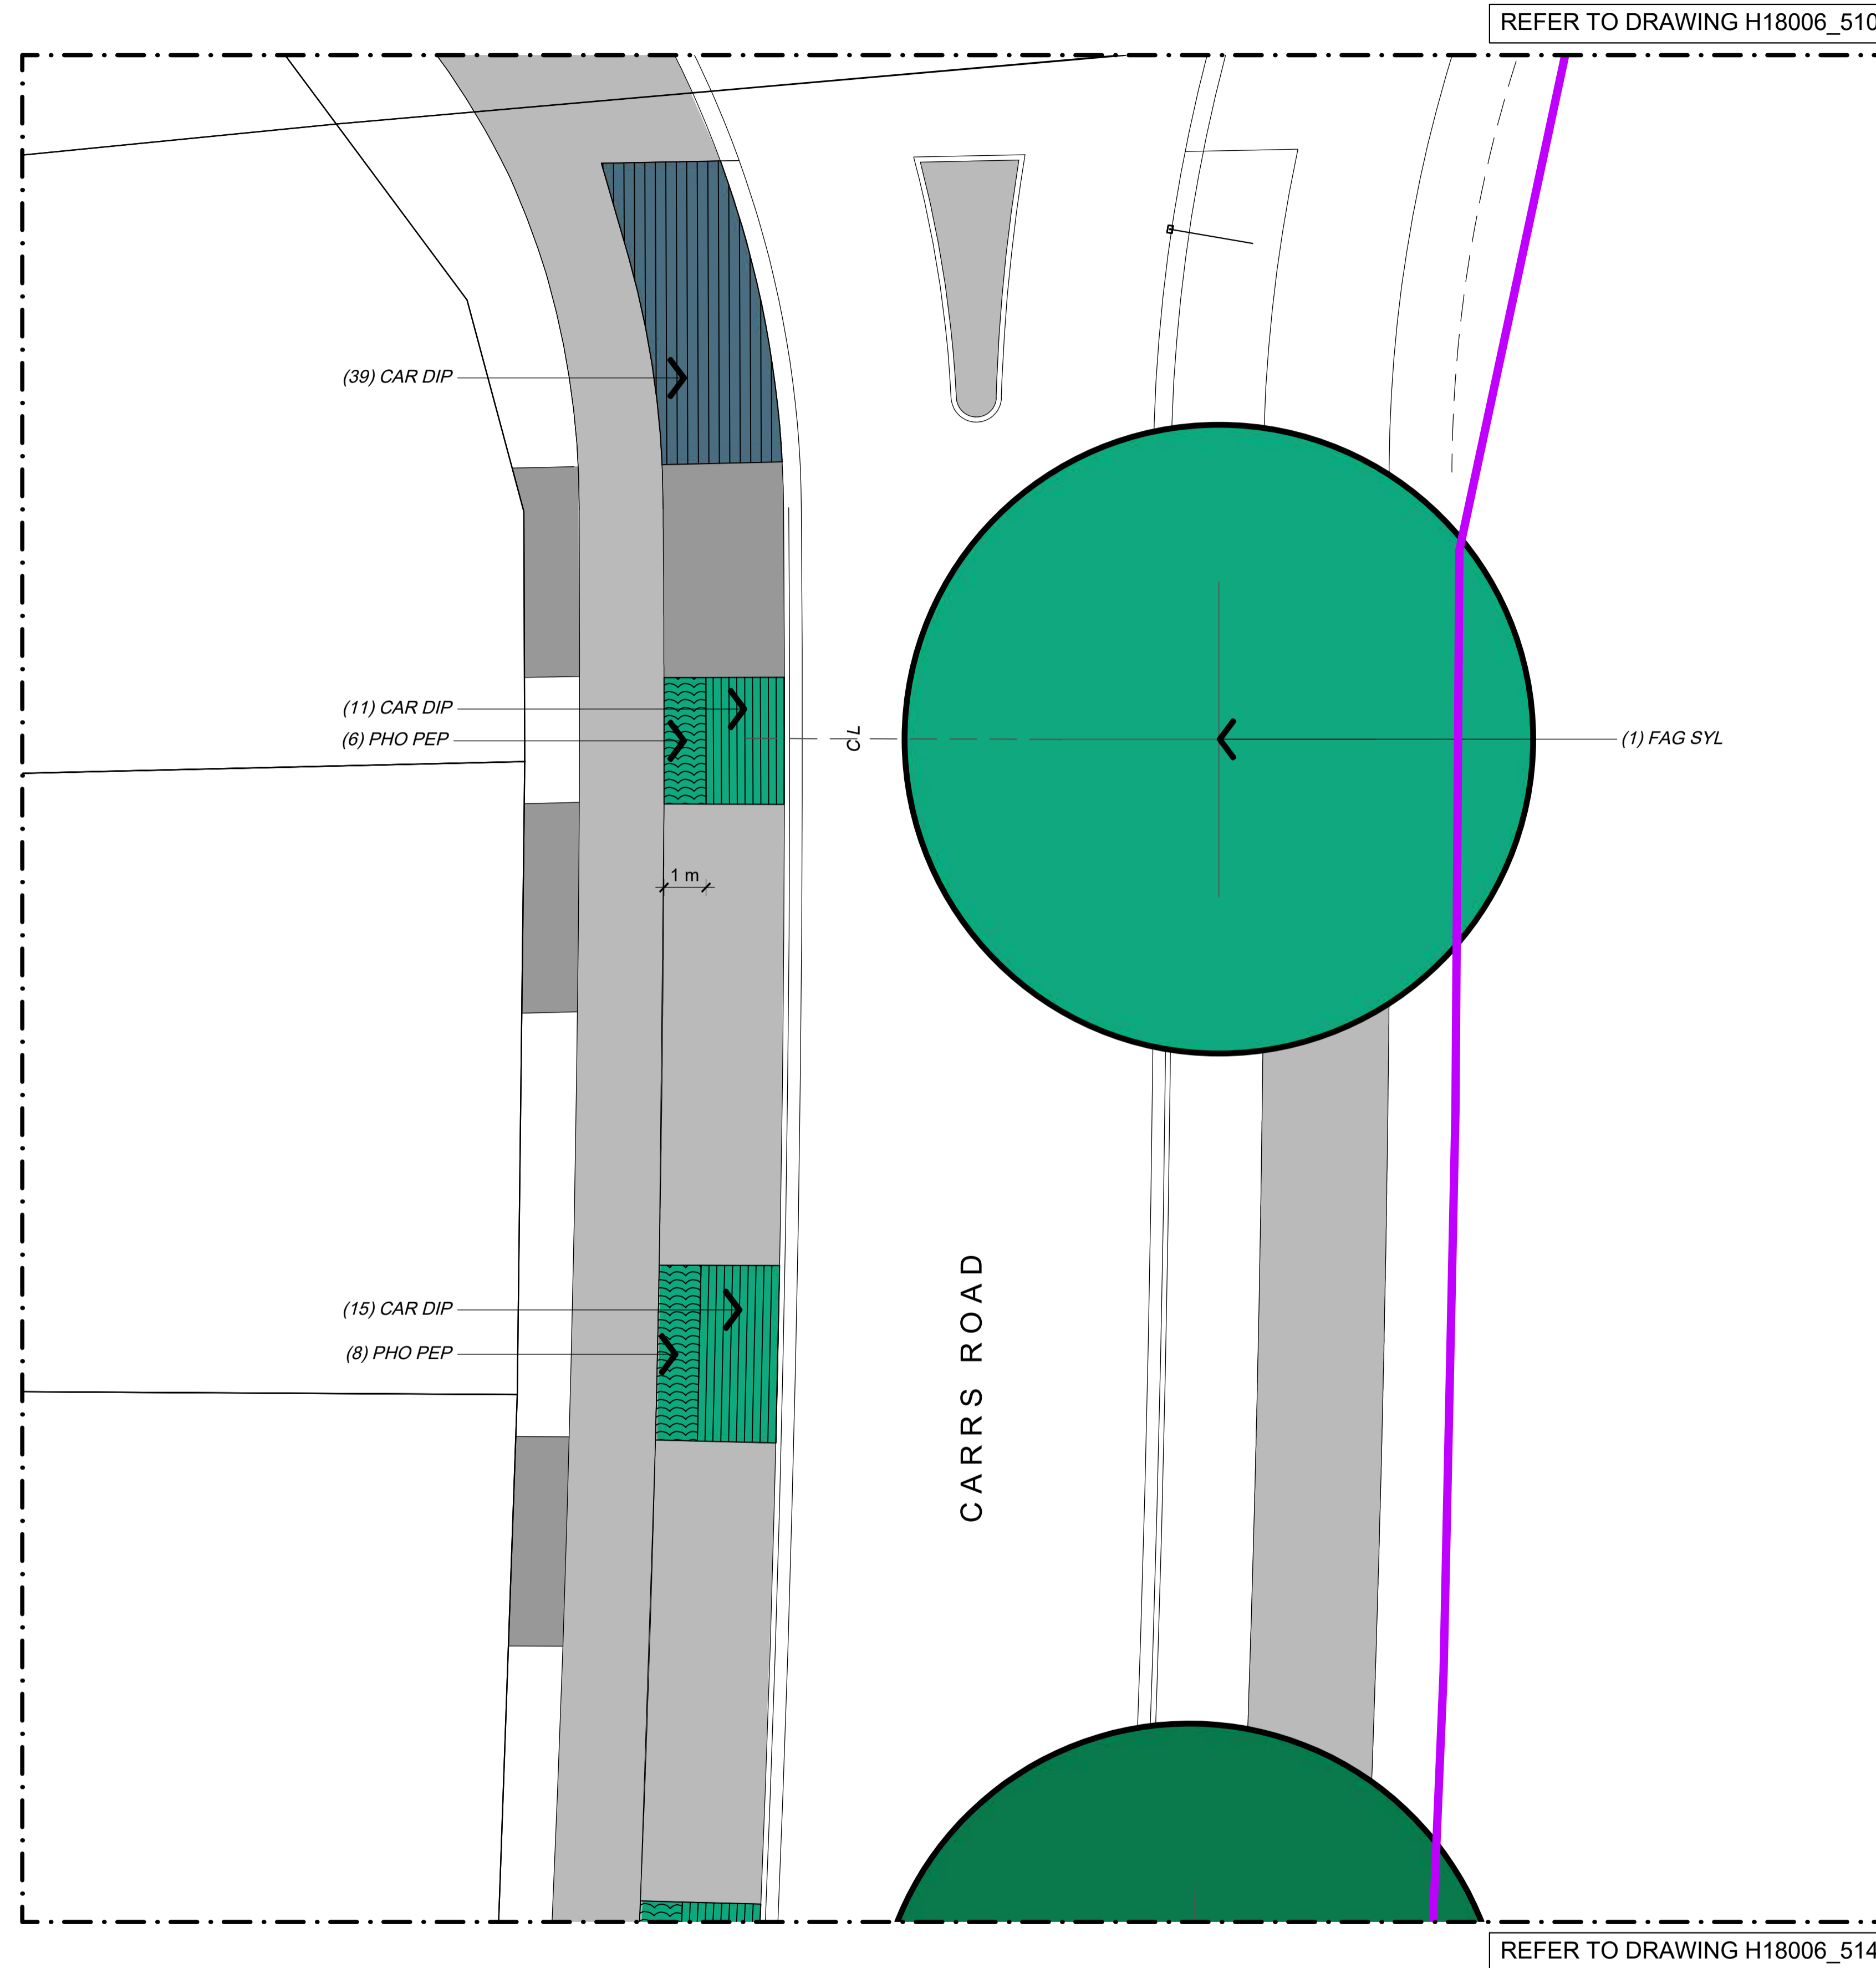

REFER TO DRAWING H18006_510

REFER TO DRAWING H18006_514

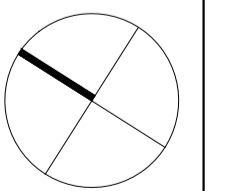

Boffa Miskell Limited
 Level 3, SouthBloc
 19 Knox Street
 PO Box 1094, Hamilton 3240, New Zealand
 Tel: +64 7 960 0006
 www.boffamiskell.co.nz

NOTES

CONTRACTORS TO VERIFY ALL DIMENSIONS ON SITE PRIOR TO COMMENCING WORK;
 CONTRACTORS ARE RESPONSIBLE FOR CONFIRMING THE LOCATION OF ALL UNDERGROUND SERVICES ON SITE PRIOR TO COMMENCING WORK;
 FIGURED DIMENSIONS TO BE TAKEN IN PREFERENCE TO SCALED DIMENSIONS.

KEY

 STAGE 13

REV	DATE	DESCRIPTION
0	02.07.19	ISSUED FOR CONSTRUCTION
1	31.07.20	PLANTING SUBSTITUTIONS, BACK BERM PLANTING AREAS SUBSTITUTED WITH LAWN
2	12.03.21	AS BUILT

CLIENT
 Chedworth Properties Ltd

CONSULTANTS
 S & L Consultants
 Beca
 Kendeiler Lighting

AS BUILT

**GREENHILL PARK
 AREA M
 STAGE 13**

PLANTING PLAN
 SHEET 11 OF 17

Design	ARo	Scale	Date
Drawn	ARo	1:100 @ A1	02.07.19
Check	MHu	1:200 @ A3	
App'vd			




DRAWING NO. REVISION


H18006_513

2


REFER TO DRAWING H18006_513

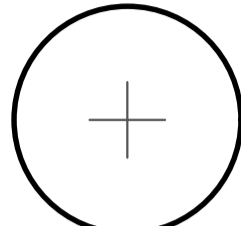Key

-  Tree
-  Collector Road Berm Planting
-  Lawn

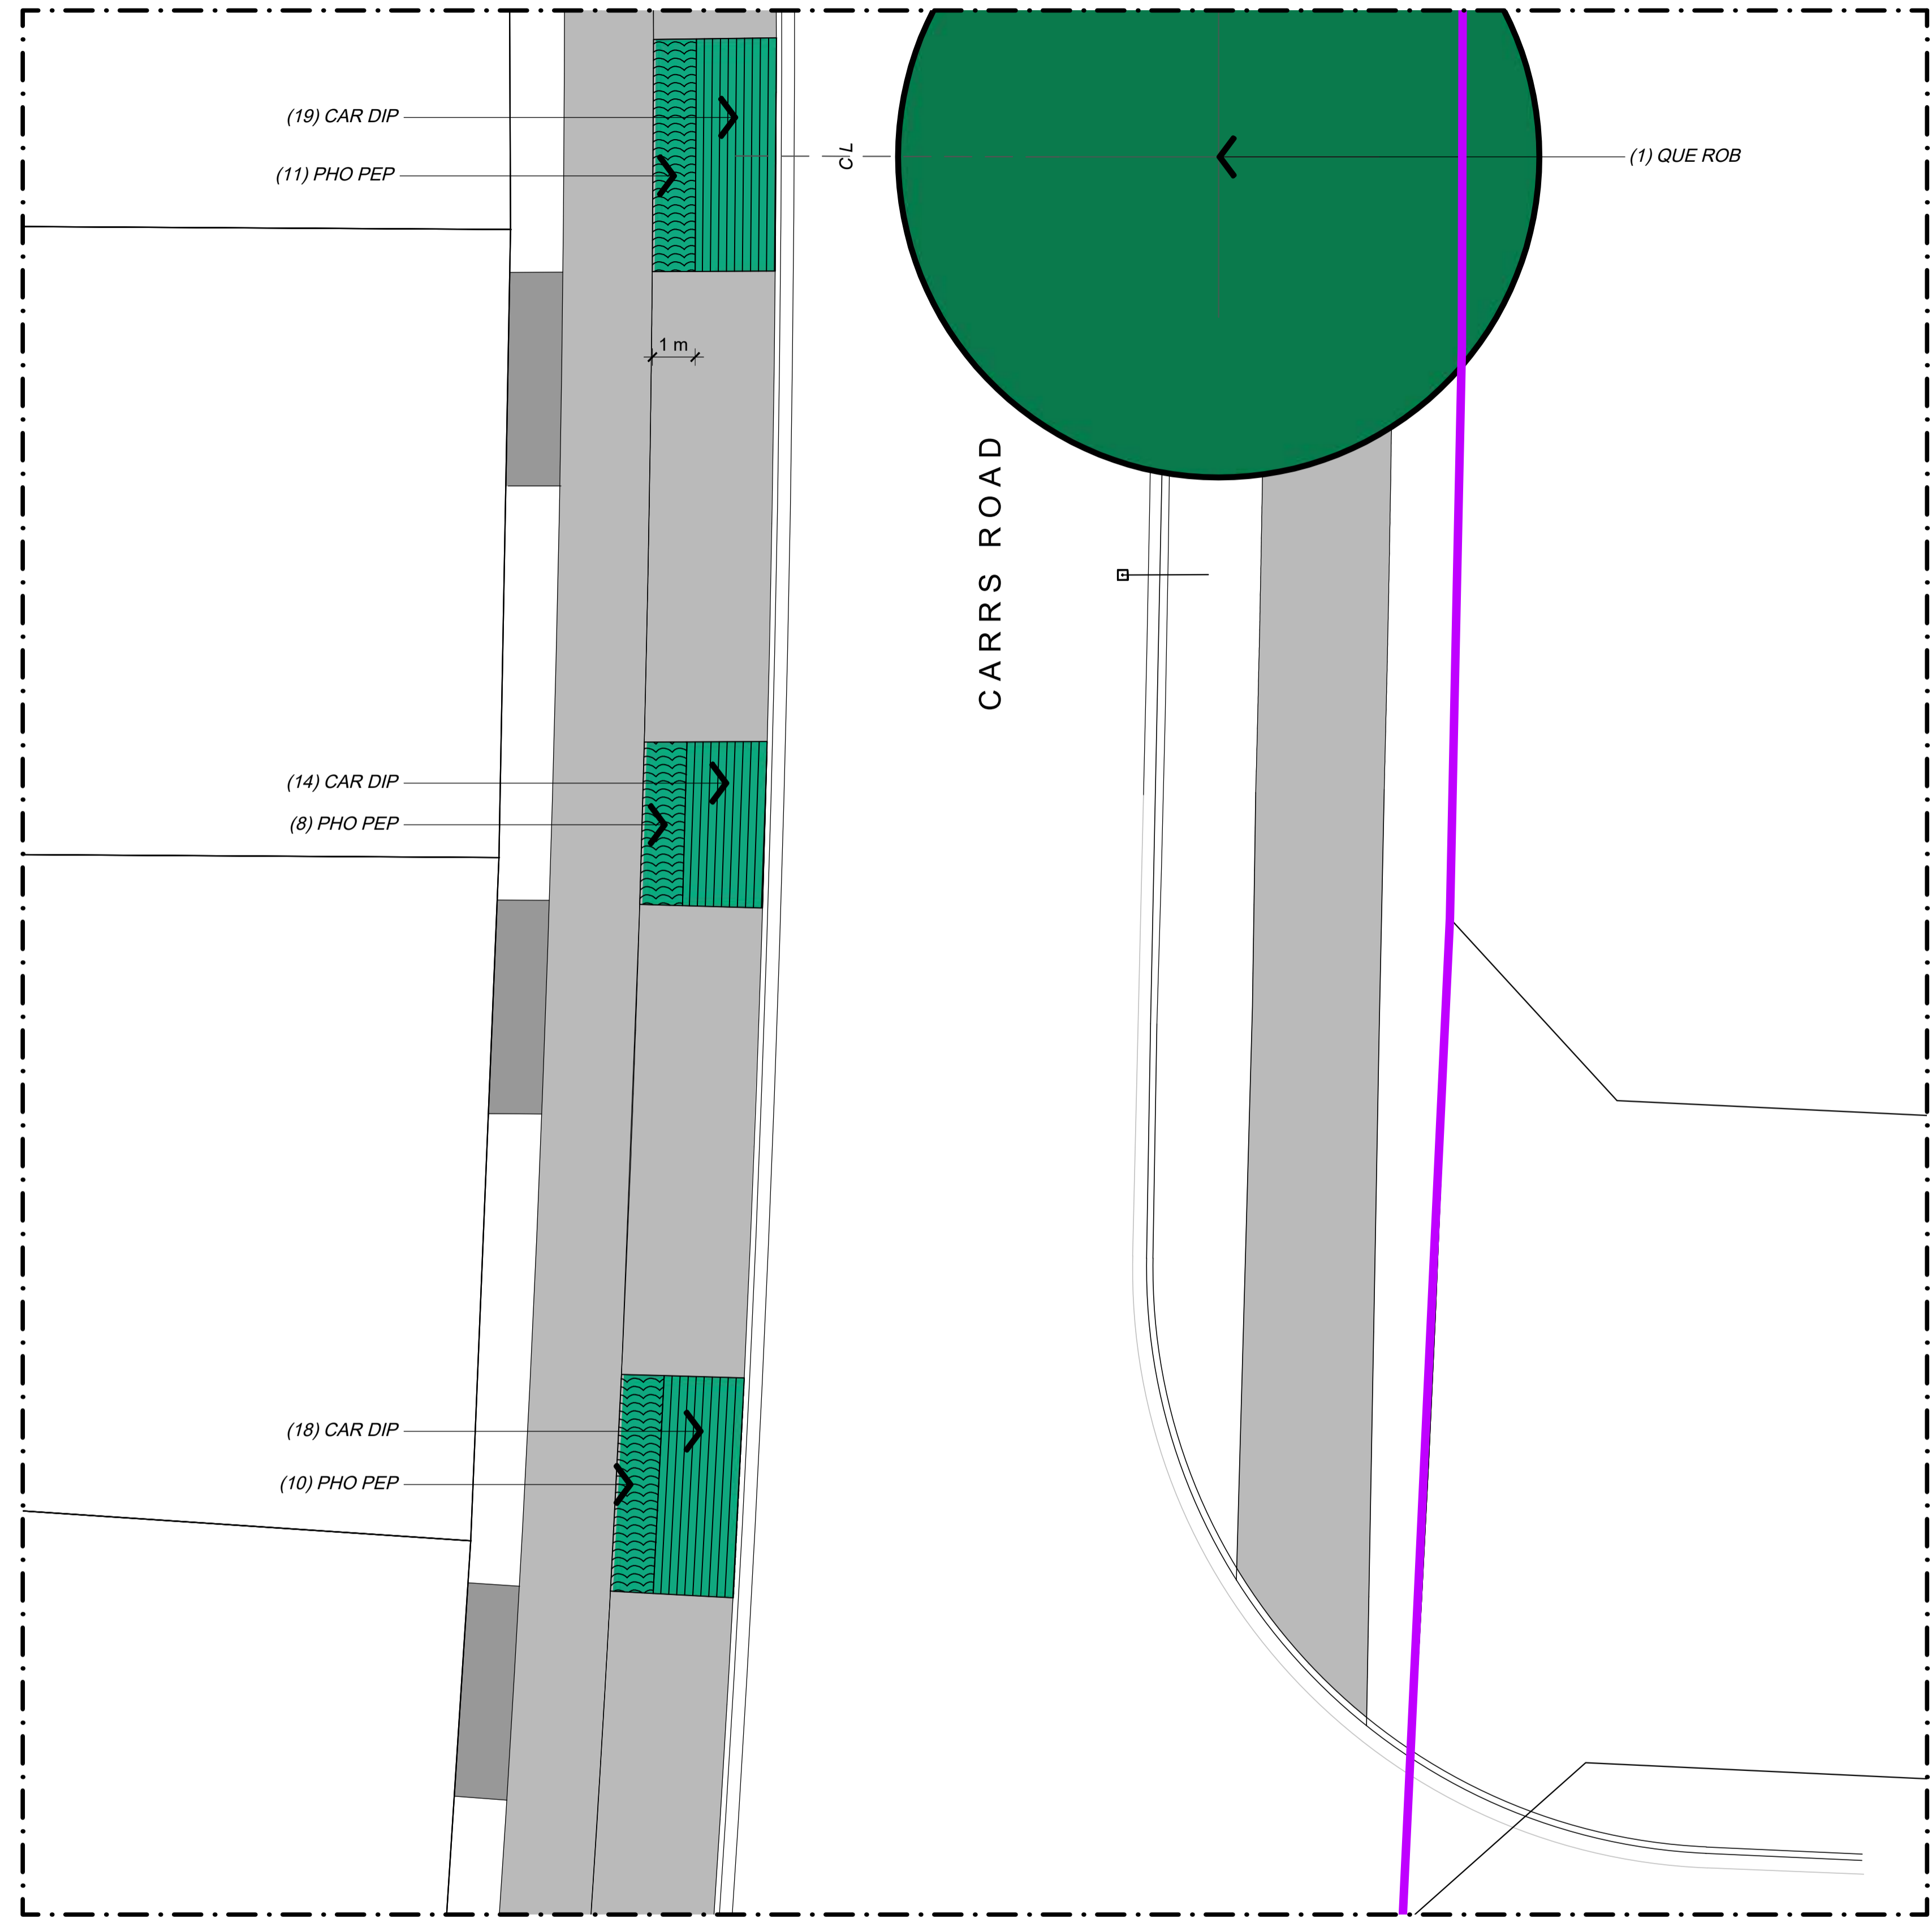

REFER TO DRAWING H18006_513

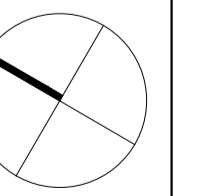


Boffa Miskell Limited
 Level 3, SouthBloc
 19 Knox Street
 PO Box 1094, Hamilton 3240, New Zealand
 Tel: +64 7 960 0006
 www.boffamiskell.co.nz

NOTES

CONTRACTORS TO VERIFY ALL DIMENSIONS ON SITE PRIOR TO COMMENCING WORK;
 CONTRACTORS ARE RESPONSIBLE FOR CONFIRMING THE LOCATION OF ALL UNDERGROUND SERVICES ON SITE PRIOR TO COMMENCING WORK;
 FIGURED DIMENSIONS TO BE TAKEN IN PREFERENCE TO SCALED DIMENSIONS.

KEY

 STAGE 13

REV	DATE	DESCRIPTION
0	02.07.19	ISSUED FOR CONSTRUCTION
1	31.07.20	PLANTING SUBSTITUTIONS, BACK BERM PLANTING AREAS SUBSTITUTED WITH LAWN
2	12.03.21	AS BUILT

CLIENT
 Chedworth Properties Ltd

CONSULTANTS
 S & L Consultants
 Beca
 Kendellier Lighting

AS BUILT




GREENHILL PARK
 AREA M
 STAGE 13
 PLANTING PLAN
 SHEET 12 OF 17


Design	ARo	Scale	Date
Drawn	ARo	1:100 @ A1	02.07.19
Check	MHu	1:200 @ A3	
App'vd			

DRAWING NO.	REVISION
H18006_514	2


REFER TO DRAWING H18006_514

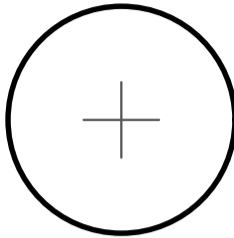Key

-  Tree
-  Collector Road Berm Planting
-  Lawn

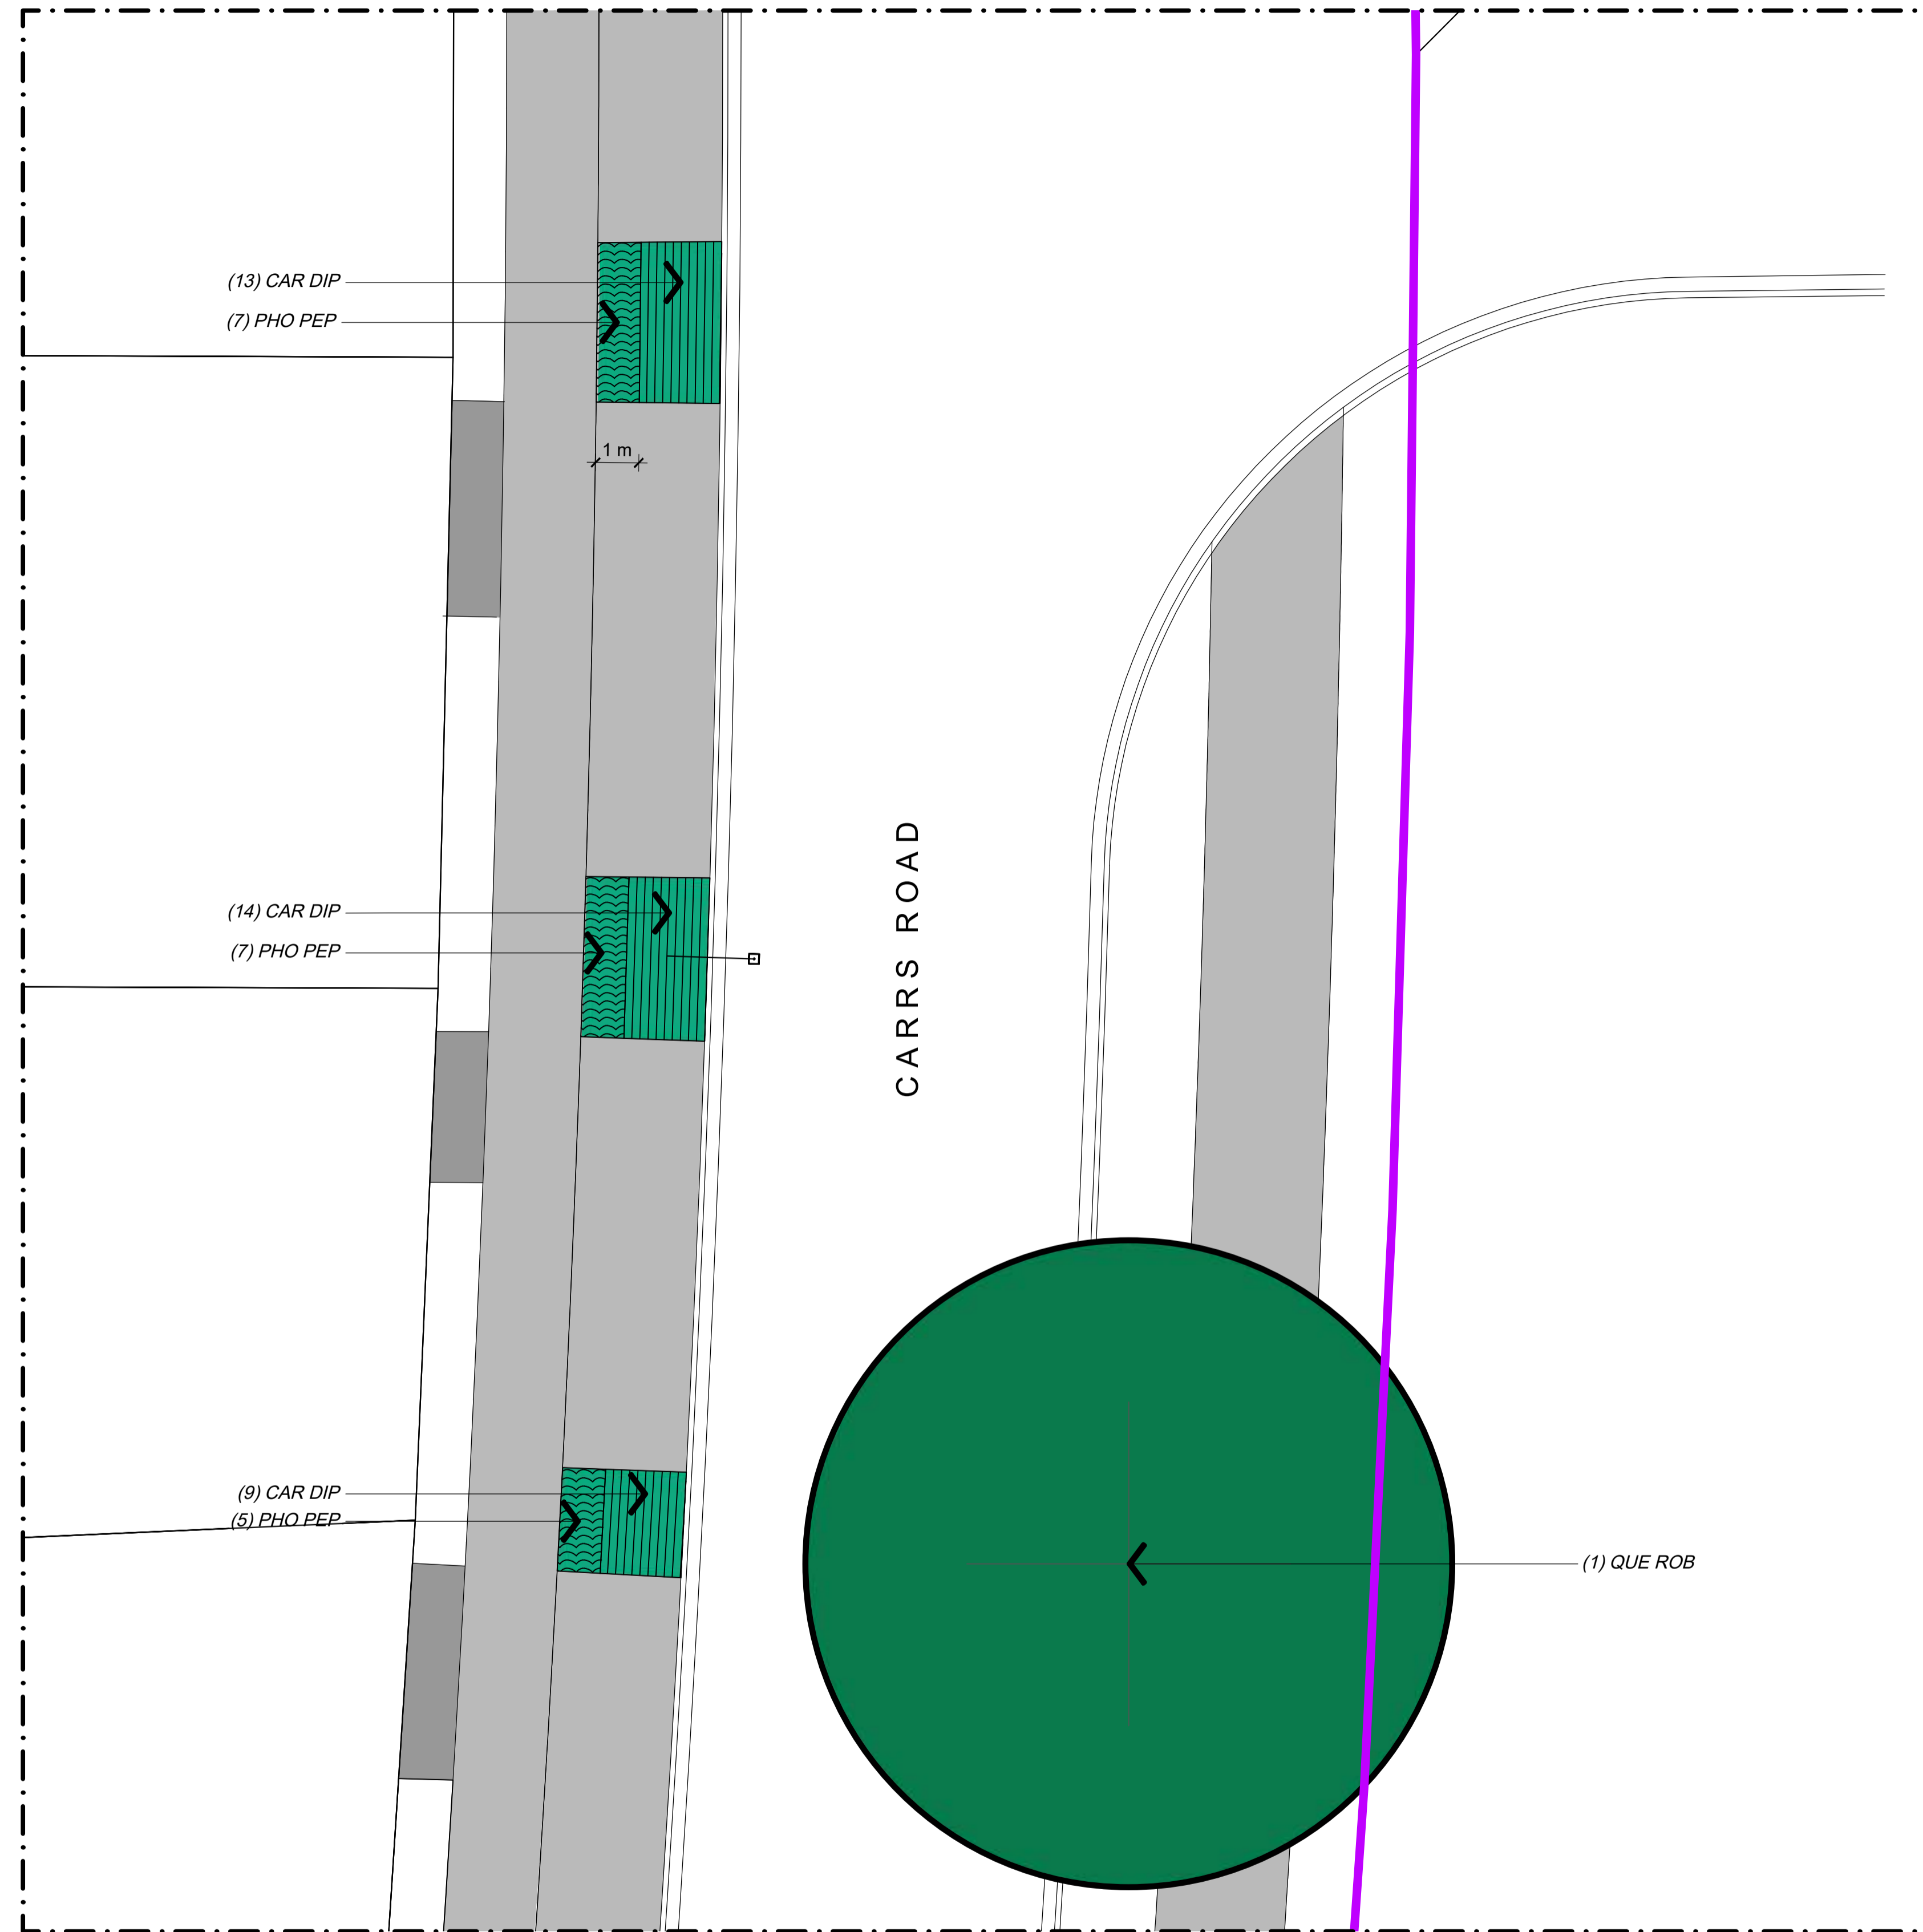

REFER TO DRAWING H18006_516

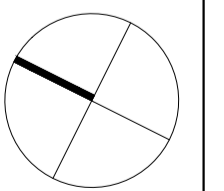

Boffa Miskell Limited
 Level 3, SouthBloc
 19 Knox Street
 PO Box 1094, Hamilton 3240, New Zealand
 Tel: +64 7 960 0006
 www.boffamiskell.co.nz

NOTES

CONTRACTORS TO VERIFY ALL DIMENSIONS ON SITE PRIOR TO COMMENCING WORK;
 CONTRACTORS ARE RESPONSIBLE FOR CONFIRMING THE LOCATION OF ALL UNDERGROUND SERVICES ON SITE PRIOR TO COMMENCING WORK;
 FIGURED DIMENSIONS TO BE TAKEN IN PREFERENCE TO SCALED DIMENSIONS.

KEY

 STAGE 13

REV	DATE	DESCRIPTION
0	02.07.19	ISSUED FOR CONSTRUCTION
1	31.07.20	PLANTING SUBSTITUTIONS, BACK BERM PLANTING AREAS SUBSTITUTED WITH LAWN
2	12.03.21	AS BUILT

CLIENT
 Chedworth Properties Ltd

CONSULTANTS
 S & L Consultants
 Beca
 Kendellier Lighting

AS BUILT

**GREENHILL PARK
 AREA M
 STAGE 13**




PLANTING PLAN
 SHEET 13 OF 17


Design	ARo	Scale	Date
Drawn	ARo	1:100 @ A1	02.07.19
Check	MHu	1:200 @ A3	
Appv'd			

DRAWING NO.	REVISION
H18006_515	2


REFER TO DRAWING H18006_515

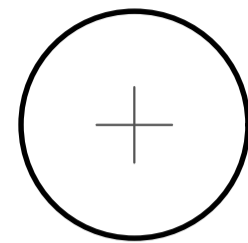Key

-  Tree
-  Collector Road Berm Planting
-  Lawn

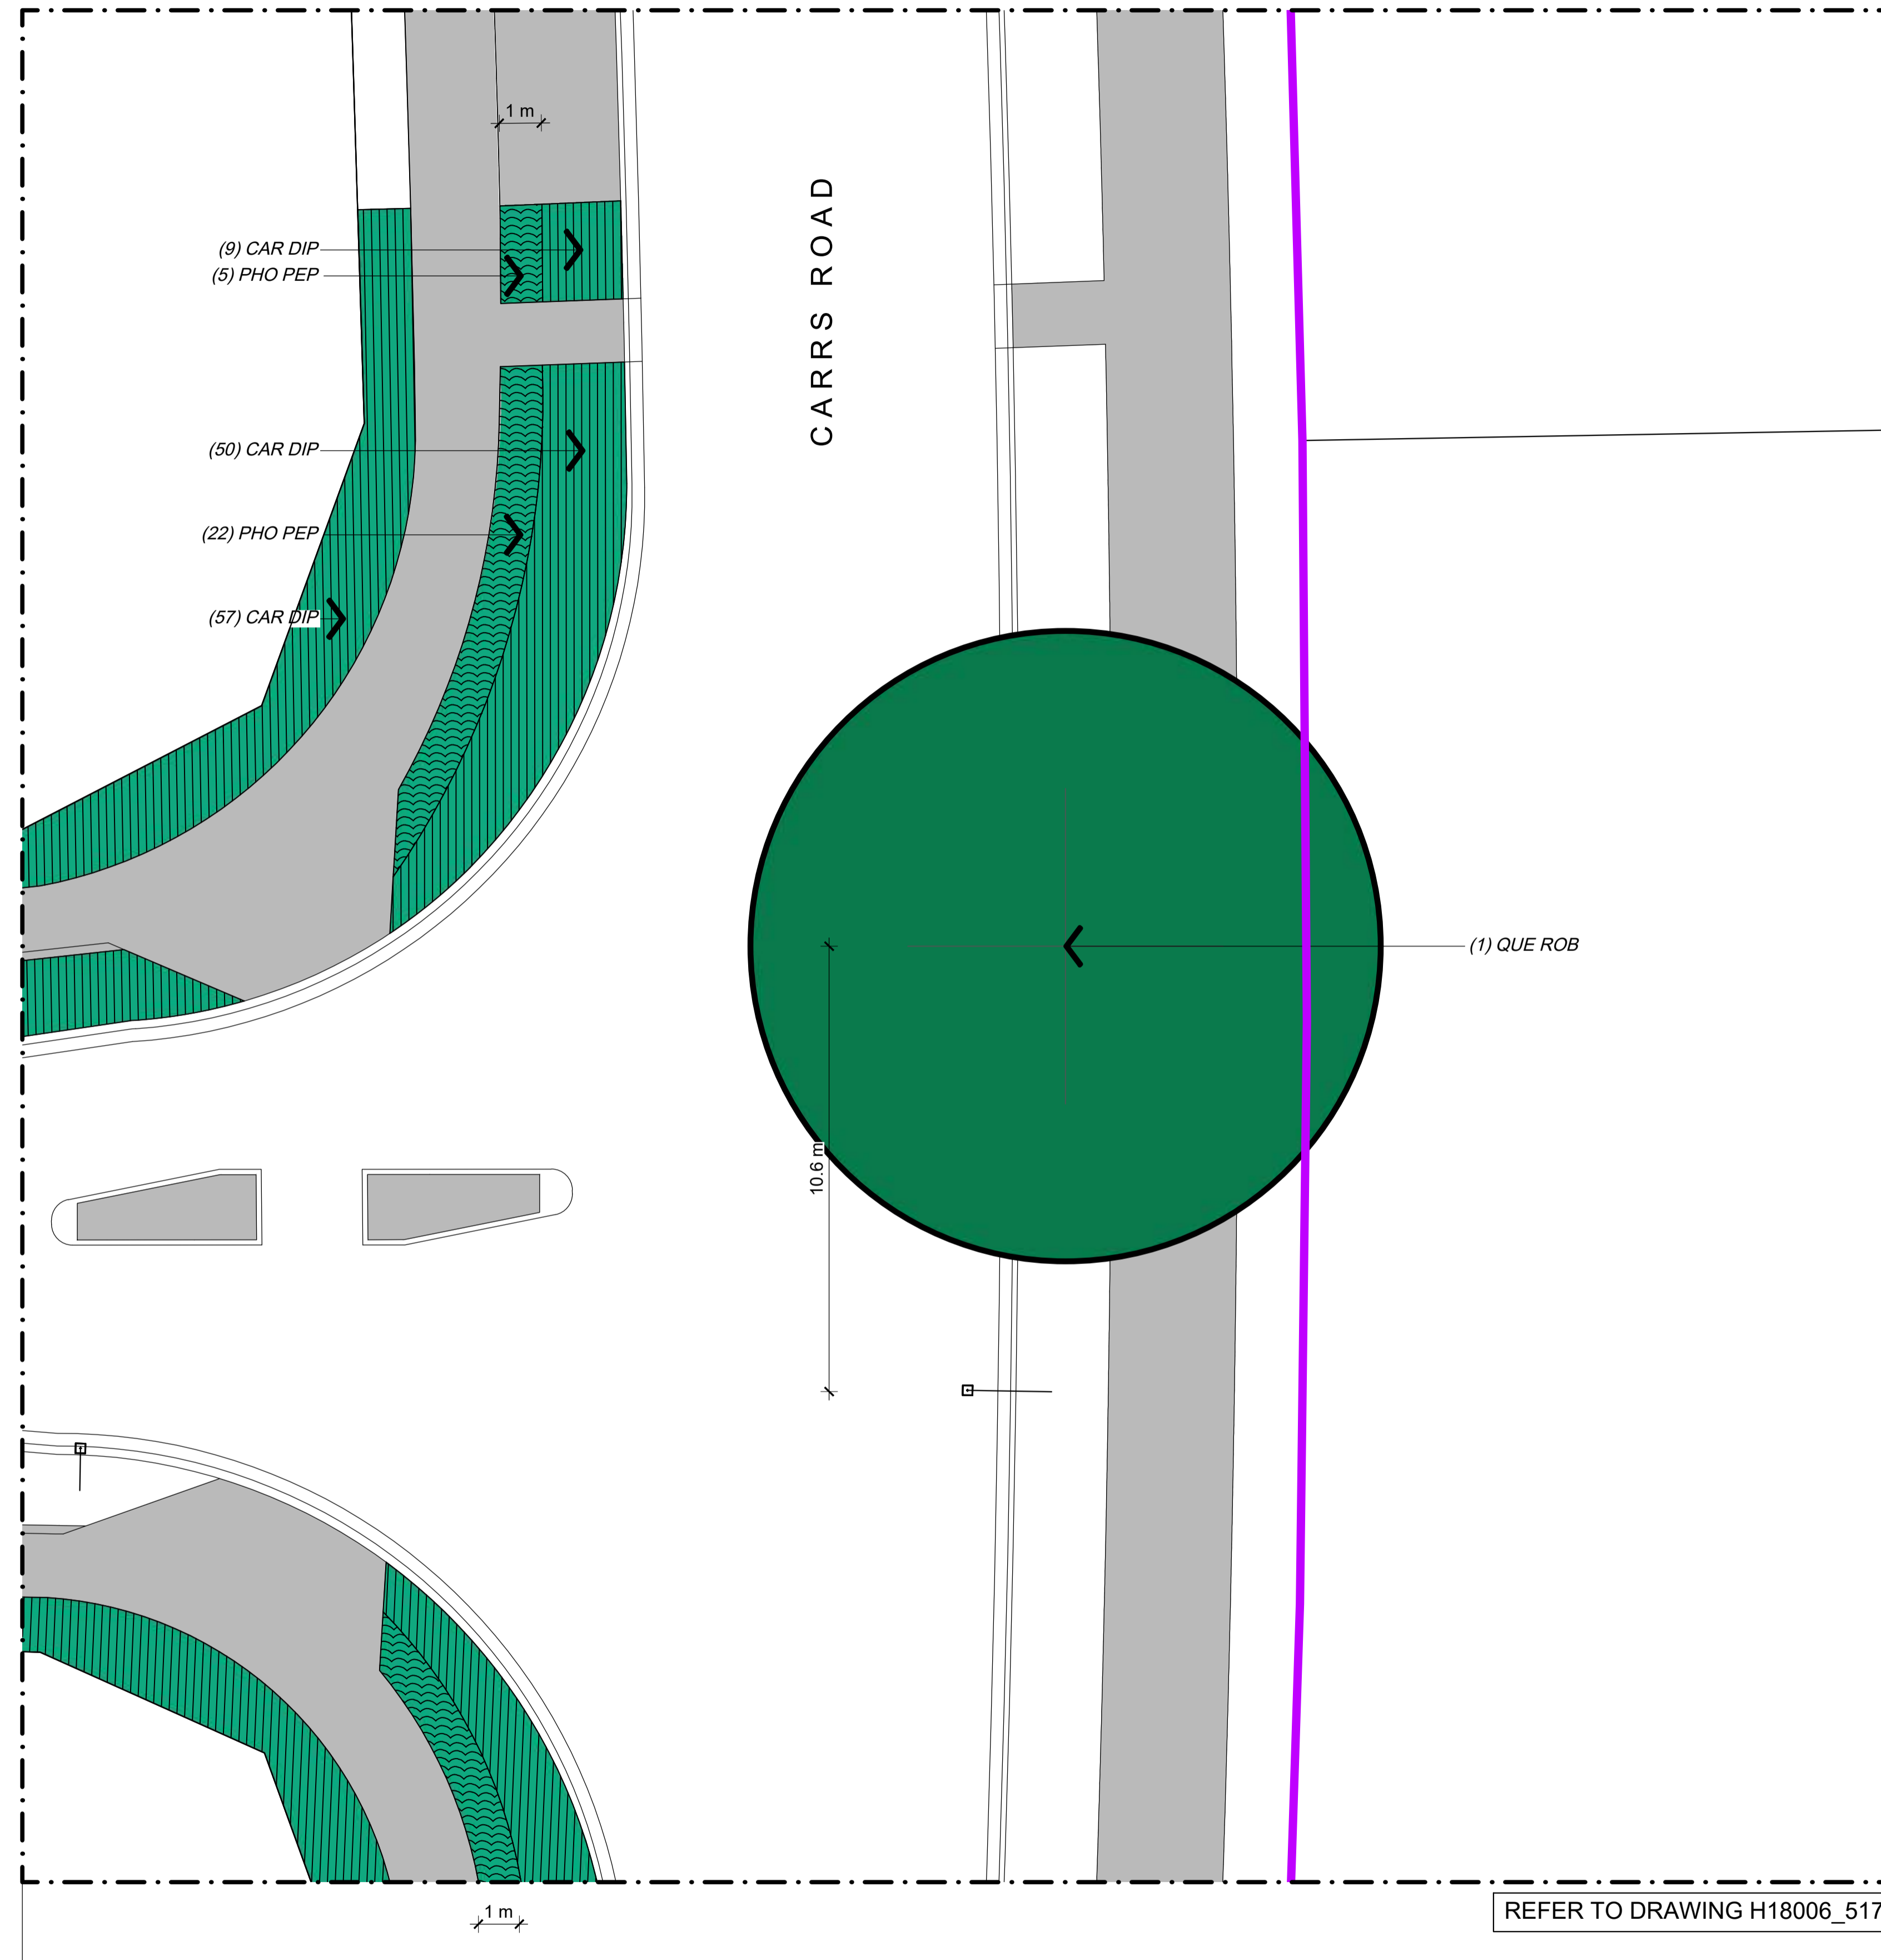

REFER TO DRAWING H18006_517

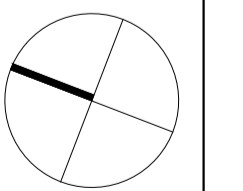

NOTES

- CONTRACTORS TO VERIFY ALL DIMENSIONS ON SITE PRIOR TO COMMENCING WORK;
- CONTRACTORS ARE RESPONSIBLE FOR CONFIRMING THE LOCATION OF ALL UNDERGROUND SERVICES ON SITE PRIOR TO COMMENCING WORK;
- FIGURED DIMENSIONS TO BE TAKEN IN PREFERENCE TO SCALED DIMENSIONS.

KEY

-  STAGE 13

REV	DATE	DESCRIPTION
0	02.07.19	ISSUED FOR CONSTRUCTION
1	31.07.20	PLANTING SUBSTITUTIONS, BACK BERM PLANTING AREAS SUBSTITUTED WITH LAWN
2	12.03.21	AS BUILT

CLIENT
 Chedworth Properties Ltd

CONSULTANTS
 S & L Consultants
 Beca
 Kendeiler Lighting

AS BUILT

**GREENHILL PARK
 AREA M
 STAGE 13**

PLANTING PLAN
 SHEET 14 OF 17

Design	ARo	Scale	Date
Drawn	ARo	1:100 @ A1	02.07.19
Check	MHu	1:200 @ A3	
Appv'd			




DRAWING NO. REVISION


H18006_516

2


REFER TO DRAWING H18006_516

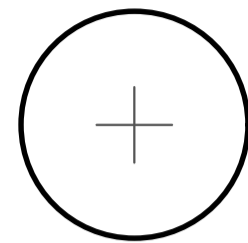Key

-  Tree
-  Collector Road Berm Planting
-  Lawn

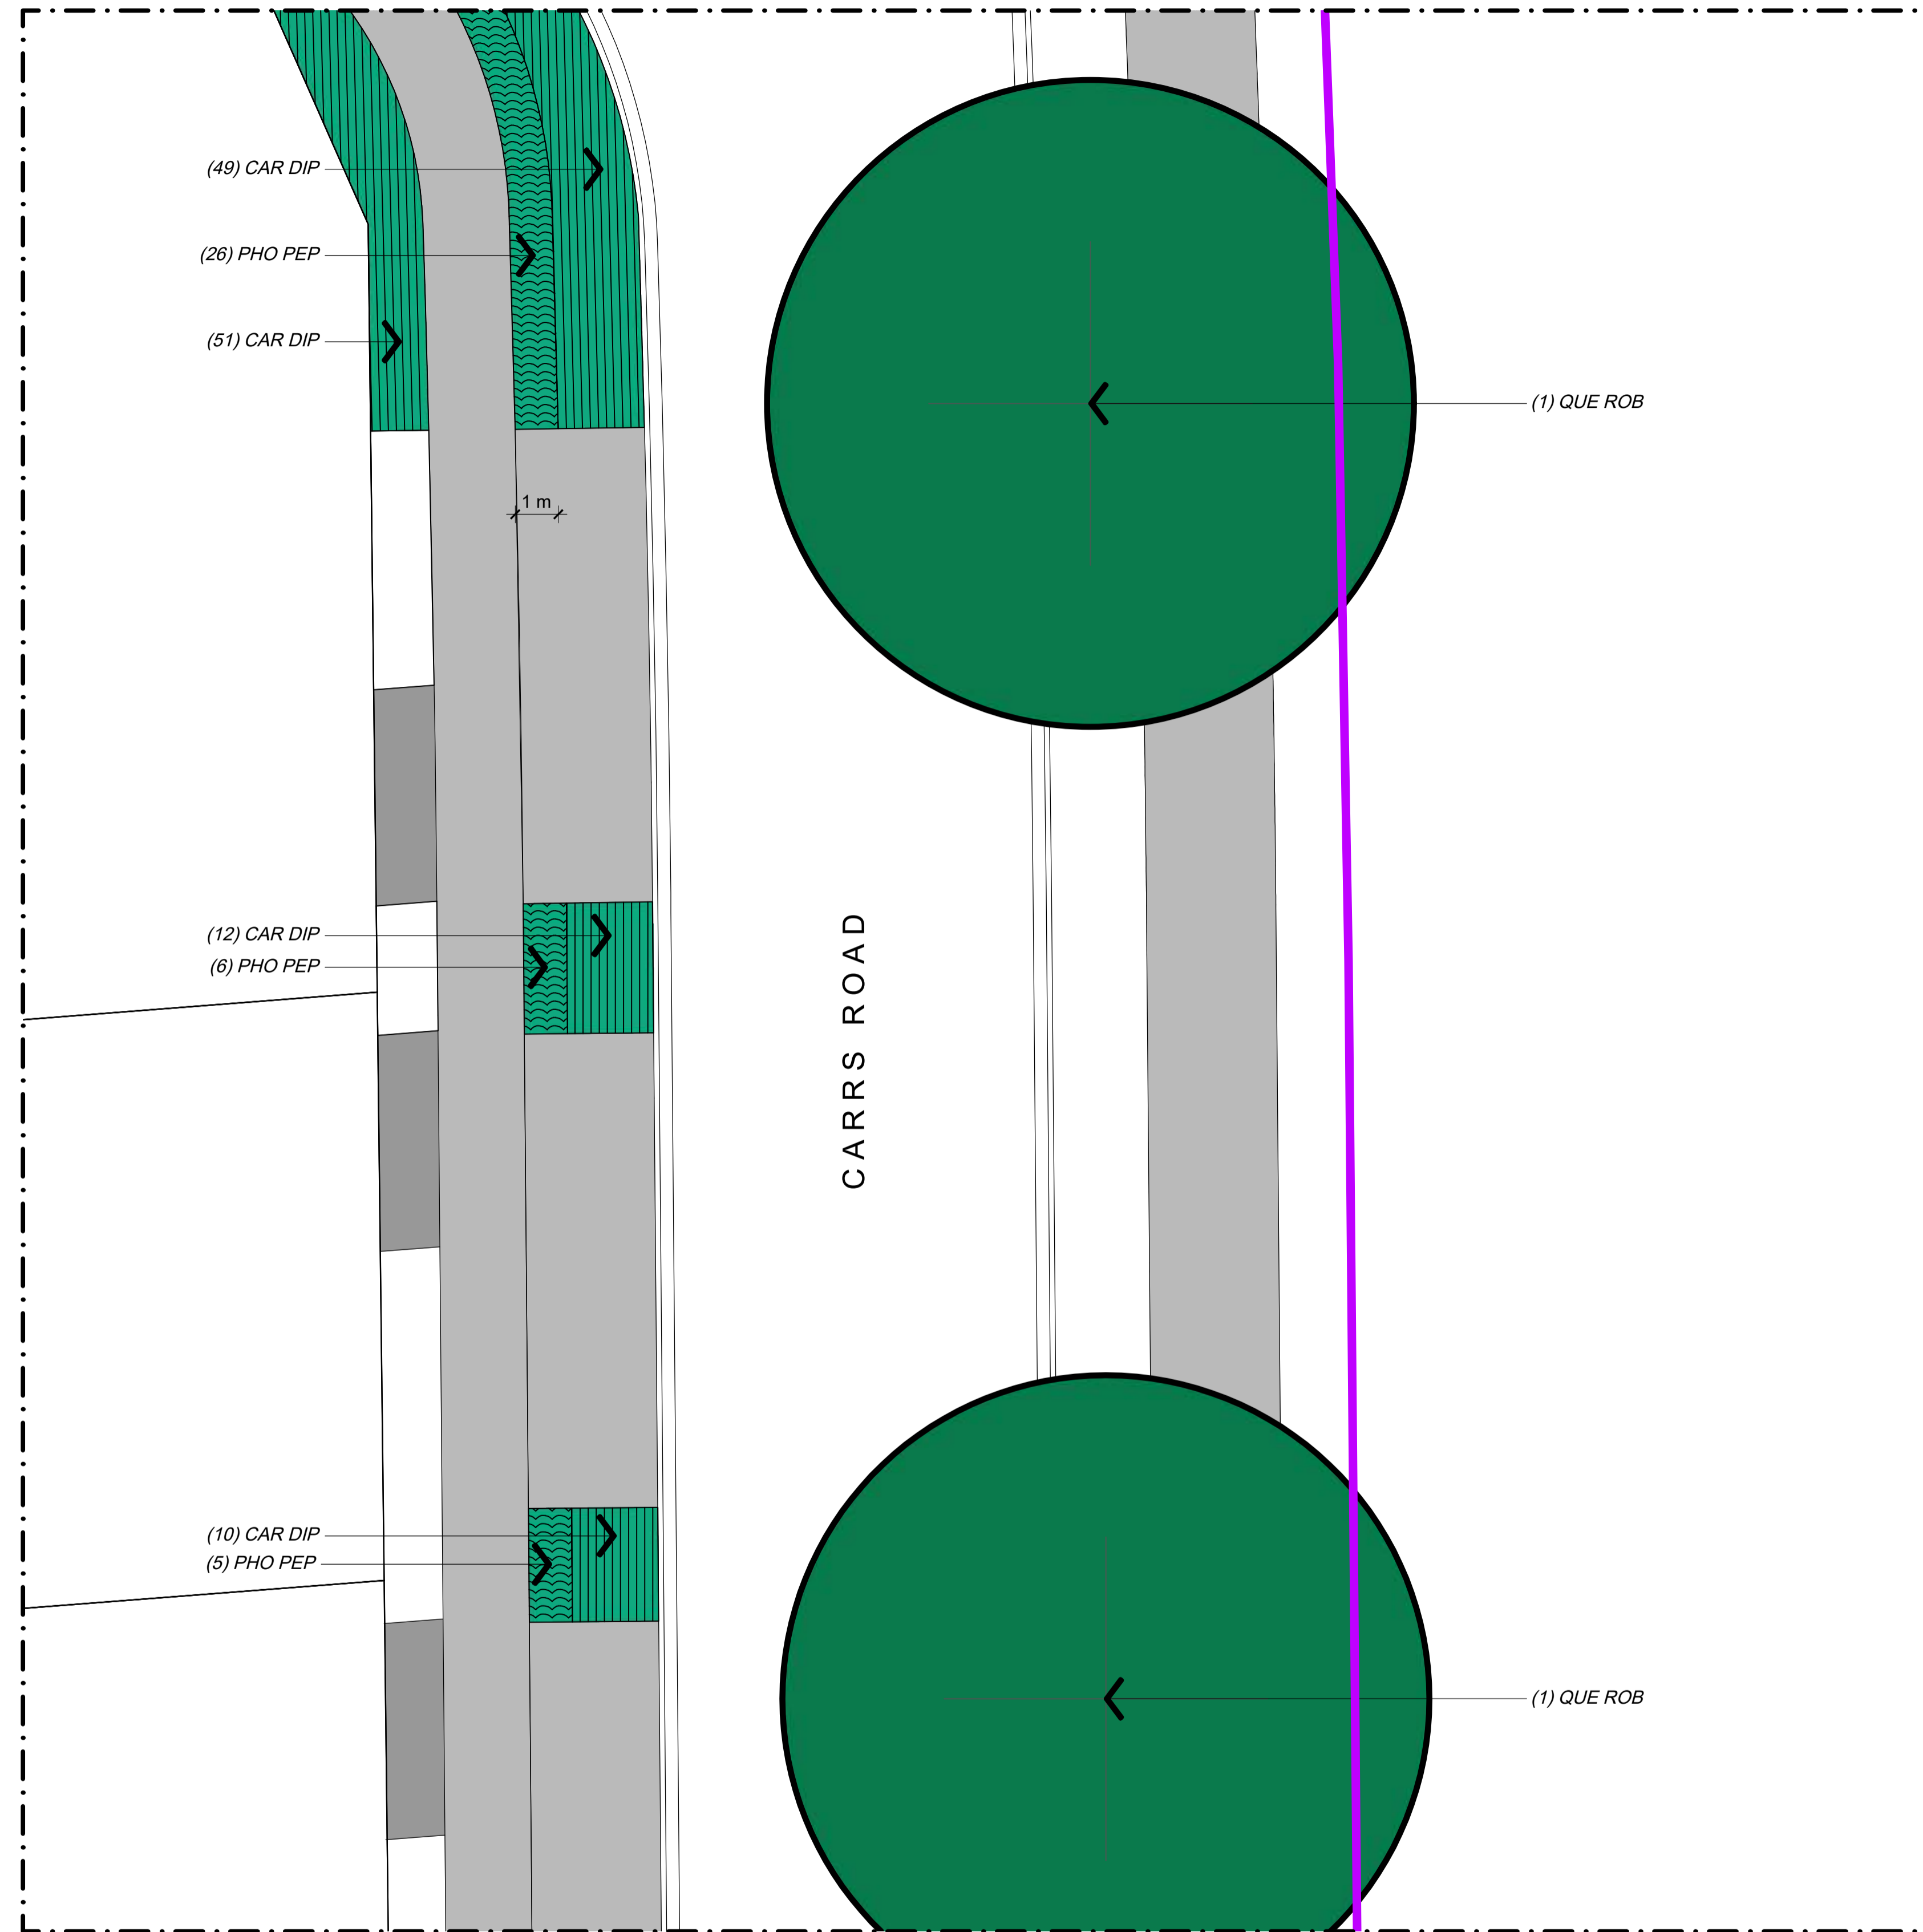

REFER TO DRAWING H18006_518

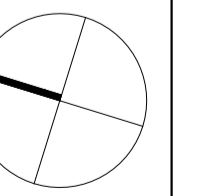

NOTES

- CONTRACTORS TO VERIFY ALL DIMENSIONS ON SITE PRIOR TO COMMENCING WORK;
- CONTRACTORS ARE RESPONSIBLE FOR CONFIRMING THE LOCATION OF ALL UNDERGROUND SERVICES ON SITE PRIOR TO COMMENCING WORK;
- FIGURED DIMENSIONS TO BE TAKEN IN PREFERENCE TO SCALED DIMENSIONS.

KEY

-  STAGE 13

REV	DATE	DESCRIPTION
0	02.07.19	ISSUED FOR CONSTRUCTION
1	31.07.20	PLANTING SUBSTITUTIONS, BACK BERM PLANTING AREAS SUBSTITUTED WITH LAWN
2	12.03.21	AS BUILT




CLIENT	Chedworth Properties Ltd
CONSULTANTS	S & L Consultants Beca Kendellier Lighting
AS BUILT	



GREENHILL PARK
AREA M
STAGE 13
 PLANTING PLAN
 SHEET 15 OF 17

Design	ARo	Scale	Date
Drawn	ARo	1:100 @ A1	02.07.19
Check	MHu	1:200 @ A3	
App'vd			
DRAWING NO.	REVISION		
H18006_517	(2)		

REFER TO DRAWING H18006_517

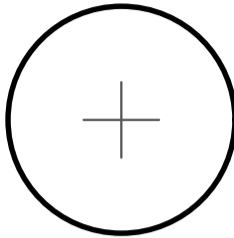Key

-  Tree
-  Collector Road Berm Planting
-  Lawn

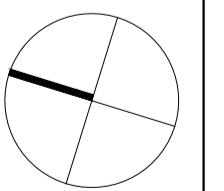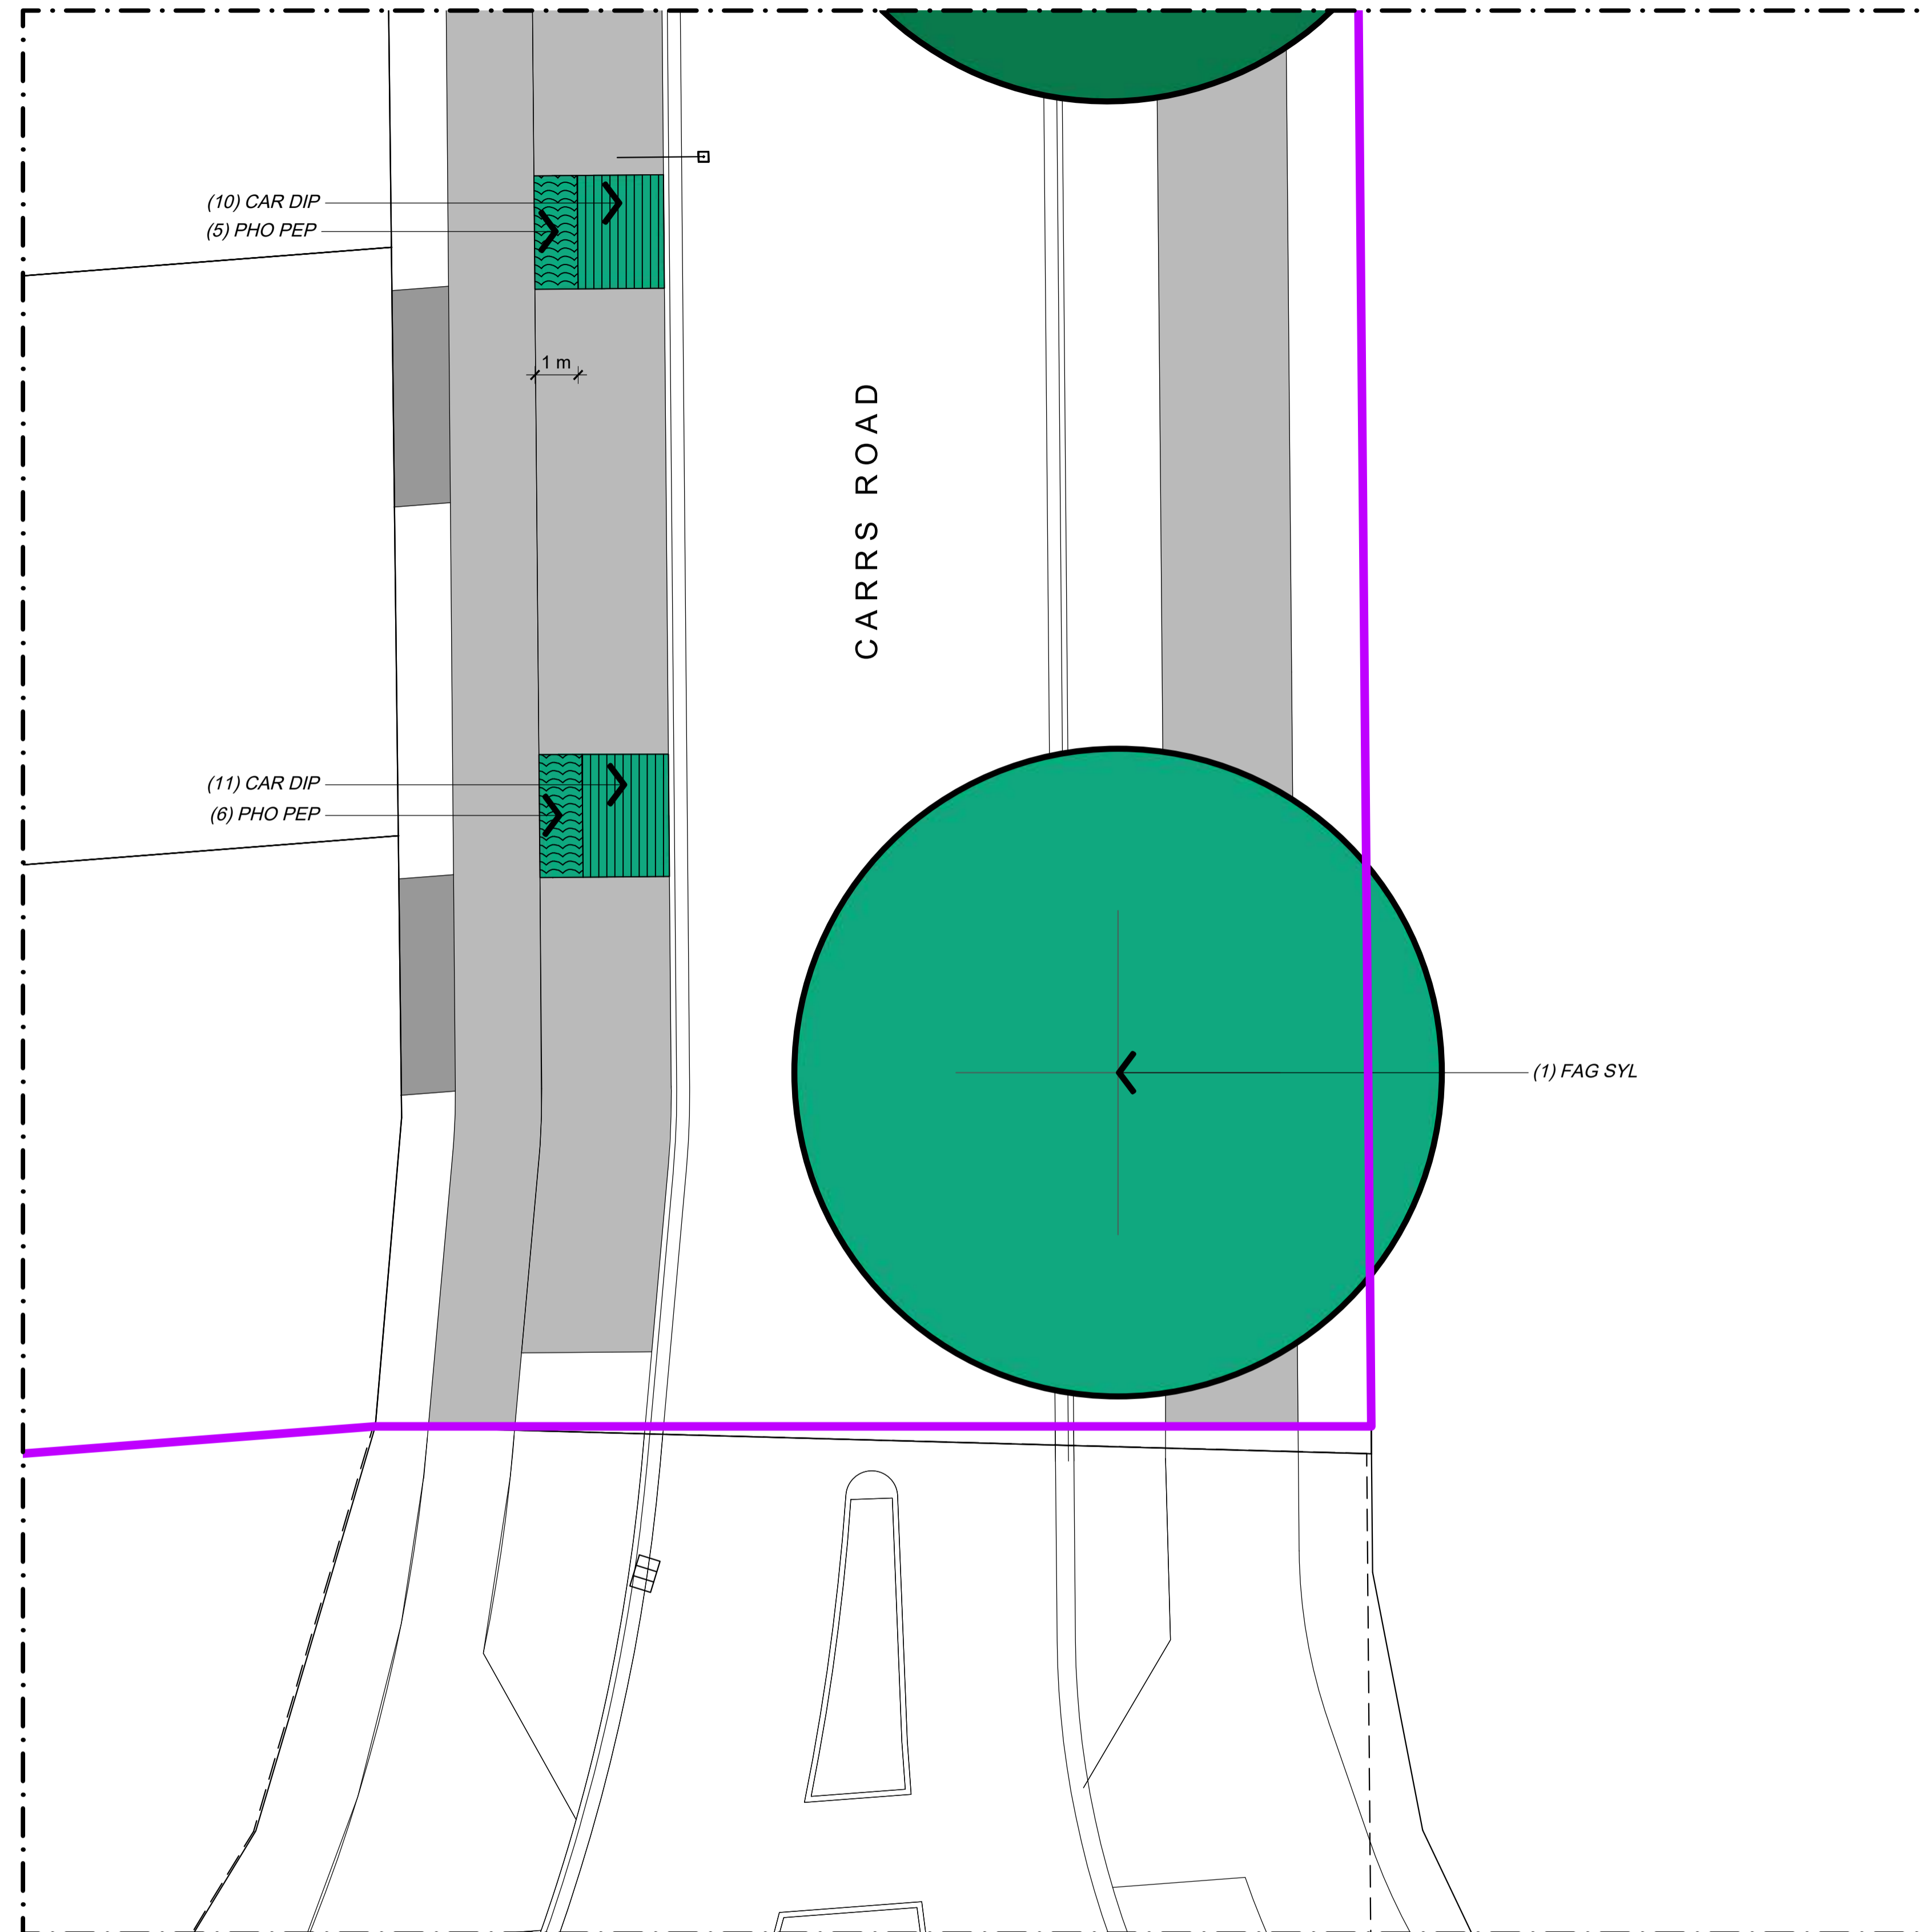

REV	DATE	DESCRIPTION
0	02.07.19	ISSUED FOR CONSTRUCTION
1	31.07.20	PLANTING SUBSTITUTIONS, BACK BERM PLANTING AREAS SUBSTITUTED WITH LAWN
2	12.03.21	AS BUILT

CLIENT
 Chedworth Properties Ltd


CONSULTANTS
 S & L Consultants
 Beca
 Kendeiler Lighting

AS BUILT

**GREENHILL PARK
 AREA M
 STAGE 13**


PLANTING PLAN
 SHEET 16 OF 17

Design	ARo	Scale	Date
Drawn	ARo	1:100 @ A1	02.07.19
Check	MHu	1:200 @ A3	
Appv'd			
DRAWING NO.		REVISION	
H18006_518		2	

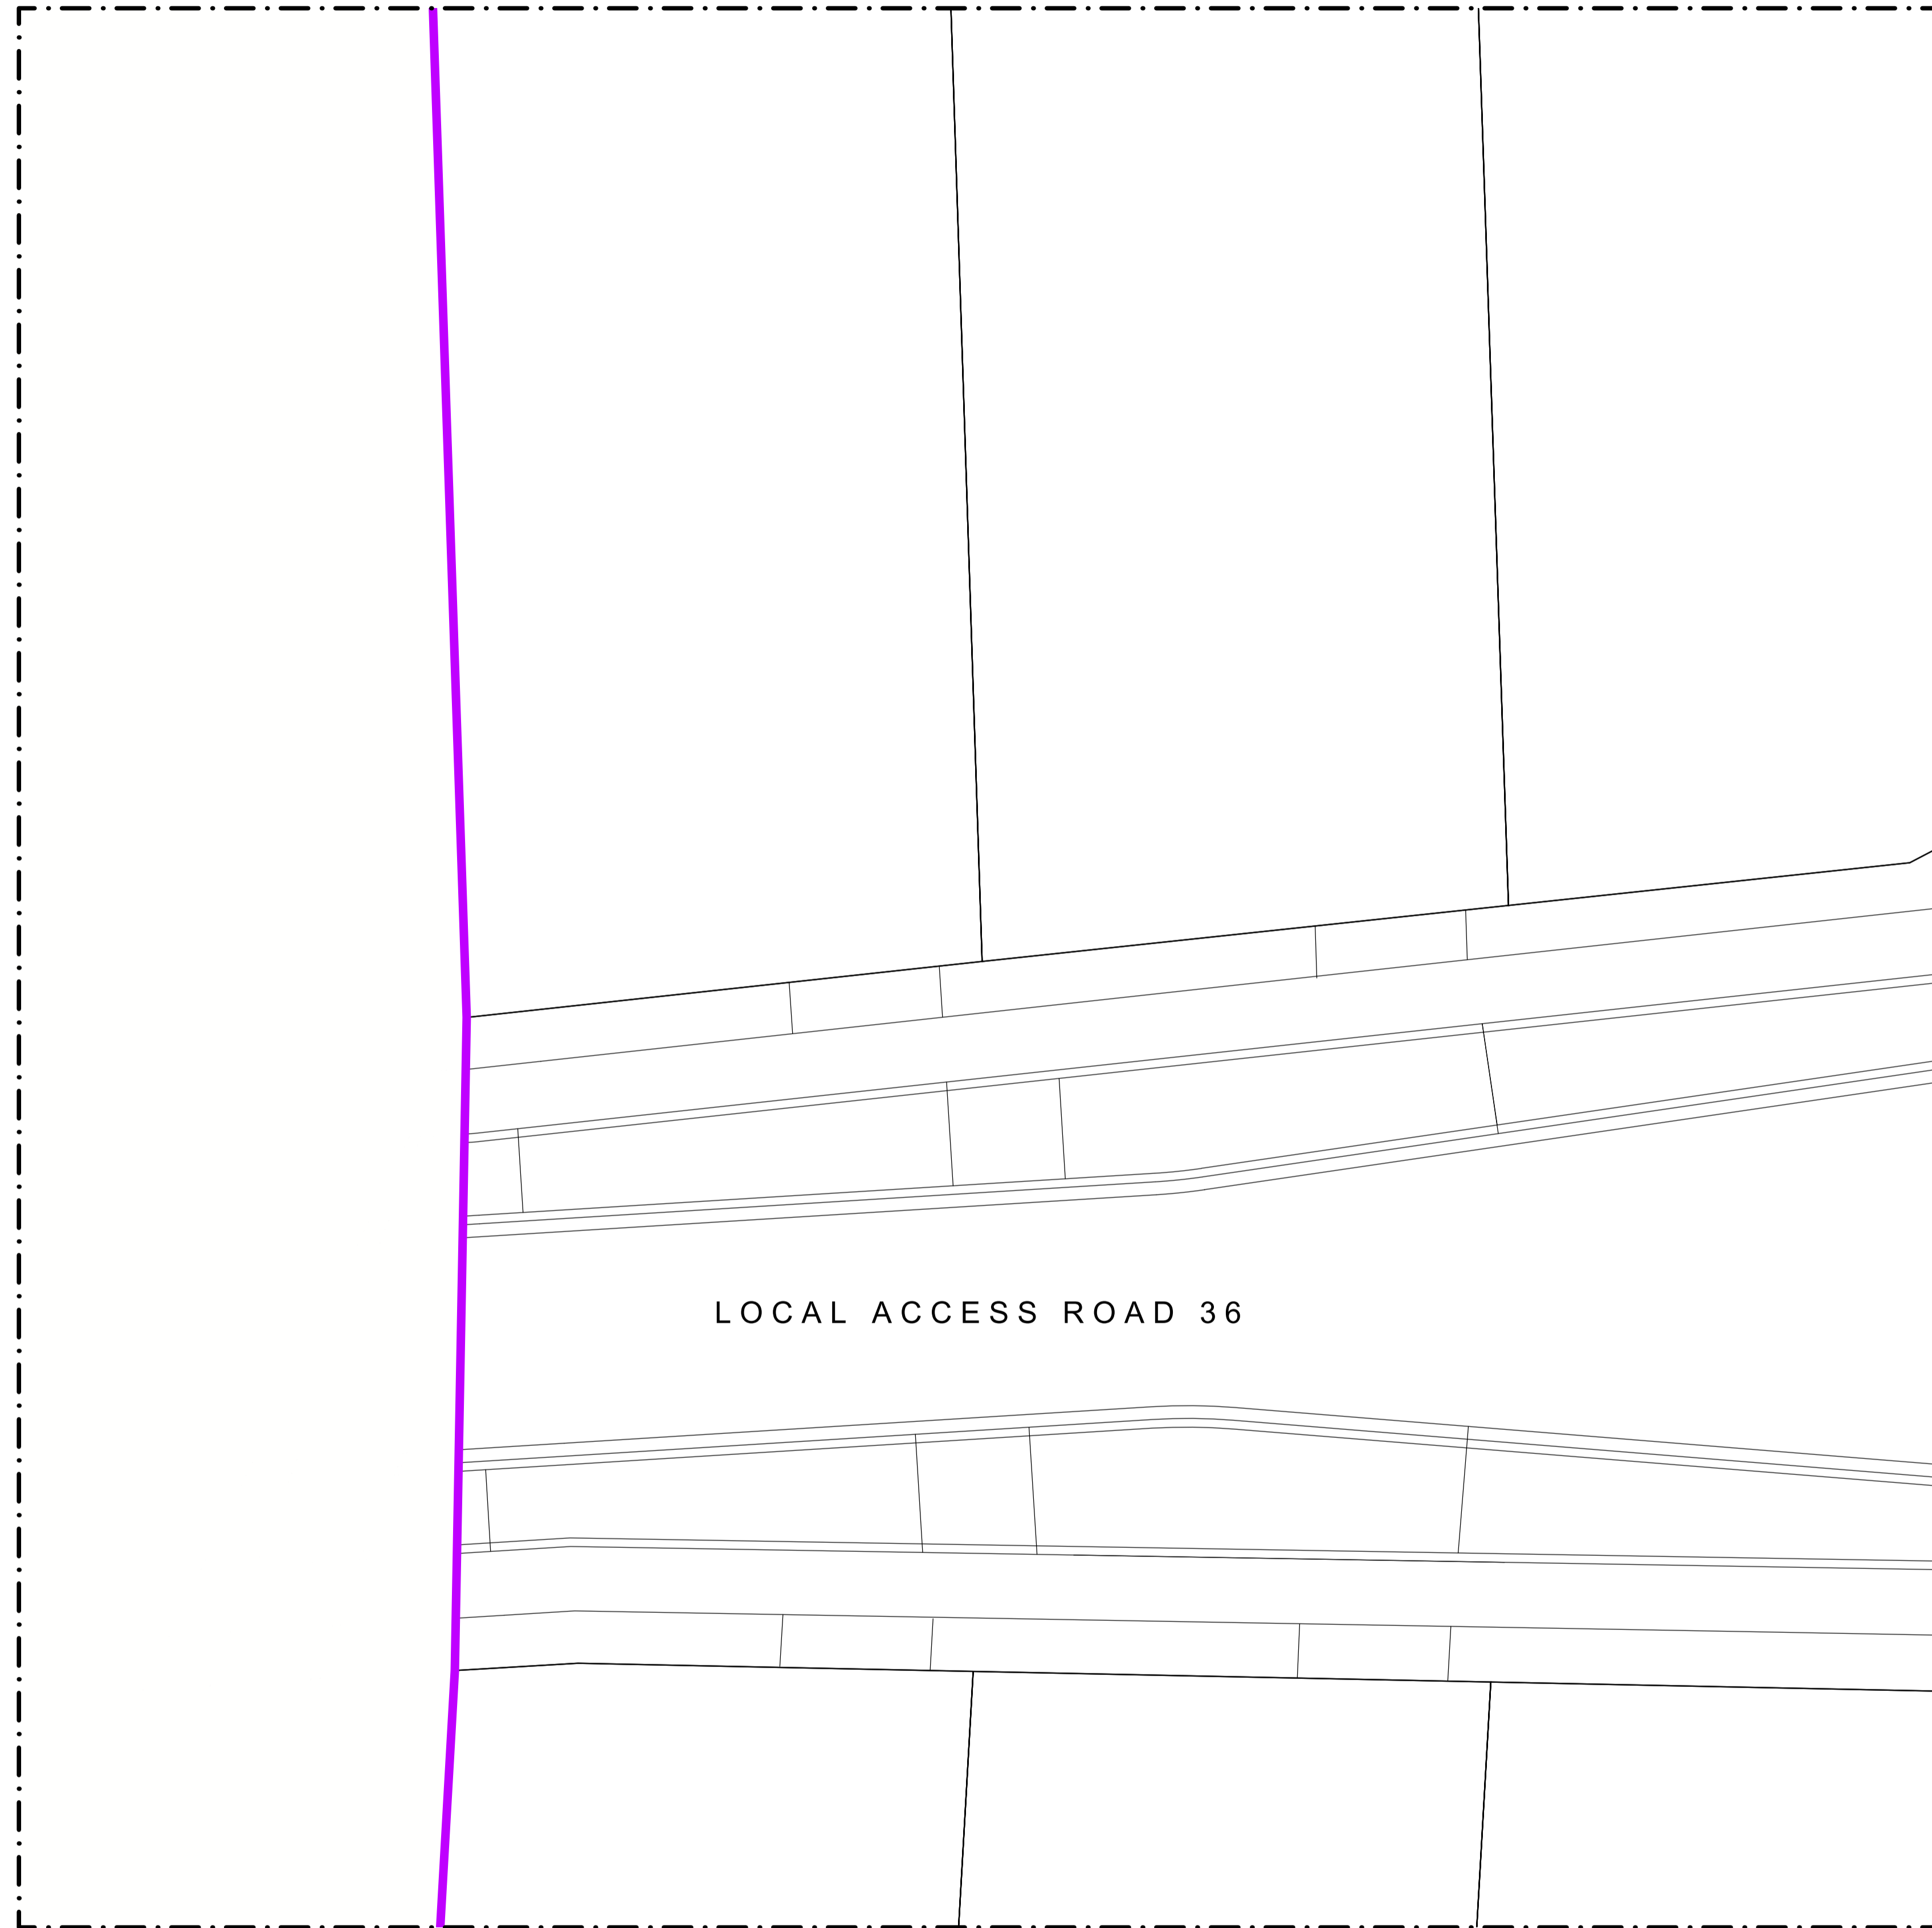

REFER TO DRAWING H18006_516

LOCAL ACCESS ROAD 36

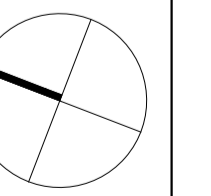

Boffa Miskell Limited
 Level 3, SouthBloc
 19 Knox Street
 PO Box 1094, Hamilton 3240, New Zealand
 Tel: +64 7 960 0006
 www.boffamiskell.co.nz

NOTES

CONTRACTORS TO VERIFY ALL DIMENSIONS ON SITE PRIOR TO COMMENCING WORK;
 CONTRACTORS ARE RESPONSIBLE FOR CONFIRMING THE LOCATION OF ALL UNDERGROUND SERVICES ON SITE PRIOR TO COMMENCING WORK;
 FIGURED DIMENSIONS TO BE TAKEN IN PREFERENCE TO SCALED DIMENSIONS.

KEY

— STAGE 13

REV	DATE	DESCRIPTION
0	02.07.19	ISSUED FOR CONSTRUCTION
1	31.07.20	PLANTING SUBSTITUTIONS, BACK BERM PLANTING AREAS SUBSTITUTED WITH LAWN
2	12.03.21	AS BUILT

CLIENT
 Chedworth Properties Ltd

CONSULTANTS
 S & L Consultants
 Beca
 Kendeiler Lighting

AS BUILT


**GREENHILL PARK
 AREA M
 STAGE 13**

PLANTING PLAN
 SHEET 17 OF 17

Design	ARo	Scale	Date
Drawn	ARo	1:100 @ A1	02.07.19
Check	MHu	1:200 @ A3	
Appv'd			


DRAWING NO. REVISION

H18006_519 (2)

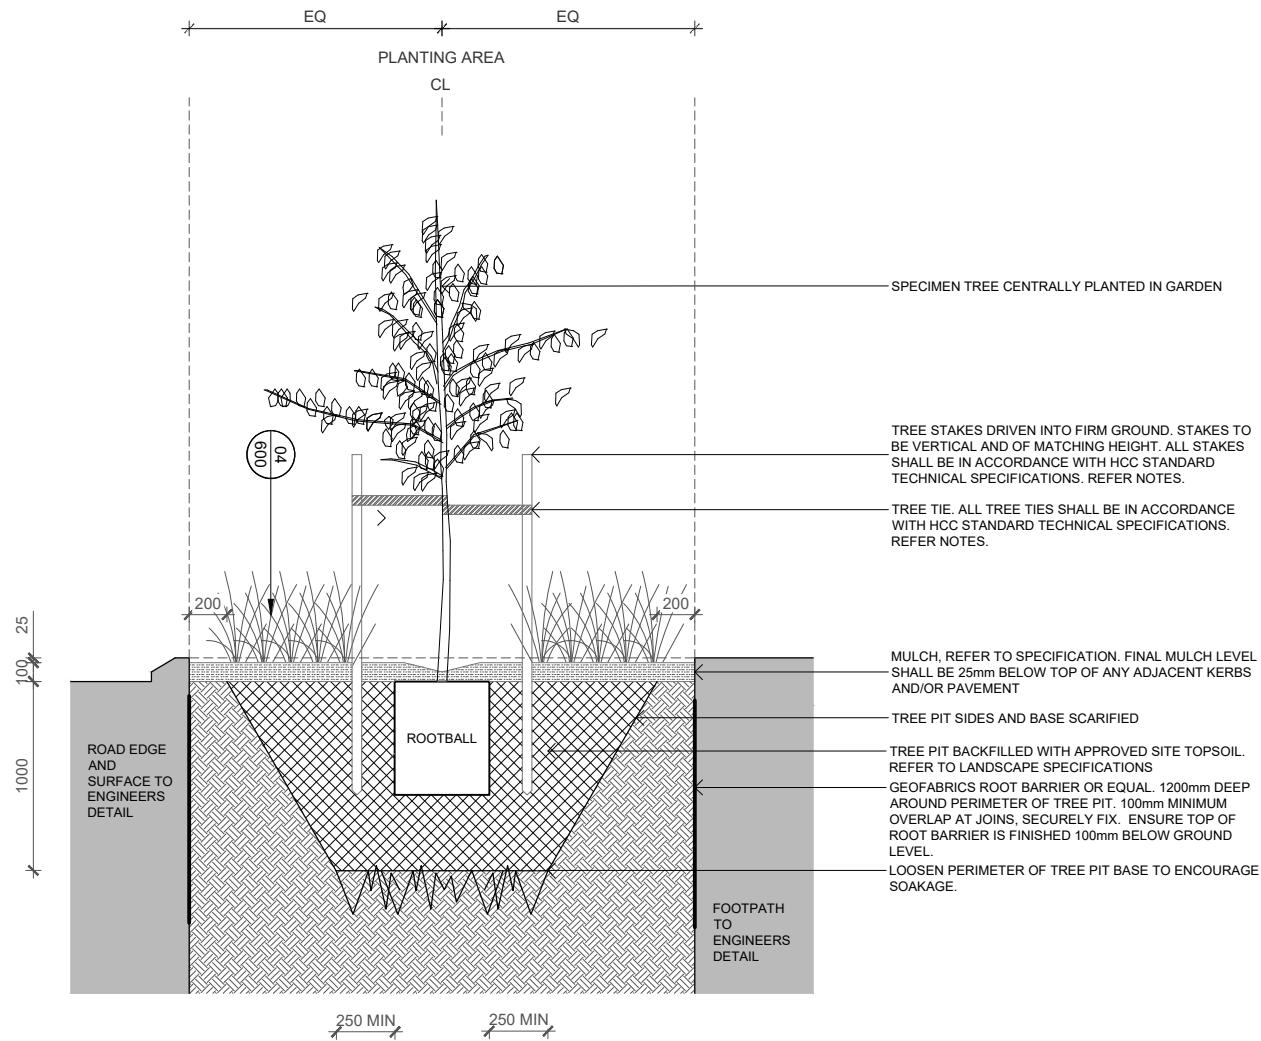


01 DETAIL | PROPOSED STREET TREE
600 Scale: 1:20 @ A1 1:40 @ A3


NOTES:
PLANT GRAPHICS AND SIZE ARE INDICATIVE ONLY
ENSURE TREE PIT IS FREE DRAINING THROUGH HOSE TESTING

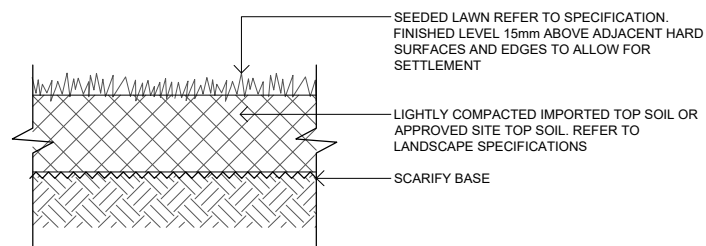

03 DETAIL | LAWN - SEEDED
600 Scale: 1:10 @ A1 1:20 @ A3

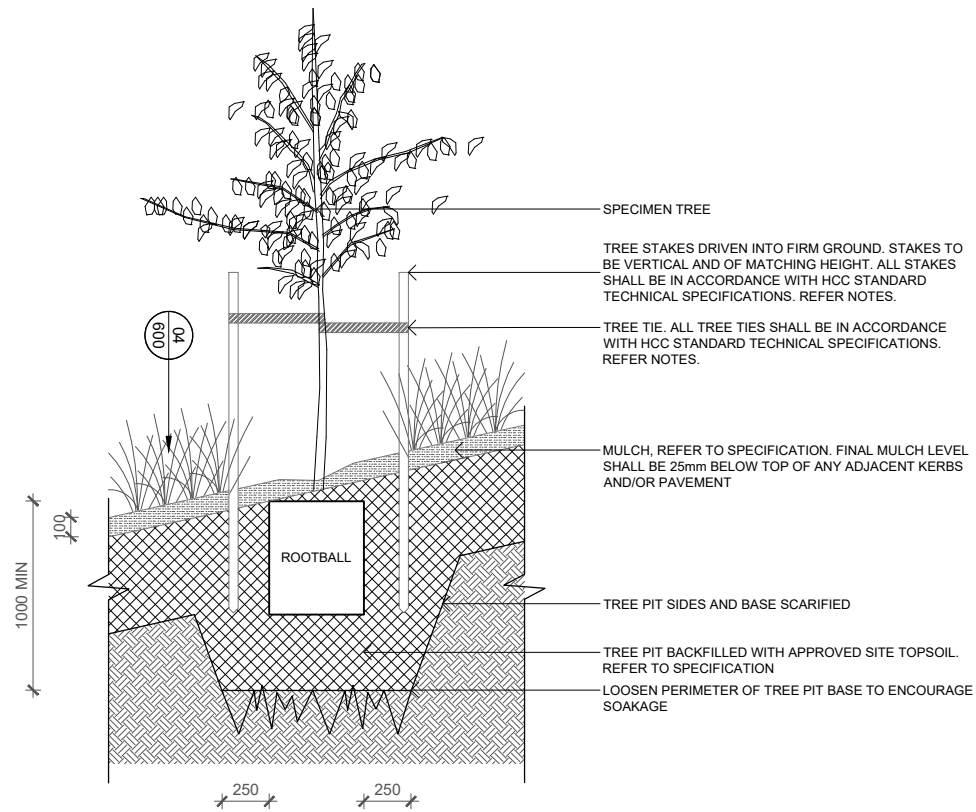

02 DETAIL | TREE PIT IN STORMWATER PARK
600 Scale: 1:20 @ A1 1:40 @ A3

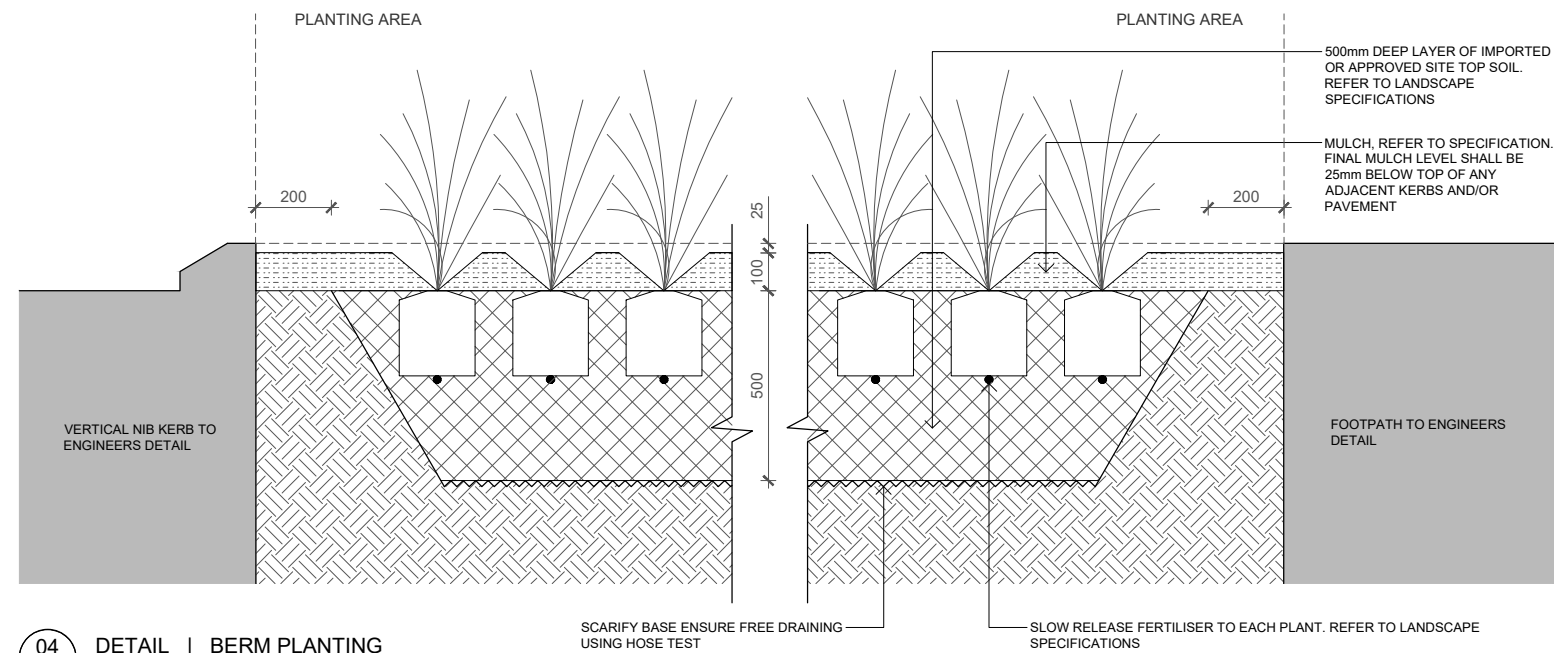

04 DETAIL | BERM PLANTING
600 Scale: 1:10 @ A1 1:20 @ A3

NOTES

PLANT GRAPHICS AND SIZE ARE INDICATIVE ONLY
ENSURE TREE PIT IS FREE DRAINING THROUGH HOSE TESTING

TREE STAKES AND TIES

ALL TREE STAKES AND TIES SHALL BE IN ACCORDANCE WITH THE FOLLOWING HAMILTON CITY COUNCIL STANDARD TECHNICAL SPECIFICATIONS:

TWO NO. 50MM X 50MM X 1.8M HIGH ROUGH SAWN H4 PINUS RADIATA STAKES WITH AT LEAST ONE-THIRD OF THEIR LENGTH (600MM) IN THE GROUND AND AT LEAST 1M ABOVE GROUND LEVEL.
ALL STAKES SHALL BE INSERTED TO AVOID HITTING THE ROOT BALL.
STAKES SHALL BE OFFSET AT LEAST 400MM FROM THE TREE TRUNK AND NO MORE THAN 500MM.
THE FLEXIBLE TREE TIES SHALL BE MADE OF BIO DEGRADABLE HESSIAN AND SHALL BE FIXED TO THE STAKES ON THE OUTER FACE WITH A MINIMUM OF FOUR STAPLES IN A SQUARE PATTERN.
ALL TREE TIES SHALL BE POSITIONED ONE-THIRD OF THE HEIGHT OF THE TREE.
ALL NURSERY BAMBOO STAKES SHALL BE REMOVED FROM ALL TREES AND ASSOCIATED PLASTIC TIES ALSO REMOVED.

NOTES

CONTRACTORS TO VERIFY ALL DIMENSIONS ON SITE PRIOR TO COMMENCING WORK;

CONTRACTORS ARE RESPONSIBLE FOR CONFIRMING THE LOCATION OF ALL UNDERGROUND SERVICES ON SITE PRIOR TO COMMENCING WORK;

FIGURED DIMENSIONS TO BE TAKEN IN PREFERENCE TO SCALED DIMENSIONS.

KEY

REFER TO DRAWING NUMBER H18006_130 GENERAL ARRANGEMENT KEY SHEET AND NOTES

REV	DATE	DESCRIPTION
0	08.08.18	ISSUED FOR CONSTRUCTION
1	31.05.19	AS BUILT

CLIENT
Chedworth Properties

CONSULTANTS
S&L Consultants
Beca
Kendellier Lighting

AS BUILT

GREENHILL PARK AREA M

PLANTING DETAILS - SHEET 01

Design	ARo	Scale	As shown	Date	08.08.18
Drawn	ARo				
Check	MHu				
App'd					

DRAWING NO. H18006_600 REVISION 1

APPENDIX 10

Asset Spreadsheets

- Water asset sheets
- Wastewater asset sheets
- Stormwater asset sheets



As Built Datasheet (to accompany As Built Plans) **Waikato Regional ITS**

STORMWATER MANHOLES

Form Version 1 - July 2017

Developer/Contractor: Chedworth Properties Ltd / Online Contractors Prepared by: S & L
 Development/Subdivision/Job: Greenhill Park Date: Mar-21
 Stage: Stage 13
 (North Rim) (Centre) (Centre)

Plan ID	Manhole ID	Property ID (Lot No. or Address)	Street Name	Street Type	Lid Level (m)	Invert Level (m)	MH Width/Diam (mm)	Easting Coordinate	Northing Coordinate	Service Status	Install Date	Asset Value	Comments
21879-M-13-SW1	SWMH 9.5	LOT 359	CARRS	ROAD	37.93	36.91	1050	447278.58	702740.86	N	Dec-20	\$4,301	
21879-M-13-SW1	SWMH 19.1	LOT 706	N/A	N/A	TBC	37.27	1200	447305.16	702835.08	N	Dec-20	\$4,601	LID LEVEL TO BE PROVIDED IN STAGE 14 AREA M
21879-M-13-SW1	SWMH 19.4	LOT 366	CARRS	ROAD	38.76	36.57	1500	447339.00	702761.45	N	Dec-20	\$5,101	
21879-M-13-SW1	SWMH 19.5	LOT 2 DP 534384	N/A	N/A	36.56	35.41	1050	447314.32	702729.71	N	Dec-20	\$4,125	
21879-M-13-SW1	SWMH 22.1	LOT 373	CARRS	ROAD	39.91	38.39	1050	447455.90	702818.80	N	Dec-20	\$4,301	
21879-M-13-SW1	SWMH 22.2	LOT 369	CARRS	ROAD	39.41	37.71	1050	447405.31	702791.67	N	Dec-20	\$4,301	
21879-M-13-SW1	SWMH SP 3.1	LOT 602	WEBB	DRIVE	39.95	38.69	1050	447446.83	702932.16	N	Dec-20	\$4,301	
21879-M-13-SW1	SWMH SP 3.2	LOT 602	WEBB	DRIVE	39.56	38.26	1050	447421.79	702980.63	N	Dec-20	\$4,301	
21879-M-13-SW1	SWMH SP 3.3	LOT 602	WEBB	DRIVE	39.18	37.81	1050	447400.98	703032.69	N	Dec-20	\$4,301	
21879-M-13-SW1	SWMH SP 3.4	LOT 602	WEBB	DRIVE	38.79	37.50	1050	447384.80	703084.71	N	Dec-20	\$4,301	
21879-M-13-SW1	SWM25001	LOT 602	WEBB	DRIVE	38.66	37.21	1050	447373.87	703120.54	E	Dec-19	N/A	EXISTING MH FROM STAGE 10 (S&L Ref SWMH SP 3.5)
21879-M-13-SW1	SWMH SP 4.2	LOT 504	WEBB	DRIVE	40.15	38.59	1050	447428.70	702911.14	N	Dec-20	\$4,301	
21879-M-13-SW1	SWM25005	LOT 504	WEBB	DRIVE	39.75	38.13	1050	447407.60	702946.78	E	Aug-20	N/A	EXISTING MH FROM STAGE 12 (S&L Ref SWMH SP 4.3)
21879-M-13-SW1	SWM25006	LOT 503 DP 548658	WEBB	DRIVE	39.37	37.52	1050	447381.34	703000.72	E	Aug-20	N/A	EXISTING MH FROM STAGE 12 (S&L Ref SWMH SP 4.5)
21879-M-13-SW1	SWM25007	LOT 503 DP 548658	WEBB	DRIVE	38.94	37.00	1050	447368.36	703046.36	E	Aug-20	N/A	EXISTING MH FROM STAGE 12 (S&L Ref SWMH SP 4.6)
21879-M-13-SW1	SWM25008	LOT 503 DP 548658	WEBB	DRIVE	38.60	36.65	1050	447357.90	703079.80	E	Aug-20	N/A	EXISTING MH FROM STAGE 12 (S&L Ref SWMH SP 4.7)
21879-M-13-SW1	SWM25004	LOT 503 DP 548658	WEBB	DRIVE	38.40	36.21	1050	447342.00	703122.13	E	Dec-19	N/A	EXISTING MH FROM STAGE 10 (S&L Ref SWMH SP 4.8)
21879-M-13-SW1	SWN24075	LOT 171 DP 543161	CARRS	ROAD	37.88	36.55	1050	447235.21	702729.92	E	Dec-19	N/A	EXISTING MH FROM STAGE 8B (S&L Ref SWMH 9.4)

As Built Datasheet (to accompany As Built Plans)**Waikato Regional ITS****STORMWATER PIPELINES**

Form Version 1 - July 2017

Developer/Contractor: Chedworth Properties Ltd / Online Contractors Prepared by: S & L
 Development/Subdivision/Job: Greenhill Park Date: Mar-21
 Stage: Stage 13

Plan ID	Upstr MH/ Asset ID	Dwnstr MH/ Asset ID	Street Name	Street Type	Physical Location (where necessary)	Pipe Diameter (mm)	Pipe Length (m)	Pipe Material	Joint Type	Invert Level Upstr (m)	Invert Level Dwnstr (m)	Service Status	Install Date	Asset Value	Comments
21879-M-13-SW1	SWMH 19.5	SWOUT 15	N/A	N/A	RESERVE	675	4.5	RC	RR	35.41	35.29	N	Dec-20	\$2,121	
21879-M-13-SW1	SWMH 19.4	SWMH 19.5	CARRS	ROAD	RESERVE/ROADWAY	675	40.2	RC	RR	36.57	35.41	N	Dec-20	\$18,948	
21879-M-13-SW1	SWMH 19.1	SWMH 19.4	GUILLAUME	STREET	ROADWAY	600	81.0	RC	RR	37.27	36.63	N	Dec-20	\$34,795	
21879-M-13-SW1	SWMH 22.2	SWMH 19.4	CARRS	ROAD	ROADWAY	375	72.9	RC	RR	37.71	36.89	N	Dec-20	\$23,471	
21879-M-13-SW1	SWMH 22.1	SWMH 22.2	CARRS	ROAD	ROADWAY	300	57.4	uPVC	SN16	38.39	37.74	N	Dec-20	\$17,780	
21879-M-13-SW1	SWMH SP 4.2	SWM25005	N/A	N/A	RESERVE	300	41.4	uPVC	SN16	38.59	38.19	N	Dec-20	\$12,825	
21879-M-13-SW1	SWMH SP 3.4	SWM25001	WEBB	DRIVE	BERM	375	37.5	RC	RR	37.50	37.25	N	Dec-20	\$12,074	
21879-M-13-SW1	SWMH SP 3.3	SWMH SP 3.4	WEBB	DRIVE	BERM	300	54.5	uPVC	SN16	37.81	37.52	N	Dec-20	\$16,882	
21879-M-13-SW1	SWMH SP 3.2	SWMH SP 3.3	WEBB	DRIVE	BERM	300	56.1	uPVC	SN16	38.26	37.91	N	Dec-20	\$17,378	
21879-M-13-SW1	SWMH SP 3.1	SWMH SP 3.2	WEBB	DRIVE	BERM	300	54.6	uPVC	SN16	38.69	38.33	N	Dec-20	\$16,913	
21879-M-13-SW1	SWMH 9.5	SWN24075	CARRS	ROAD	ROADWAY	300	44.7	uPVC	SN16	36.91	36.65	N	Dec-20	\$13,847	

As Built Datasheet (to accompany As Built Plans)
STORMWATER CONNECTION/SERVICE LINE

Waikato Regional ITS

Form Version 1 - July 2017

Developer/Contractor: Chedworth Properties Ltd / Online Contractors
 Development/Subdivision/Job: Greenhill Park
 Stage: Stage 13

Prepared by: S & L
 Date: Mar-21

Plan ID	Upstr MH/ Asset ID	Dwnstr MH/ Asset ID	Property ID (Lot No. or Address)	Street Name	Street Type	Physical Location (where necessary)	Service Pipe Diam (mm)	Service Pipe Length (m)	Service Pipe Material	Invert Level At Private End (m) OR Depth (m)	Easting Coordinate	Northing Coordinate	Distance from left (LB) or right (RB) boundary (m)	Distance from front (FB) or back (BB) boundary (m)	Service Status	Install Date	Asset Value	Comments
21879-M-13-SW1	SWMH 9.5	SWN24075	LOT 357	CARRS	ROAD	BERM	100	13.2	uPVC SN16	1.2	447254.90	702748.26	3.9RB	1.5FB	N	Dec-20	\$1,040	
21879-M-13-SW1	SWMH 9.5	SWN24075	LOT 358	CARRS	ROAD	BERM	100	13.4	uPVC SN16	1.2	447268.63	702751.92	3.4RB	0.8FB	N	Dec-20	\$1,054	
21879-M-13-SW1	-	SWMH 9.5	LOT 359	CARRS	ROAD	BERM	100	5.5	uPVC SN16	1.2	447283.21	702757.18	1.5RB	1.4FB	N	Dec-20	\$515	
21879-M-13-SW1	-	SWMH 9.5	LOT 360	CARRS	ROAD	BERM	100/150	20.9	uPVC SN16	1.2	447289.14	702758.98	4.7LB	1.3FB	N	Dec-20	\$1,671	PIPE SIZE: 8.1m = 100mm; 12.8m = 150mm
21879-M-13-SW1	SWMH 19.1	SWMH 19.4	LOT 361	GUILLAUME	STREET	BERM	100	12.5	uPVC SN16	1.2	447317.27	702778.95	6.8RB	1.3FB	N	Dec-20	\$993	
21879-M-13-SW1	SWMH 19.1	SWMH 19.4	LOT 362	GUILLAUME	STREET	BERM	100/150	11.3	uPVC SN16	1.2	447310.92	702795.69	0.9RB	1.6FB	N	Dec-20	\$968	PIPE SIZE: 5.5m = 100mm; 5.8m = 150mm
21879-M-13-SW1	SWMH 19.1	SWMH 19.4	LOT 363	GUILLAUME	STREET	BERM	100	5.5	uPVC SN16	1.2	447310.86	702798.74	2.0LB	0.6FB	N	Dec-20	\$515	
21879-M-13-SW1	SWMH 19.1	SWMH 19.4	LOT 364	GUILLAUME	STREET	BERM	100	4.6	uPVC SN16	1.2	447327.58	702805.04	2.1RB	1.0FB	N	Dec-20	\$454	
21879-M-13-SW1	SWMH 19.1	SWMH 19.4	LOT 365	GUILLAUME	STREET	BERM	100/150	9.6	uPVC SN16	1.2	447329.47	702802.39	1.1LB	1.5FB	N	Dec-20	\$843	PIPE SIZE: 3.7m = 100mm; 5.9m = 150mm
21879-M-13-SW1	SWMH 22.2	SWMH 19.4	LOT 366	CARRS	ROAD	BERM	100/150	11.9	uPVC SN16	1.2	447363.66	702785.79	1.6RB	1.1FB	N	Dec-20	\$1,012	PIPE SIZE: 4.7m = 100mm; 7.2m = 150mm
21879-M-13-SW1	SWMH 22.2	SWMH 19.4	LOT 367	CARRS	ROAD	BERM	100	7.5	uPVC SN16	1.2	447368.82	702787.95	4.0LB	1.0FB	N	Dec-20	\$652	
21879-M-13-SW1	SWMH 22.2	SWMH 19.4	LOT 368	CARRS	ROAD	BERM	100/150	12.1	uPVC SN16	1.2	447388.30	702797.20	1.4RB	1.3FB	N	Dec-20	\$1,026	PIPE SIZE: 4.5m = 100mm; 7.6m = 150mm
21879-M-13-SW1	SWMH 22.2	SWMH 19.4	LOT 369	CARRS	ROAD	BERM	100	6.1	uPVC SN16	1.2	447392.22	702798.71	2.7LB	0.9FB	N	Dec-20	\$556	
21879-M-13-SW1	SWMH 22.1	SWMH 22.2	LOT 370	CARRS	ROAD	BERM	100/150	12.6	uPVC SN16	1.2	447415.51	702811.37	1.3RB	1.6FB	N	Dec-20	\$1,063	PIPE SIZE: 4.2m = 100mm; 8.4m = 150mm
21879-M-13-SW1	SWMH 22.1	SWMH 22.2	LOT 371	CARRS	ROAD	BERM	100	5.3	uPVC SN16	1.2	447418.78	702812.82	2.3LB	1.3FB	N	Dec-20	\$501	
21879-M-13-SW1	SWMH 22.1	SWMH 22.2	LOT 372	CARRS	ROAD	BERM	100/150	13.3	uPVC SN16	1.2	447442.25	702826.44	1.6RB	1.5FB	N	Dec-20	\$1,114	PIPE SIZE: 4.5m = 100mm; 8.8m = 150mm
21879-M-13-SW1	SWMH 22.1	SWMH 22.2	LOT 373	CARRS	ROAD	BERM	100	5.0	uPVC SN16	1.2	447445.14	702827.70	1.5LB	1.1FB	N	Dec-20	\$481	
21879-M-13-SW1	-	SWMH 22.1	LOT 374	CARRS	ROAD	BERM	100	17.5	uPVC SN16	1.2	447459.62	702835.93	3.1LB	0.4FB	N	Dec-20	\$1,334	

As Built Datasheet (to accompany As Built Plans)**Waikato Regional ITS****STORMWATER CATCHPITS**

Form Version 1 - July 2017

Developer/Contractor: Chedworth Properties Ltd / Online Contractors **Prepared by:** S & L
Development/Subdivision/Job: Greenhill Park **Date:** Mar-21
Stage: Stage 13

Plan ID	Catchpit ID	Property ID (Lot No. or Address)	Street Name	Street Type	Catchpit Type	Grate Level (m)	Easting Coordinate	Northing Coordinate	Service Status	Install Date	Asset Value	Comments
21879-M-13-SW1	CP 057	LOT 359	CARRS	ROAD	SINGLE SUMP	37.86	447282.29	702739.44	N	Dec-20	\$2,071	
21879-M-13-SW1	CP 058	LOT 359	CARRS	ROAD	SINGLE SUMP	37.89	447280.92	702747.97	N	Dec-20	\$2,071	
21879-M-13-SW1	CP 114	LOT 373	CARRS	ROAD	SINGLE SUMP	39.83	447455.97	702825.50	N	Dec-20	\$2,071	
21879-M-13-SW1	CP 115	LOT 373	CARRS	ROAD	SINGLE SUMP	39.79	447459.57	702817.62	N	Dec-20	\$2,071	
21879-M-13-SW1	CP 116	LOT 370	CARRS	ROAD	SINGLE SUMP	39.31	447405.81	702797.04	N	Dec-20	\$2,071	
21879-M-13-SW1	CP 117	LOT 370	CARRS	ROAD	SINGLE SUMP	39.30	447411.93	702789.02	N	Dec-20	\$2,071	
21879-M-13-SW1	CP 118	LOT 366	CARRS	ROAD	SINGLE SUMP	38.80	447348.77	702771.49	N	Dec-20	\$2,071	
21879-M-13-SW1	CP 119	LOT 366	CARRS	ROAD	SINGLE SUMP	38.75	447348.80	702762.23	N	Dec-20	\$2,071	
21879-M-13-SW1	CP SP 09	LOT 602	WEBB	DRIVE	SINGLE SUMP	39.53	447420.55	702979.06	N	Dec-20	\$2,071	
21879-M-13-SW1	CP SP 10	LOT 602	WEBB	DRIVE	SINGLE SUMP	39.13	447399.69	703031.37	N	Dec-20	\$2,071	
21879-M-13-SW1	CP SP 11	LOT 602	WEBB	DRIVE	SINGLE SUMP	38.75	447383.53	703083.47	N	Dec-20	\$2,071	
21879-M-13-SW1	CP SP 18	LOT 602	WEBB	DRIVE	SINGLE SUMP	39.72	447418.53	702950.90	N	Dec-20	\$2,071	
21879-M-13-SW1	CP SP 19	LOT 602	WEBB	DRIVE	SINGLE SUMP	39.33	447396.15	702999.97	N	Dec-20	\$2,071	
21879-M-13-SW1	CP SP 20	LOT 602	WEBB	DRIVE	SINGLE SUMP	38.99	447380.10	703046.89	N	Dec-20	\$2,071	
21879-M-13-SW1	DCP 113	LOT 366	GUILLAUME	STREET	DOUBLE SUMP	38.30	447333.83	702779.46	N	Dec-20	\$2,848	
21879-M-13-SW1	DCP SP 08	LOT 602	WEBB	DRIVE	DOUBLE SUMP	39.94	447446.31	702929.80	N	Dec-20	\$2,848	
21879-M-13-SW1	DCP SP 17	LOT 602	WEBB	DRIVE	DOUBLE SUMP	39.94	447438.45	702915.71	N	Dec-20	\$2,848	
21879-M-13-SW1	DCP SP 21	LOT 602	WEBB	DRIVE	DOUBLE SUMP	38.45	447357.97	703117.66	N	Dec-20	\$2,848	

As Built Datasheet (to accompany As Built Plans)

Waikato Regional ITS

STORMWATER CATCHPIT LEADS

Form Version 1 - July 2017

Developer/Contractor: Chedworth Properties Ltd / Online Contractors
 Development/Subdivision/Job: Greenhill Park
 Stage: Stage 13

Prepared by: S & L
 Date: Mar-21

Plan ID	Catchpit ID	Dwnstr MH/ Asset ID	Property ID (Lot No. or Address)	Street Name	Street Type	Physical Location (where necessary)	Catchpit Lead Pipe Diam (mm)	Catchpit Lead Pipe Length (m)	Catchpit Lead Pipe Material	Invert Level at Dwnstrm end	Service Status	Install Date	Asset Value	Comments
21879-M-13-SW1	CP 057	SWMH 9.5	LOT 359	CARRS	ROAD	ROADWAY	225	4.0	uPVC SN16	36.96	N	Dec-20	\$930	
21879-M-13-SW1	CP 058	SWMH 9.5	LOT 359	CARRS	ROAD	ROADWAY	225	7.5	uPVC SN16	36.94	N	Dec-20	\$1,744	
21879-M-13-SW1	CP 114	SWMH 22.1	LOT 373	CARRS	ROAD	ROADWAY	225	6.7	uPVC SN16	38.80	N	Dec-20	\$1,558	
21879-M-13-SW1	CP 115	SWMH 22.1	LOT 373	CARRS	ROAD	ROADWAY	225	3.9	uPVC SN16	38.65	N	Dec-20	\$907	
21879-M-13-SW1	CP 116	SWMH 22.2	LOT 370	CARRS	ROAD	ROADWAY	225	5.4	uPVC SN16	38.05	N	Dec-20	\$1,256	
21879-M-13-SW1	CP 117	SWMH 22.2	LOT 370	CARRS	ROAD	ROADWAY	225	7.1	uPVC SN16	38.06	N	Dec-20	\$1,651	
21879-M-13-SW1	CP 118	SWMH 19.4	LOT 366	CARRS	ROAD	ROADWAY	225	14.0	uPVC SN16	37.52	N	Dec-20	\$3,256	
21879-M-13-SW1	CP 119	SWMH 19.4	LOT 366	CARRS	ROAD	ROADWAY	225	9.8	uPVC SN16	37.30	N	Dec-20	\$2,279	
21879-M-13-SW1	CP SP 09	SWMH SP 3.2	LOT 602	WEBB	DRIVE	BERM	225	2.0	uPVC SN16	38.50	N	Dec-20	\$465	
21879-M-13-SW1	CP SP 10	SWMH SP 3.3	LOT 602	WEBB	DRIVE	BERM	225	1.8	uPVC SN16	38.12	N	Dec-20	\$419	
21879-M-13-SW1	CP SP 11	SWMH SP 3.4	LOT 602	WEBB	DRIVE	BERM	225	1.8	uPVC SN16	37.62	N	Dec-20	\$419	
21879-M-13-SW1	CP SP 18	SWM25005	LOT 602	WEBB	DRIVE	BERM	225	11.7	uPVC SN16	38.36	N	Dec-20	\$2,721	
21879-M-13-SW1	CP SP 19	SWM25006	LOT 602	WEBB	DRIVE	BERM	225	14.8	uPVC SN16	37.89	N	Dec-20	\$3,442	
21879-M-13-SW1	CP SP 20	SWM25007	LOT 602	WEBB	DRIVE	BERM	225	11.7	uPVC SN16	37.33	N	Dec-20	\$2,721	
21879-M-13-SW1	DCP 113	SWMH 19.4	LOT 366	GUILLAUME	STREET	ROADWAY	300	3.7	uPVC SN16	36.63	N	Dec-20	\$972	
21879-M-13-SW1	DCP SP 08	SWMH SP 3.1	LOT 602	WEBB	DRIVE	BERM	300	2.4	uPVC SN16	38.70	N	Dec-20	\$630	
21879-M-13-SW1	DCP SP 17	SWMH SP 4.2	LOT 602	WEBB	DRIVE	BERM	300	10.8	uPVC SN16	38.71	N	Dec-20	\$2,836	
21879-M-13-SW1	DCP SP 21	SWM25004	LOT 602	WEBB	DRIVE	BERM	300	16.6	uPVC SN16	36.34	N	Dec-20	\$4,359	

As Built Datasheet (to accompany As Built Plans) **Waikato Regional ITS**
STORMWATER SUBSOIL DRAIN Form Version 1 - July 2017

Developer/Contractor: Chedworth Properties Ltd / Online Contractors Prepared by: S & L
 Development/Subdivision/Job: Greenhill Park Date: Mar-21
 Stage: Stage 13

Plan ID	Dwnstr Asset ID	Street Name	Street Type	Physical Location (where necessary)	Pipe Diameter (mm)	Pipe Length (m)	Pipe Material	Invert Level Upstr (m)	Invert Level Dwnstr (m)	Easting Coordinate Inlet	Northing Coordinate Inlet	Easting Coordinate Outlet	Northing Coordinate Outlet	Service Status	Install Date	Asset Value	Comments
21879-M-13-SW1	DCP 053	CARRS	ROAD	BERM	100	36.9	NOVA	37.13	36.77					N	Dec-20	\$1,884	EXISTING CATCHPIT
21879-M-13-SW1	DCP 054	CARRS	ROAD	BERM	100	36.4	NOVA	37.14	36.77					N	Dec-20	\$1,859	EXISTING CATCHPIT
21879-M-13-SW1	CP 057	CARRS	ROAD	BERM	100	69.4	NOVA	38.02	37.11					N	Dec-20	\$3,544	
21879-M-13-SW1	CP 058	CARRS	ROAD	BERM	100	54.7	NOVA	37.57	37.14					N	Dec-20	\$2,793	
21879-M-13-SW1	CP 114	CARRS	ROAD	BERM	100	37.1	NOVA	39.78	39.08					N	Dec-20	\$1,894	
21879-M-13-SW1	CP 115	CARRS	ROAD	BERM	100	40.8	NOVA	39.68	39.04					N	Dec-20	\$2,083	
21879-M-13-SW1	CP 116	CARRS	ROAD	BERM	100	57.1	NOVA	39.08	38.56					N	Dec-20	\$2,916	
21879-M-13-SW1	CP 117	CARRS	ROAD	BERM	100	54.7	NOVA	39.06	38.55					N	Dec-20	\$2,793	
21879-M-13-SW1	CP 118	CARRS	ROAD	BERM	100	61.4	NOVA	38.57	38.05					N	Dec-20	\$3,135	
21879-M-13-SW1	CP 119	CARRS	ROAD	BERM	100	59.8	NOVA	38.44	38.00					N	Dec-20	\$3,053	
21879-M-13-SW1	CP SP 09	WEBB	DRIVE	BERM	100	54.3	NOVA	39.20	38.78					N	Dec-20	\$2,773	
21879-M-13-SW1	CP SP 10	WEBB	DRIVE	BERM	100	174.7	NOVA	39.35	38.38					N	Dec-20	\$8,920	
21879-M-13-SW1	CP SP 11	WEBB	DRIVE	BERM	100	53.7	NOVA	38.42	38.00					N	Dec-20	\$2,742	
21879-M-13-SW1	CP SP 18	WEBB	DRIVE	BERM	100	150.9	NOVA	39.85	38.97					N	Dec-20	\$7,705	
21879-M-13-SW1	CP SP 19	WEBB	DRIVE	BERM	100	53.1	NOVA	38.98	38.58					N	Dec-20	\$2,711	
21879-M-13-SW1	CP SP 20	WEBB	DRIVE	BERM	100	156.8	NOVA	39.13	38.24					N	Dec-20	\$8,006	
21879-M-13-SW1	DCP 113	GUILLAUME	STREET	BERM	100	51.2	NOVA	38.03	37.55					N	Dec-20	\$2,614	
21879-M-13-SW1	DCP SP 08	WEBB	DRIVE	BERM	100	161.4	NOVA	39.87	39.19					N	Dec-20	\$8,241	
21879-M-13-SW1	DCP SP 17	WEBB	DRIVE	BERM	100	72.7	NOVA	39.78	39.19					N	Dec-20	\$3,712	
21879-M-13-SW1	DCP SP 21	WEBB	DRIVE	BERM	100	72.8	NOVA	38.26	37.70					N	Dec-20	\$3,717	
21879-M-13-SW1	DCP SP 12	WEBB	DRIVE	BERM	100	44.7	NOVA	37.97	37.61					N	Dec-20	\$2,282	EXISTING CATCHPIT

As Built Datasheet (to accompany As Built Plans) Waikato Regional ITS

WASTEWATER PIPELINES

Form Version 1 - July 2017

Developer/Contractor: Chedworth Properties Ltd / Online Contractors
 Development/Subdivision/Job: Greenhill Park
 Stage: Stage 13

Prepared by: S & L
 Date: Mar-21

Plan ID	Upstr MH/ Asset ID	Dwnstr MH/ Asset ID	Street Name	Street Type	Physical Location (where necessary)	Pipe Diameter (mm)	Pipe Length (m)	Pipe Material	Joint Type	Invert Level Upstr (m)	Invert Level Dwnstr (m)	Service Status	Install Date	Asset Value	Comments
21879-M-13-WW1	WWMH 18.5	WWM25004	CARRS	ROAD	ROADWAY	225	20.7	uPVC SN16	RR	33.63	33.08	N	Nov-20	\$14,535	
21879-M-13-WW1	WWMH 18.4	WWMH 18.5	CARRS	ROAD	ROADWAY	225	85.0	uPVC SN16	RR	34.10	33.66	N	Nov-20	\$50,150	
21879-M-13-WW1	WWMH 18.3	WWMH 18.4	CARRS	ROAD	ROADWAY	150	66.8	uPVC SN16	RR	34.96	34.13	N	Nov-20	\$24,426	
21879-M-13-WW1	WWMH 18.2	WWMH 18.3	GUILLAUME	STREET	ROADWAY/PRIVATE PROPERTY	150	73.4	uPVC SN16	RR	35.39	35.02	N	Nov-20	\$19,438	
21879-M-13-WW1	WWMH 18A.1	WWMH 18.3	CARRS	ROAD	ROADWAY	150	70.2	uPVC SN16	RR	36.39	35.01	N	Nov-20	\$14,734	

As Built Datasheet (to accompany As Built Plans)**Waikato Regional ITS****WASTEWATER CONNECTION/SERVICE LINE**

Form Version 1 - July 2017

Developer/Contractor: Chedworth Properties Ltd / Online Contractors
 Development/Subdivision/Job: Greenhill Park
 Stage: Stage 13

Prepared by: S & L
 Date: Mar-21

Plan ID	Upstr MH/ Asset ID	Dwnstr MH/ Asset ID	Property ID (Lot No. or Address)	Street Name	Street Type	Physical Location (where necessary)	Service Pipe Diam (mm)	Service Pipe Length (m)	Service Pipe Material	Invert Level At Private End (m) OR Depth (m)	Easting Coordinate	Northing Coordinate	Distance from left (LB) or right (RB) boundary (m)	Distance from front (FB) or back (BB) boundary (m)	Service Status	Install Date	Asset Value	Comments
21879-M-13-WW1	-	WWMH 18A.1	LOT 357	CARRS	ROAD	BERM	100	13.6	uPVC SN16	1.2	447257.47	702748.87	1.3RB	1.3FB	N	Nov-20	\$1,054	
21879-M-13-WW1	-	WWMH 18A.1	LOT 358	CARRS	ROAD	BERM	100	3.6	uPVC SN16	1.2	447260.02	702749.95	1.5LB	1.6FB	N	Nov-20	\$279	
21879-M-13-WW1	WWMH 18A.1	WWMH 18.3	LOT 359	CARRS	ROAD	BERM	100	10.4	uPVC SN16	1.2	447273.45	702754.09	1.9LB	1.4FB	N	Nov-20	\$806	
21879-M-13-WW1	WWMH 18A.1	WWMH 18.3	LOT 360	CARRS	ROAD	BERM	100	10.1	uPVC SN16	1.2	447297.13	702761.45	0.6RB	1.2FB	N	Nov-20	\$783	
21879-M-13-WW1	WWMH 18.2	WWMH 18.3	LOT 361	GUILLAUME	STREET	BERM	100	10.3	uPVC SN16	1.2	447315.20	702784.20	1.2RB	1.5FB	N	Nov-20	\$799	
21879-M-13-WW1	WWMH 18.2	WWMH 18.3	LOT 362	GUILLAUME	STREET	BERM	100	5.6	uPVC SN16	1.2	447314.38	702787.75	2.5LB	1.0FB	N	Nov-20	\$434	
21879-M-13-WW1	WWMH 18.2	WWMH 18.3	LOT 363	GUILLAUME	STREET	BERM	100	8.8	uPVC SN16	1.2	447307.66	702806.26	1.9RB	1.0FB	N	Nov-20	\$682	
21879-M-13-WW1	WWMH 18.2	WWMH 18.3	LOT 364	GUILLAUME	STREET	BERM	100	11.0	uPVC SN16	1.2	447324.32	702811.91	2.3LB	1.3FB	N	Nov-20	\$852	
21879-M-13-WW1	WWMH 18.2	WWMH 18.3	LOT 365	GUILLAUME	STREET	BERM	100	5.6	uPVC SN16	1.2	447333.64	702794.84	2.6RB	1.8FB	N	Nov-20	\$434	
21879-M-13-WW1	WWMH 18.2	WWMH 18.3	LOT 366	GUILLAUME	STREET	BERM	100	11.6	uPVC SN16	1.2	447335.61	702791.82	0.9LB	2.2FB	N	Nov-20	\$899	
21879-M-13-WW1	WWMH 18.3	WWMH 18.4	LOT 367	CARRS	ROAD	BERM	100	10.4	uPVC SN16	1.2	447375.57	702791.57	0.7RB	1.6FB	N	Nov-20	\$806	
21879-M-13-WW1	WWMH 18.3	WWMH 18.4	LOT 368	CARRS	ROAD	BERM	100	5.3	uPVC SN16	1.2	447378.92	702792.15	2.6LB	0.7FB	N	Nov-20	\$411	
21879-M-13-WW1	WWMH 18.4	WWMH 18.5	LOT 369	CARRS	ROAD	BERM	100	5.4	uPVC SN16	1.2	447400.40	702803.19	2.6RB	1.3FB	N	Nov-20	\$419	
21879-M-13-WW1	WWMH 18.4	WWMH 18.5	LOT 370	CARRS	ROAD	BERM	100	10.4	uPVC SN16	1.2	447403.00	702804.99	0.6LB	1.7FB	N	Nov-20	\$806	
21879-M-13-WW1	WWMH 18.4	WWMH 18.5	LOT 371	CARRS	ROAD	BERM	100	4.9	uPVC SN16	1.2	447427.94	702817.79	2.0RB	1.2FB	N	Nov-20	\$380	
21879-M-13-WW1	WWMH 18.4	WWMH 18.5	LOT 372	CARRS	ROAD	BERM	100	9.7	uPVC SN16	1.2	447430.38	702819.94	1.2LB	1.9FB	N	Nov-20	\$752	
21879-M-13-WW1	WWMH 18.4	WWMH 18.5	LOT 373	CARRS	ROAD	BERM	100	10.1	uPVC SN16	1.2	447455.34	702834.66	1.2RB	1.6FB	N	Nov-20	\$783	
21879-M-13-WW1	WWMH 18.4	WWMH 18.5	LOT 374	CARRS	ROAD	BERM	100	5.5	uPVC SN16	1.2	447458.44	702836.78	2.5LB	1.8FB	N	Nov-20	\$426	

As Built Datasheet (to accompany As Built Plans) **Waikato Regional ITS**

WATER HYDRANTS

Form Version 1 - July 2017

Developer/Contractor: Chedworth Properties Ltd / Online Contractors Prepared by: S & L
 Development/Subdivision/Job: Greenhill Park Date: Mar-21
 Stage: Stage 13

Plan ID	Hydrant ID	Pipe ID	Property ID (Lot No. or Address)	Street Name	Street Type	Hydrant Size (mm)	Physical Location (where necessary)	Easting Coordinate	Northing Coordinate	Service Status	Install Date	Asset Value	Comments
21879-M-13-W1	FH1	RM9	LOT 602	WEBB	DRIVE	250	BERM	447355.64	703104.69	N	Jan-21	\$2,750	
21879-M-13-W1	FH2	RM9	LOT 602	WEBB	DRIVE	250	FOOTPATH	447399.96	702975.68	N	Jan-21	\$2,750	
21879-M-13-W1	FH3	RM9	LOT 602	WEBB	DRIVE	250	FOOTPATH	447451.13	702886.15	N	Jan-21	\$2,750	
21879-M-13-W1	FH4	RM3	LOT 370	CARRS	ROAD	150	FOOTPATH	447405.39	702802.63	N	Jan-21	\$2,750	
21879-M-13-W1	FH5	RM8	LOT 602	WEBB	DRIVE	150	BERM	447425.41	702983.23	N	Jan-21	\$2,750	
21879-M-13-W1	FH6	RM8	LOT 602	WEBB	DRIVE	150	BERM	447382.49	703107.23	N	Jan-21	\$2,750	

As Built Datasheet (to accompany As Built Plans)**Waikato Regional ITS****WATER PIPELINES**

Form Version 1 - July 2017

Developer/Contractor: Chedworth Properties Ltd / Online Contractors
 Development/Subdivision/Job: Greenhill Park
 Stage: Stage 13

Prepared by: S & L
 Date: Mar-21

Plan ID	Pipe ID	Pipe Diameter (mm)	Pipe Length (m)	Laying Depth (m)	Pipe Material	Joint Type	Service Status	Install Date	Asset Value	Comments
21879-M-13-W1	RM1	150	81.0	1.2	PVC-M PN12	RRJ	N	Jan-21	\$4,131	
21879-M-13-W1	RM2	150	41.1	1.2	PVC-M PN12	RRJ	N	Jan-21	\$2,096	
21879-M-13-W1	RM3	150	93.1	1.2	PVC-M PN12	RRJ	N	Jan-21	\$4,748	
21879-M-13-W1	RM4	150	18.0	1.2	PVC-M PN12	RRJ	N	Jan-21	\$918	
21879-M-13-W1	RM5	150	5.2	1.2	PVC-M PN12	RRJ	N	Jan-21	\$265	
21879-M-13-W1	RM6	150	71.7	1.2	PVC-M PN12	RRJ	N	Jan-21	\$3,657	
21879-M-13-W1	RM7	150	110.7	1.2	PVC-M PN12	RRJ	N	Jan-21	\$5,646	
21879-M-13-W1	RM8	150	230.9	1.2	PVC-M PN12	RRJ	N	Jan-21	\$11,776	
21879-M-13-W1	RM9	250	306.3	1.2	PVC-M PN12	RRJ	N	Jan-21	\$26,036	
21879-M-13-W1	RM10	250	144.2	1.2	PVC-M PN12	RRJ	N	Jan-21	\$12,257	
21879-M-13-W1	RM11	250	9.3	1.2	PVC-M PN12	RRJ	N	Jan-21	\$791	
21879-M-13-W1	RM12	250	107.5	1.2	PVC-M PN12	RRJ	N	Jan-21	\$9,138	
21879-M-13-W1	RM13	250	50.3	1.2	PVC-M PN12	RRJ	N	Jan-21	\$4,276	

As Built Datasheet (to accompany As Built Plans) **Waikato Regional ITS**
Form Version 1 - July 2017

WATER CONNECTION/SERVICE LINE

Developer/Contractor: Chedworth Properties Ltd / Online Contractors
 Development/Subdivision/Job: Greenhill Park
 Stage: Stage 13

Prepared by: S & L
 Date: Mar-21

Plan ID	Pipe ID	Property ID (Lot No. or Address)	Street Name	Street Type	Physical Location (where necessary)	Service Pipe Diam (mm)	Service Pipe Length (m)	Service Pipe Material	Easting Coordinate	Northing Coordinate	Distance from left (LB) or right (RB) boundary (m)	Meter Installed (Y/N)	Service Status	Install Date	Asset Value	Comments
21879-M-13-W1	RM1	LOT 357	CARRS	ROAD	BERM	25	3.4	MDPE	447247.62	702744.64	1.6LB	N	N	Jan-21	\$705	
21879-M-13-W1	RM1	LOT 358	CARRS	ROAD	BERM	25	3.5	MDPE	447260.17	702747.85	0.8LB	N	N	Jan-21	\$705	
21879-M-13-W1	RM1	LOT 359	CARRS	ROAD	BERM	25	3.4	MDPE	447272.98	702751.88	0.6LB	N	N	Jan-21	\$705	
21879-M-13-W1	RM1	LOT 360	CARRS	ROAD	BERM	25	0.8	MDPE	447286.21	702756.13	0.9LB	N	N	Jan-21	\$705	
21879-M-13-W1	RM1	LOT 361	CARRS	ROAD	BERM	25	1.2	MDPE	447313.84	702765.52	16.4LB	N	N	Jan-21	\$705	
		LOT 362														TO BE PROVIDED WITH STAGE 14 ASBUILTS
		LOT 363														TO BE PROVIDED WITH STAGE 14 ASBUILTS
		LOT 364														TO BE PROVIDED WITH STAGE 14 ASBUILTS
		LOT 365														TO BE PROVIDED WITH STAGE 14 ASBUILTS
21879-M-13-W1	RM2	LOT 366	CARRS	ROAD	BERM	25	0.9	MDPE	447350.92	702778.73	16.2RB	N	N	Jan-21	\$705	
21879-M-13-W1	RM2	LOT 367	CARRS	ROAD	BERM	25	1.1	MDPE	447366.88	702785.60	1.2LB	N	N	Jan-21	\$705	
21879-M-13-W1	RM2	LOT 368	CARRS	ROAD	BERM	25	0.8	MDPE	447377.70	702790.24	0.6LB	N	N	Jan-21	\$705	
21879-M-13-W1	RM3	LOT 369	CARRS	ROAD	BERM	25	1.0	MDPE	447391.30	702796.71	1.0LB	N	N	Jan-21	\$705	
21879-M-13-W1	RM3	LOT 370	CARRS	ROAD	BERM	25	0.9	MDPE	447404.23	702803.11	0.8LB	N	N	Jan-21	\$705	
21879-M-13-W1	RM3	LOT 371	CARRS	ROAD	BERM	25	1.0	MDPE	447418.61	702810.67	1.1LB	N	N	Jan-21	\$705	
21879-M-13-W1	RM3	LOT 372	CARRS	ROAD	BERM	25	1.0	MDPE	447431.32	702817.75	0.9LB	N	N	Jan-21	\$705	
21879-M-13-W1	RM3	LOT 373	CARRS	ROAD	BERM	25	1.1	MDPE	447445.59	702826.20	1.1LB	N	N	Jan-21	\$705	
21879-M-13-W1	RM9	LOT 374	CARRS	ROAD	BERM	25	2.2	MDPE	447466.70	702841.66	4.3RB	N	N	Jan-21	\$705	

As Built Datasheet (to accompany As Built Plans) **Waikato Regional ITS**
Form Version 1 - July 2017

Developer/Contractor: Chedworth Properties Ltd / Online Contractors
 Development/Subdivision/Job: Greenhill Park
 Stage: Stage 13

Prepared by: S & L
 Date: Mar-21

Plan ID	Valve ID	Pipe ID	Property ID (Lot No. or Address)	Street Name	Street Type	Valve Size (mm)	Valve Manufacturer	Easting Coordinate	Northing Coordinate	Service Status	Install Date	Asset Value	Comments
21879-M-13-W1	SV1	RM9	LOT 602	WEBB	DRIVE	250	HAWLE	447356.04	703103.45	N	Jan-21	\$3,350	
21879-M-13-W1	SV2	RM8	LOT 602	WEBB	DRIVE	150	HAWLE	447459.46	702921.23	N	Jan-21	\$2,200	
21879-M-13-W1	SV3	RM12	LOT 374	CARRS	ROAD	250	HAWLE	447460.40	702833.61	N	Jan-21	\$3,350	
21879-M-13-W1	SV4	RM9	LOT 374	CARRS	ROAD	250	HAWLE	447459.27	702833.43	N	Jan-21	\$3,350	
21879-M-13-W1	SV5	RM2	LOT 368	CARRS	ROAD	150	HAWLE	447378.79	702789.89	N	Jan-21	\$2,200	
21879-M-13-W1	SV6	RM3	LOT 368	CARRS	ROAD	150	HAWLE	447380.15	702788.87	N	Jan-21	\$2,200	
21879-M-13-W1	SV7	RM10	LOT 603	CARRS	ROAD	250	HAWLE	447387.15	702772.34	N	Jan-21	\$3,350	
21879-M-13-W1	SV8	RM11	LOT 603	CARRS	ROAD	250	HAWLE	447395.67	702776.15	N	Jan-21	\$3,350	
21879-M-13-W1	SV9	RM5	LOT 603	CARRS	ROAD	150	HAWLE	447396.45	702775.43	N	Jan-21	\$2,200	
21879-M-13-W1	SV10	RM12	LOT 603	CARRS	ROAD	250	HAWLE	447471.96	702818.60	N	Jan-21	\$3,350	
21879-M-13-W1	SV11	RM8	LOT 602	WEBB	DRIVE	150	HAWLE	447374.78	703134.89	N	Jan-21	\$2,200	
21879-M-13-W1	SV12	RM7	LOT 602	N/A	N/A	150	HAWLE	447529.31	702884.47	N	Jan-21	\$2,200	
21879-M-13-W1	SV13	RM7	LOT 1 DP 534384	N/A	N/A	150	HAWLE	447536.12	702871.33	N	Jan-21	\$2,200	
21879-M-13-W1	SV14	RM6	LOT 1 DP 534384	N/A	N/A	150	HAWLE	447538.23	702870.49	N	Jan-21	\$2,200	
21879-M-13-W1	SV15	RM6	LOT 1 DP 534384	N/A	N/A	150	HAWLE	447529.64	702834.50	N	Jan-21	\$2,200	